

QUANTITY SHEET - E

ITEMS	SHEET NO.'S				AS PER PLANS				AS CONSTRUCTED						
	TOTALS		UNITS		CONSTRUCTION SEQUENCE		REMOVALS		PLAN & PROFILES		UTILITY PLAN		WATER SYSTEM ALTERATIONS		
	R-4	R-5	R-6	R-8	W-1	R-4	R-5	R-6	R-8	W-1	R-4	R-5	R-6	R-8	W-1
ROADWAY ITEMS															
Removing Pavement	2720	58'166'													
Remove Curb	201	Lin. Ft.													
Remove Sidewalk	325	58'166'													
Remove Masonry f Concrete Structures	300	Cu. Yds.													
Abandoning Drainage Structures	5	Each													
Remove Bituminous Surface	207	Sq. Yds.													
Earth Excavation	8434	Cu. Yds.													
Subgrade Underpinning with 22A Slag Backfill	1000	Cu. Yds.													
22A Slag Backfill	1500	Cu. Yds.													
Conc. Base Course - Nonreinforced - 9" with Integral Curb	879	Sq. Yds.													
Bituminous Conc. Leveling Course (2.5A)	203	Tons													
Bituminous Conc. Slewing Course Type F	145	Tons													
Bituminous Bond Coat (Not a Pav. Item)	521	Gals.													
Preparing Existing Pavement	Lump Sum	Lump Sum													
Conc. Pavement - Nonreinforced - 8"	42	Sq. Yds.													
Conc. Pavement - Reinforced - 9" with Integral Curb	150	Sq. Yds.													
Conc. Pavement - Double Reinforced - 9"	2512	Sq. Yds.													
Conc. Pavement - Double Reinforced - 9" with Integral Curb	1422	Sq. Yds.													
Reinforcing Conc. Pavement - Nonreinforced - 8"	35	Sq. Yds.													
12" Sewer 2' x 2' III (Trench Detail S)	68	Lin. Ft.													
12" Sewer 2' x 2' III (Encased) (Trench Detail S)	137	Lin. Ft.													
12" Ductile Iron Encased Pipe (Trench Detail S)	45	Lin. Ft.													
12" Ductile Iron Encased Pipe (Trench Detail S)	190	Lin. Ft.													
Check Basin "A"	1	Each													
Check Basin "B"	5	Each													
Manhole Drop	1	Each													
Adjust Drainage Structure Covers	3	Each													
12" Sewer Trap	1	Each													
Concrete Curb Detail X	526	Lin. Ft.													
4" Concrete Sidewalk	4431	Sq. Ft.													
6" Concrete Sidewalk	289	Sq. Ft.													
Sidewalk Ramps - Type I	160	Sq. Ft.													
Glued Rail Anchorage - Single	1	Each													
Structural Glued Rail Anchorage - Type A	1	Each													
Field Lab - Concrete Proportioning	1	Each													
Maintaining Traffic	Lump Sum	Lump Sum													
Type II Barricade (Drums) Lighted	14	Each													
Drum Guide Rail	350	Lin. Ft.													
Class A Sealing	1312	Sq. Yds.													
Gravel Surface (L.M.)	158	Cu. Yds.													
WATER SYSTEM ALTERATIONS															
12" In Ductile Iron Water Main	934	Lin. Ft.													
12" In Gate Valve	1	Each													
12" In Gate Valve Well	1	Each													
8" In Ductile Iron Meter Main	62	Lin. Ft.													
6" In Ductile Iron Meter Main	92	Lin. Ft.													
3'0"x3'0" Reinforced Conc. Encasement	573	Lin. Ft.													
2'0"x2'0" Reinforced Conc. Encasement	140	Lin. Ft.													
6" In Fire Hydr. (incl. 6" In gate Valve Box Related Piping)	2	Each													
Adjust Gatewell Manhole Cover	4	Each													
Abandon Manhole (Electrical)	4	Each													
On the Job Training															
BULKHEAD 15" SEWER	LUMP SUM @ 700.00														
72" CHAIN LINK FENCE	LUMP SUM @ 1383.40														
SUPPLEMENTAL VENTILATION	LUMP SUM @ 4450.00														
INSTALL FLATER REMOVE CHAIN LINK FENCE WITH															
BARBED WIRE AT TUNNEL OPENINGS	@ 1370.00														
FIREPROOFING CABLES	@ 3456.12														
WIRING OF FAN INTAKE DAMPER MOTORS	@ 3655.25														



GENERAL NOTES

All Water Main construction shall be performed with materials and workmanship of the highest quality for the particular purpose and shall strictly conform to the current standards and specifications of the Detroit Metro Water Department.

Pavement removal and replacement, excavation and backfill for the entire work, including that for work to be done by the D.M.W.D., shall be done by the contractor.

The contractor shall furnish all waterworks material required for the entire work, including materials for work indicated on the drawings to be done by the D.M.W.D., except for materials for services 2-inch in diameter or smaller.

After the newly constructed Water Mains have been satisfactorily pressure tested, flushed and chlorinated, the contractor shall make all connections to existing Water Mains, unless otherwise noted or shown on the drawings.

Service connections, 2-inch in diameter or smaller, and their relocations will be made by D.M.W.D. Abandoned water services 2-inch in diameter or smaller on Existing Water Mains to remain in service will be abandoned at the Existing Water Mains by D.M.W.D. Services to be abandoned at the Existing Water Main or to be reconnected to the New Water Mains are not all shown on the plans.

Existing Water Mains, as shown, indicate approximate locations only as shown by D.M.W.D. records and no guarantee is made as to completeness or accuracy.

Exact elevations of Existing Water Mains are not known. Approximate elevations shown on the profiles are based on the assumption of 5 feet average depth. The grades of the Proposed Water Mains are subject to change to suit actual elevations of Existing Water Mains.

The locations and elevations of existing utilities are shown in accordance with available data received from utility companies.

The Contractor shall expose these utilities, where required to determine actual locations.

Other utilities may be making alterations to their existing systems in the vicinity of the Water Main construction shown on the plans. These utilities should be consulted for the latest information regarding the location of their facilities.

A minimum clearance of one foot vertically and three and one half feet horizontally shall be maintained between the Water Main and other utilities, unless otherwise shown on the plans or approved by the Engineer. If a conflict is indicated between the Water Main and any other utility, that utility should be consulted.

The location of Fire Hydrants, as shown, are approximate. D.F.D. will give exact location of New or Relocated Fire Hydrants prior to installation.

Elevation Datum is City of Detroit Datum.

Pipe shall have Bell and Spigot Joints designed for sealing with a Rubber Gasket such as "Tyton" "Super Bell Tight" or approved equal except that Line Valves, Hydrant Connections and Hydrant Valves shall have leaded joints in accordance with D.M.W.D. Specifications.

The Drawings indicate the arrangement, general design and extent of the Water Main alterations. The Mains and connections are shown, more or less, in diagram and in their general locations, except where in certain cases the Drawings may include details giving the exact location and arrangement. Due to the small scale of the Drawings, it is not possible to indicate all offsets, fittings, valves and accessories that are required. The Contractor shall carefully investigate the structural and other conditions affecting all the work and shall arrange and perform his work under this Contract accordingly, furnishing and installing such items of material as may be required to meet such conditions.

In compliance with Public Act 53 of the State of Michigan (Effective Aug. 1, 1970), the Contractor shall notify in advance of construction all public and private owners having existing facilities in or near the immediate working area. For convenience the known utility owners are listed on this sheet. This listing does not, however, relieve the Contractor of the responsibility of verifying utility locations and notifying all utility owners and Miss Dig (Phone 677-344 in Area Code 313).

The Detroit Edison Co. 2000 Second Avenue Detroit, Michigan 48226 Overhead, 644-8940 Underground, 962-2100	Mich. Consolidated Gas Co. One Woodward Avenue Detroit, Michigan 48226 Overhead, 644-8940 Underground, 962-2100	Mich. Bell Telephone Co. 29350 Southfield Rd., Rm. 25 Southfield, Michigan 48076 Phone 352-5946	Public Lighting Comm. 7900 Joseph Campus Detroit, Michigan 48211 Phone 675-0972
--	---	--	--

CONSTRUCTION NOTES

All Water Main work performed by the Contractor must be inspected by the D.M.W.D. during construction.

Encasements and Thrust Blocks shall be poured against undisturbed earth. Bottom 3" of Encasement may be poured separate from Encasement and used as a sub-footing.

All Encasements and Thrust Blocks shall terminate at the face of pipe bells.

Removal of abandoned Water Mains as required for clearance to construct the proposed Water Mains shall be done by the contractor.

The Contractor shall expose existing Water Mains at points of connection and verify their location prior to pipe laying, so that minimum work will be required.

Thrust Blocks will be required at all bends greater than 110° for C.I. or D.I. Water Mains. Vertical Thrust Blocks for all top bends will require reinforcing steel.

Contractor shall construct all Concrete Thrust Blocks and Gate Wells.

The Contractor shall perform the work required to connect or disconnect water mains at junctions with the existing system which is to remain in service, except as otherwise shown. Valve operations, installation of Hydrants connecting to existing, or new Water Mains, shall be included in the Contractors Work. Flushing and chlorination will be included in D.M.W.D. work. The Contractor shall perform all other work in conjunction with D.M.W.D. work. Contractor's work includes Earth Excavation, Disposal, Backfill, Sheet piling, Bracing, Pumping and Drainage required for maintenance of trench and for disposal of waste water; Barricades, Traffic Control, Material handling and Standby assistance (including crane work required), Pavement Removal and Replacement, Thrust Blocks Encasements and Gate Wells.

The Contractor shall cut and cap or plug existing Water Mains to remain in service where required.

All 4" C.I. Blow-off Assemblies, C.I. Plugs and Caps to be installed and/or removed by Contractor have not been shown on the drawings.

The Contractor shall remove all temporary C.I. Plugs, Tees and Blow-off Assemblies at points of water main connections unless otherwise specified.

The Contractor shall install all Pipe and Fittings necessary to complete the connections required on this Contract.


Proposed construction work by other Utility Companies as shown on these drawings, is in accordance with information supplied by the Utility Company. The D.M.W.D. does not guarantee the completeness or accuracy of locations of Proposed Utility Work by others. The Contractor shall make his own investigation regarding such work.

Outline of demolished building substructures as shown on the drawings are based on the best available information. We do not guarantee that these or other underground substructures are or are not present.


Existing Water Mains to be cut and abandoned for new Water Main construction shall be bulkheaded with a minimum 8" thickness of concrete or brick, mortared in place.

WATER SYSTEM ALTERATION QUANTITIES	
DESCRIPTION OF ITEM	QUANTITIES AND PAY UNIT
12-inch Ductile Iron Water Main	934 lin. ft.
12-inch Gate Valve	1 each
12-inch Gate Valve Well	1 each
8-inch Ductile Iron Water Main	62 lin. ft.
6-inch Ductile Iron Water Main	92 lin. ft.
3'-0" x 3'-0" Reinforced Conc. Encasement	573 lin. ft.
2'-0" x 2'-0" Reinforced Conc. Encasement	140 lin. ft.
6-inch Fire Hydrant (Including 6-inch Gate Valve, Gate Box & Related Piping)	2 each

LEGEND

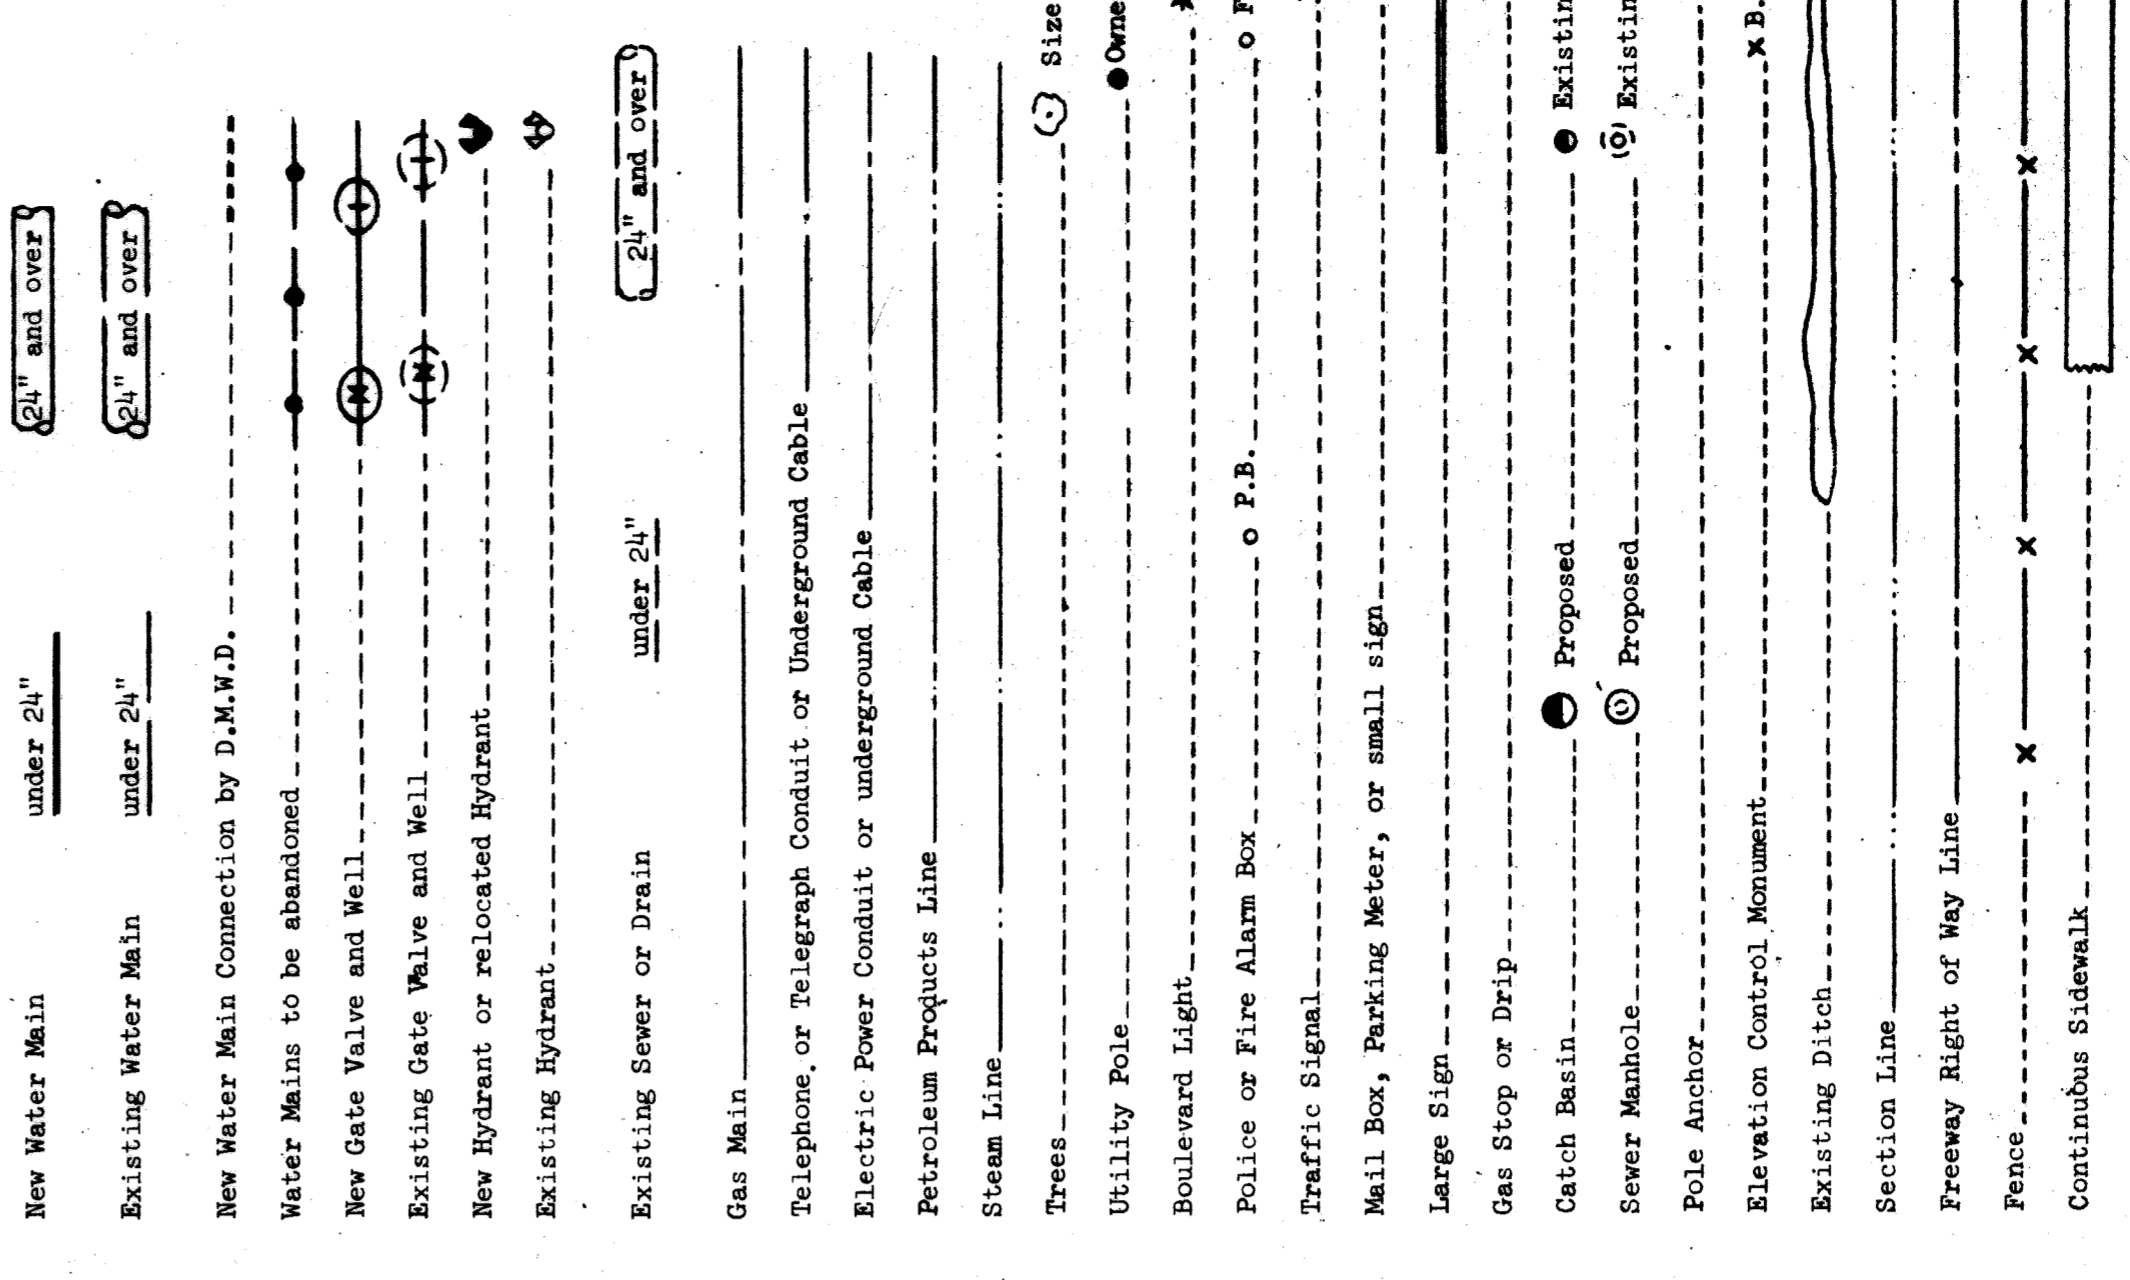

DETROIT METRO WATER DEPARTMENT ENGINEERING DIVISION		M.D.P. PERMIT NO. FED. REF. NO. CONTRACT NO.	
CIVIC CENTER PLAZA - PHASE II WATER SYSTEM ALTERATIONS GENERAL NOTES AND QUANTITIES			
DESIGNED BY <i>H. Wilson</i>		APPROVED <i>H. Wilson</i>	
DRAWN BY		CHECKED BY <i>L.S. 1/28/75</i>	
DIRECTOR OF ENGINEERING		CHIEF ENGINEER	
DATE 8-11-75	SCALE	SECTION MAP	TOWN
DATE FEBRUARY, 1975		REGION	RANGE
WORK ORDER NO. D-010		SECTION	SHEET
DRAWING NO.		SHEET	23 OF 81

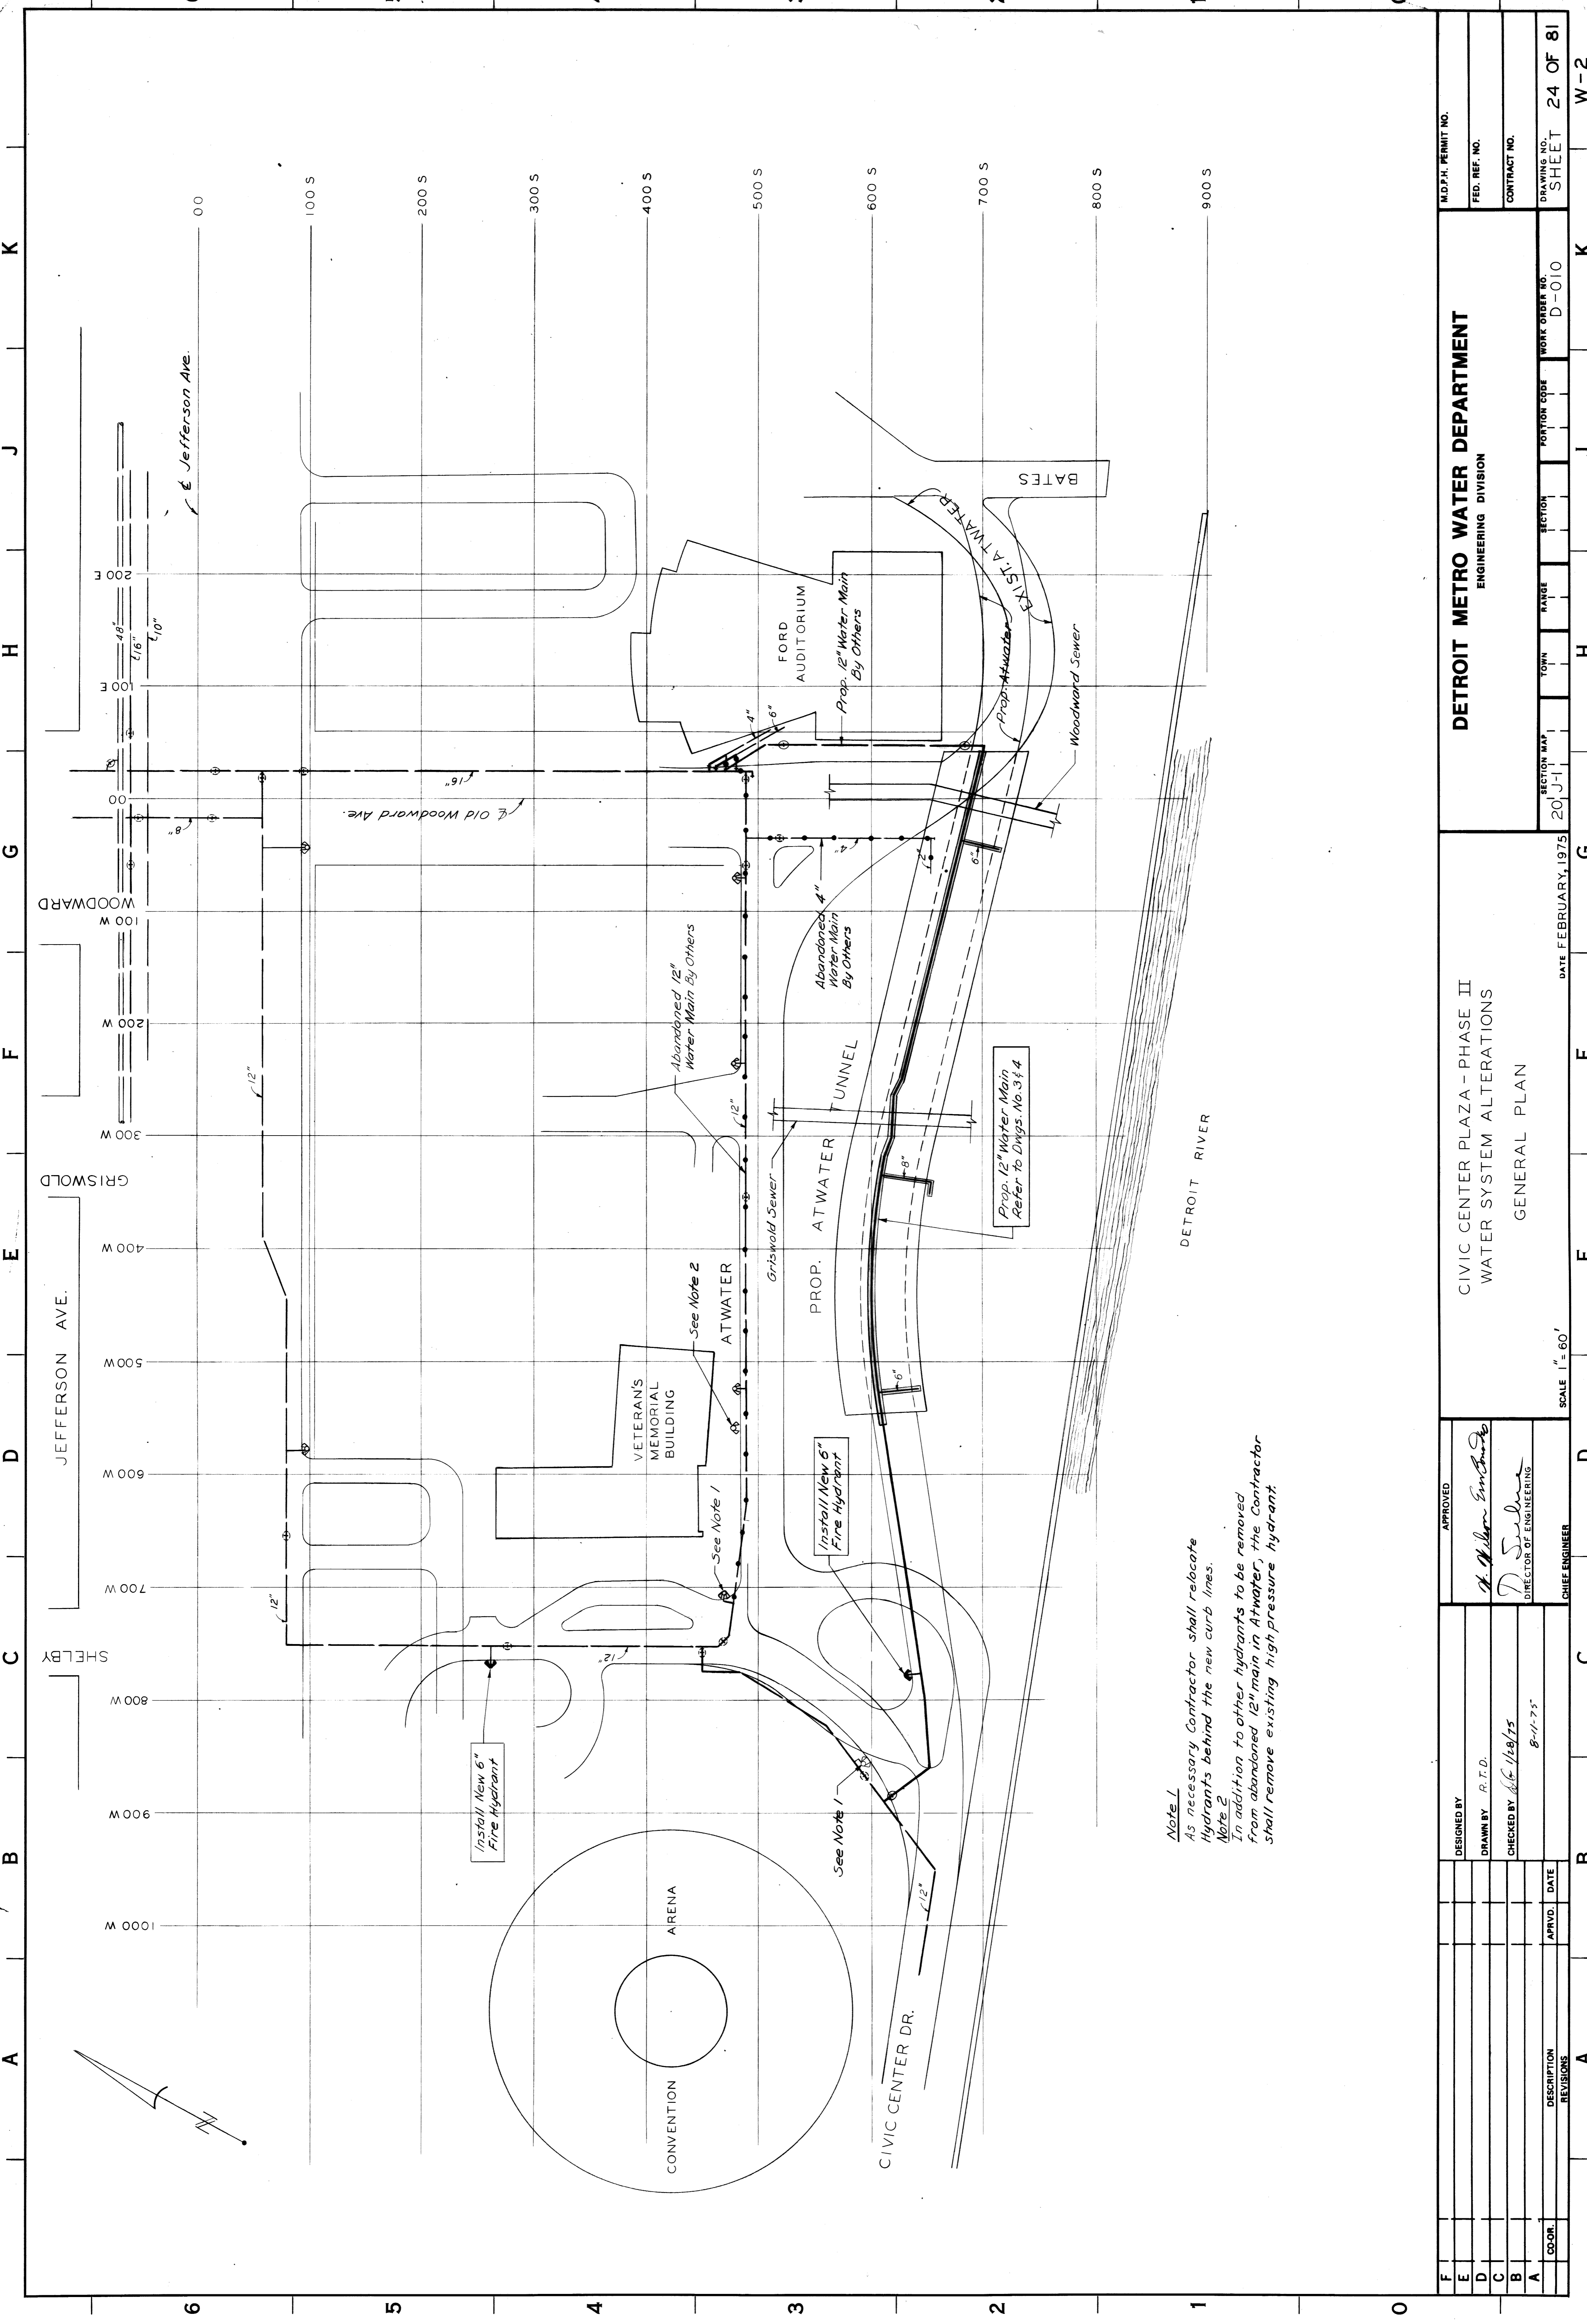


Note 1
 As necessary Contractor shall relocate Hydrants behind the new curb lines.
Note 2
 In addition to other hydrants to be removed from abandoned 12" main in Atwater, the Contractor shall remove existing high pressure hydrant.

Prop. 12" Water Main Refer to Dwg. No. 3 & 4

Install New 6" Fire Hydrant

Install New 6" Fire Hydrant


DESIGNED BY		APPROVED	
DRAWN BY R.T.D.		<i>A. Wilson</i>	
CHECKED BY <i>6/12/75</i>		DIRECTOR OF ENGINEERING	
APVD. DATE 8-11-75		CHIEF ENGINEER	
DESCRIPTION REVISIONS		SCALE 1" = 60'	
SECTION MAP 20 J-1		DATE FEBRUARY, 1975	
TOWN RANGE SECTION		WORK ORDER NO. D-010	
DRAWING NO. SHEET 24 OF 81		CONTRACT NO.	
FED. REF. NO.		M.D.P.H. PERMIT NO.	
DETROIT METRO WATER DEPARTMENT			
ENGINEERING DIVISION			
CIVIC CENTER PLAZA - PHASE II			
WATER SYSTEM ALTERATIONS			
GENERAL PLAN			

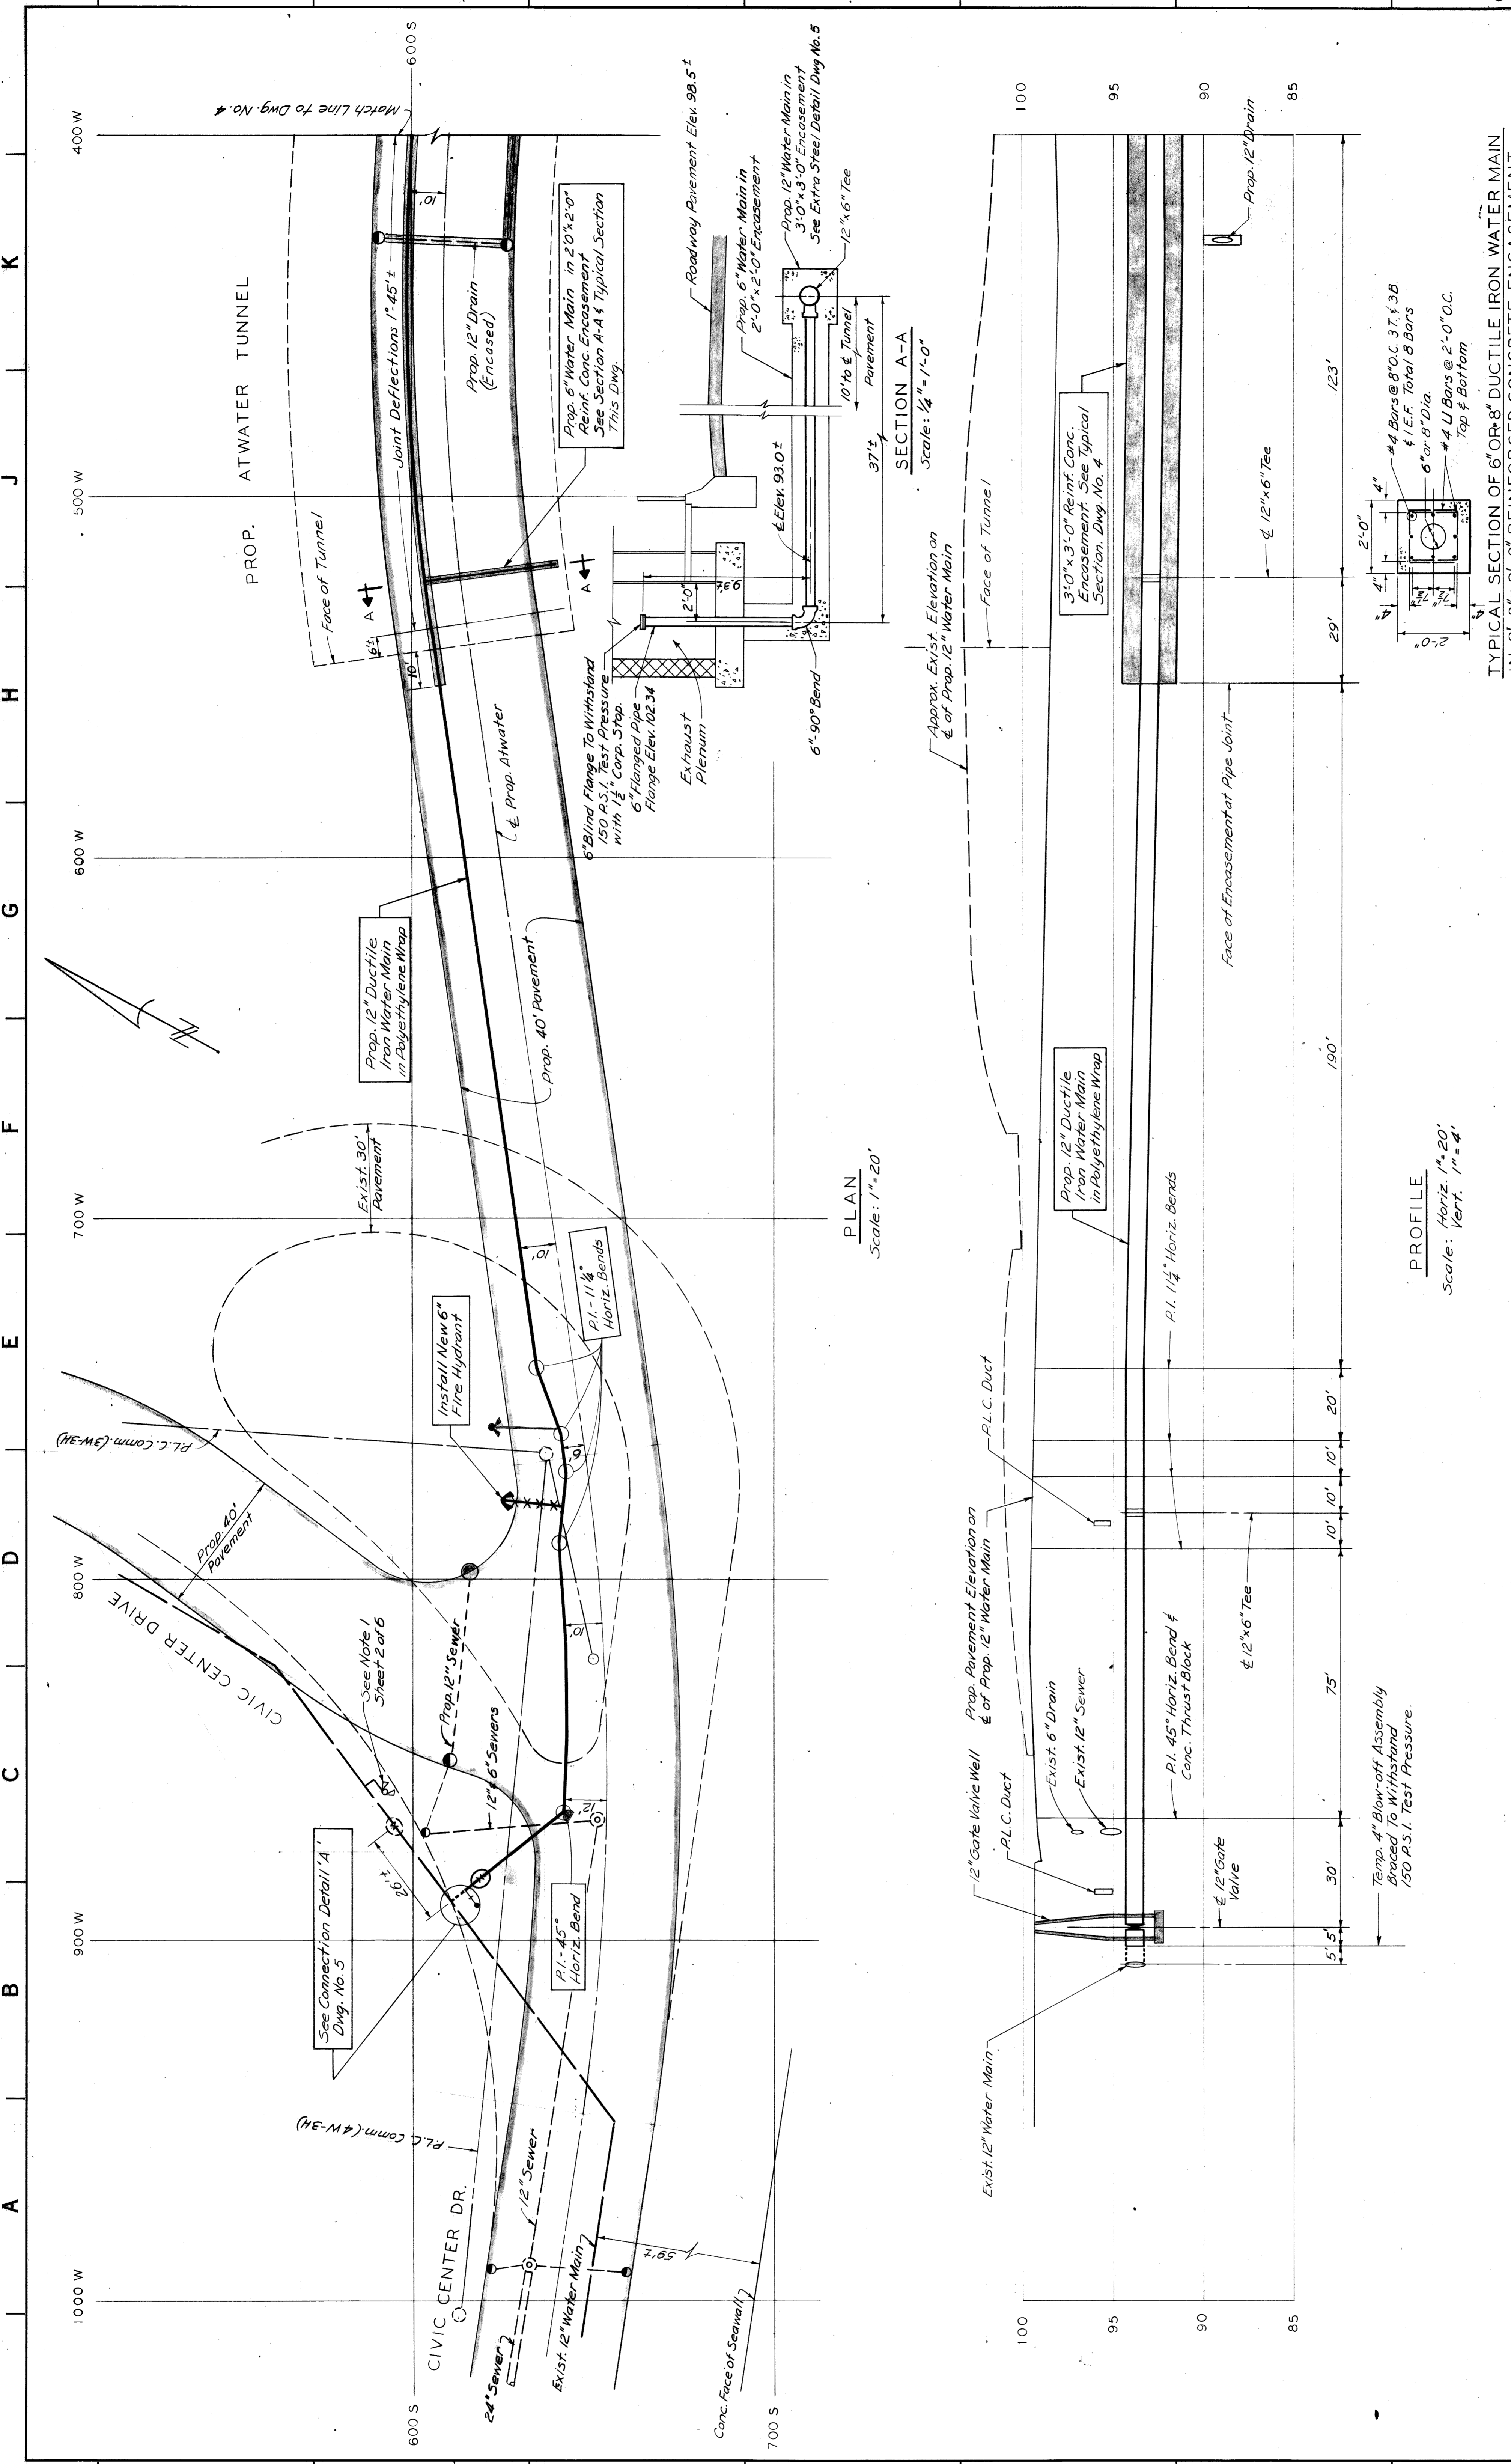


PLAN
Scale: 1" = 20'

PROFILE
Scale: Horiz 1" = 20'
Vert 1" = 4'


TYPICAL SECTION OF 6" OR 8" DUCTILE IRON WATER MAIN
IN 2'-0" x 2'-0" REINFORCED CONCRETE ENCASEMENT
Scale: 1/2" = 1'-0"

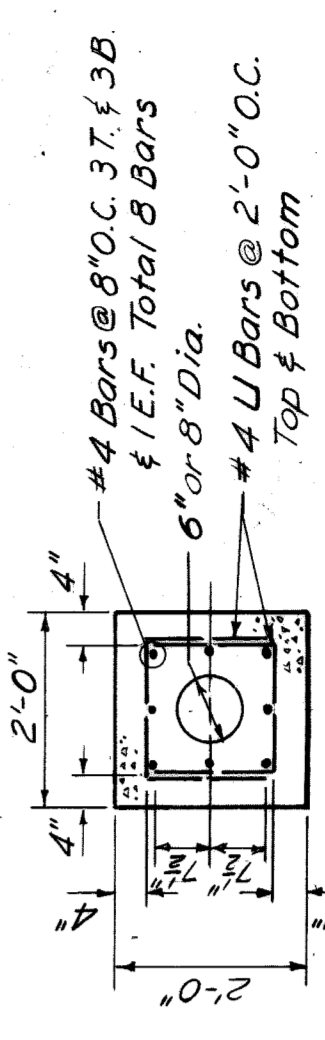


DESIGNED BY	APPROVED	DETROIT METRO WATER DEPARTMENT ENGINEERING DIVISION	
DRAWN BY R.T.D.	<i>Robert Embs</i>	CIVIC CENTER PLAZA - PHASE II WATER SYSTEM ALTERATIONS ATWATER TUNNEL PROPOSED 12-INCH WATER MAIN	
CHECKED BY D.S.	<i>D. S. Sullivan</i>	SECTION MAP	WORK ORDER NO.
DATE 8-11-75	DIRECTOR OF ENGINEERING	20-J-1	D-010
DESCRIPTION	SCALE AS SHOWN	TOWN	RANGE
REVISIONS	CHIEF ENGINEER	SECTION	PORTION CODE
A	AS BUILT	DATE FEBRUARY, 1975	NO. 25 OF 81
B			
C			
D			
E			
F			

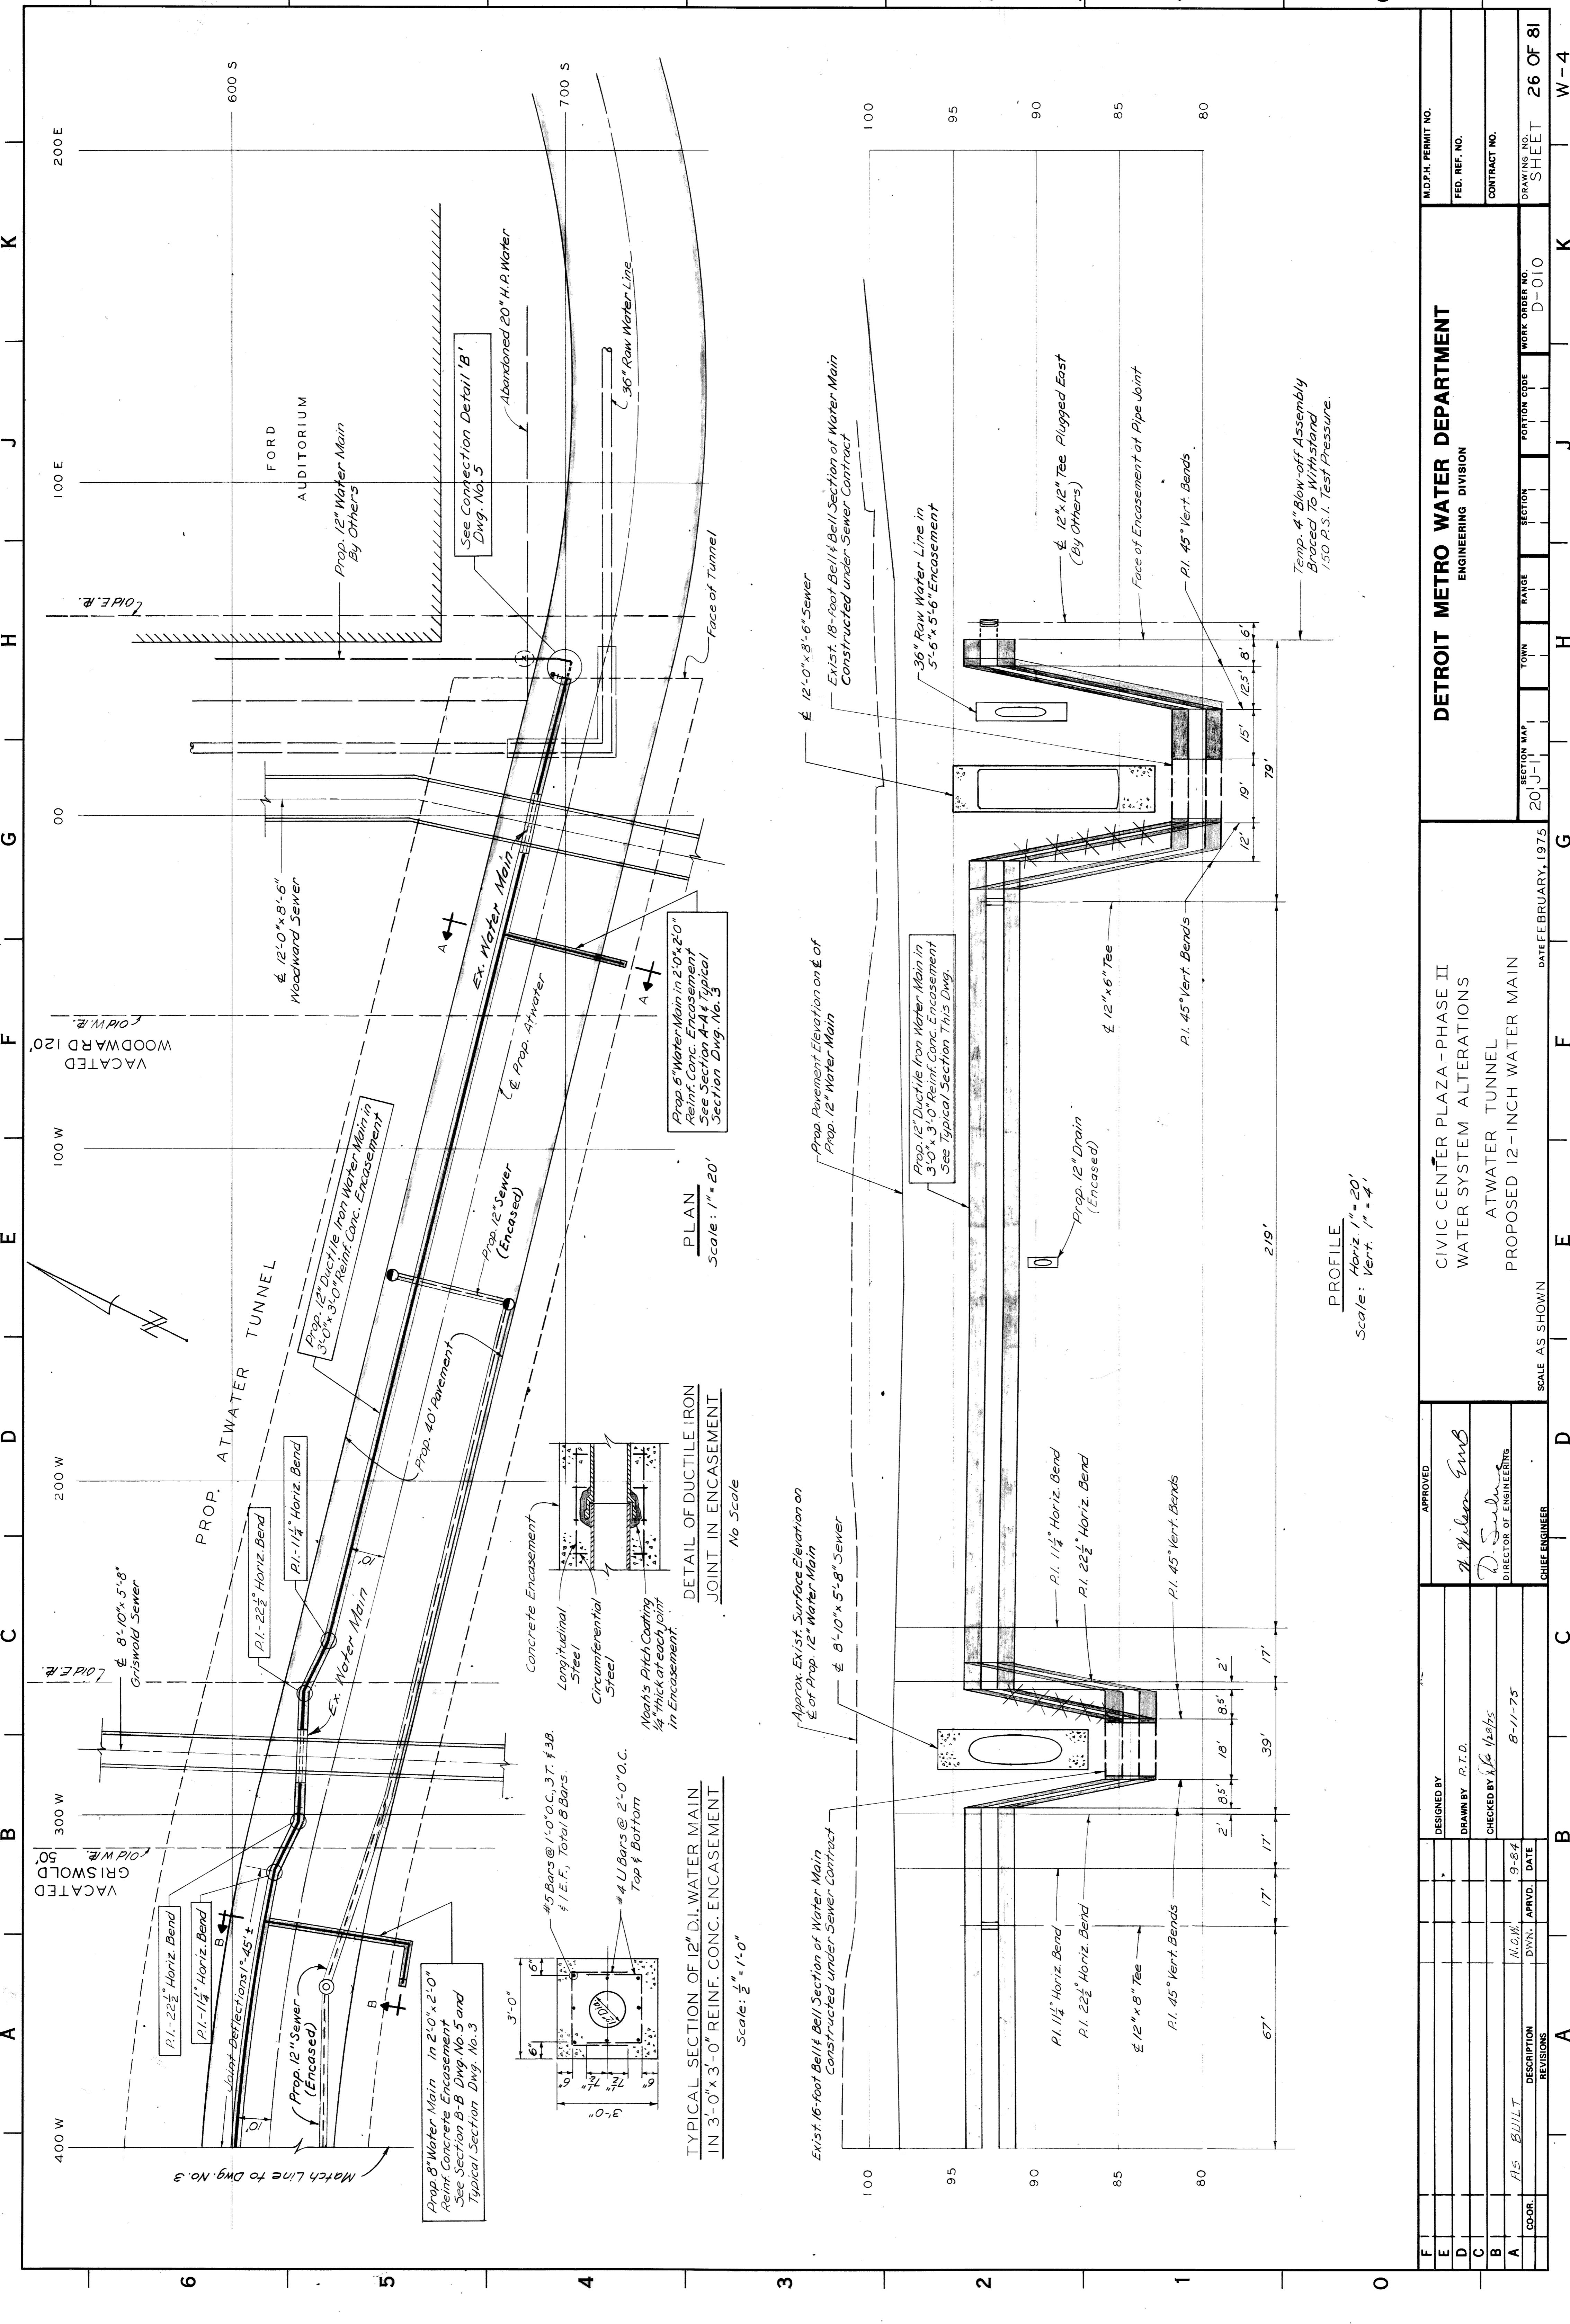


DESIGNED BY	APPROVED	CIVIC CENTER PLAZA - PHASE II WATER SYSTEM ALTERATIONS AT WATER TUNNEL PROPOSED 12-INCH WATER MAIN	DETROIT METRO WATER DEPARTMENT ENGINEERING DIVISION	M.D.P.H. PERMIT NO. FED. REF. NO. CONTRACT NO.			
DRAWN BY R.T.D.	<i>A. Wilson Emb</i> DIRECTOR OF ENGINEERS				SECTION MAP 20-J-1	PORTION CODE D-010	WORK ORDER NO. D-010
CHECKED BY J.B. 1/28/75	8-11-75				TOWN RANGE SECTION	SHEET 26 OF 81	DATE FEBRUARY, 1975
COOR.	AS BUILT N.O.M. 9-84	REVISIONS	SCALE AS SHOWN	DATE FEBRUARY, 1975	SHEET 26 OF 81	W-4	

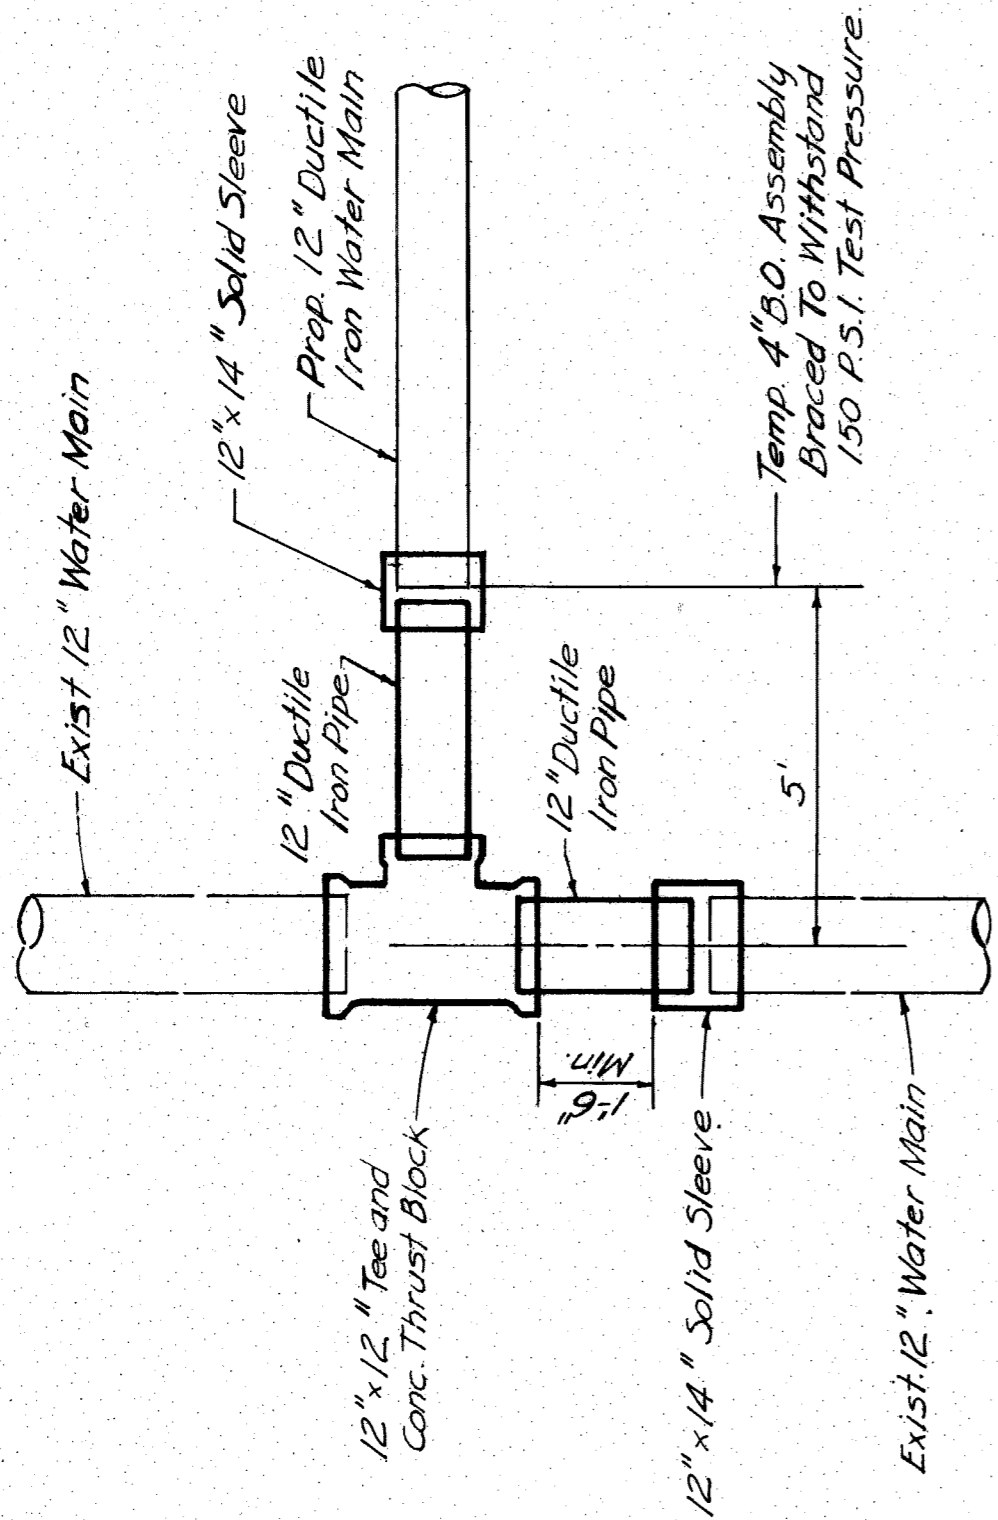

PLAN
DETAIL 'A'
(Dwg. No. 3)

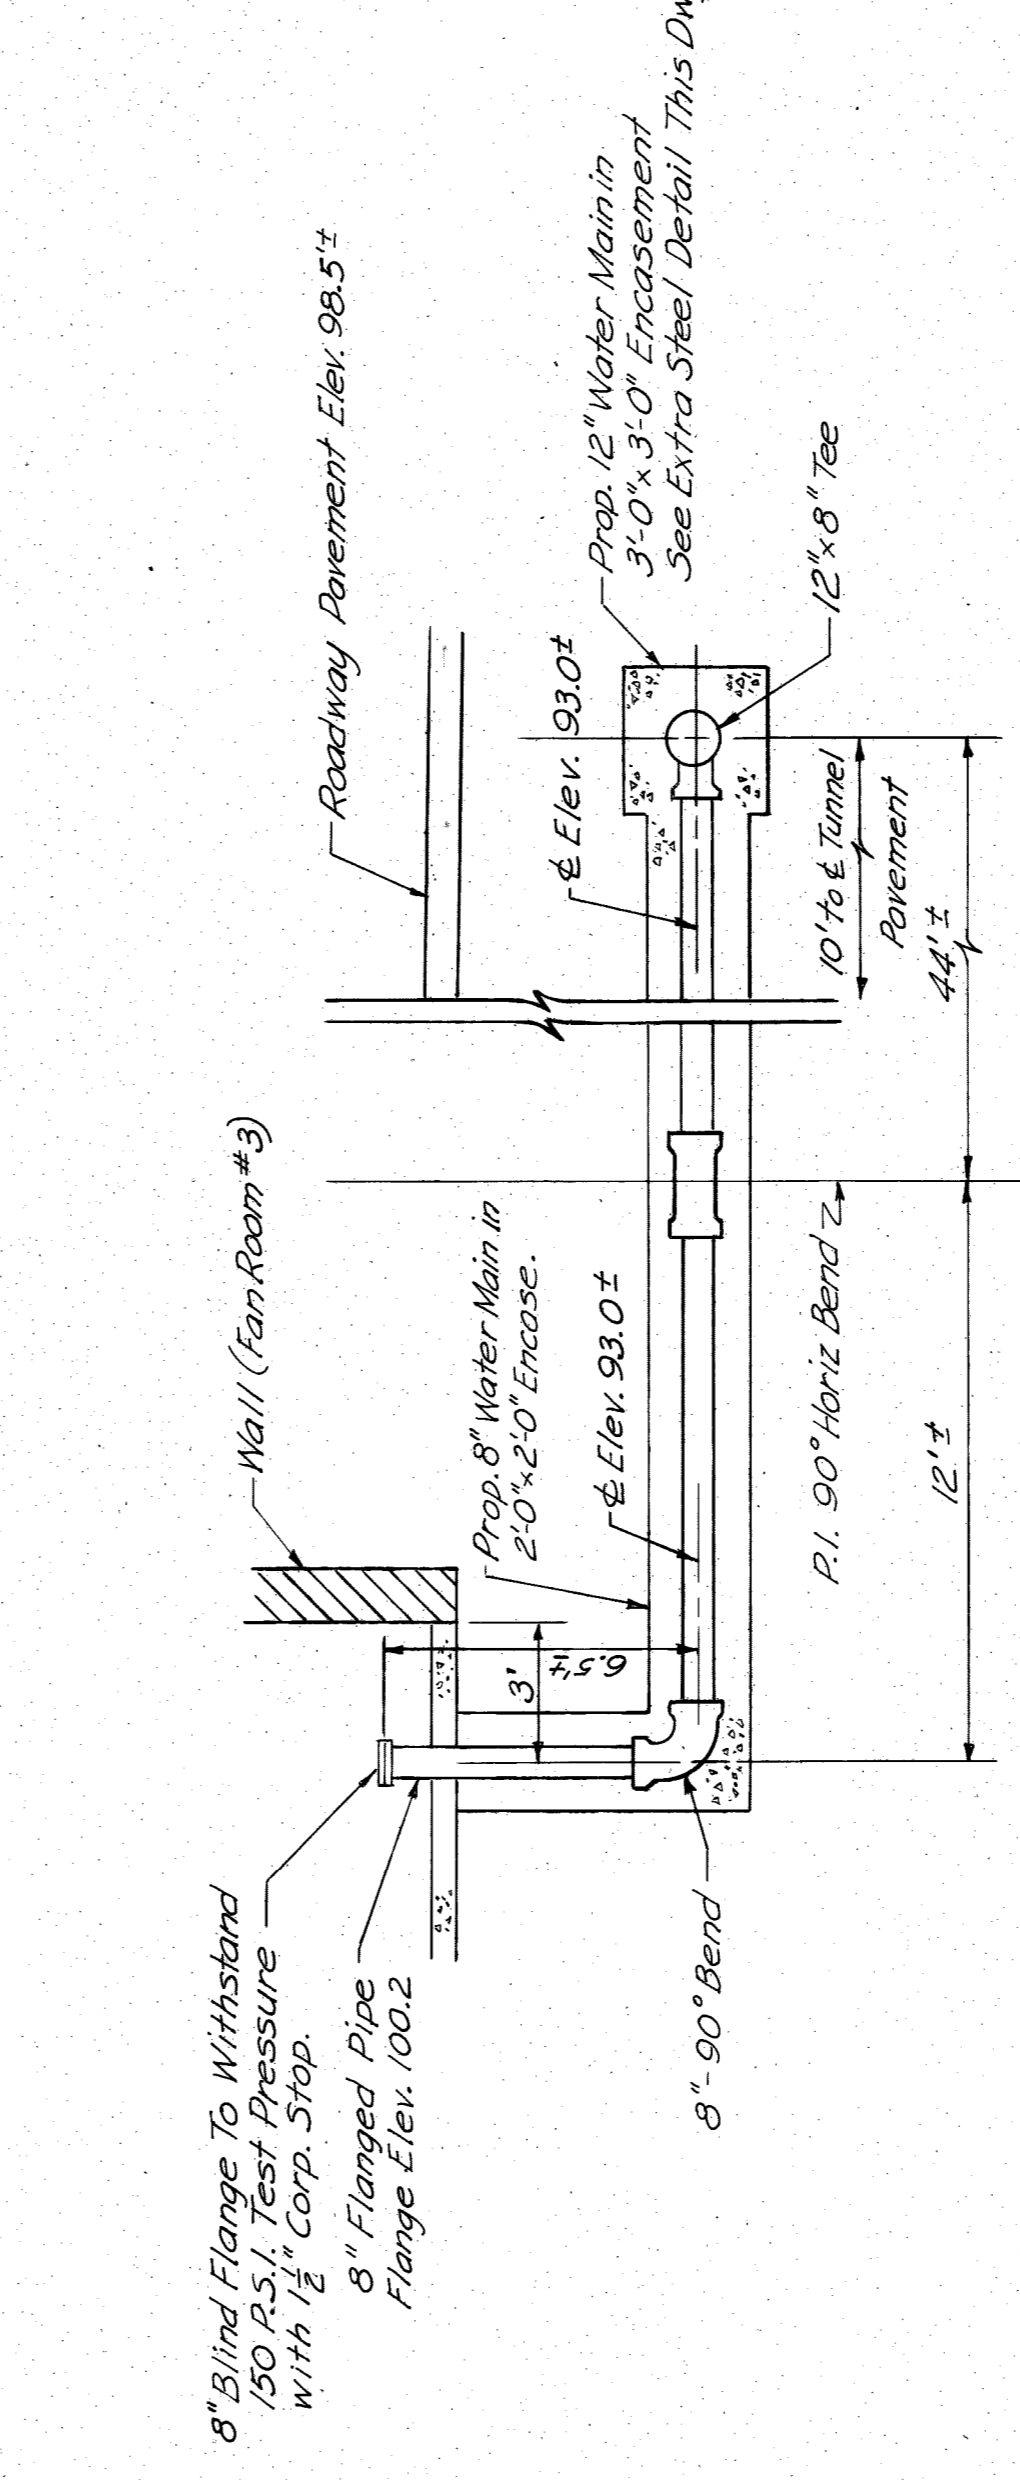


SECTION B-B
(Dwg. No. 4)

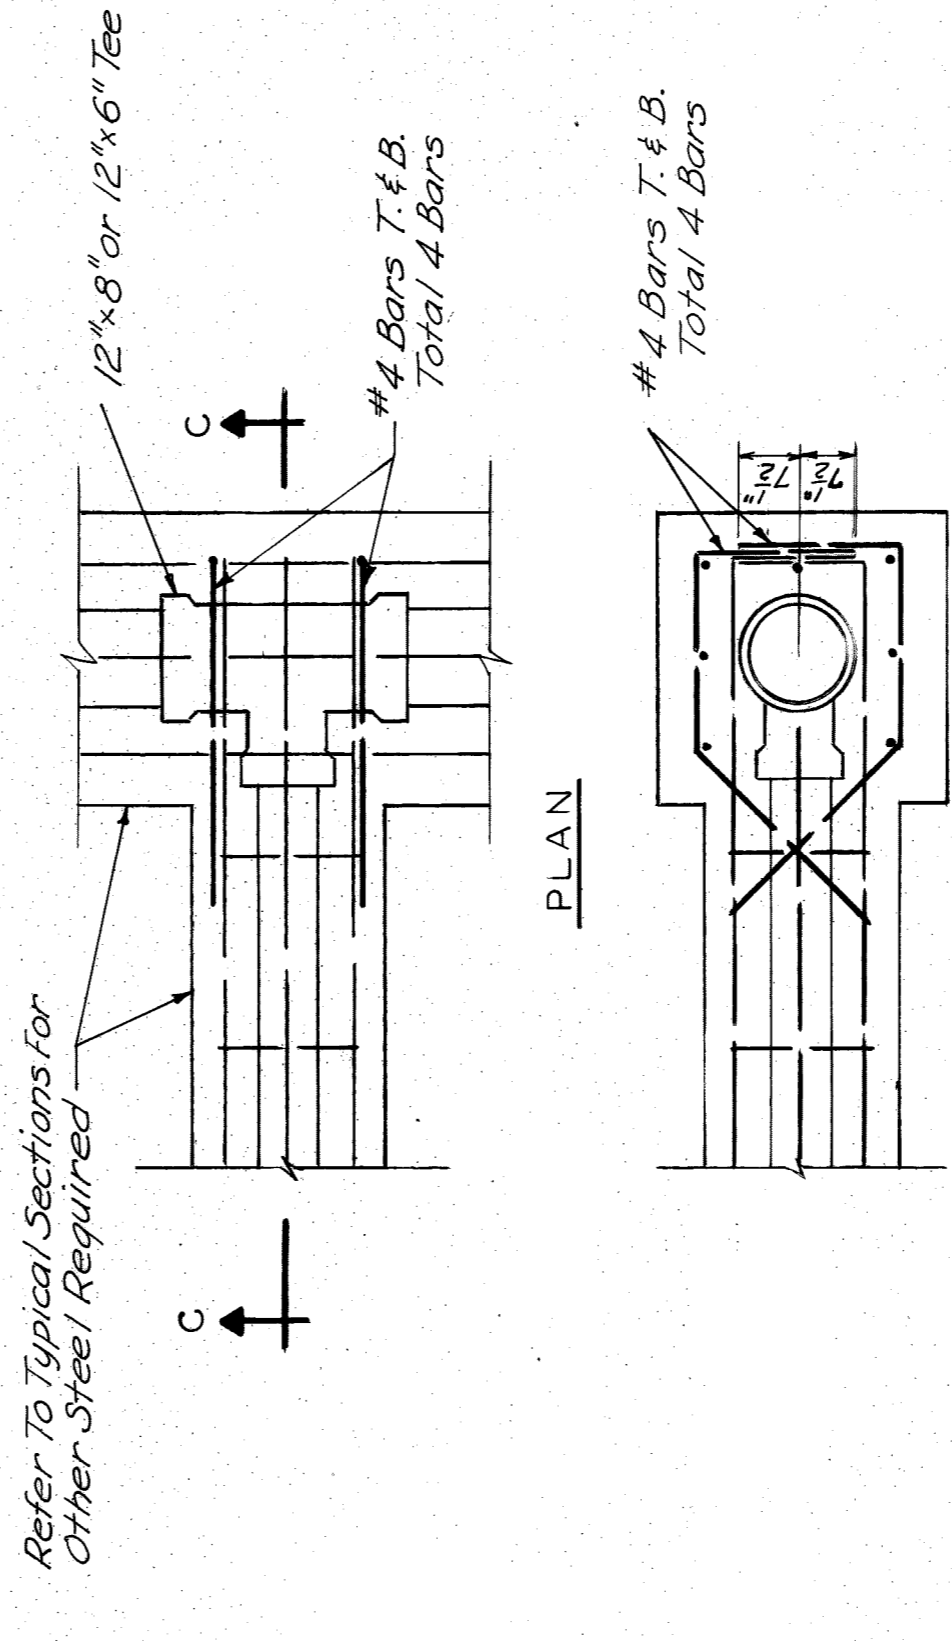

SECTION C-C


































EXTRA STEEL REQUIRED FOR ENCASEMENT
AT 12" x 8" AND 12" x 6" TEE
(Dwgs. No. 3 & 4)

NOTE
Connection Details are typical and may require adaptation to fit a particular connection.

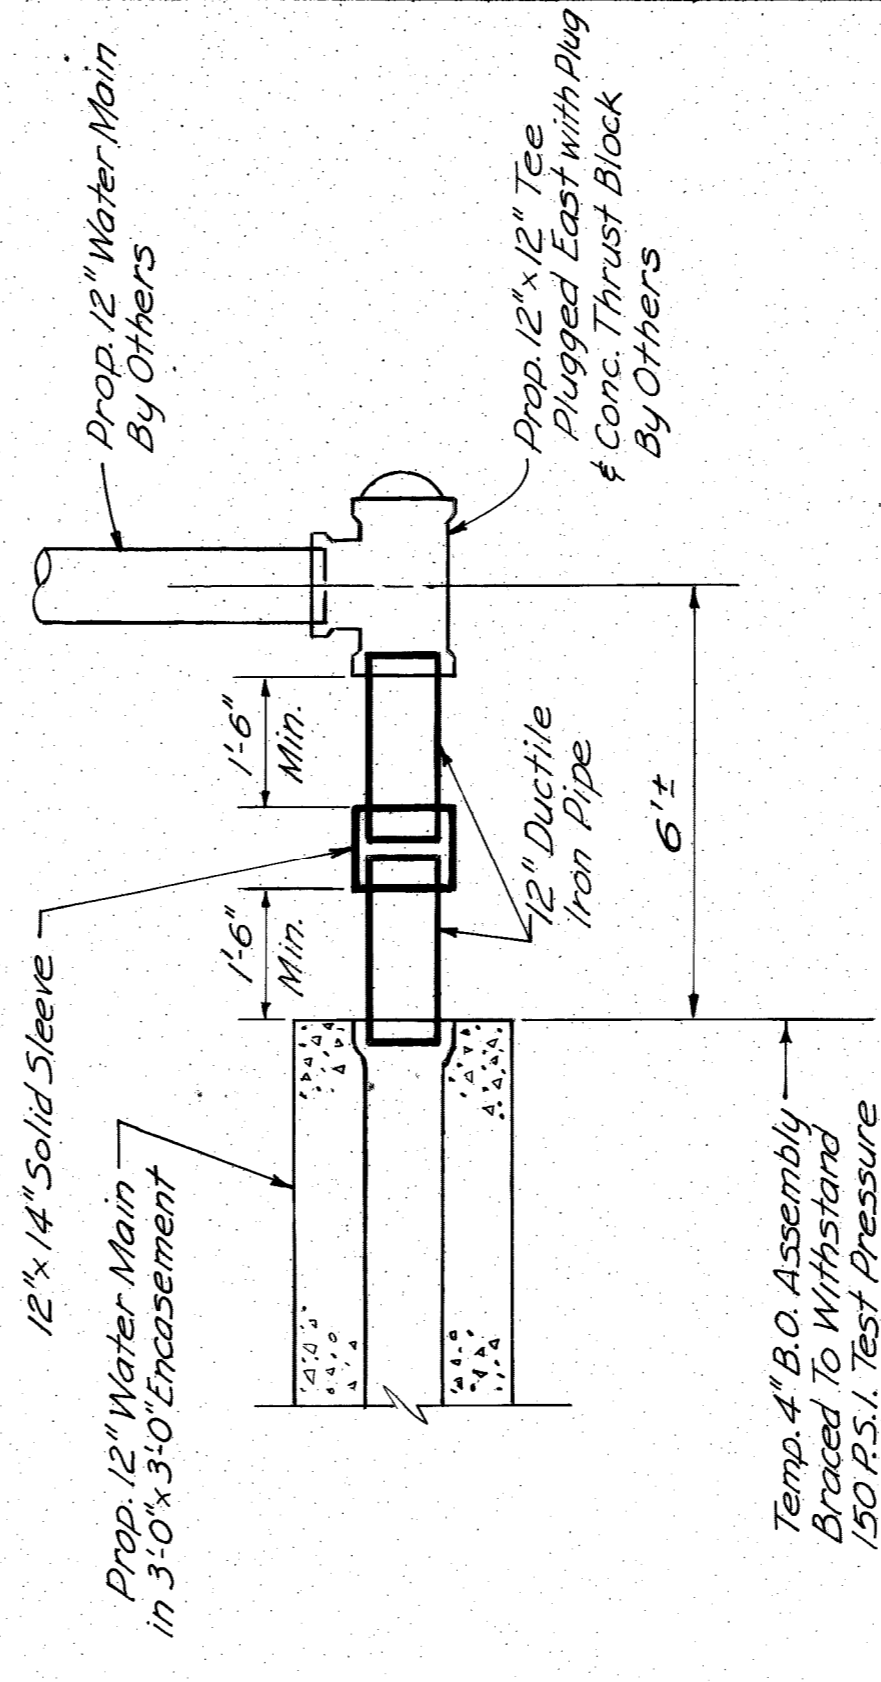

PLAN
DETAIL 'B'
(Dwg. No. 4)

DESIGNED BY		APPROVED		DETROIT METRO WATER DEPARTMENT		M.D.P.H. PERMIT NO.	
DRAWN BY R.T.D.		<i>A. Johnson</i>		ENGINEERING DIVISION		FED. REF. NO.	
CHECKED BY <i>EE 1/24/75</i>		<i>D. J. ...</i>		CONNECTION AND ENCASEMENT DETAILS		CONTRACT NO.	
DATE 8-11-75		DIRECTOR OF ENGINEERING		CIVIC CENTER PLAZA - PHASE II WATER SYSTEM ALTERATIONS		DRAWING NO. SHEET 27 OF 81	
APPRD. DATE		CHIEF ENGINEER		SCALE NONE		WORK ORDER NO. D-010	
DESCRIPTION REVISIONS				SECTION MAP		TOWN RANGE SECTION PORTION CODE	
				DATE FEBRUARY, 1975		W - 5	

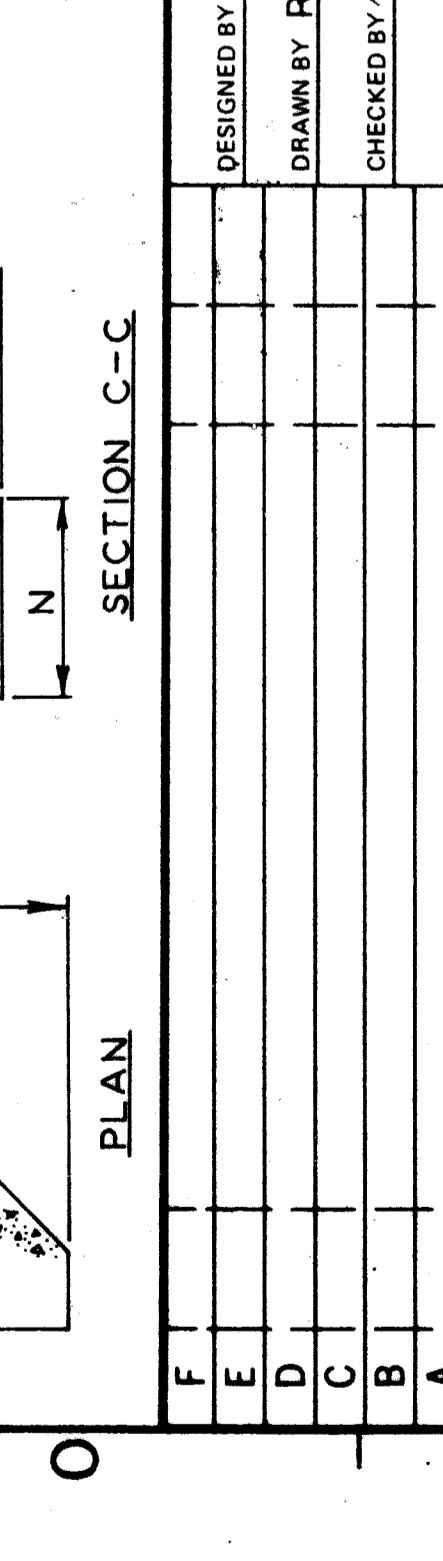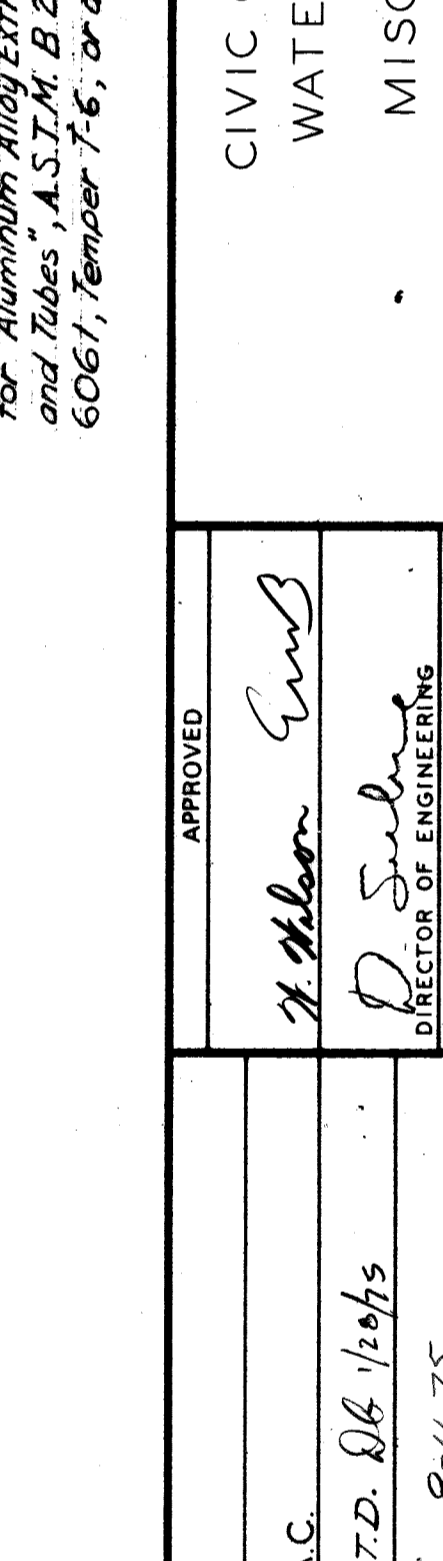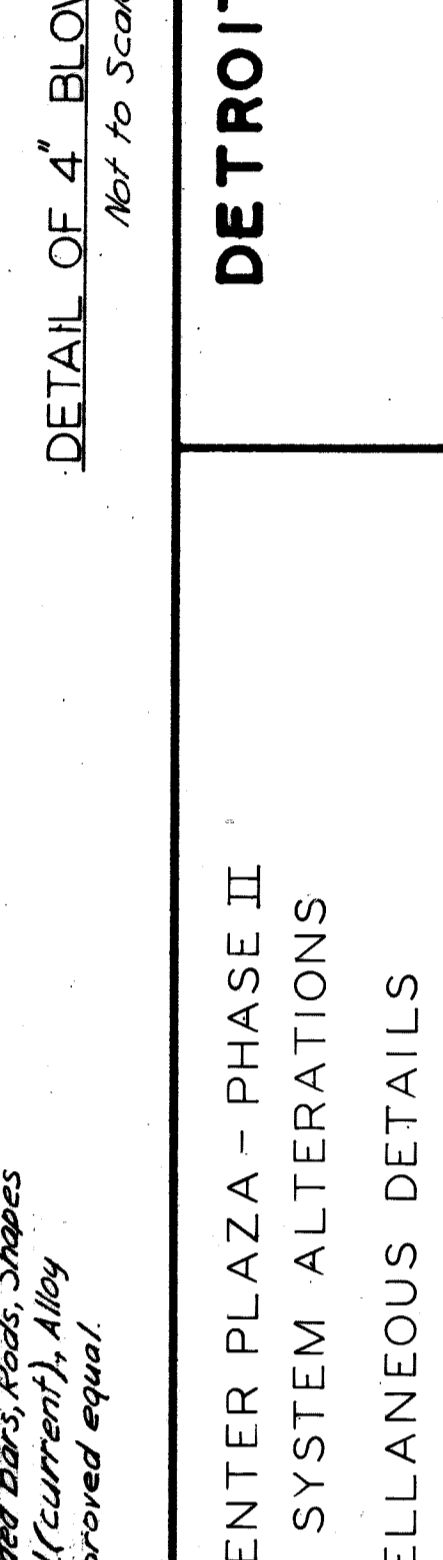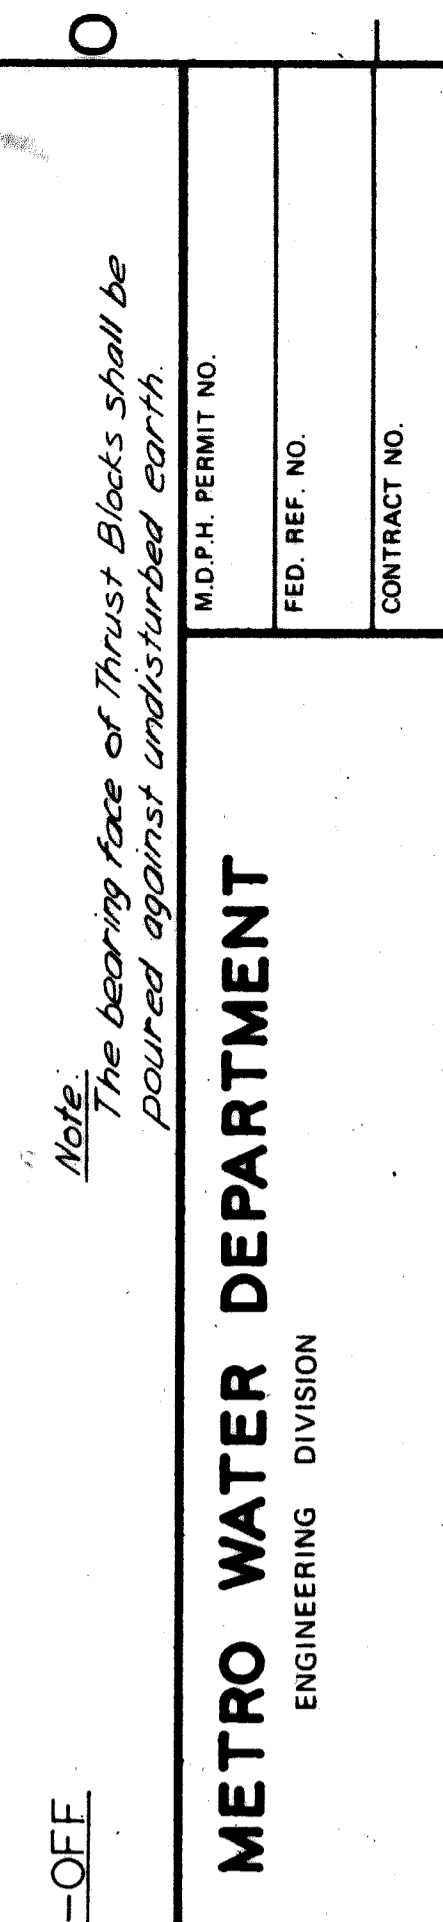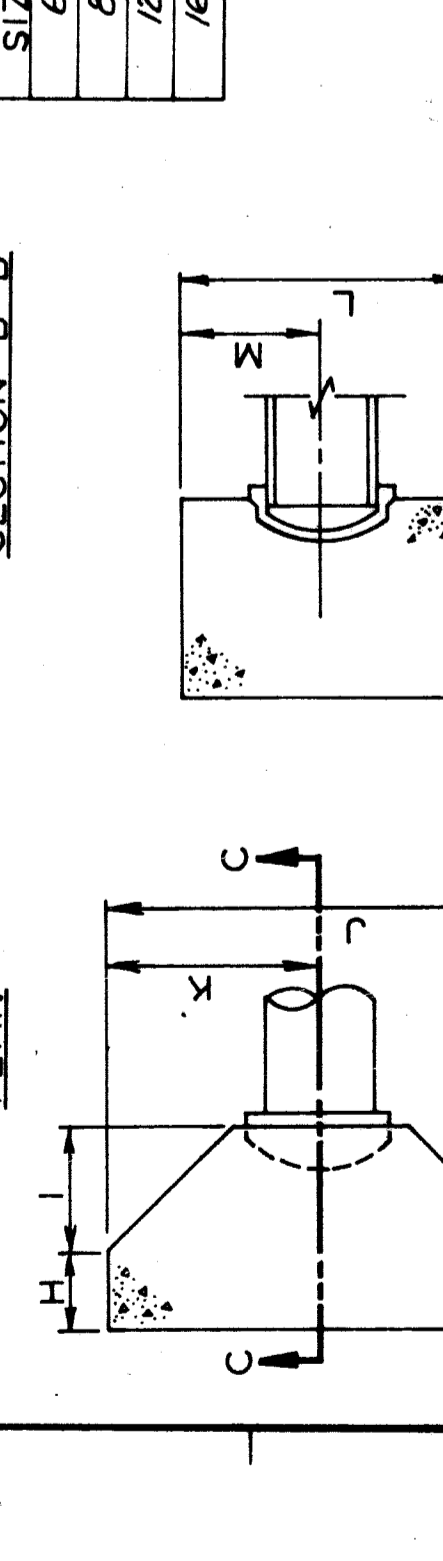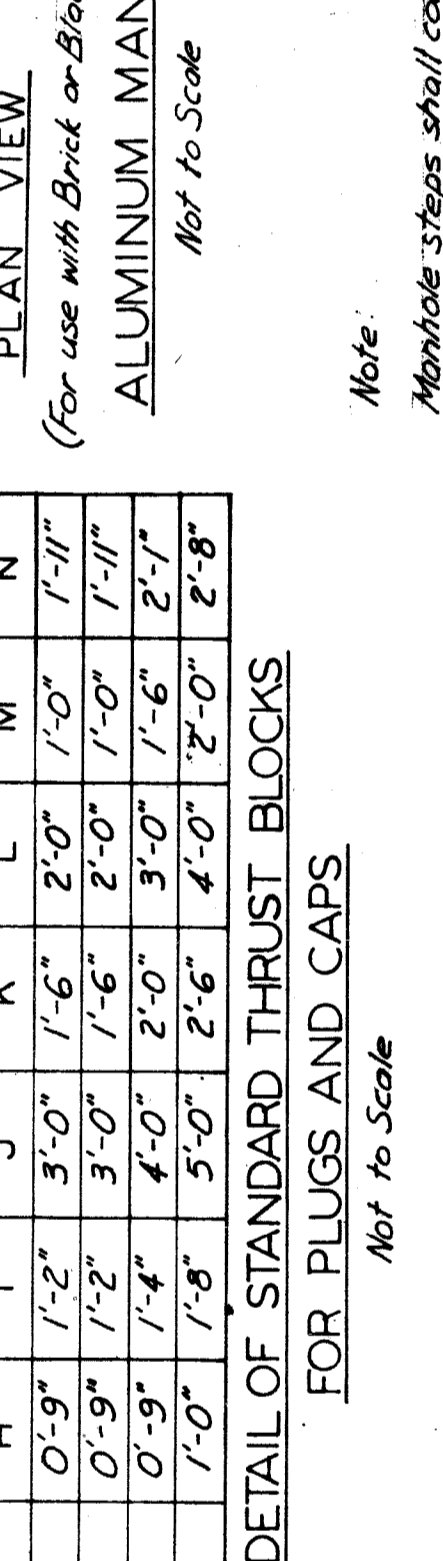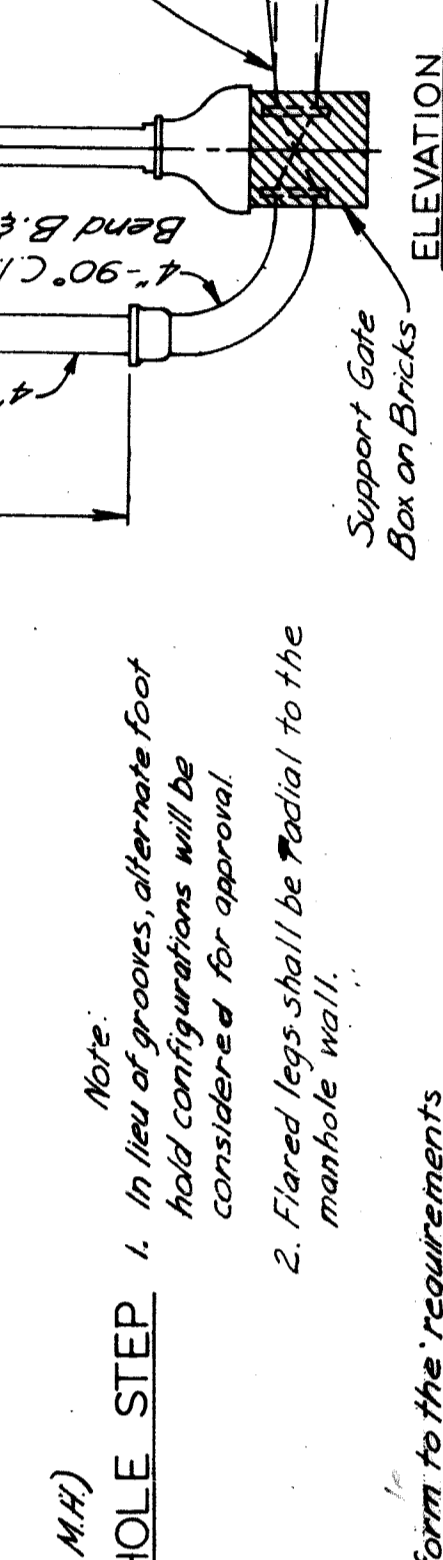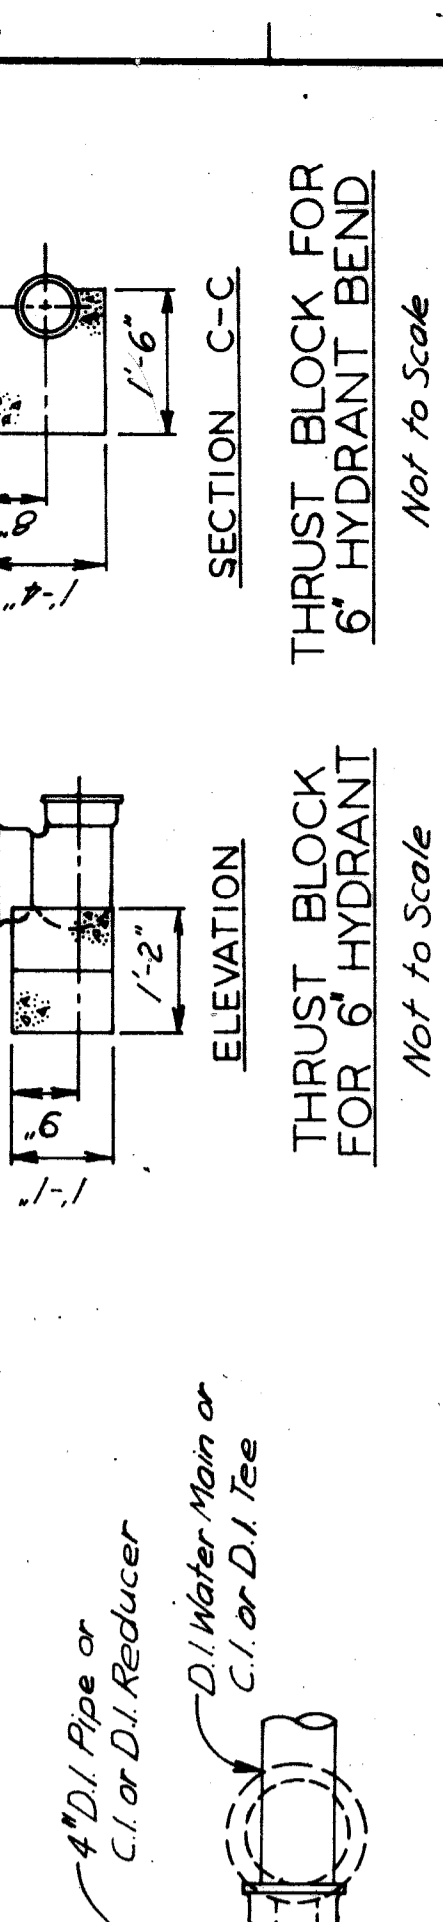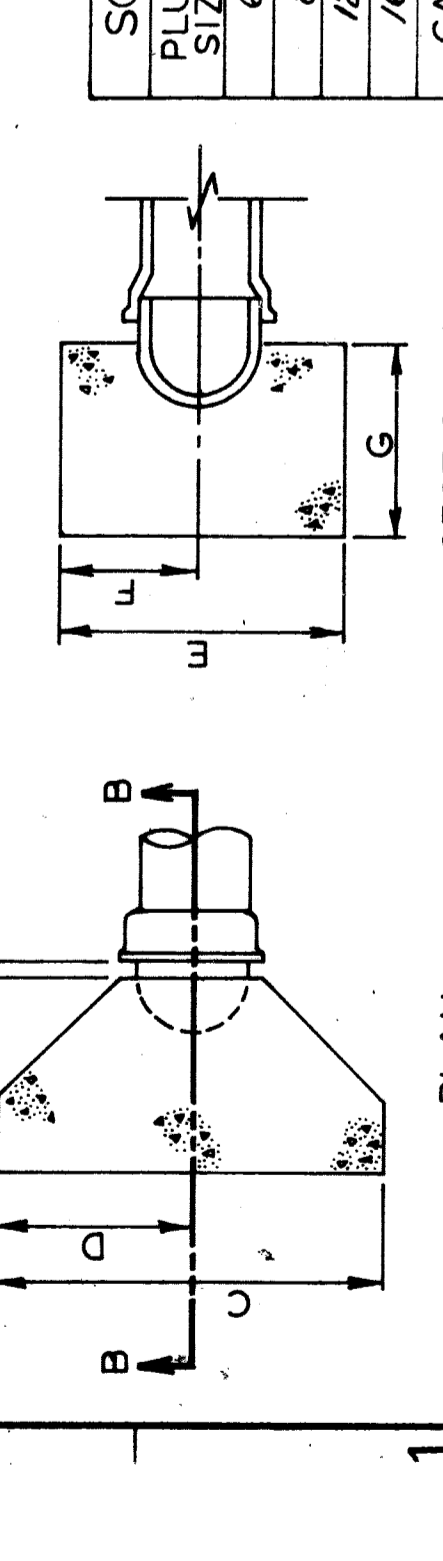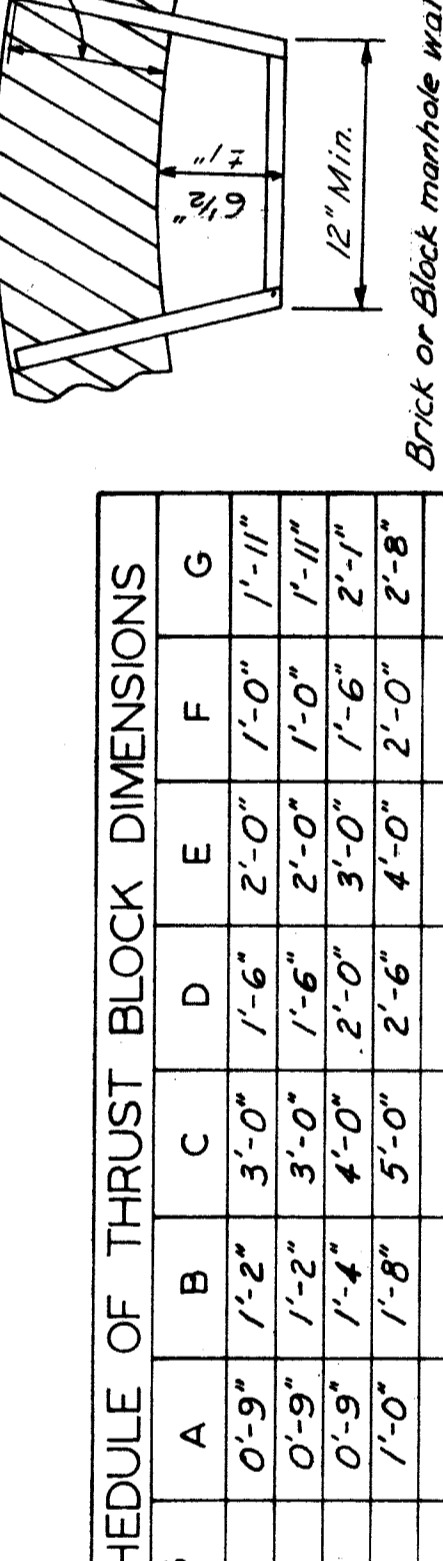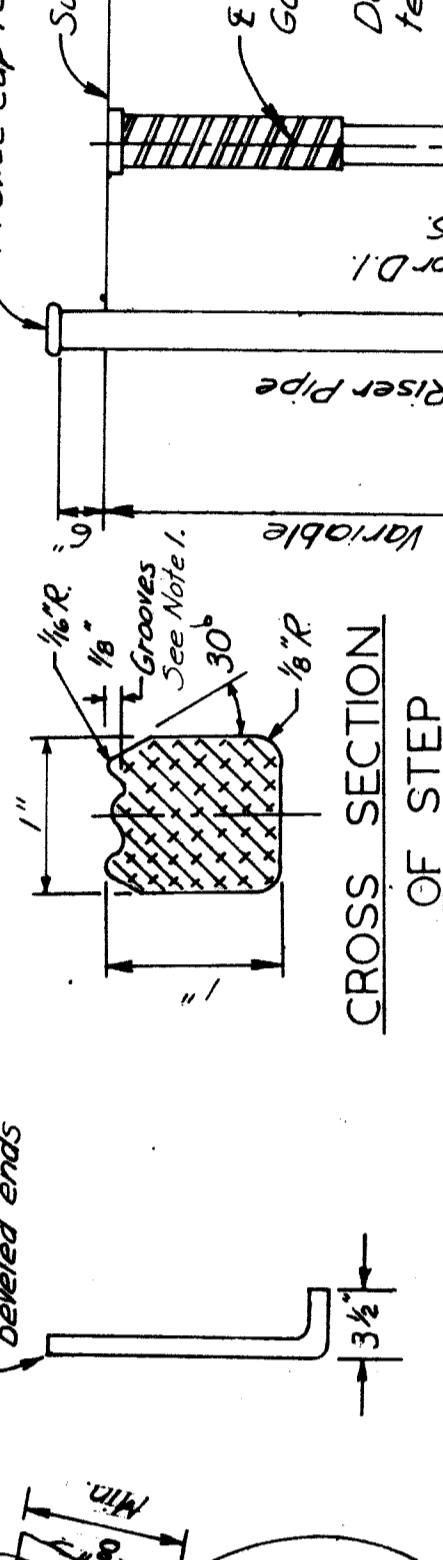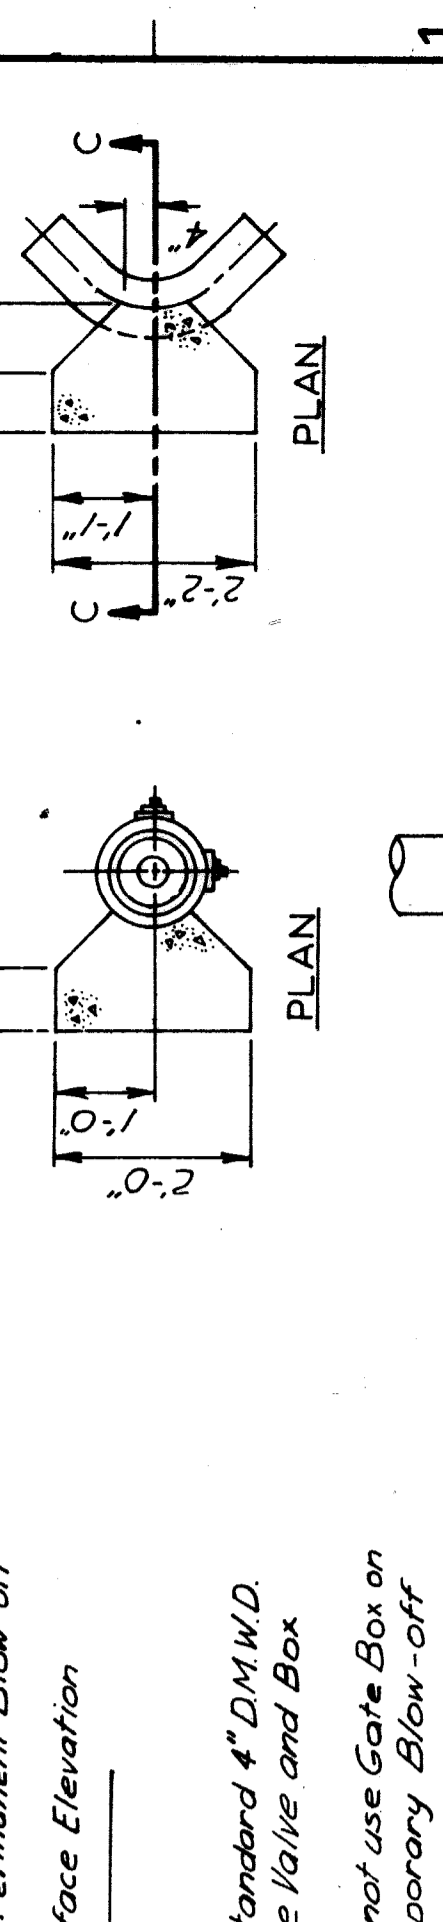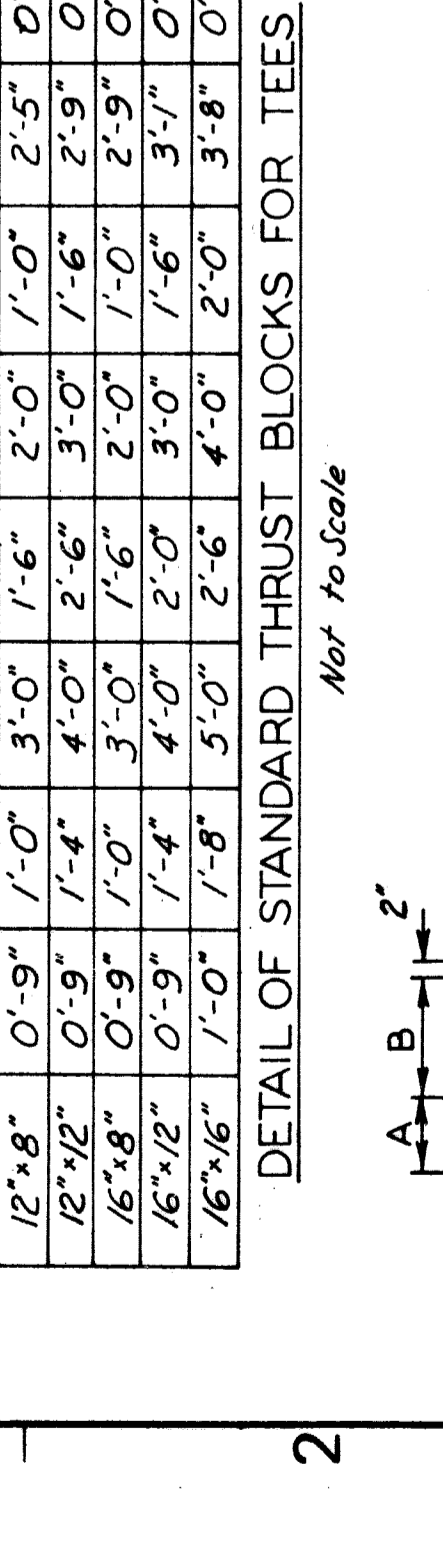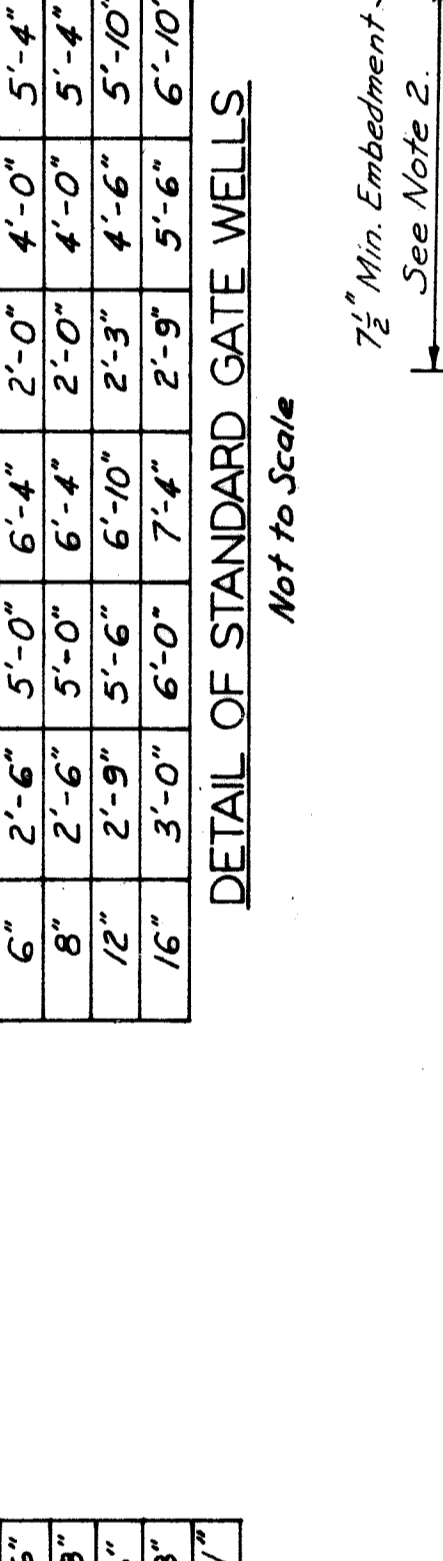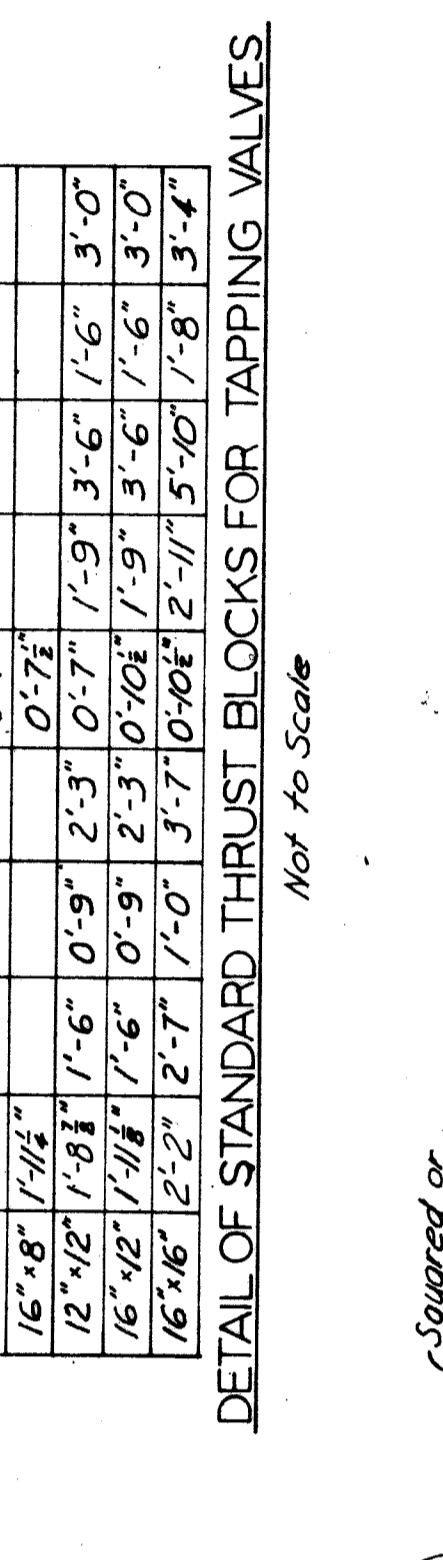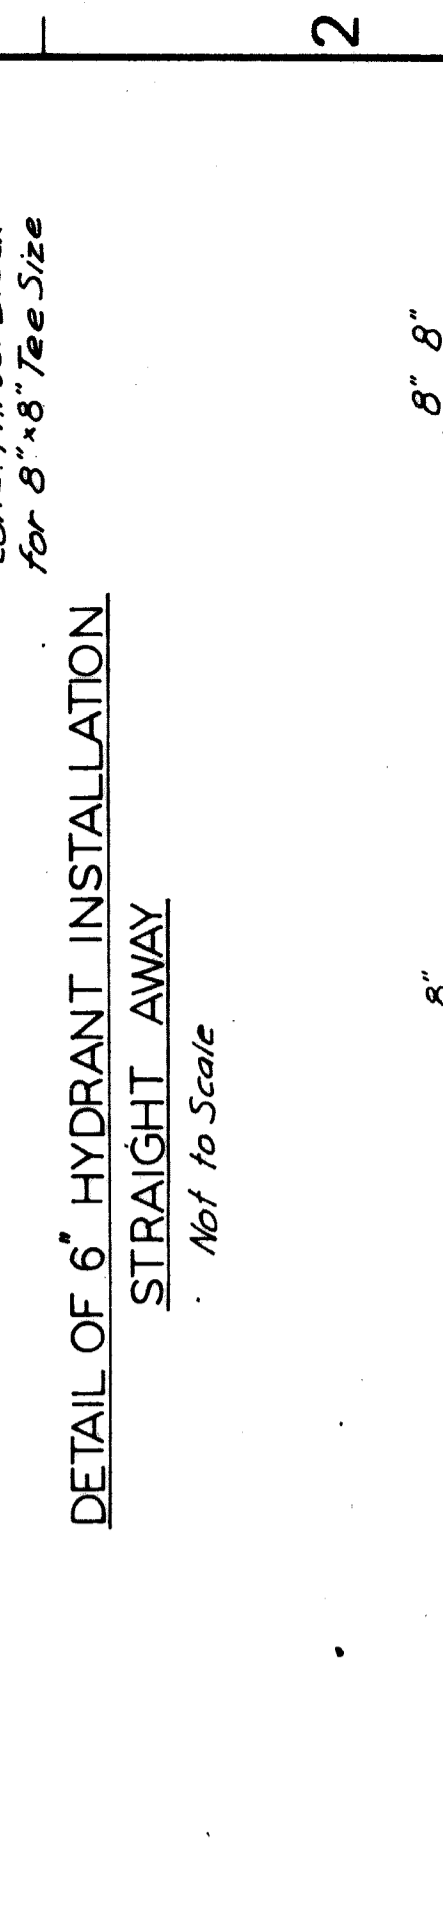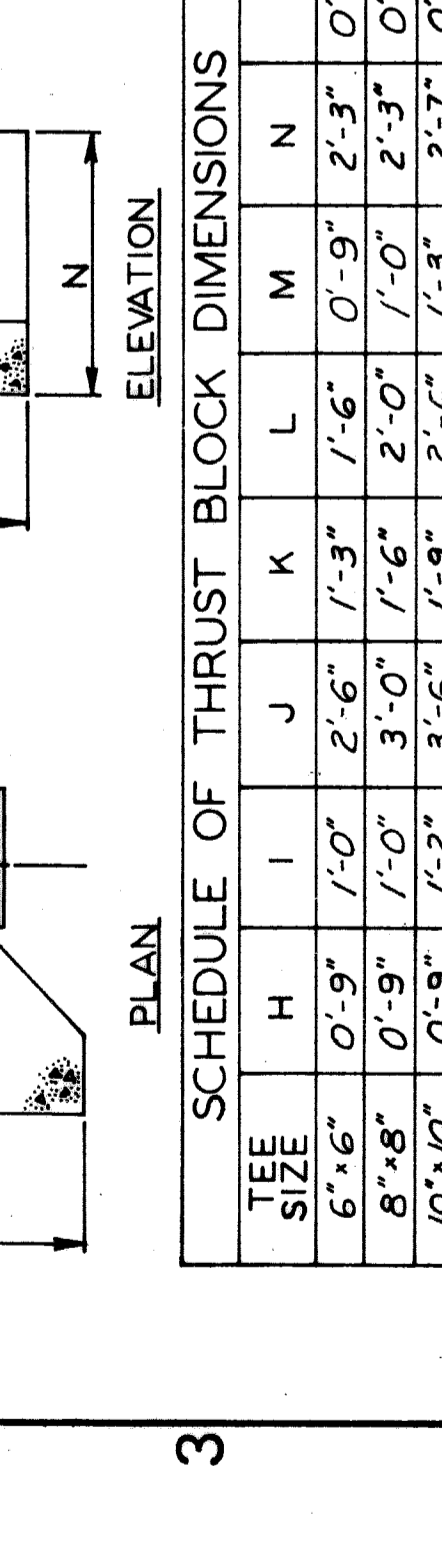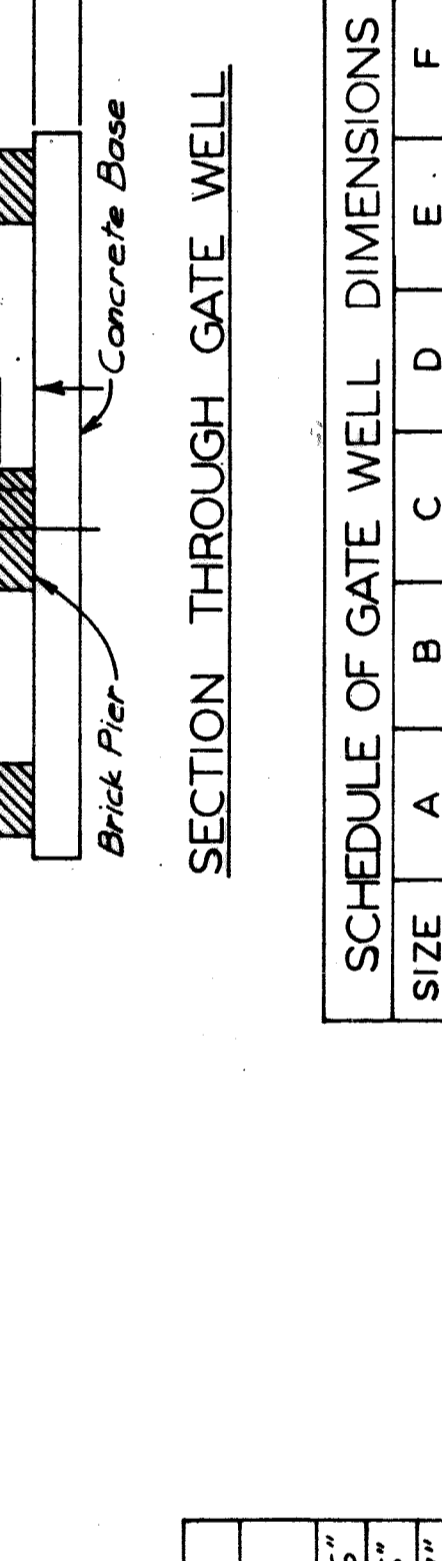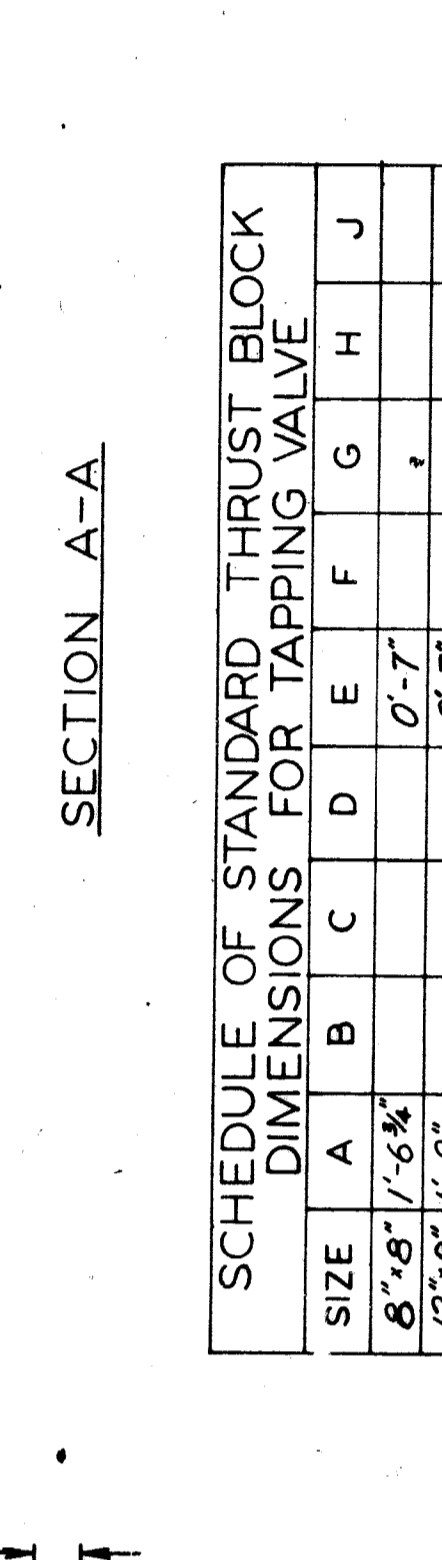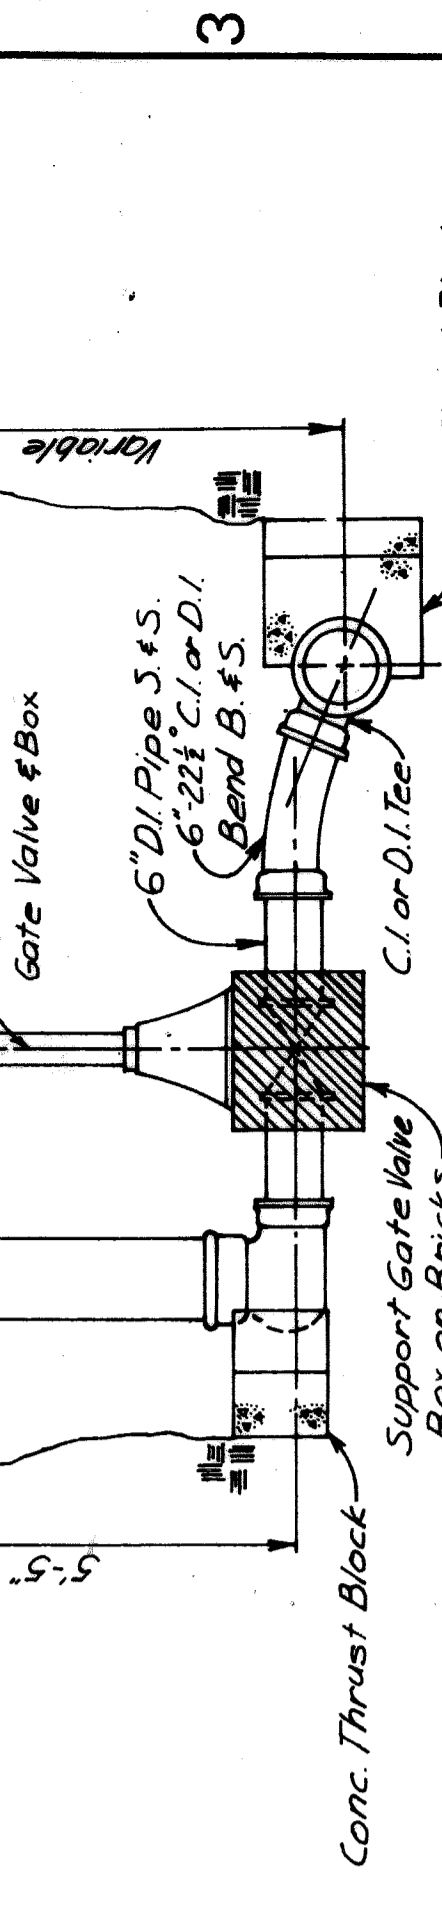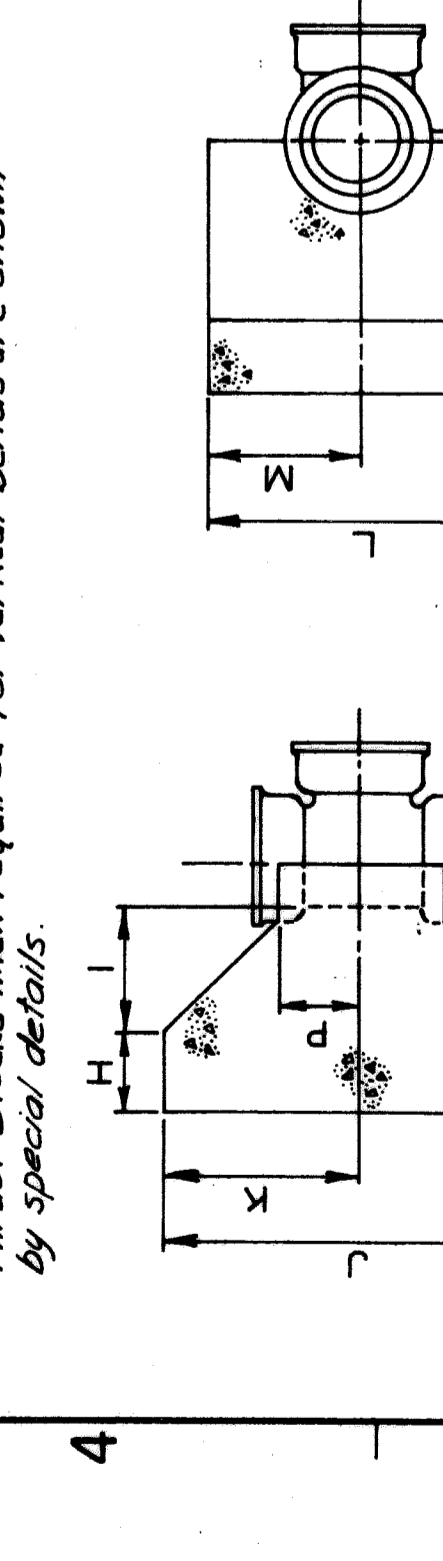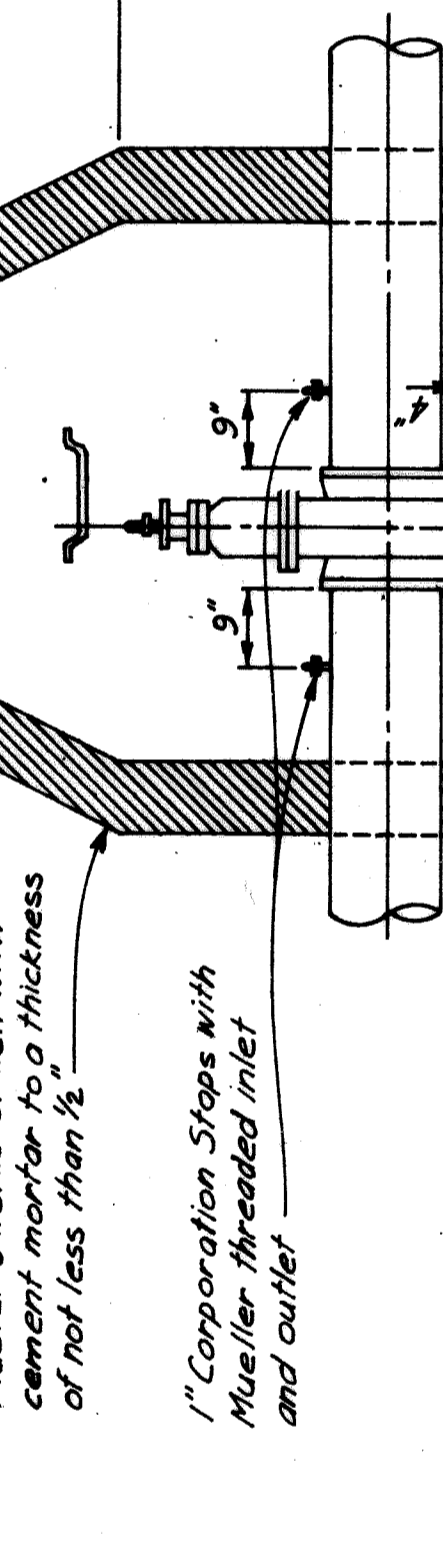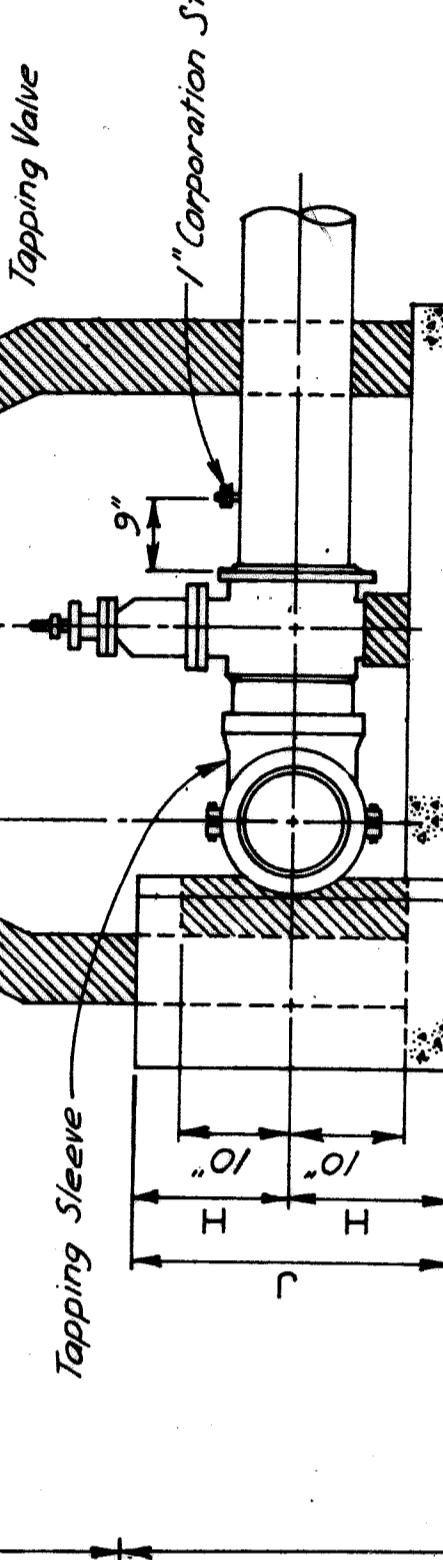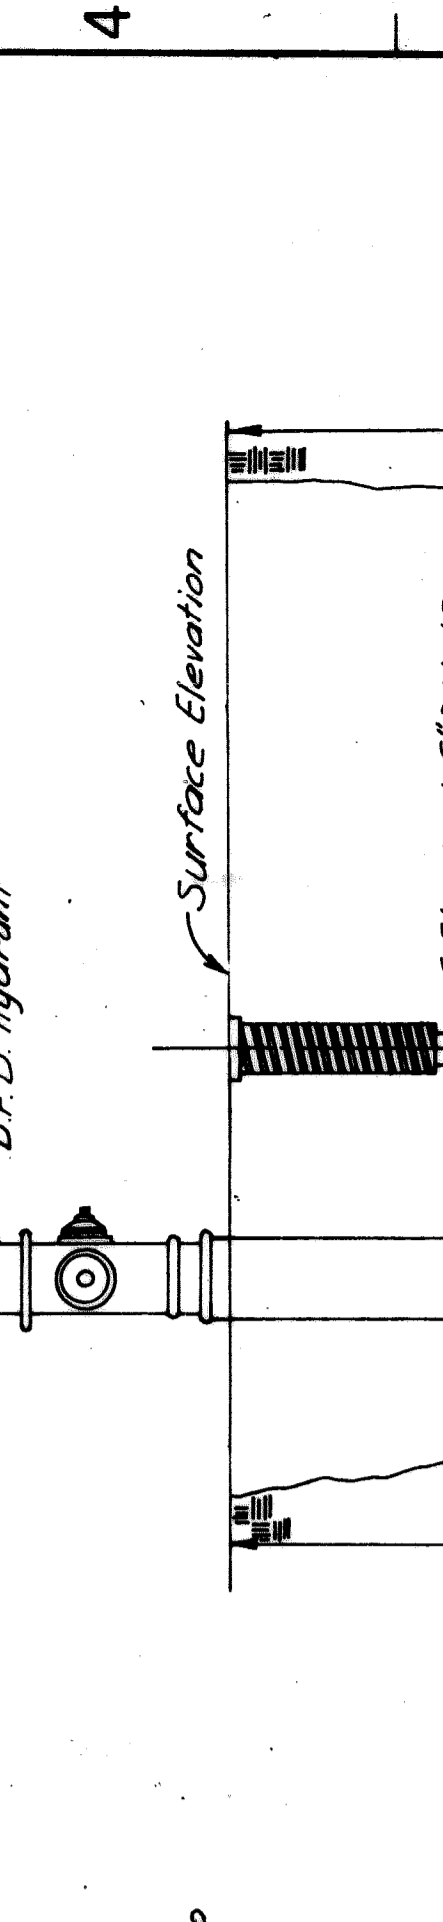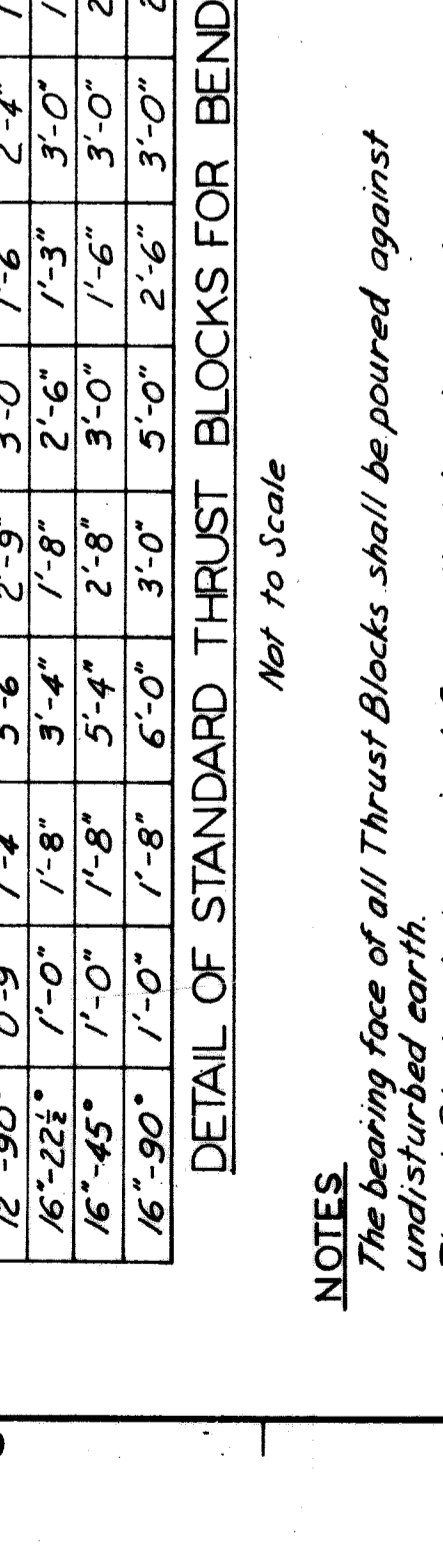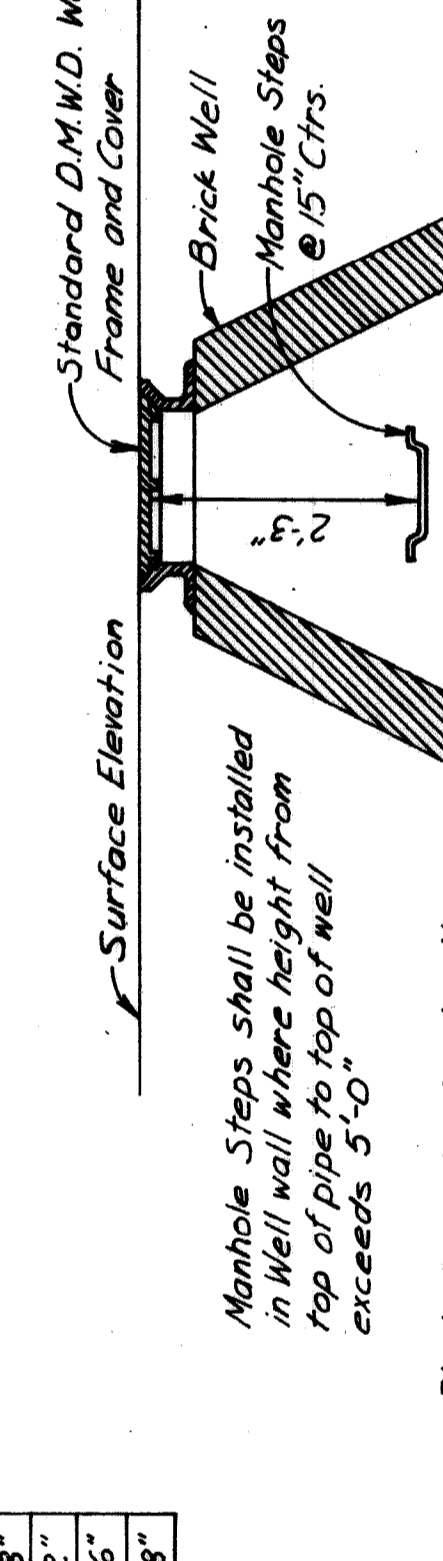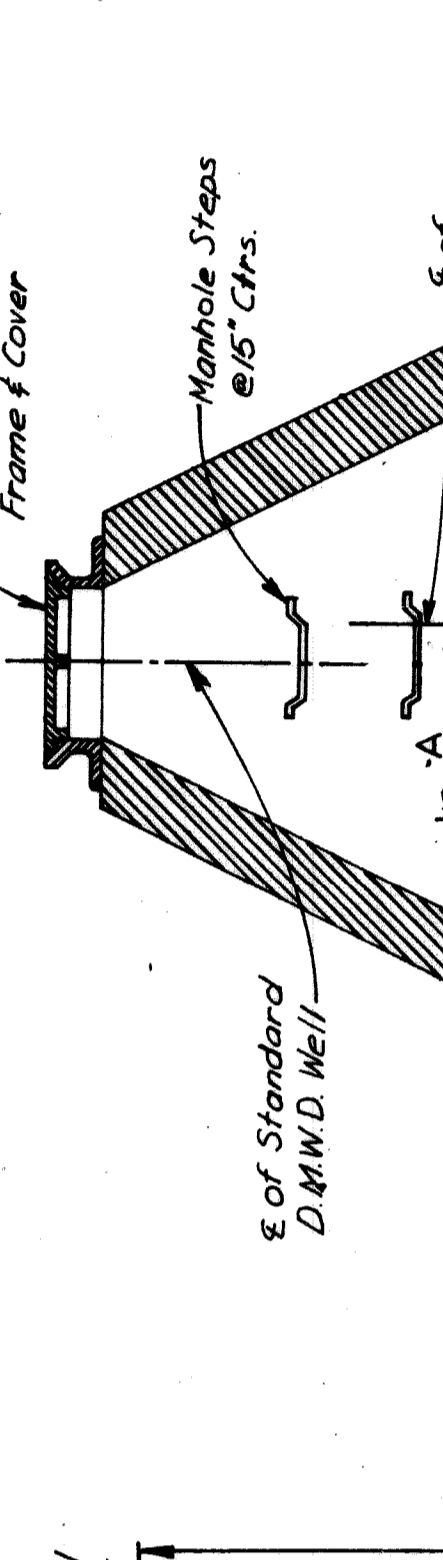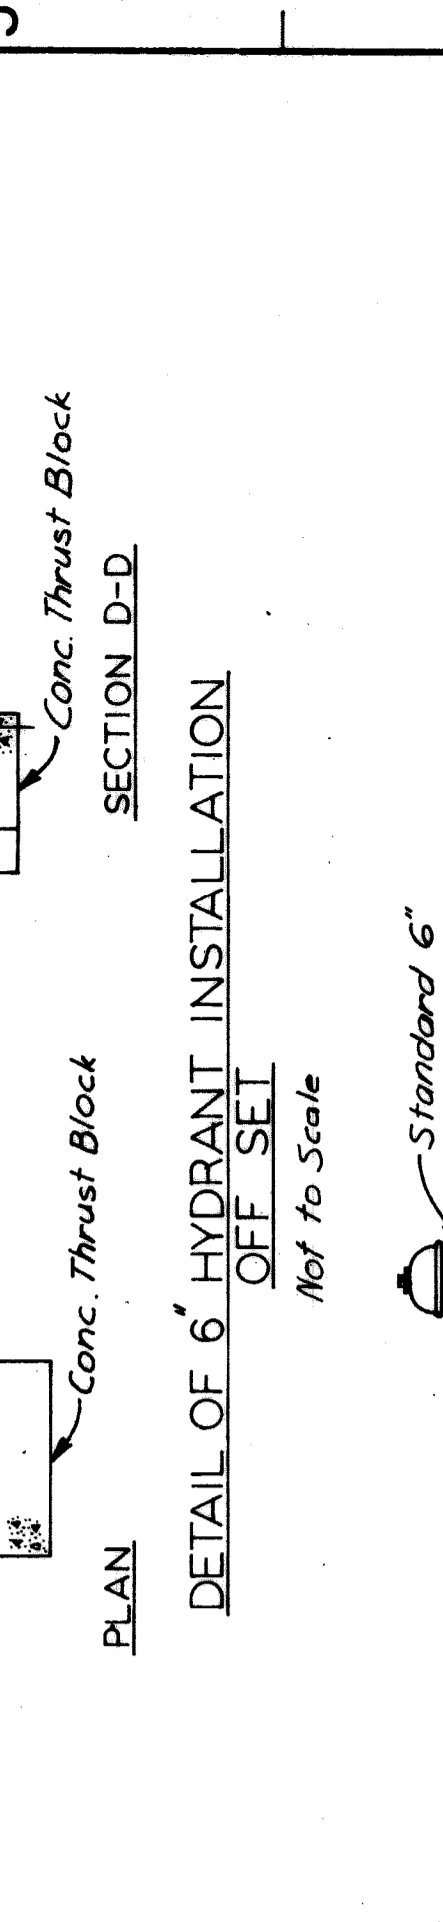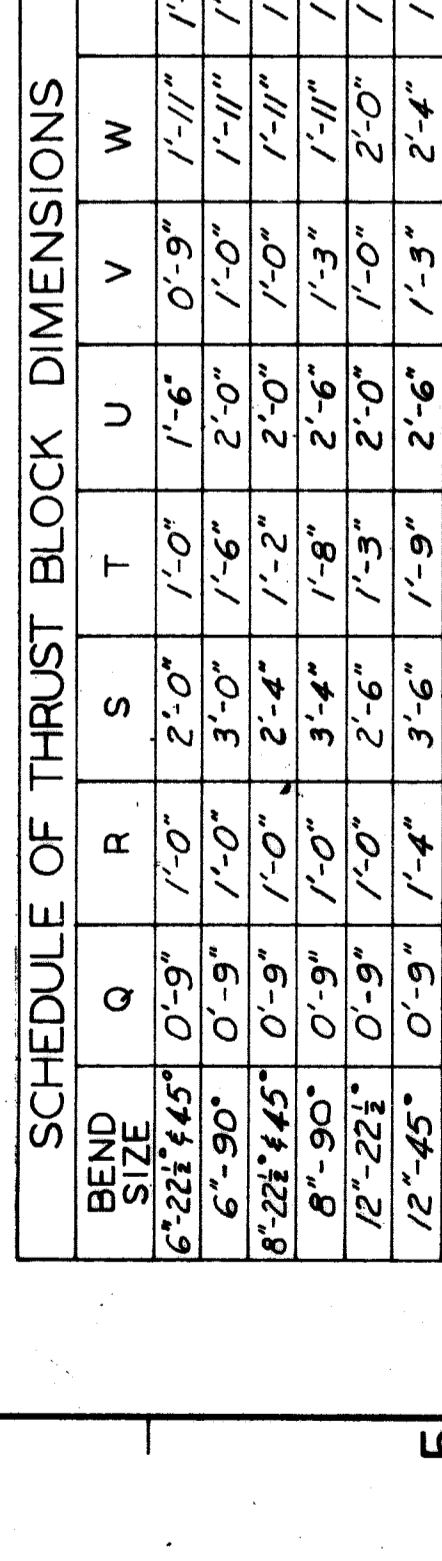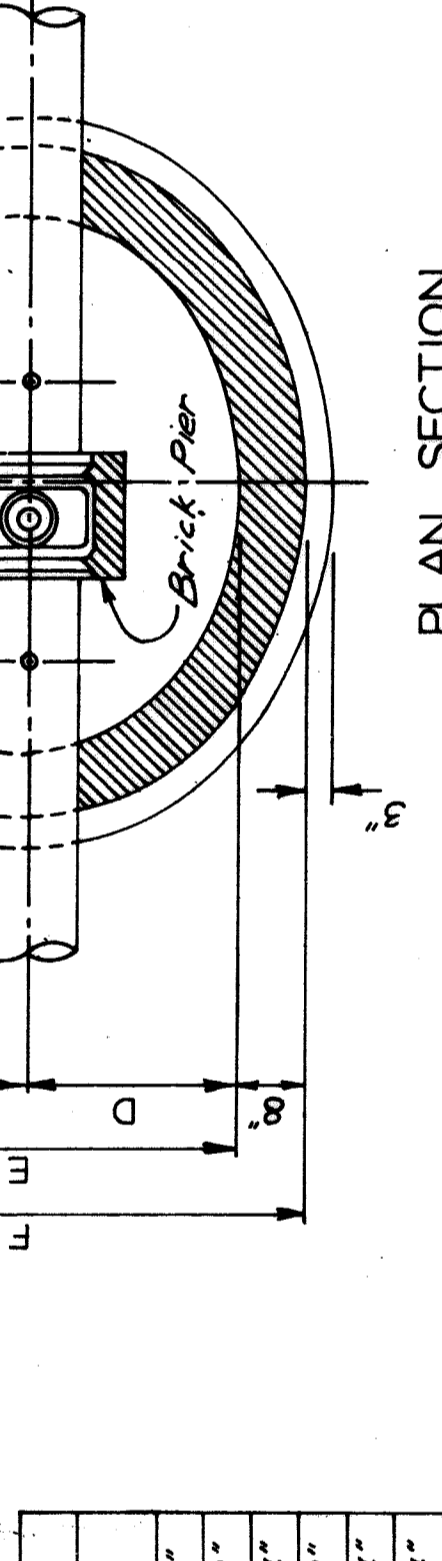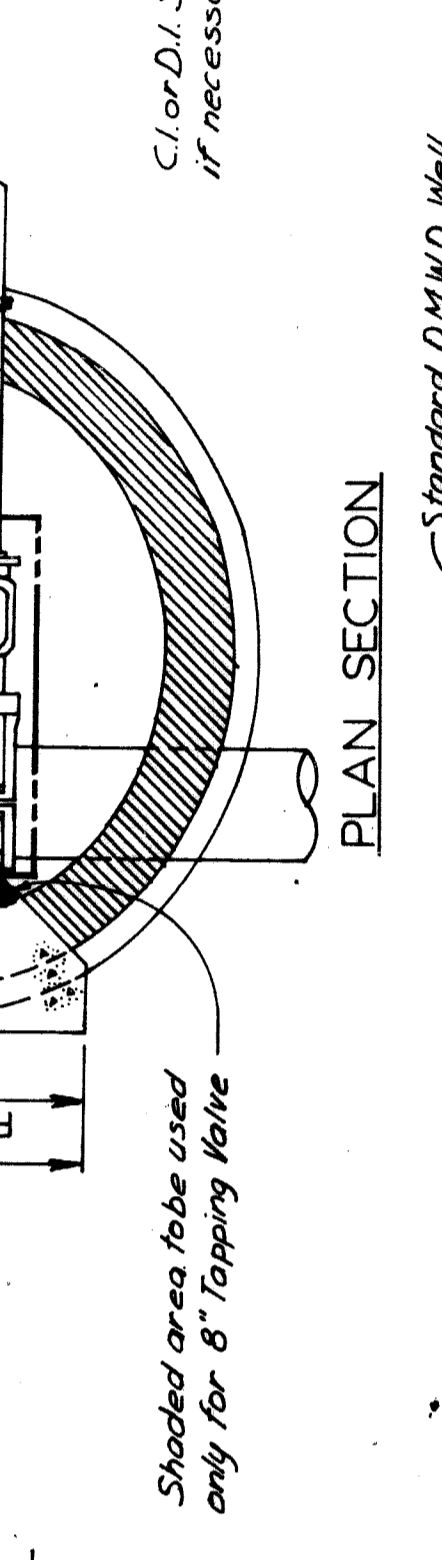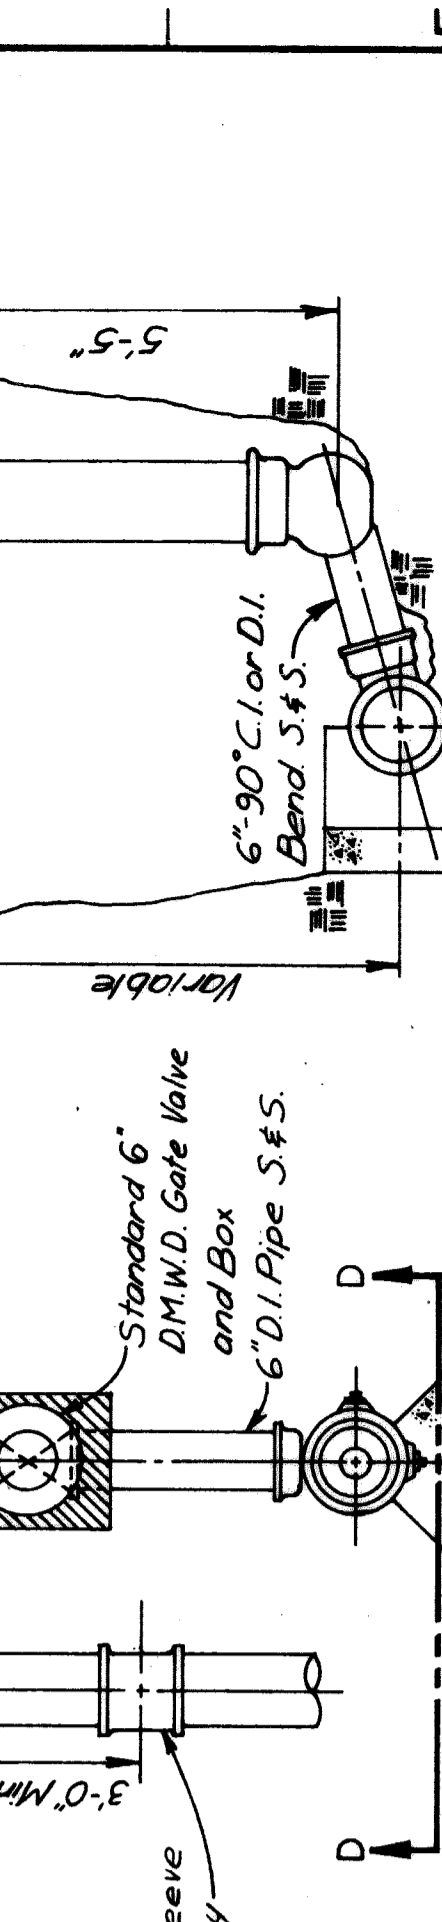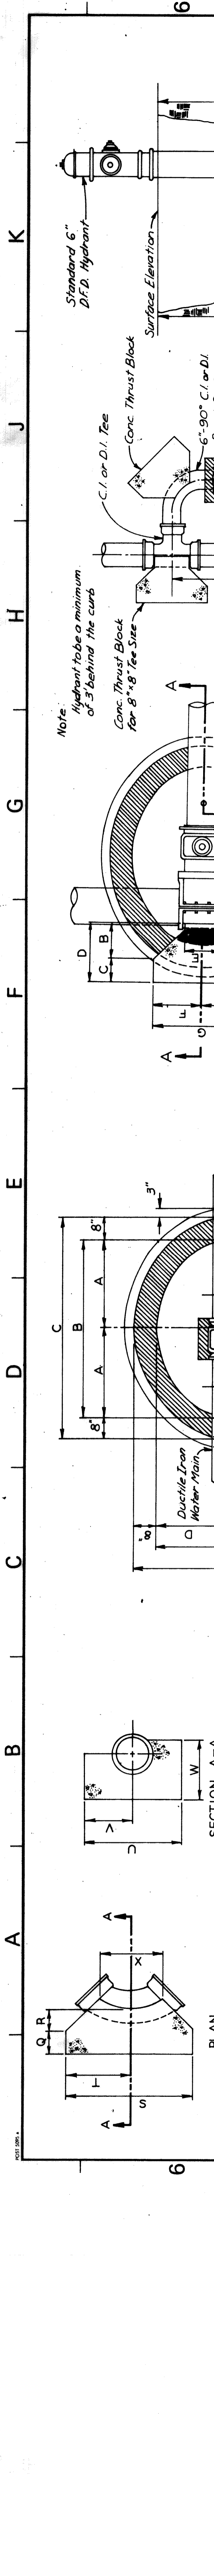

SCHEDULE OF THRUST BLOCK DIMENSIONS

BEND SIZE	Q	R	S	T	U	V	W	X
6"-22 1/2" 45°	0'-9"	1'-0"	2'-0"	1'-0"	1'-6"	0'-9"	1'-11"	1'-4"
6"-90°	0'-9"	1'-0"	3'-0"	1'-6"	2'-0"	1'-0"	1'-11"	1'-2"
8"-22 1/2" 45°	0'-9"	1'-0"	2'-4"	1'-2"	2'-0"	1'-0"	1'-11"	1'-4"
8"-90°	0'-9"	1'-0"	3'-4"	1'-8"	2'-6"	1'-3"	1'-11"	1'-2"
12"-22 1/2" 45°	0'-9"	1'-0"	2'-6"	1'-3"	2'-0"	1'-0"	2'-0"	1'-4"
12"-45°	0'-9"	1'-4"	3'-6"	1'-3"	2'-6"	1'-3"	2'-4"	1'-4"
12"-90°	0'-9"	1'-4"	5'-6"	2'-9"	3'-0"	1'-6"	2'-4"	1'-8"
16"-22 1/2" 45°	1'-0"	1'-8"	3'-4"	1'-8"	2'-6"	1'-6"	3'-0"	2'-6"
16"-45°	1'-0"	1'-8"	5'-4"	2'-8"	3'-0"	1'-6"	3'-0"	2'-6"
16"-90°	1'-0"	1'-8"	6'-0"	3'-0"	3'-0"	2'-6"	3'-0"	2'-8"

SCHEDULE OF THRUST BLOCK DIMENSIONS

TEE SIZE	H	I	J	K	L	M	N	P
6"-6"	0'-9"	1'-0"	2'-6"	1'-3"	1'-6"	0'-9"	2'-3"	0'-6"
8"-8"	0'-9"	1'-0"	3'-0"	1'-6"	2'-0"	1'-0"	2'-3"	0'-6"
10"-10"	0'-9"	1'-2"	3'-6"	1'-9"	2'-6"	1'-3"	2'-7"	0'-7"
12"-12"	0'-9"	1'-0"	3'-0"	1'-6"	2'-0"	1'-0"	2'-5"	0'-6"
16"-16"	0'-9"	1'-4"	4'-0"	2'-6"	3'-0"	1'-6"	2'-9"	0'-8"
16"-12"	0'-9"	1'-0"	3'-0"	1'-6"	2'-0"	1'-0"	2'-9"	0'-8"
16"-16"	0'-9"	1'-4"	4'-0"	2'-0"	3'-0"	1'-6"	3'-1"	0'-8"
16"-16"	1'-0"	1'-8"	5'-0"	2'-6"	4'-0"	2'-0"	3'-8"	0'-11"

SCHEDULE OF GATE WELL DIMENSIONS

SIZE	A	B	C	D	E	F
6"	2'-6"	5'-0"	6'-4"	2'-0"	4'-0"	5'-4"
8"	2'-6"	5'-0"	6'-4"	2'-0"	4'-0"	5'-4"
12"	2'-9"	5'-6"	6'-10"	2'-3"	4'-6"	5'-10"
16"	3'-0"	6'-0"	7'-4"	2'-9"	5'-6"	6'-10"

SCHEDULE OF STANDARD THRUST BLOCKS FOR TAPPING VALVES





SIZE	A	B	C	D	E	F	G	H	J
8"x8"	1'-6 1/2"								
12"x8"	1'-9"								
16"x8"	1'-11 1/2"								
16"x12"	1'-8 1/2"	1'-6"	0'-9"	2'-3"	0'-7"	1'-9"	3'-6"	1'-6"	3'-0"
16"x16"	2'-2"	2'-2"	1'-0"	3'-7"	0'-10 1/2"	1'-9"	3'-6"	1'-6"	3'-0"

SCHEDULE OF THRUST BLOCK DIMENSIONS FOR PLUGS AND CAPS

PLUG SIZE	A	B	C	D	E	F	G
6"	0'-9"	1'-2"	3'-0"	1'-6"	2'-0"	1'-0"	1'-11"
8"	0'-9"	1'-2"	3'-0"	1'-6"	2'-0"	1'-0"	1'-11"
12"	0'-9"	1'-4"	4'-0"	2'-0"	3'-0"	1'-6"	2'-1"
16"	1'-0"	1'-8"	5'-0"	2'-6"	4'-0"	2'-0"	2'-8"

SCHEDULE OF STANDARD THRUST BLOCKS FOR TAPPING VALVES

CAP SIZE	H	I	J	K	L	M	N
6"	0'-9"	1'-2"	3'-0"	1'-6"	2'-0"	1'-0"	1'-11"
8"	0'-9"	1'-2"	3'-0"	1'-6"	2'-0"	1'-0"	1'-11"
12"	0'-9"	1'-4"	4'-0"	2'-0"	3'-0"	1'-6"	2'-1"
16"	1'-0"	1'-8"	5'-0"	2'-6"	4'-0"	2'-0"	2'-8"

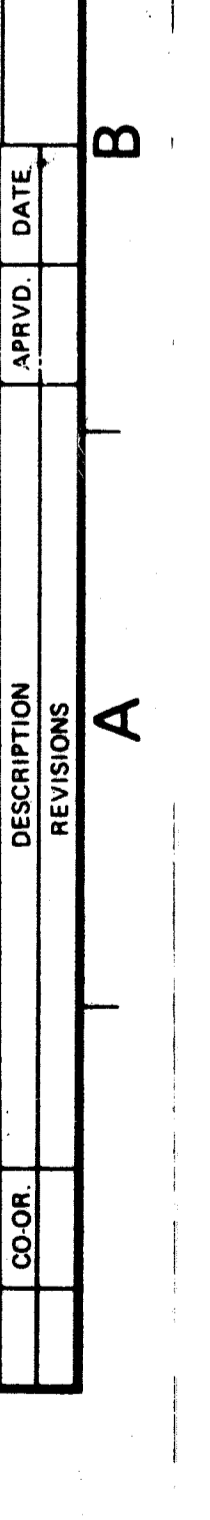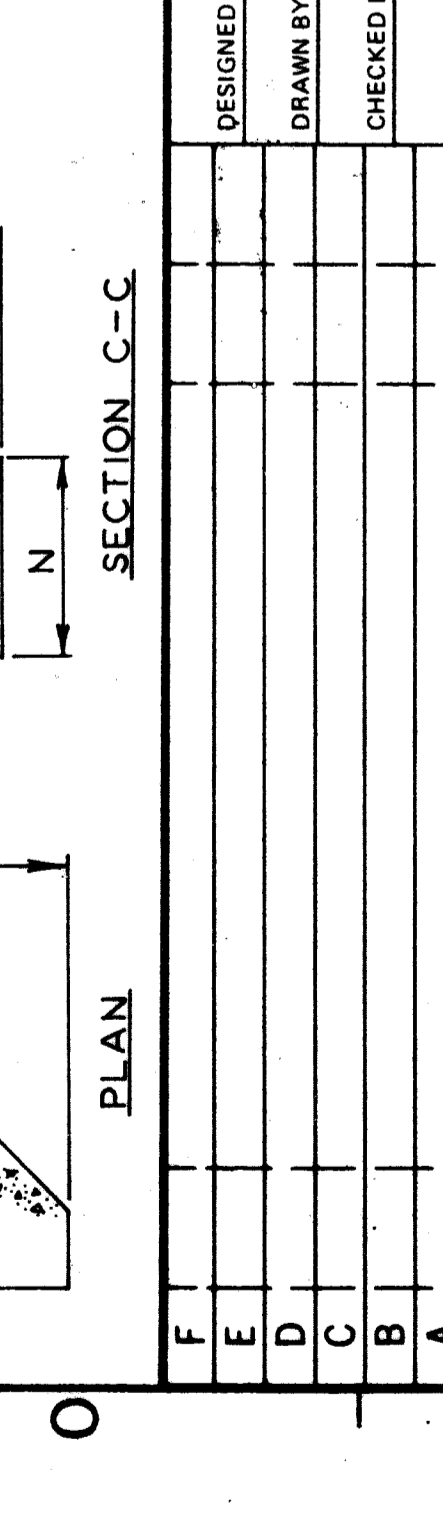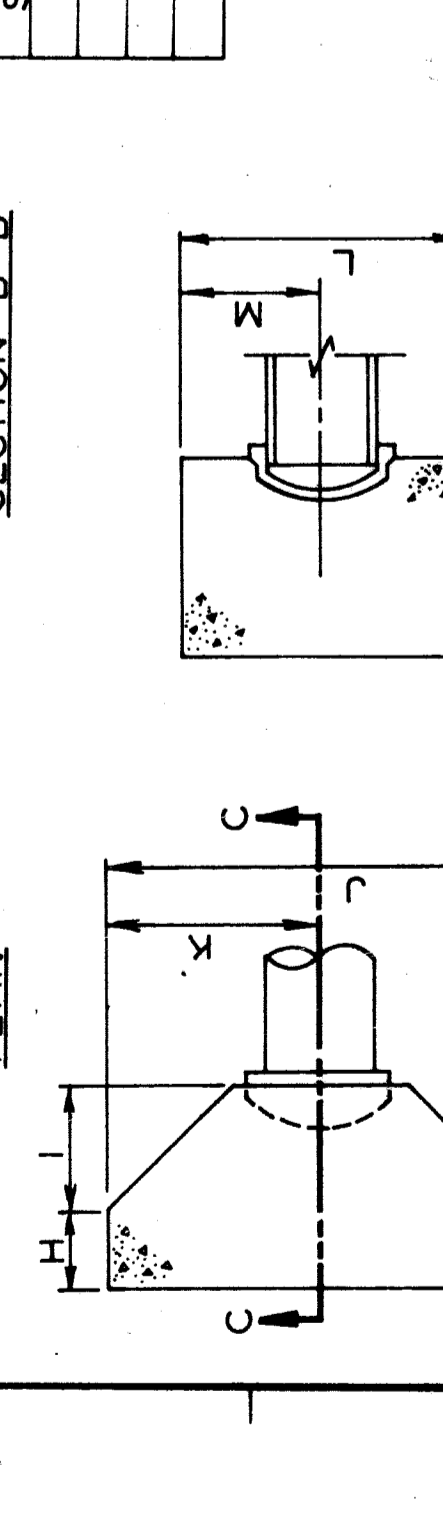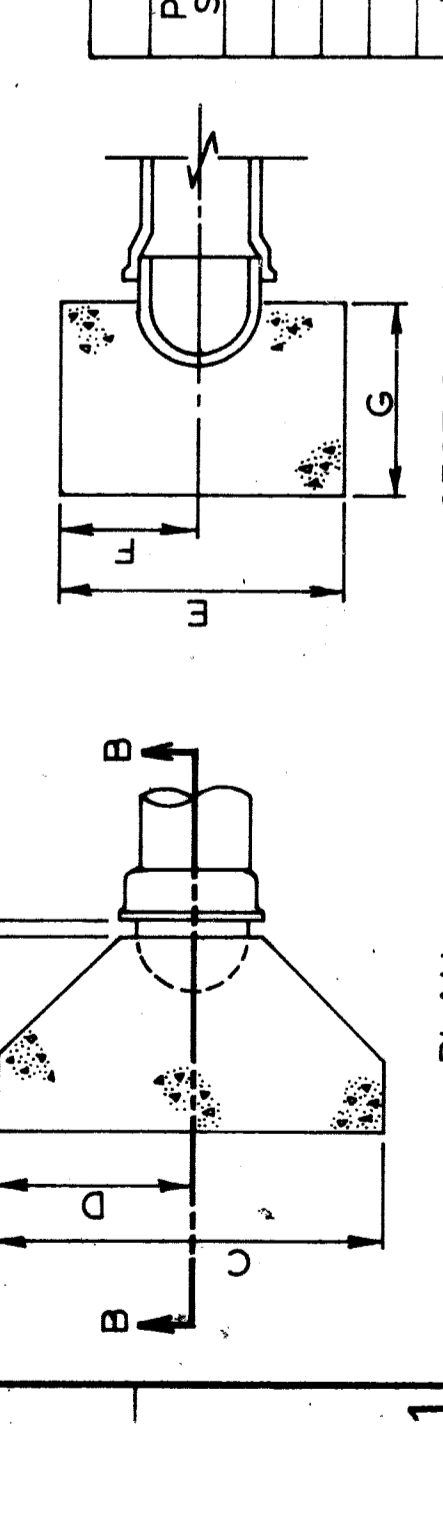

NOTES:
 The bearing face of all Thrust Blocks shall be poured against undisturbed earth.
 Thrust Blocks when required for vertical bends are shown by special details.

Note: Hydrant to be a minimum of 3' behind the curb.
 Conc. Thrust Block for 8"x8" Tee Size.
 C.I. or D.I. Tee.
 6"-90° C.I. or D.I. BEND S & S.
 Standard 6" D.I.M.W.D. Gate Valve and Box.
 6" D.I. Pipe S & S.
 Conc. Thrust Block.

DETAIL OF 6" HYDRANT INSTALLATION OFF SET.
 Not to Scale

DETAIL OF 6" HYDRANT INSTALLATION STRAIGHT AWAY.
 Not to Scale

DETAIL OF 4" BLOW-OFF.
 Not to Scale


DETAIL OF STANDARD THRUST BLOCKS FOR TAPPING VALVES.
 Not to Scale

DETAIL OF STANDARD THRUST BLOCKS FOR TAPPING VALVES.
 Not to Scale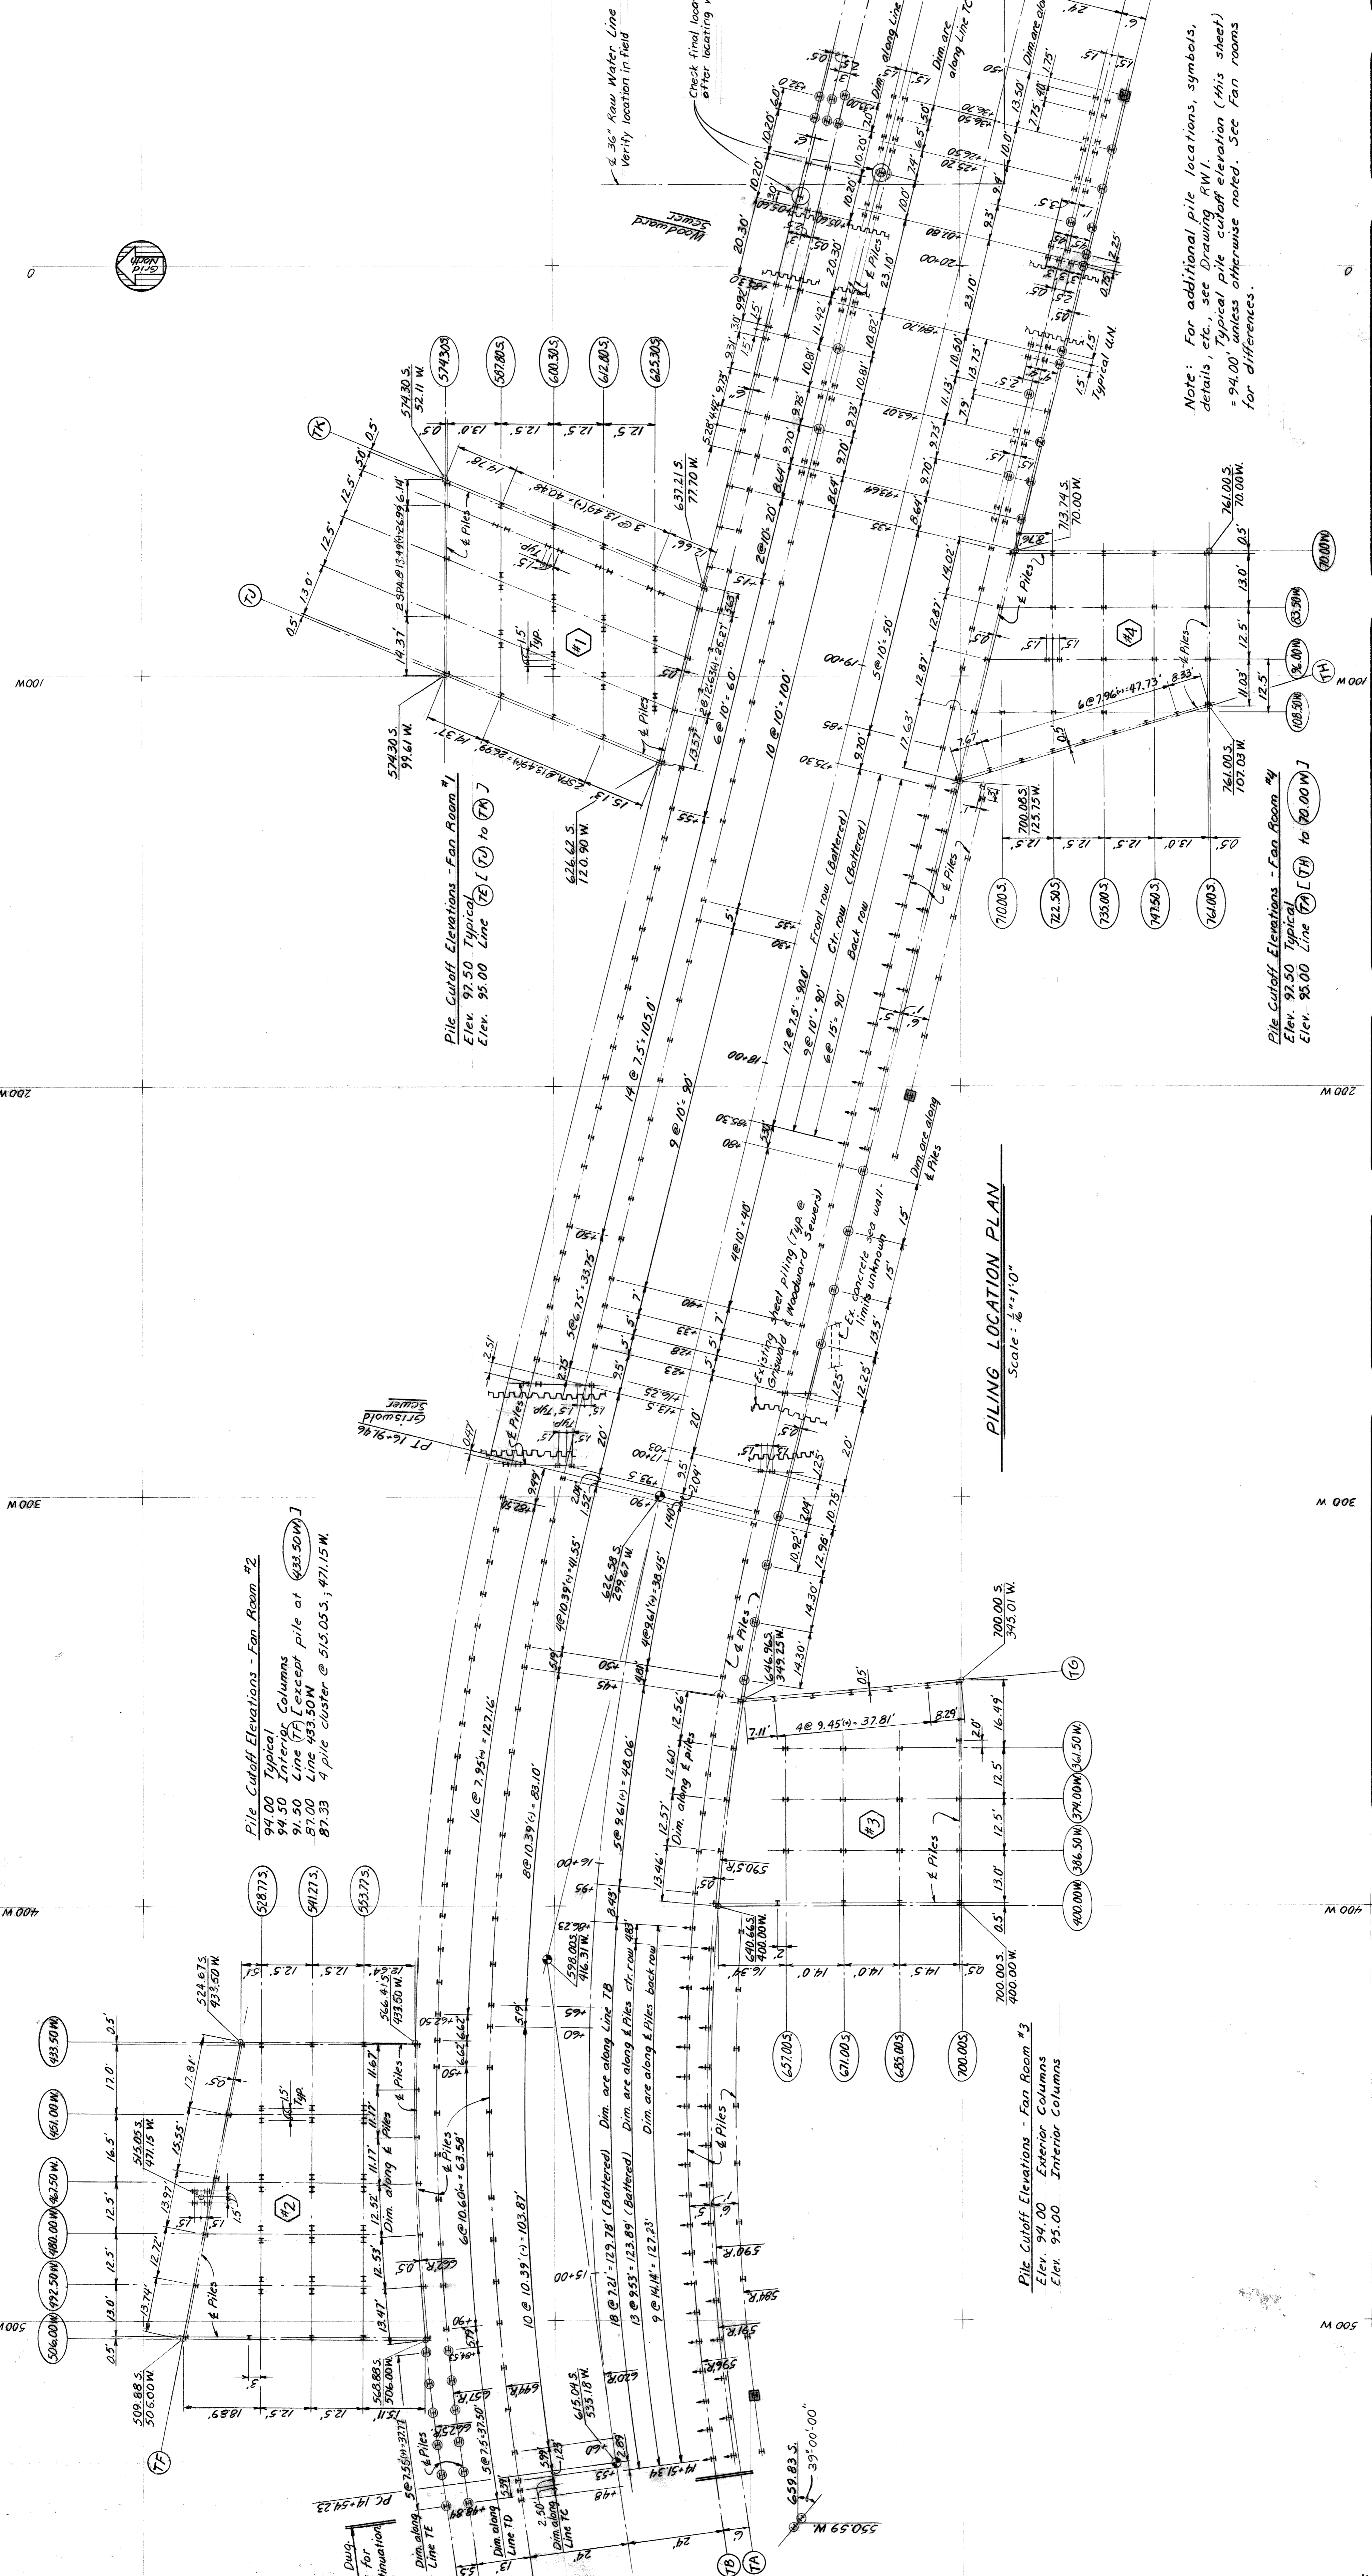

PILING LOCATION PLAN
Scale: 1/4" = 1'-0"

Note: For additional pile locations, symbols, details, etc., see Drawing RW 1. Typical pile cutoff elevation (this sheet) = 94.00' unless otherwise noted. See Fan Rooms for differences.

sheet 2 of 21
drawing no: 07105A
contract no. 07105A
ATWATER STREET RELOCATION
ATWATER TUNNEL
PILE LOCATION PLAN


CITY OF DETROIT
CITY ENGINEERING DEPARTMENT

approved
T. E. Guire
STRUCTURAL ENGINEER

date 8-11-75
designed M. Guire
drawn M. Guire
checked M. C.

NO.	DATE	DESCRIPTION

revisions

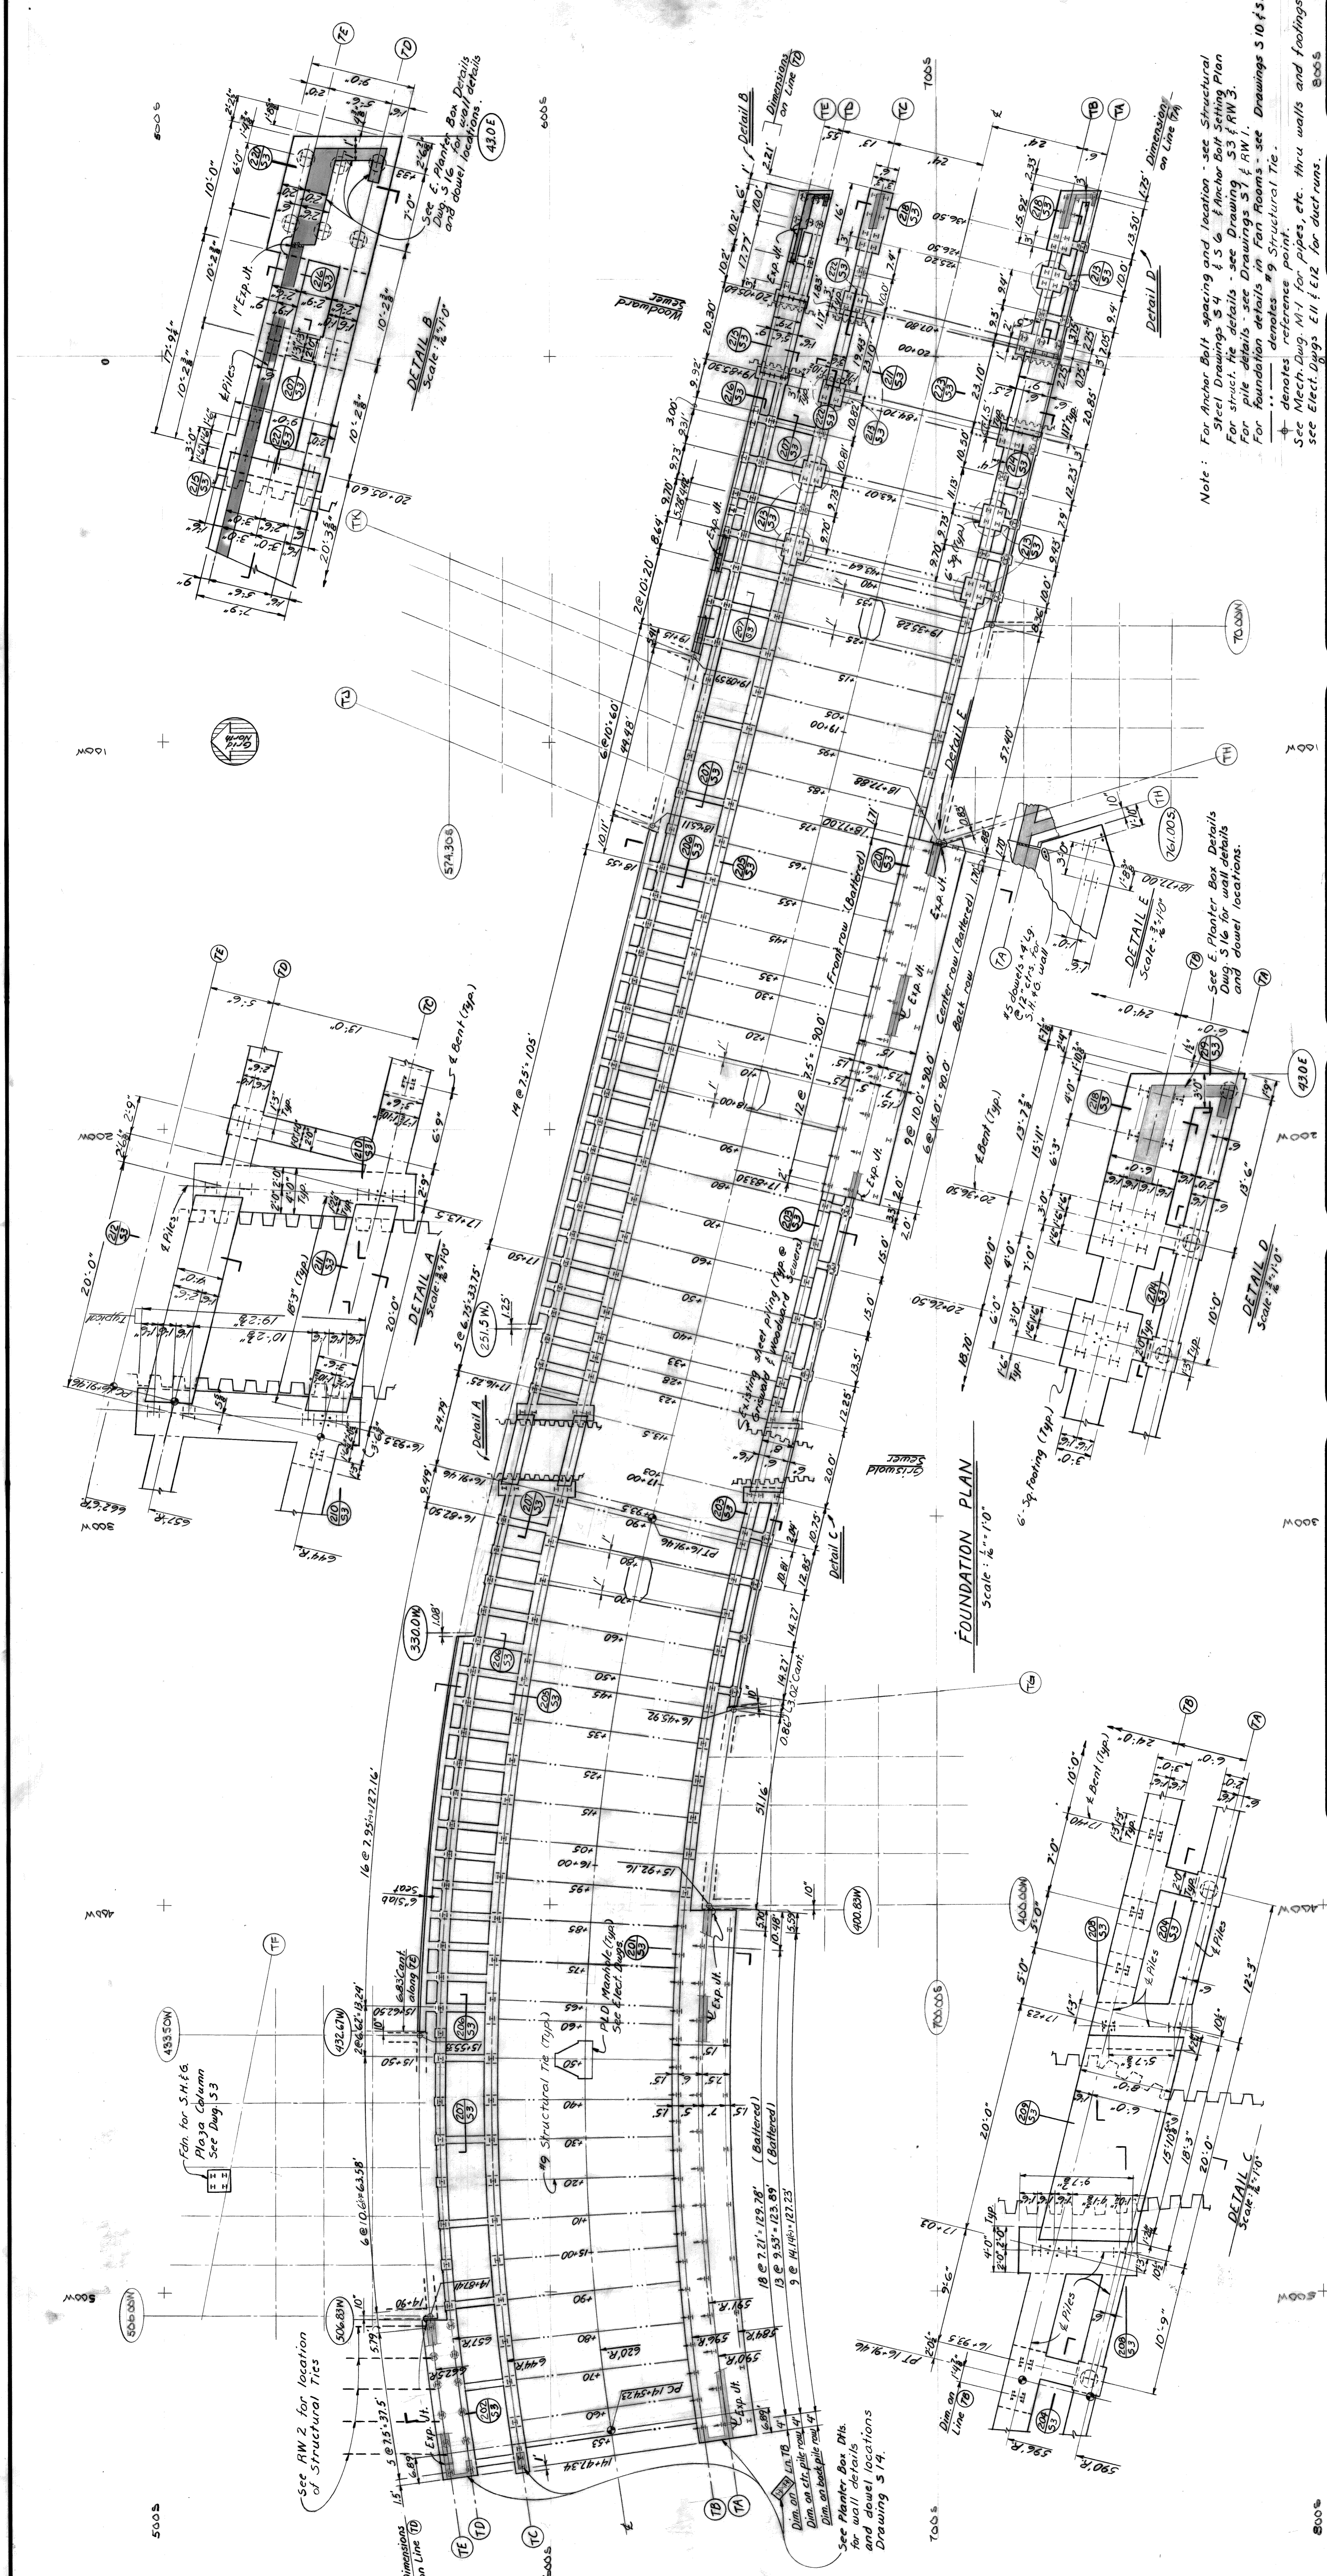

5000
5005
5010
6000
6005
6010
7000
7005
7010
8000
8005
8010
9000
9005
9010
1000
1005
1010
contract no. 07105A
sheet 20 of 21
drawing no. S2

ATWATER STREET RELOCATION
ATWATER TUNNEL
TUNNEL FOUNDATION PLAN

CITY OF DETROIT
CITY ENGINEERING DEPARTMENT

approved T. E. O'Connell
DESIGNED J. McGuire
DRAWN J. McGuire
checked M. C.



date 8-11-75

revisions

COLUMN LOADS FROM PYRAMID STRUCTURE





POINT NO.	LOAD	LOCATION		SUPPORT POINT NO.	LOAD	LOCATION		SUPPORT BEAM
		STATION	OFFSET *			STATION	OFFSET *	
535	42K	19+40.79	9.86 L(N2L)	B7	42K	19+78.99	19.22 L(N2L)	B4
537	42K	19+43.68	1.80 R(S2L)	F3	570	19+80.39	27.11 R(S2L)	B4
519	42K	19+46.50	13.45 R(S2L)	B4	531	19+81.85	7.56 L(N2L)	B4
513	42K	19+48.72	22.52 R(S2L)	B4	523	19+84.70	4.09 R(S2L)	F3
536	42K	19+50.50	12.24 L(N2L)	B2	517	19+86.92	13.16 R(S2L)	B4
528	42K	19+53.35	0.58 L(N2L)	B4	540	19+88.58	21.52 L(N2L)	B4
530	42K	19+56.21	11.07 R(S2L)	B2	571	19+89.78	24.81 R(S2L)	B4
514	42K	19+58.43	20.14 R(S2L)	B4	532	19+91.23	9.86 L(N2L)	B2
537	42K	19+60.21	14.62 L(N2L)	B4	524	19+94.09	1.79 R(S2L)	B4
539	42K	19+63.07	2.96 L(N2L)	F3	518	19+96.31	10.86 R(S2L)	B2
511	52K	19+65.92	8.69 K(S2L)	B4	541	19+98.09	23.90 L(N2L)	B4
515	52K	19+68.74	17.76 R(S2L)	B4	512	19+99.17	22.51 R(S2L)	B4
538	42K	19+69.60	16.92 L(N2L)	B2	533	20+00.95	12.24 L(N2L)	B4
509	42K	19+71.00	29.41 R(S2L)	B4	525	20+03.80	0.59 L(N2L)	B4
530	42K	19+72.96	5.26 L(N2L)	B4	542	20+07.80	28.28 L(N2L)	F4
522	52K	19+75.31	6.39 R(S2L)	B4	534	20+10.66	14.62 L(N2L)	B4
516	52K	19+77.53	15.46 R(S2L)	B2	526	20+13.52	2.97 L(N2L)	B2

* OFFSET MEASURED PERPENDICULAR TO & ATWATER TUNNEL

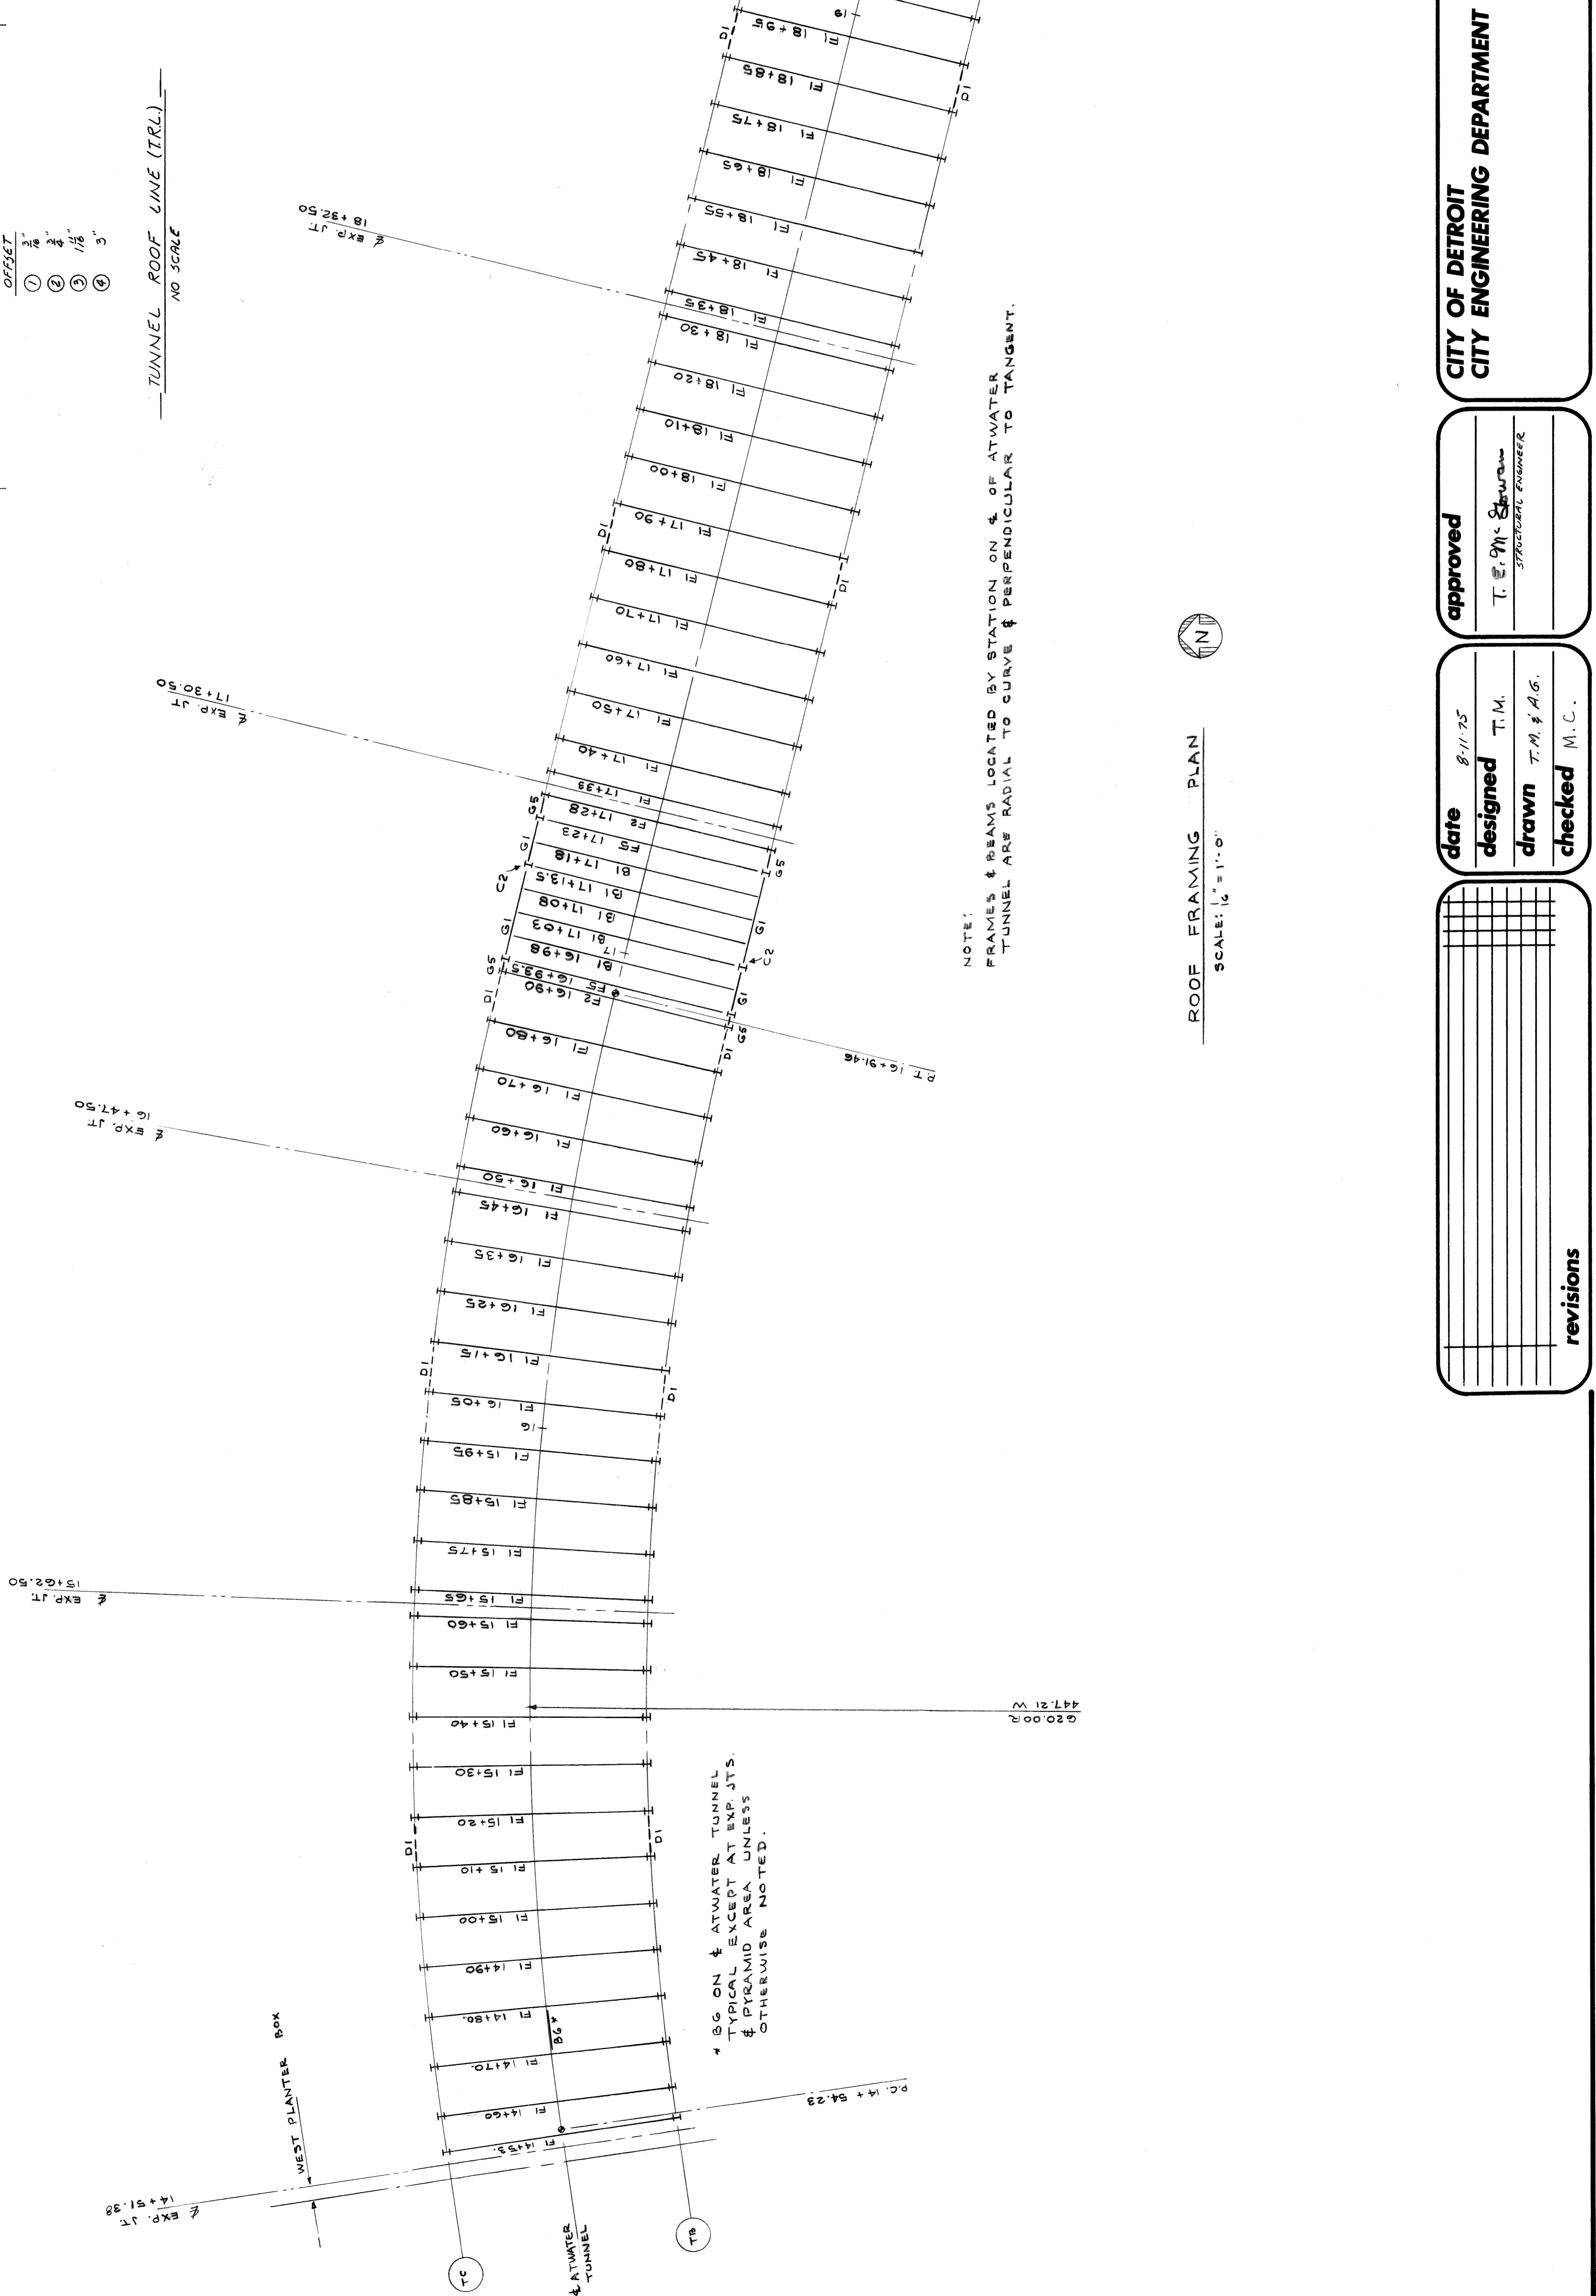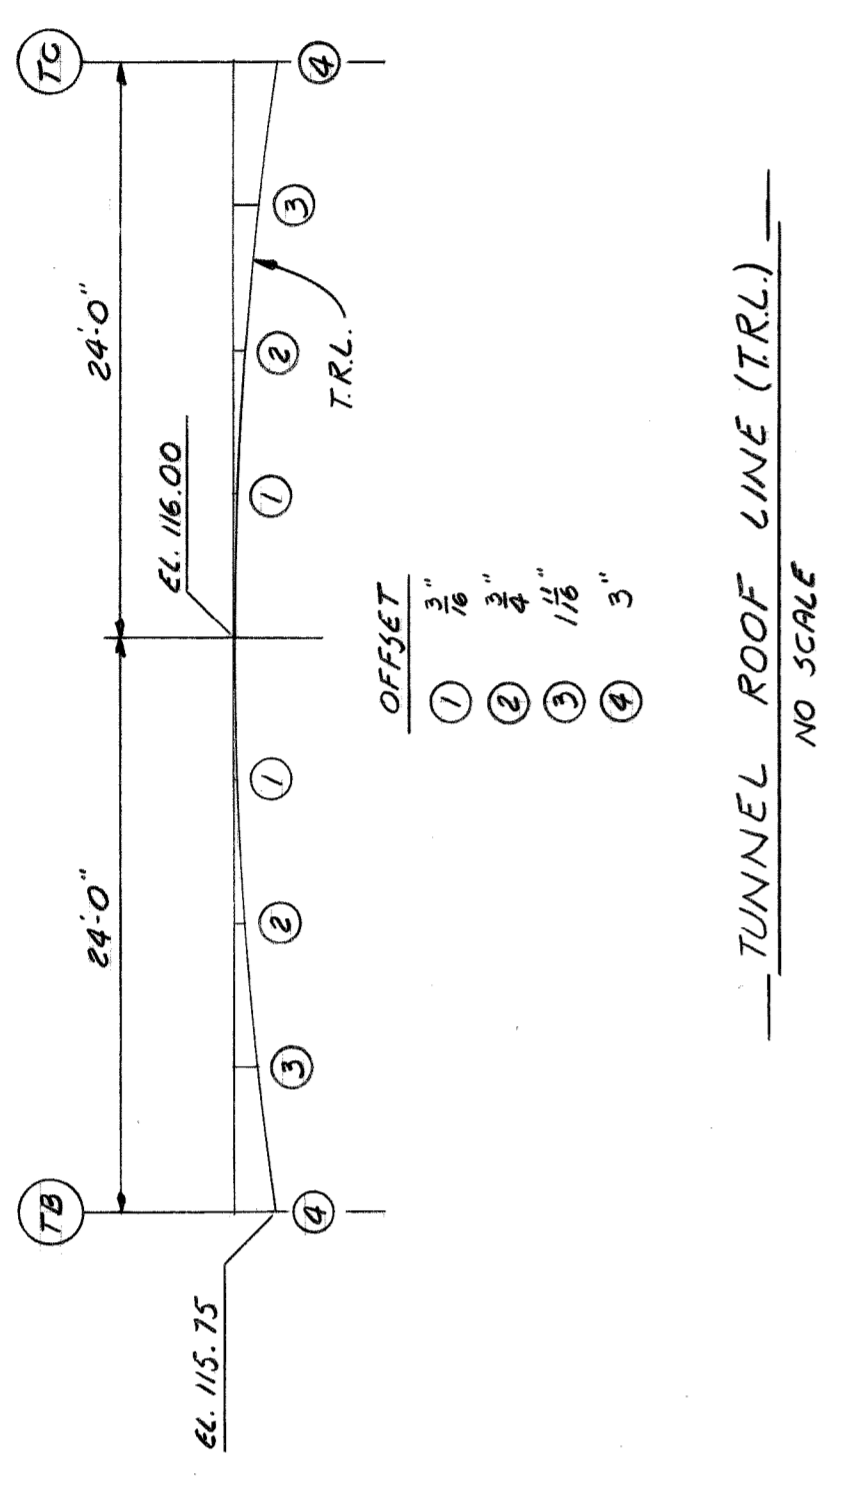

* 26 ON C.L. OF ATWATER TUNNEL
TYPICAL EXCEPT AT EXP. JTS.
& PYRAMID AREA UNLESS
OTHERWISE NOTED.

revisions <table border="1"> <tr><td> </td><td> </td><td> </td><td> </td><td> </td><td> </td></tr> <tr><td> </td><td> </td><td> </td><td> </td><td> </td><td> </td></tr> <tr><td> </td><td> </td><td> </td><td> </td><td> </td><td> </td></tr> <tr><td> </td><td> </td><td> </td><td> </td><td> </td><td> </td></tr> <tr><td> </td><td> </td><td> </td><td> </td><td> </td><td> </td></tr> </table>																															date 8-11-75 designed T.M. drawn T.M. & A.G. checked M.C.	approved T. M. Spurney STRUCTURAL ENGINEER	CITY OF DETROIT CITY ENGINEERING DEPARTMENT	ATWATER STREET RELOCATION ATWATER TUNNEL STEEL FRAMING PLAN	contract no. 07105A	sheet 22 of 21 drawing no: S 4

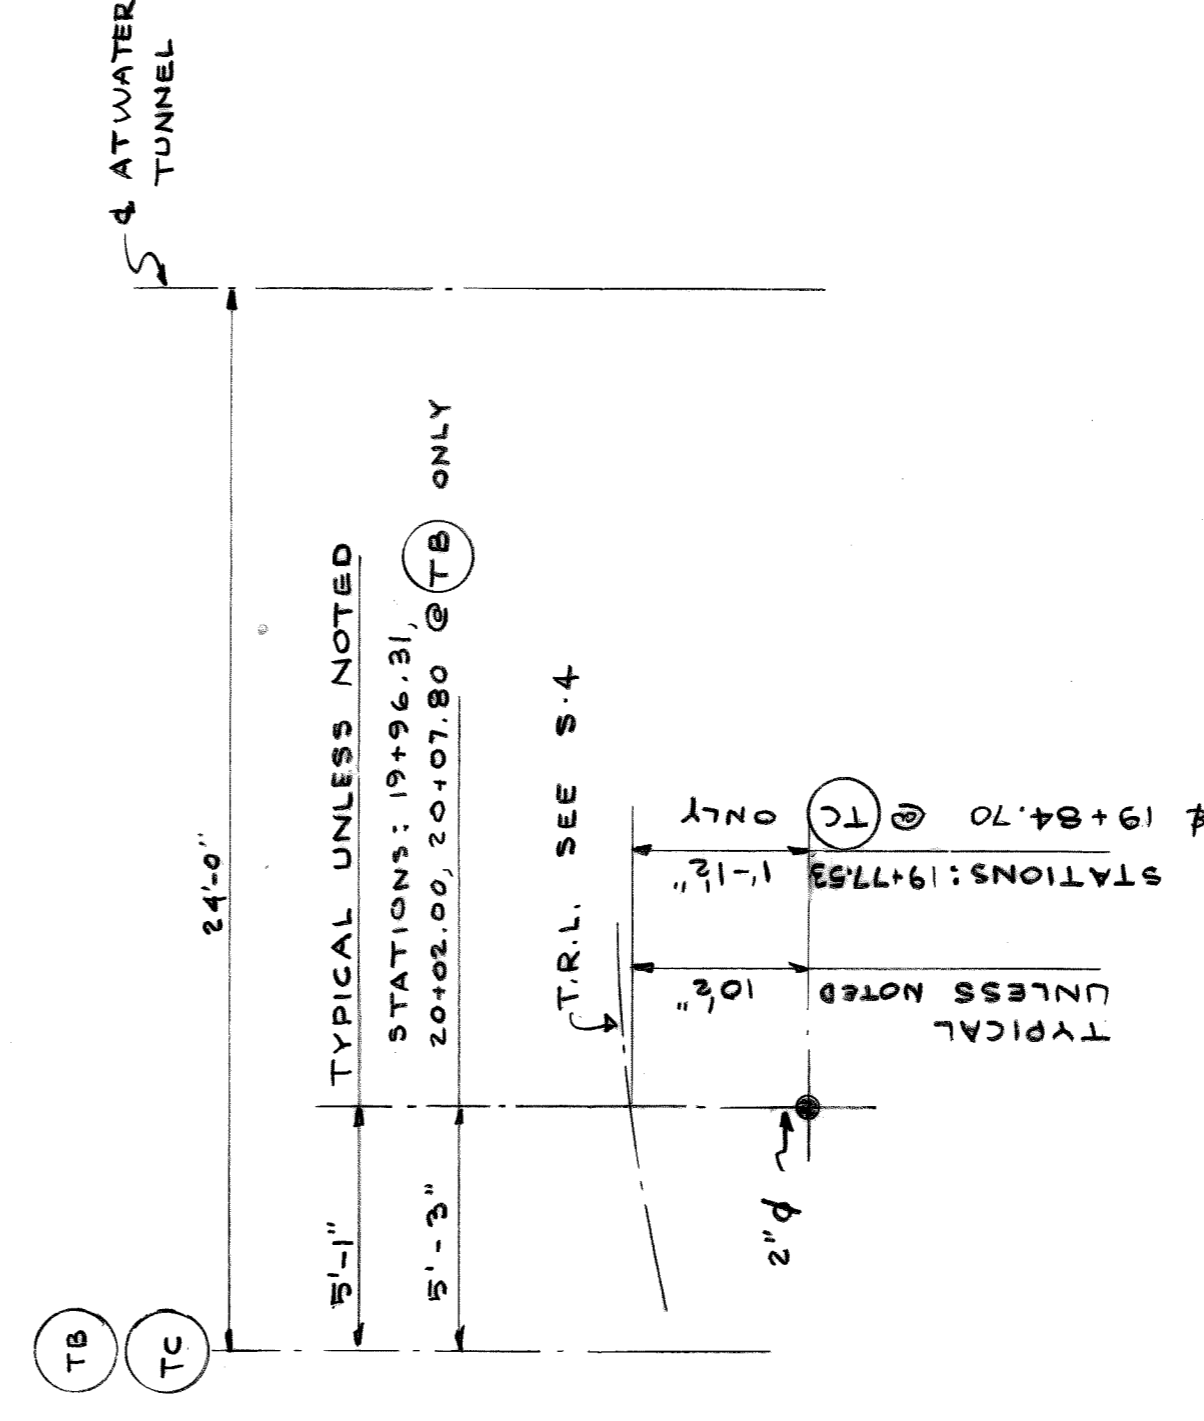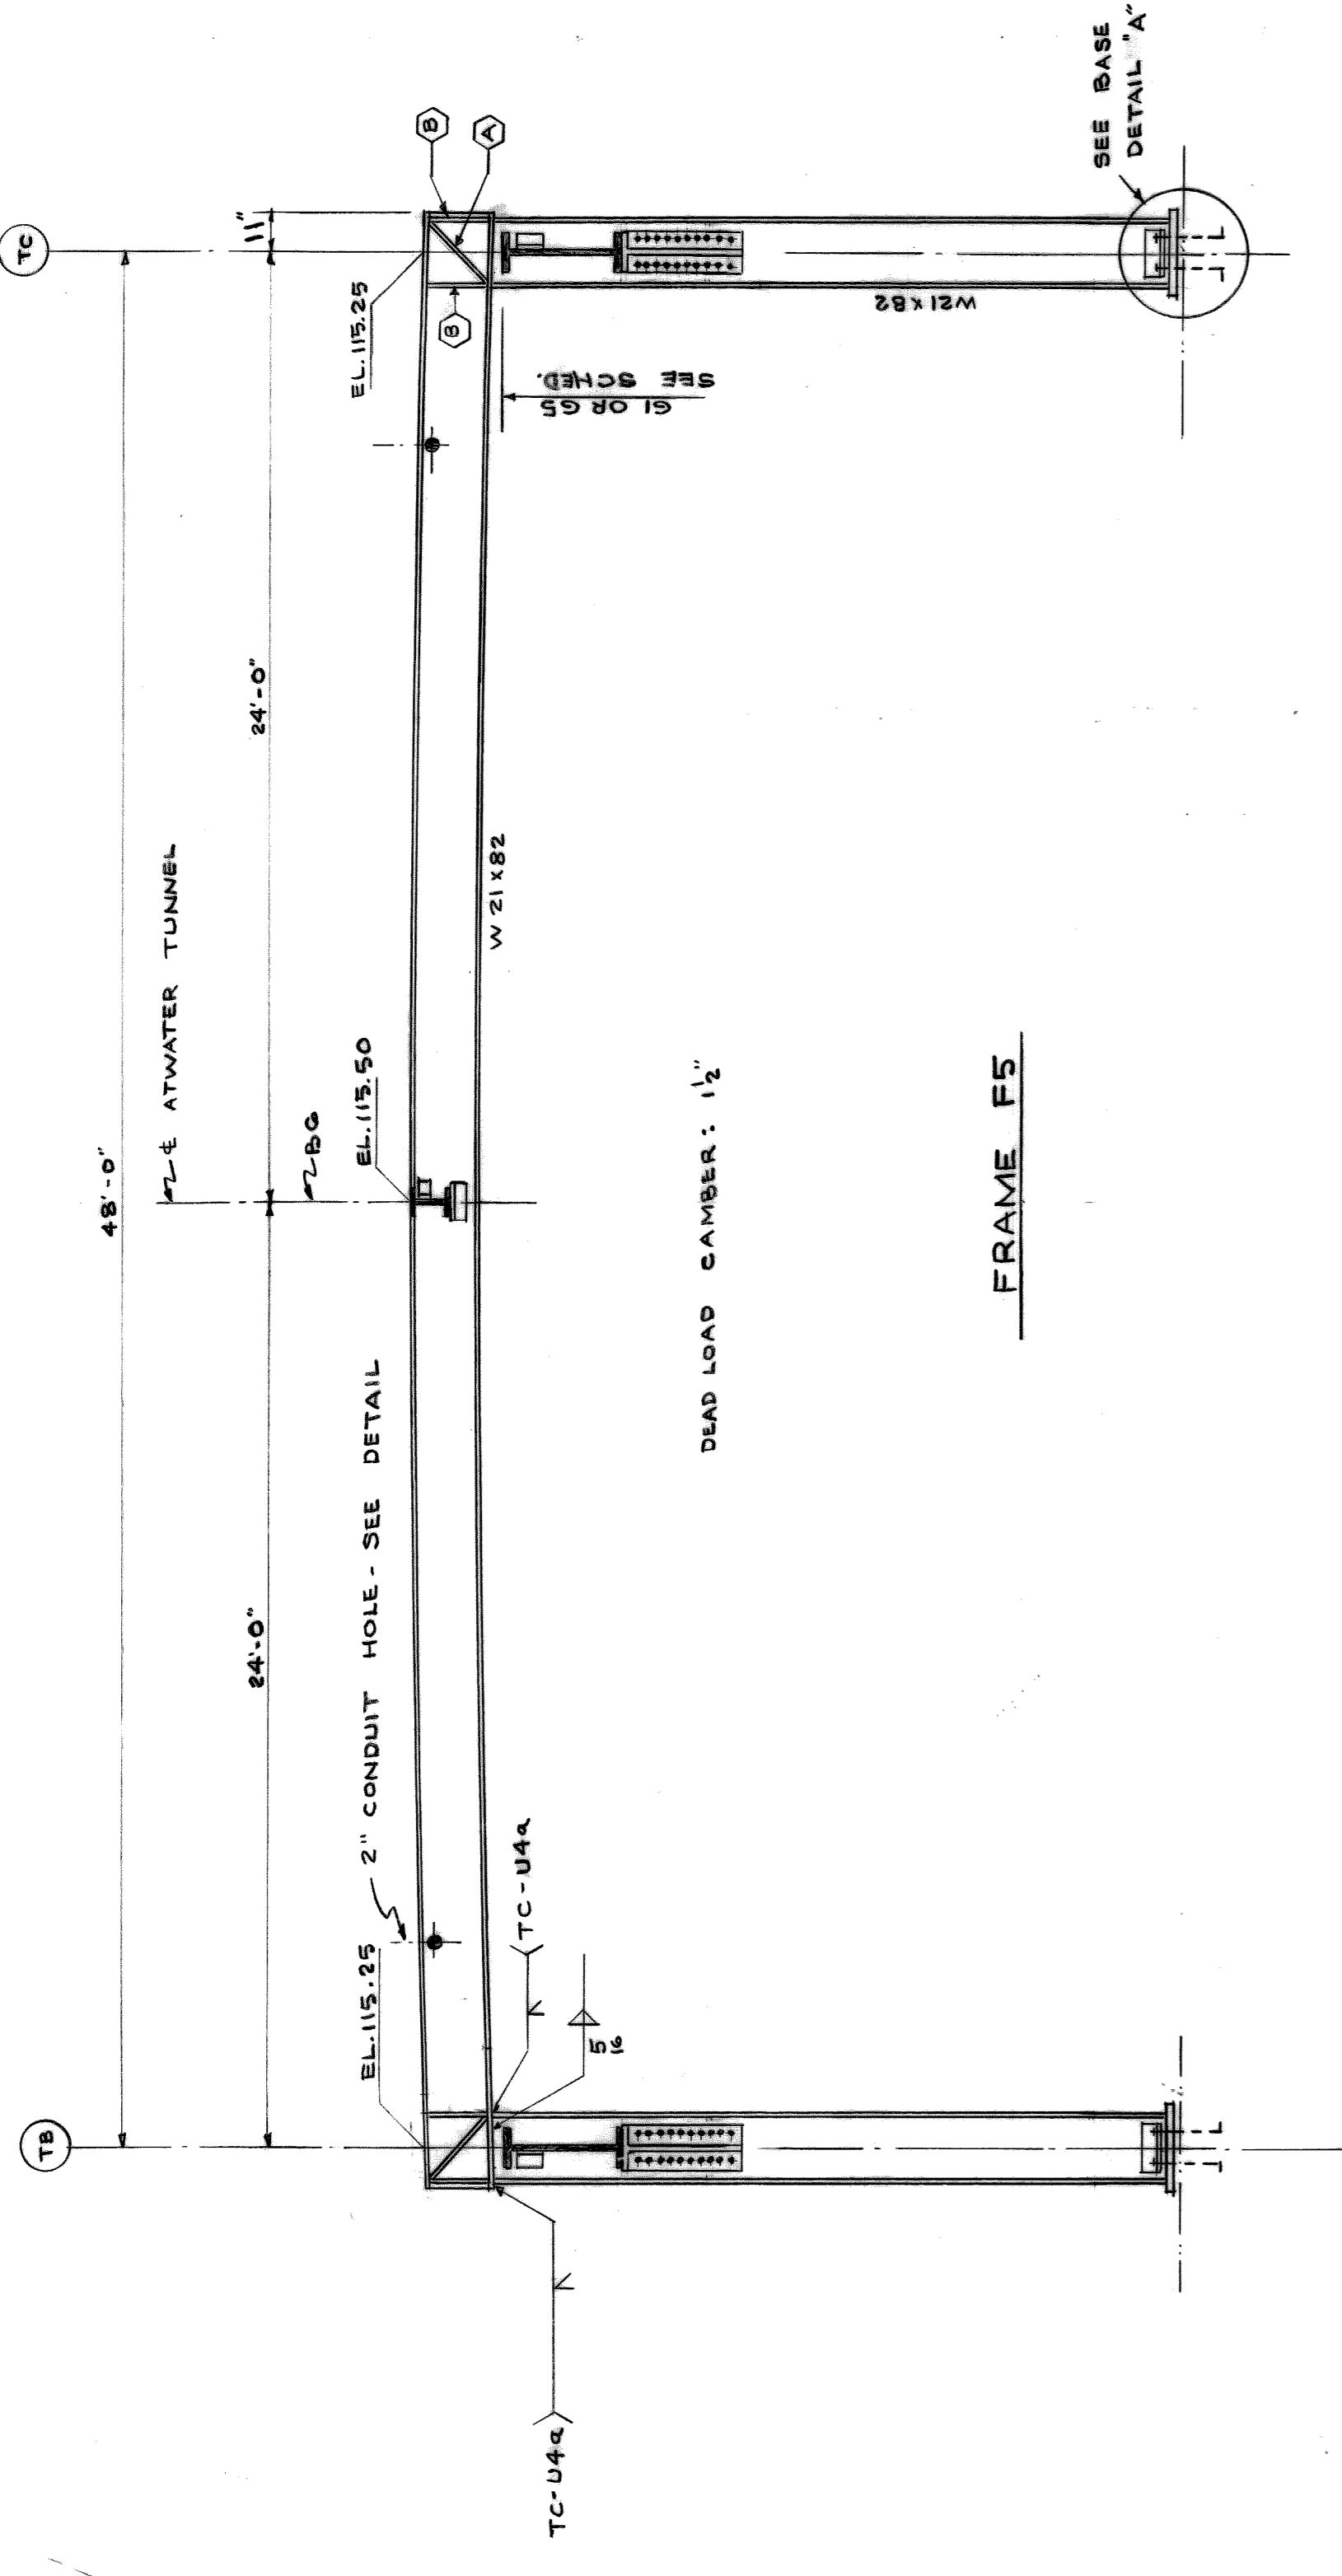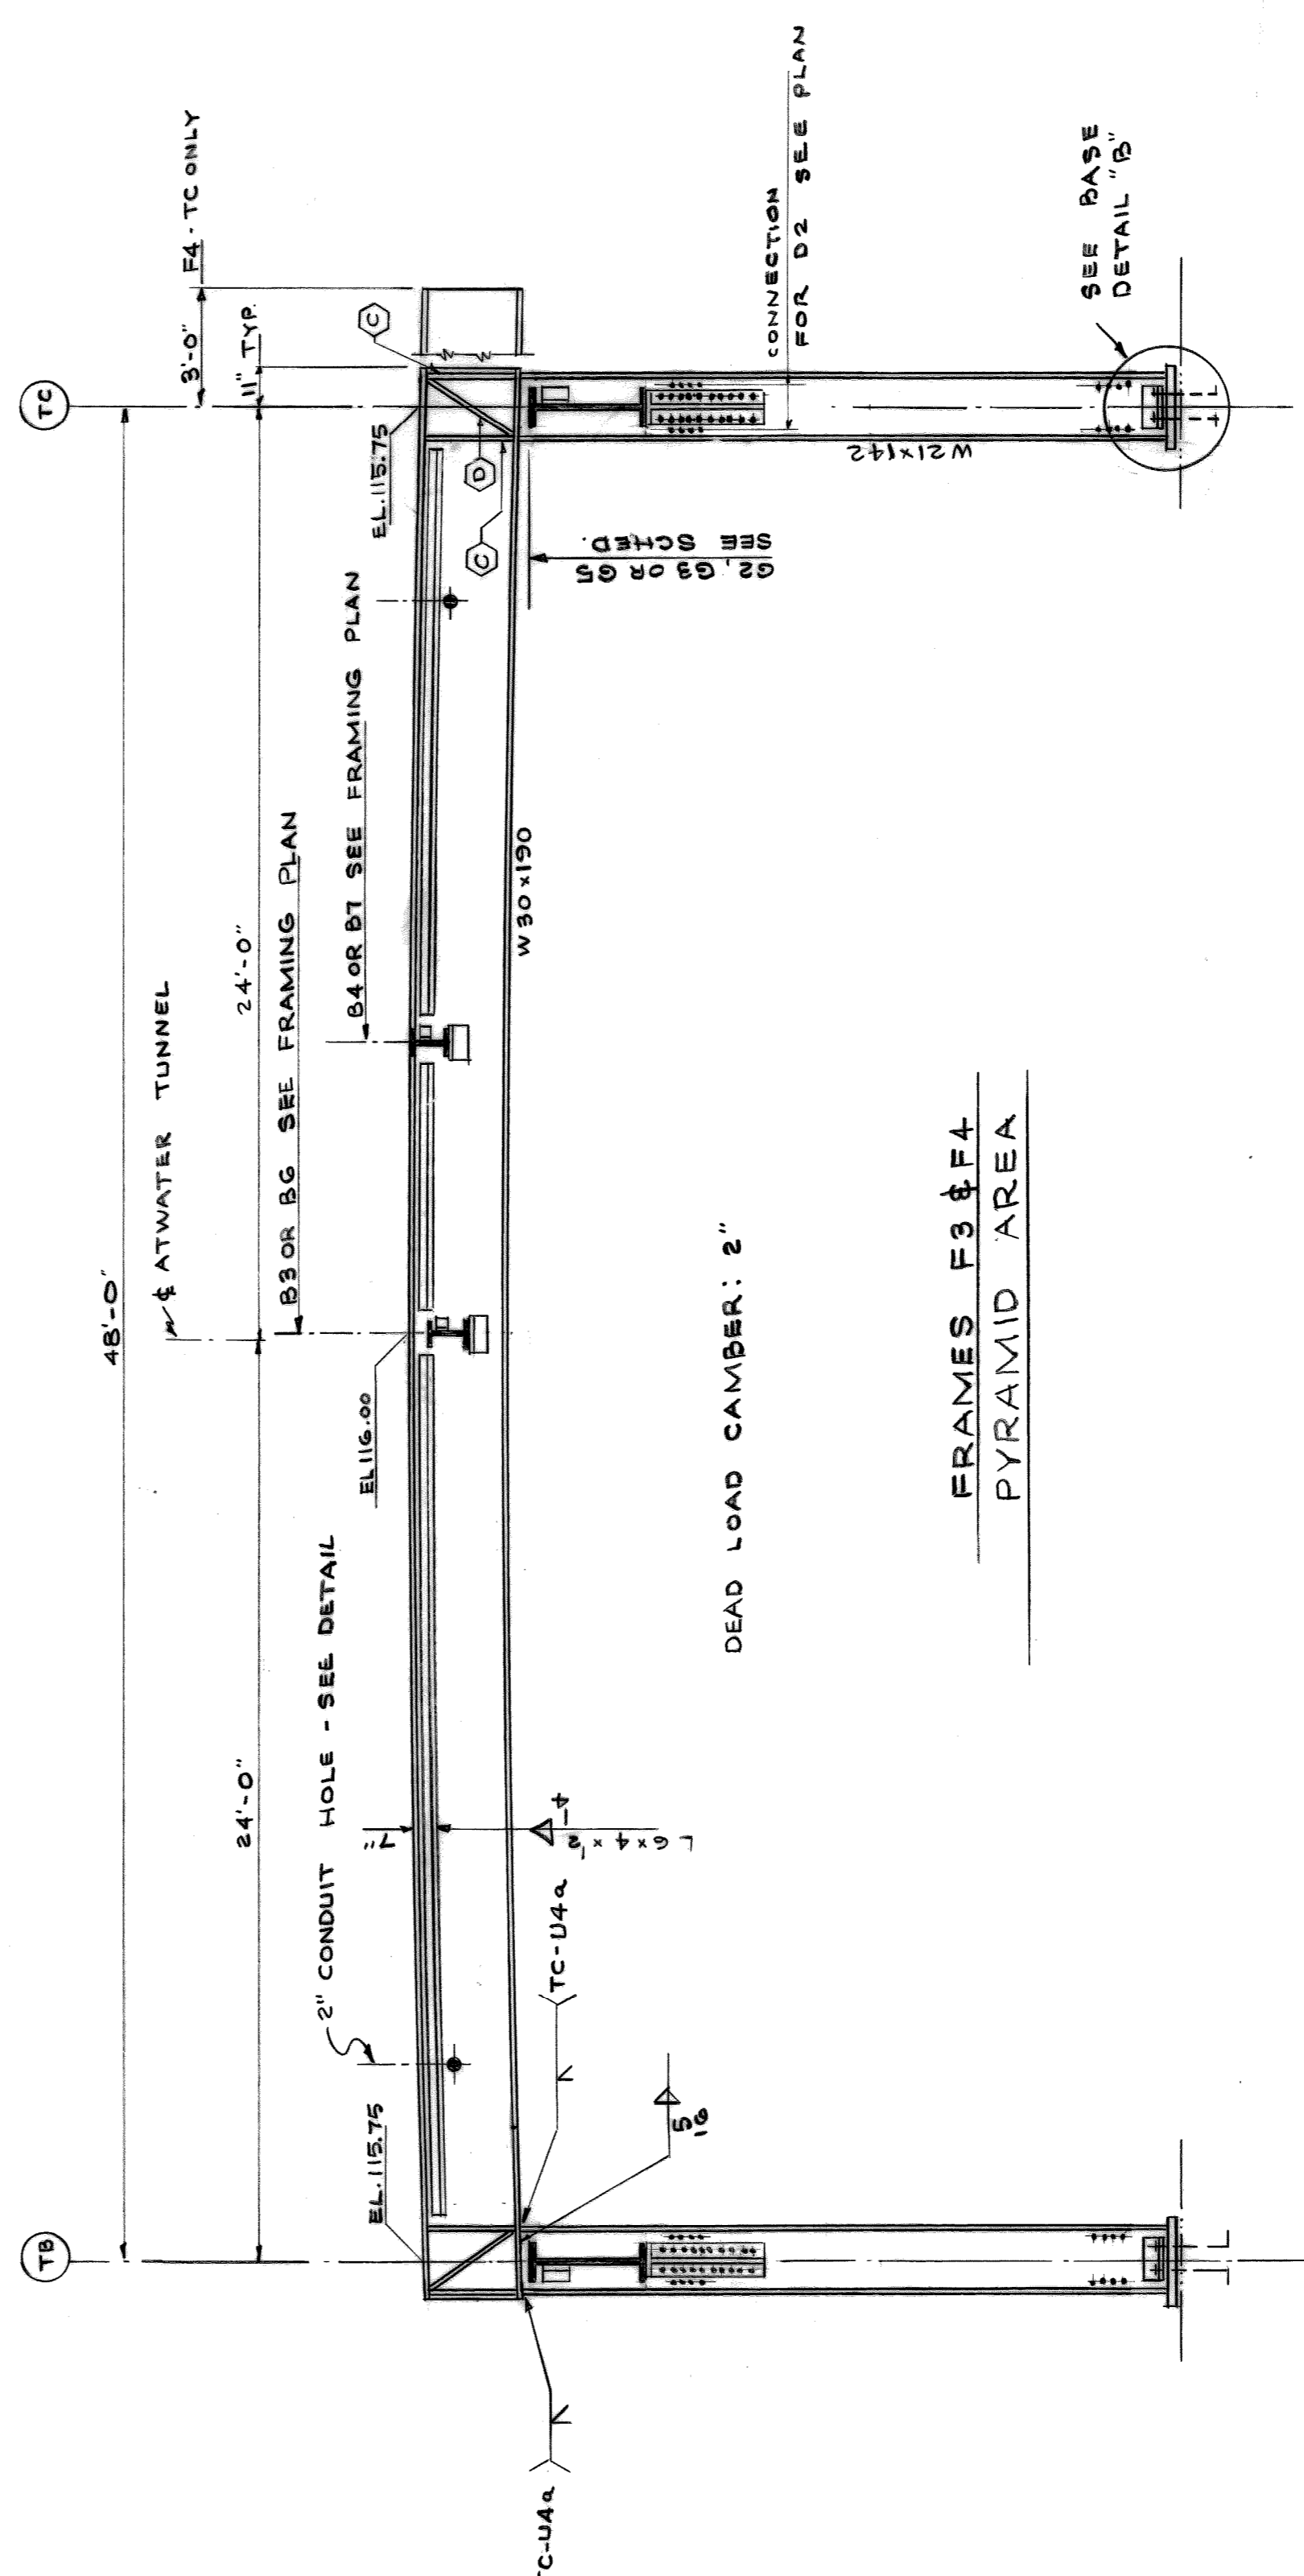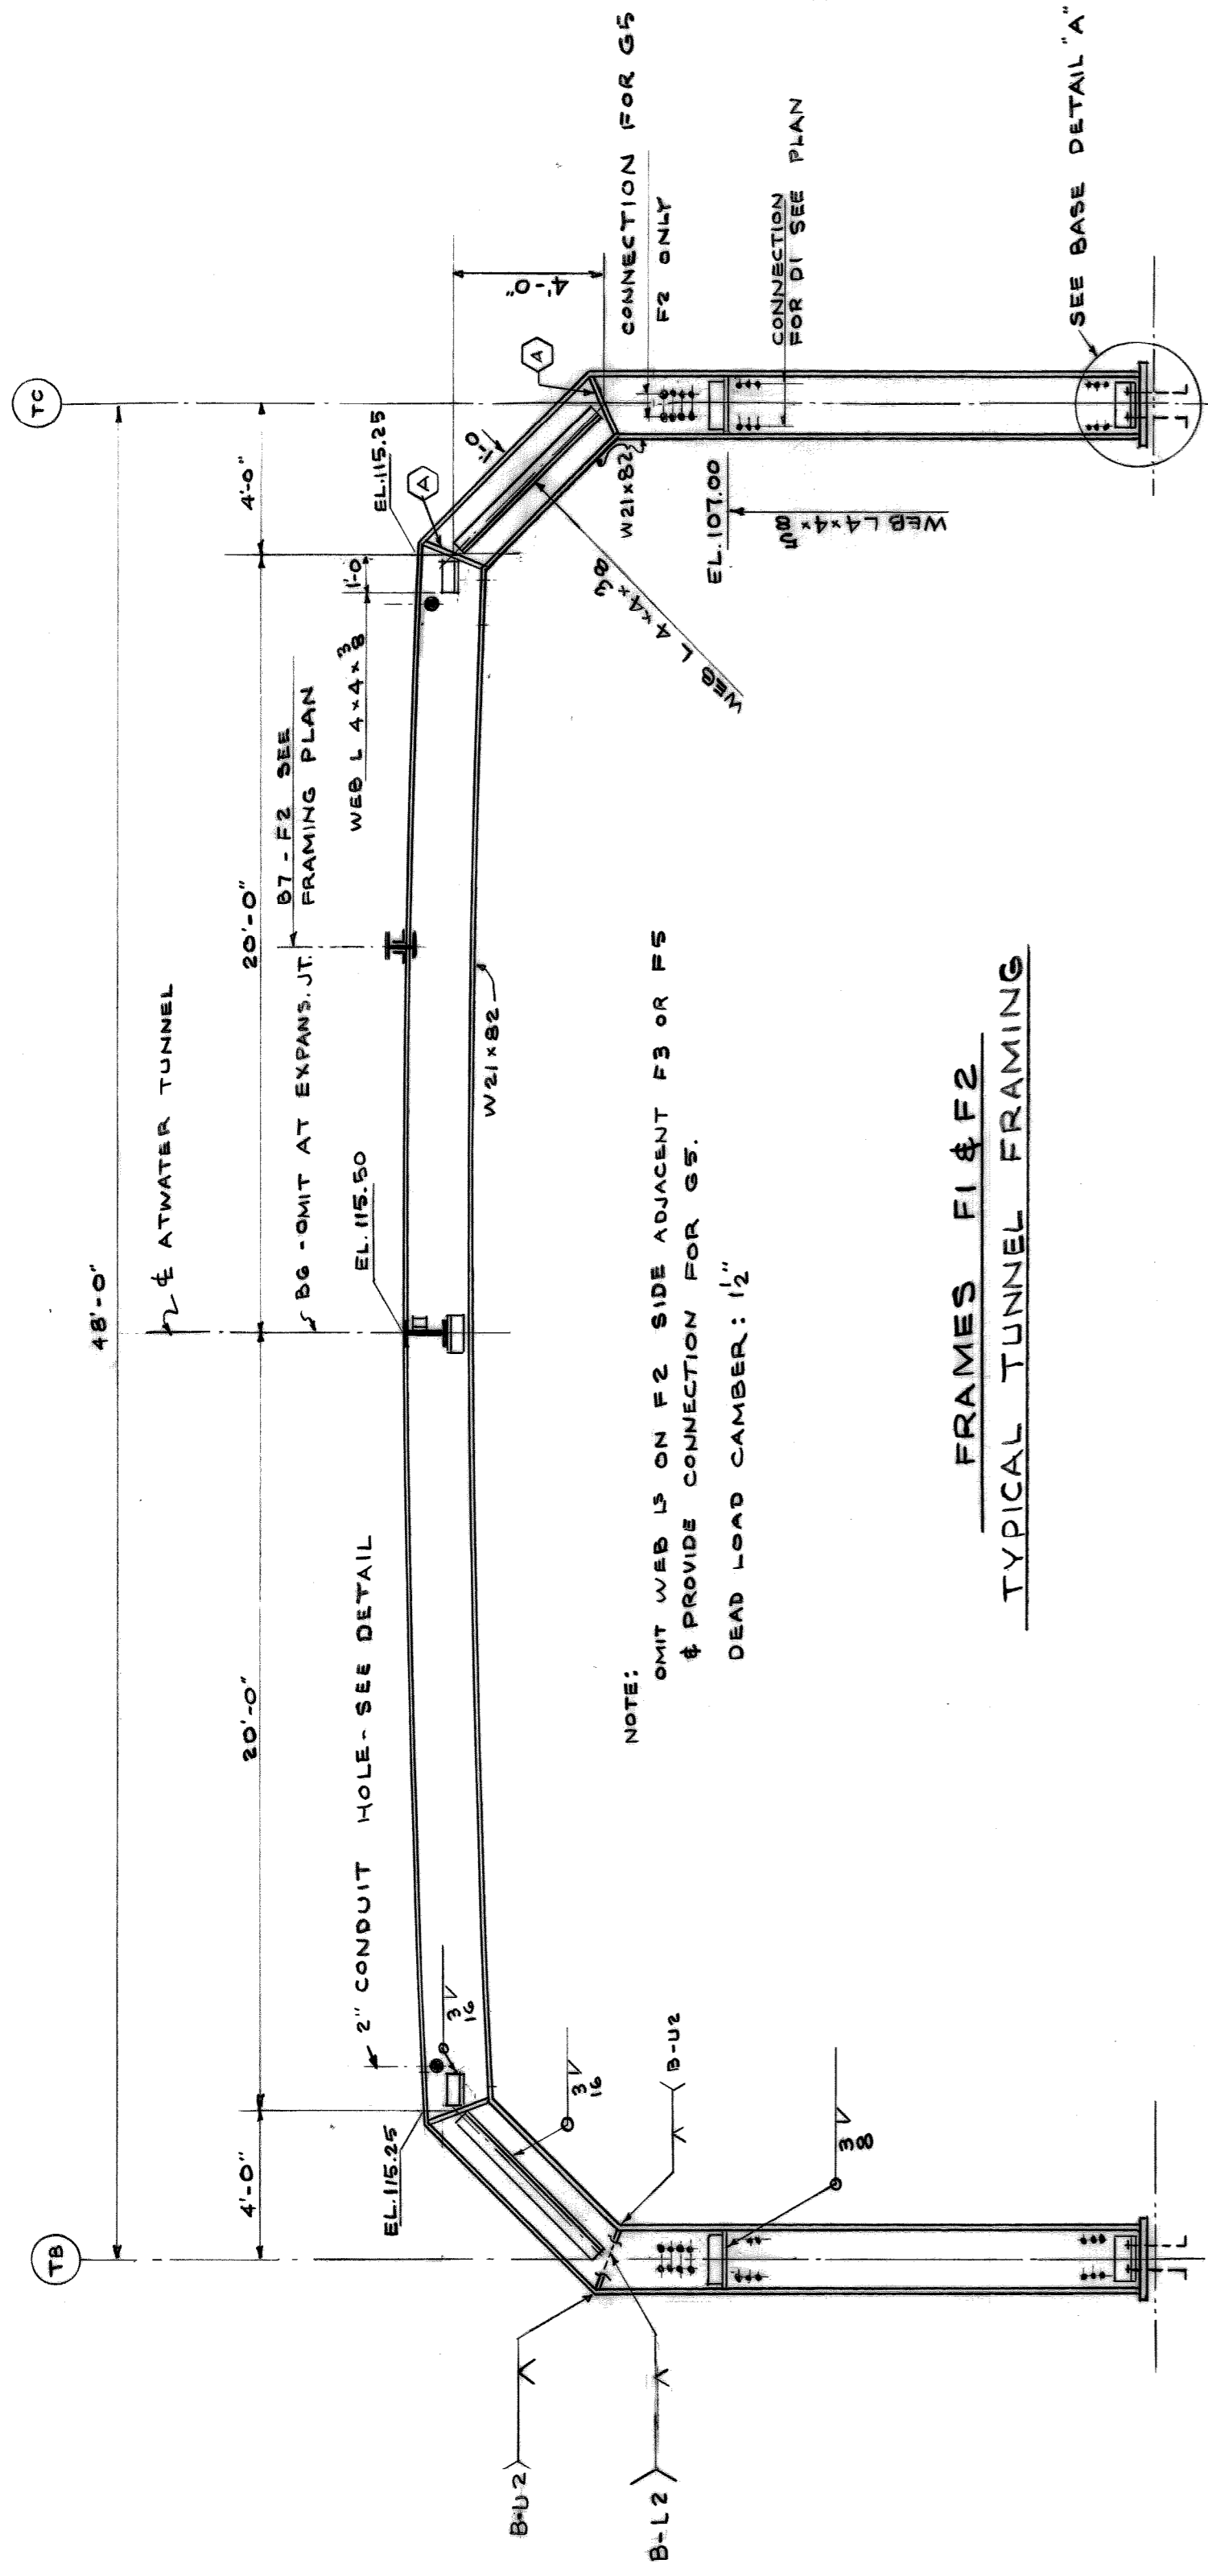

MARK	DESCRIPTION	MATERIAL	END WELD	WEB WELD
(A)	DIAGONAL STIFFENER	R 3/4" x 4"	TC-U5b	1/2"
(B)	FLANGE STIFFENER	R 7/8" x 4"	TC-U4a	1/2"
(C)	DIAGONAL STIFFENER	R 1 1/4" x 7"	TC-U5b	1/2"
(D)	FLANGE STIFFENER	R 1 1/4" x 7"	TC-U4a	1/2"

CONDUIT HOLE DETAIL
FOR ALL FRAMES F1
BEAMS B1, B2, B3, B5

SCALE: 1/4" = 1'-0"

NO.	REVISIONS

DATE 8-11-75
DESIGNED T. M.
DRAWN T. M. & A. G.
CHECKED M. C.

APPROVED
T. E. G. M. S. J. R. W. R. M.
STRUCTURAL ENGINEER

CITY OF DETROIT
CITY ENGINEERING DEPARTMENT

ATWATER STREET RELOCATION
ATWATER TUNNEL
STEEL FRAME DETAILS

CONTRACT NO. 07105A
DRAWING NO. S5
SHEET 23 OF 24

MATERIAL SCHEDULE

MARK	SHAPE	SECTION	ELEVATION	CAMBER REACT.	CONNECTION	REMARKS
B1	I	W 21 x 82	T.R.L. -6"	35"	SEAT "A" @ G1 STD. FRAMED BEAM CONN. - GROWS 3/4" @ BOLTS @ C2	SEE CONDUIT HOLE DETAIL
B2	I	W 30 x 210 2 LG x 4 1/2 STOP @ BEAM CONN.	T.R.L. -5"	150"	SEAT "A" @ G2, G3 & G4	CONT. 4 WELD TOP 1/4" BOT. 4" LEG L.S. - EXTEND AT 19" 1123 - SEE PLAN. SEE CONDUIT HOLE DETAIL
B3	I	W 12 x 53	T.R.L. -6"	50"	SEAT @ F4 STD. FRAMED BEAM CONN. @ B2 & B5	WALL SUPPORT
B4	I	W 12 x 53	T.R.L. -	50"	SEAT @ F3 & F4 STD. FRAMED BEAM CONN. @ B2	FUTURE COL. SUPPORT
B5	I	W 24 x 160	T.R.L. -6"	100"	SEAT "A" @ G4 STD. FRAMED BEAM CONN. @ C2	SEE CONDUIT HOLE DETAIL
B6	I	W 12 x 27	T.R.L. -6"	35"	SEAT CONN. @ FRAMES STD. FRAMED BEAM CONN. @ BEAMS	TYPICAL @ 4 TUNNEL UNLESS NOTED.
B7	I	W 12 x 53	T.R.L. -	50"	SEAT @ F2 & F3 COPE @ F2	2 - 3/4" @ BOLTS F2
B8	I	W 12 x 53	115.00	50"	SEAT @ C2 W 12 x 53 SECTION SEAT @ G3	FUTURE COL SUPPORT
C1	I	W 12 x 40	-	100"	SEE COLUMN BASE DETAIL "C"	R 1 x 12 x 1'-0" CAP R
C2	I	W 21 x 82	-	250"	SEE COLUMN BASE DETAIL "A"	
G1	I	W 36 x 135	113.25	100"	SEAT "B" @ F5 STD. FRAMED BEAM CONN. @ C2	COPE TOP FLG. FOR ERECTION
G2	I	W 36 x 194	115.00	225"	SEAT "C" @ F3 & F4	COPE TOP FLG. FOR ERECTION
G3	I	W 36 x 150	113.00	180"	SEAT "C" @ F3	COPE TOP FLG. FOR ERECTION
G4	I	W 36 x 195	113.00	180"	SEAT "C" F3 & F4 STD. FRAMED BEAM CONN. @ C2	COPE TOP FLG. FOR ERECTION
G5	I	W 24 x 100	109.00	50"	STD. FRAMED BEAM CONN.	MATCH ADJACENT FRAMING.
G6	I	W 36 x 135	113.00	-	SEE GIRDER G6 DETAIL	CANTILEVER - SEE DETAIL


* INCLUDES 3" FOR T.R.L. PROFILE

GENERAL NOTES

- DESIGN SPECIFICATIONS:
- 1969 A.I.S.C. LATEST EDITION
 - STRUCTURAL STEEL FRAMES SHALL CONFORM TO PART 2 A.I.I.9C SPECIFICATIONS FOR PLASTIC DESIGN
 - M.D.S.H. STD. SPECIFICATIONS FOR HIGHWAY CONSTRUCTION 1973.
- MATERIAL: ASTM A-572 GRADE 50 EXCEPT ANCHOR BOLTS AND BASE PLATES WHICH SHALL BE ASTM A-36.
- WELDING:
- PROCESS - E70XX
 - GROOVE WELDS SHALL BE TESTED IN ACCORDANCE WITH SECTION 504.16 OF M.S.H.D. STD. SPEC.
 - SURFACES OF ALL WELDS SHALL HAVE REASONABLY SMOOTH AND UNIFORM.
- STRUCTURAL STEEL CONTR. SHALL FURNISH ANCHOR BOLTS AND ANCHOR BOLT SETTING PLAN TO FON. CONTR. ANCHOR BOLTS SHALL BE SET FIRMLY TO A TEMPLATE AND THE ENGINEER SHALL VERIFY LOCATION, ELEVATION, AND PROJECTION OF ANCHOR BOLTS BEFORE CONC. IS POURED.
- GROUT: NON-SHRINK IN ACCORDANCE WITH SECTION 7.02 OF M.D.S.H. STD. SPEC.
- CONC. SLABS ARE DESIGNED FOR AN ALTERNATE CONCENTRATED LOAD OF 50K. SEE 9H-54 FOR COLUMN LOADS FROM PYRAMID STRUCTURE







LOADING:

TUNNEL PROPER	PYRAMID AREA
1" GRANITE	27
1" MORTAR	10
2 1/4" CONC. MAT	34
4" M.W.P.	2
CONC. SLAB (7)	88
STEEL 9M.	10
LIGHTS - MECH.	55
DEAD LOAD	4
LIVE LOAD	175 PSF
	100 PSF

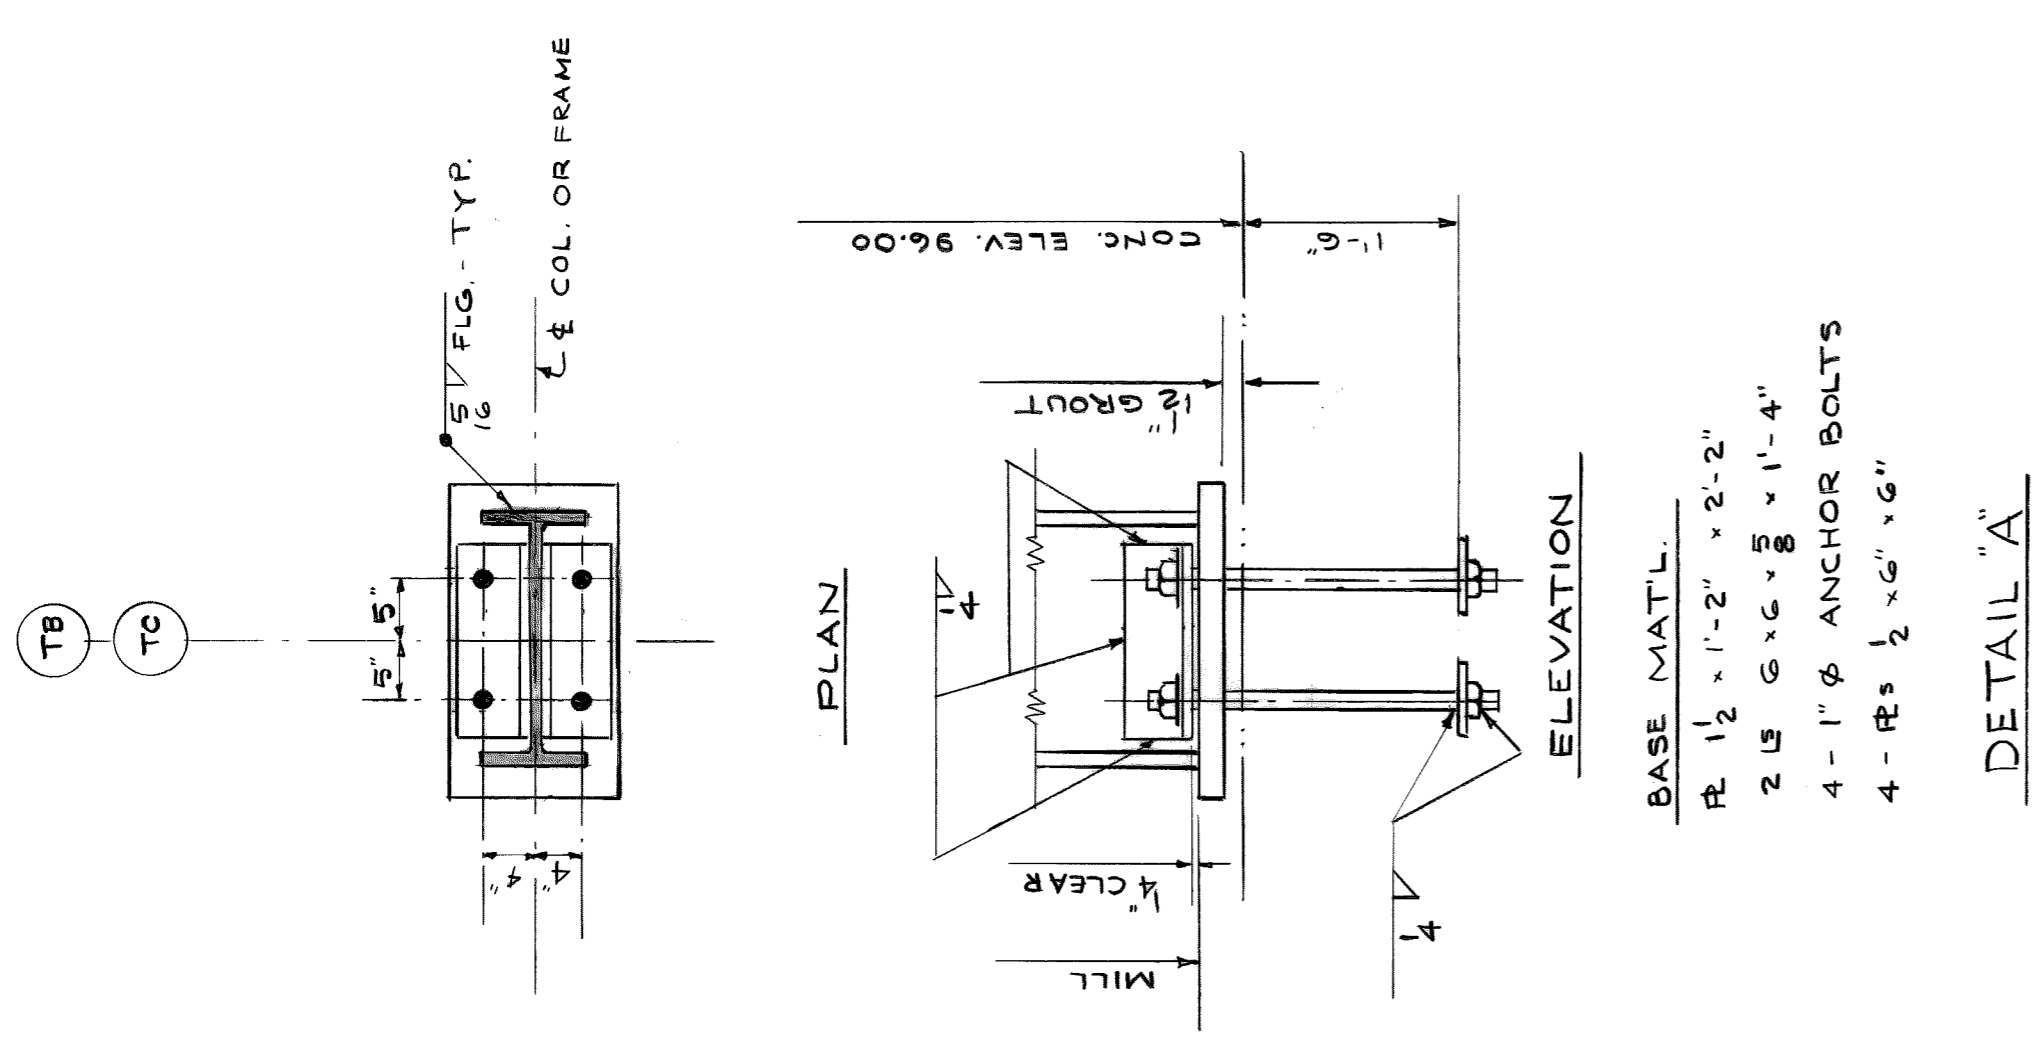

COLUMN BASE DETAILS

SCALE: 3/4" = 1'-0"

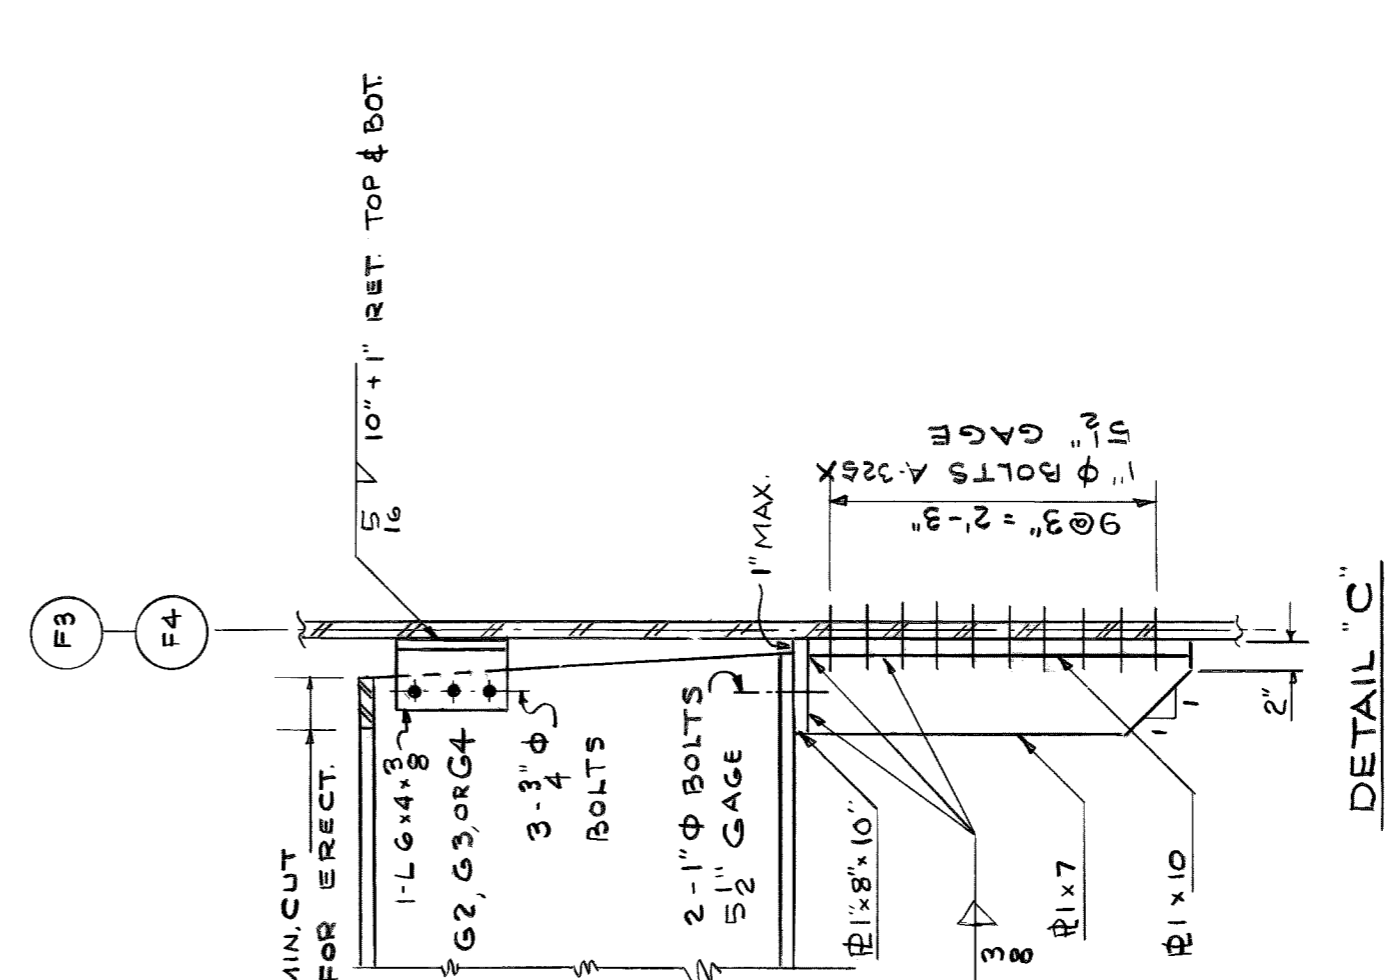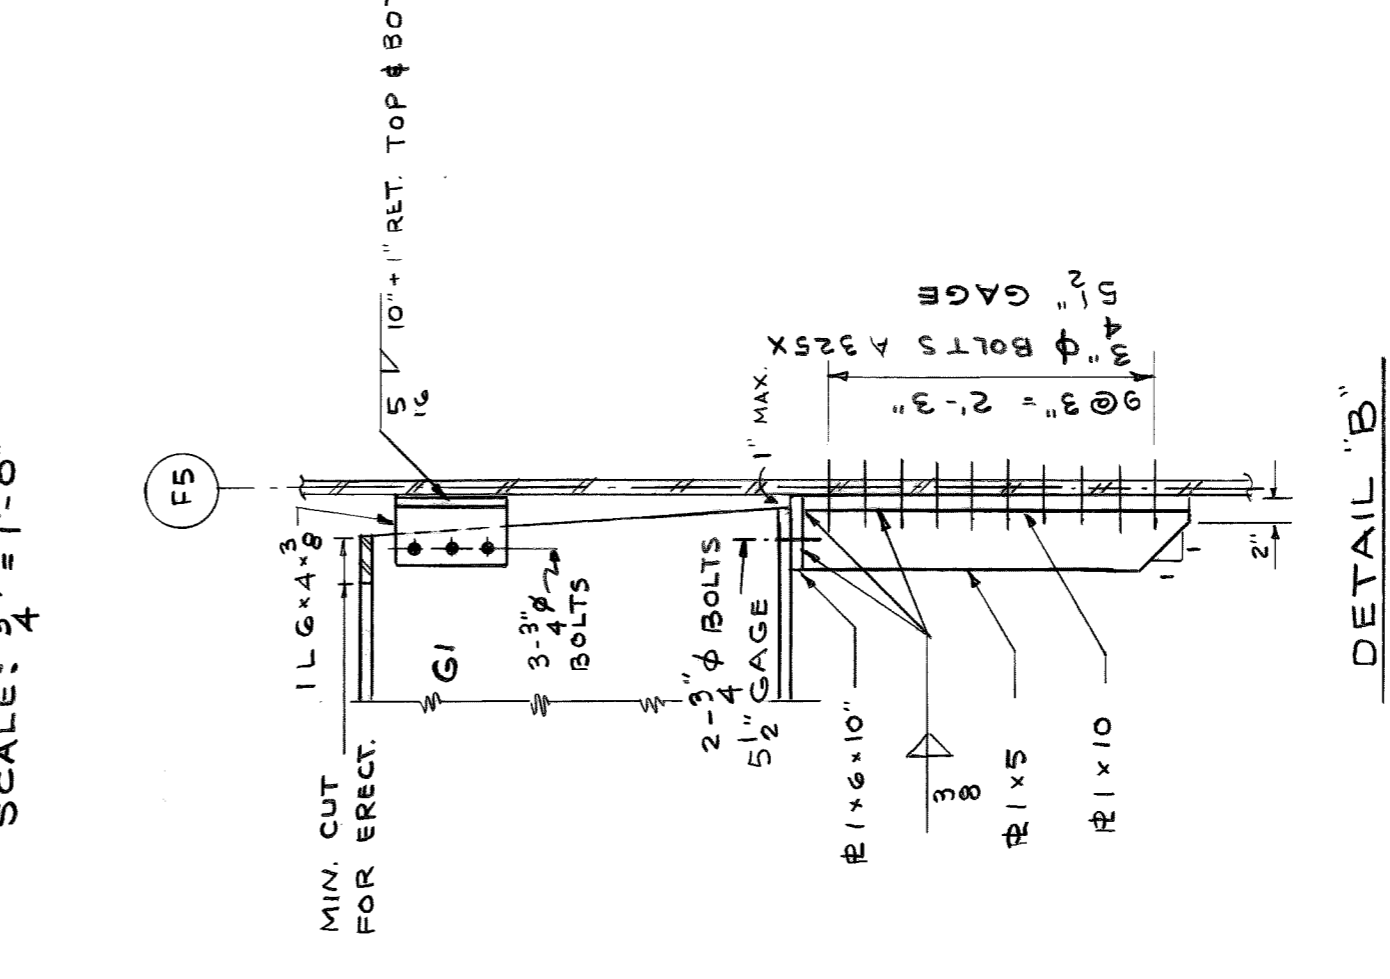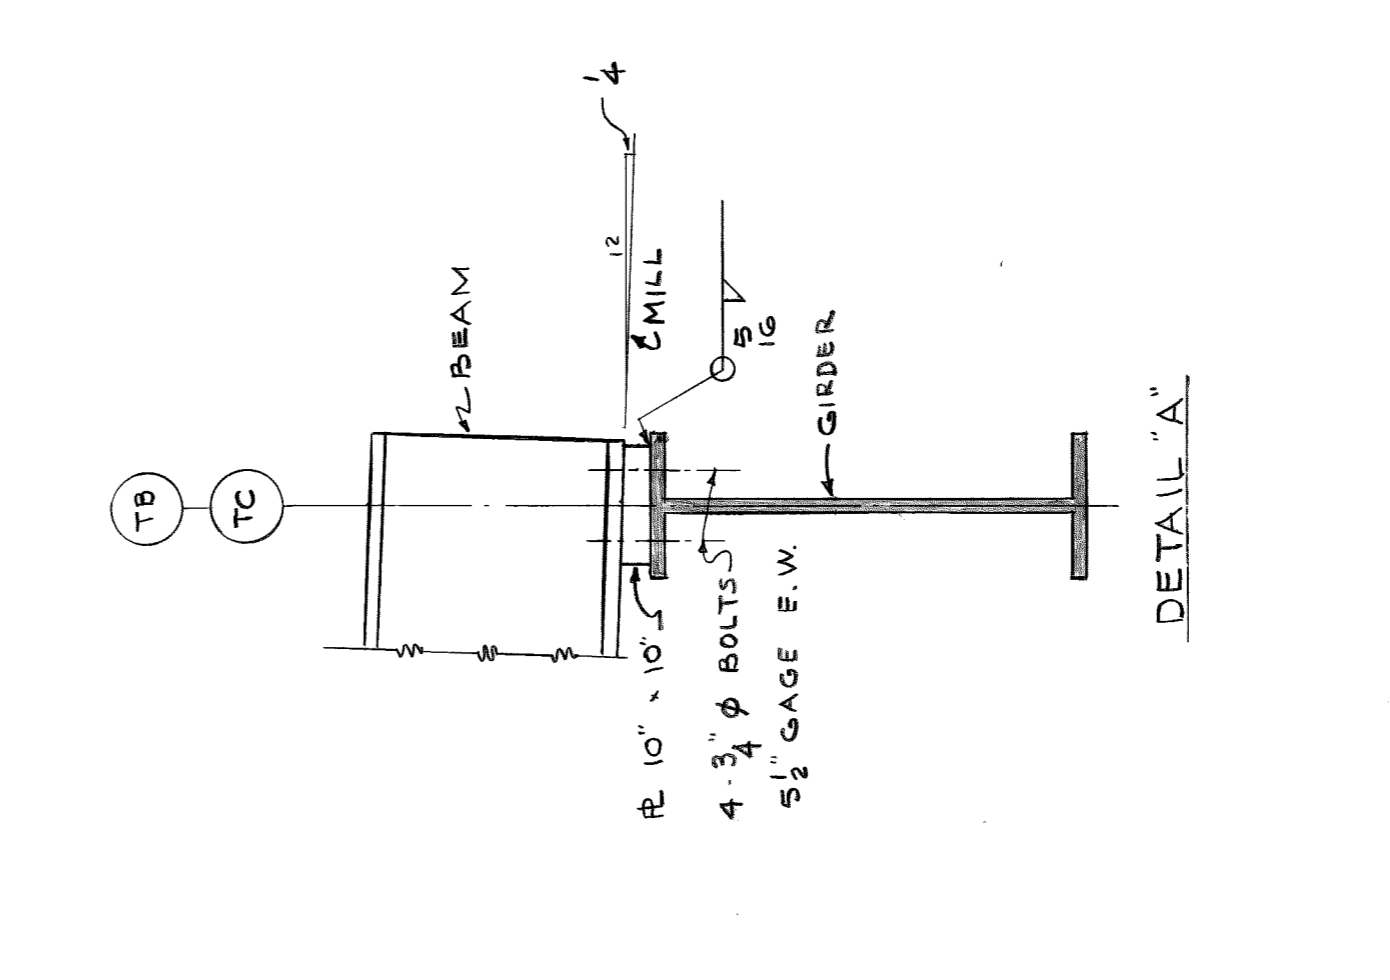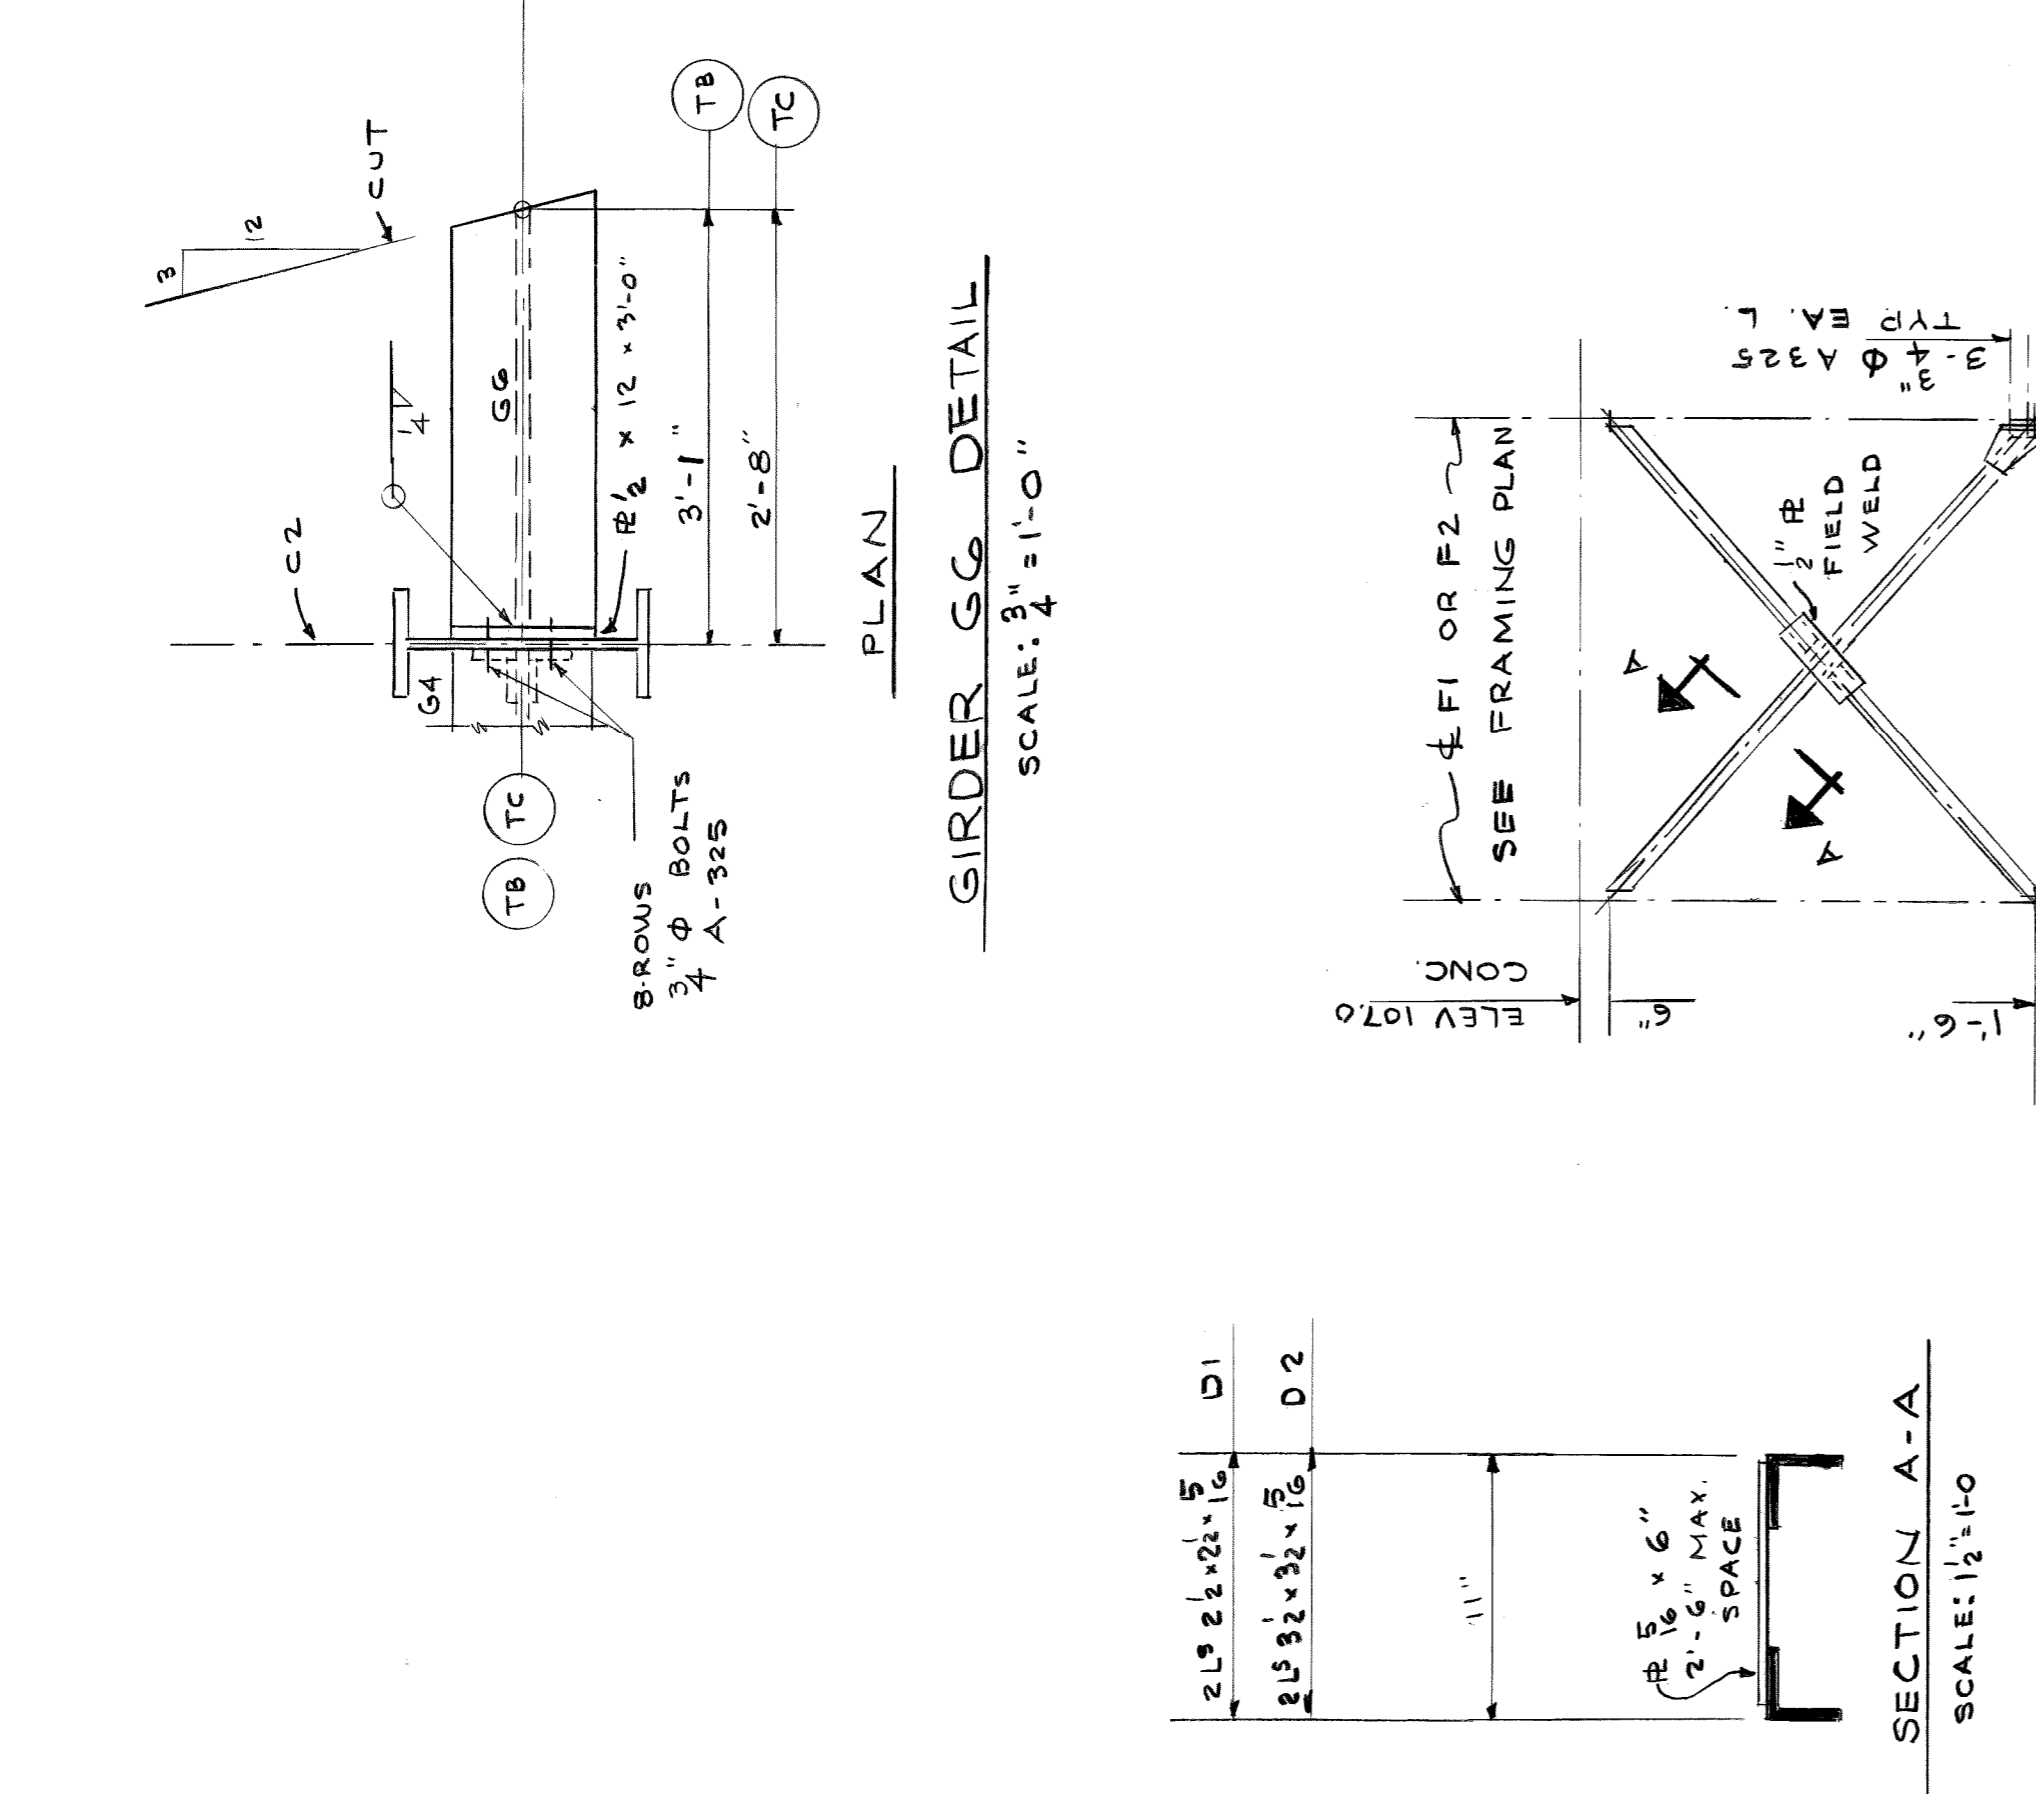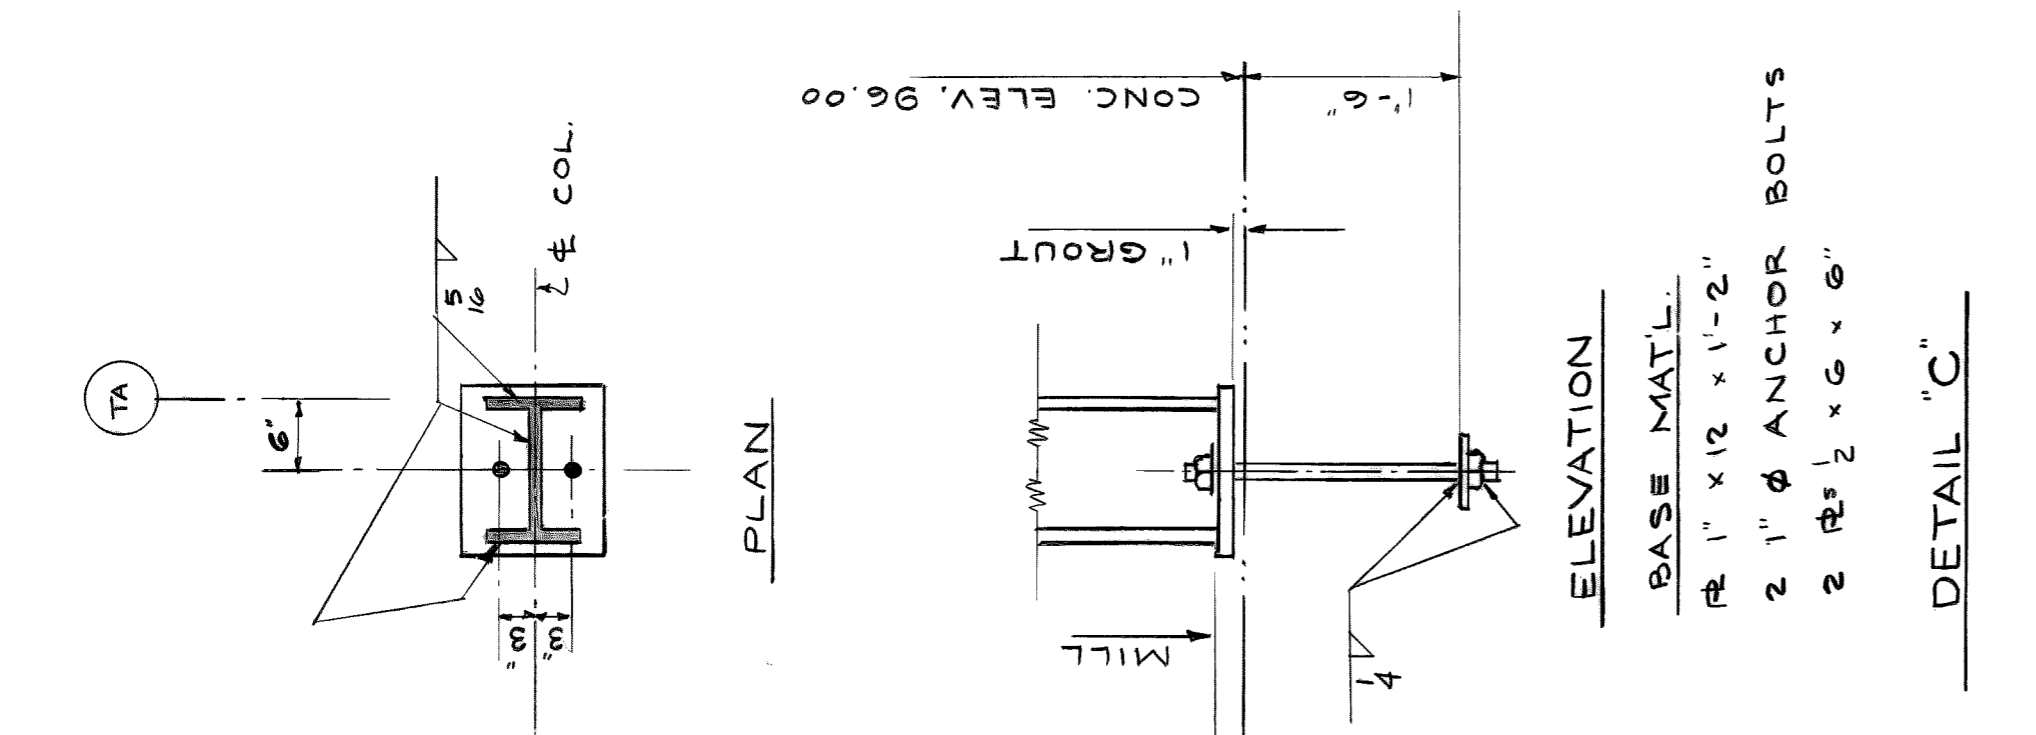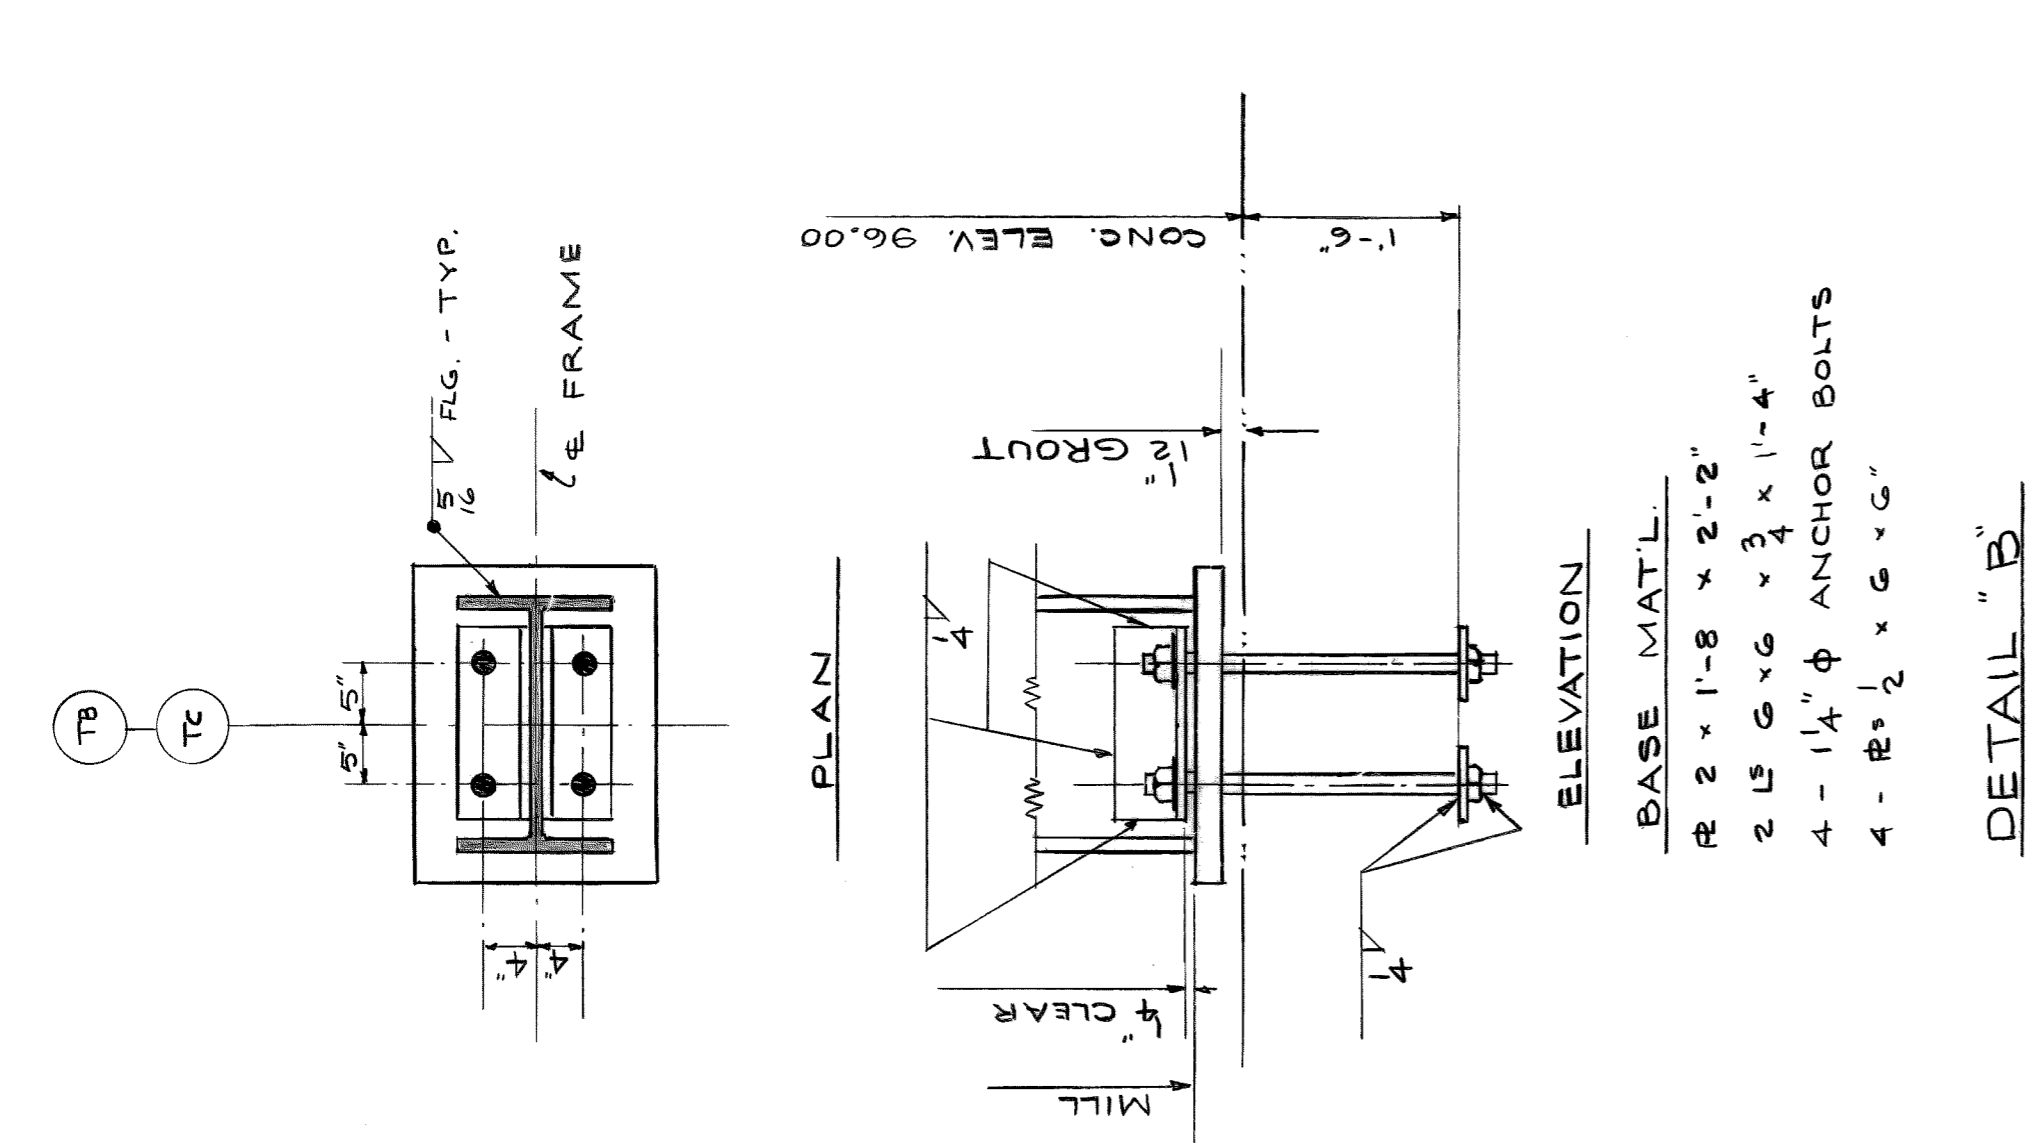

BEAM & GIRDER SEAT CONNECTION DETAILS

SCALE: 3/4" = 1'-0"

revisions

NO.	DESCRIPTION

date 8-11-75
designed T.M.
drawn T.M.
checked M.C.

approved
T.E. [Signature]
STRUCTURAL ENGINEER

CITY OF DETROIT
CITY ENGINEERING DEPARTMENT

ATWATER STREET RELOCATION
ATWATER TUNNEL

STRUCTURAL STEEL DETAILS

contract no. 07105A
sheet 24 of 81
drawing no. S6

GENERAL NOTES

ELEVATIONS SHOWN ARE FINAL ELEVATIONS. STEEL BEAMS HAVE BEEN CAMBERED FOR TOTAL DEAD LOAD.

PROVIDE CLASS B LAP SPLICES IN ACCORDANCE WITH ACI 318-71. LAP CONTINUOUS TOP BARS AT MID-SPAN. LAP CONTINUOUS BOTTOM BARS AT SUPPORT.

REINFORCING STEEL SHALL CONFORM TO ASTM A615 GRADE 60.

ALL CONCRETE SHALL HAVE A MINIMUM 28 DAY COMPRESSIVE STRENGTH OF 4000 PSI. WHITE CONCRETE SHALL BE PLACED WITHIN THE LIMITS SHOWN ON THE DRAWINGS. ALL OTHER CONCRETE SHALL BE GRADE 405.

ALL ITEMS EMBEDDED IN WHITE CONCRETE SUCH AS HANGER INSERTS, PIPES, BAR CHAIRS, ETC., SHALL BE PLASTIC OR PLASTIC COATED.

THE CONTRACTOR SHALL CHECK WITH OTHER TRADES FOR EMBEDDED ITEMS THAT ARE TO BE SET IN PLACE PRIOR TO PLACING OF CONCRETE. SEE MECH. DRAWING MA FOR HANGER INSERT SCHEDULE.

PROVIDE DETAILS IN ACCORDANCE WITH ACI 318-74.

FOR TUNNEL ROOF LOADS SEE DRWG # 36.


FORMS, RELEASE AGENTS, & ACCESSORIES SHALL BE APPROVED BY THE ENGINEER IN WHITE CONCRETE PORTION.

ALL EQUIPMENT USED IN STORAGE, TRANSPORTATION, MIXING, & DEPOSITING OF WHITE CONCRETE OR COMPONENTS SHALL BE INSPECTED BY THE ENGINEER & APPROVED IN WRITING.

DESIGN SPECIFICATIONS: ACI STANDARD 318-71.

MATERIALS SHALL CONFORM TO MDSH STANDARD SPECIFICATIONS 1973 & SPECIAL PROVISIONS.

FORMS SHALL BE TYPE A IN ACCORDANCE WITH SECTION 5.03.06 OF THE MDSH STANDARD SPECIFICATIONS.

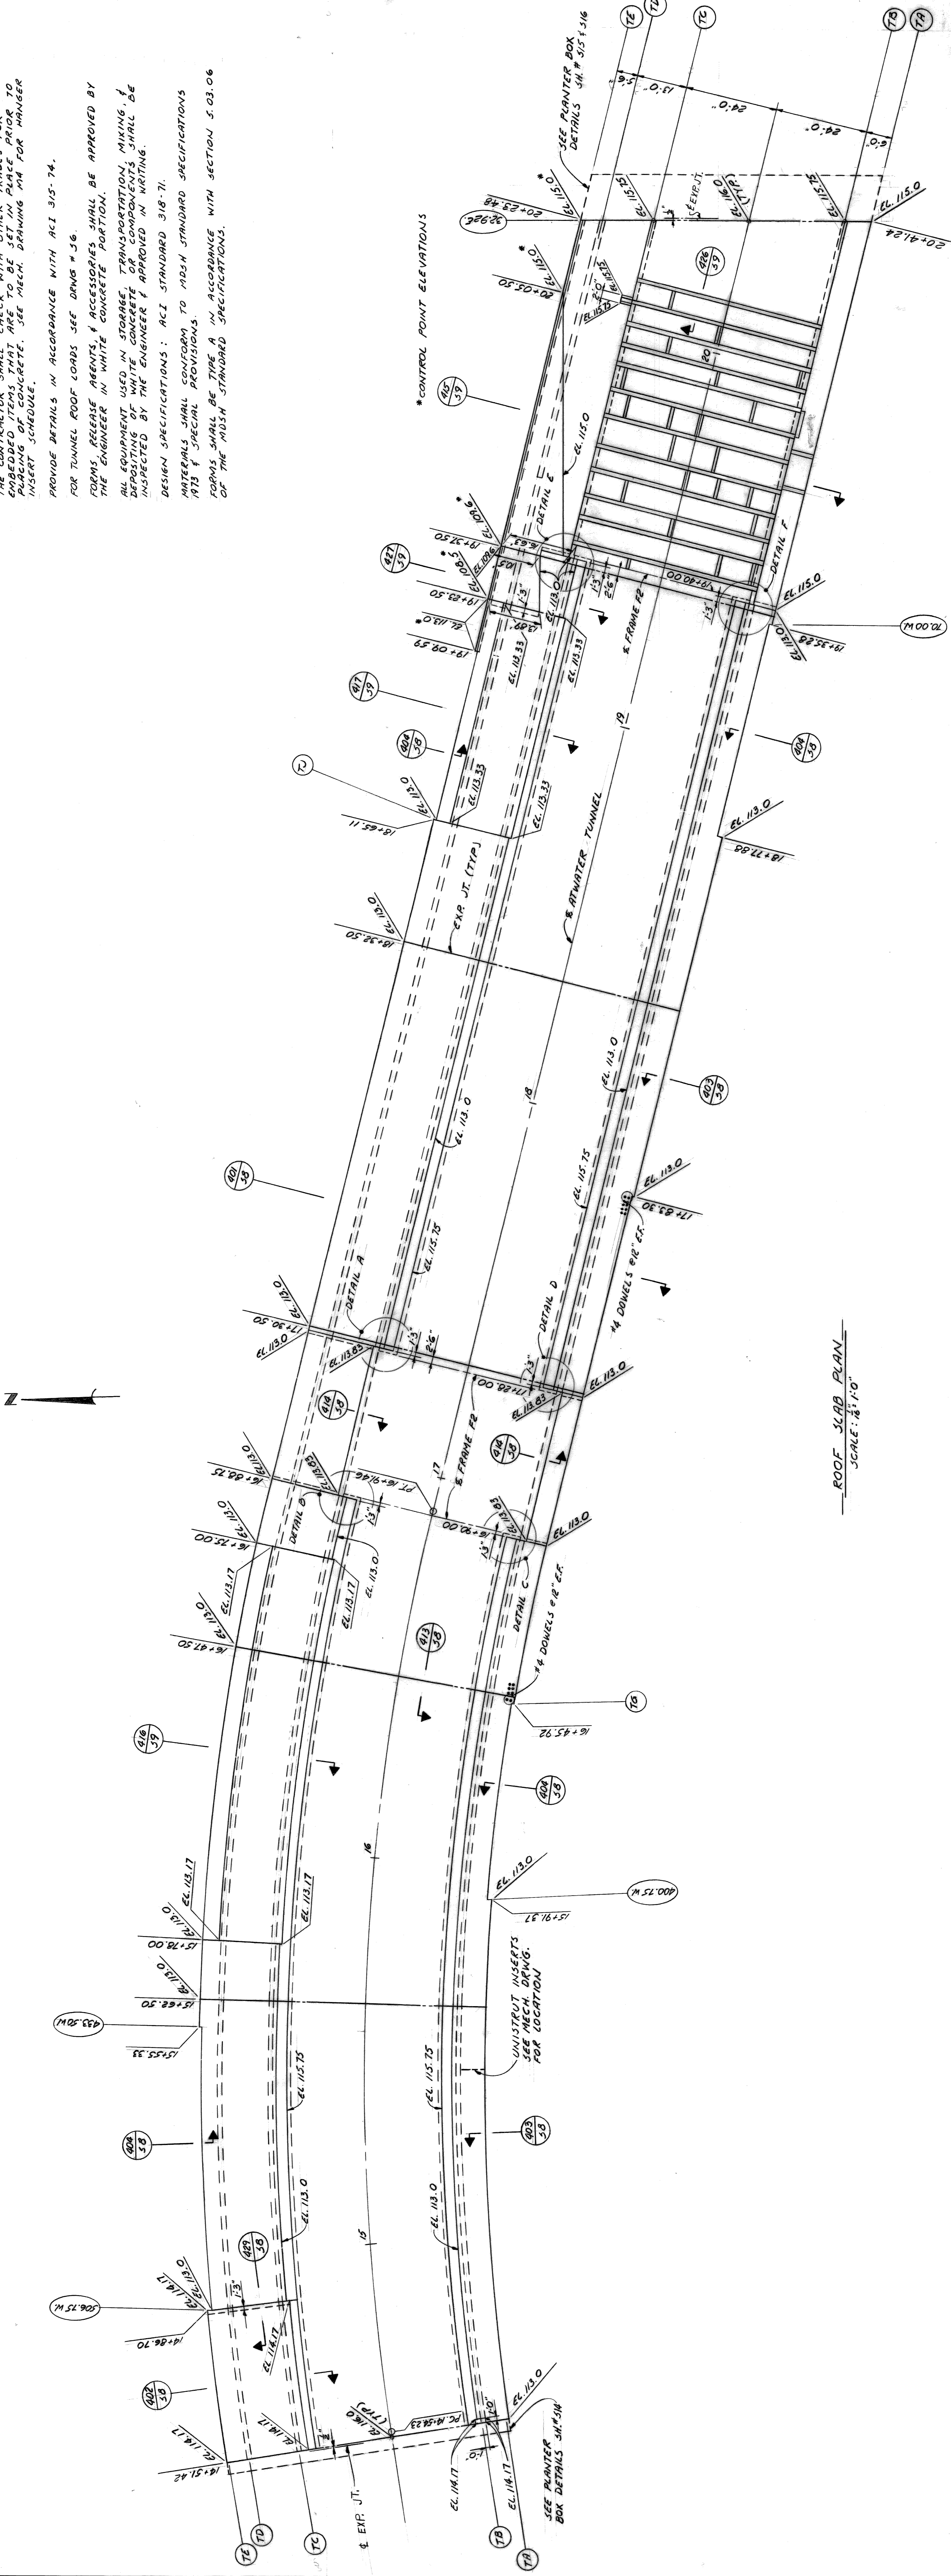

sheet 55 of 81
drawing no: S7

contract no. 07105A




ATWATER STREET RELOCATION
ATWATER TUNNEL
TUNNEL ROOF SLAB PLAN

CITY OF DETROIT
CITY ENGINEERING DEPARTMENT

approved
T. E. O'Connell
STRUCTURAL ENGINEER

date	designed	drawn	checked
8-11-75	R. Bunce	A.G.	R.B.

revisions

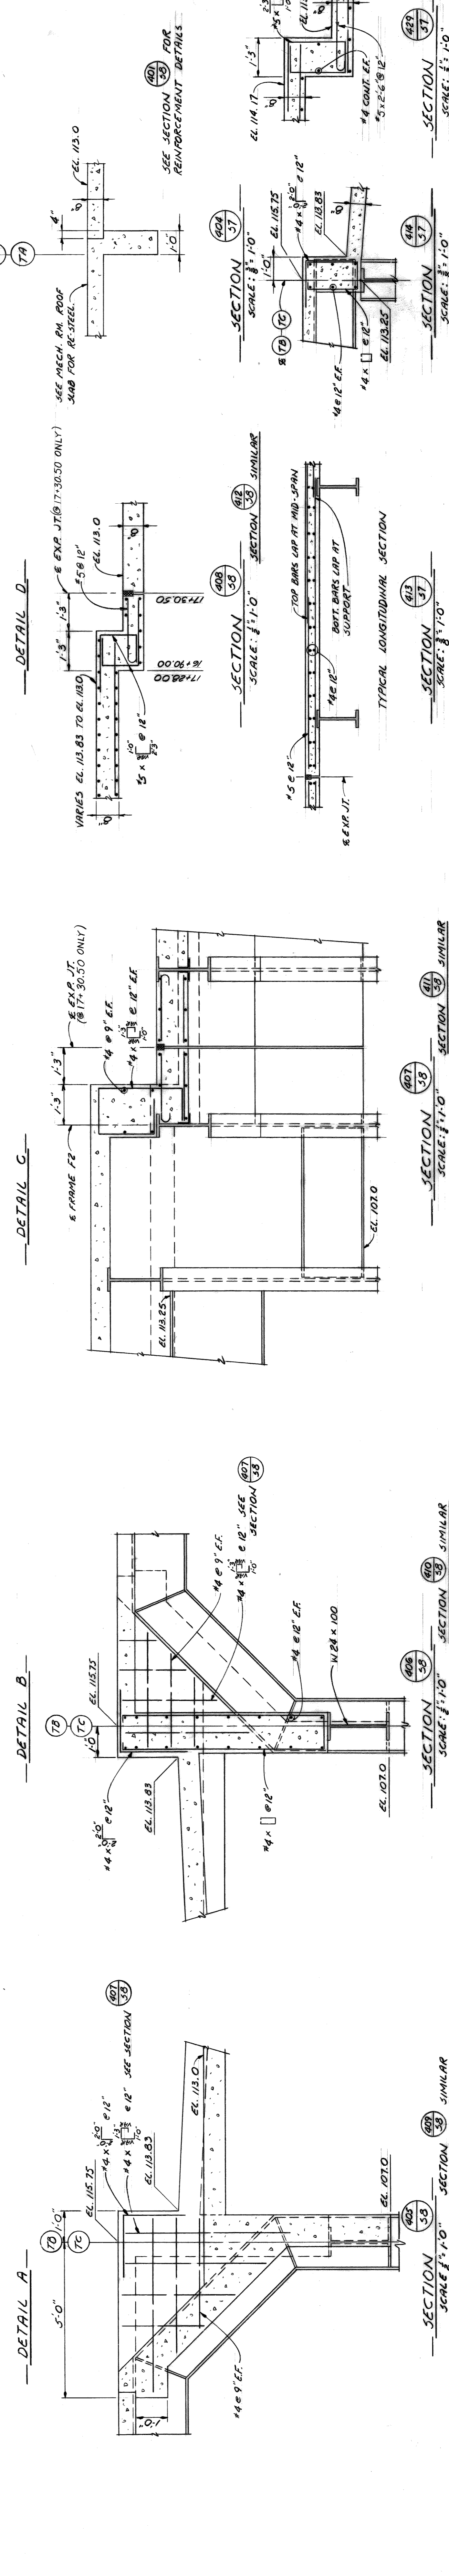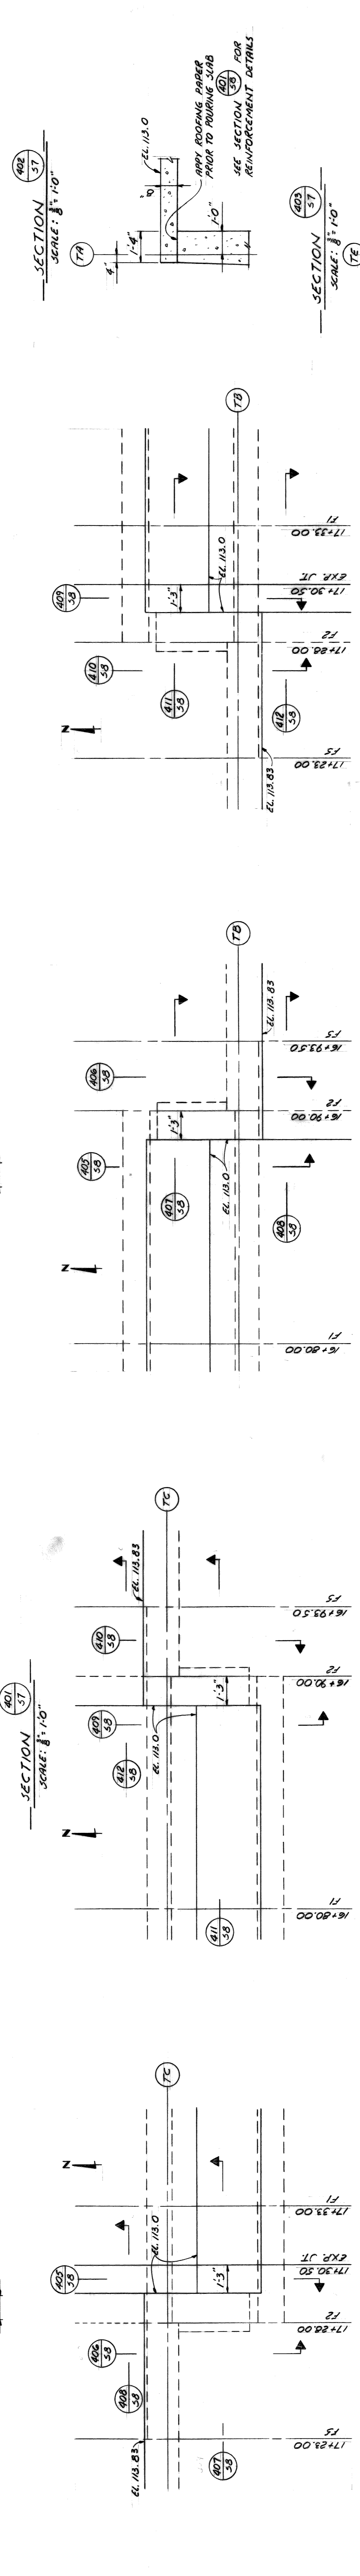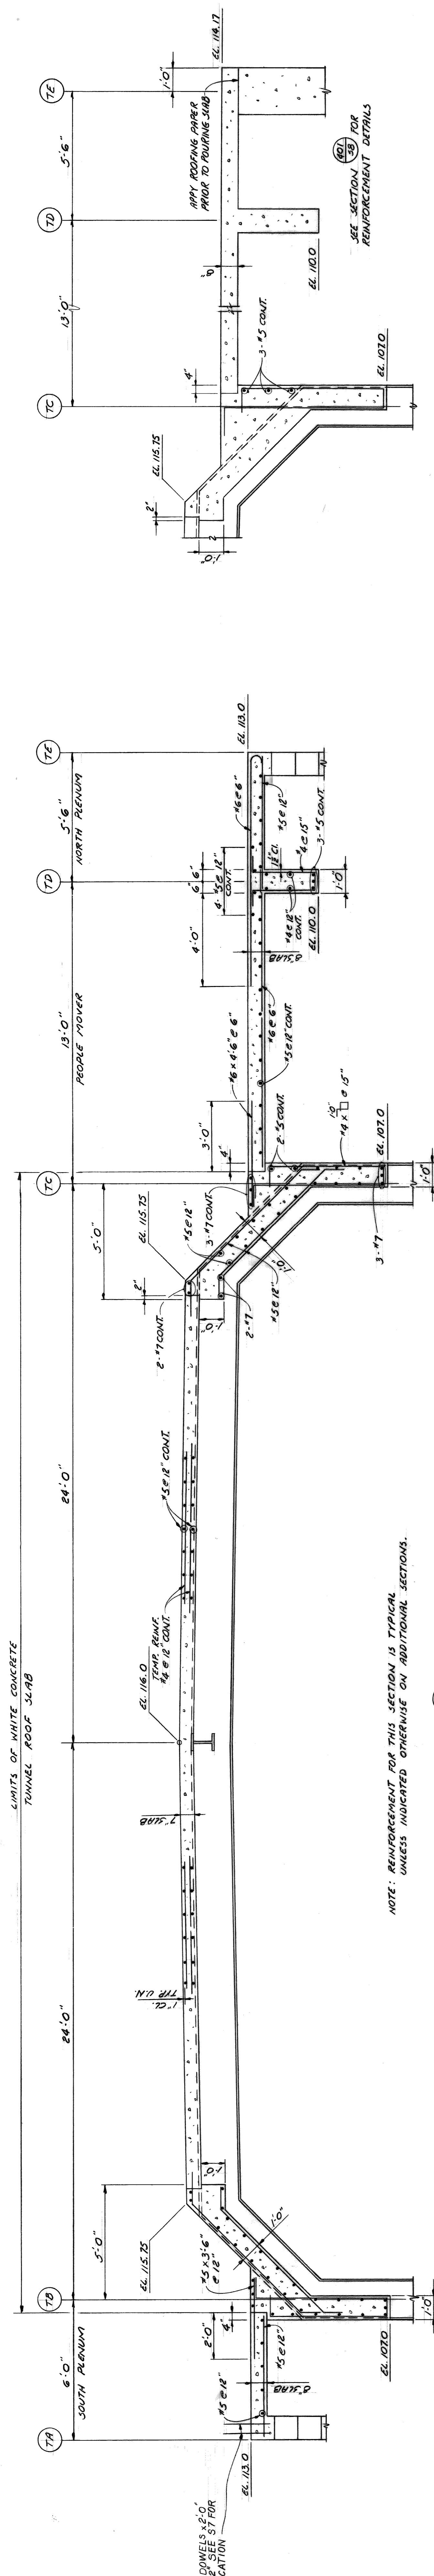

APPROVED

DESIGNED BY: R. BUICE

DRAWN BY: A. G.

CHECKED BY: R. B.

DATE: 8-11-75







CITY OF DETROIT
CITY ENGINEERING DEPARTMENT

ATWATER STREET RELOCATION
ATWATER TUNNEL





TUNNEL ROOF SLAB DETAILS

CONTRACT NO. 07105 A

SHEET 36 OF 51
DRAWING NO. S8

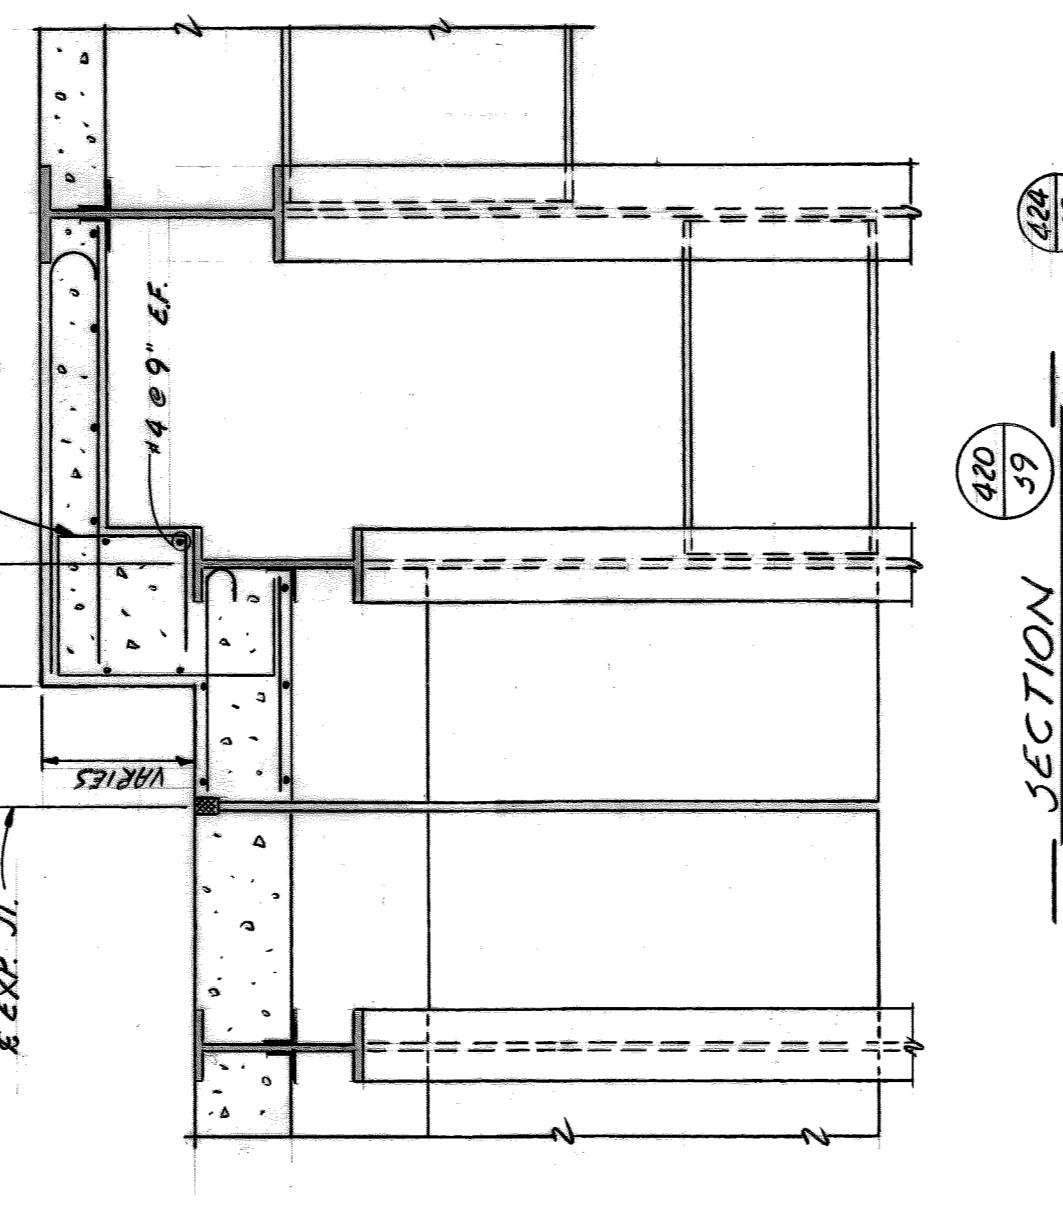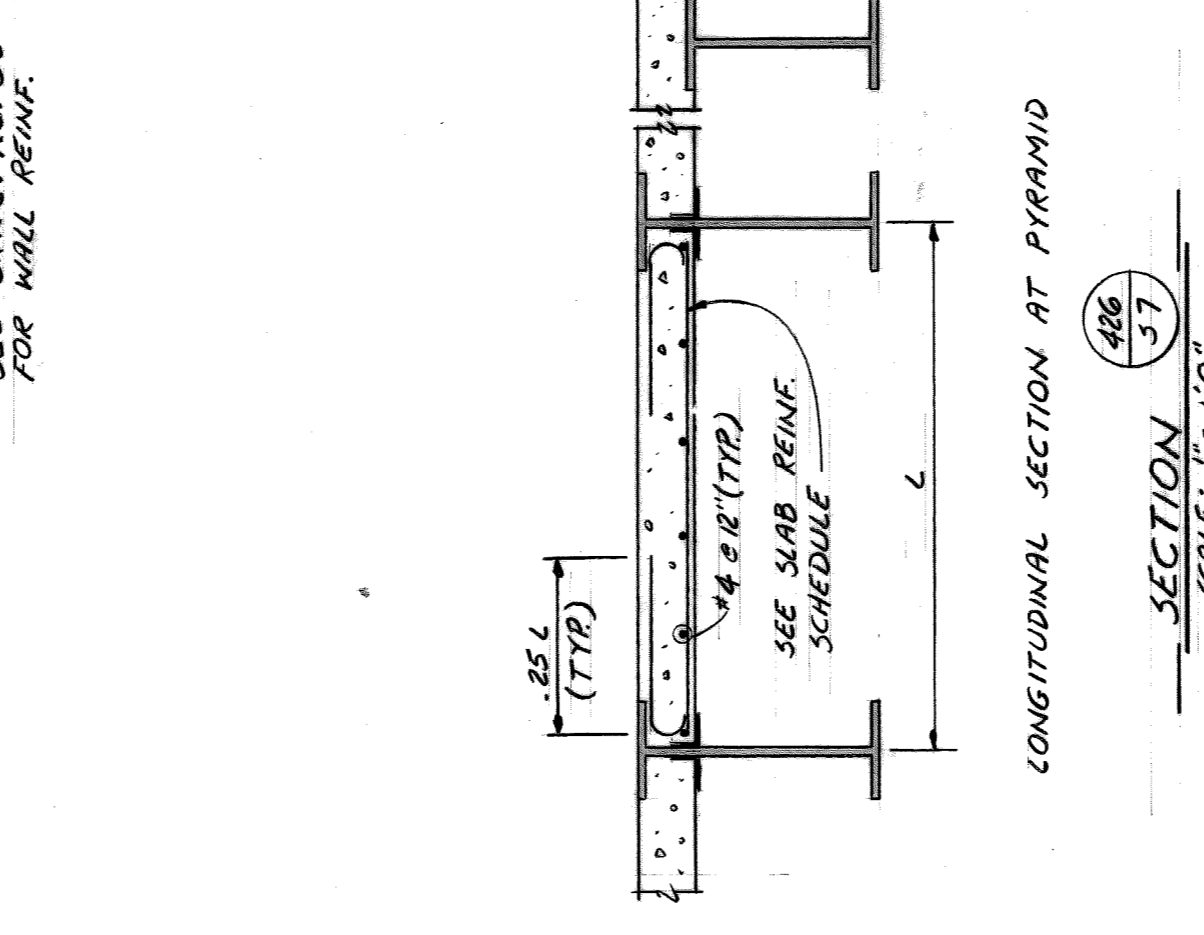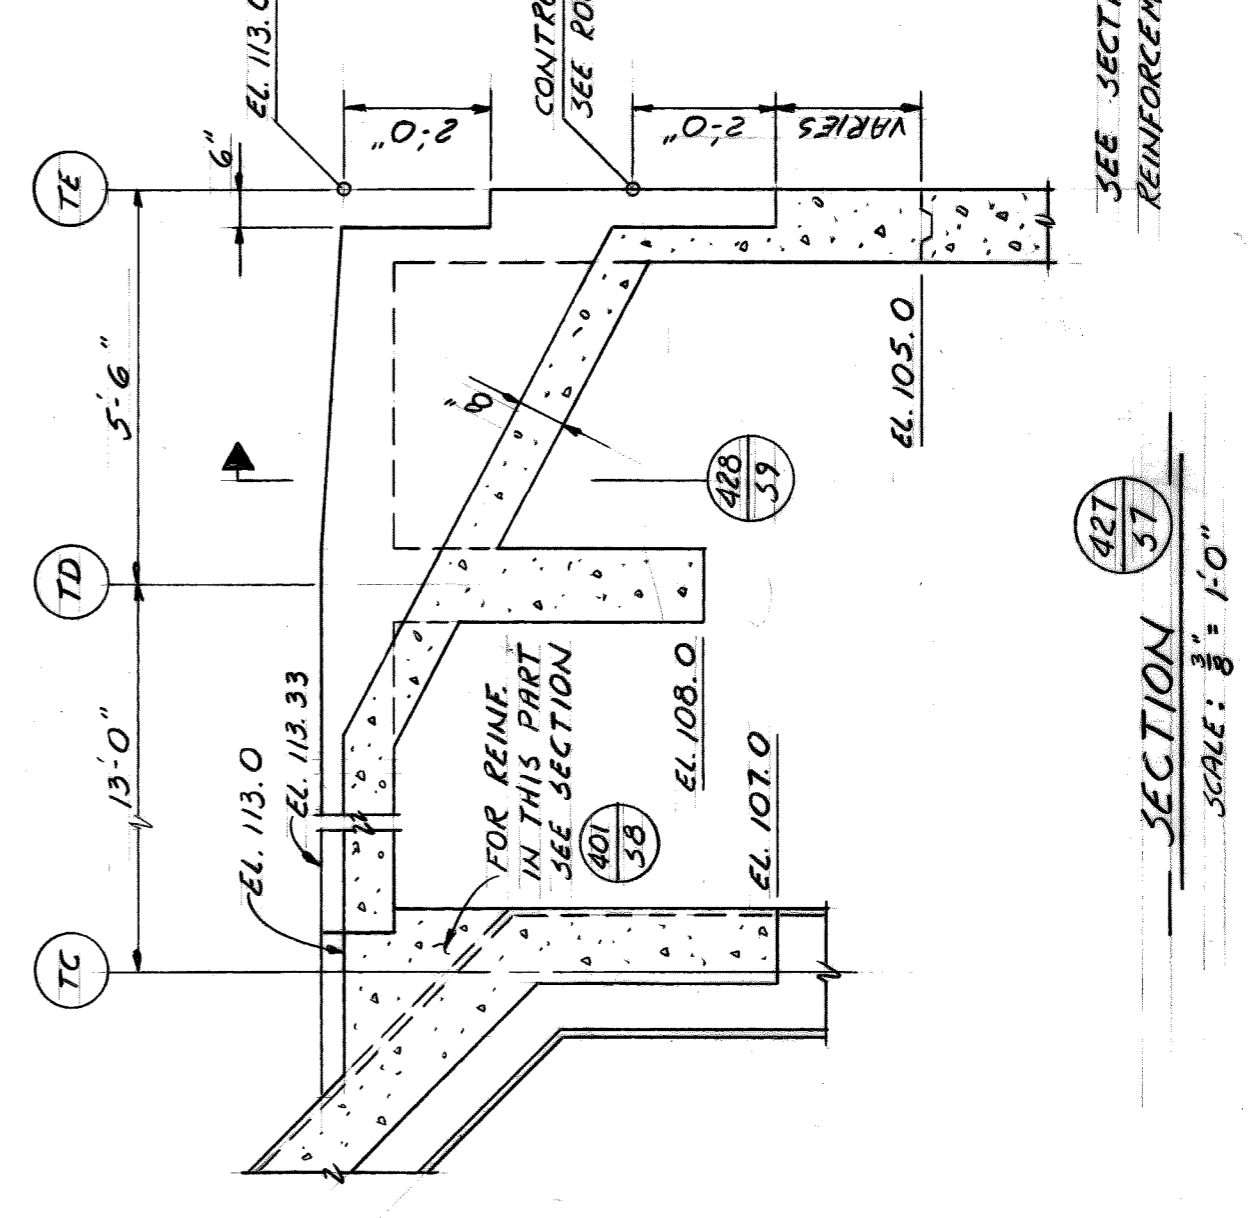
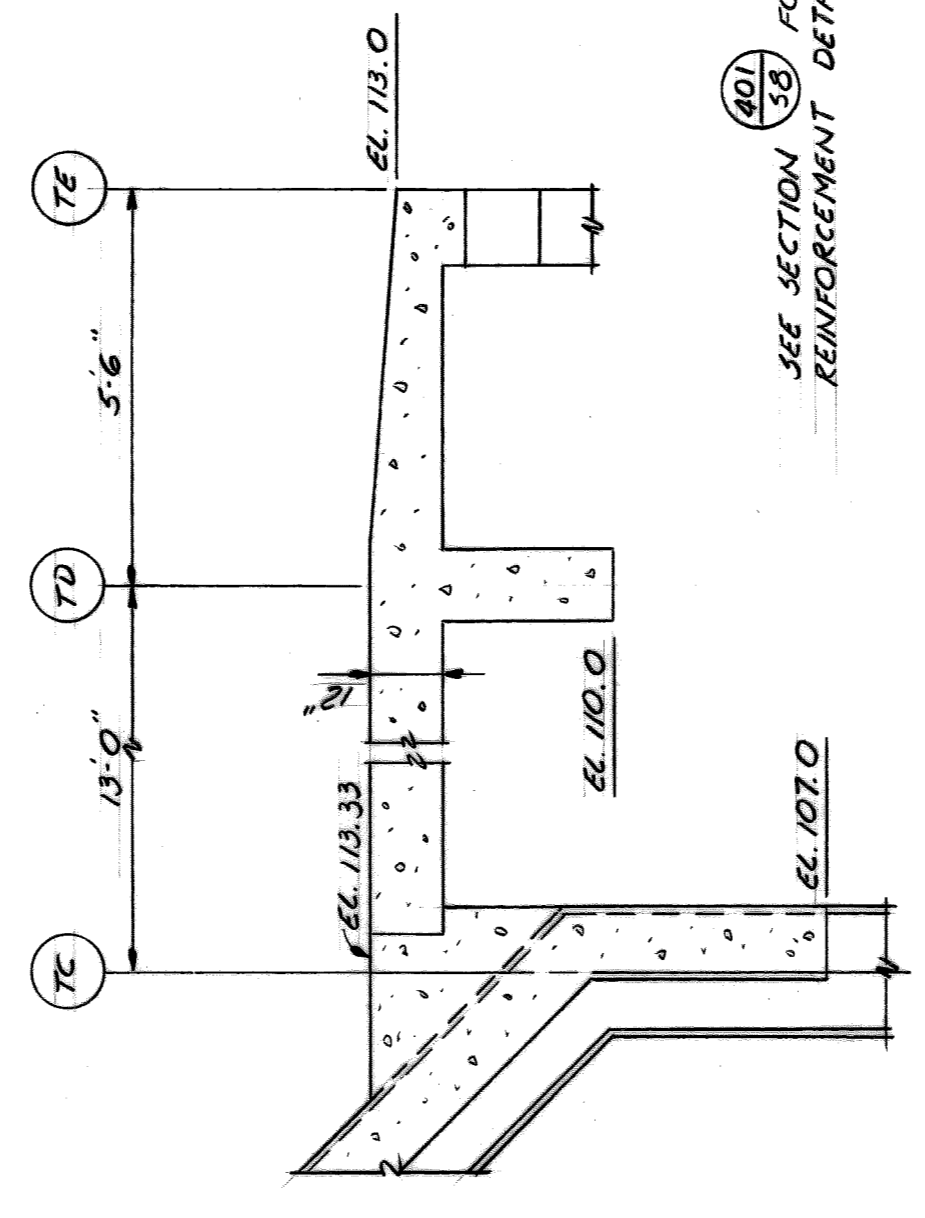
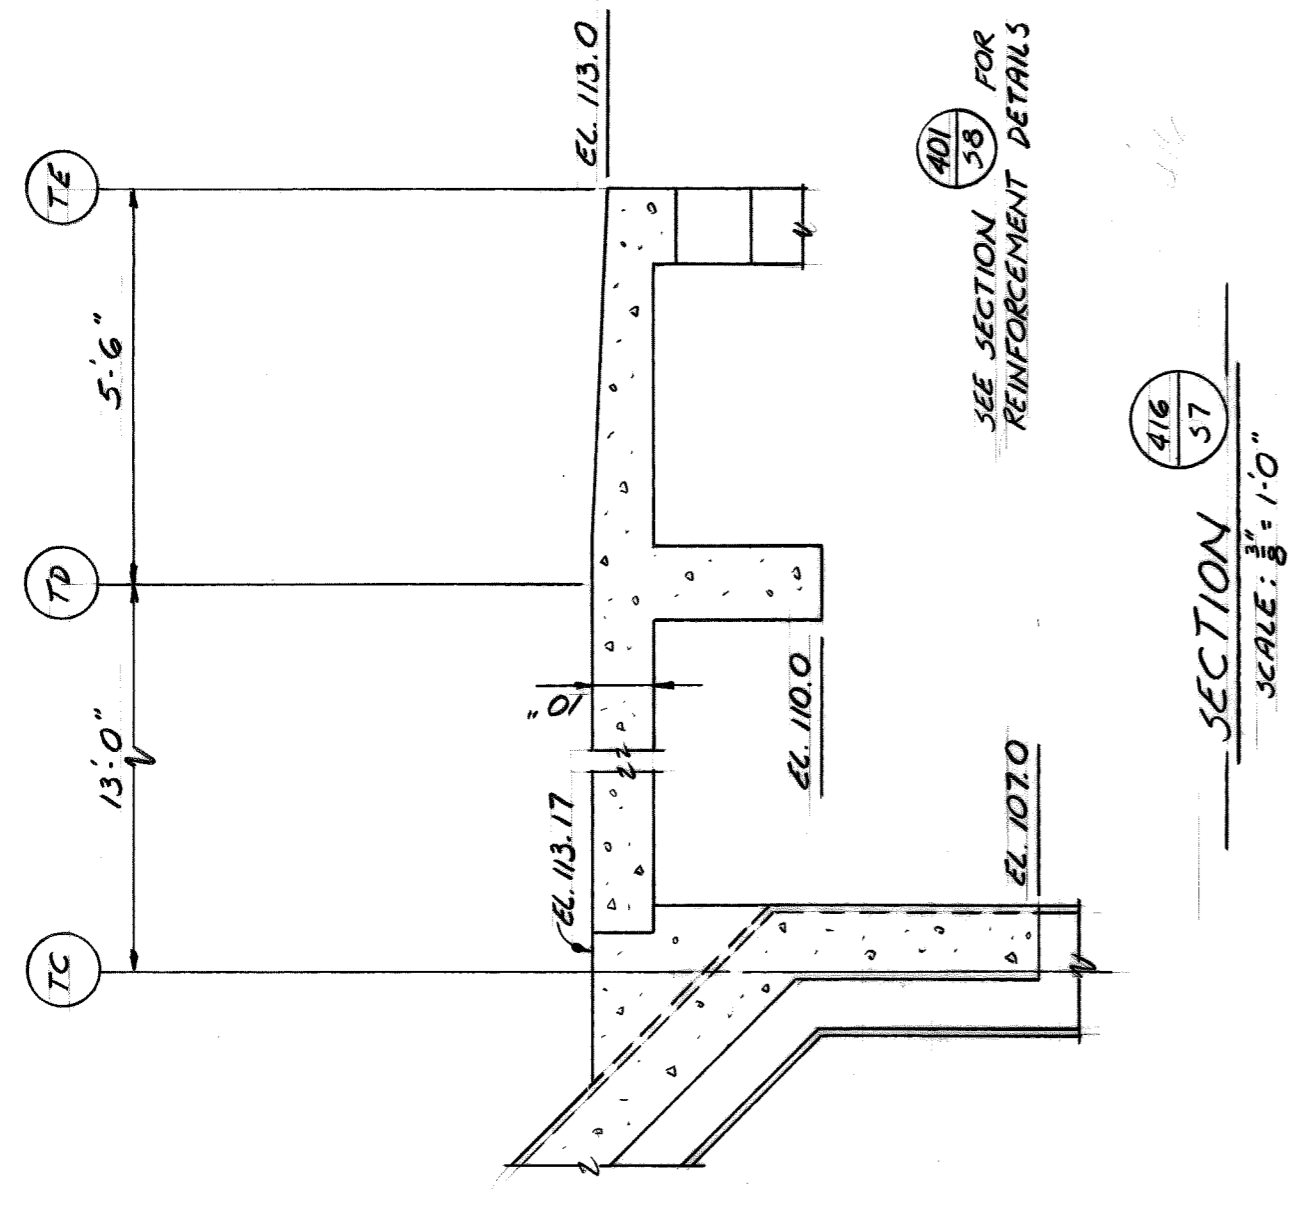
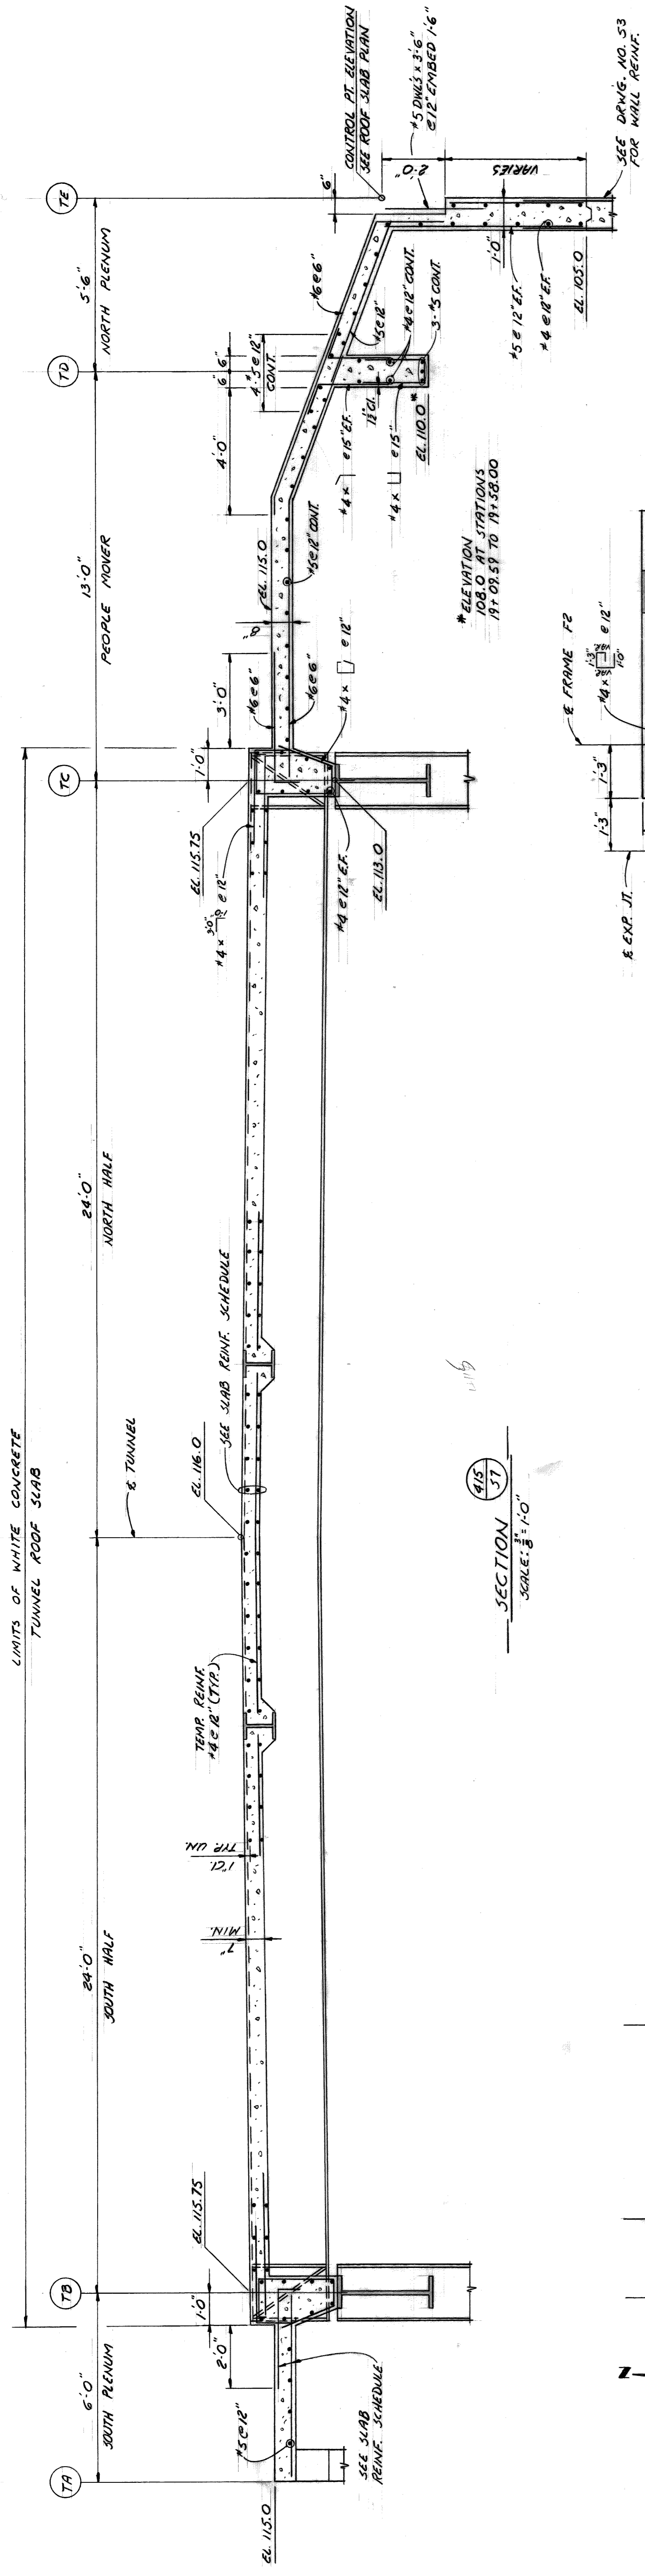


SLAB REINFORCEMENT SCHEDULE	LOCATION	SIZE/SPACING	STATION
TUNNEL ROOF	15' 0" 12" BOT	#5 @ 12"	14+51.34 TO 19+37.50
TUNNEL ROOF	15' 0" 12" TOP	#5 @ 12"	19+37.50 TO 19+91.23
TUNNEL ROOF	18' 0" 12" BOT	#5 @ 12"	19+91.23 TO 32.92 E.
TUNNEL ROOF	18' 0" 12" TOP	#5 @ 12"	32.92 E. TO 32.92 E.
TUNNEL ROOF	14' 0" 6" BOT	#5 @ 12"	19+91.23 TO 32.92 E.
TUNNEL ROOF	14' 0" 6" TOP	#5 @ 12"	32.92 E. TO 32.92 E.
SOUTH PLENUM	15' 0" 12" BOT	#5 @ 12"	14+51.34 TO 19+91.23
SOUTH PLENUM	15' 0" 12" TOP	#5 @ 12"	19+91.23 TO 32.92 E.
PEOPLE MOVER	16' 0" 6" BOT	#5 @ 12"	14+51.34 TO 32.92 E.
PEOPLE MOVER	16' 0" 6" TOP	#5 @ 12"	32.92 E. TO 32.92 E.
NORTH PLENUM	15' 0" 12" BOT	#5 @ 12"	14+51.34 TO 32.92 E.
NORTH PLENUM	15' 0" 12" TOP	#5 @ 12"	32.92 E. TO 32.92 E.

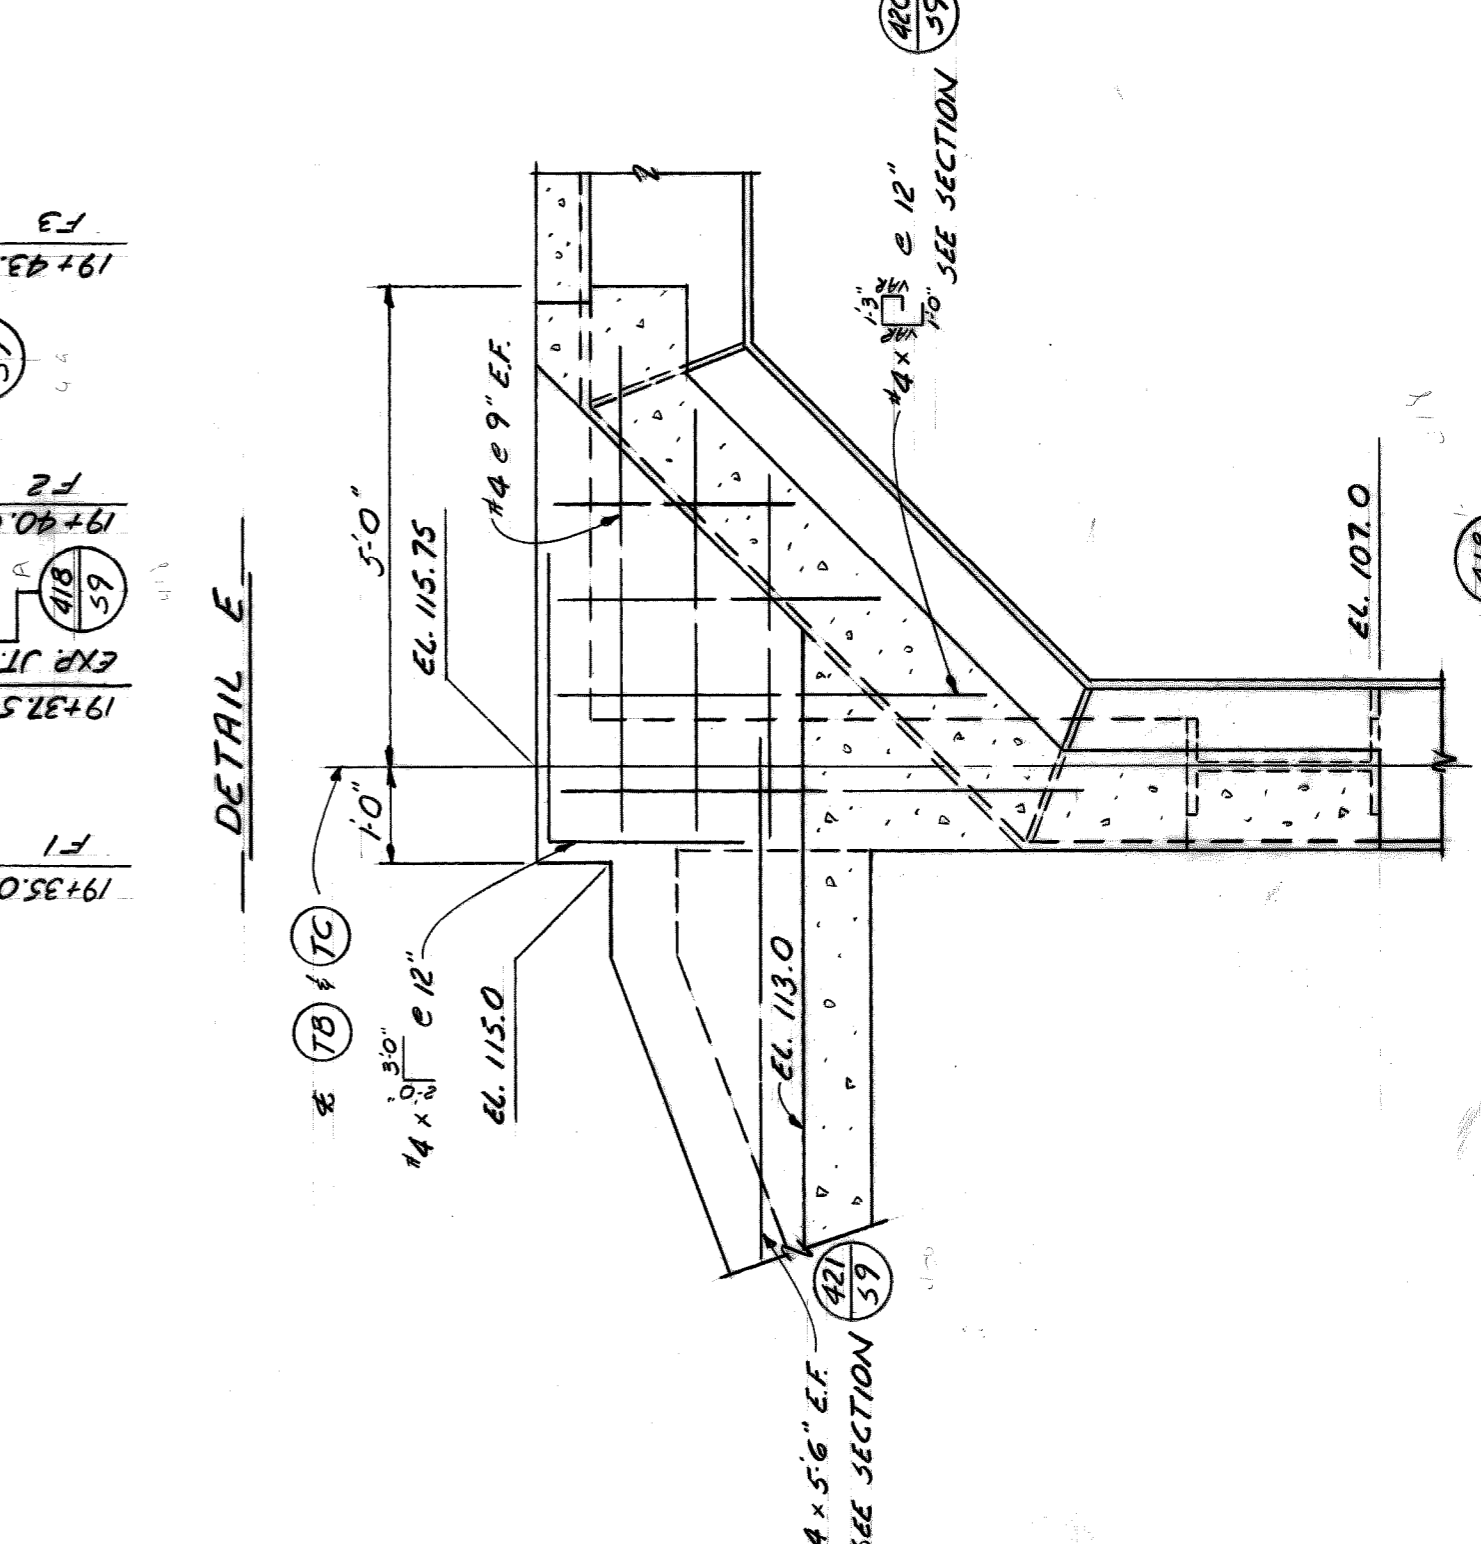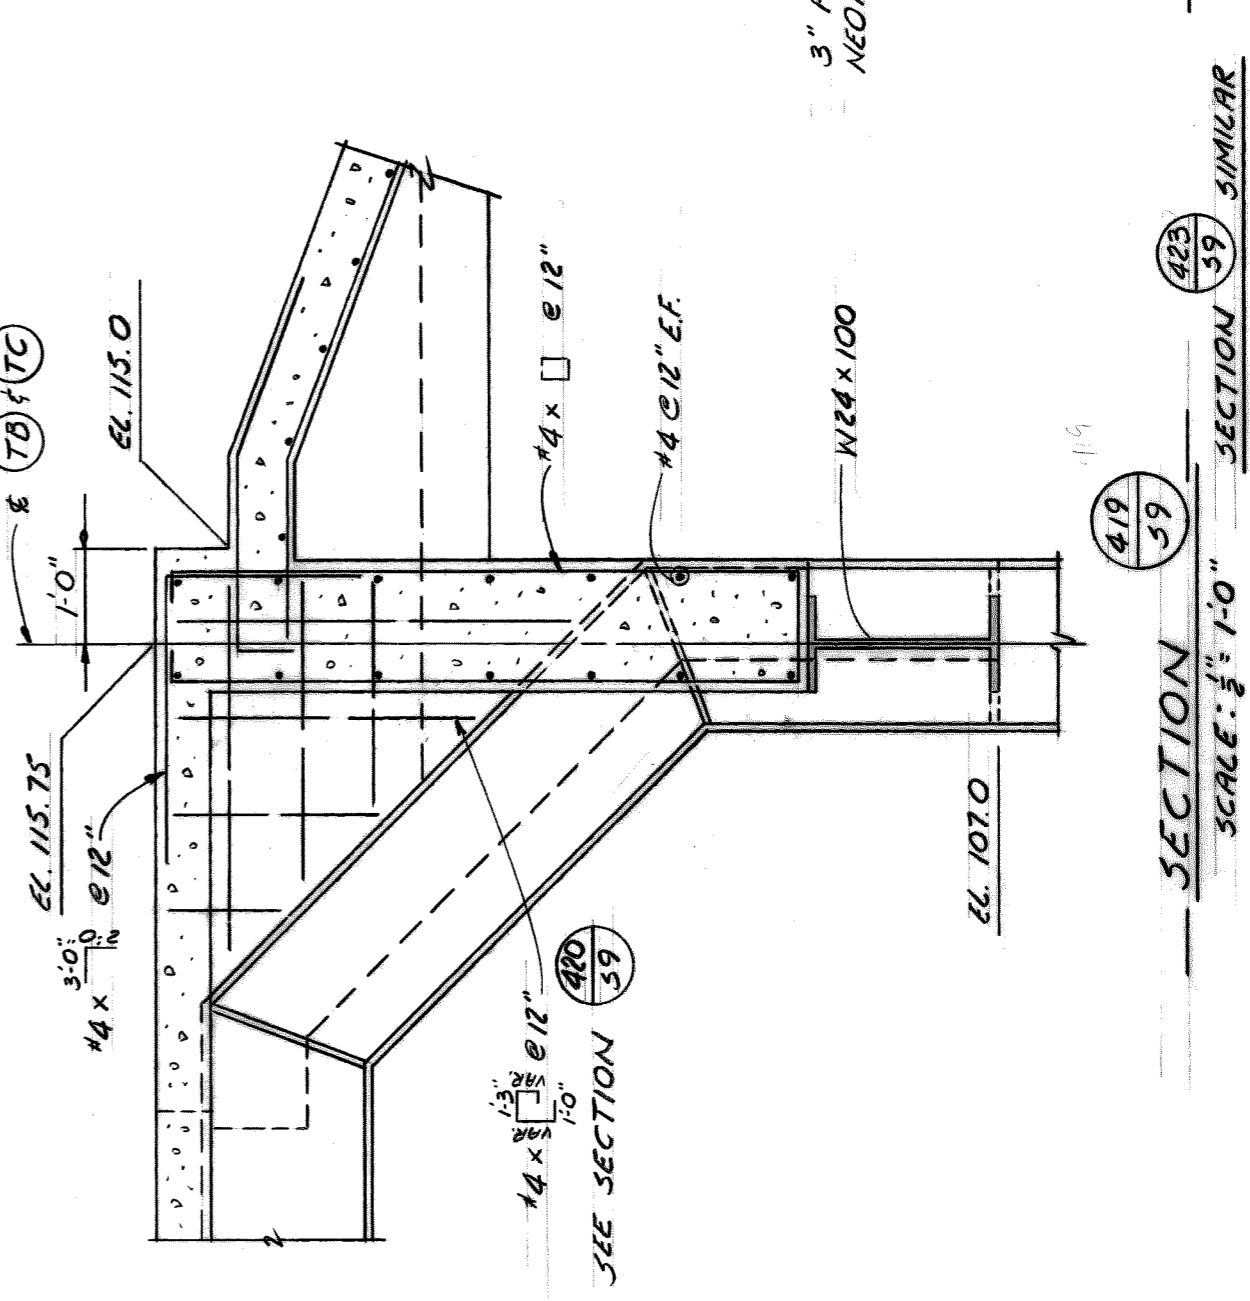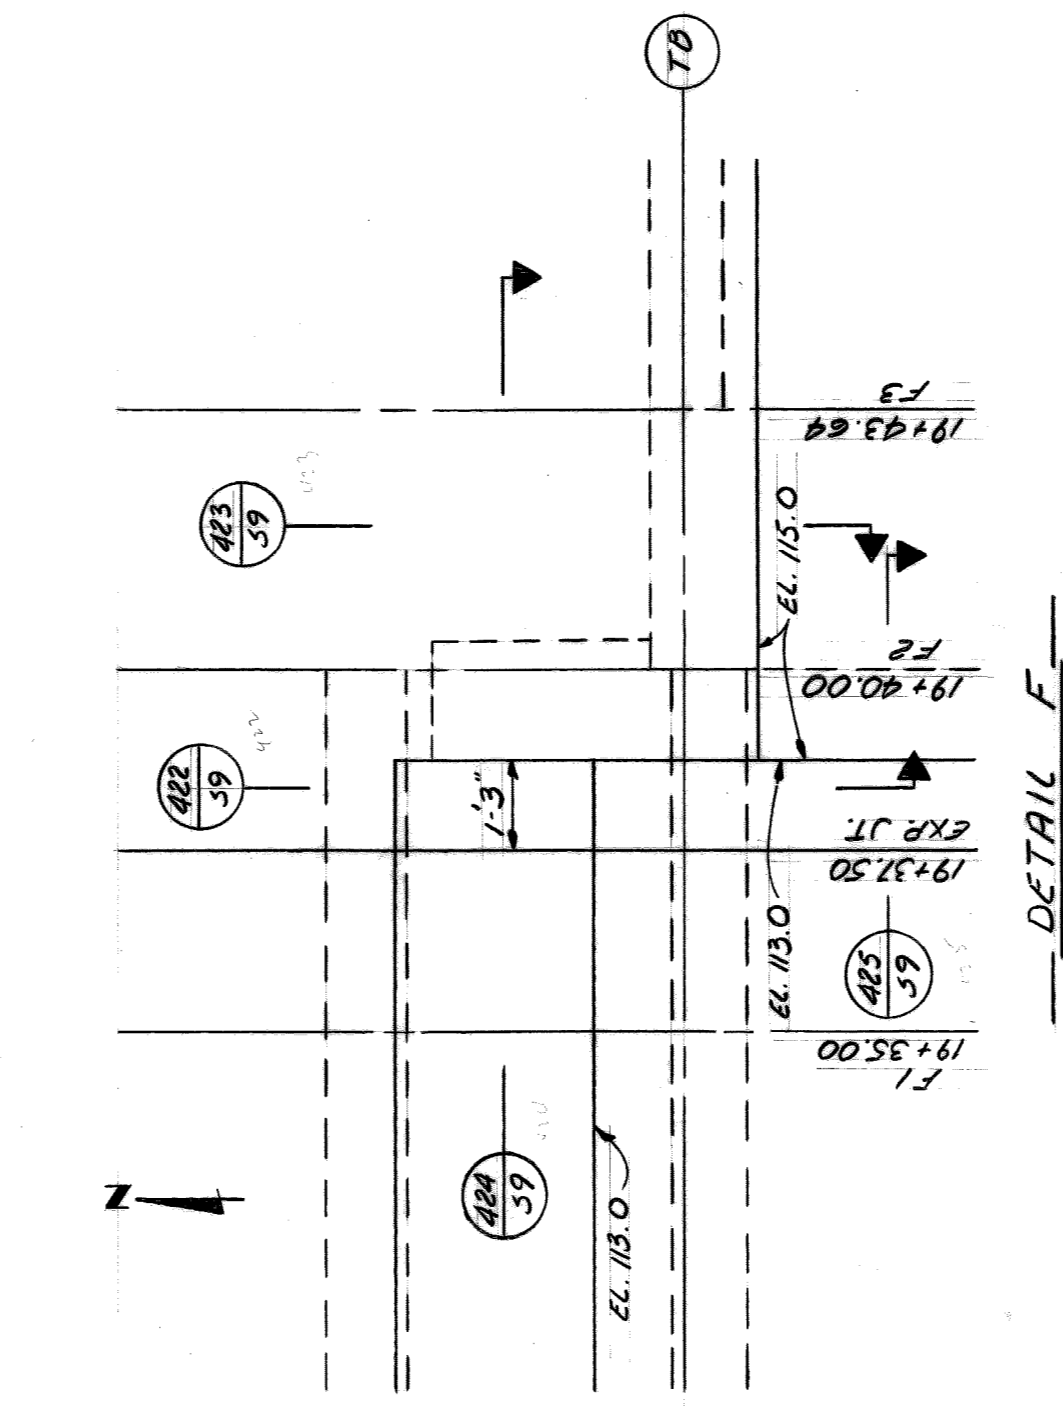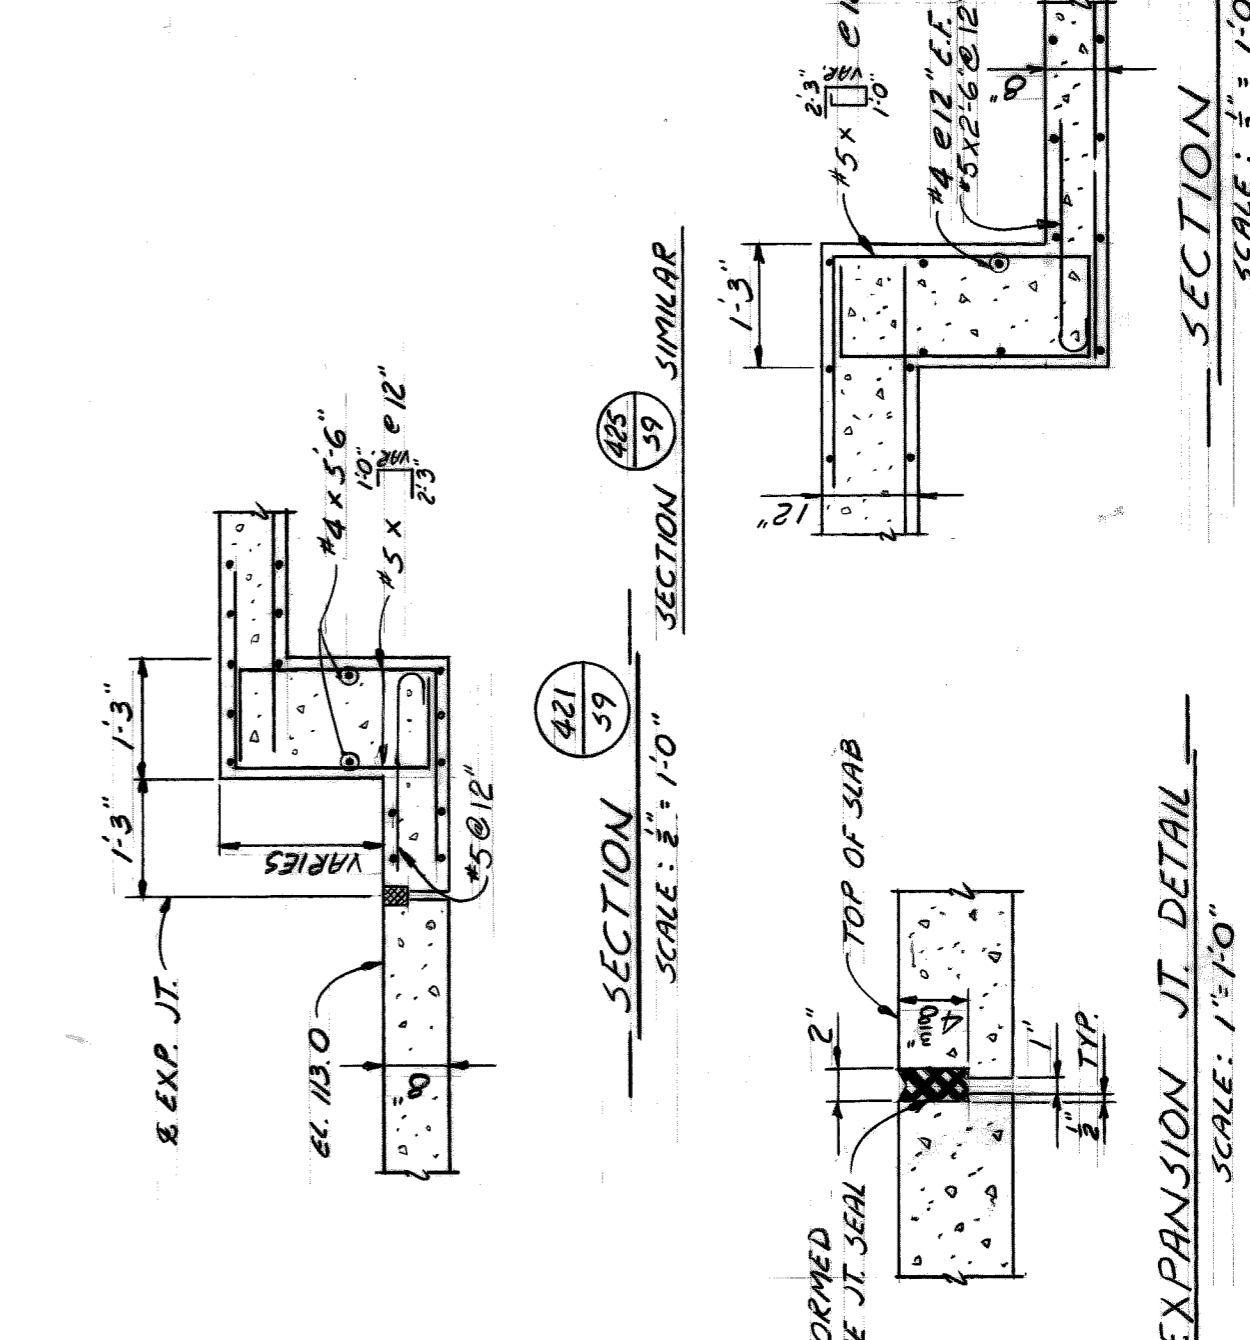

LIMITS OF WHITE CONCRETE TUNNEL ROOF SLAB

contract no. 07105A
ATWATER STREET RELOCATION AT WATER TUNNEL
TUNNEL ROOF SLAB DETAILS
CITY OF DETROIT CITY ENGINEERING DEPARTMENT
 approved **T. E. M. S. J. A.** STRUCTURAL ENGINEER
 date **8-11-75** designed **R. B. GUNNE**
 drawn **A. G.** checked **R. B.**
drawing no: S 9
sheet 27 of 61
 revisions

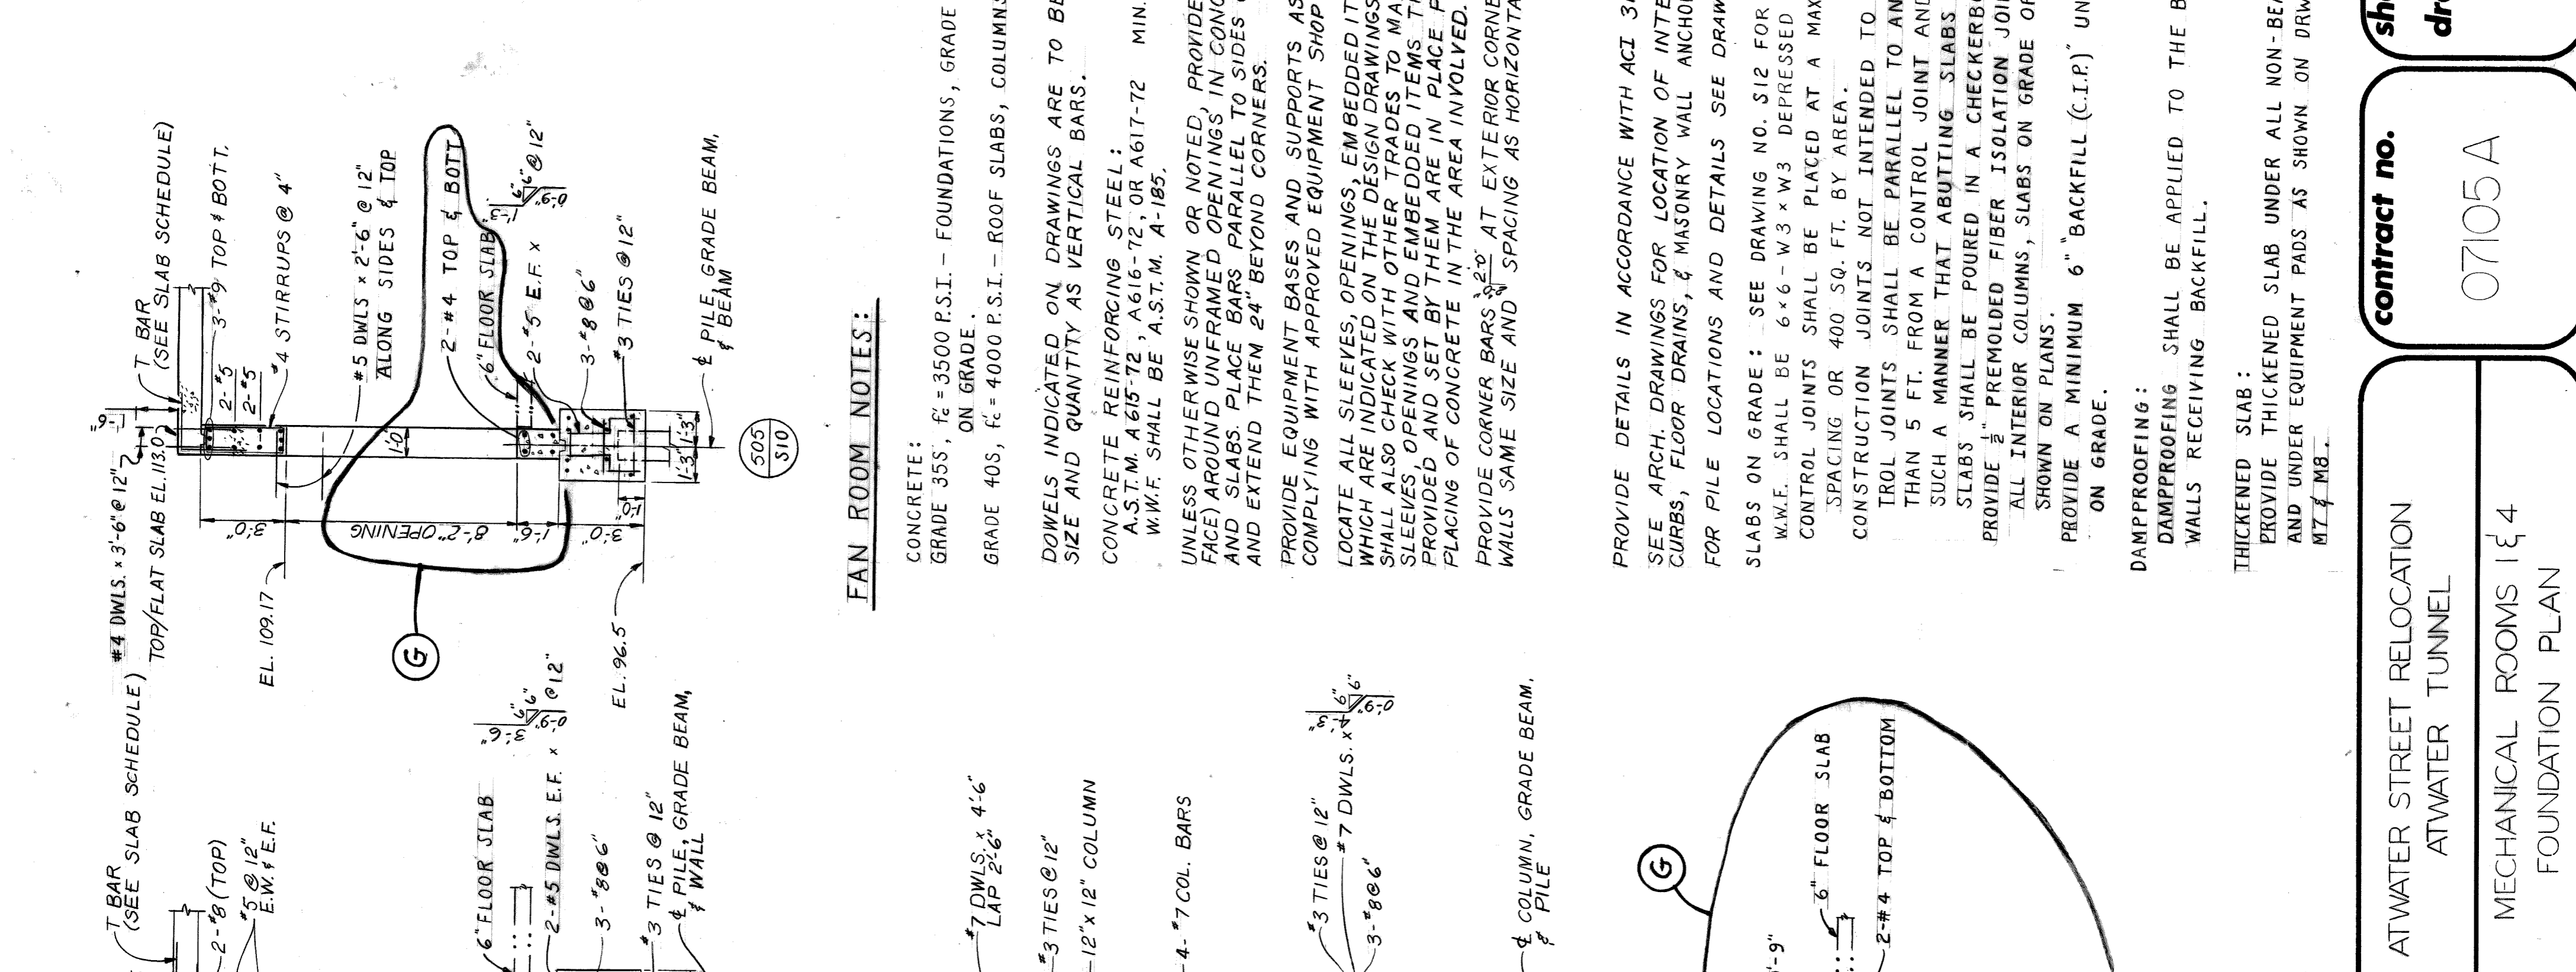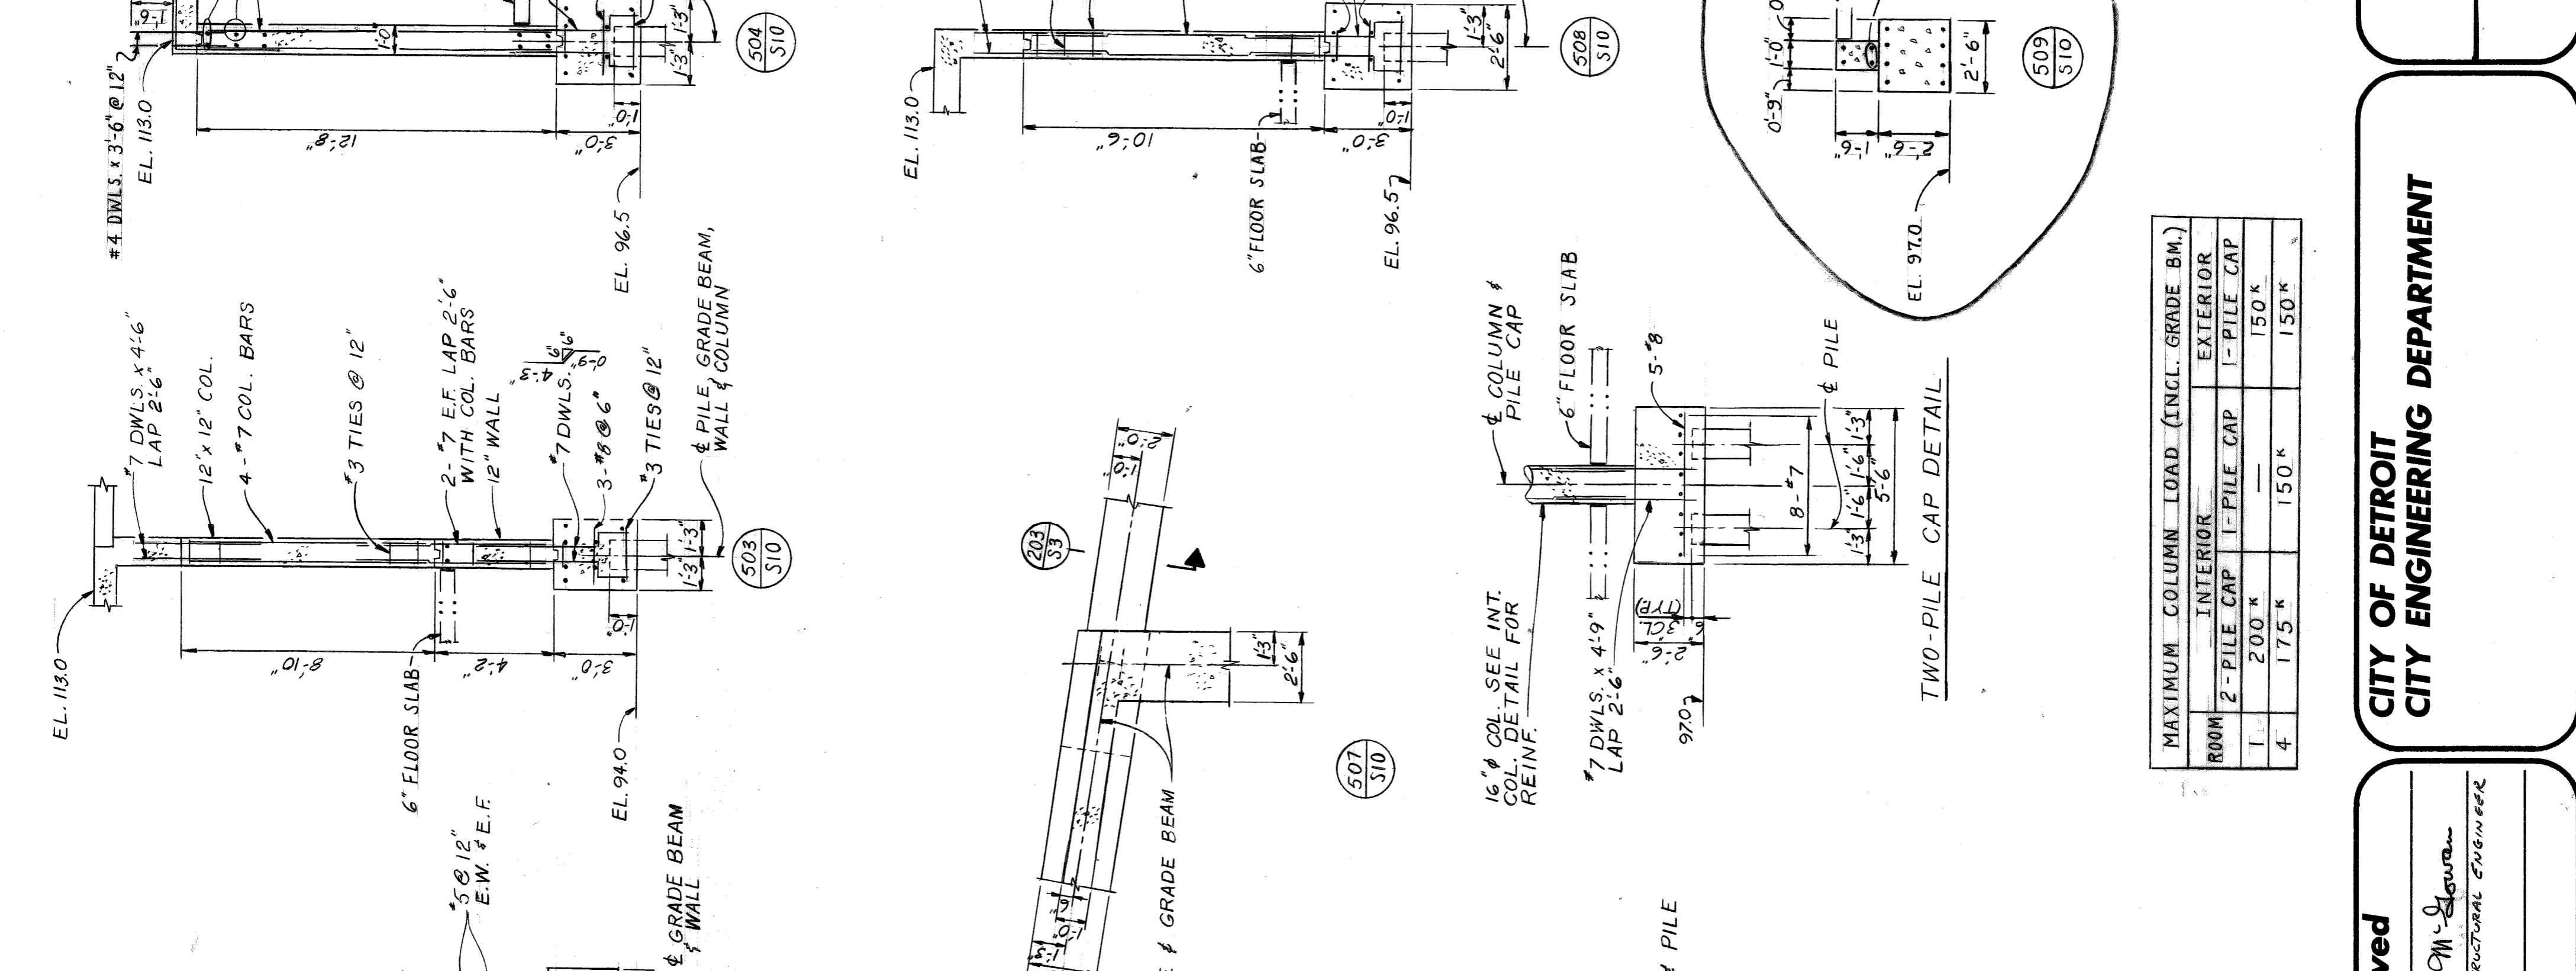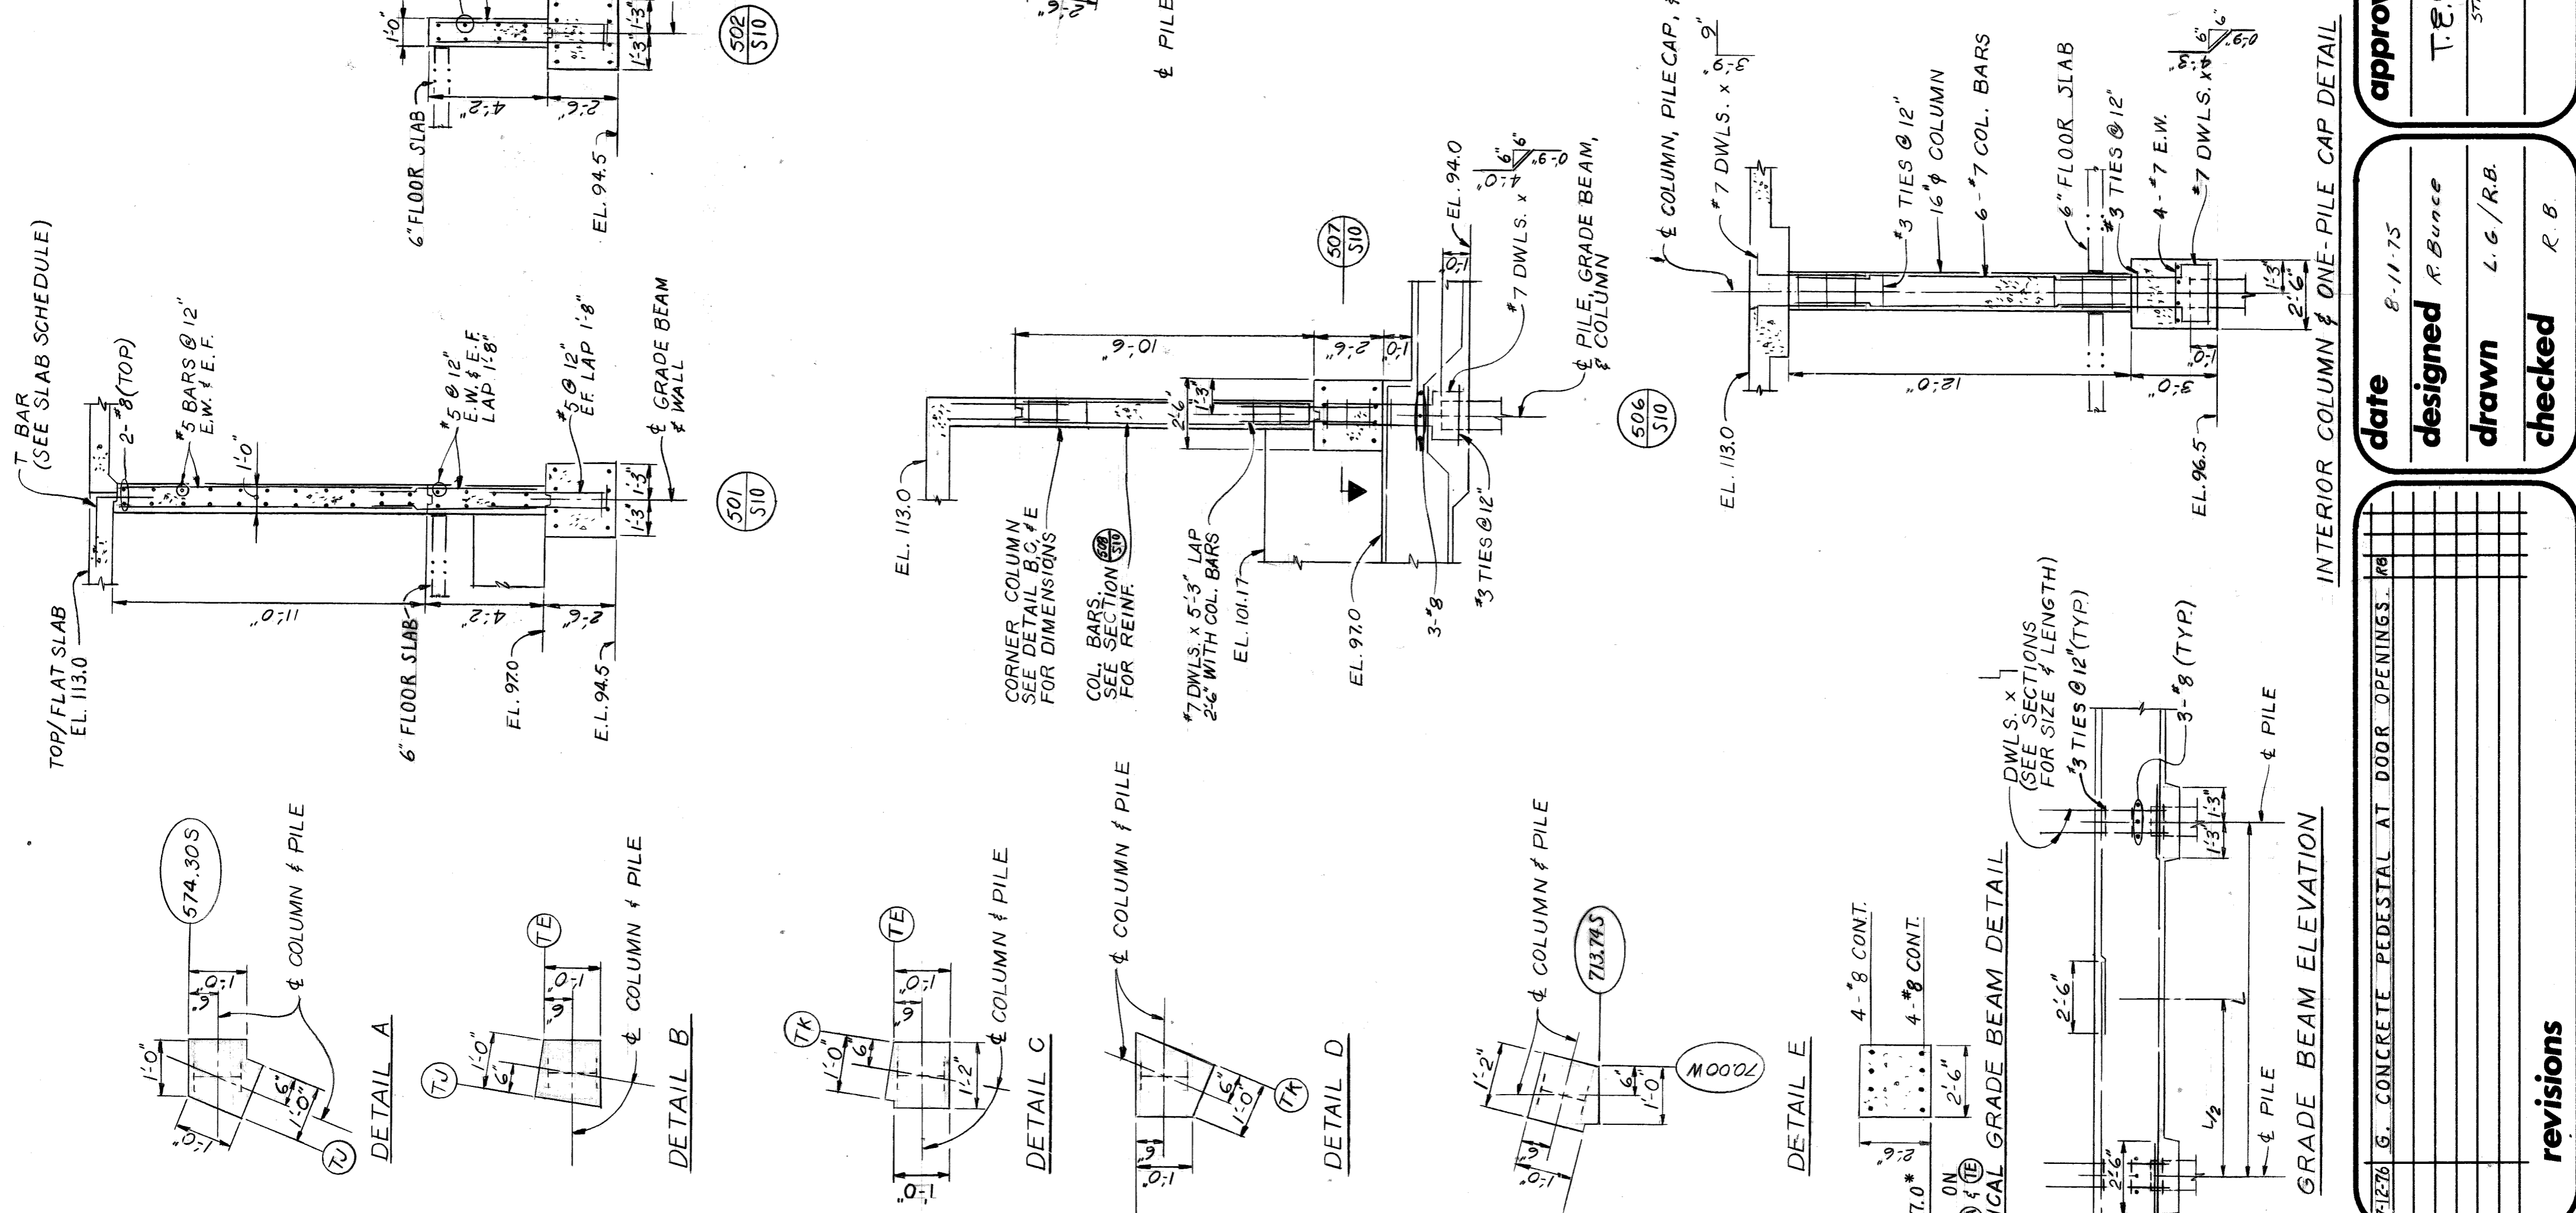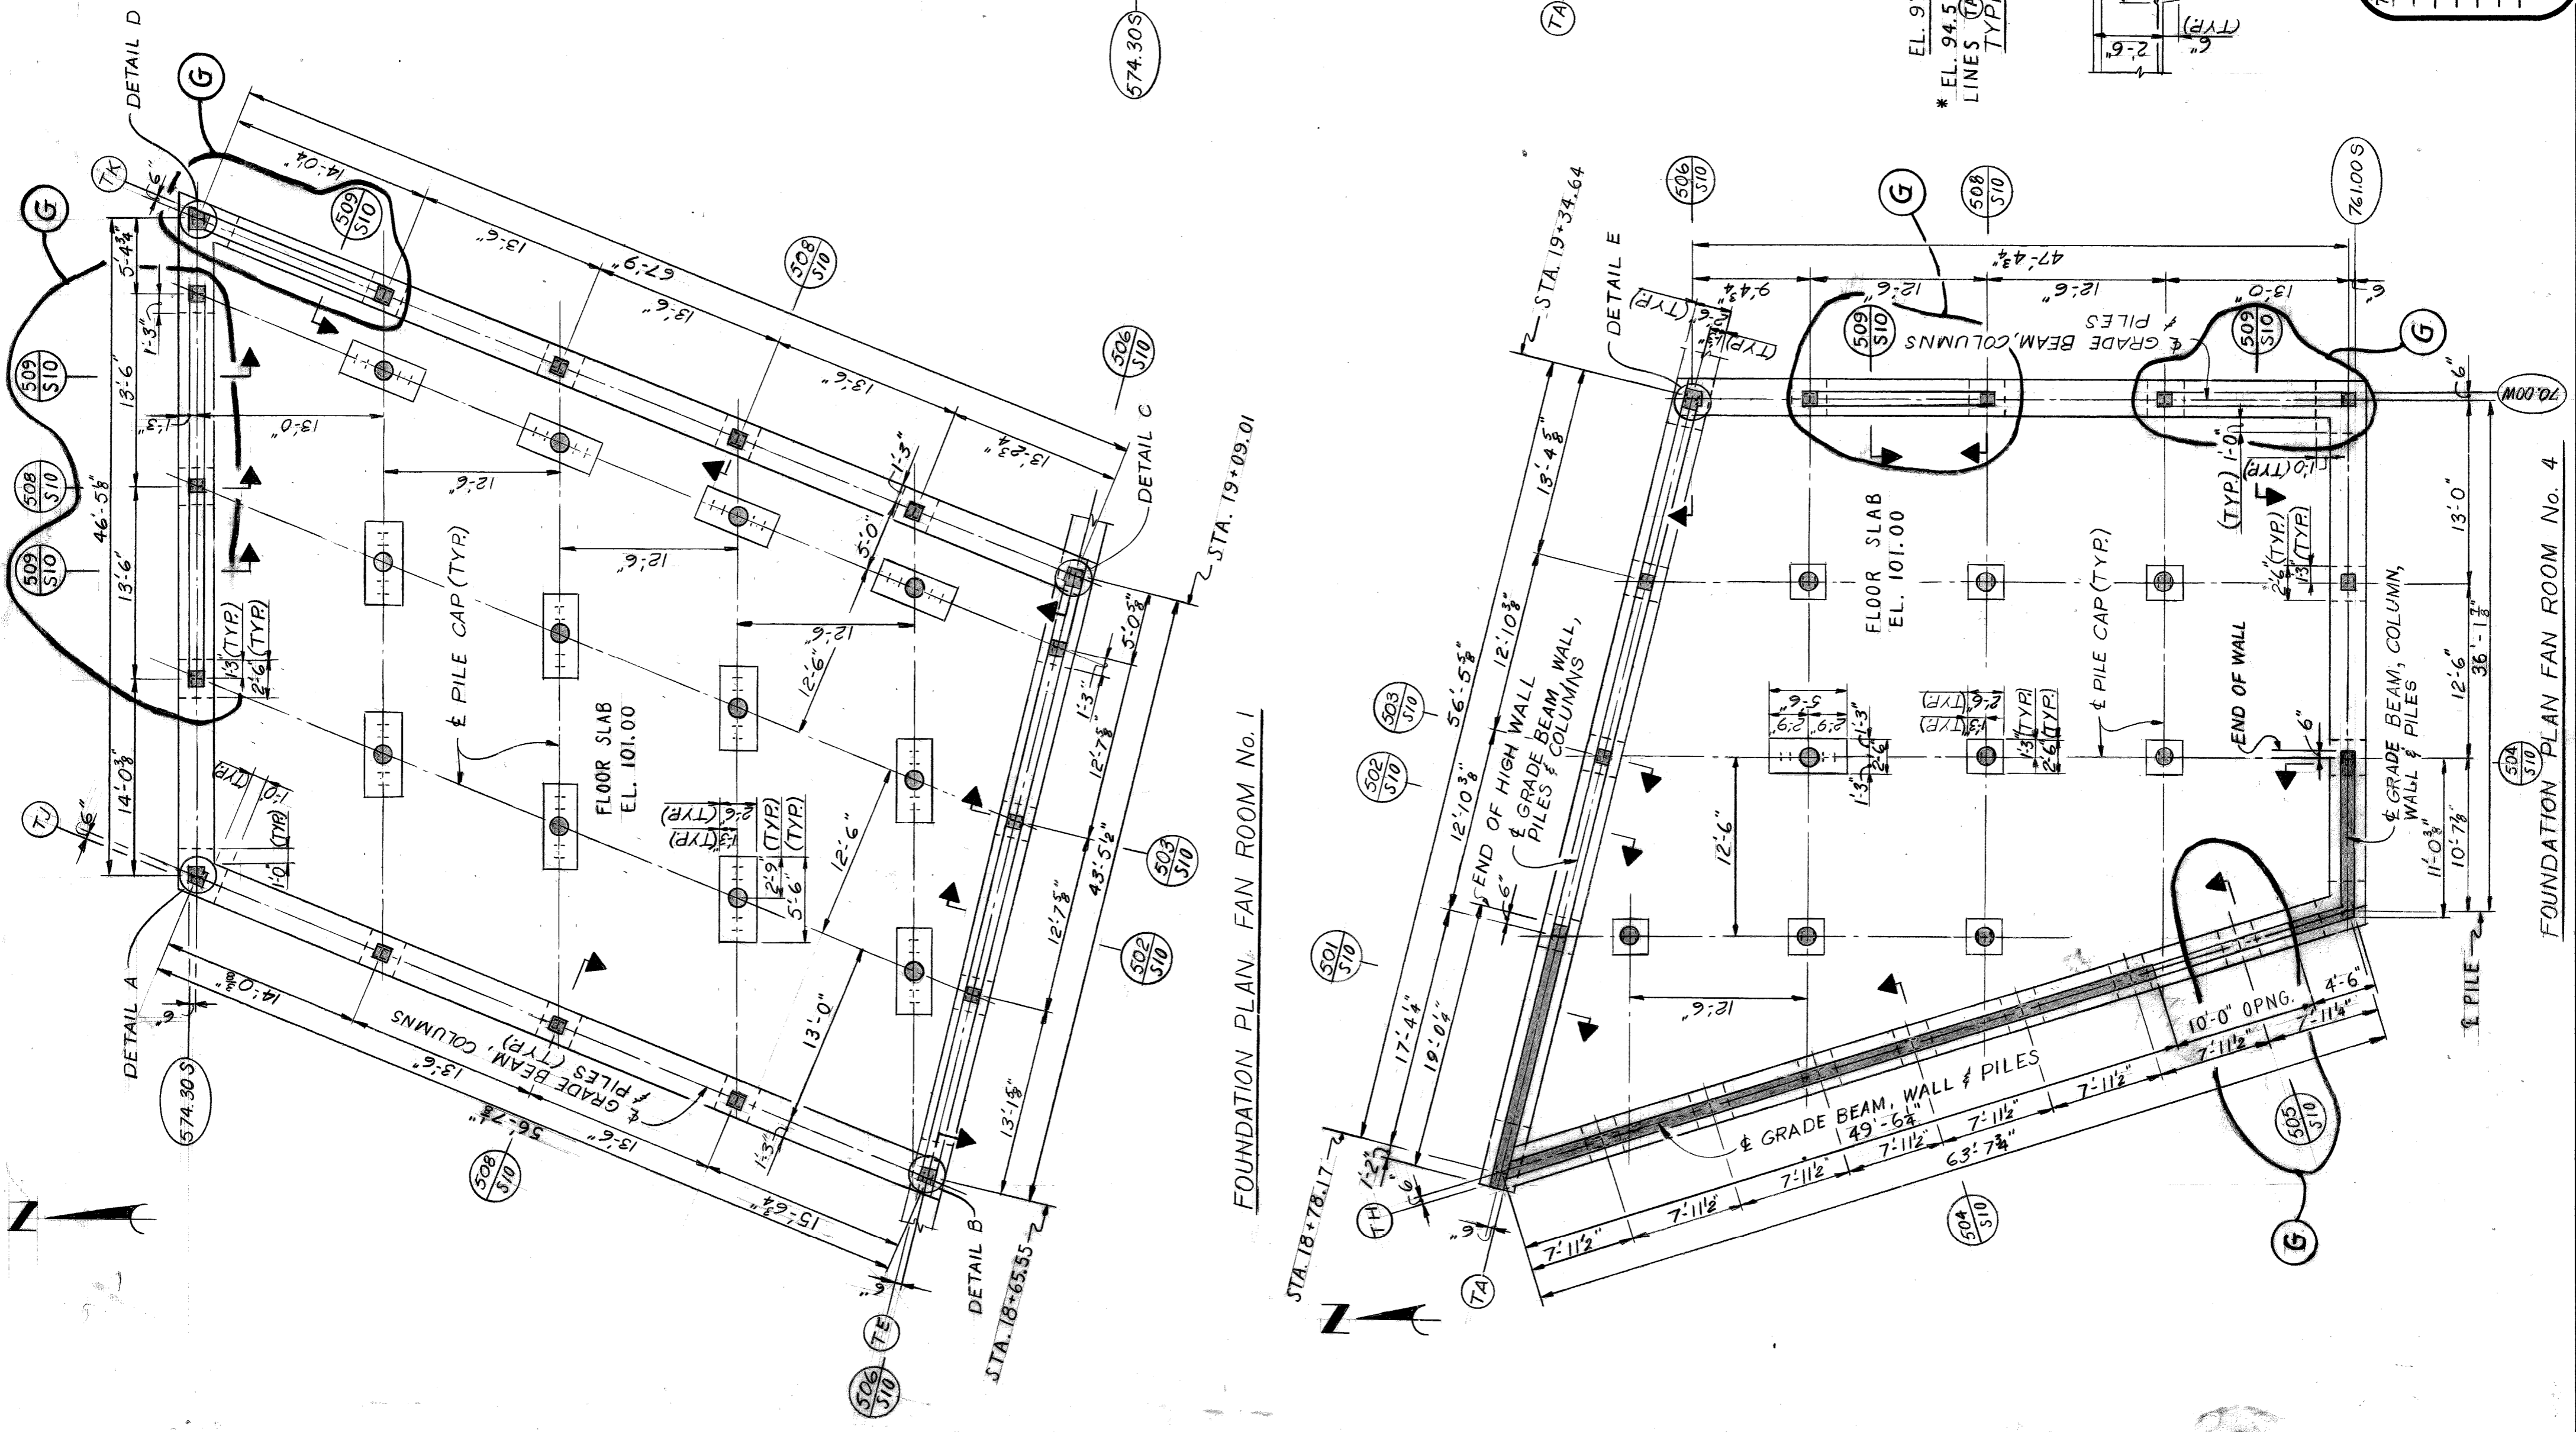

FAN ROOM NOTES:

CONCRETE: GRADE 355, $f_c = 3500$ P.S.I. - FOUNDATIONS, GRADE BEAMS, & SLABS. GRADE 405, $f_c = 4000$ P.S.I. - ROOF SLABS, COLUMNS, & CONC. WALLS.

DOWELS INDICATED ON DRAWINGS ARE TO BE OF SAME SIZE AND QUANTITY AS VERTICAL BARS.

CONCRETE REINFORCING STEEL: A.S.T.M. A615-72 AS-1172, OR A617-72 MIN. YIELD 60,000 P.S.I. W.W.F. SHALL BE A.S.T.M. A-165.

UNLESS OTHERWISE SHOWN OR NOTED, PROVIDE 2-5 (EACH FACE) AROUND UNFRAMED OPENINGS IN CONCRETE WALLS AND SLABS. PLACE BARS PARALLEL TO SIDES OF OPENINGS AND EXTEND THEM 24 BEYOND CORNERS.

PROVIDE EQUIPMENT BASES AND SUPPORTS AS REQUIRED COMPLYING WITH APPROVED EQUIPMENT SHOP DRAWINGS.

LOCATE ALL SLEEVES, OPENINGS, EMBEDDED ITEMS, ETC. WHICH ARE INDICATED ON THE DESIGN DRAWINGS. THE CONTRACTOR SHALL ALSO CHECK THE DESIGN DRAWINGS TO MAKE SURE THE SLEEVES, OPENINGS AND EMBEDDED ITEMS ARE TO BE PROVIDED AND SET BY THEM ARE IN PLACE PRIOR TO THE PLACING OF CONCRETE IN THE AREA INVOLVED.

PROVIDE CORNER BARS AT EXTERIOR CORNERS OF CONCRETE WALLS SAME SIZE AND SPACING AS HORIZONTAL REINFORCEMENT.

PROVIDE DETAILS IN ACCORDANCE WITH ACT 315-74. SEE ARCH. DRAWINGS FOR LOCATION OF INTERIOR WALLS, CURBS, FLOOR DRAINS, & MASONRY WALL ANCHOR DETAILS. FOR PILE LOCATIONS AND DETAILS SEE DRAWING NO. S1.

SLABS ON GRADE: SEE DRAWING NO. S12 FOR DETAILS. W.W.F. SHALL BE 6-6 x 3 x 3 x 3 DERESSED 1/2 FROM TOP. CONTROL JOINTS SHALL BE PLACED AT A MAXIMUM OF 25' SPACING OR 400 SQ. FT. BY AREA.

CONSTRUCTION JOINTS NOT INTENDED TO ACT AS CONTROL JOINTS SHALL BE PARALLEL TO AND NOT LESS THAN 5 FT. FROM A CONTROL JOINT AND CAST IN SUCH A MANNER THAT ABUTTING SLABS ARE BONDED. SLABS SHALL BE POURED IN A CHECKERBOARD FASHION. PROVIDE 1/2" PREMOULDED FIBER ISOLATION JOINTS AROUND ALL INTERIOR COLUMNS, SLABS ON GRADE OR WHERE ELSE SHOWN ON PLANS.

PROVIDE A MINIMUM 6" BACKFILL (C.I.P.) UNDER ALL SLABS ON GRADE.

DAMP PROOFING: DAMPROOFING SHALL BE APPLIED TO THE BACK OF ALL WALLS RECEIVING BACKFILL.

THICKENED SLAB: PROVIDE THICKENED SLAB UNDER ALL NON-BEARING WALLS AND UNDER EQUIPMENT PADS AS SHOWN ON DRWS. AS, AG, BTZ & H.

ROOM	INTERIOR	EXTERIOR
1	200 K	150 K
4	175 K	150 K

revisions

NO.	DATE	BY	REVISION

approved 6-11-75
T. E. M. G. *Structural Engineer*

designed R. Buice

drawn L. G. / R. B.

checked R. B.

contract no. 07105 A

sheet 38 of 81

drawing no. S10

CITY OF DETROIT
CITY ENGINEERING DEPARTMENT

AT WATER STREET RELOCATION
AT WATER TUNNEL

MECHANICAL ROOMS 1 & 4
FOUNDATION PLAN


FOUNDATION PLAN FAN ROOM No. 4

SLAB SCHEDULE

BOTTOM BARS			TOP BARS		
MARK	SIZE	NO.	MARK	SIZE	NO.
B1	#4	9	T1	#4	4
B2	#4	4	T2	#4	5
B3	#5	4	T3	#4	3
B4	#5	4	T4	#4	7
B5	#5	4	T5	#4	4
B6	#5	4	T6	#4	10
B7	#5	8	T7	#4	5
B8	#5	4	T8	#4	7
B9	#5	9	T9	#5	4
B10	#6	4	T10	#5	9
B11	#6	12	T11	#5	5
B12	#6	4	T12	#6	4
B13	#6	8	T13	#6	4
B14	#6	2	T14	#6	12
B15	#6	7	T15	#6	4
B16	#6	3	T16	#6	4
B17	#6	8	T17	#6	12
B18	#6	4	T18	#6	4
B19	#6	3	T19	#6	4
B20	#7	2	T20	#6	5
B21	#7	6	T21	#6	4
B22	#7	4	T22	#6	6
B23	#7	8	T23	#6	4
B24	#7	4	T24	#6	5
B25	#7	4	T25	#6	5
B26	#7	5	T26	#6	7
B27	#7	8	T27	#6	5
B28	#7	4	T28	#6	9
B29	#7	6	T29	#6	11
B30	#7	4	T30	#6	10
B31	#7	5	T31	#6	10
B32	#7	4	T32	#6	12
B33	#7	8	T33	#6	4
B34	#8	4	T34	#6	16
B35	#7	4	T35	#6	5
B36	#8	4	T36	#6	5
B37	#8	3	T37	#6	6
B38	#8	2	T38	#6	12
B39	#8	4	T39	#6	8
B40	#8	2	T40	#6	6
B41	#8	4	T41	#7	4
B42	#8	4	T42	#5	6
			T43	#7	8
			T44	#6	4
			T45	#7	5
			T46	#6	9
			T47	#5	9
			T48	#6	11
			T49	#6	16
			T50	#6	16
			T51	#7	4
			T52	#6	10
			T53	#7	4
			T54	#6	14
			T55	#7	5
			T56	#6	3
			T57	#7	6
			T58	#7	7
			T59	#7	9
			T60	#7	6
			T61	#7	6
			T62	#7	9
			T63	#7	5
			T64	#9	7
			T65	#8	4
			T66	#9	10
			T67	#8	5
			T68	#8	6
			T69	#8	6
			T70	#9	4
			T71	#9	4
			T72	#9	3
			T73	#9	3

NOTE:
 ODD NUMBERED BARS INDICATE COLUMN STRIP
 EVEN NUMBERED BARS INDICATE MIDDLE STRIP


PROVIDE 2-#6 DWLS. ALONG LINES T600S & T000M SAME SIZE AND SPACING AS BEAM STIRRUPS WITH 12" MIN. EMBEDMENT.

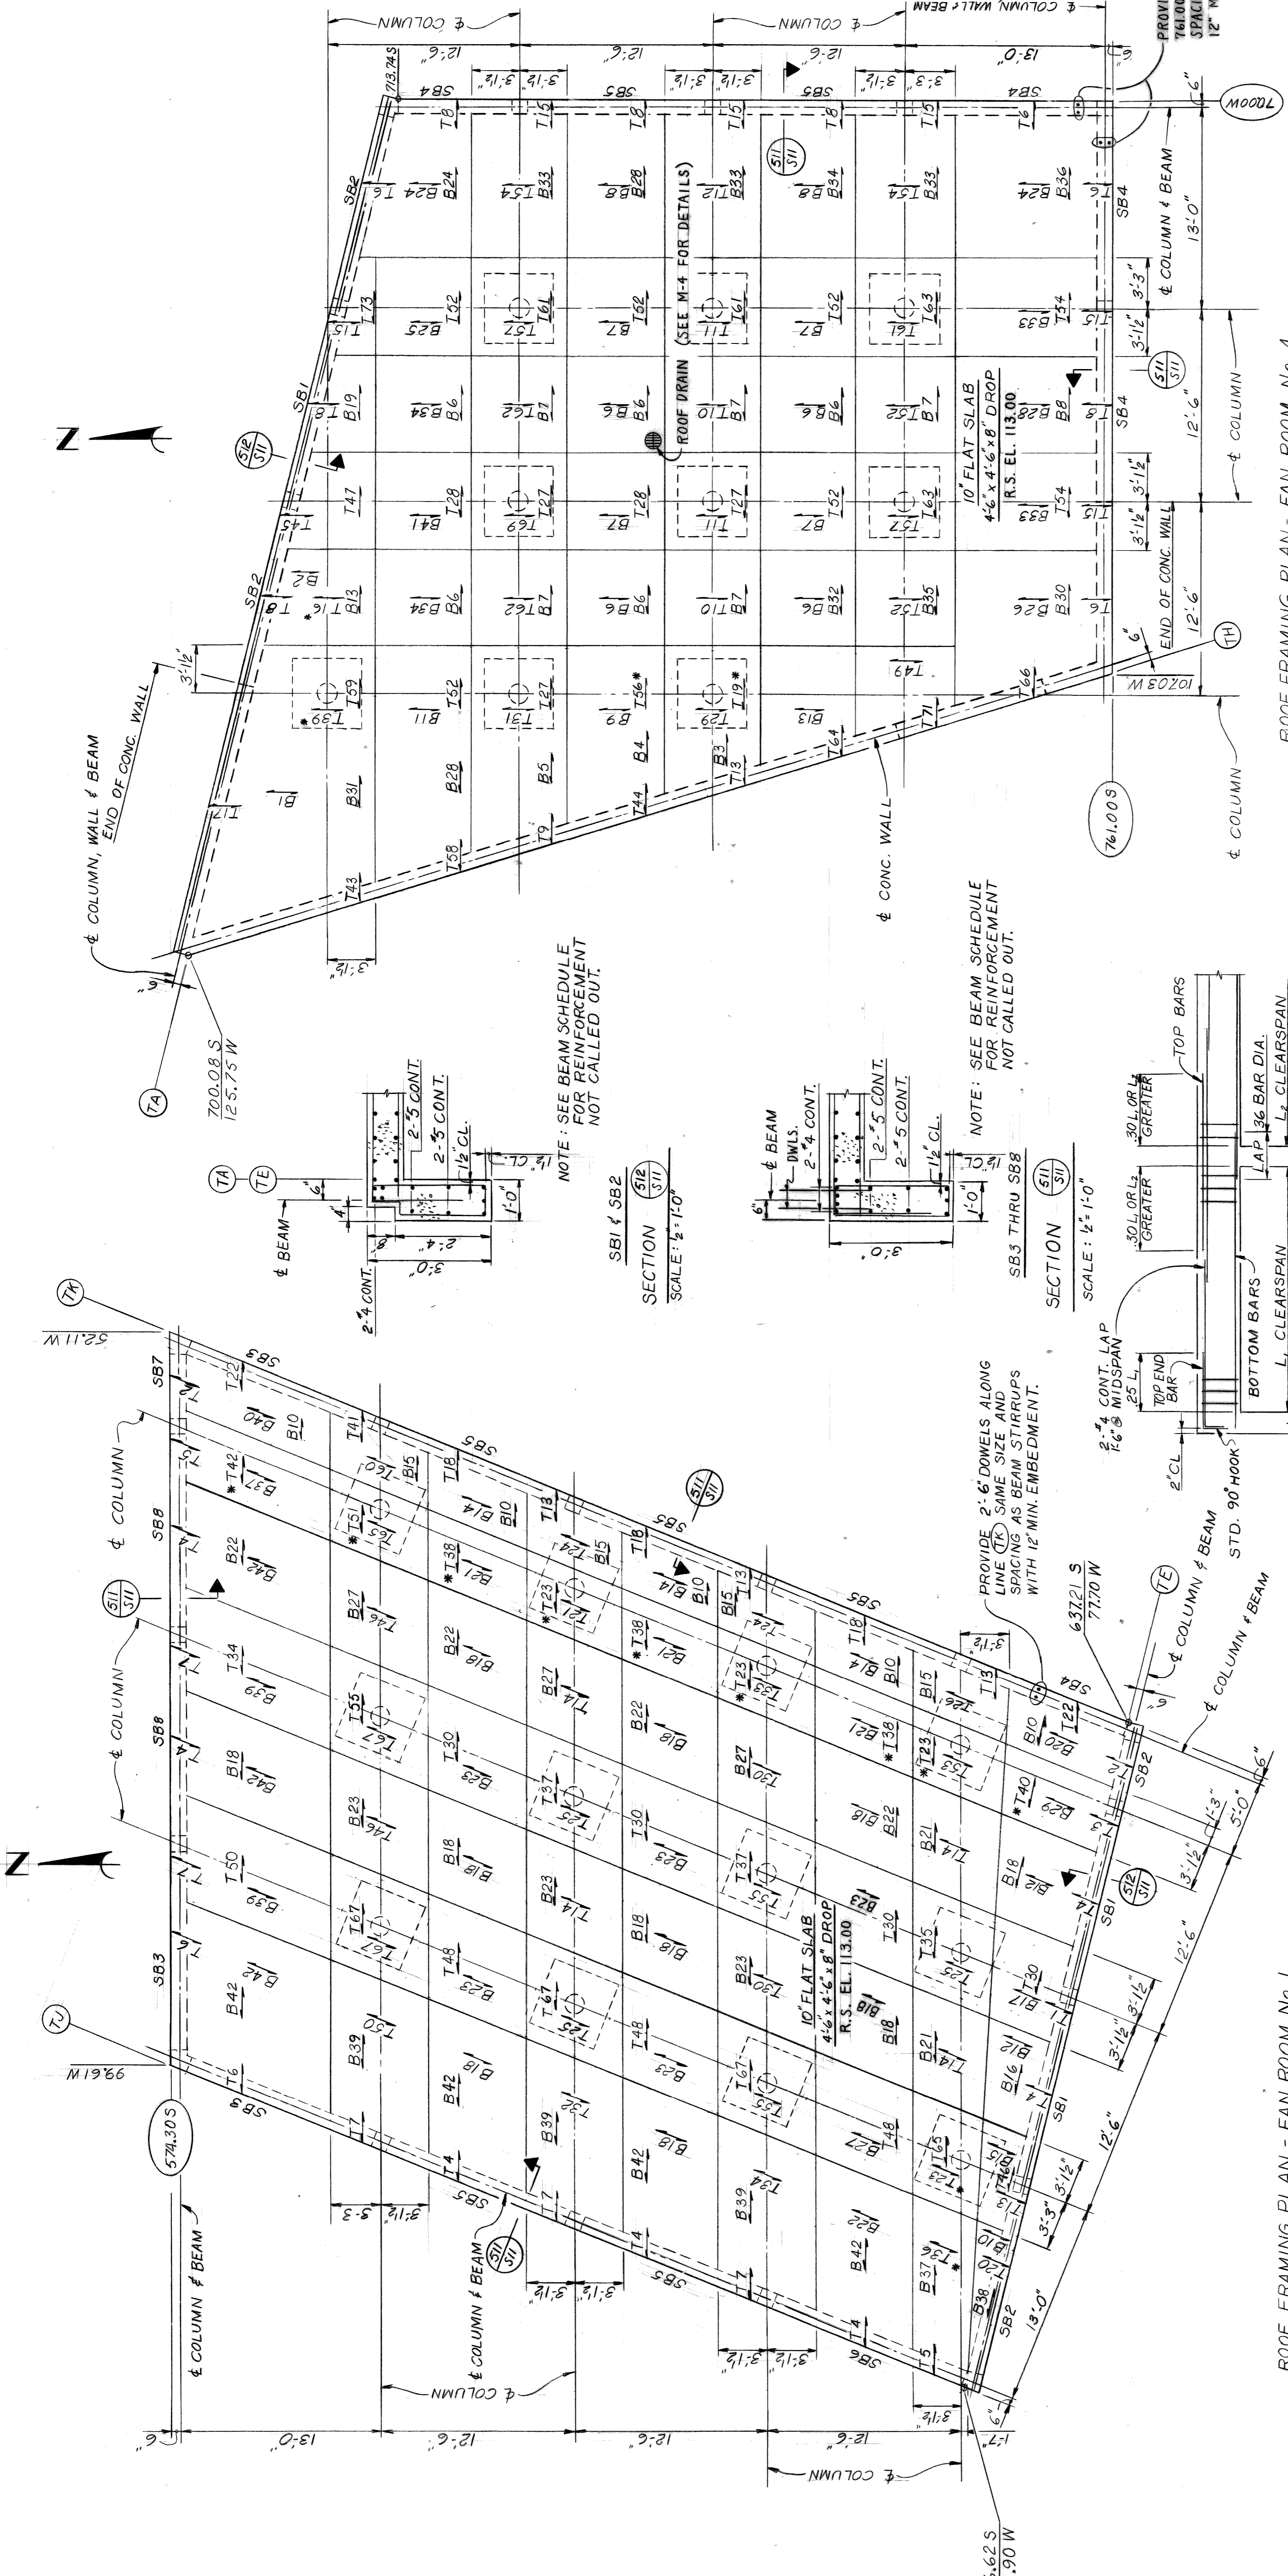

ROOF FRAMING PLAN - FAN ROOM No. 4
 SCALE: 3/8" = 1'-0"


BEAM SCHEDULE

MARK	SIZE	BOTTOM	TOP	STIRRUPS THRU OUT	REMARKS
SB1	12 X 36	3-#6	2-#7	4@10"	TOP STEEL IN TWO LAYERS
SB2	12 X 36	3-#6	2-#7	4@10"	TOP STEEL IN TWO LAYERS
SB3	12 X 36	3-#7	2-#7	4@10"	
SB4	12 X 36	3-#6	2-#7	4@10"	
SB5	12 X 36	3-#6	2-#7	4@10"	
SB6	12 X 36	3-#8	2-#7	4@10"	
SB7	12 X 36	3-#6	2-#7	4@10"	
SB8	12 X 36	3-#6	2-#7	4@10"	

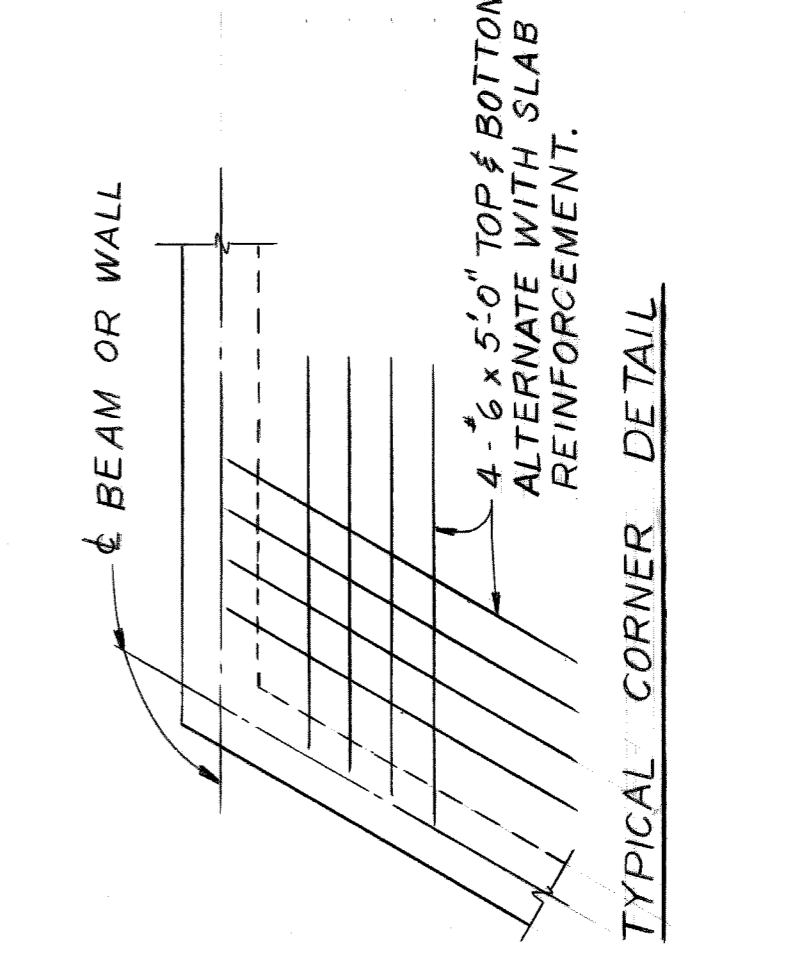

BAR PLACING SEQUENCE

SEQ.	BAR	RM. #1	RM. #4
BOTTOM BARS	E-W	N-S	N-S
TOP BARS	E-W	E-W	E-W
TOP BARS	N-S	N-S	N-S

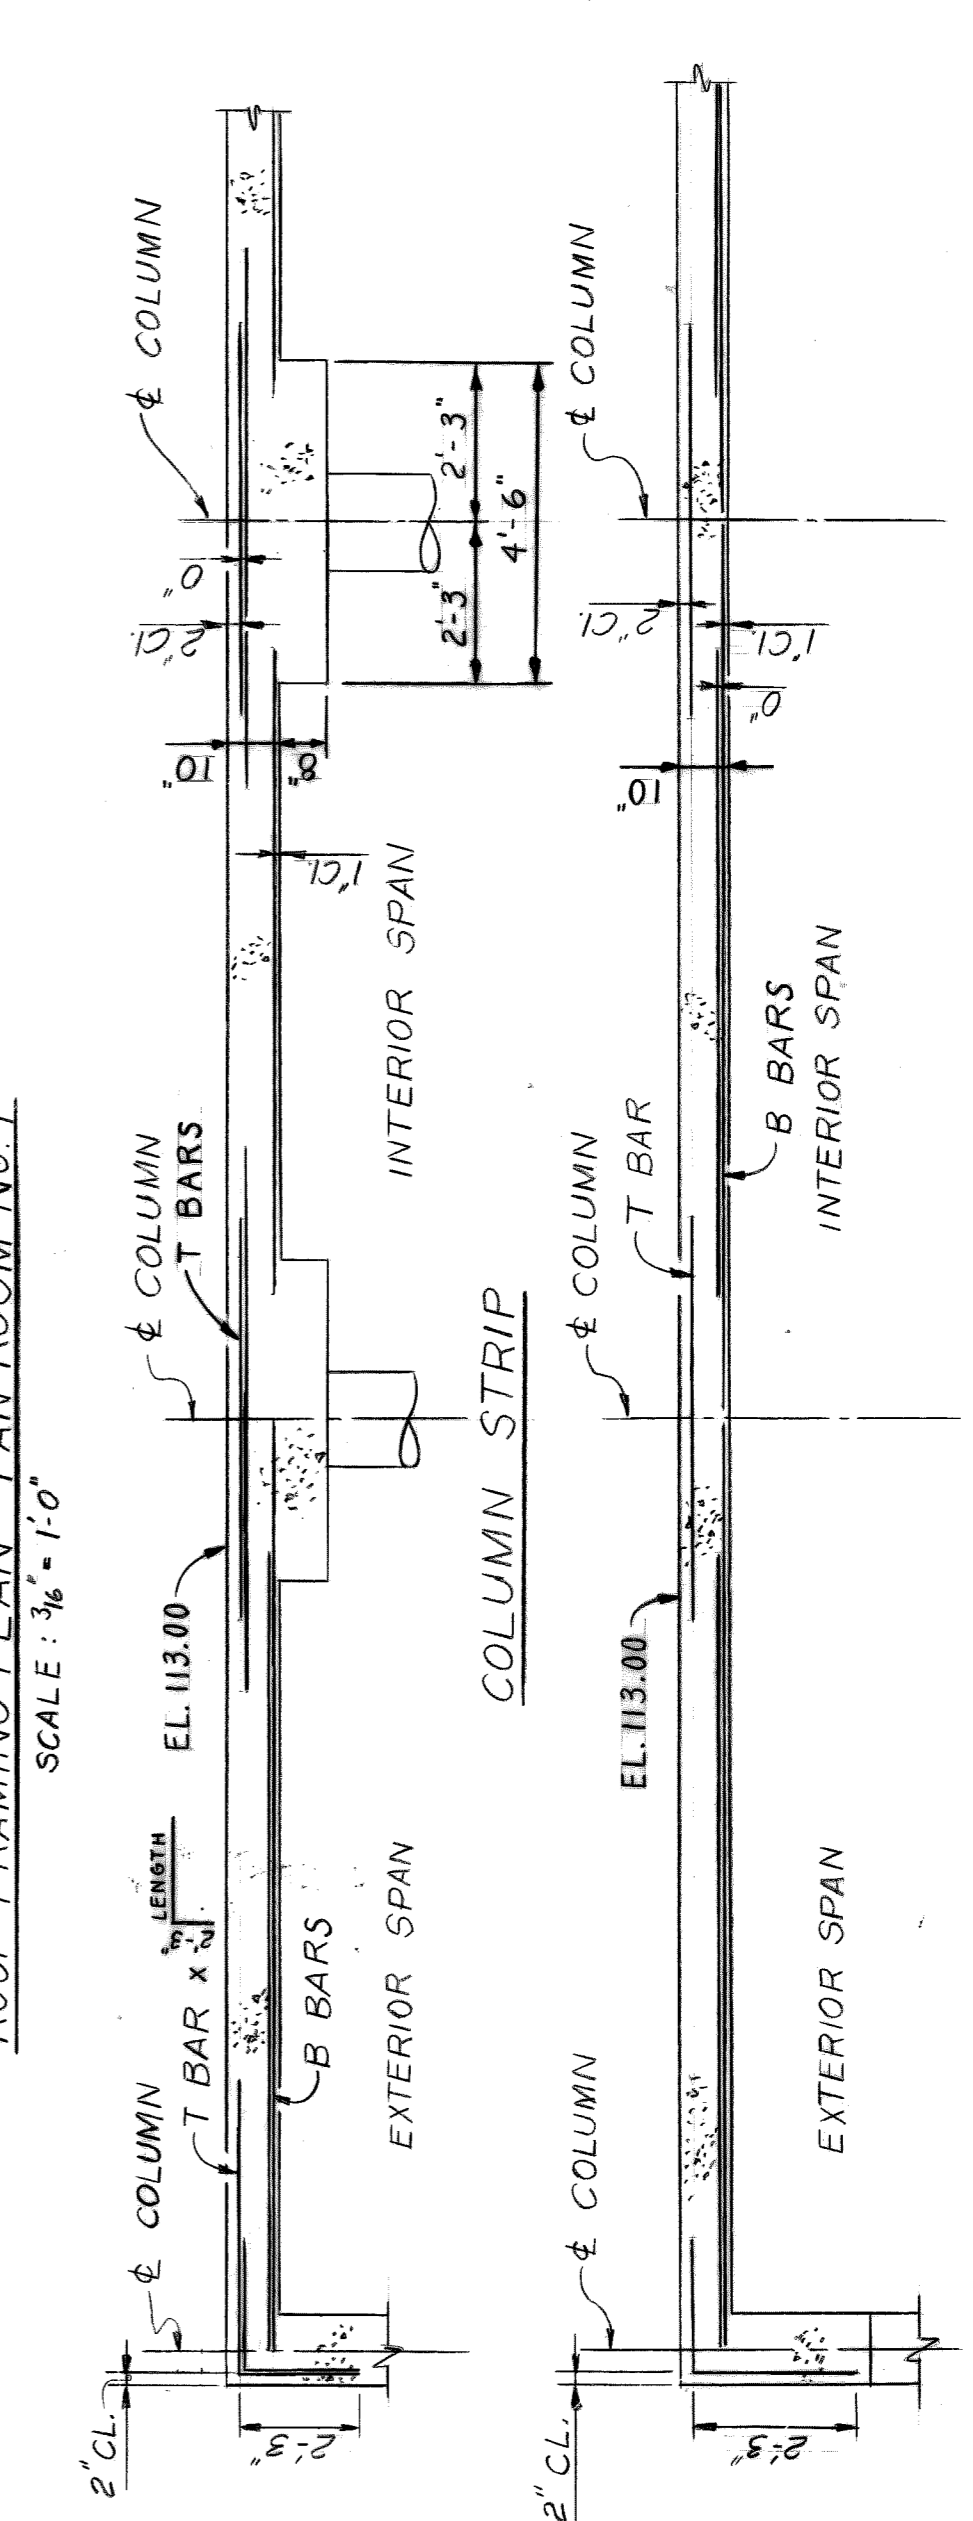

ROOF FRAMING PLAN - FAN ROOM No. 1
 SCALE: 3/8" = 1'-0"

contract no. 07105A
 drawing no. S11
 sheet 37 of 67

ATWATER STREET RELOCATION
 ATWATER TUNNEL
 MECHANICAL ROOMS 1 & 4
 ROOF FRAMING PLAN


CITY OF DETROIT
 CITY ENGINEERING DEPARTMENT

approved
 T. E. Quinn
 STRUCTURAL ENGINEER

date 8-11-75
 designed R. Bunce
 drawn L. G.
 checked P. B.

revisions	

NOTE:
 INTERIOR SPANS:
 1. CENTER TOP REINFORCEMENT OVER COLUMNS
 2. CENTER BOTTOM REINFORCEMENT BETWEEN COLUMNS
 EXTERIOR SPANS:
 1. EXTERIOR SPAN (★) BARS FULL LENGTH OF EXTERIOR SUPPORT

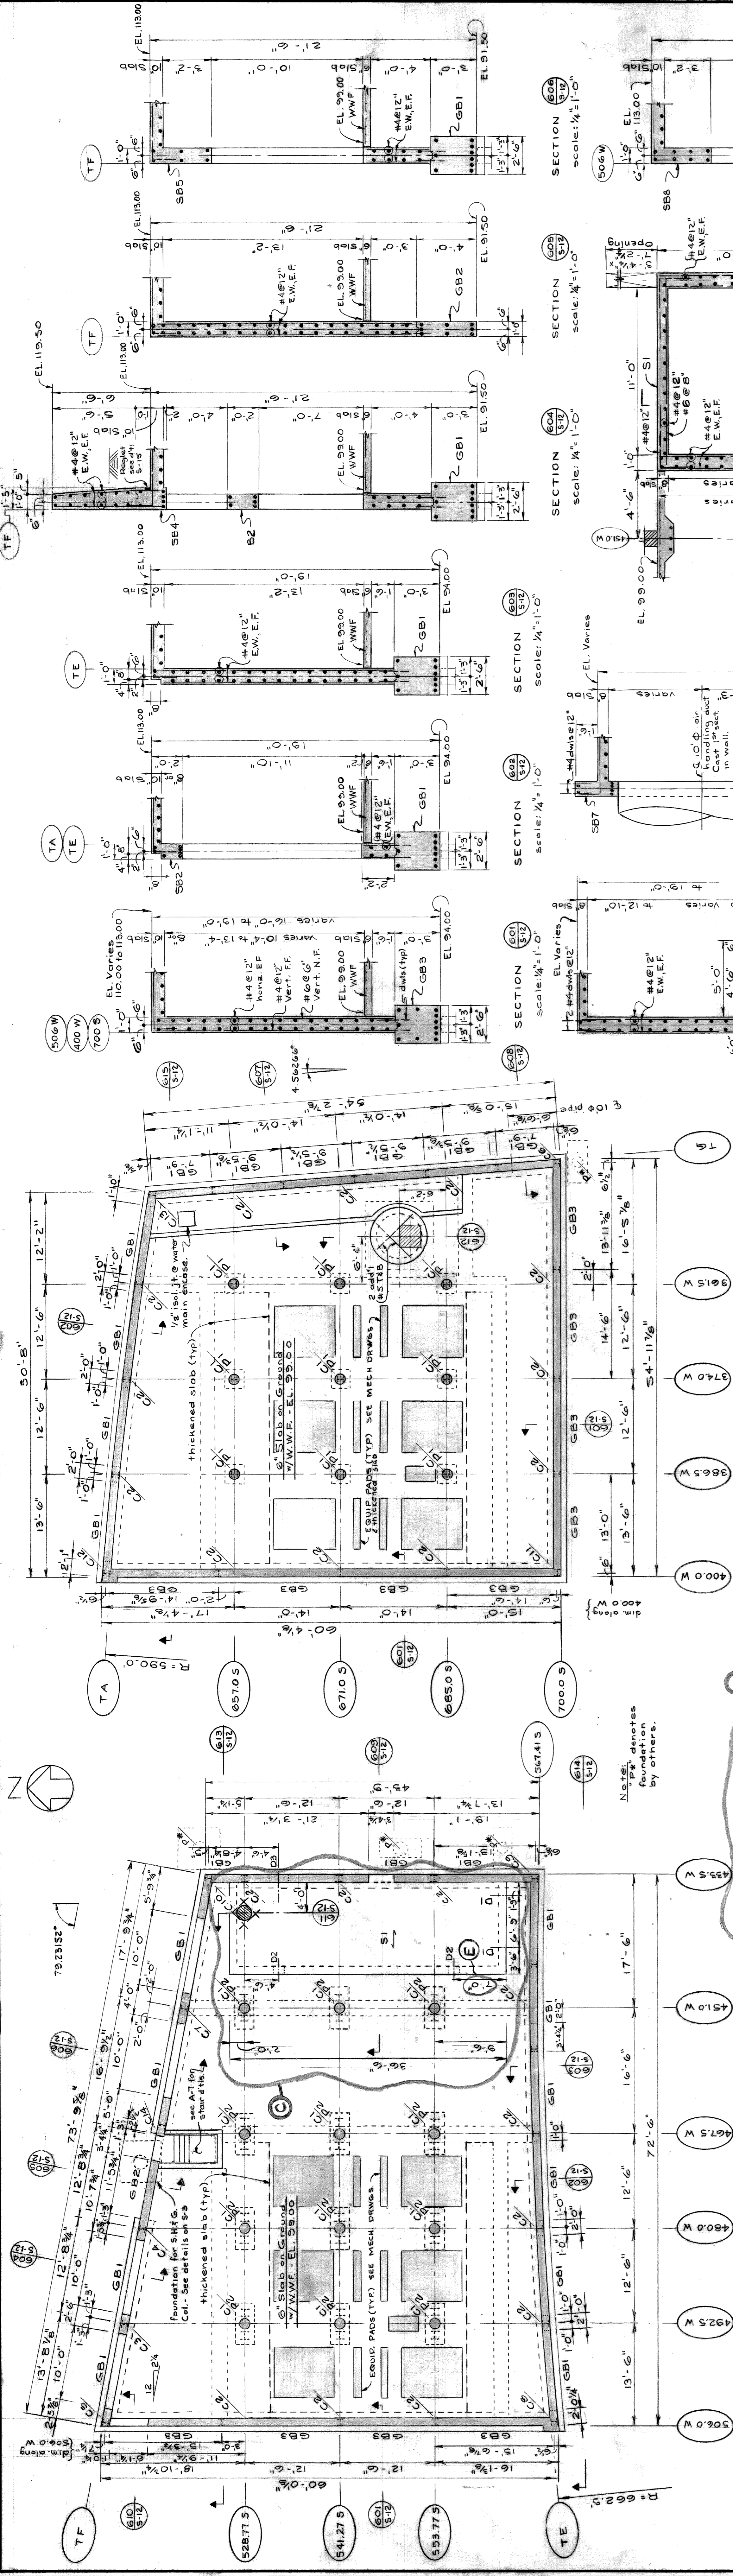

FLOOR AND FOUNDATION PLAN - MECHANICAL ROOM #2
Scale: 1/8" = 1'-0"

FLOOR AND FOUNDATION PLAN - MECHANICAL ROOM #1
Scale: 1/8" = 1'-0"


FLOOR AND FOUNDATION PLAN - MECHANICAL ROOM #3
Scale: 1/8" = 1'-0"

QUANTITY CHANGES

REV.	ITEM	QUANT.
A	CONC. 355	+ 4.3 C.Y.
A	REINFR. STEEL	+ 358 LBS

ELEC. DUCT SCHEDULE

Mark	Opening	± Elev.
D1	30" x 18"	92.5
D2	12" x 18"	92.5
D3	12" x 30"	92.5

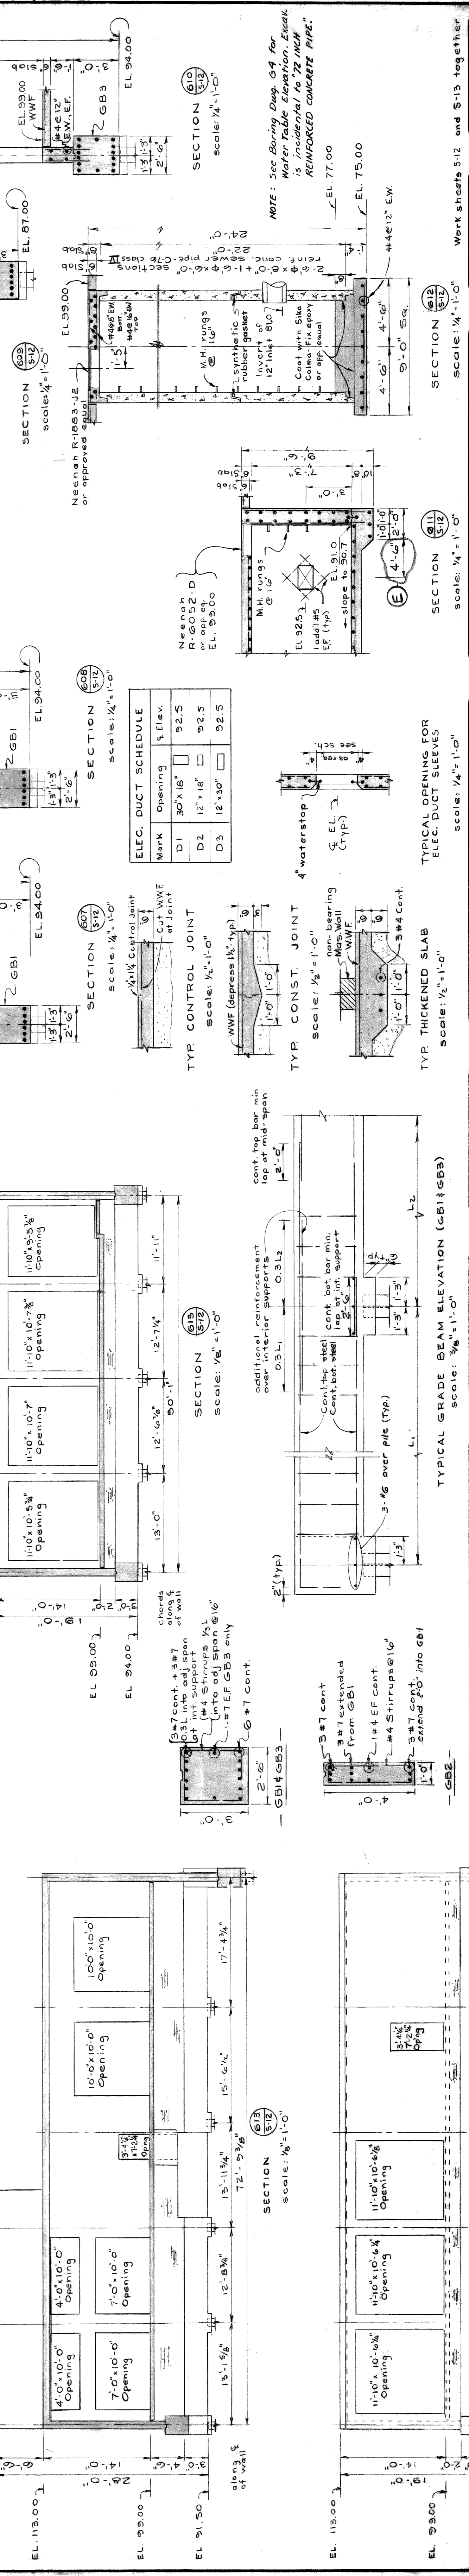

SECTION 600
Scale: 1/4" = 1'-0"

SECTION 601
Scale: 1/4" = 1'-0"

SECTION 602
Scale: 1/4" = 1'-0"

SECTION 603
Scale: 1/4" = 1'-0"

SECTION 604
Scale: 1/4" = 1'-0"

SECTION 605
Scale: 1/4" = 1'-0"

SECTION 606
Scale: 1/4" = 1'-0"

SECTION 607
Scale: 1/4" = 1'-0"

SECTION 608
Scale: 1/4" = 1'-0"

SECTION 609
Scale: 1/4" = 1'-0"

SECTION 610
Scale: 1/4" = 1'-0"

SECTION 611
Scale: 1/4" = 1'-0"

SECTION 612
Scale: 1/4" = 1'-0"

SECTION 613
Scale: 1/8" = 1'-0"

SECTION 614
Scale: 1/8" = 1'-0"

SECTION 615
Scale: 1/8" = 1'-0"

SECTION 616
Scale: 1/8" = 1'-0"

SECTION 617
Scale: 1/4" = 1'-0"

SECTION 618
Scale: 1/4" = 1'-0"

SECTION 619
Scale: 1/4" = 1'-0"

SECTION 620
Scale: 1/4" = 1'-0"

SECTION 621
Scale: 1/4" = 1'-0"

SECTION 622
Scale: 1/4" = 1'-0"

SECTION 623
Scale: 1/4" = 1'-0"

SECTION 624
Scale: 1/4" = 1'-0"

SECTION 625
Scale: 1/4" = 1'-0"

NOTE: See Boring Log 04 for Water Table Elevation. Elevation is incidental to 72" INCH REINFORCED CONCRETE PIPE.

Neenah R-1003-J2 or approved equal

Neenah R-1003-J2 or approved equal

ATWATER STREET RELOCATION ATWATER TUNNEL MECHANICAL ROOMS 2 & 3 FOUNDATION AND FLOOR PLAN

contract no. 07105A

sheet 29 of 31

drawing no. S12

CITY OF DETROIT CITY ENGINEERING DEPARTMENT

approved 8-11-75
designed R. K. Kuhn
drawn R. K. Kuhn
checked J. B. Smith

date 8-11-75

approved T. E. M. Gordon
STRUCTURAL ENGINEER

revisions

WORK SHEETS S-12 AND S-13 TOGETHER