


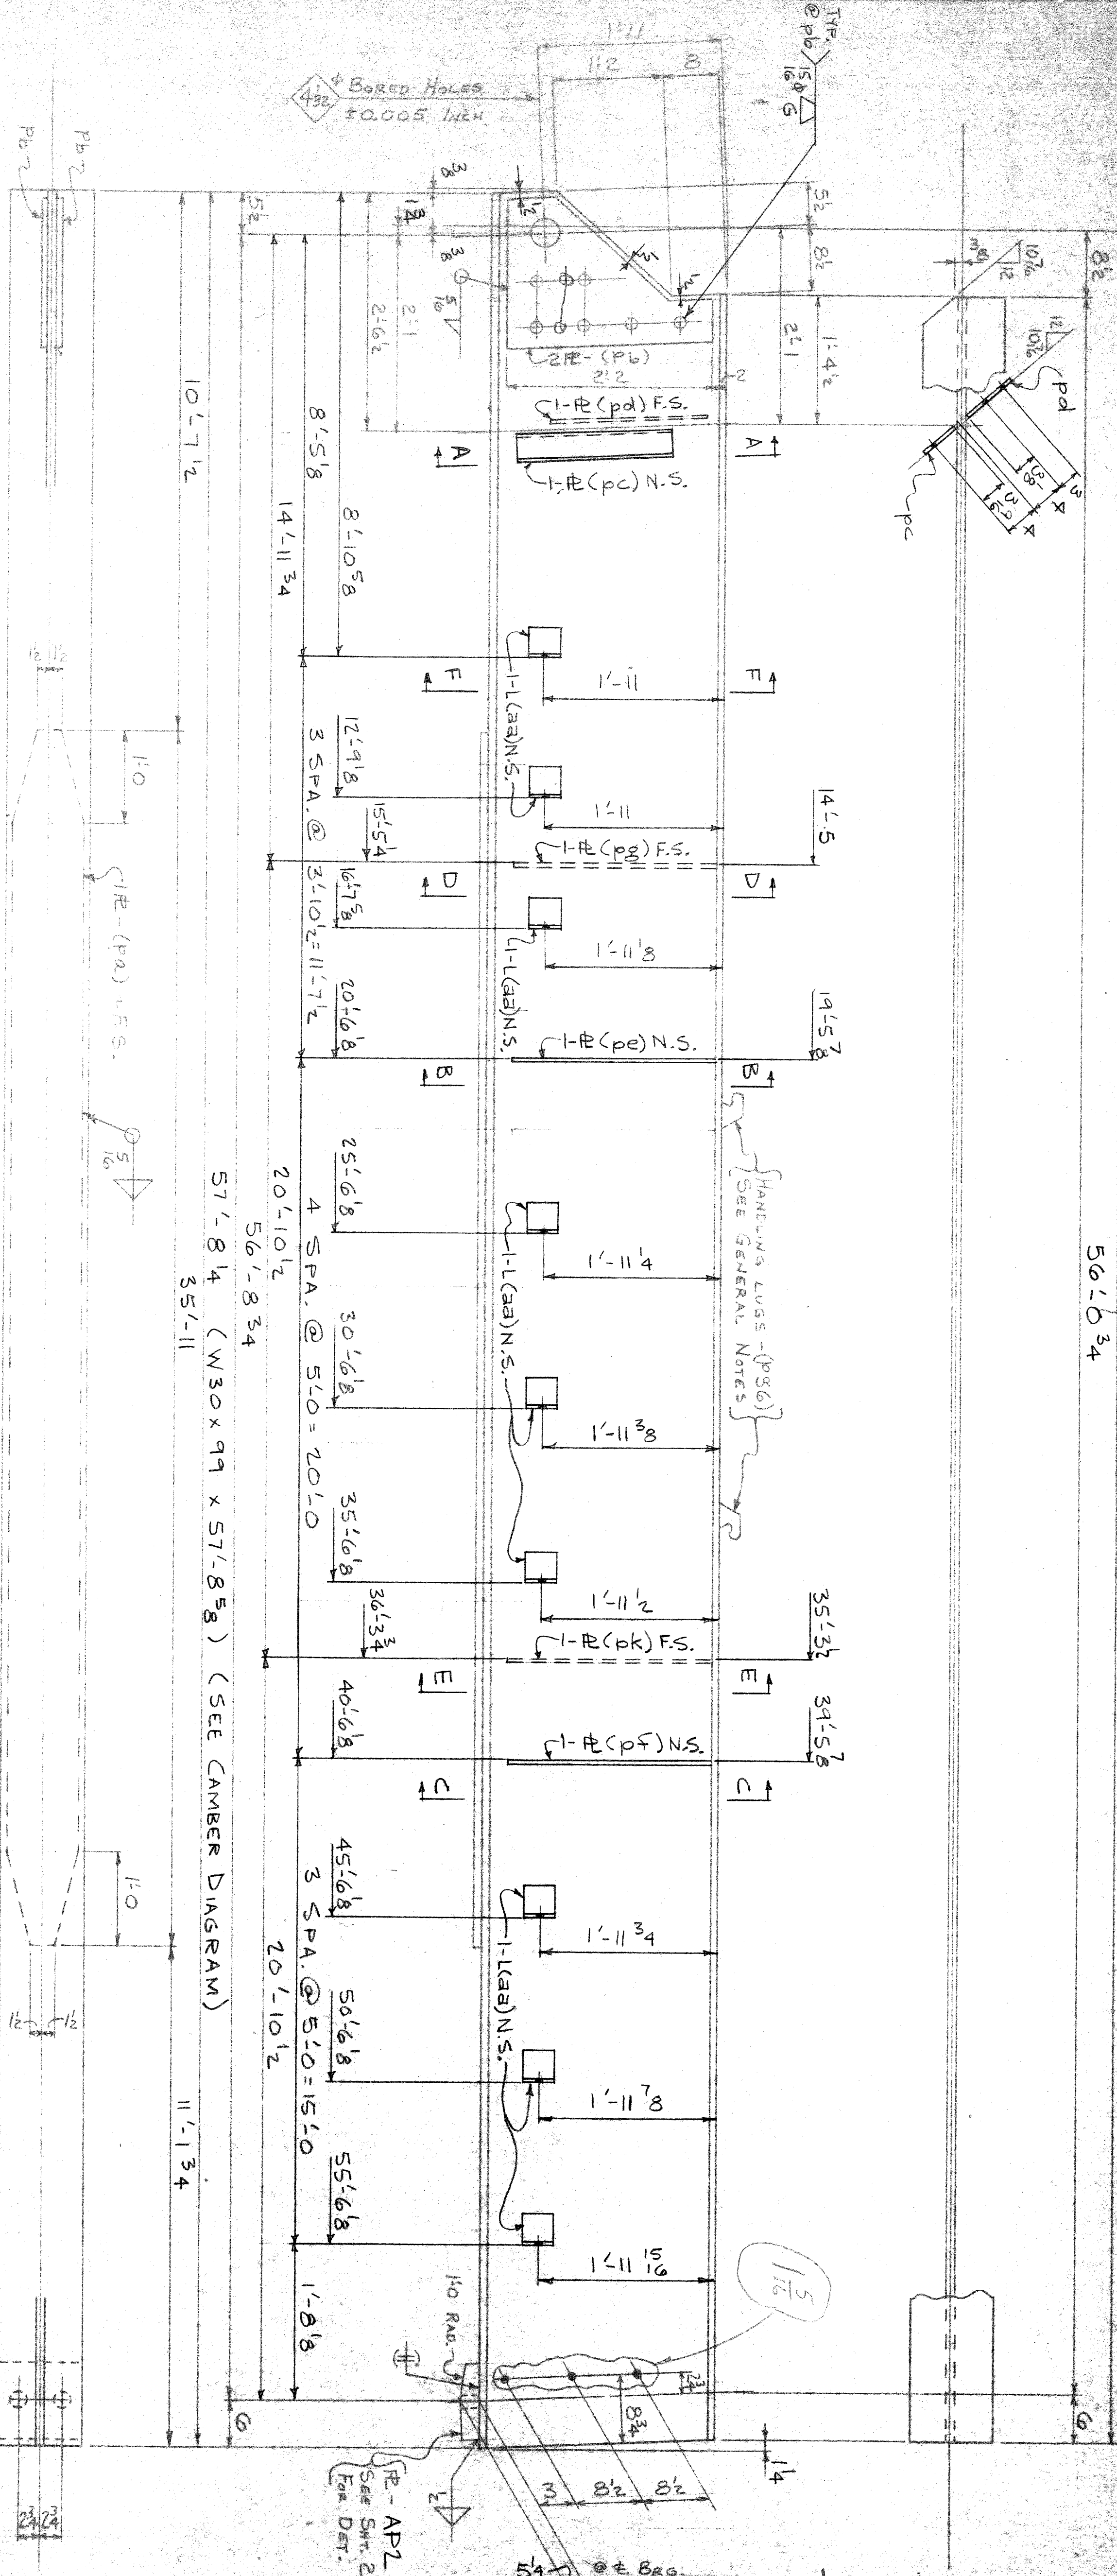
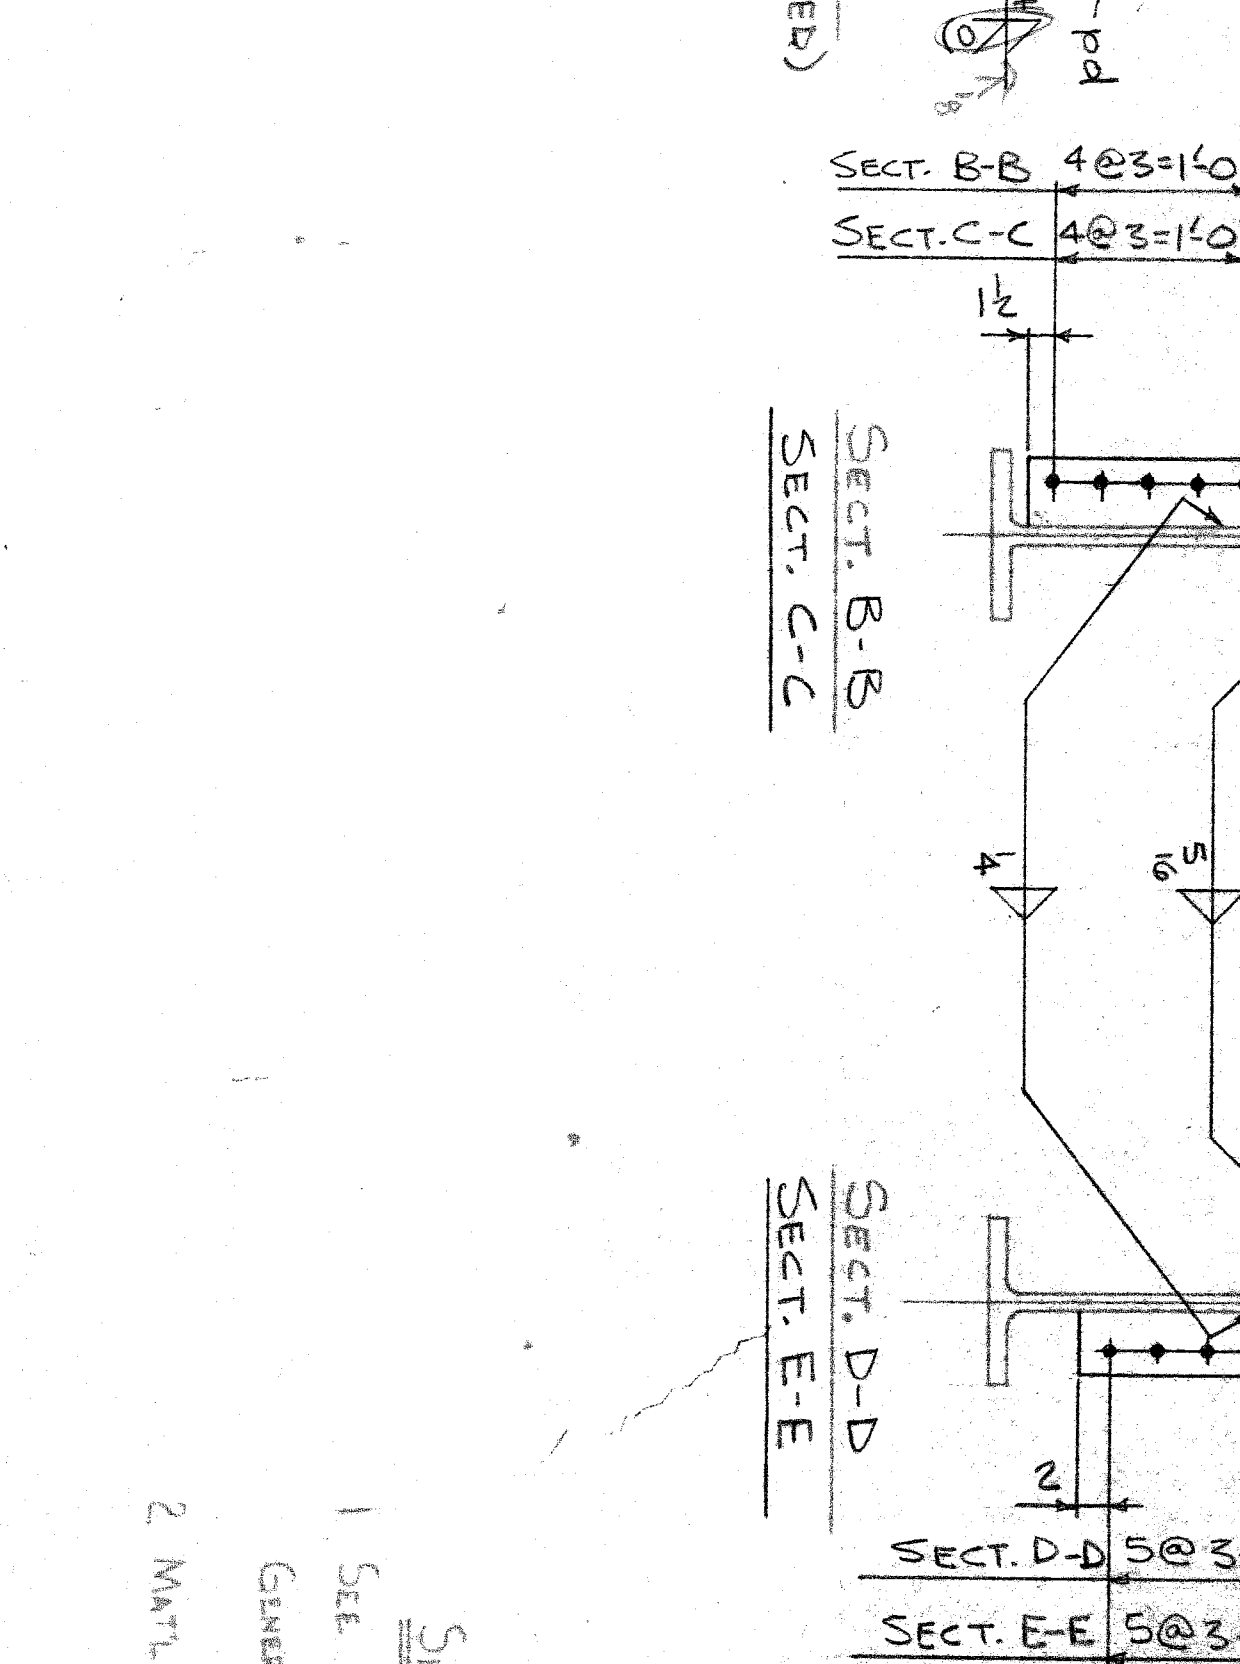


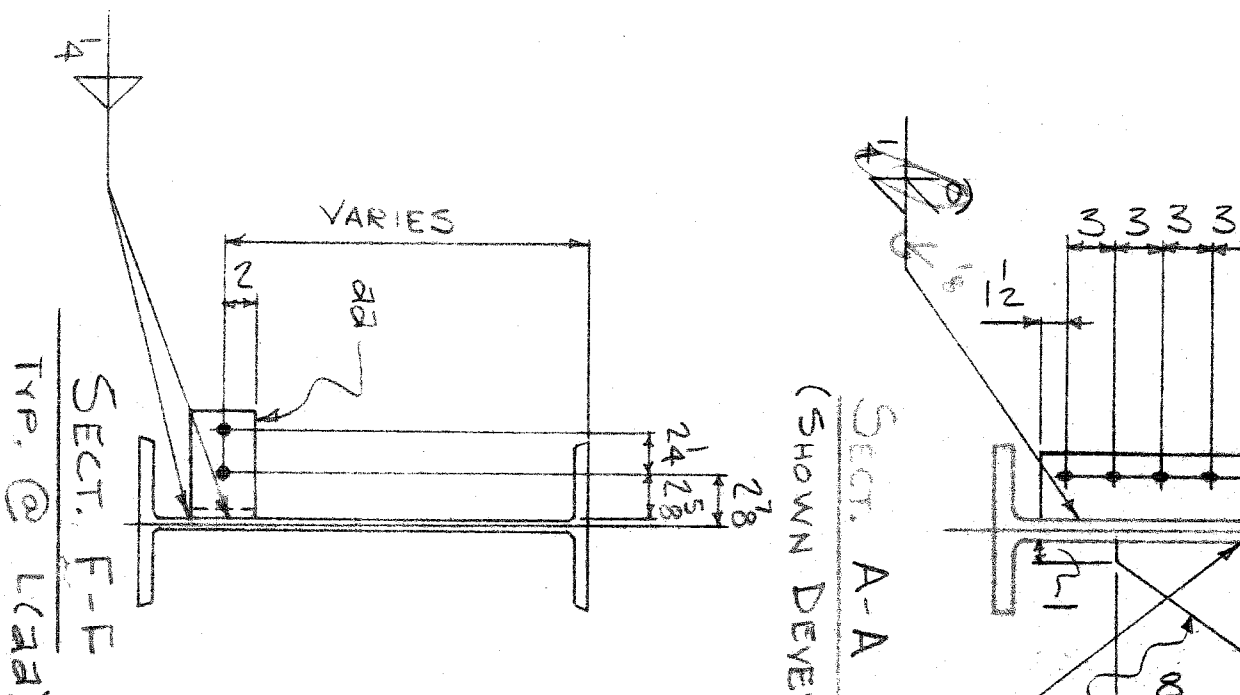

57'-3 1/4  
56'-0 3/4

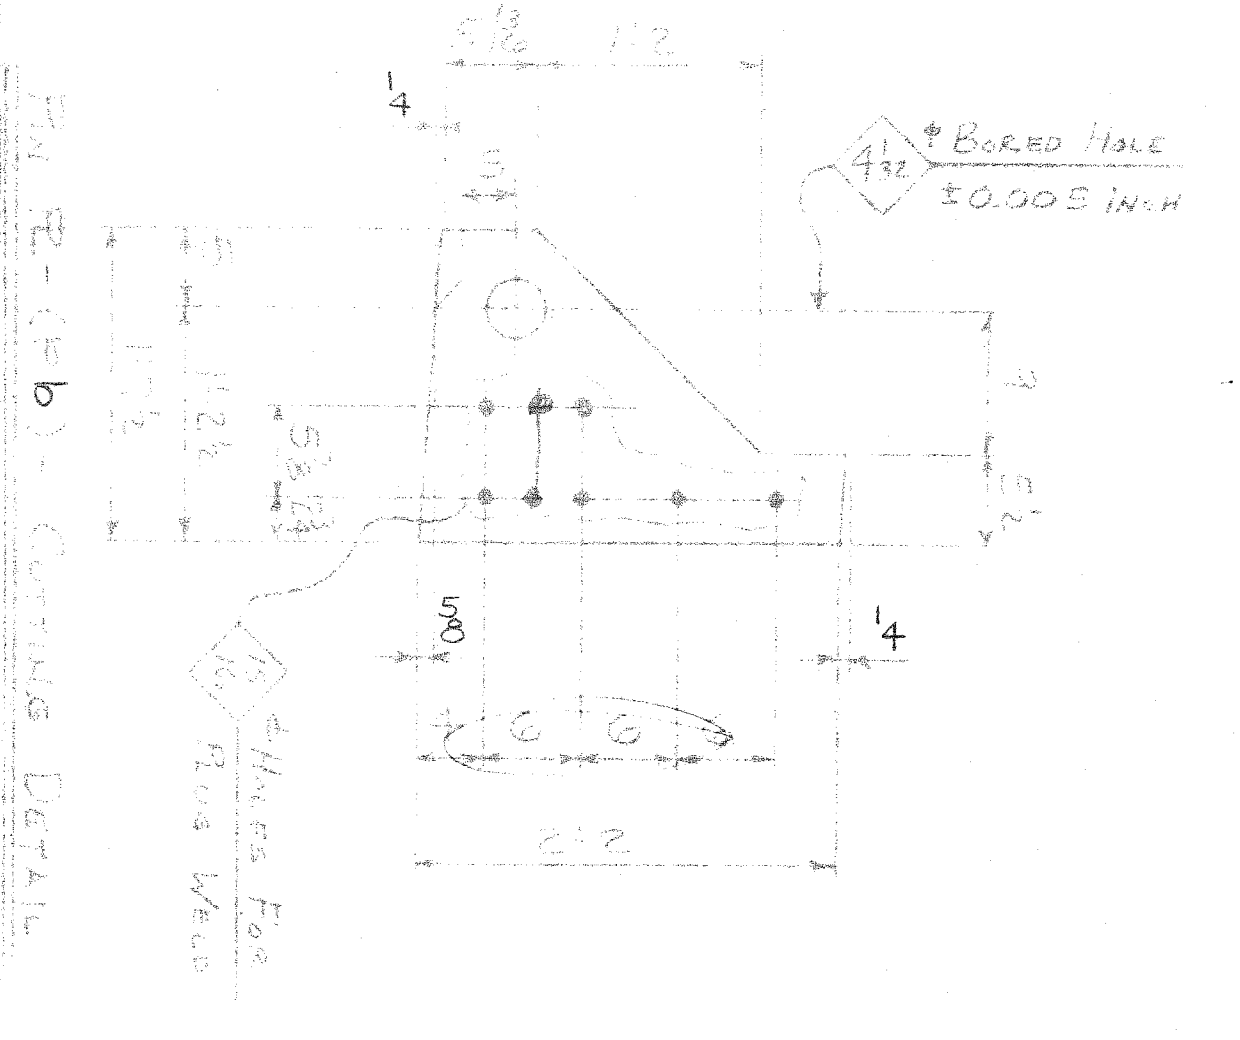

ONE-STRINGER - A48  
LINE G SPAN 4

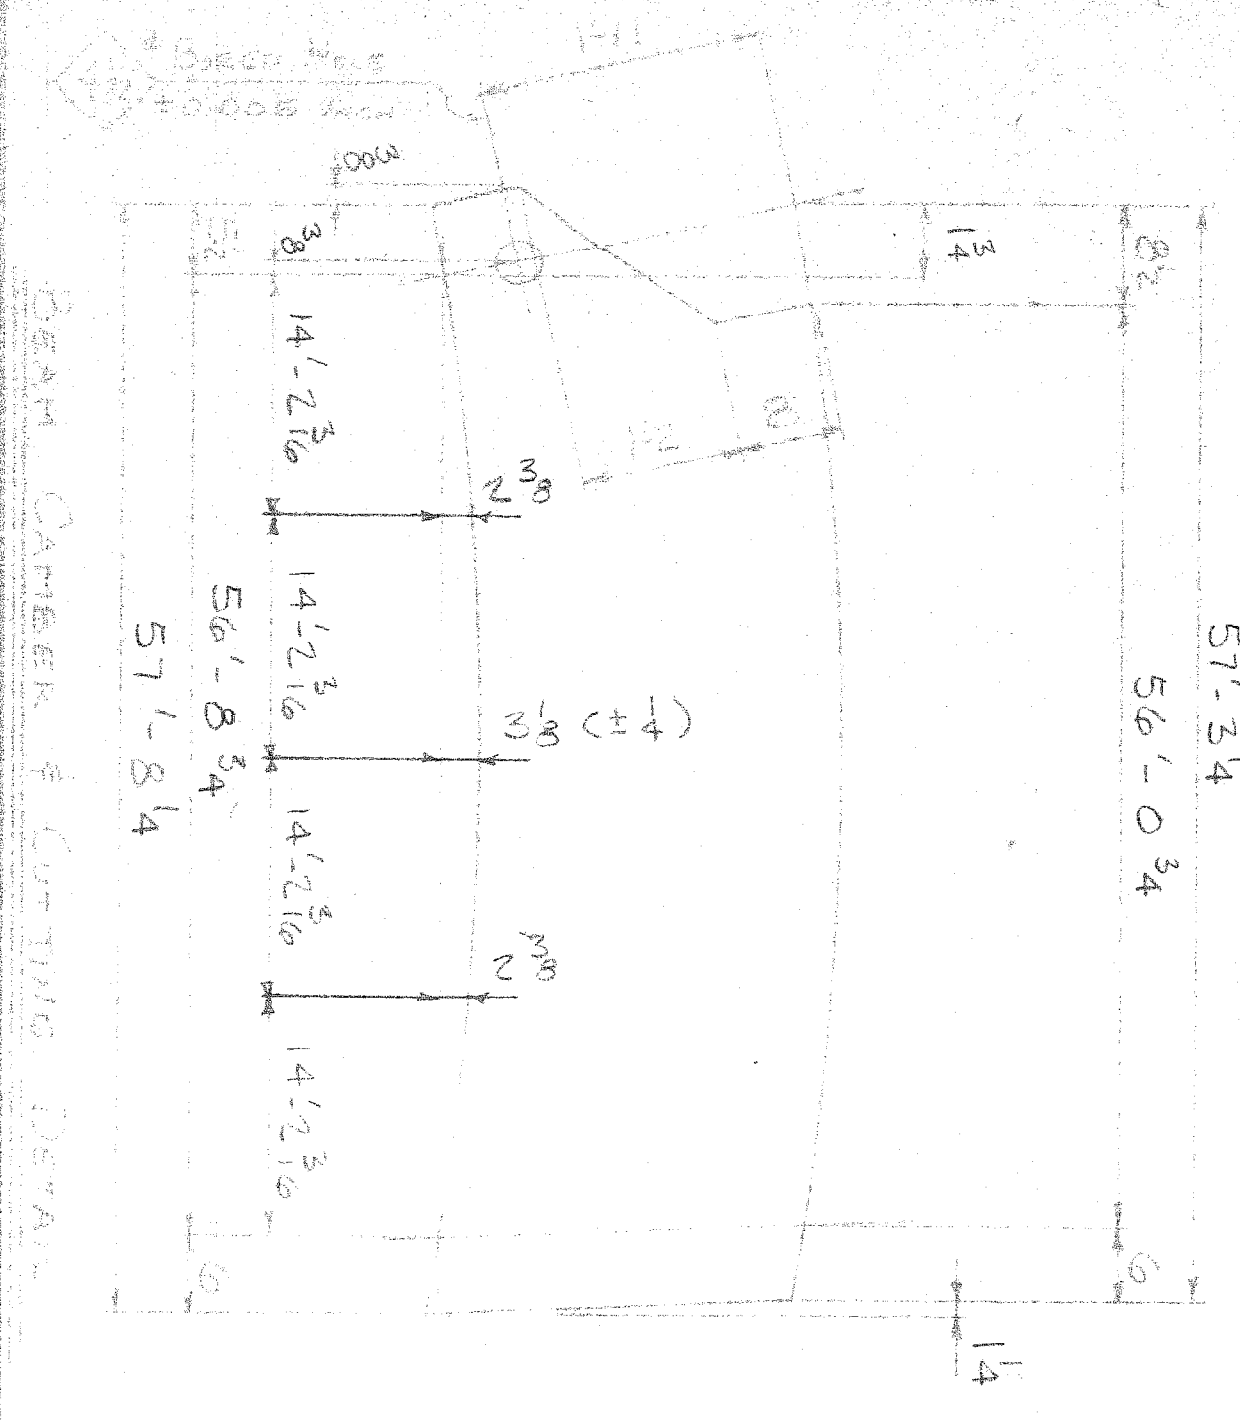

NO.	DESCRIPTION	QUANTITY	UNIT	PRICE	TOTAL
1	1 W 30 x 99	571.83	EA		
2	1 PC 12 x 12	2.24	PC		
3	1 PC 12 x 12	1.8	PC		
4	1 PC 12 x 12	1.8	PC		
5	1 PC 12 x 12	2.24	PC		
6	1 PC 12 x 12	1.17	PC		
7	1 PC 12 x 12	1.17	PC		
CITY OF DETROIT  
CIVIL ENGINEERING DEPARTMENT  
**APPROVED AS NOTED**  
FOR COMPLIANCE WITH CONTRACT NO. 145521  
DATE: MAR 2 1977

PHILIP ZWEIF & SONS







2100E 5TH AVE  
BUILDING DESIGN & ARCHITECTURE  
OWNER: CITY OF DETROIT  
CONTRACTOR: PHILIP ZWEIF & SONS  
DATE: 2-1-77  
SHEET 4B OF 53

SHOP NOTES  
1 SEE SHEET E4 FOR GENERAL NOTES.  
2 MAT'L: A588 U.N.



49'-7 7/8 (W30X99 X 50:176) (SEE CAMBER DIAGRAM)

48'-5 3/8

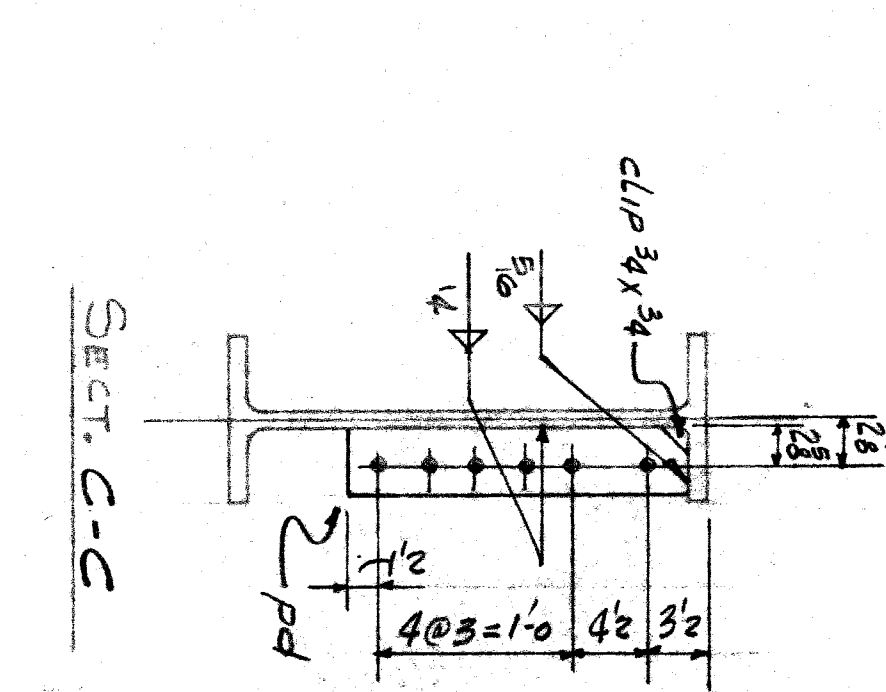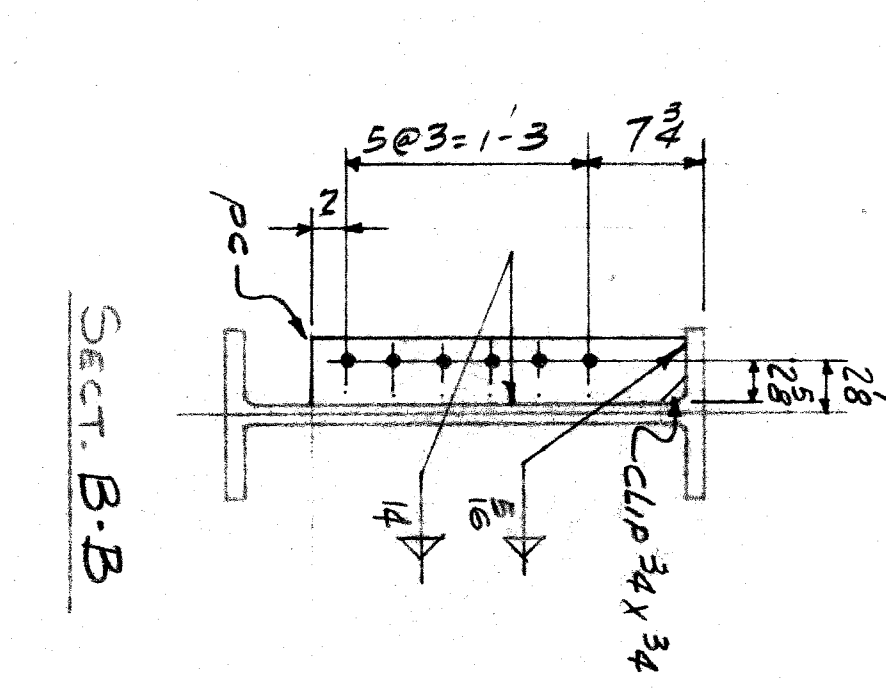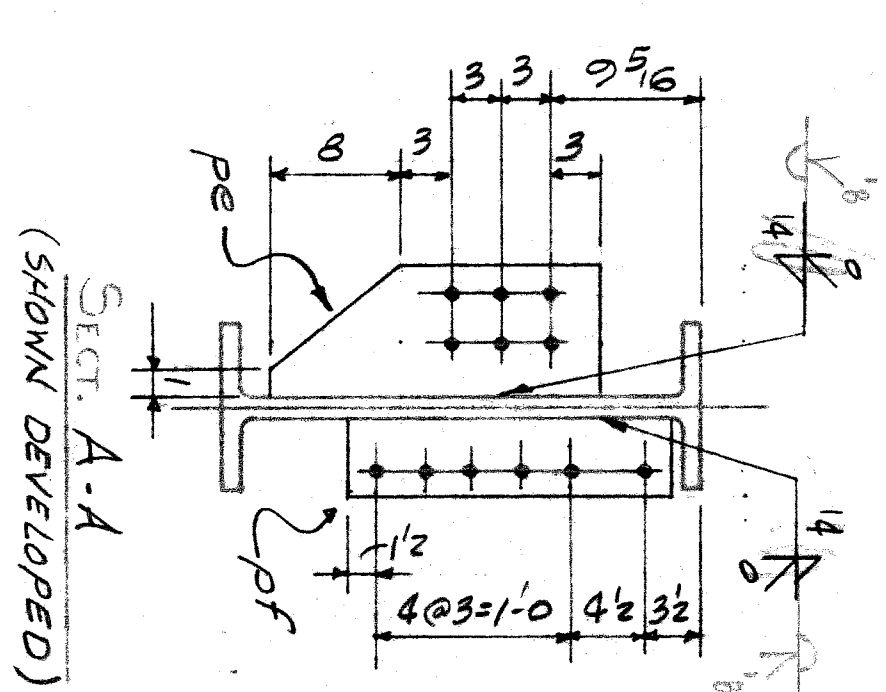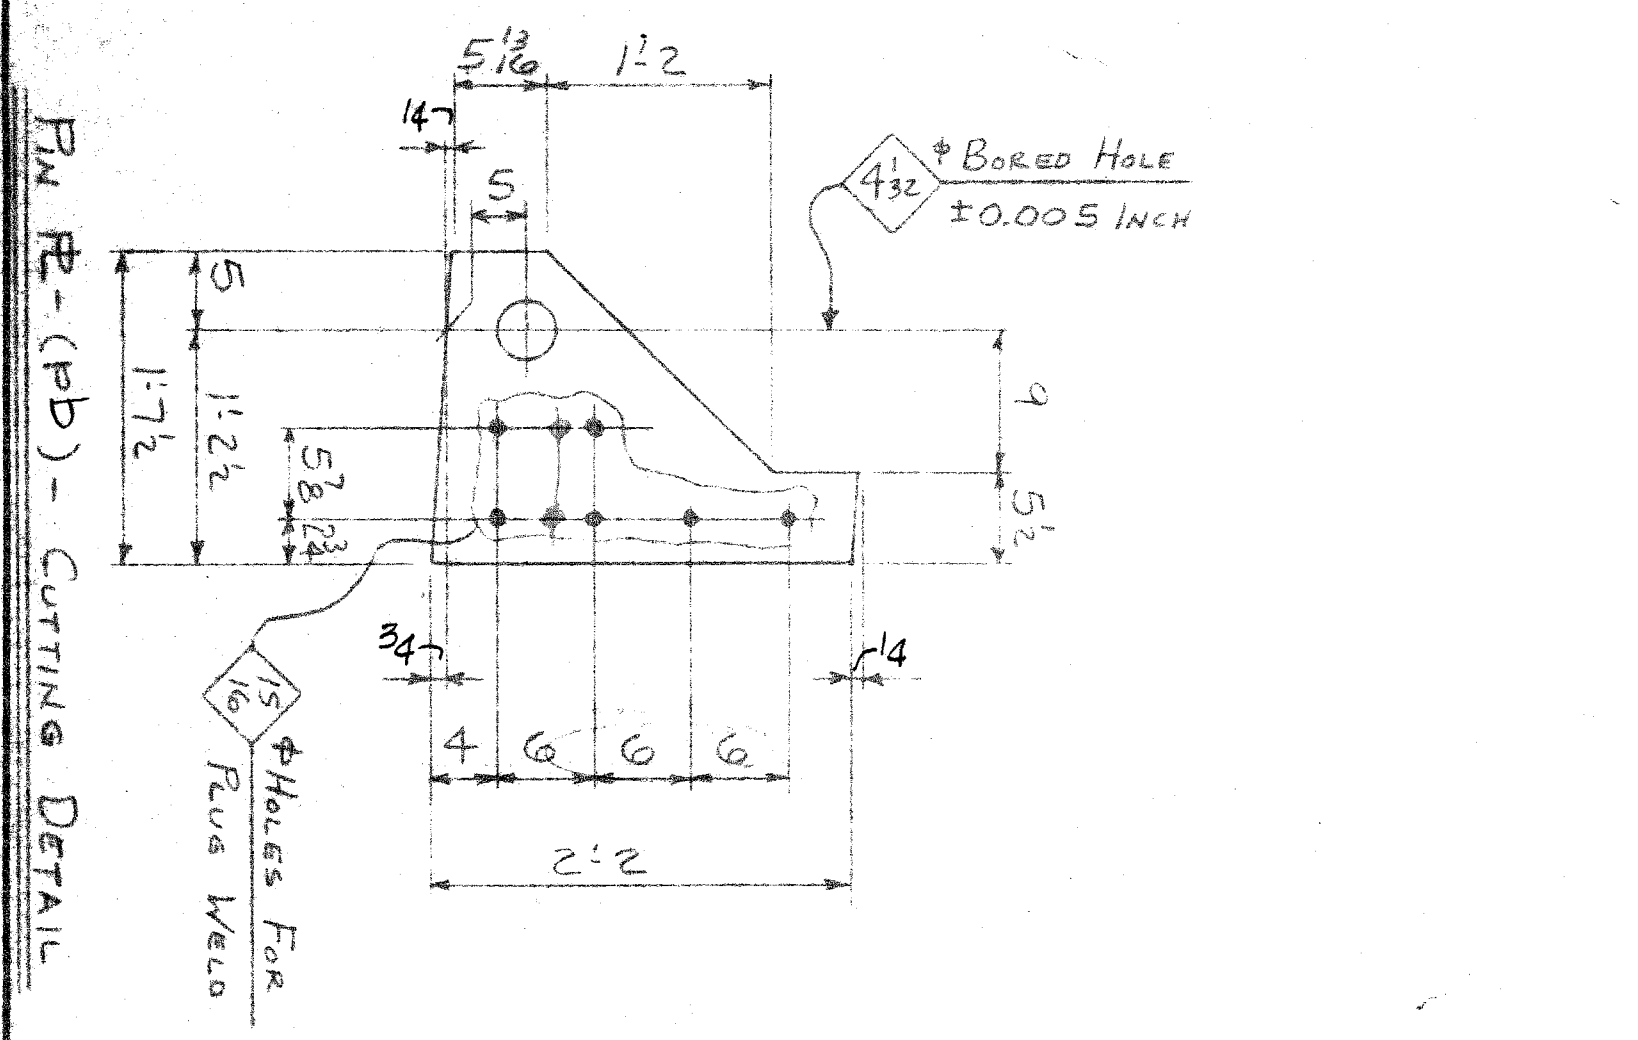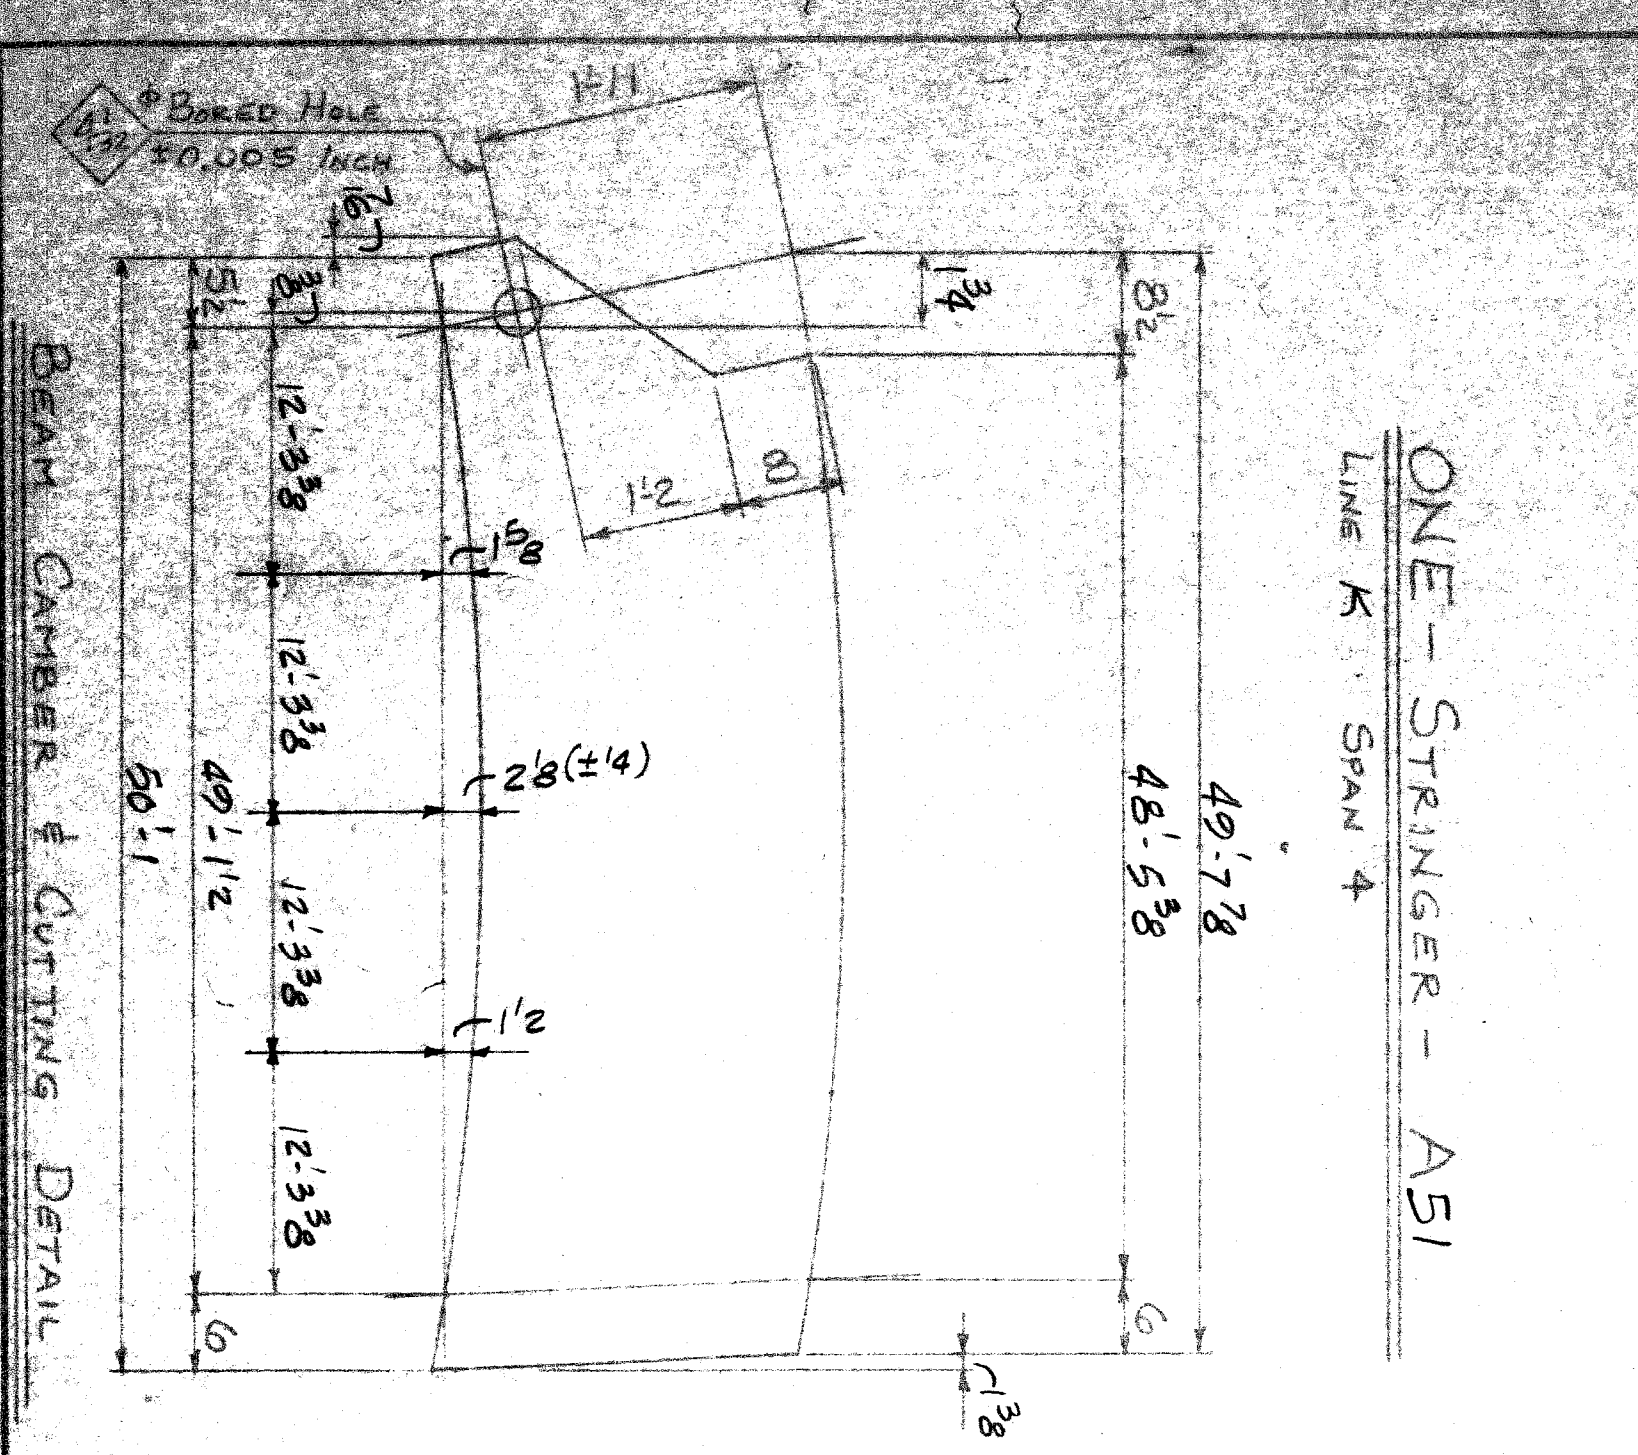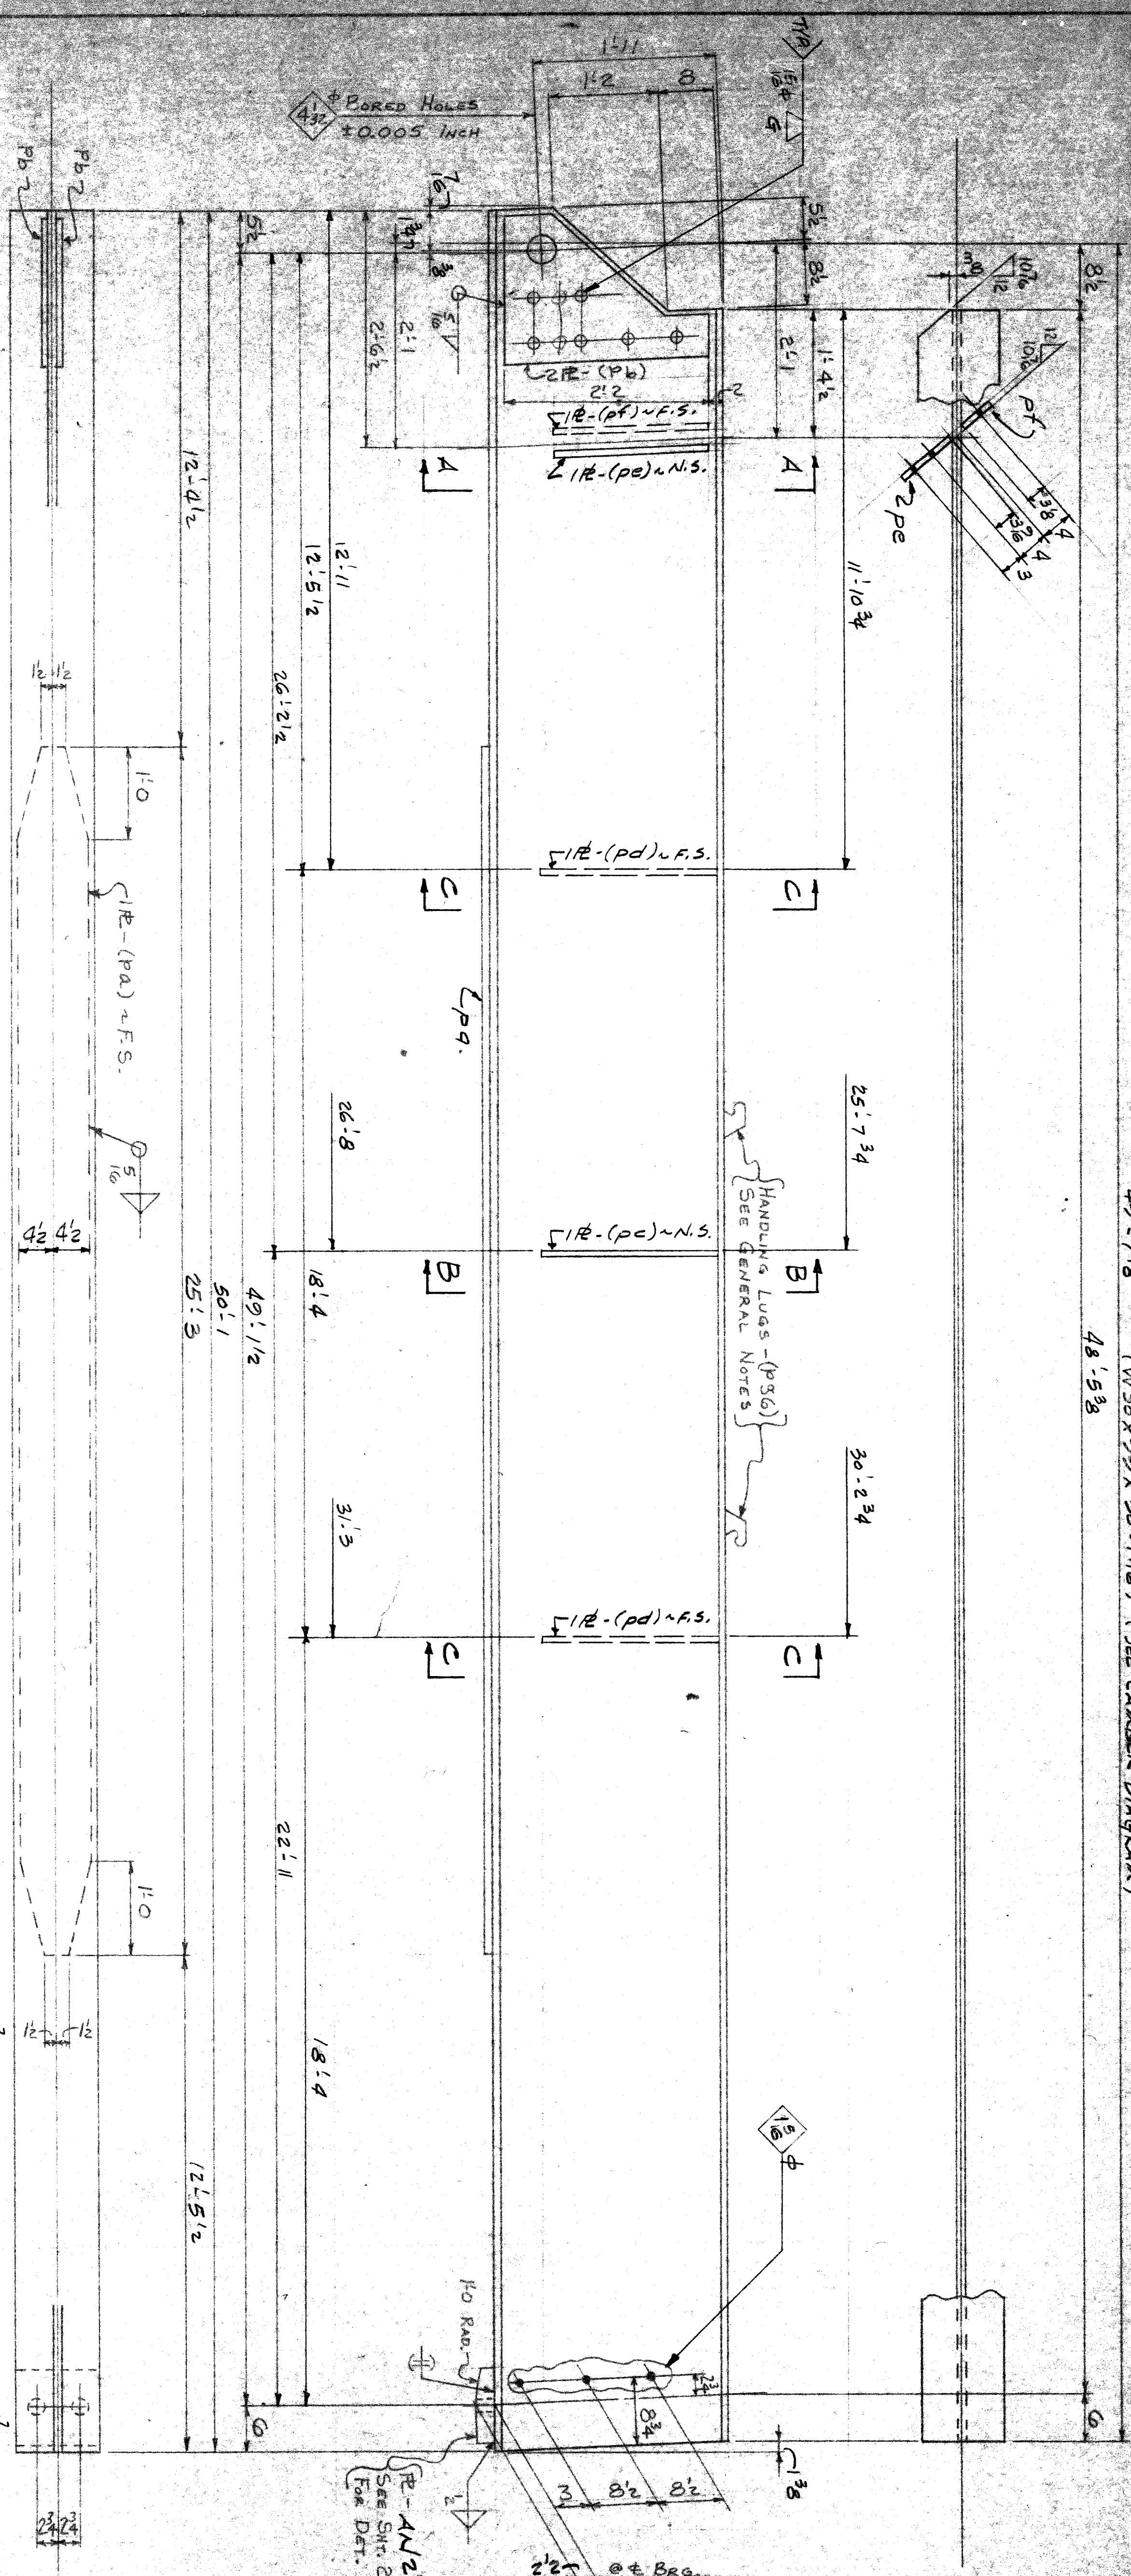







SHOP NOTES  
1 SEE SHEET E4 FOR GENERAL NOTES.  
2 MAT'L: A588 U.N.

LINE NO.	DESCRIPTION	MATERIAL	LENGTH	WEIGHT	REMARKS	DATE
1	STRINGER	A51	50'-1 1/8			1/4
2	1/2" x 30" x 99"	Pa	85		CVN	1/29
3	1/2" x 12" x 4"	Pb	2'-2 1/4		CVN	1/30
4	1/2" x 12" x 4"	Pc	2'-0 1/8			2/6
5	1/2" x 12" x 4"	Pd	1'-8			2/6
6	1/2" x 12" x 4"	Pf	1'-7 1/2			2/11
7	1/2" x 12" x 4"	Pg	0'-6 1/8			2/17
8	1/2" x 12" x 4"	See SHT 2 FOR DET.				
9	1/2" x 12" x 4"	See SHT 2 FOR DET.				
CITY OF DETROIT  
ENGINEERING DEPARTMENT  
APPROVED AS NOTED

PHILIP ZWEIFG & SONS  
BUILDING DIVISION  
2000 BROADVIEW AVE. DETROIT, MICH.  
CONTRACTOR: PHILIP ZWEIFG & SONS  
DRAWN: [Signature]  
DATE: 2-1-77  
SHEET 51 OF 53

47'-1 3/8 (W 30 x 99 x 47'-6 3/8) (SEE CAMBER DIAGRAM)  
 45'-10 3/8

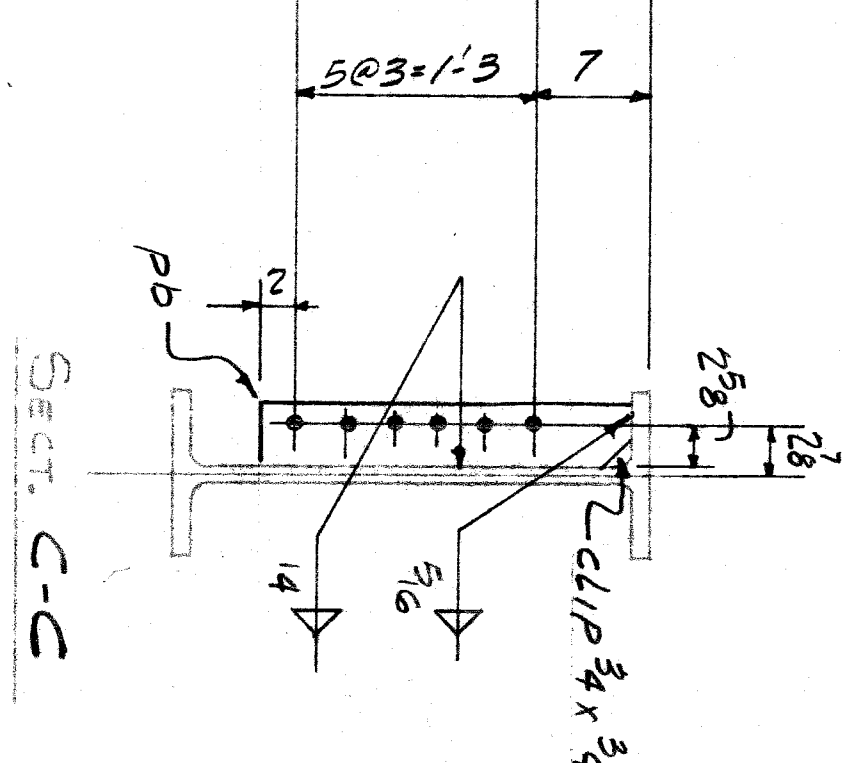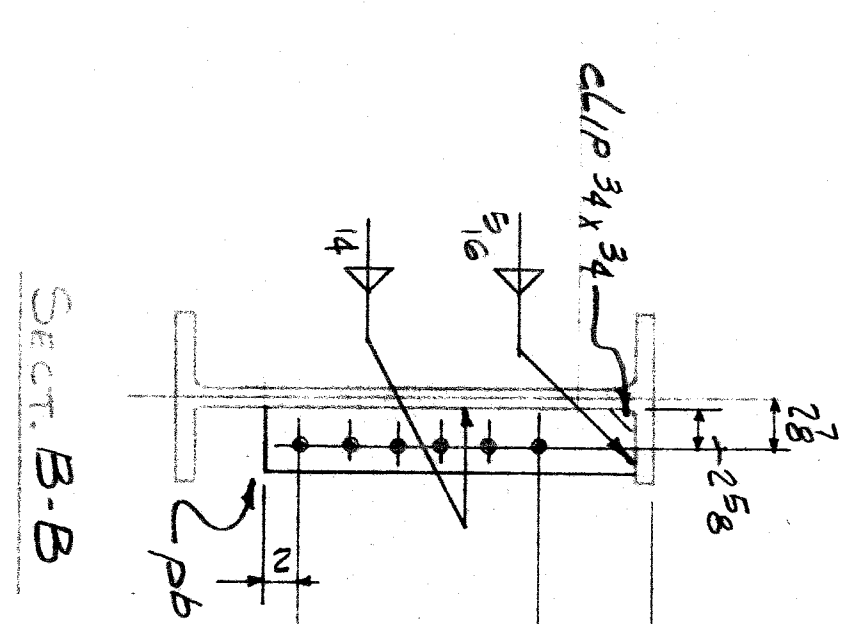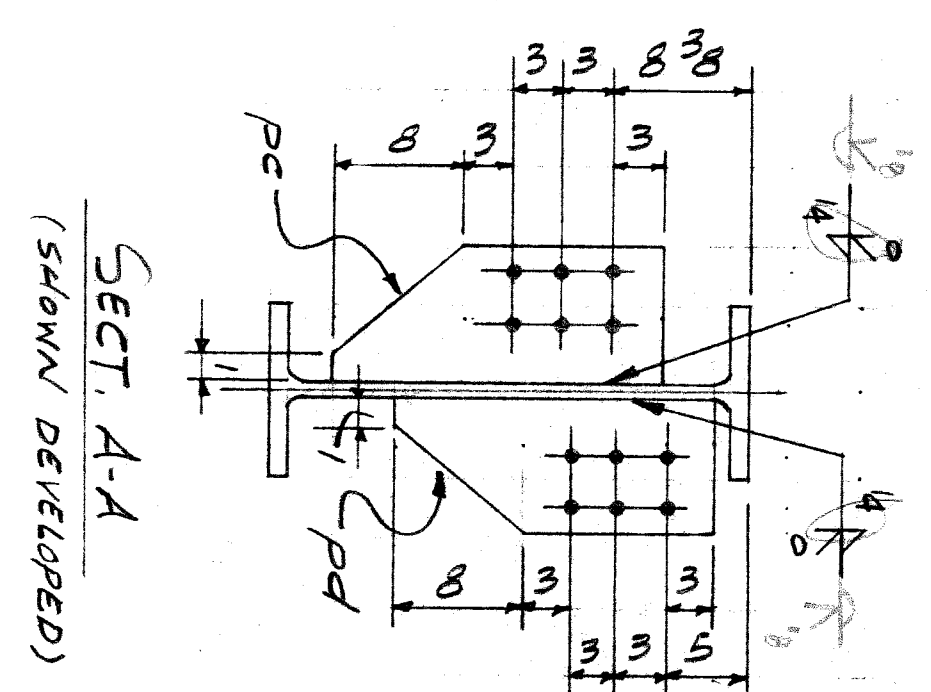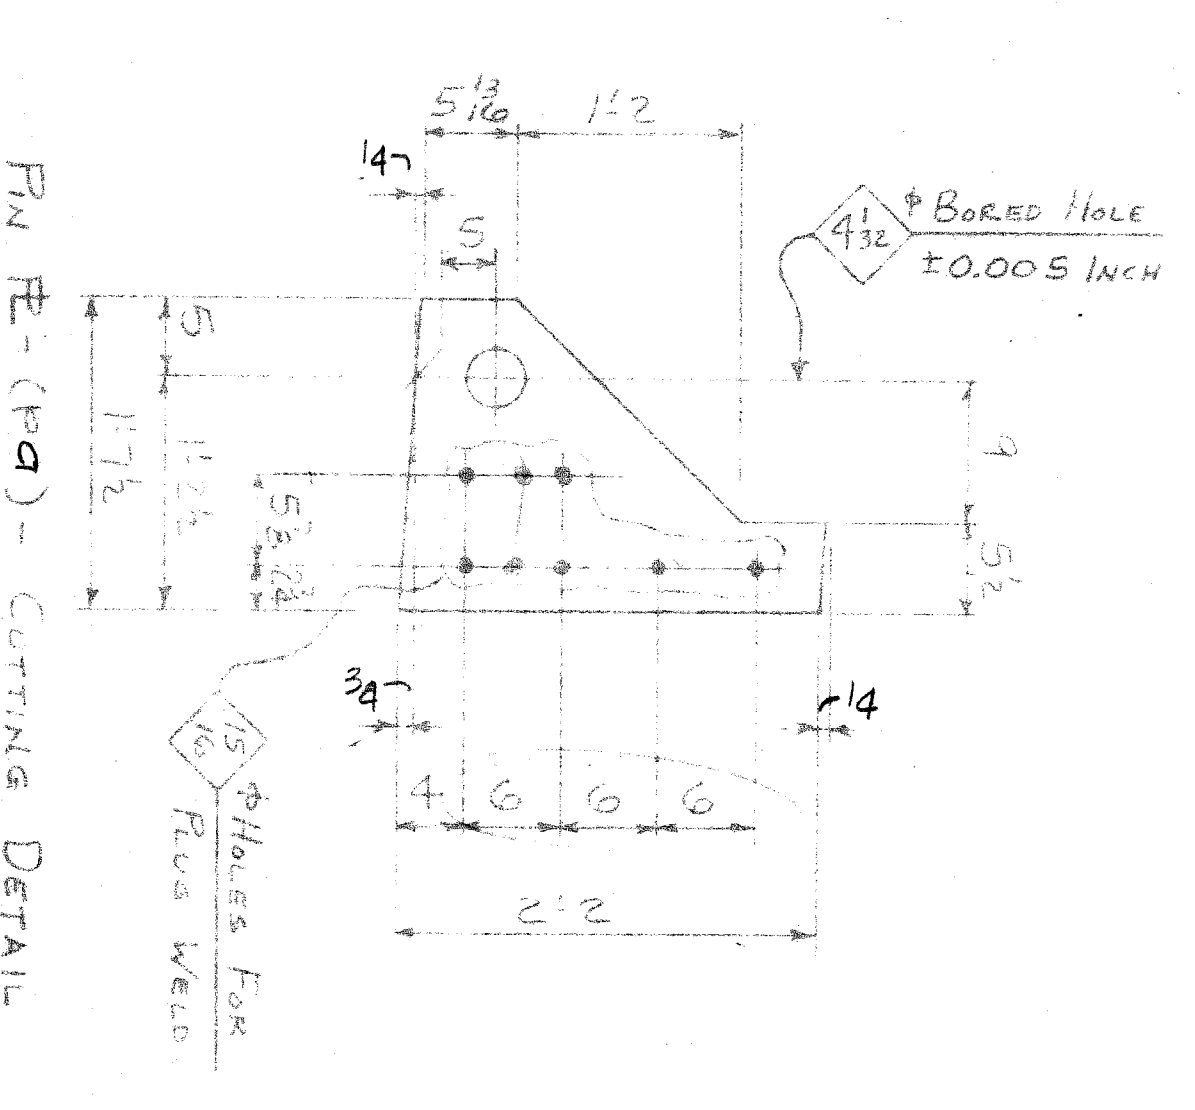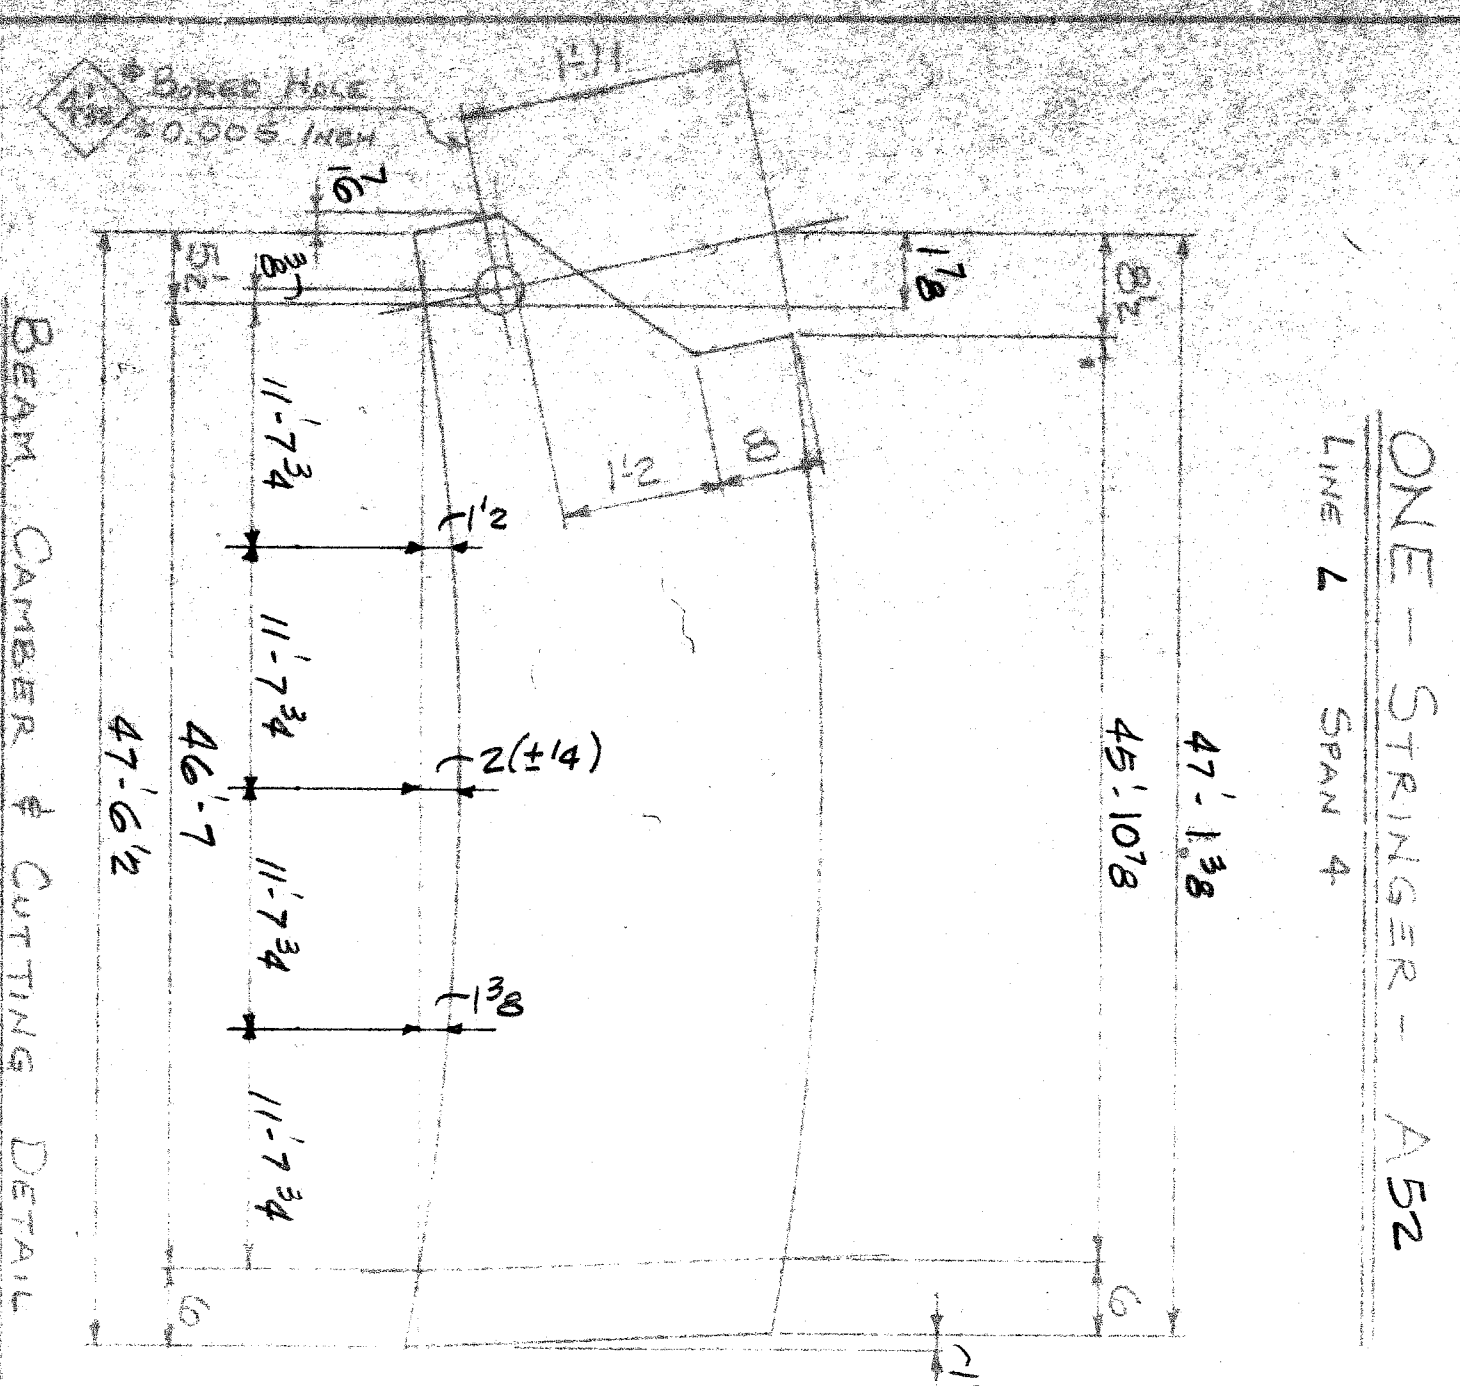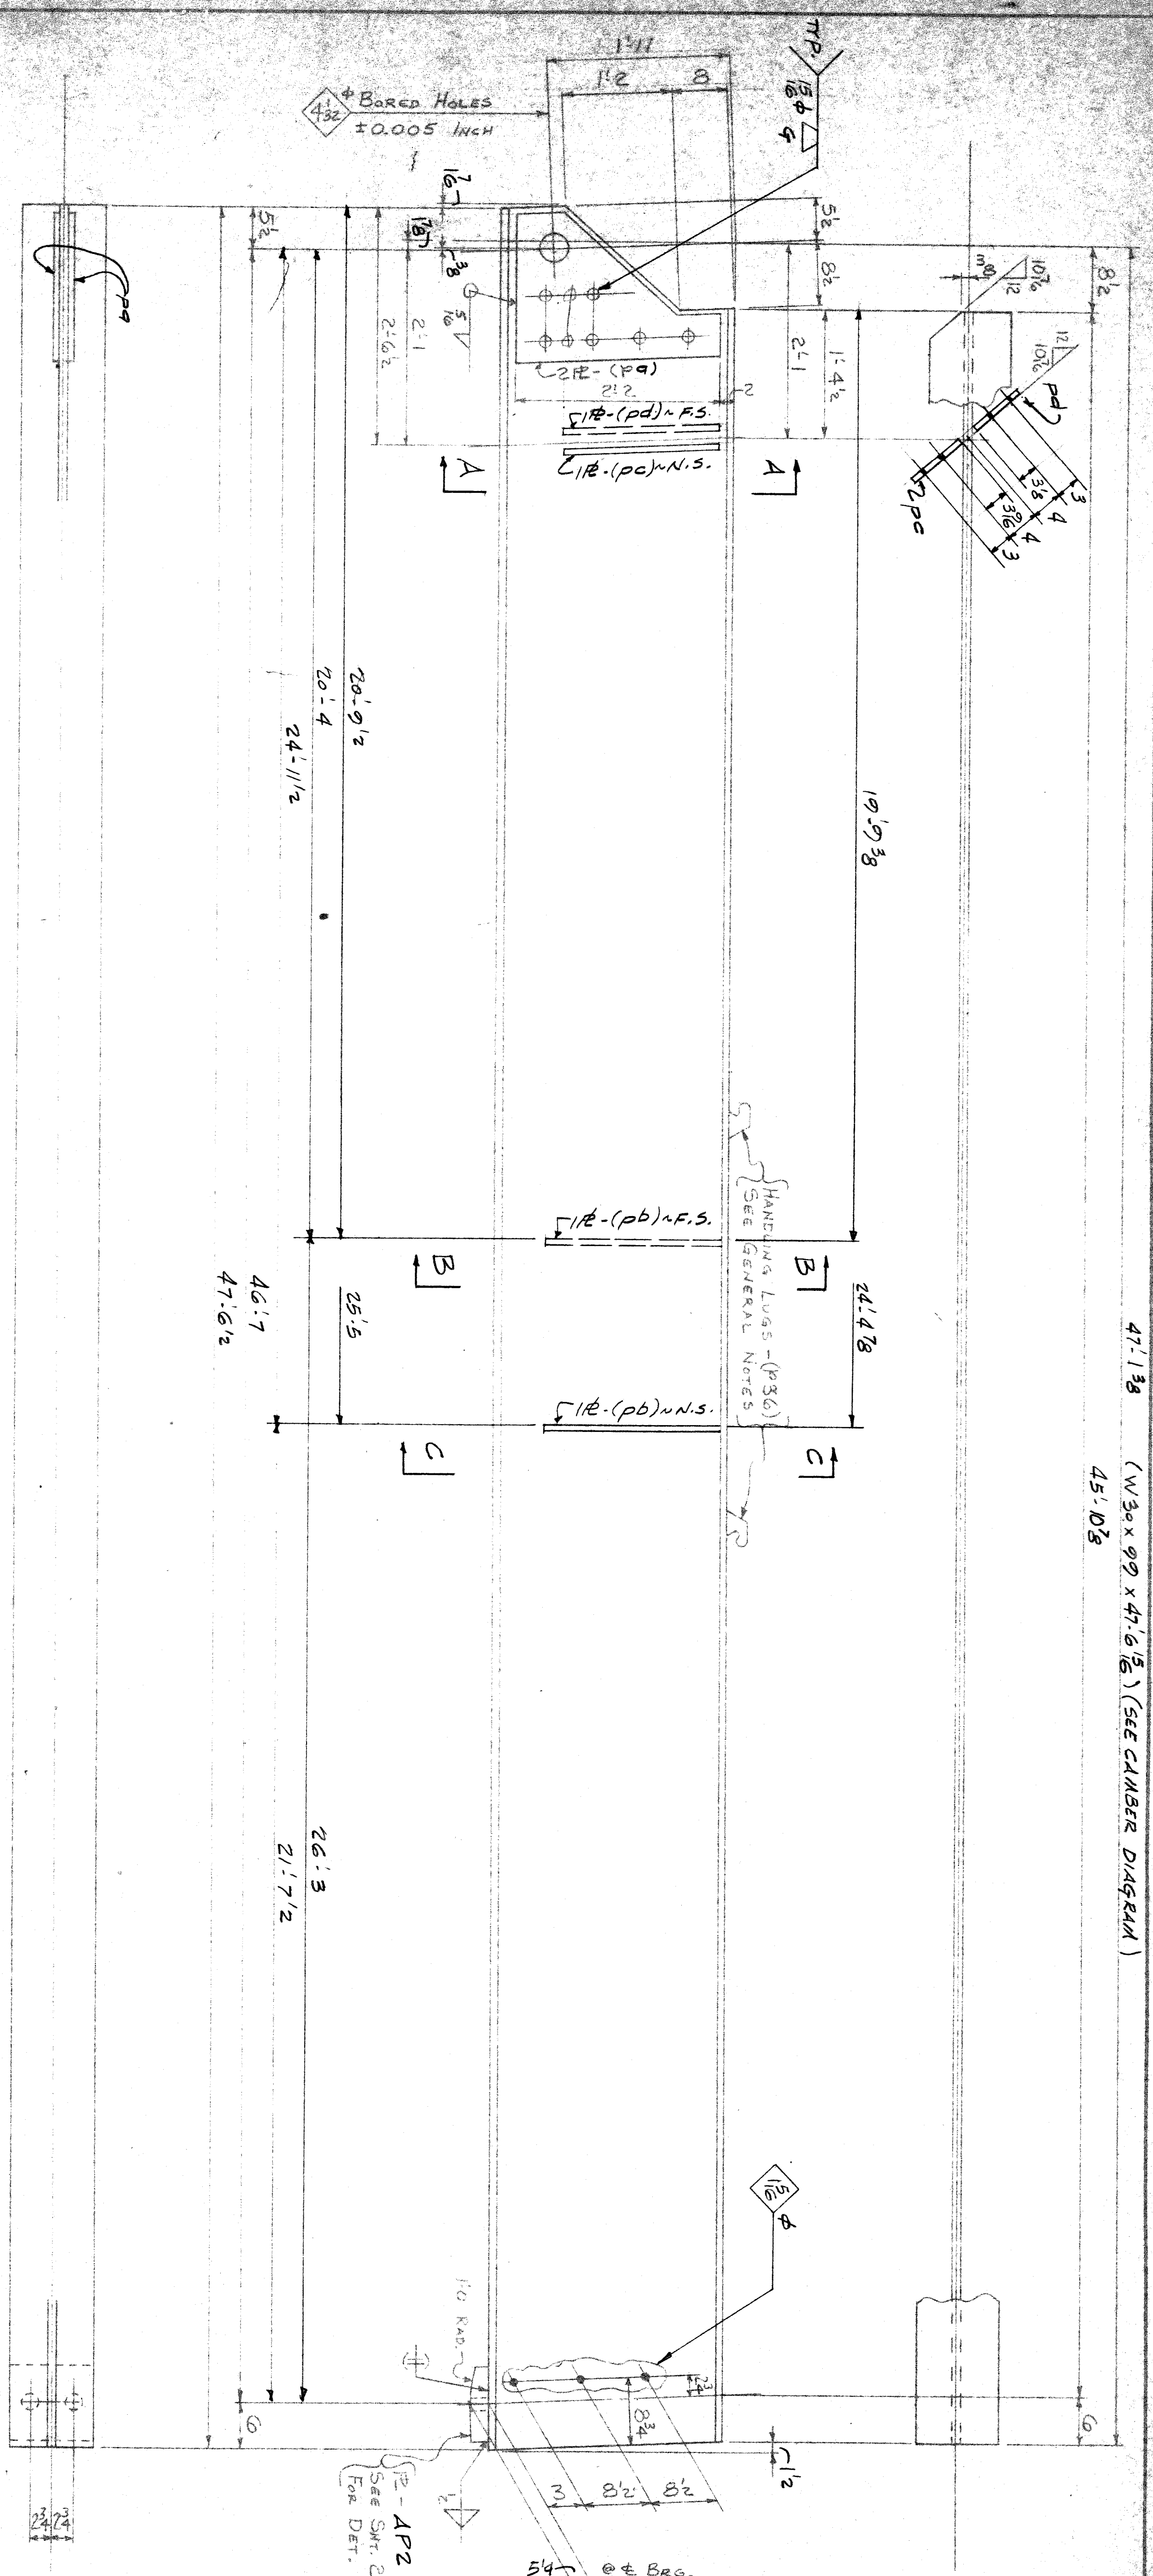





LINE NO.	REV.	DATE	BY	CHKD.	APP'D.	MATERIAL	QUANTITY	REMARKS
1						Stringer	47' 6 3/8	AB2
2						W 30 x 99	2	CVN
3						P 12 1/4	2	CVN
4						P 11 3/8	1	PB
5						P 12 5/8	1	PC
6						P 12 7/8	1	PD
7						P 1 1/4	0	SEE SMT. 2 FOR DET.
8						AP2	54	SEE SMT. 2 FOR DET.
9								
10								
CITY OF DETROIT  
 CITY ENGINEERING DEPARTMENT  
**APPROVED**  
 FOR COMPLIANCE WITH CONTRACT NO. 14-6533  
 THIS APPROVAL SHALL NOT RELIEVE THE CONTRACTOR OF ANY RESPONSIBILITY COVERED BY THE CONTRACT  
 MAR 2 1977

**PHILIP ZWIG & SONS**

Shop Notes  
 1 SEE SHEET E4 FOR GENERAL NOTES.  
 2 MATL: A588 U.N.  
 CONTRACT 335  
 SHEET 52 OF 53

44'-7" (W30x99 x 45'-0 1/16) (SEE CAMBER DIAGRAM)  
43'-4 1/2"

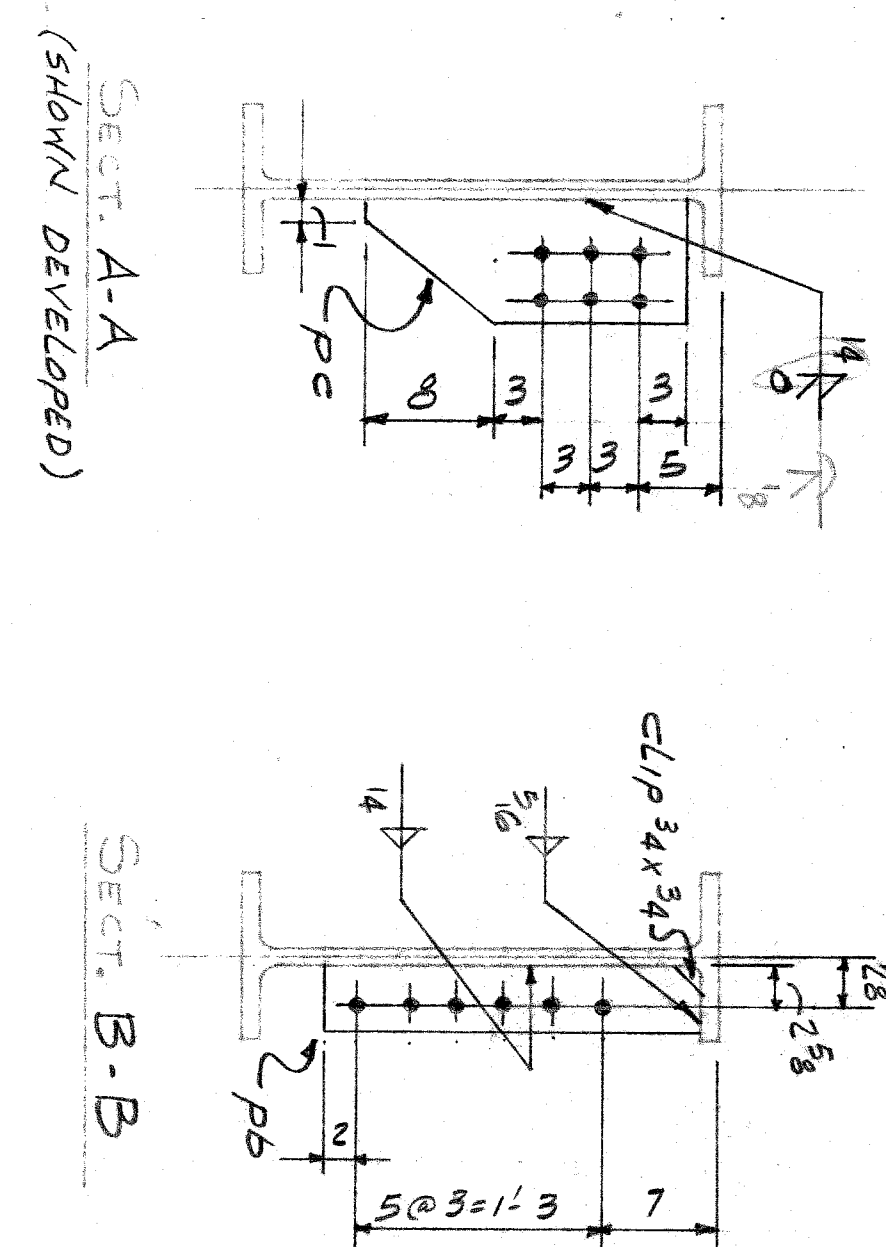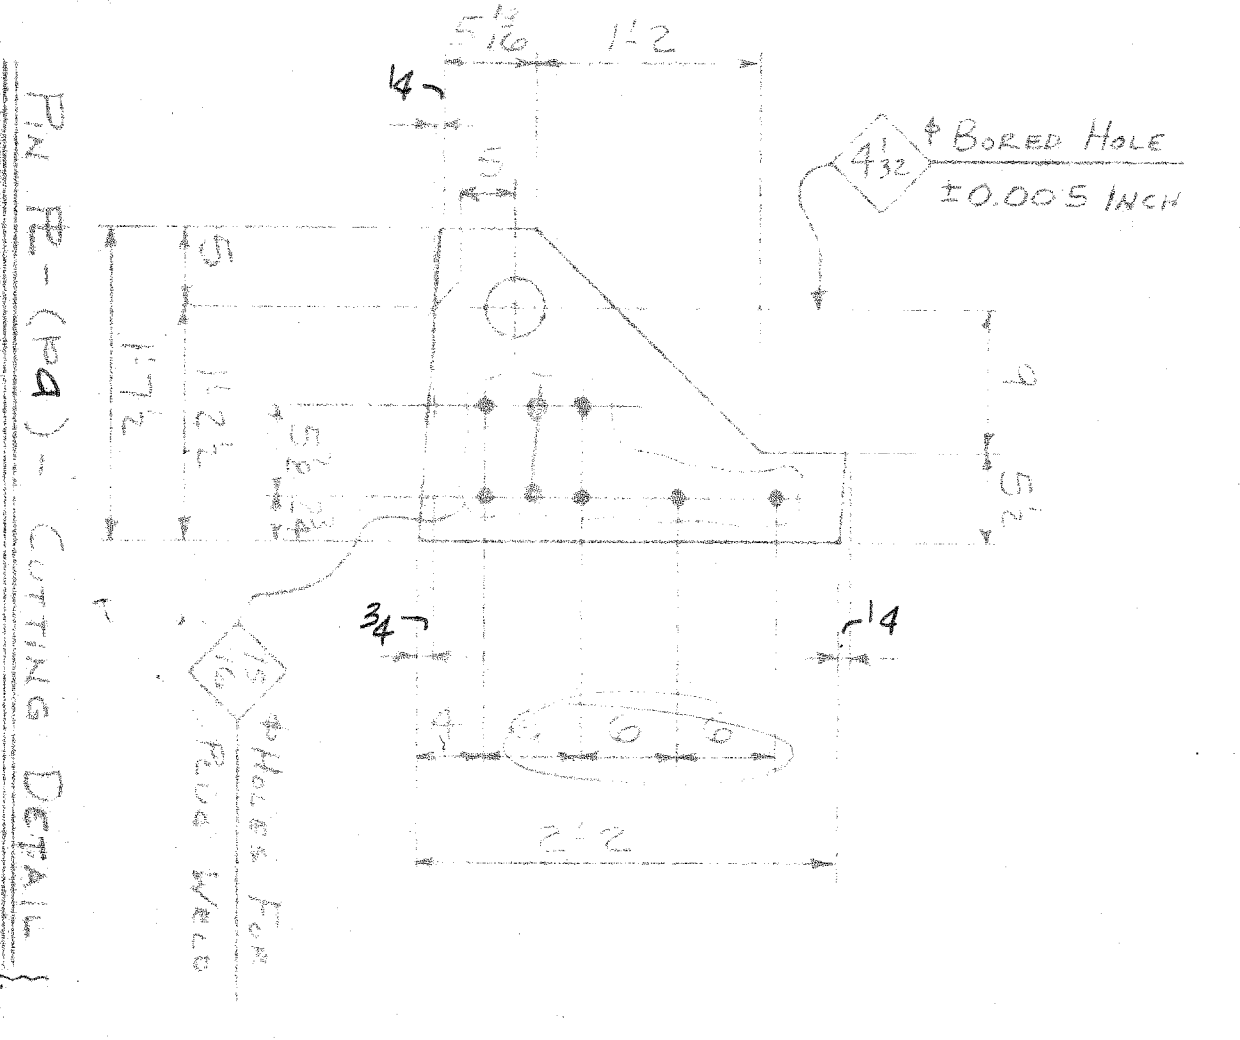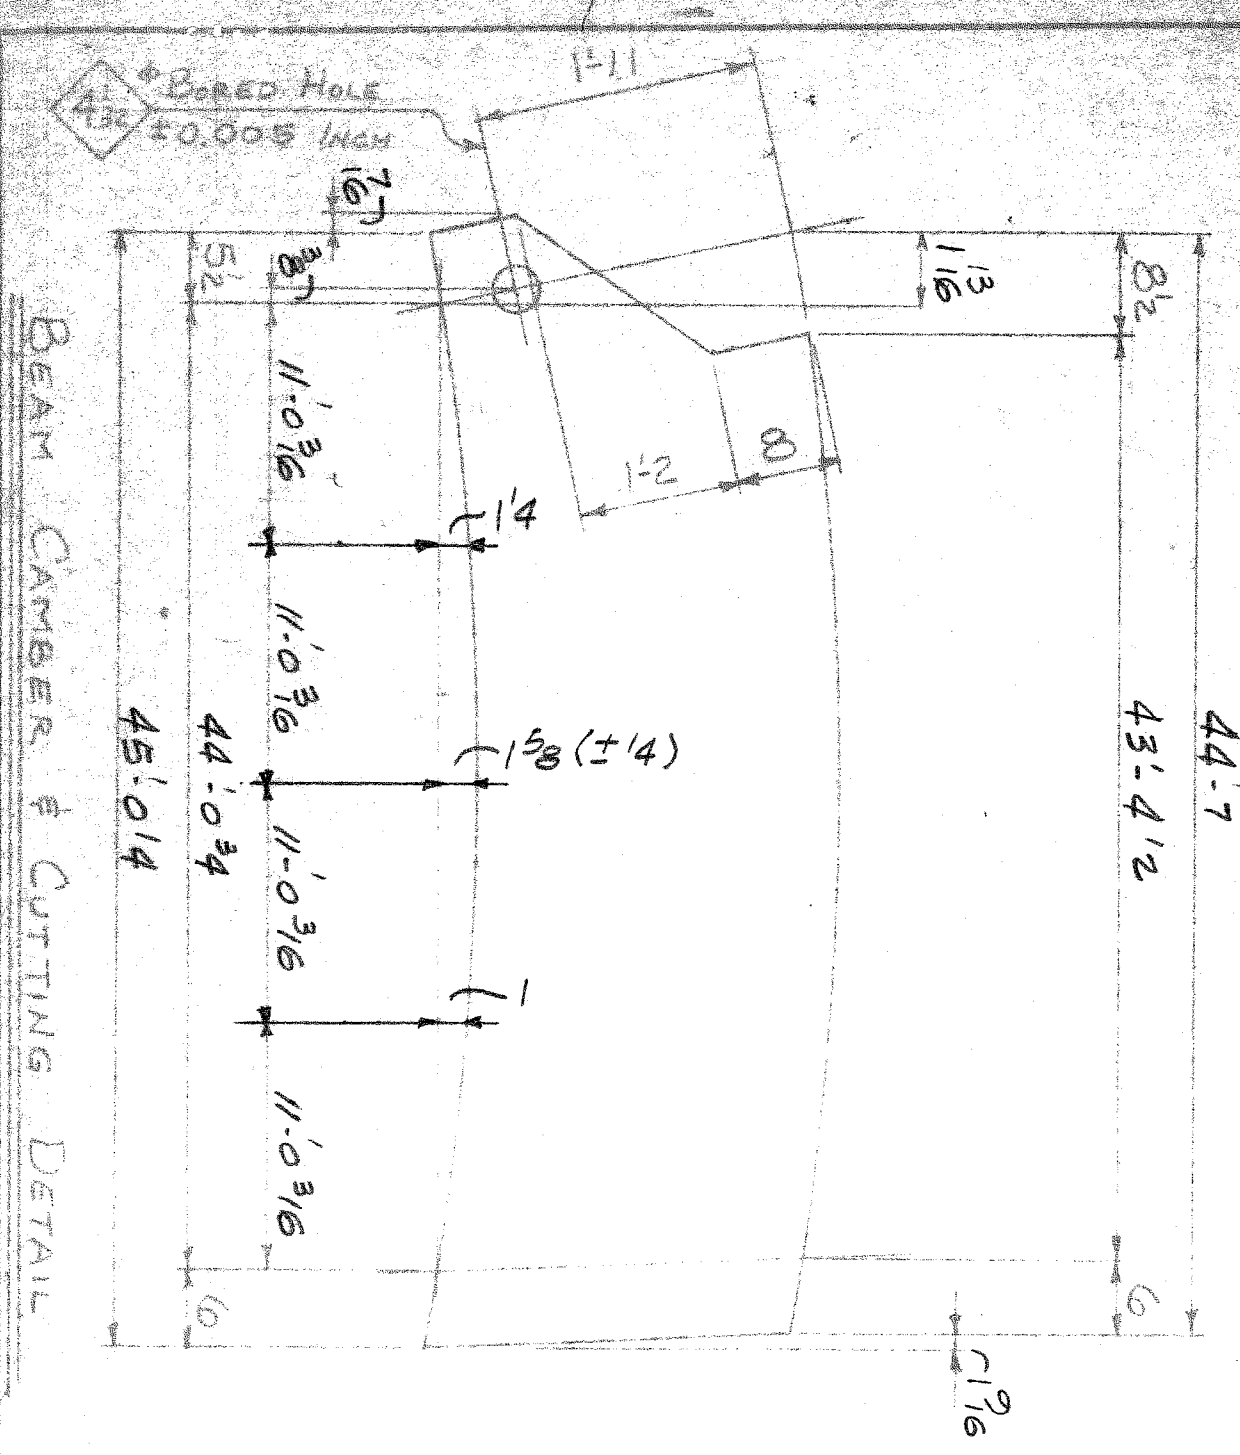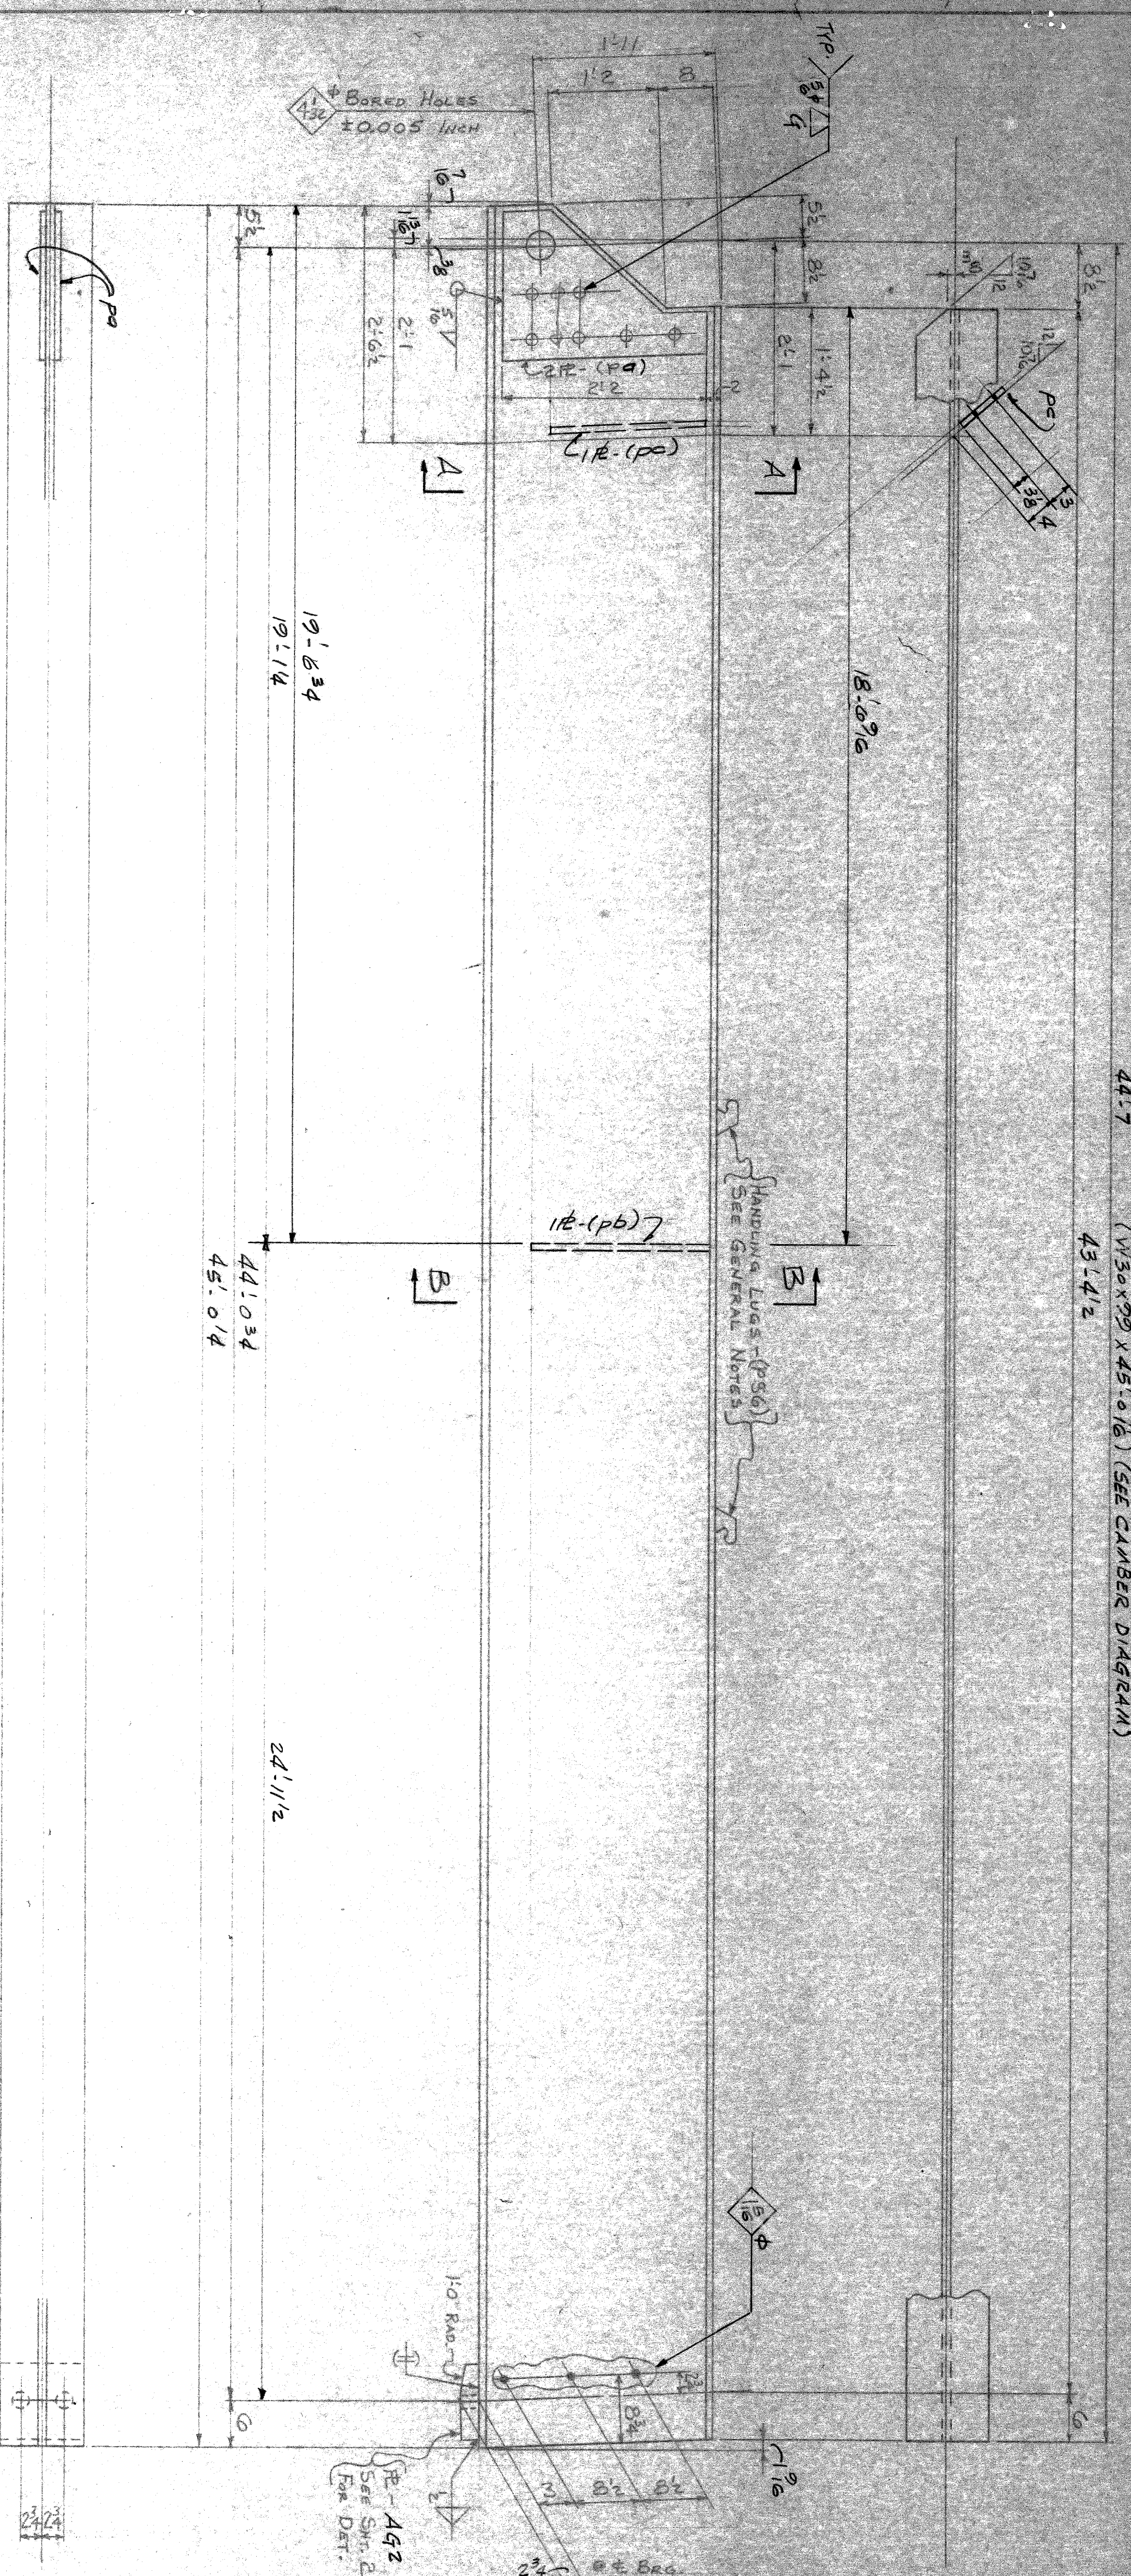

ITEM NO.	DESCRIPTION	QUANTITY	UNIT	REMARKS
1	5' x 30' x 99' A53	45.016	LN	CVN
2	2' x 24' x 12' A53	2.214	LN	CVN
3	1' x 11' x 36' A53	1.136	LN	CVN
4	1' x 8' x 27' A53	1.8	LN	CVN
5	1' x 8' x 27' A53	0.616	LN	CVN
6	1' x 8' x 27' A53	0.616	LN	CVN
**PHILIP ZWEIF & SONS**  
2100 E. 8TH AVE.  
BUILDING Erector Ave. Detroit, Michigan  
OWNER: City Of Detroit, Michigan  
LOCATION: Detroit, Michigan  
CONTRACTOR: Walter T. Treadwell, Construction Company  
ARCHITECT: City Engineering Department, City of Detroit, Michigan  
TITLE: STRINGER, SPAN 4

**CITY OF DETROIT  
CITY ENGINEERING DEPARTMENT  
APPROVED**

FOR COMPLIANCE WITH CONTRACT NO. PW 6552  
THIS APPROVAL SHALL NOT RELIEVE THE CONTRACTOR OF ANY RESPONSIBILITY COVERED BY THE CONTRACT  
DATE: 8/27/77 BY: [Signature]

**SHOP NOTES**  
1 SEE SHEET E4 FOR GENERAL NOTES.  
2 MATL: A588 U.N.

CONTRACT 335 SHEET 53 OF 53