

BENCH MARKS

P.B.M. # 28-356 ELEV. 100.217
BRASS CAP IN HANDHOLE SET IN WALK OF CENTER ISLAND. 82' N & JEFFERSON AVE (70' WIDE) EXTENDED EAST AND 45' E WL THIRD ST. (59.42' WIDE) EXTENDED NORTHWESTERLY

C.B.M. # 1 ELEV. 110.30
STEEL CUT NAIL IN JOINT OF JOHN C. LODGE SOUTHBOUND RETAINING WALL ON ABOUT THE EAST LINE OF THIRD EXTENDED SOUTHEASTERLY FROM CONGRESS. ABOUT 3.5' ABOVE GROUND

C.B.M. # 2 ELEV. 99.76
RR SPIKE IN TRANSFORMER POLE ON WEST LINE OF THIRD ST. (59.42' WIDE) AND 85' SS R. JEFFERSON AVE (70' WIDE)

WITNESSES



THE CITY OF DETROIT WILL RE-ESTABLISH THE ϵ SURVEY OF EXISTING JEFFERSON AVE. PRIOR TO AWARD OF THE CONTRACT. THE CONTRACTOR SHALL CONTACT THE CITY ENGINEERING DEPARTMENT TO OBTAIN WITNESSED POINTS.

JEFFERSON AVE. EXIT RAMP CURVE DATA

CURVE # 1	CURVE # 2	CURVE # 3	CURVE # 4
$\Delta = 29^{\circ}01'49"$ RT.	$\Delta = 103^{\circ}51'23"$ RT.	$\Delta = 47^{\circ}13'23"$ RT.	$\Delta = 41^{\circ}49'00.4"$ LT.
D = 19^{\circ}05'54.9"	D = 27^{\circ}01'34.7"	D = 35^{\circ}22'04.0"	D = 47^{\circ}44'47.3"
R = 300'	R = 212'	R = 162'	R = 120'
T = 77.67'	T = 270.65'	T = 70.81'	T = 45.84'
L = 152'	L = 384.28'	L = 133.52'	L = 87.58'
E = 9.89'	E = 131.80'	E = 14.80'	E = 8.46'
P.C. = 202+54.33	P.C. = 204+06.33	P.C. = 207+90.61	P.C. = 210+11.38
P.I. = 203+32.00	P.I. = 206+76.98	P.I. = 208+61.42	P.I. = 210+57.22
P.T. = 204+06.33	P.T. = 207+90.61	P.T. = 209+24.13	P.T. = 210+98.96
SE = 0.04'/'	SE = 0.04'/'	SE = 0.04'/'	SE = 0.03'/'

CURVE # 5	CURVE # 20	CURVE # 21	CURVE # 22
$\Delta = 3^{\circ}32'50.3"$ RT.	$\Delta = 15^{\circ}44'11.7"$ RT.	$\Delta = 11^{\circ}07'34"$ LT.	$\Delta = 38^{\circ}19'37"$ RT.
D = 5^{\circ}34'44.2"	D = 57^{\circ}17'44.8"	D = 57^{\circ}17'44.8"	D = 57^{\circ}17'44.8"
R = 1027'	R = 100'	R = 100'	R = 100'
T = 31.80'	T = 13.82'	T = 9.74'	T = 34.75'
L = 63.58'	L = 27.47'	L = 19.42'	L = 66.89'
E = 0.49'	E = 0.95'	E = 0.47'	E = 5.87'
P.C. = 212+96.22	P.C. = 320+03.18	P.C. = 320+56.80	P.C. = 321+18.48
P.I. = 213+28.02	P.I. = 320+17.00	P.I. = 320+66.54	P.I. = 321+53.23
P.T. = 213+59.81	P.T. = 320+30.65	P.T. = 320+76.22	P.T. = 321+85.37
SE = 0.015'/'			SE = 0.015'/'

NOTE: ADD 479.755' TO CONVERT TO U.S.C.G.S. DATUM
DATUM FOR JOE LOUIS SPORTS ARENA PARKING GARAGE PLANS
MAY BE DIFFERENT THAN CITY DATUM AND SHOULD NOT BE USED
ON THE PROJECT.

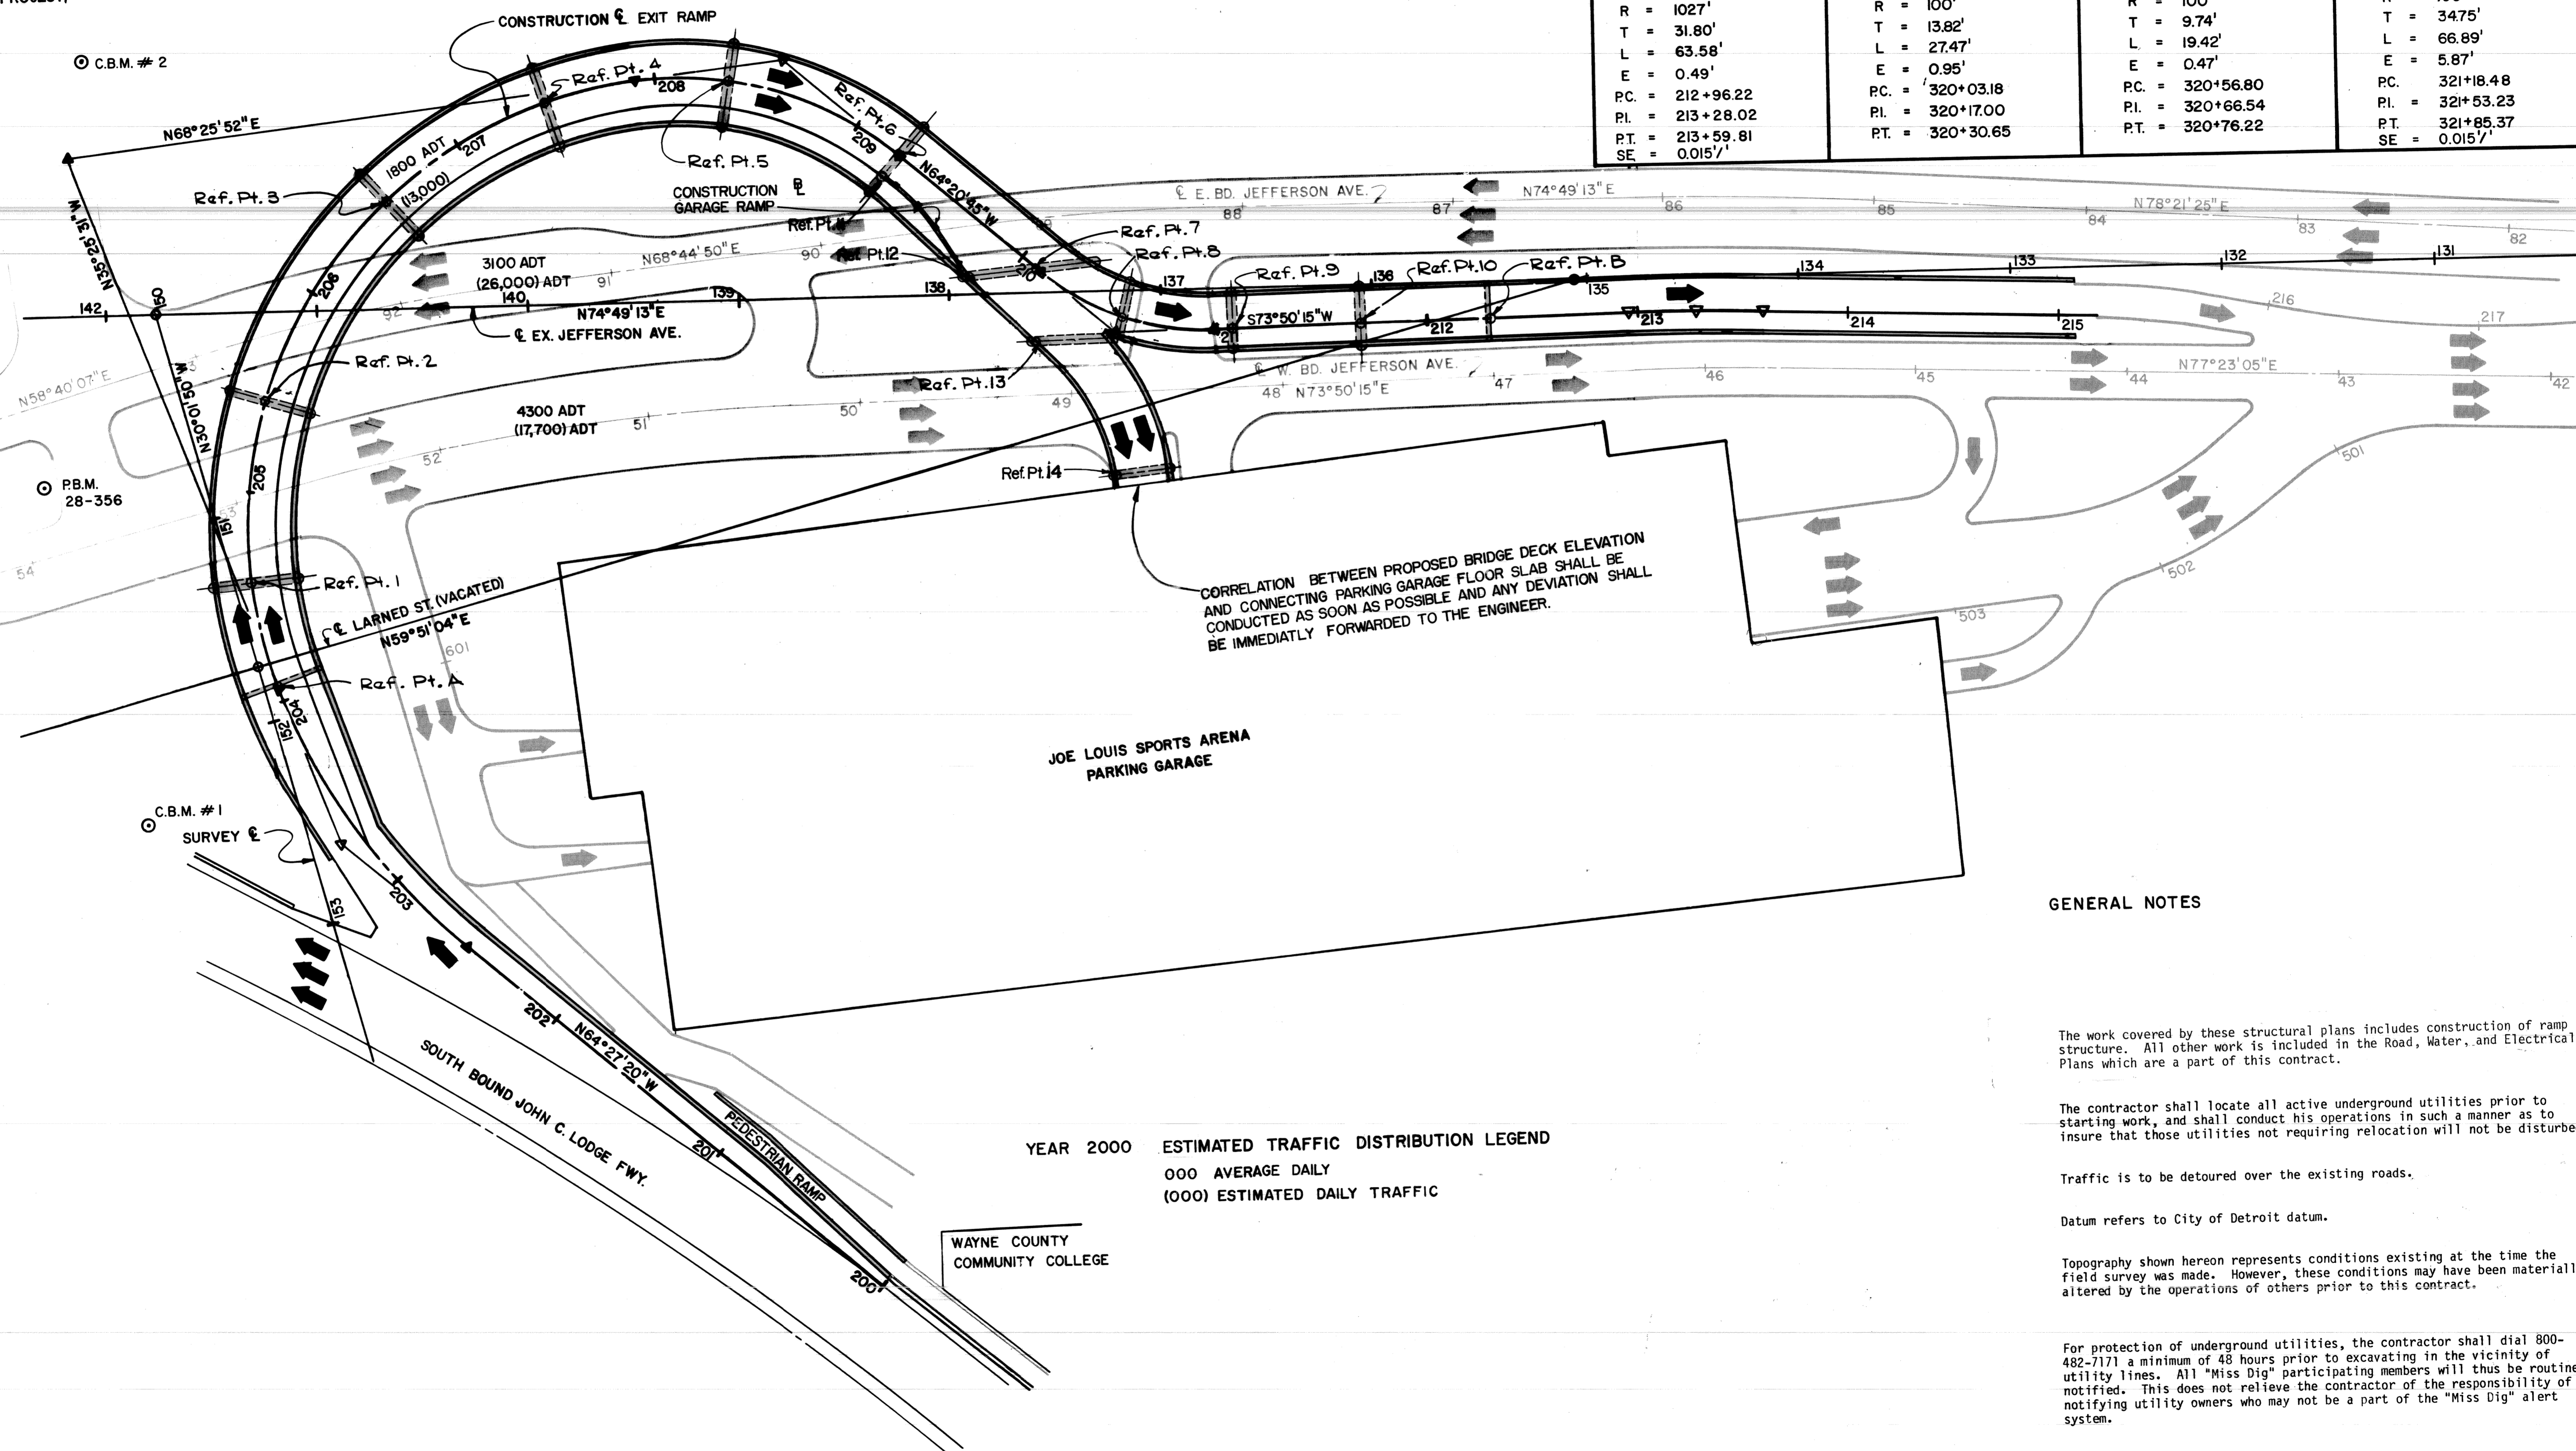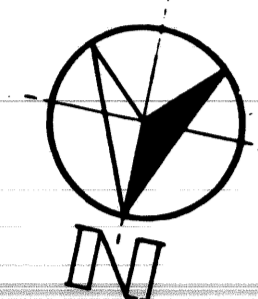

CORRELATION BETWEEN PROPOSED BRIDGE DECK ELEVATION AND CONNECTING PARKING GARAGE FLOOR SLAB SHALL BE CONDUCTED AS SOON AS POSSIBLE AND ANY DEVIATION SHALL BE IMMEDIATELY FORWARDED TO THE ENGINEER.

YEAR 2000 ESTIMATED TRAFFIC DISTRIBUTION LEGEND
000 AVERAGE DAILY
(000) ESTIMATED DAILY TRAFFIC

GENERAL NOTES

- The work covered by these structural plans includes construction of ramp structure. All other work is included in the Road, Water, and Electrical Plans which are a part of this contract.
- The contractor shall locate all active underground utilities prior to starting work, and shall conduct his operations in such a manner as to insure that those utilities not requiring relocation will not be disturbed.
- Traffic is to be detoured over the existing roads.
- Datum refers to City of Detroit datum.
- Topography shown hereon represents conditions existing at the time the field survey was made. However, these conditions may have been materially altered by the operations of others prior to this contract.
- For protection of underground utilities, the contractor shall dial 800-482-7171 a minimum of 48 hours prior to excavating in the vicinity of utility lines. All "Miss Dig" participating members will thus be routinely notified. This does not relieve the contractor of the responsibility of notifying utility owners who may not be a part of the "Miss Dig" alert system.

1	A
2	
3	
4	

DSGN BY: RGW, SJP	REVISIONS
DRN BY: SJP	
CK'D BY: RGW	
APP'D BY:	

CITY OF DETROIT, MICHIGAN





Work This Sheet With Sheets # S2 thru S5
JOHN C. LODGE EXIT RAMP AND JEFFERSON AVENUE RECONSTRUCTION AT THE JOE LOUIS ARENA.

GENERAL PLAN OF SITE
BRIDGE PLAN & PROPOSED ROADWAY

SCALE: NONE
DRN. NO: SJ

DATE: August, 1979

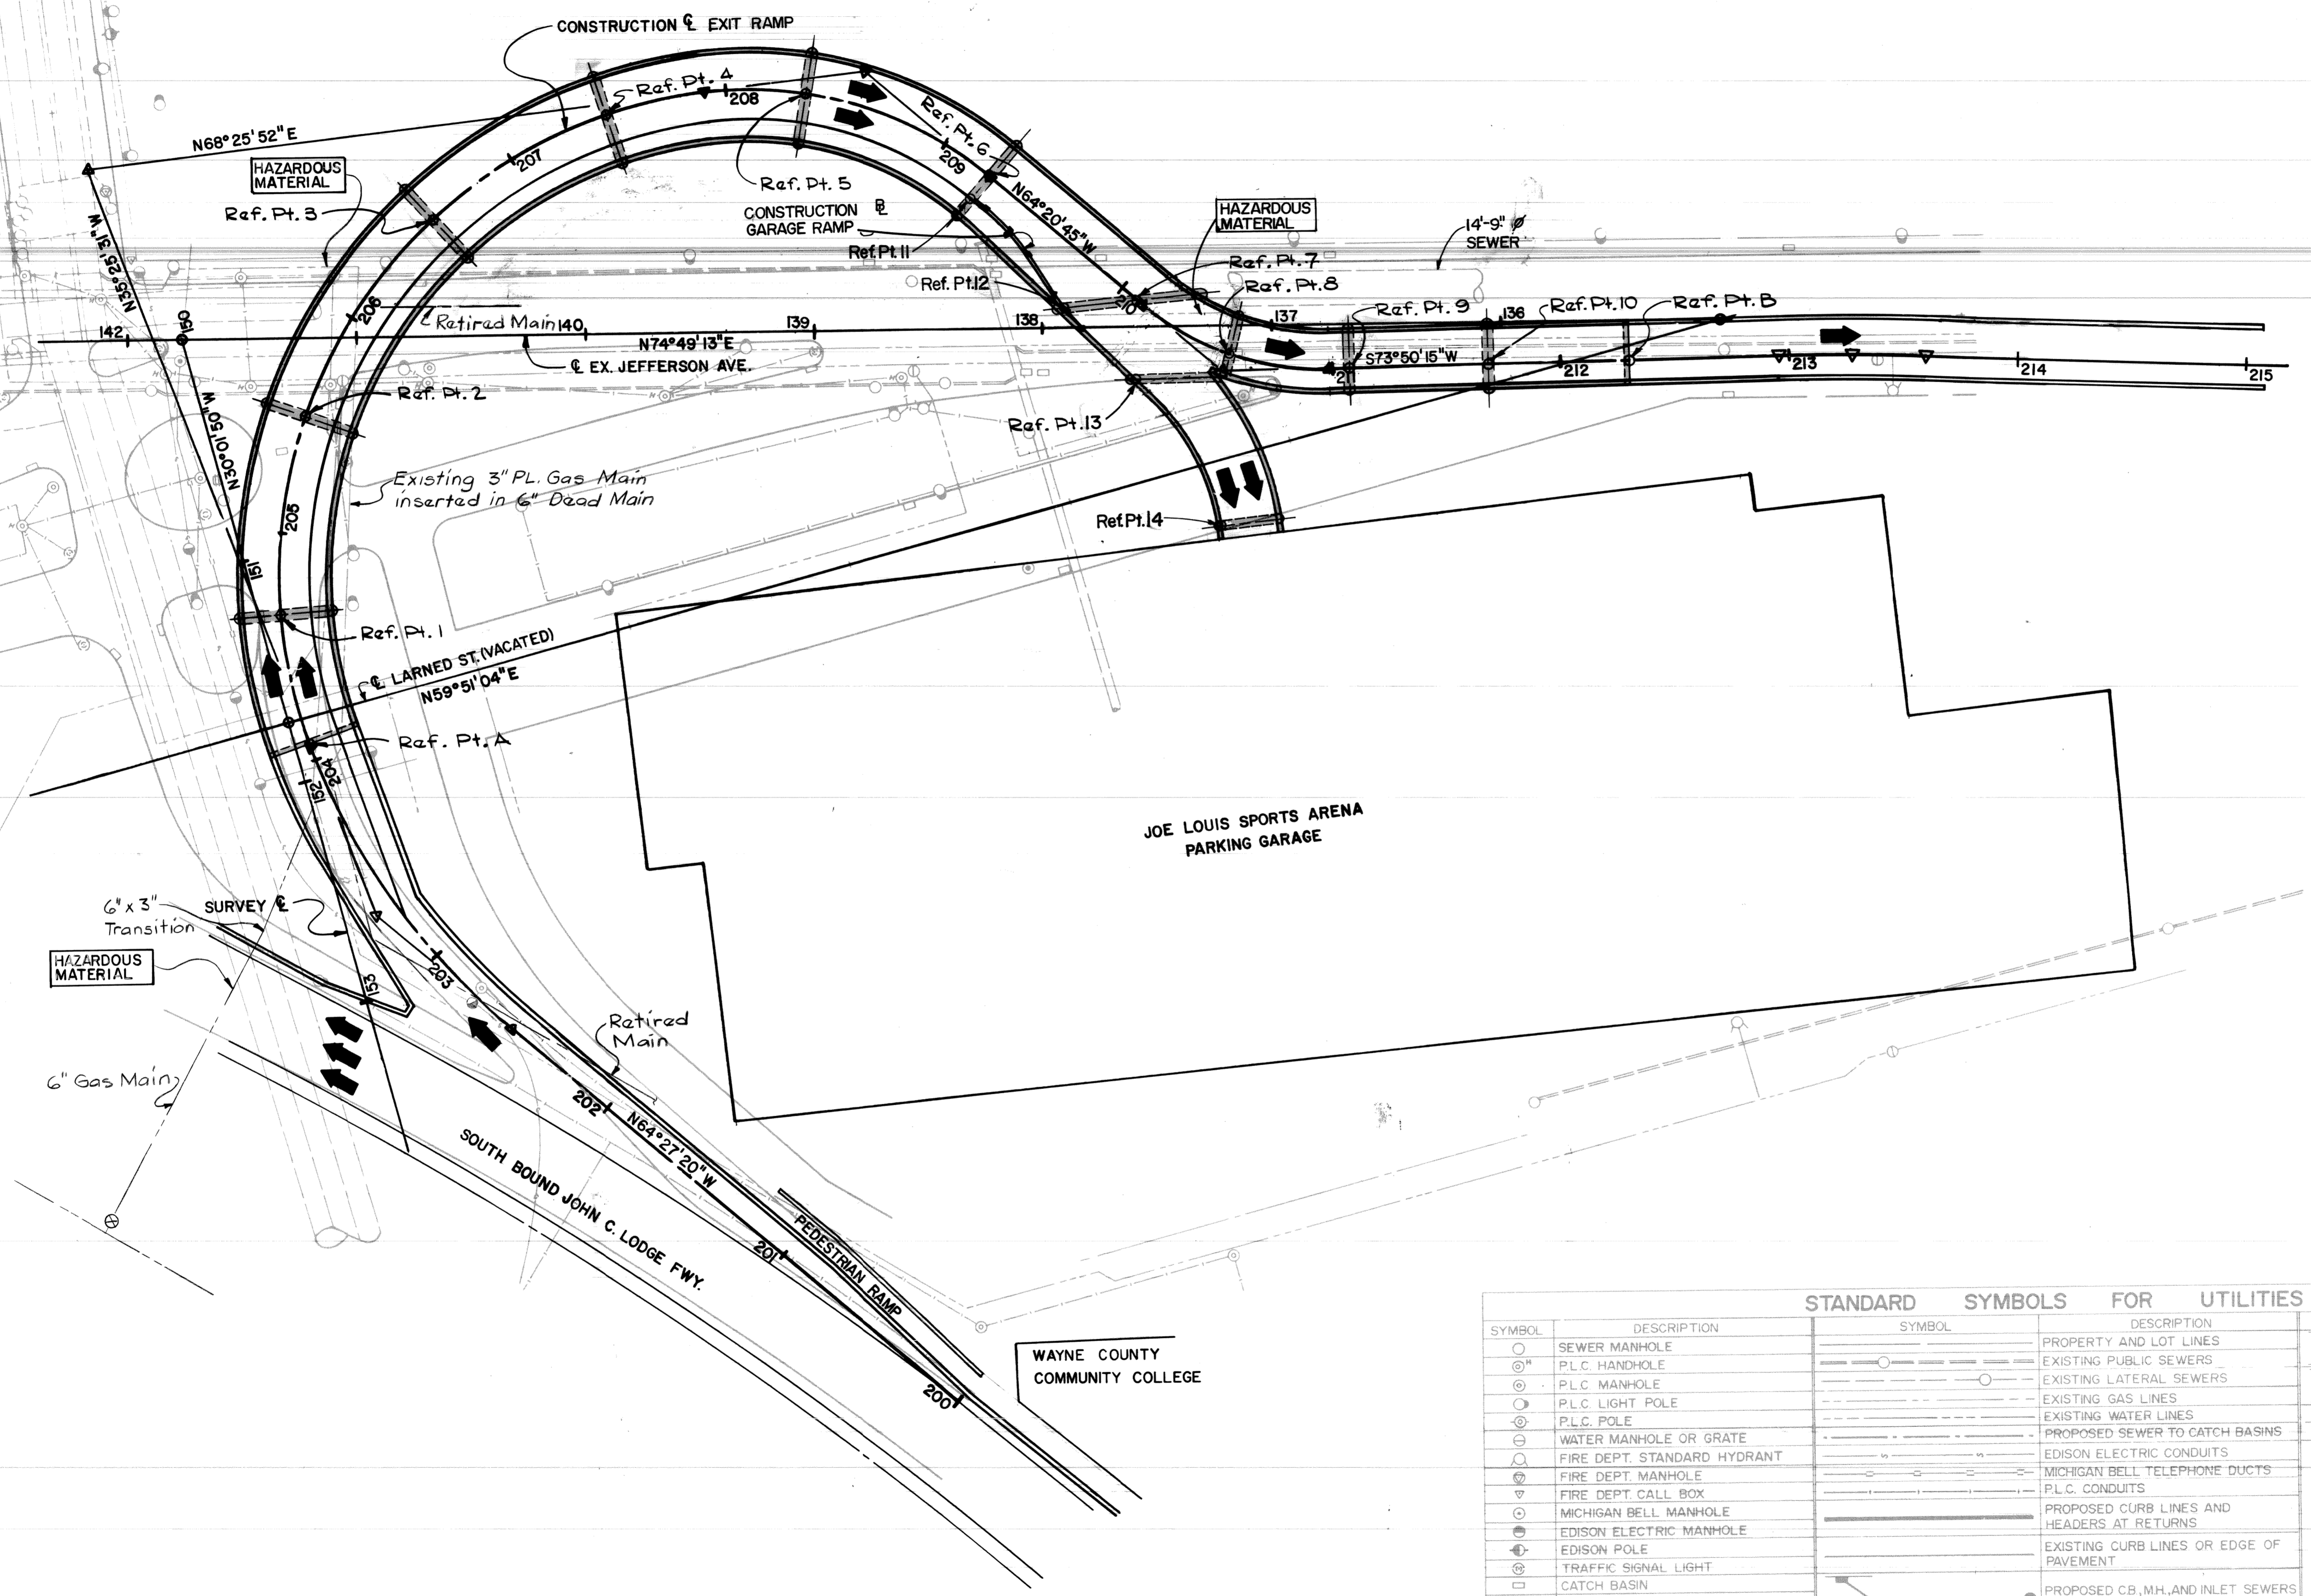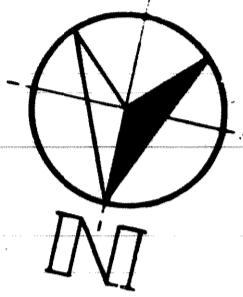

I
A
C

STANDARD SYMBOLS FOR UTILITIES (DETROIT)			
SYMBOL	DESCRIPTION	SYMBOL	DESCRIPTION
○	SEWER MANHOLE	—○—	PROPERTY AND LOT LINES
⊙	P.L.C. HANDHOLE	—○—	EXISTING PUBLIC SEWERS
⊙	P.L.C. MANHOLE	—○—	EXISTING LATERAL SEWERS
⊙	P.L.C. LIGHT POLE	—○—	EXISTING GAS LINES
⊙	P.L.C. POLE	—○—	EXISTING WATER LINES
⊙	WATER MANHOLE OR GRATE	—○—	PROPOSED SEWER TO CATCH BASINS
⊙	FIRE DEPT. STANDARD HYDRANT	—○—	EDISON ELECTRIC CONDUITS
⊙	FIRE DEPT. MANHOLE	—○—	MICHIGAN BELL TELEPHONE DUCTS
⊙	FIRE DEPT. CALL BOX	—○—	P.L.C. CONDUITS
⊙	MICHIGAN BELL MANHOLE	—○—	PROPOSED CURB LINES AND HEADERS AT RETURNS
⊙	EDISON ELECTRIC MANHOLE	—○—	EXISTING CURB LINES OR EDGE OF PAVEMENT
⊙	EDISON POLE	—○—	PROPOSED CB, M.H., AND INLET SEWERS
⊙	TRAFFIC SIGNAL LIGHT	—○—	
⊙	CATCH BASIN	—○—	


Work This Sheet With Sheets# S1# S3 thru S5

DATE: August, 1979

DSGN BY: RGW	
DR'N BY: SJP	
CK'D BY: RGW	
APP'D BY:	

REVISIONS	

CITY OF DETROIT, MICHIGAN

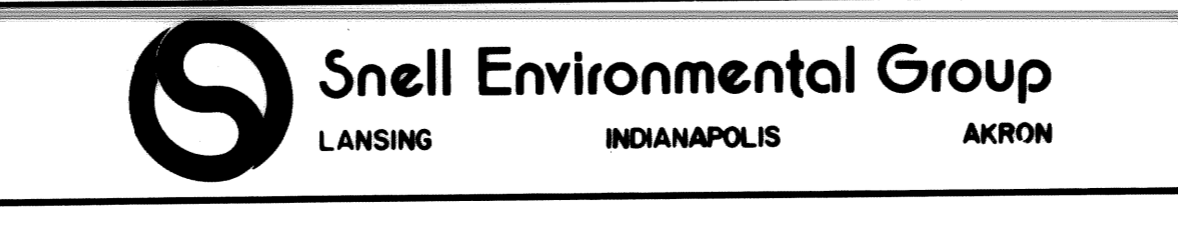



JOHN C. LODGE EXIT RAMP AND JEFFERSON AVENUE- RECONSTRUCTION AT THE JOE LOUIS ARENA.

GENERAL PLAN OF SITE
PROPOSED BRIDGE & EXISTING UTILITIES

SCALE: NONE
DRN. NO: S2

UTILITIES



Michigan Bell Telephone Company Right of Way - Metro 27777 Franklin Road Southfield, Michigan 48034 Telephone	Michigan Consolidated Gas Company One Woodward Avenue Detroit, Michigan 48226 Gas Mains	City of Detroit Public Lighting Department 7500 Joseph Campau Detroit, Michigan 48221 Lighting Communications	City of Detroit Detroit Water and Sewerage Department 735 Randolph Street Detroit, Michigan 48226 Water Mains Sewers	City of Detroit Detroit Fire Department 250 W. Larned Detroit, Michigan 48226 Fire Call Box	City of Detroit Detroit Police Department 1300 Beaubien Detroit, Michigan 48226 Police Call Box	City of Detroit Department of Transportation 1301 E. Warren Detroit, Michigan 48207 D.O.T. Traffic	Detroit Edison Company Detroit Service Planning 6200 W. Warren, B-207 H.S.C. Detroit, Michigan 48210 Electric Power
---	--	---	---	---	---	---	---

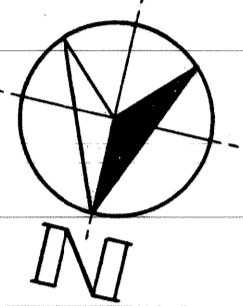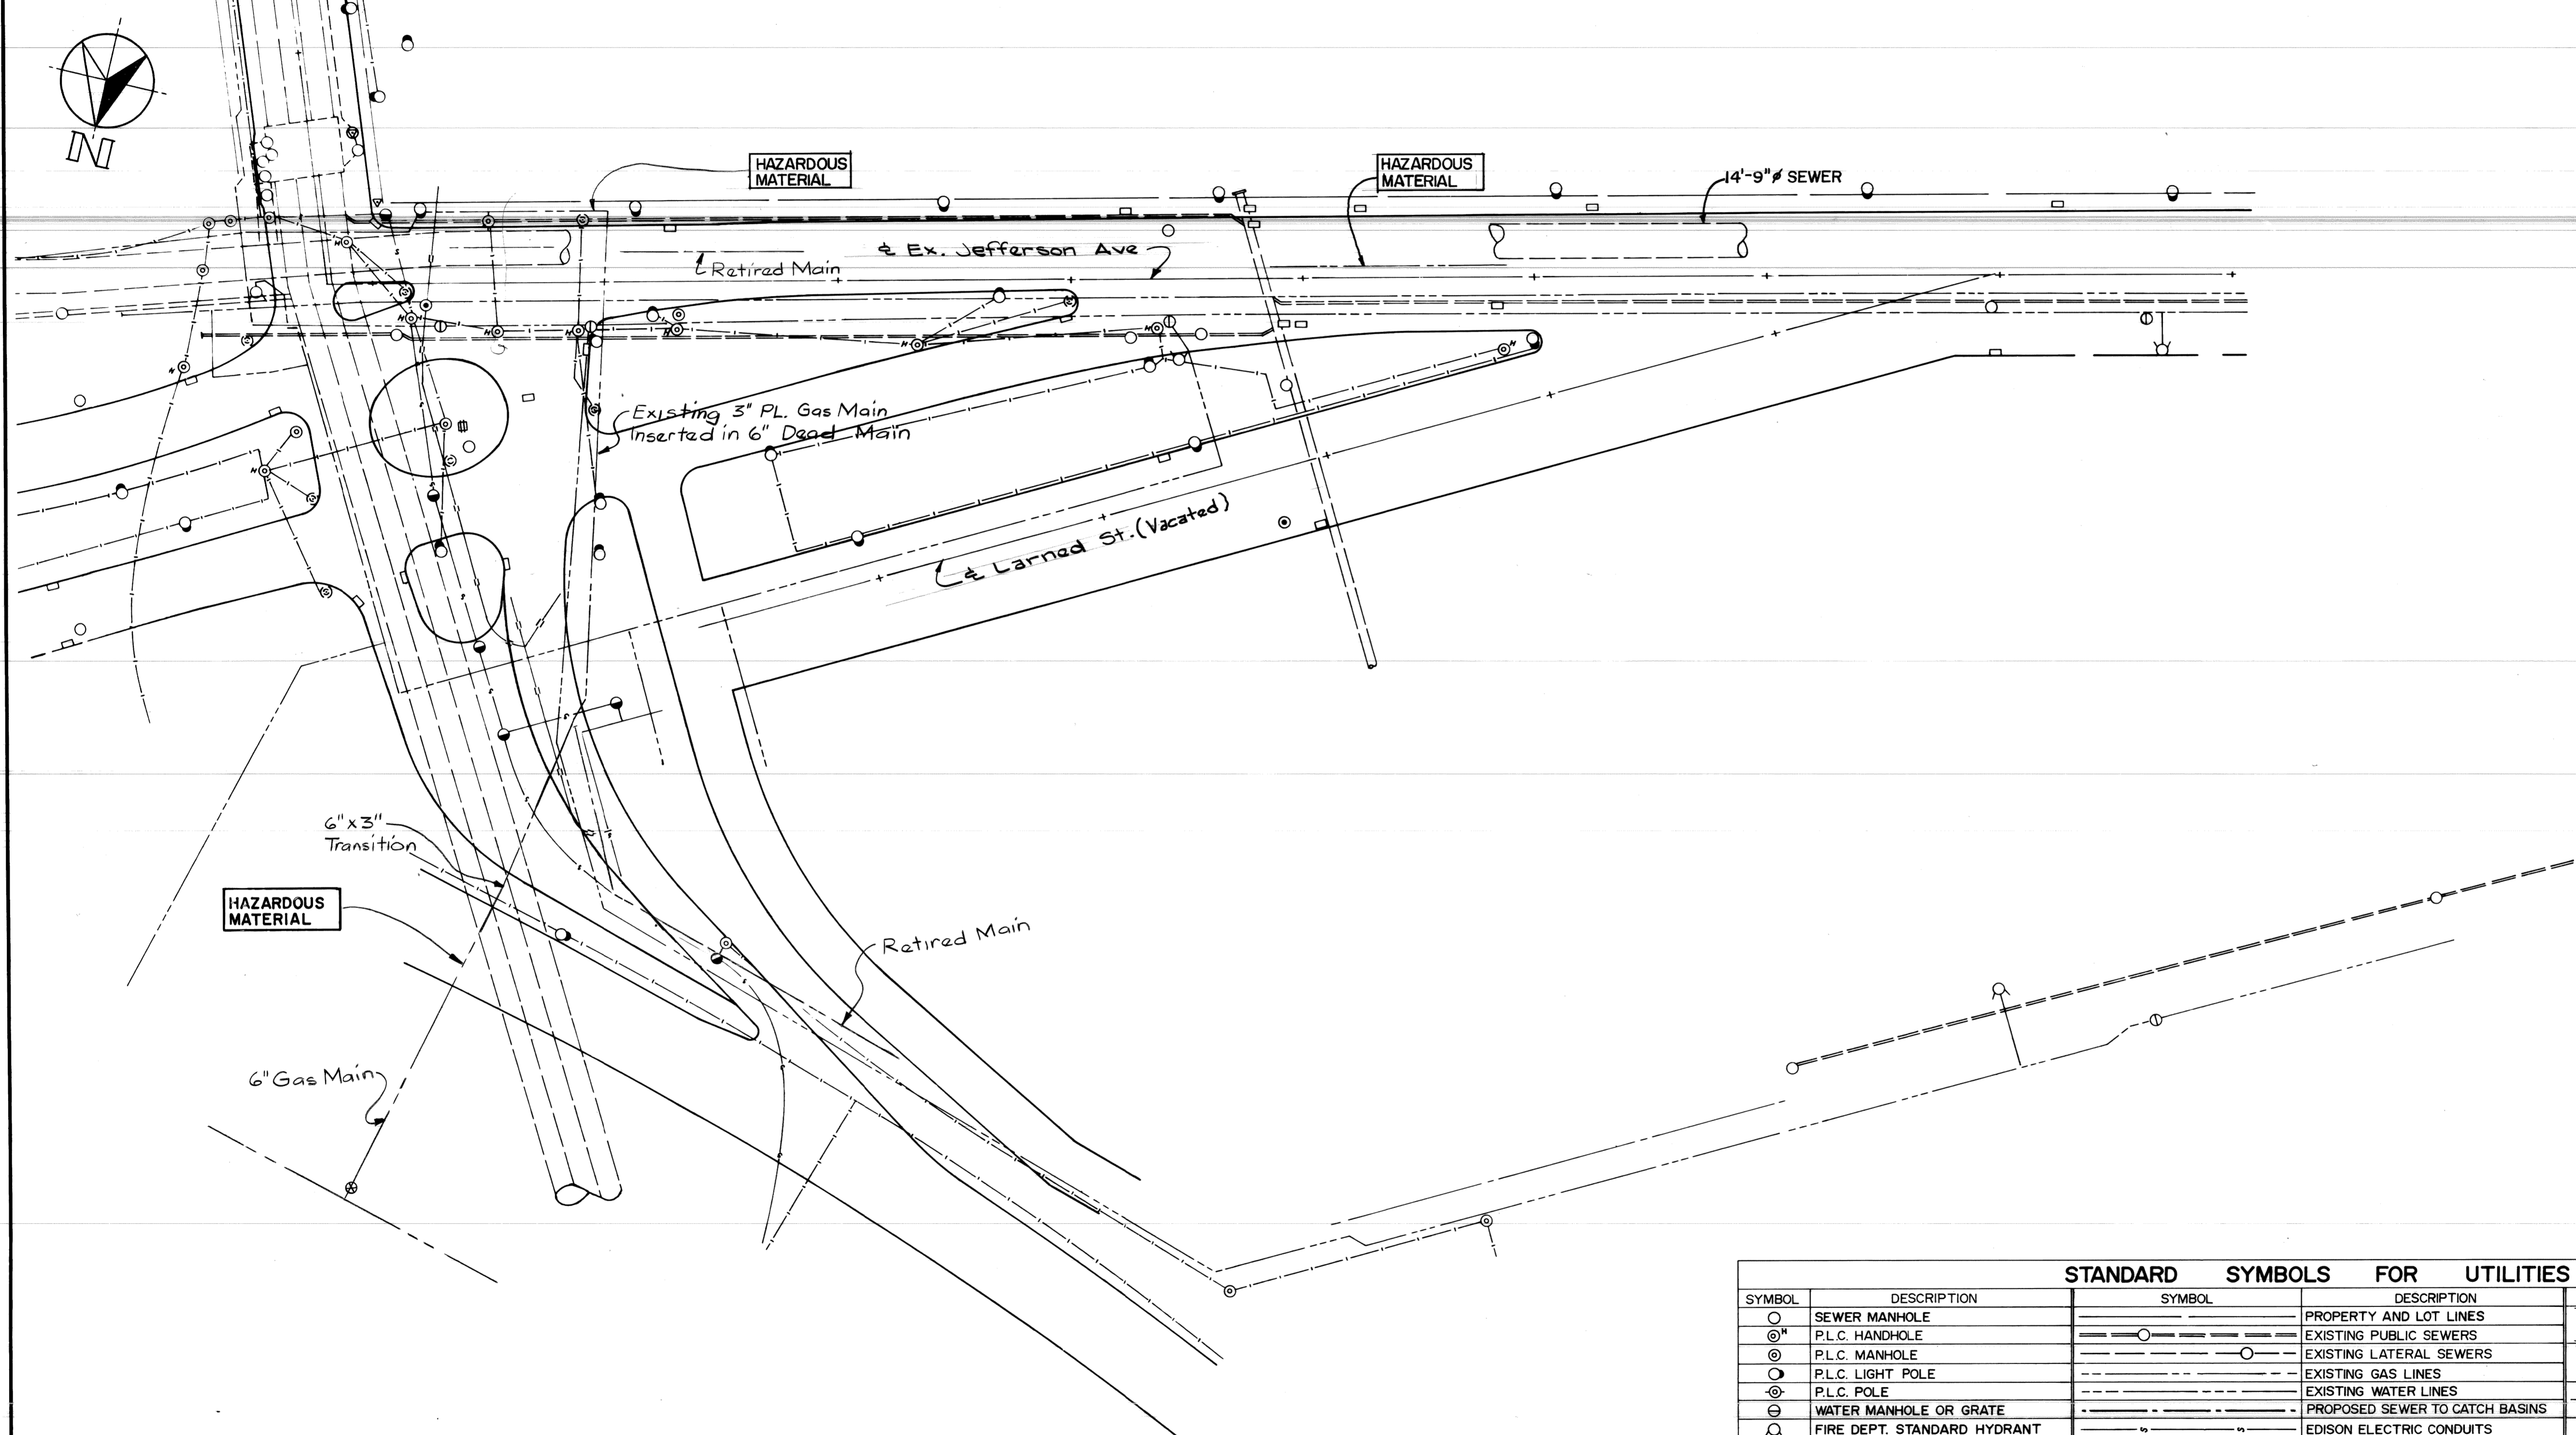


STANDARD SYMBOLS FOR UTILITIES (DETROIT)			
SYMBOL	DESCRIPTION	SYMBOL	DESCRIPTION
○	SEWER MANHOLE	—	PROPERTY AND LOT LINES
⊙	P.L.C. HANDHOLE	—	EXISTING PUBLIC SEWERS
⊙	P.L.C. MANHOLE	—	EXISTING LATERAL SEWERS
⊙	P.L.C. LIGHT POLE	—	EXISTING GAS LINES
⊙	P.L.C. POLE	—	EXISTING WATER LINES
⊙	WATER MANHOLE OR GRATE	—	PROPOSED SEWER TO CATCH BASINS
⊙	FIRE DEPT. STANDARD HYDRANT	—	EDISON ELECTRIC CONDUITS
⊙	FIRE DEPT. MANHOLE	—	MICHIGAN BELL TELEPHONE DUCTS
⊙	FIRE DEPT. CALL BOX	—	P.L.C. CONDUITS
⊙	MICHIGAN BELL MANHOLE	—	PROPOSED CURB LINES AND HEADERS AT RETURNS
⊙	EDISON ELECTRIC MANHOLE	—	EXISTING CURB LINES OR EDGE OF PAVEMENT
⊙	EDISON POLE	—	PROPOSED CURB, M.H., AND INLET SEWERS
⊙	TRAFFIC SIGNAL LIGHT	—	
⊙	CATCH BASIN	—	

Work This Sheet With Sheets # S1, S2, S4 & S5


DATE: August, 1979

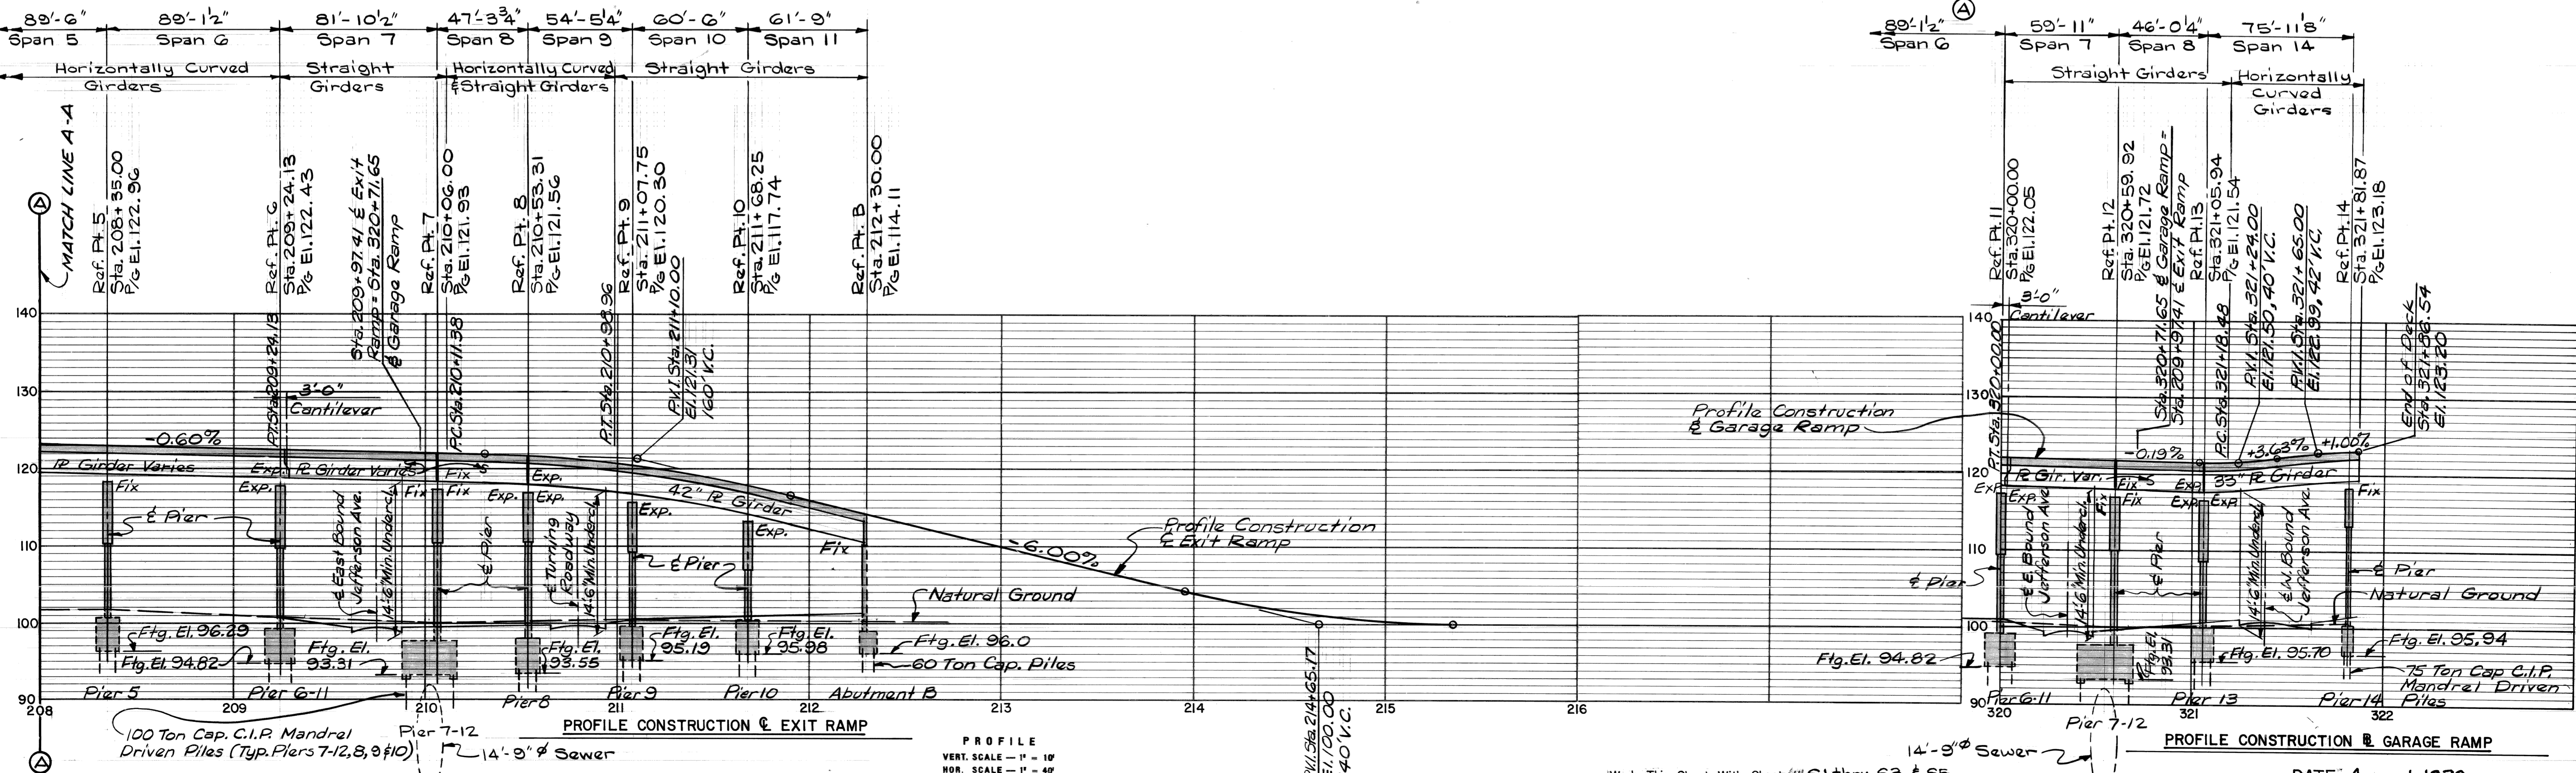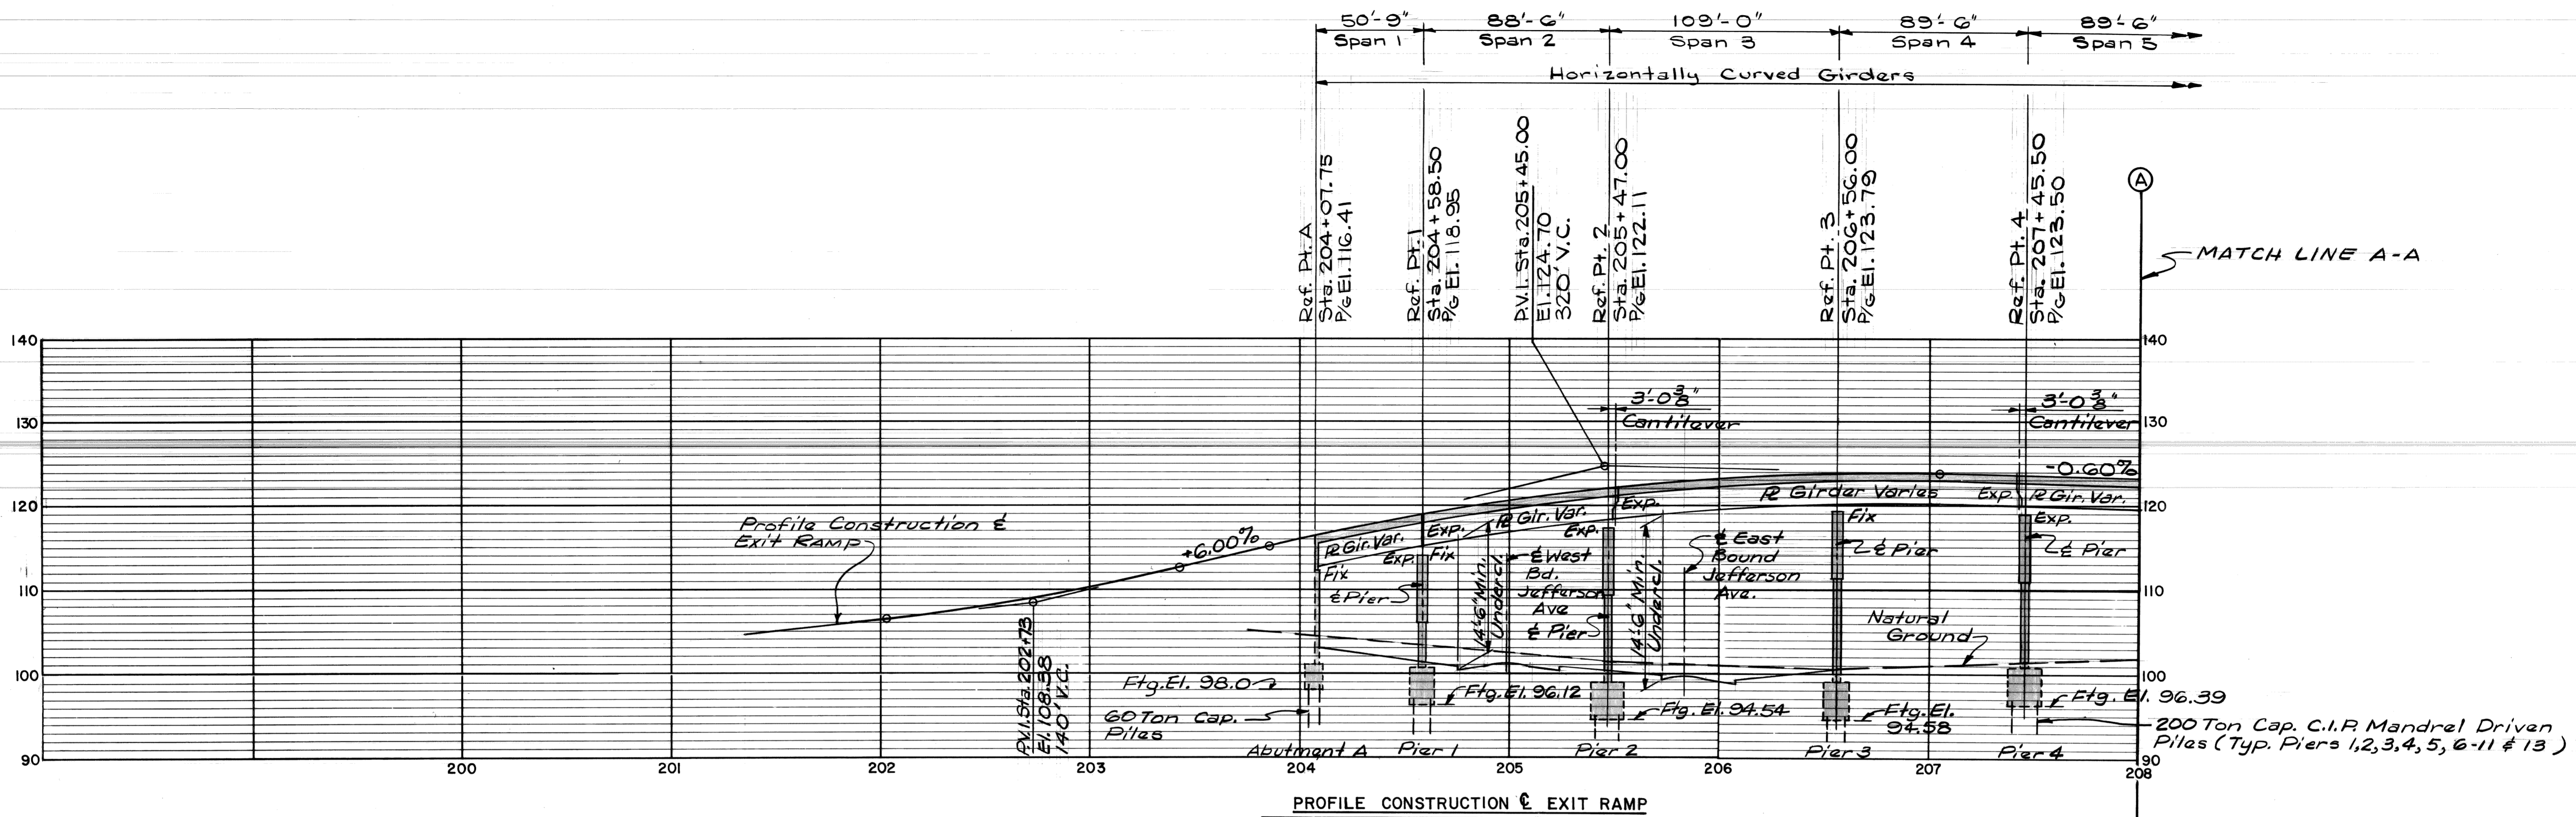


DSGN BY: RGW	REVISIONS	CITY OF DETROIT, MICHIGAN	Snell Environmental Group LANSING INDIANAPOLIS AKRON	JOHN C. LODGE EXIT RAMP AND JEFFERSON AVENUE RECONSTRUCTION AT THE JOE LOUIS ARENA	GENERAL PLAN OF SITE RAMP STRUCTURE PROFILES	DATE: August, 1979	SCALE: NOTED	
CK'D BY: RGW							DRN. NO: S4	
APP'D BY:								

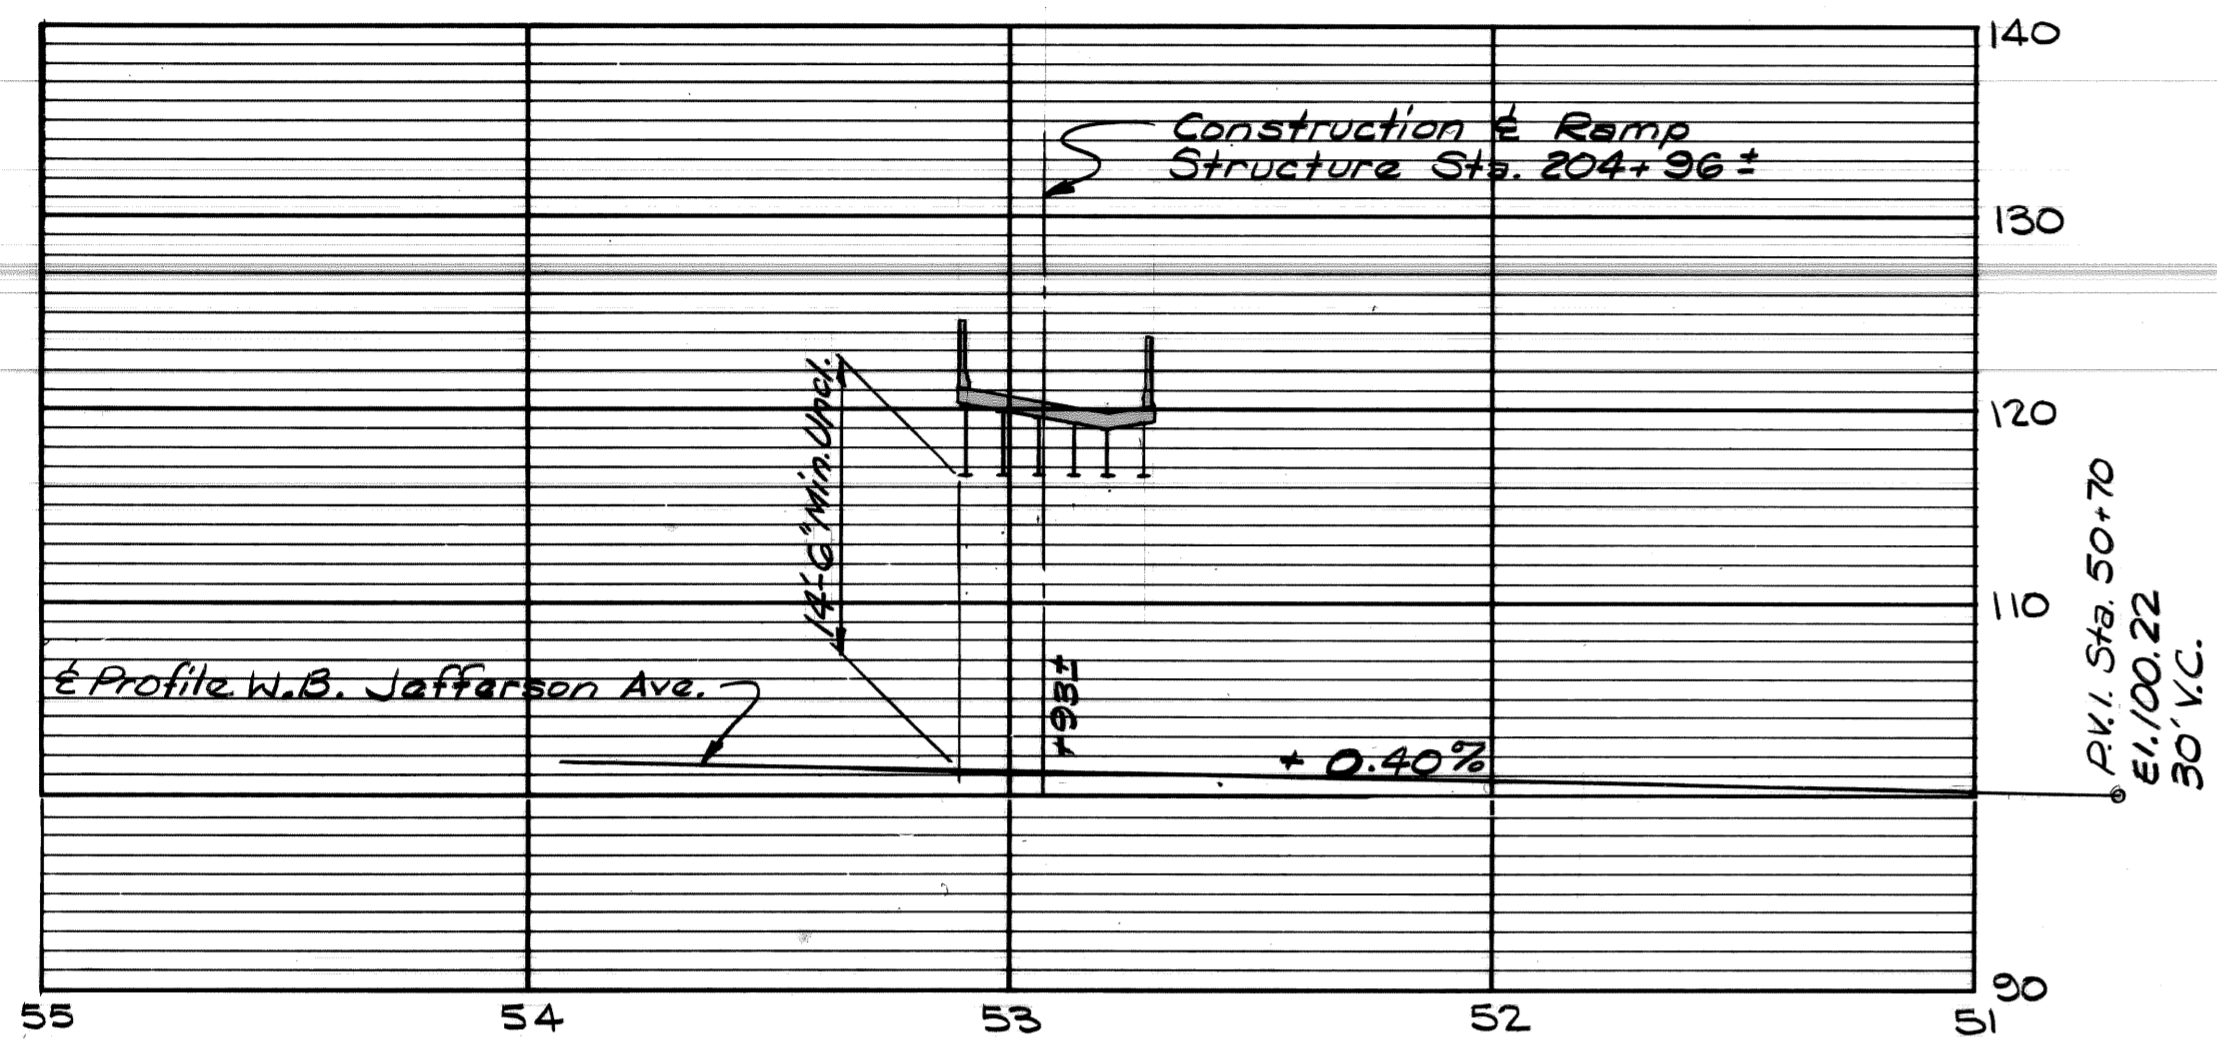


PROFILE W.B. JEFFERSON AVE.

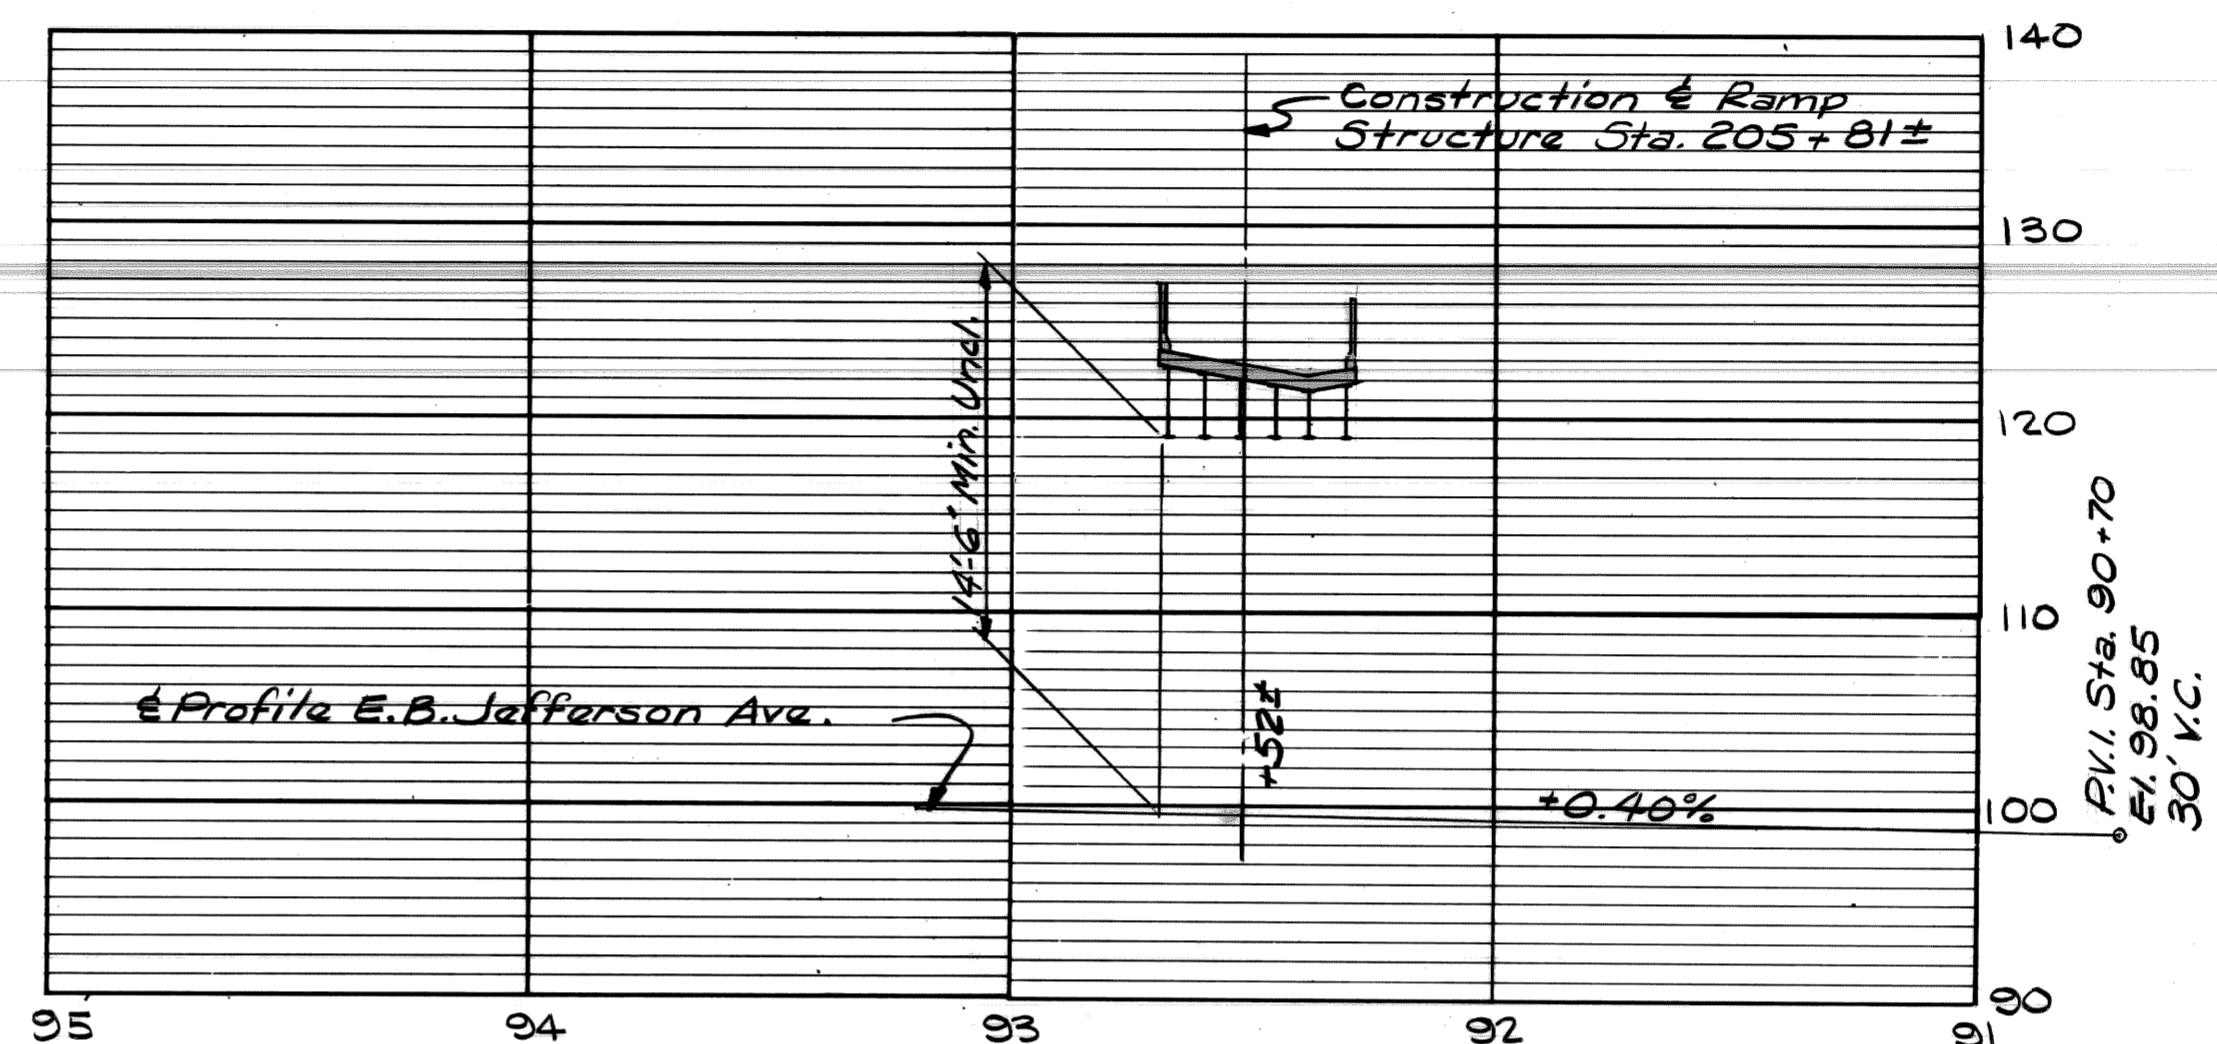

PROFILE E.B. JEFFERSON AVE.

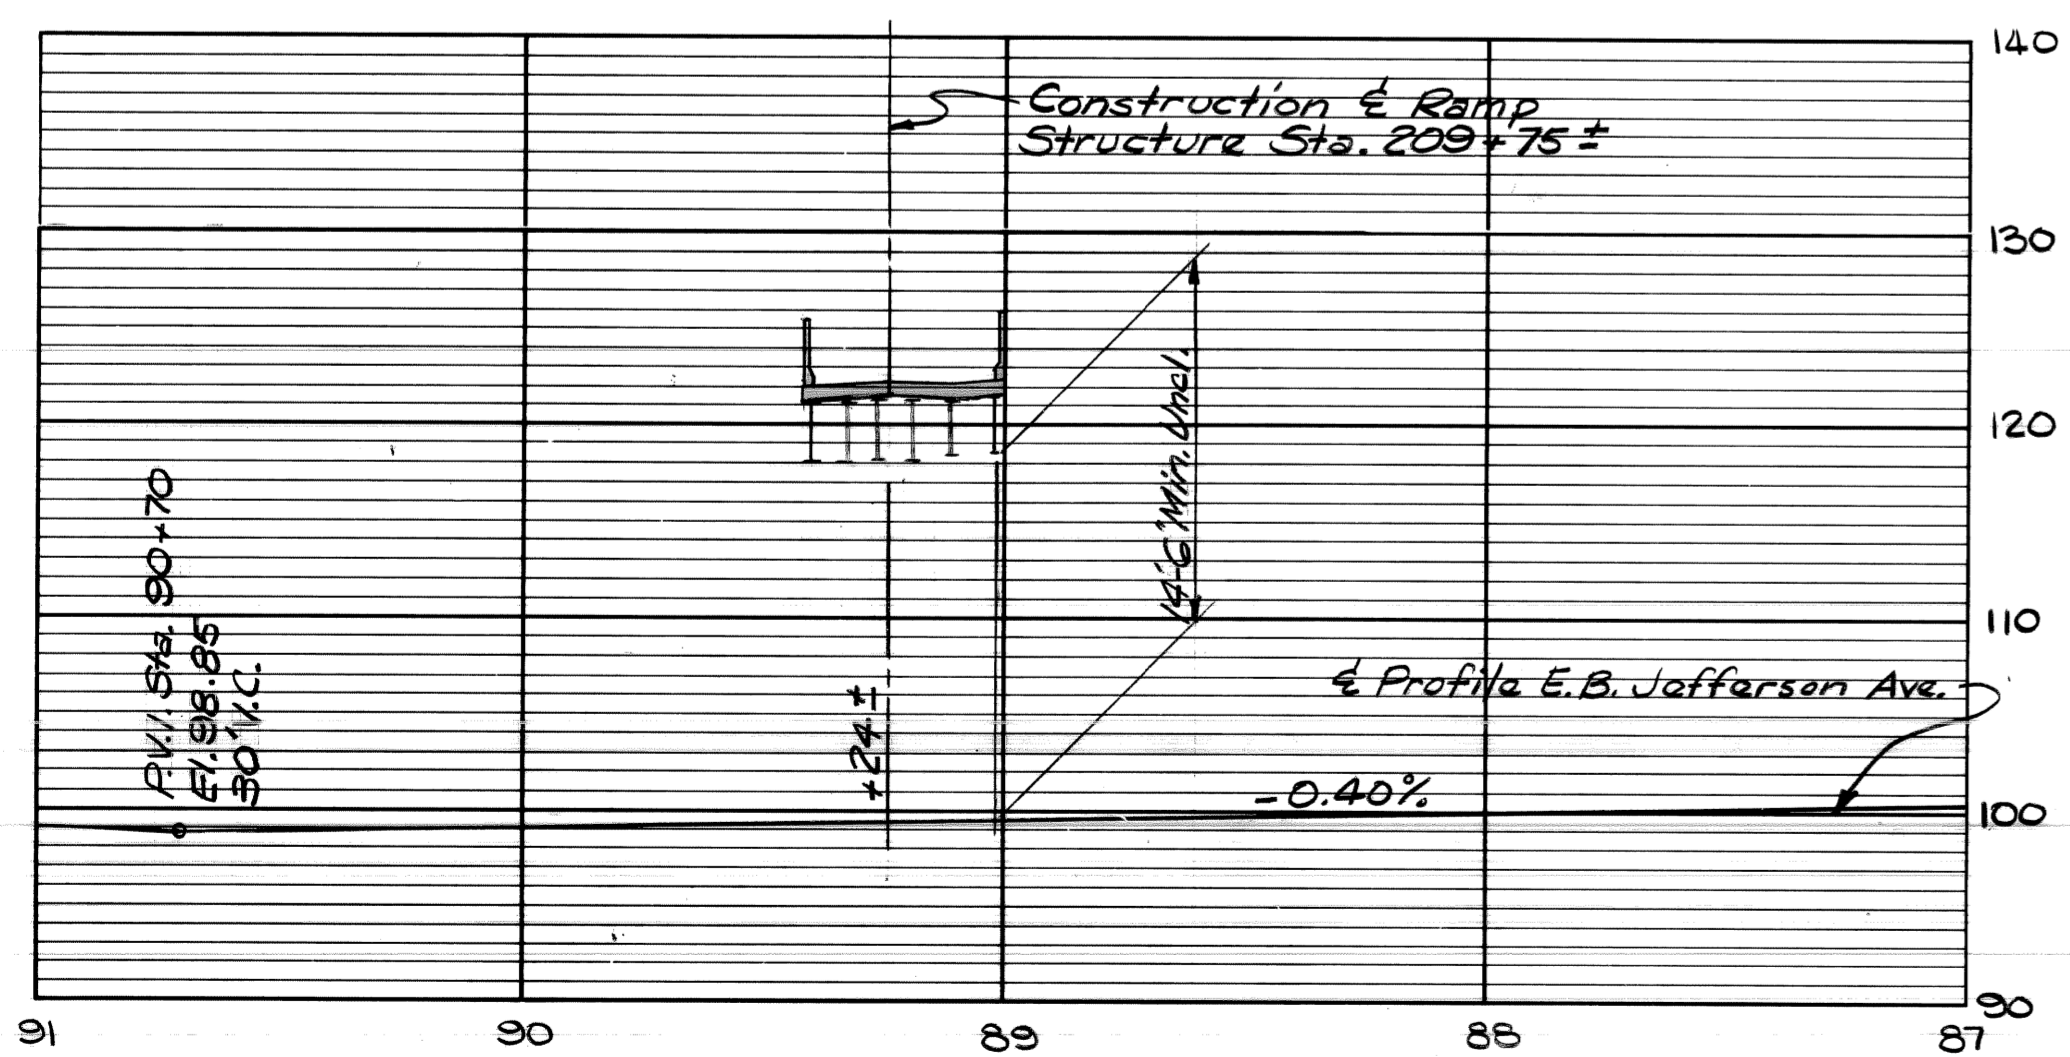

PROFILE E.B. JEFFERSON AVE.

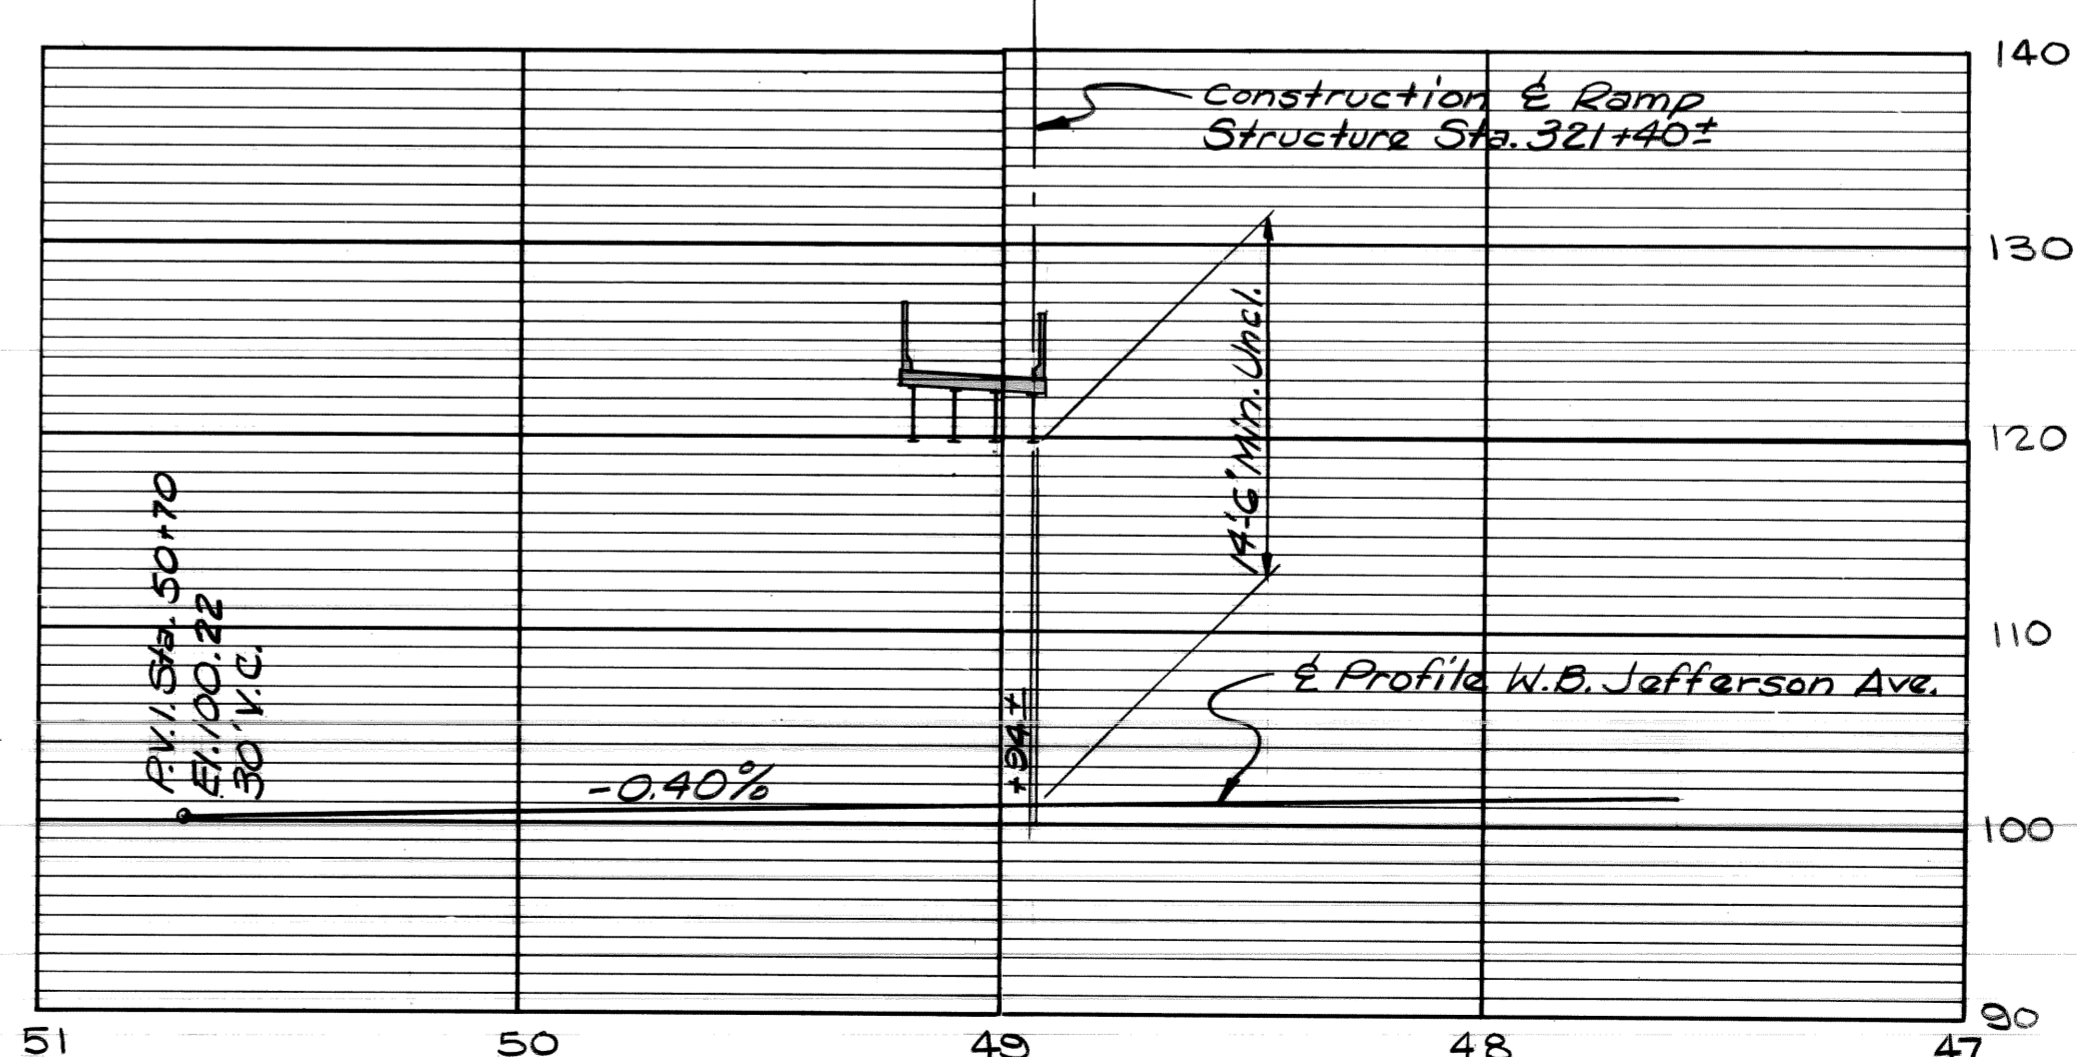

PROFILE W.B. JEFFERSON AVE.


PROFILE
VERT. SCALE - 1" = 10'
HOR. SCALE - 1" = 40'

Work This Sheet With Sheets # S1 thru S4

DATE: August, 1979

DSGN BY: RGW			
CHK'D BY: RGW			
APP'D BY:			

CITY OF DETROIT, MICHIGAN







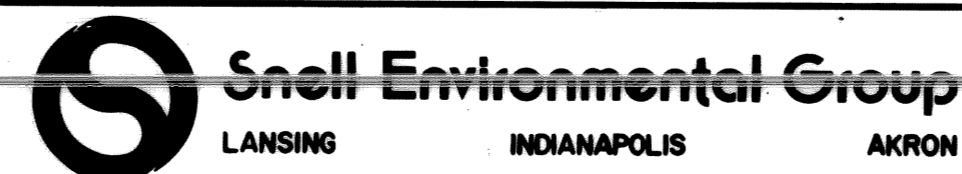


JOHN C. LODGE EXIT RAMP AND JEFFERSON AVENUE -
RECONSTRUCTION AT THE JOE LOUIS ARENA

GENERAL PLAN OF SITE
JEFFERSON AVE. PROFILES


SCALE: NONE

DRN. NO: S5

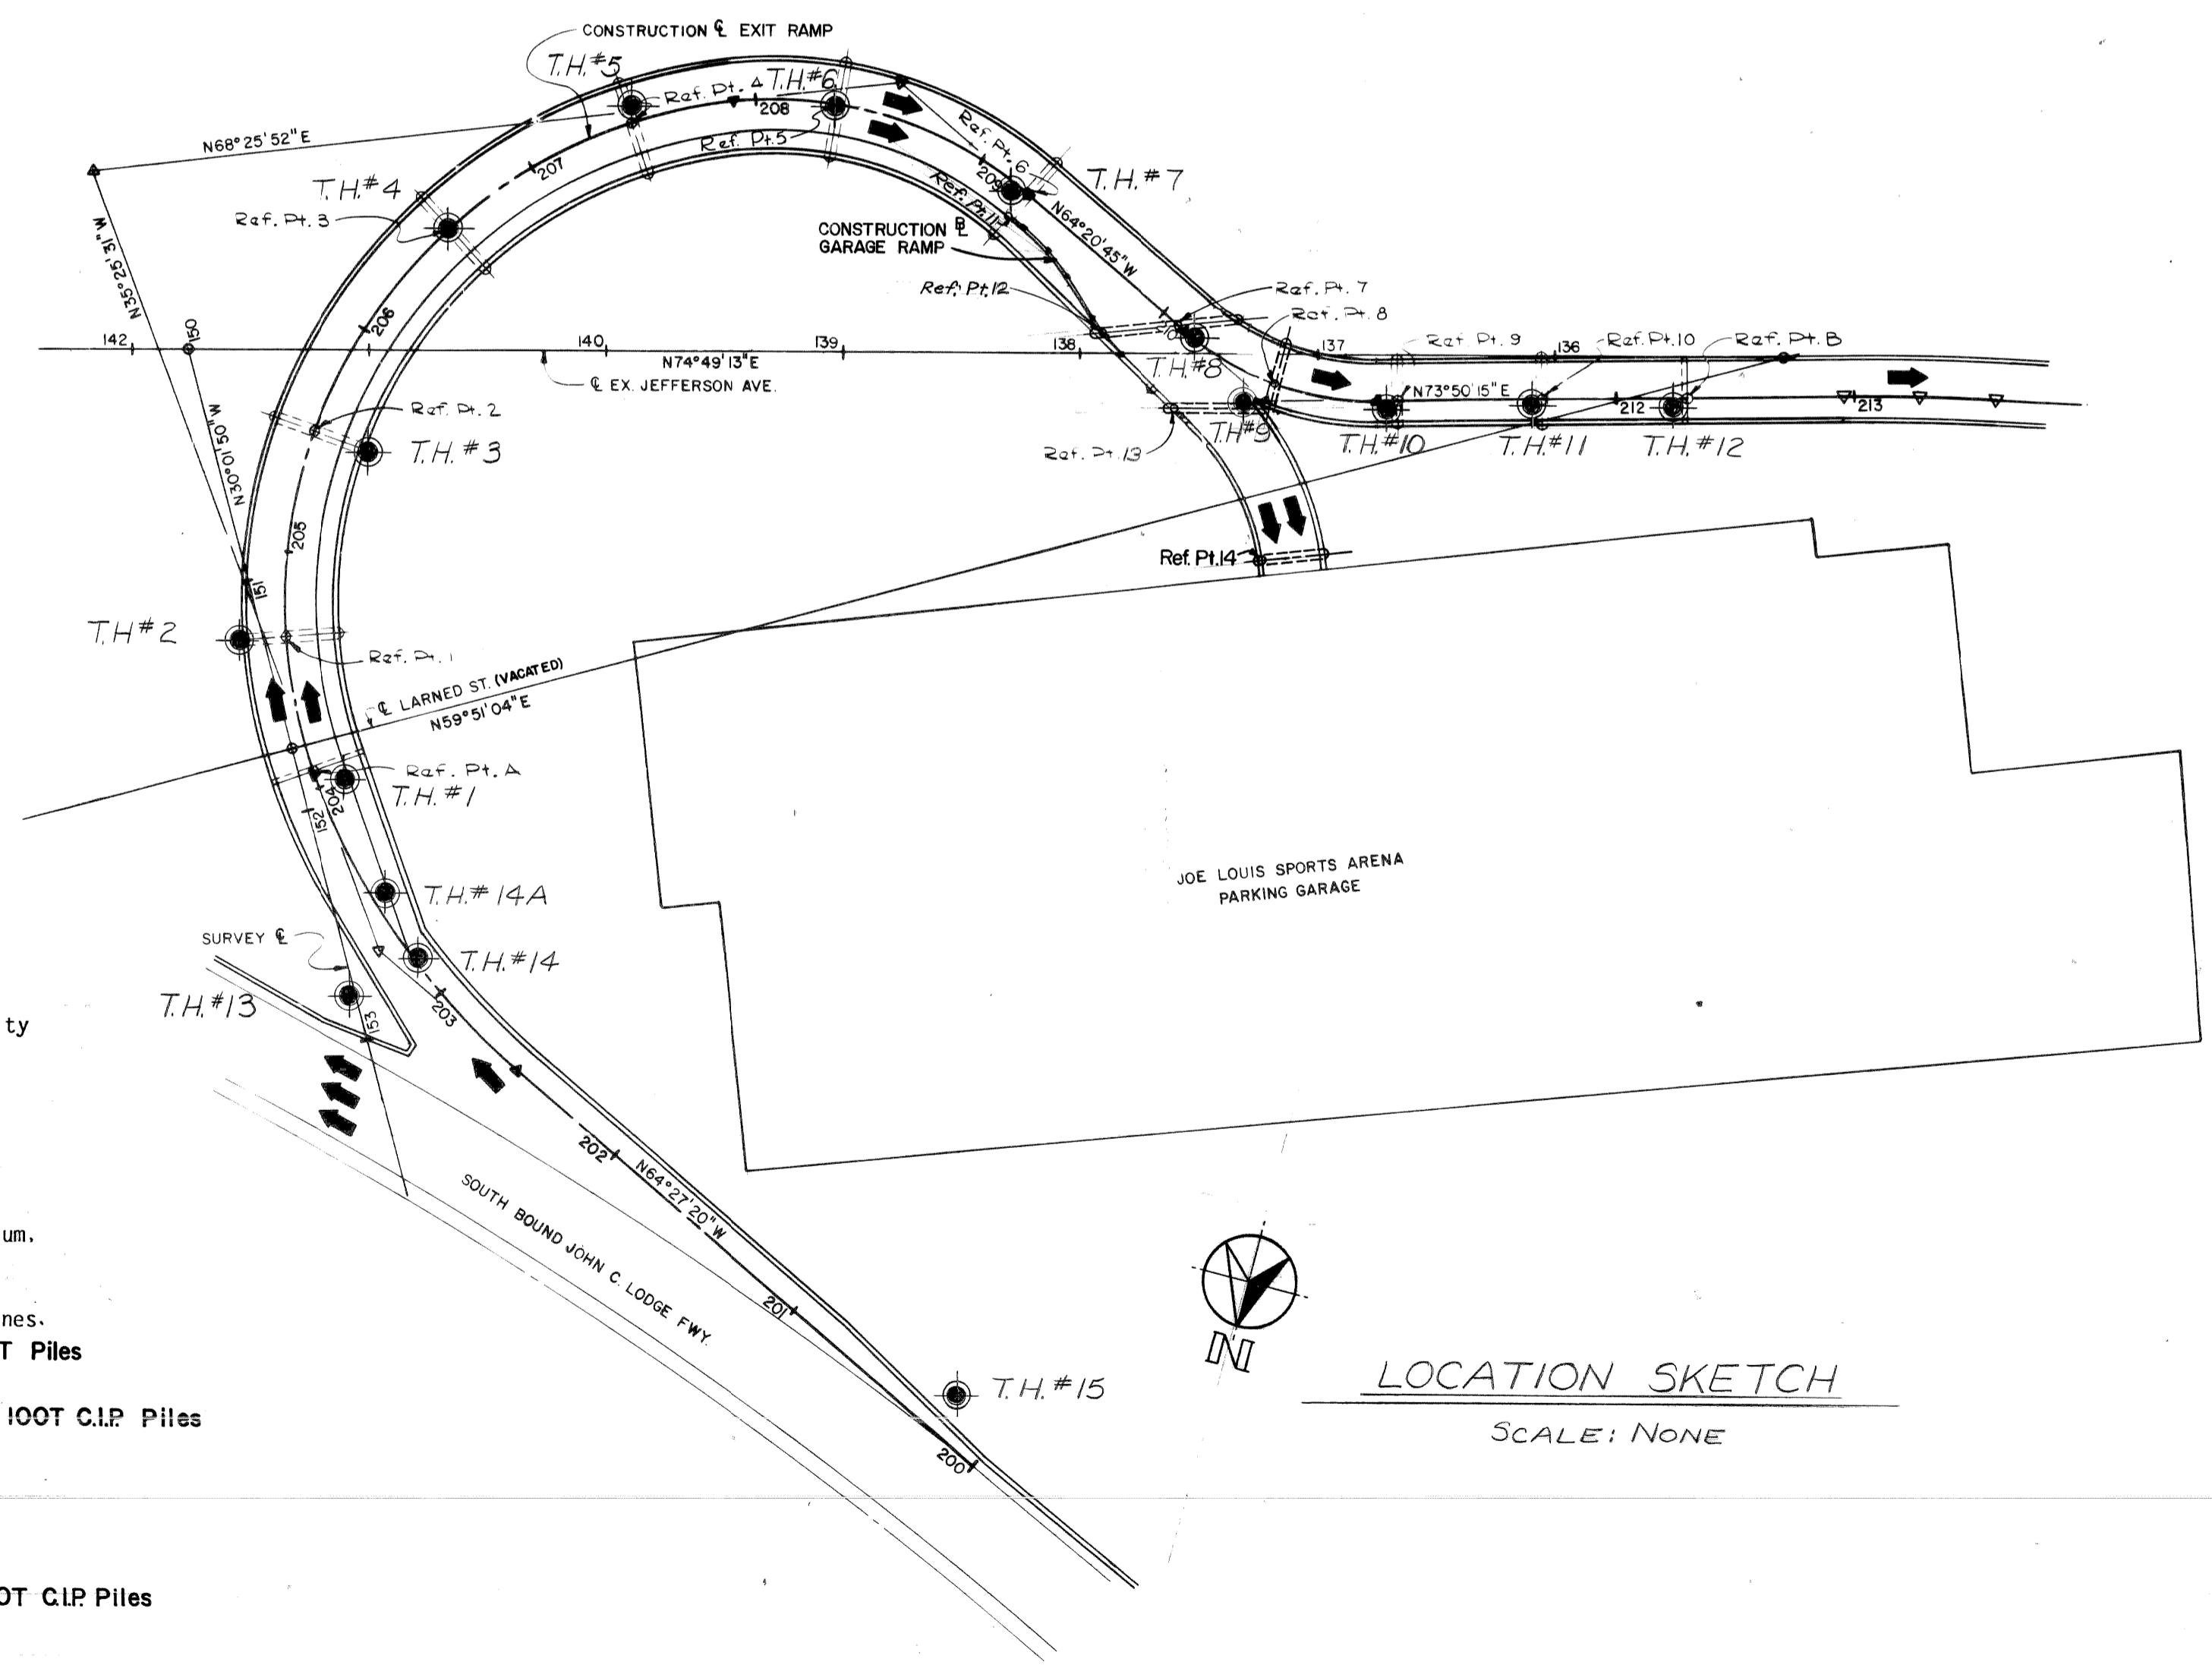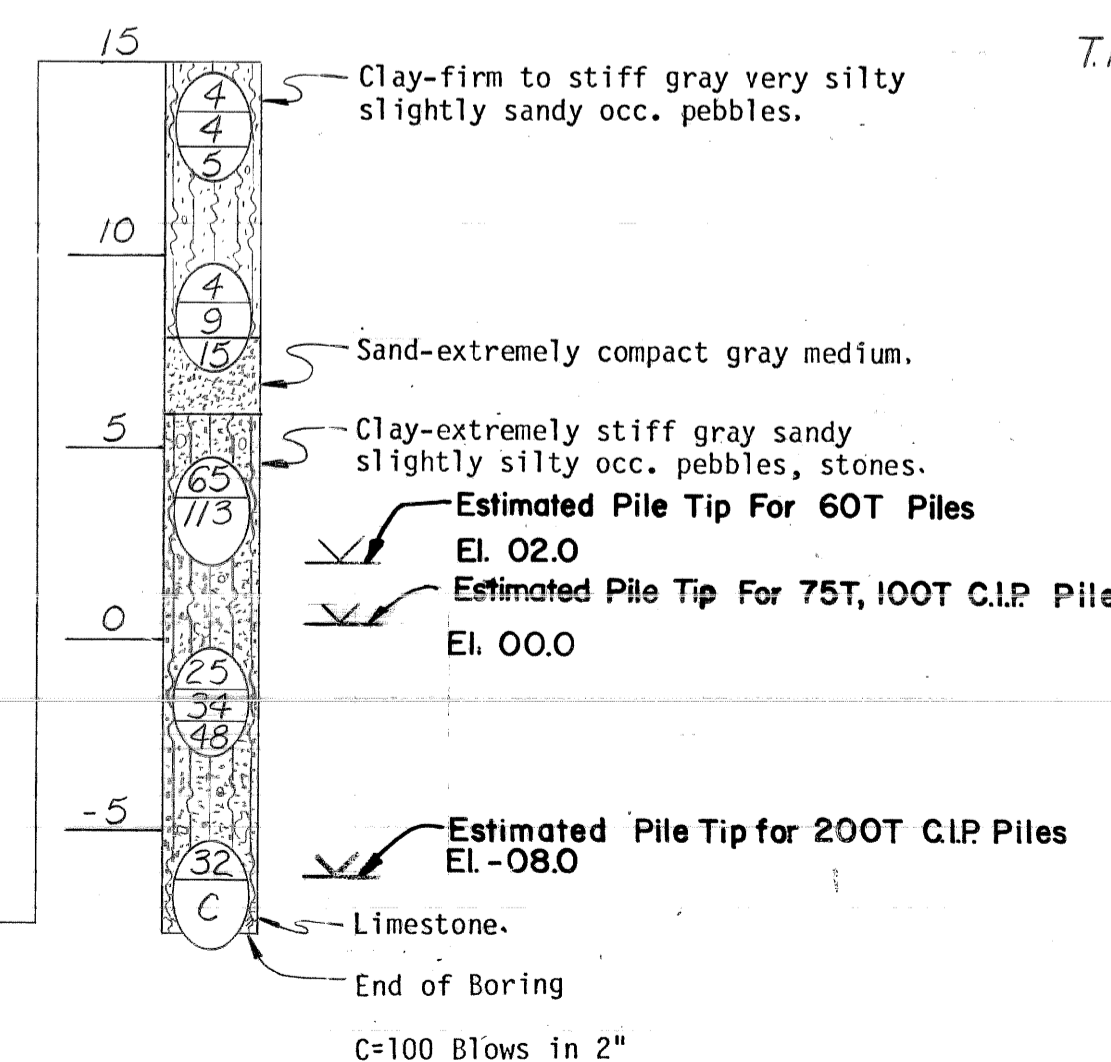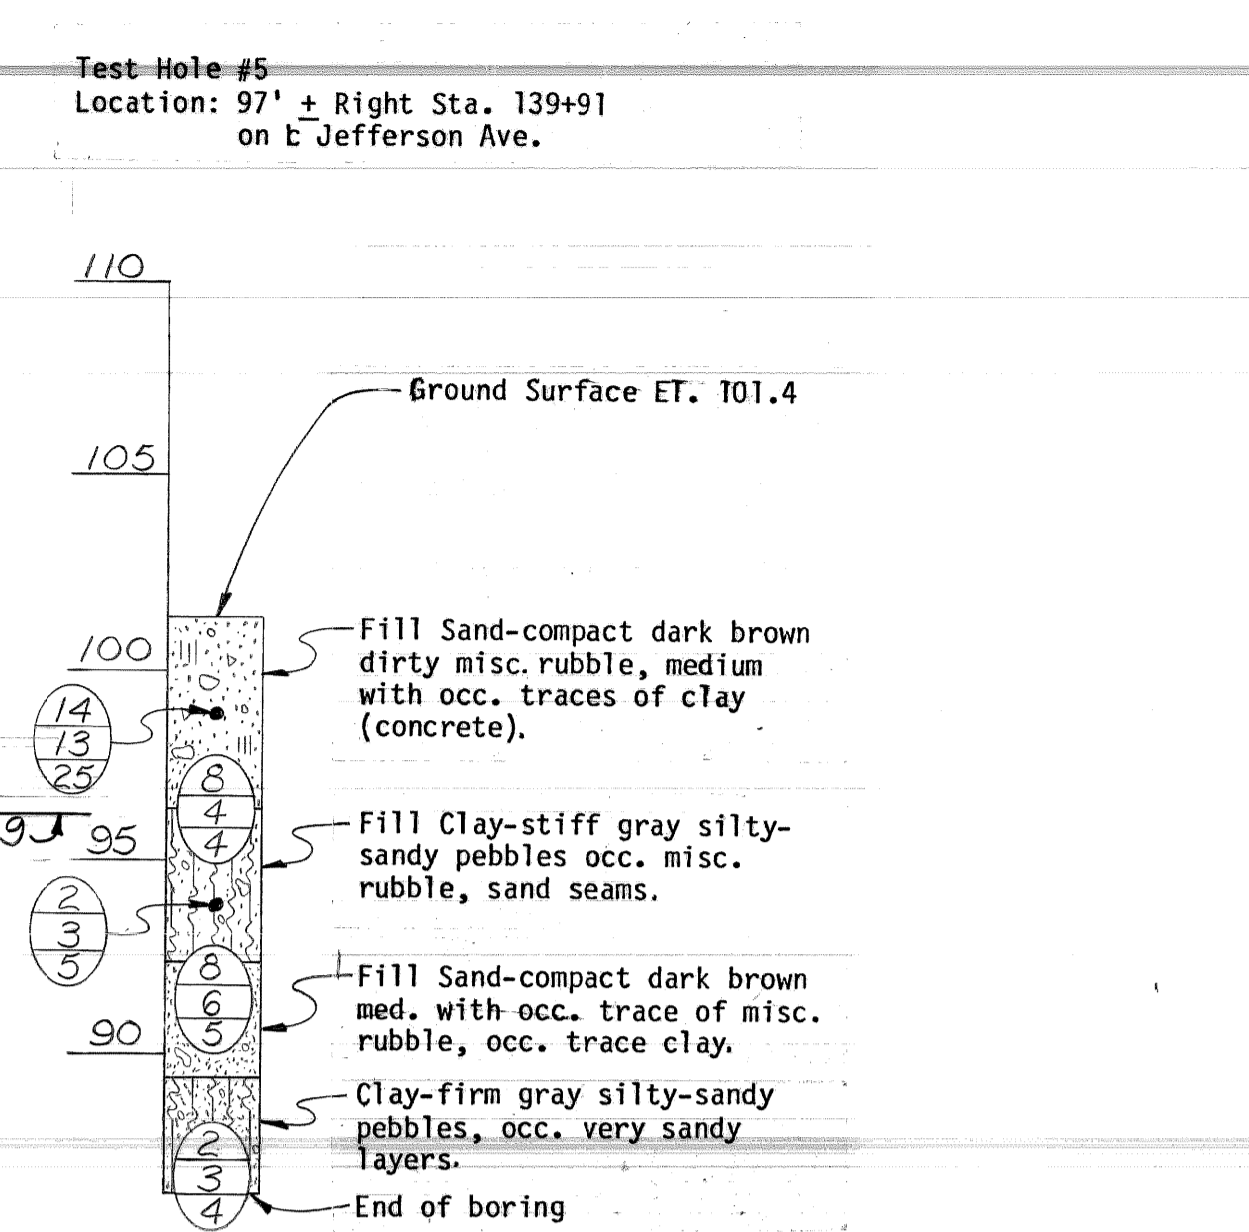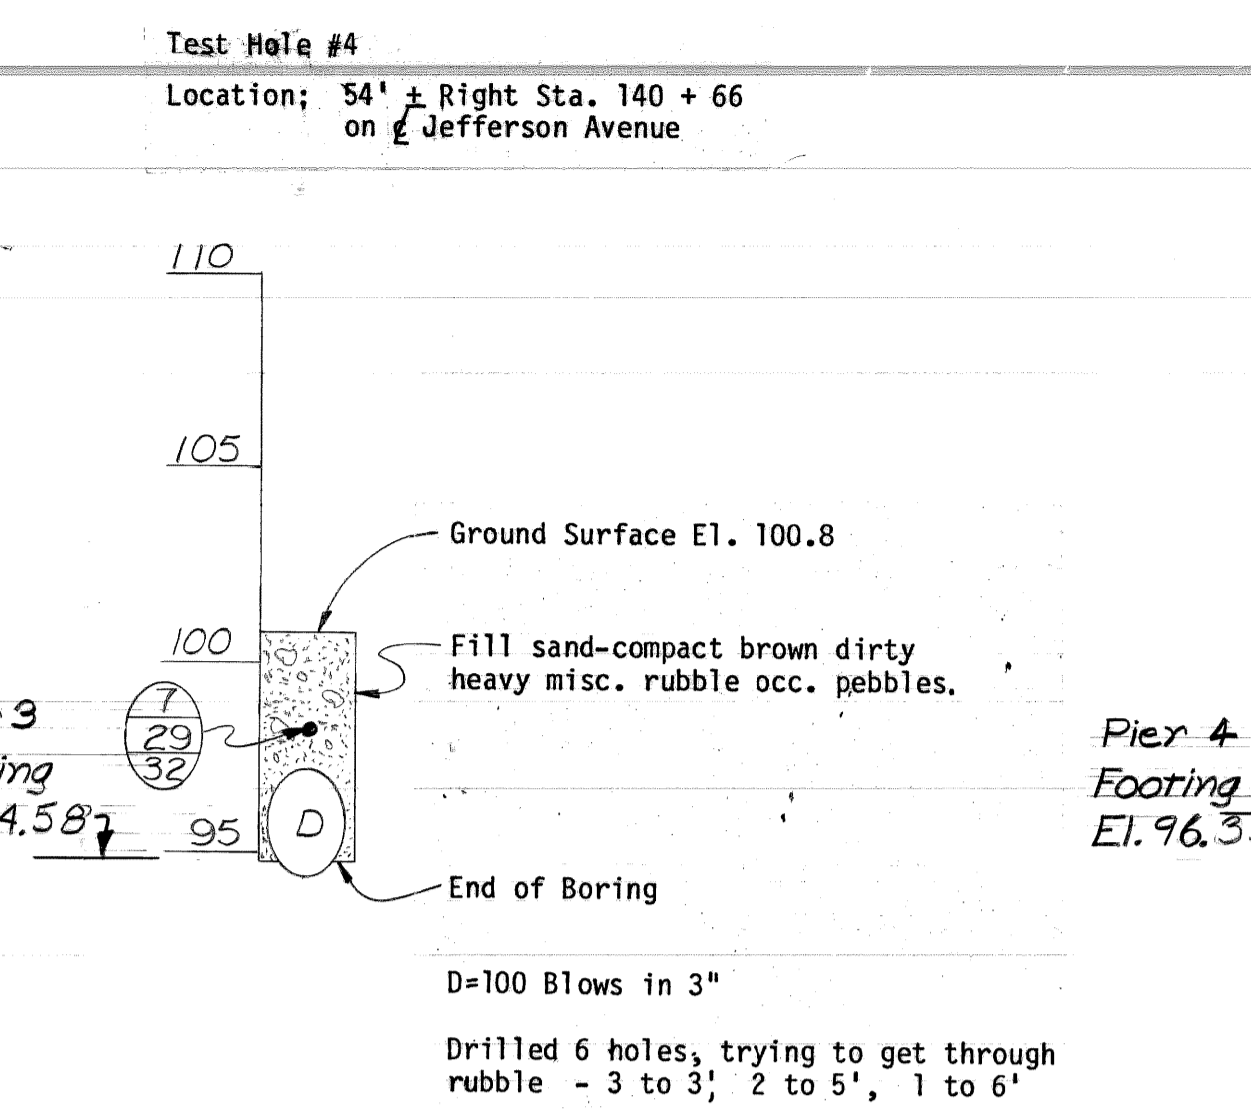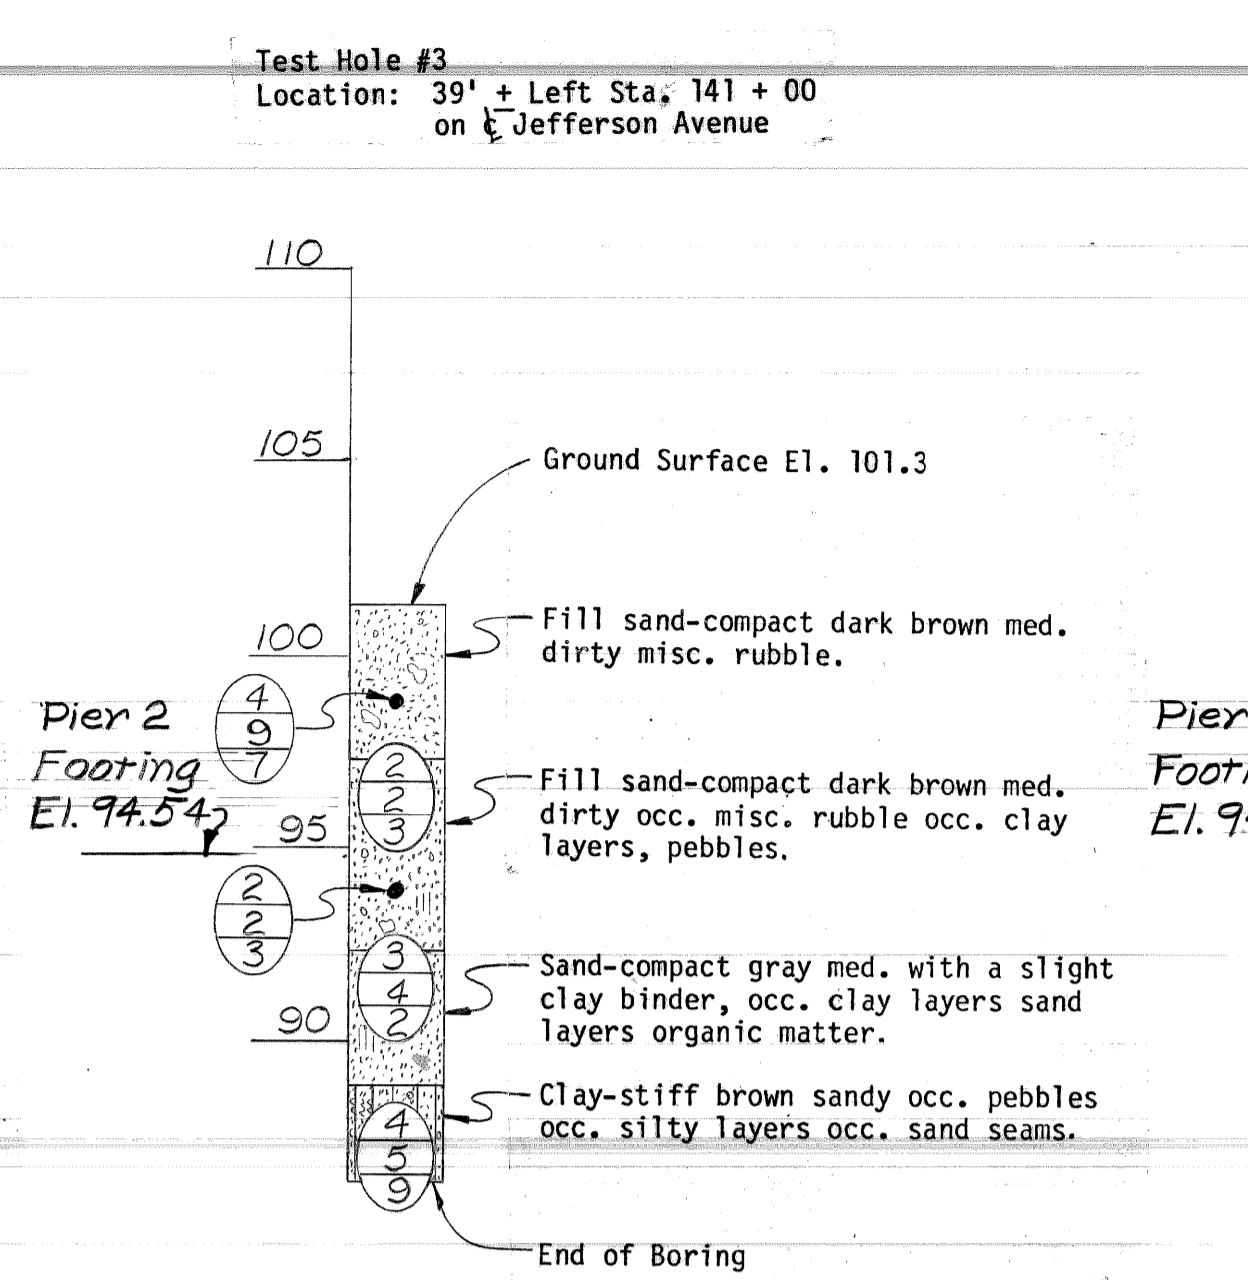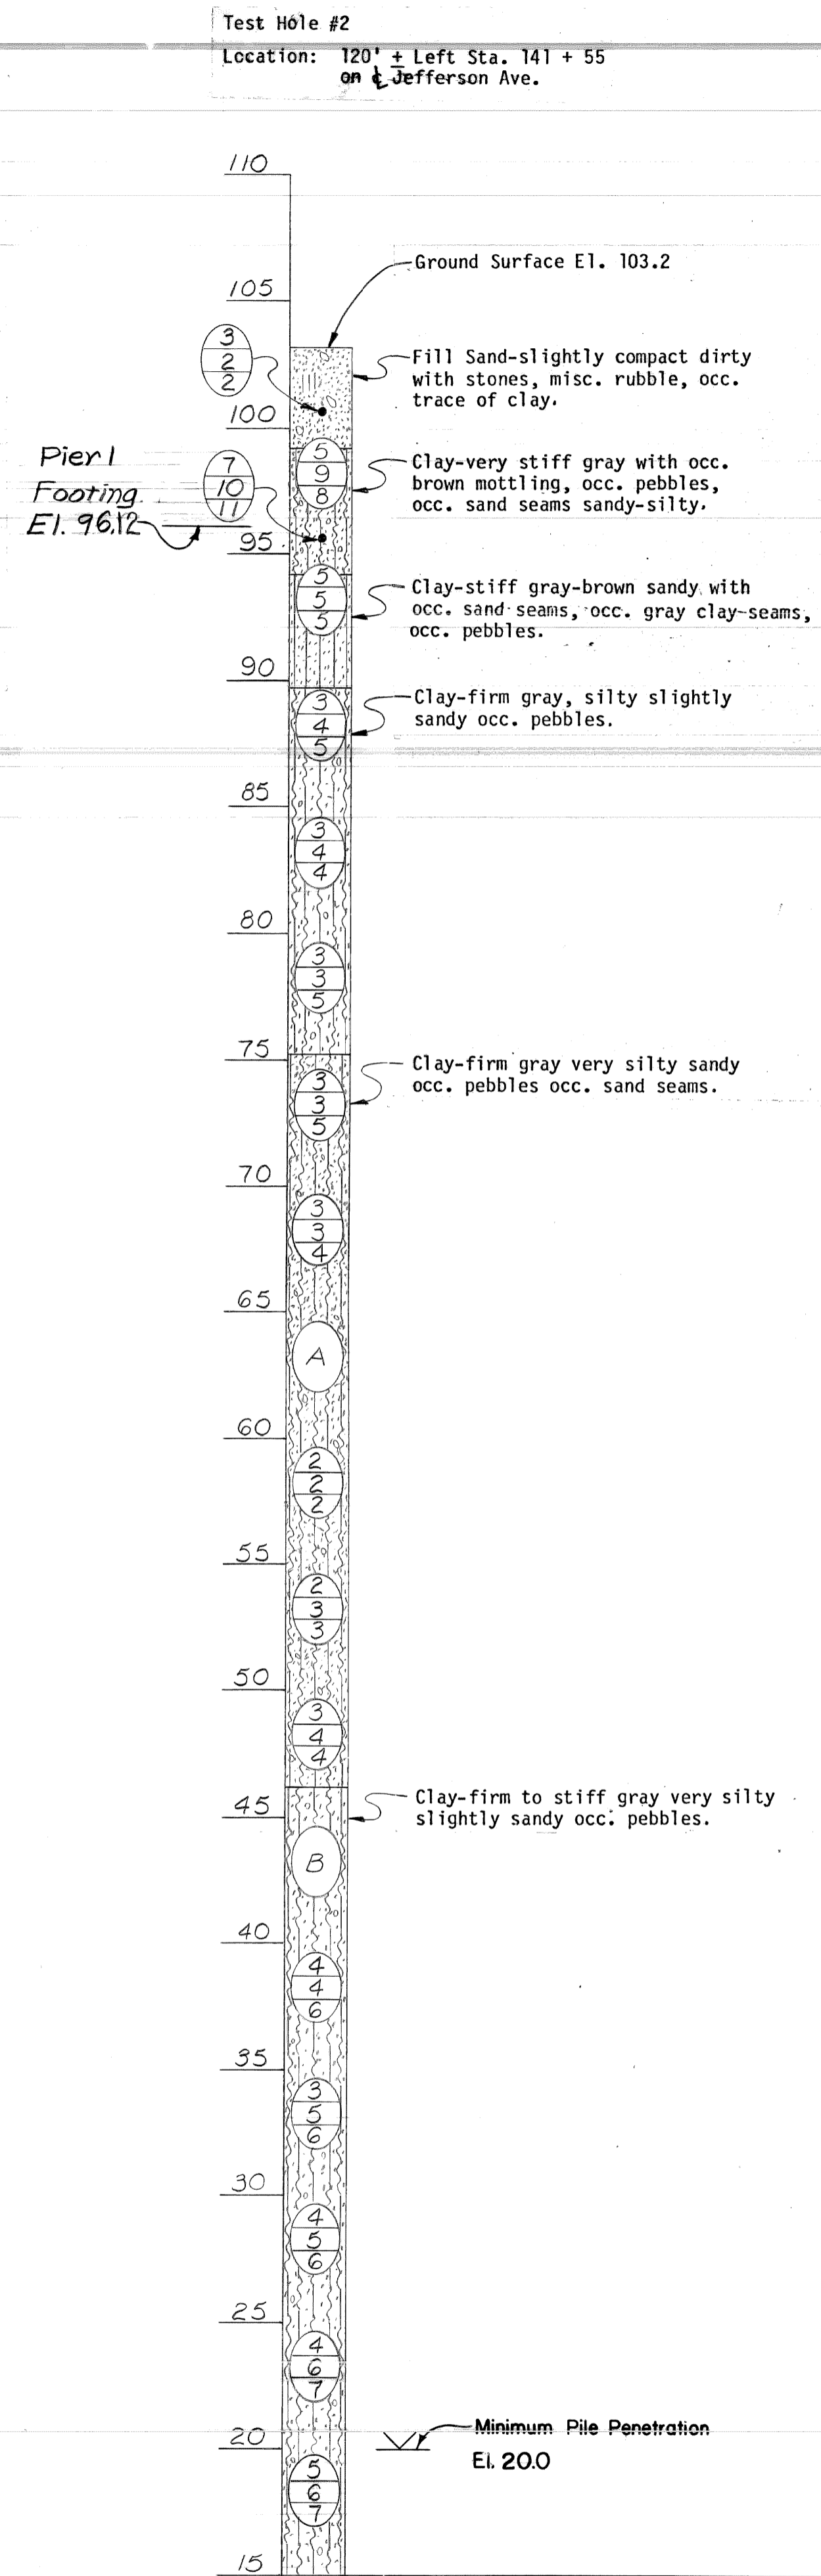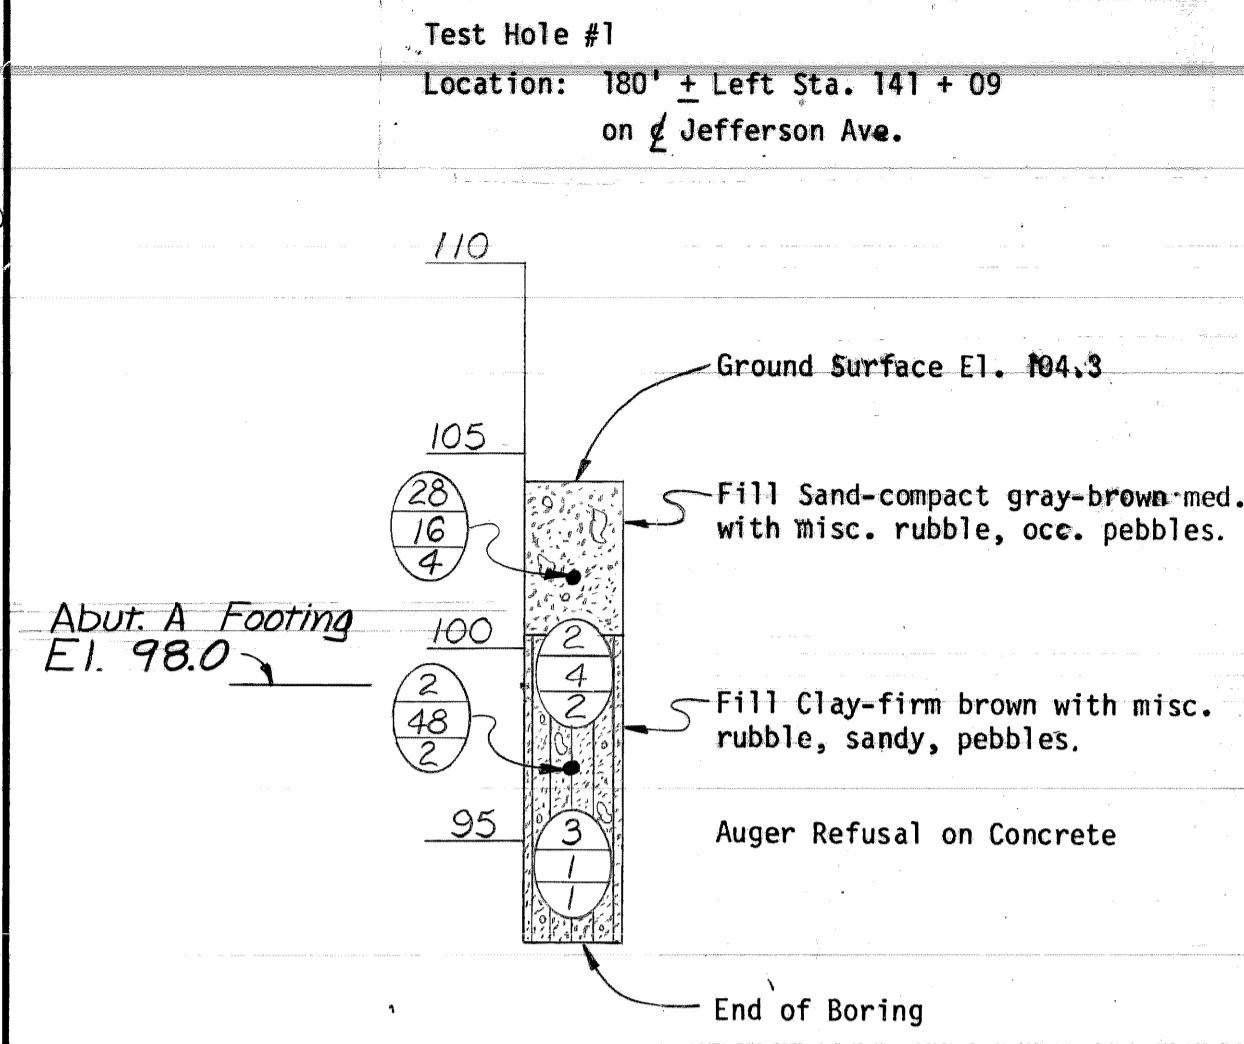

DSGN BY: RGW		
CHK'D BY: RGW	REVISIONS	
APP'D BY:		

CITY OF DETROIT, MICHIGAN

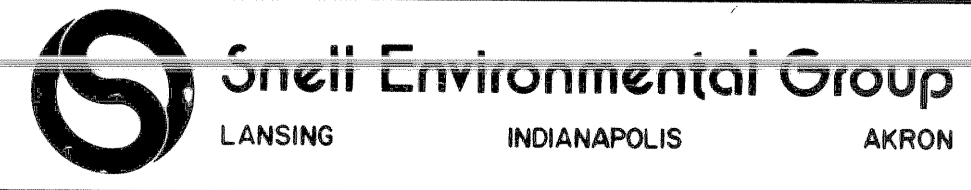

Work This Sheet With Sheets # 57 & 58

JOHN C. LODGE EXIT RAMP AND JEFFERSON AVENUE-
RECONSTRUCTION AT THE JOE LOUIS ARENA

LOG OF BORINGS
LOCATION SKETCH

DATE: August, 1979

SCALE: NONE

DRN. NO: S6







Test Hole #6
Location: 103' ± Right Sta. 139 + 05
on Jefferson Ave.

Test Hole #7
Location: 66' ± Right Sta. 138 + 27
on Jefferson Ave.

Test Hole #8
Location: 5' ± Right Sta. 137 + 55
on Jefferson Ave.

Test Hole #9
Location: 20' ± Left Sta. 137 + 29
on Jefferson Ave.

Test Hole #10
Location: 20' ± Left Sta. 136 + 70
on Jefferson Avenue

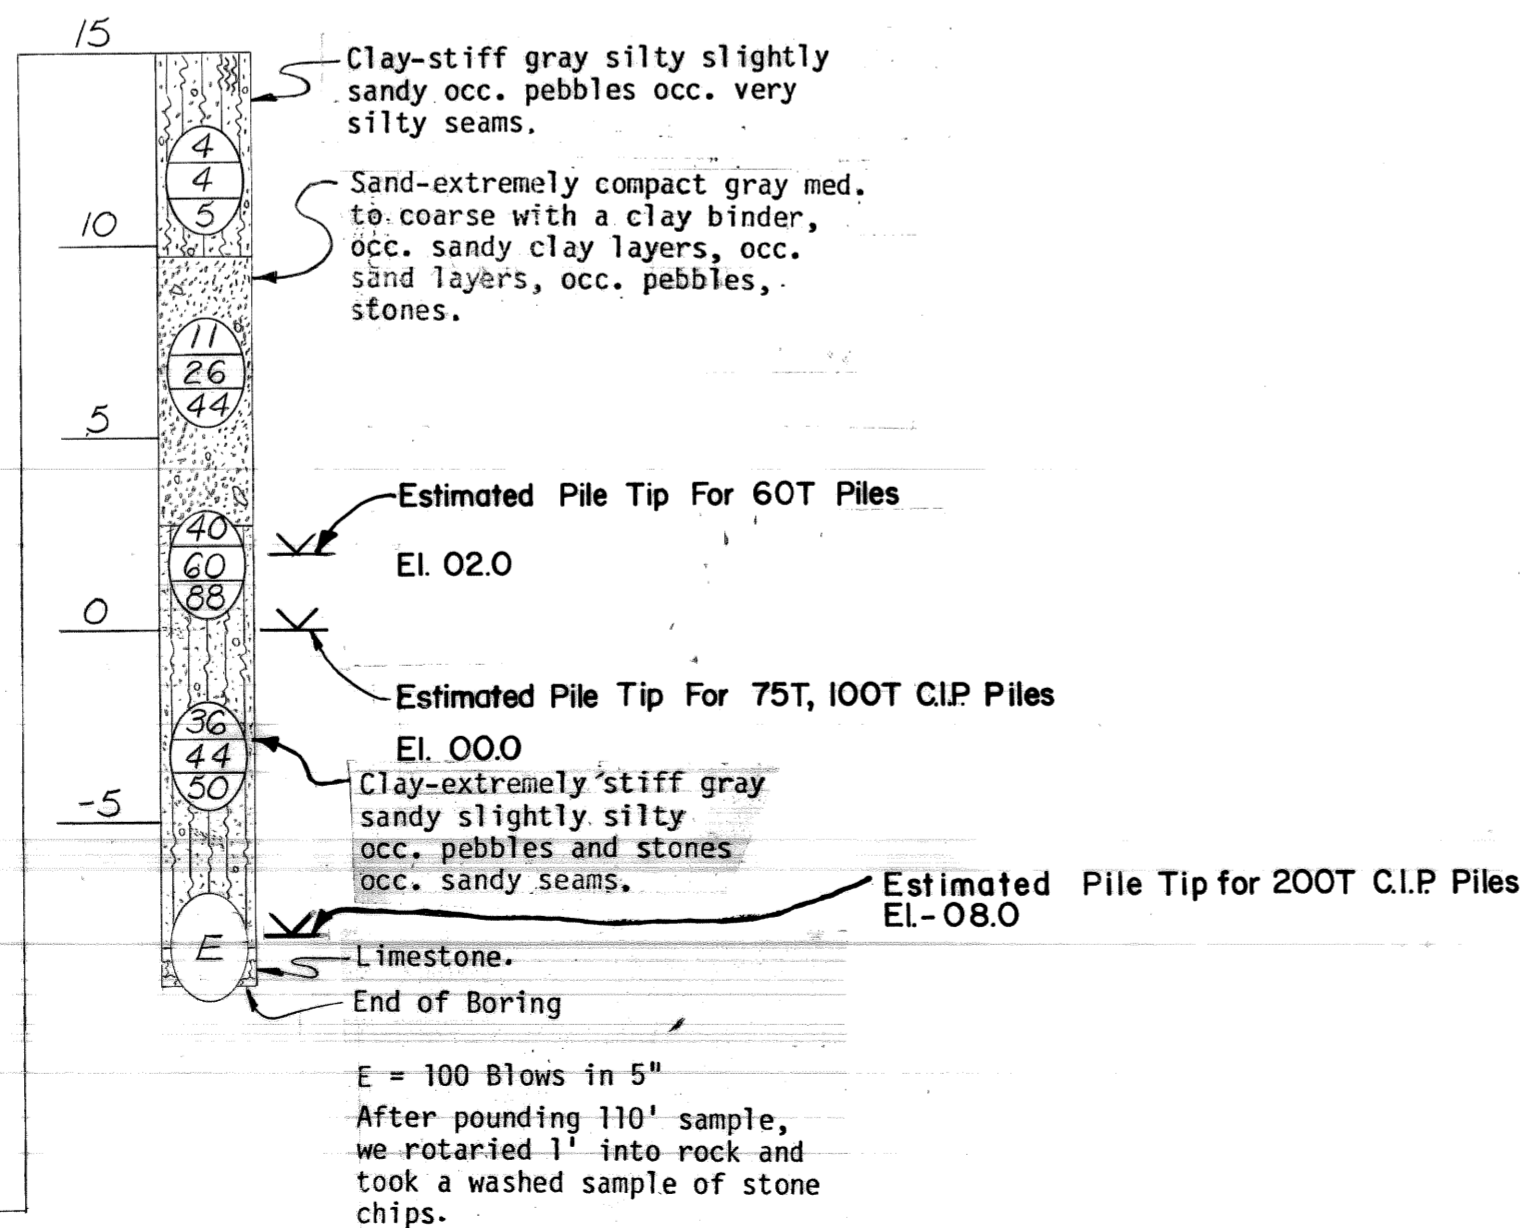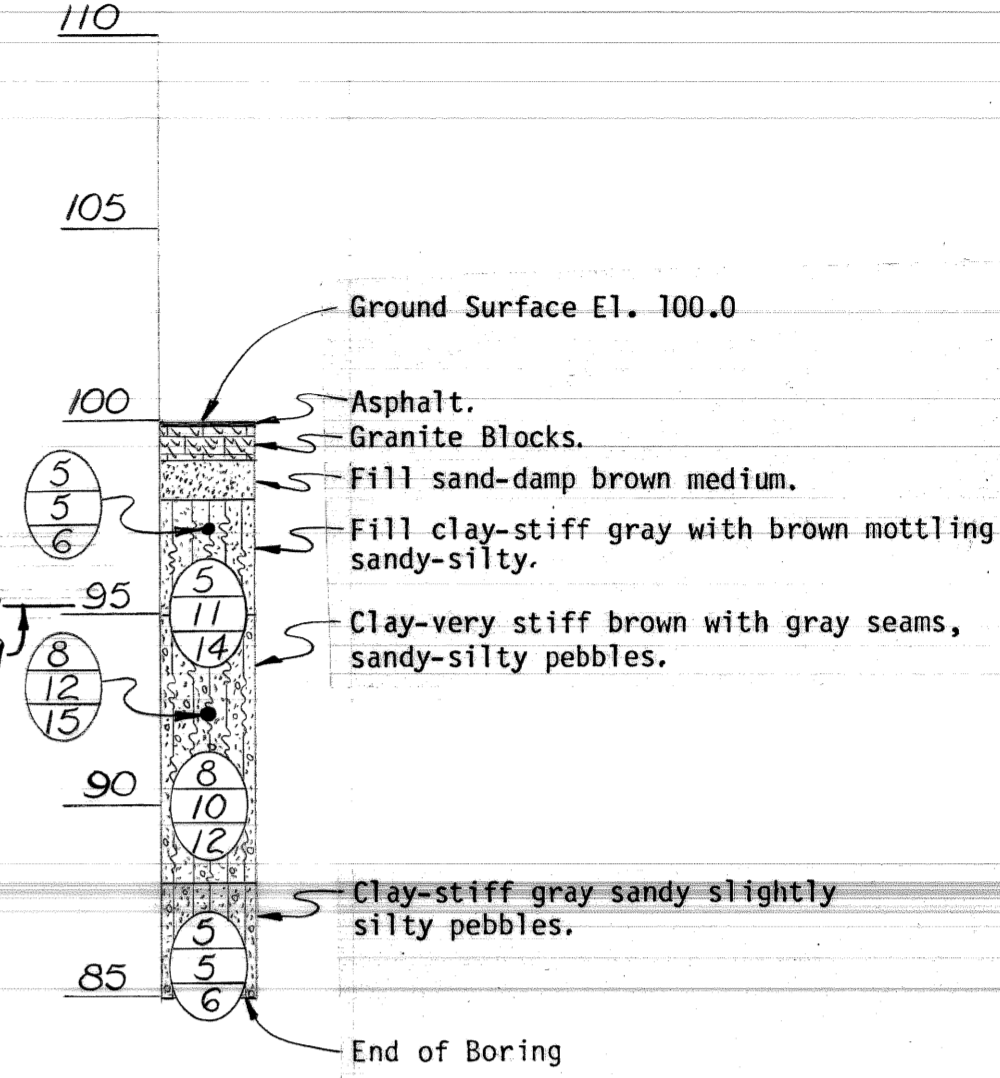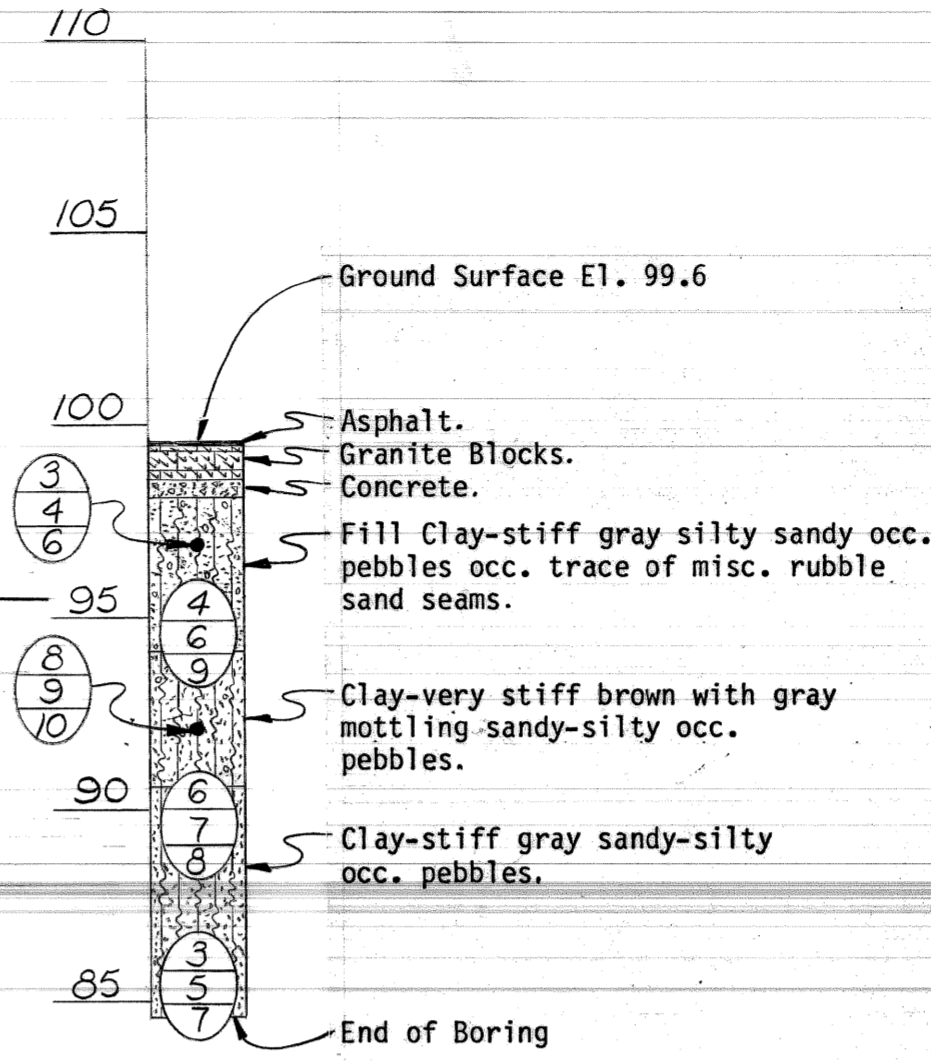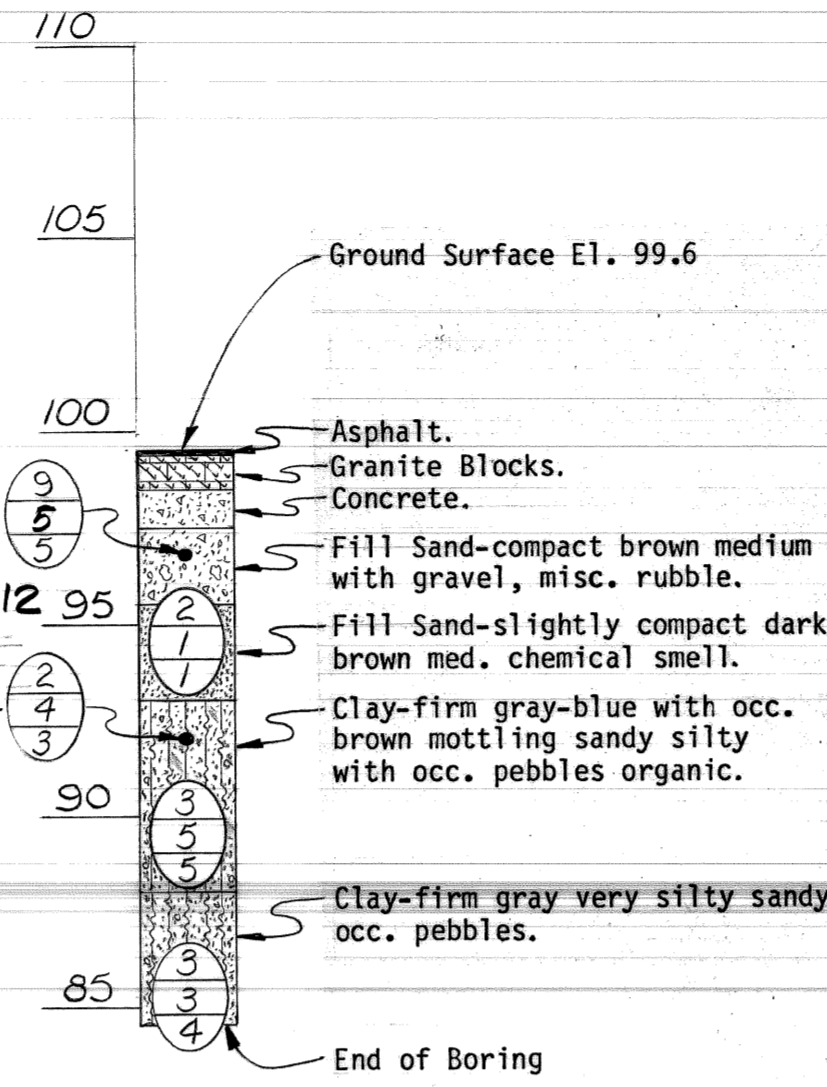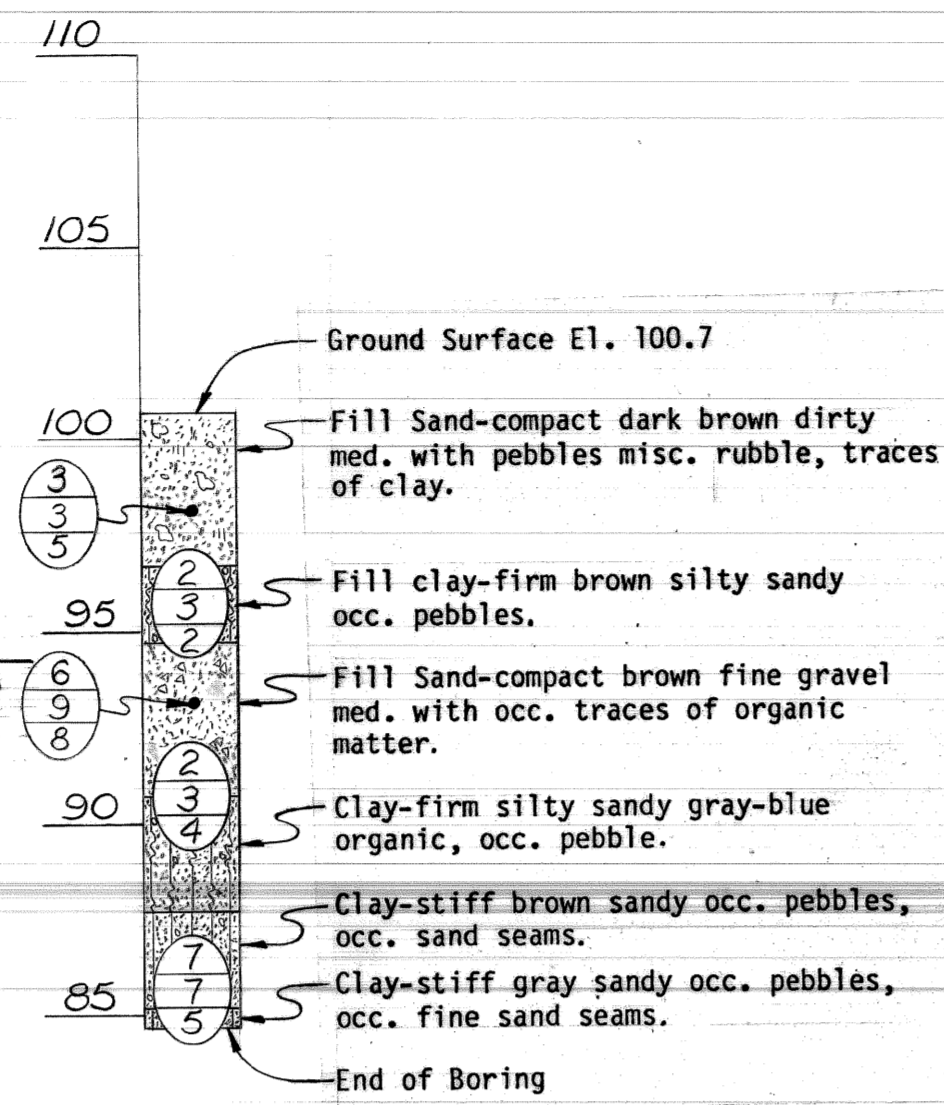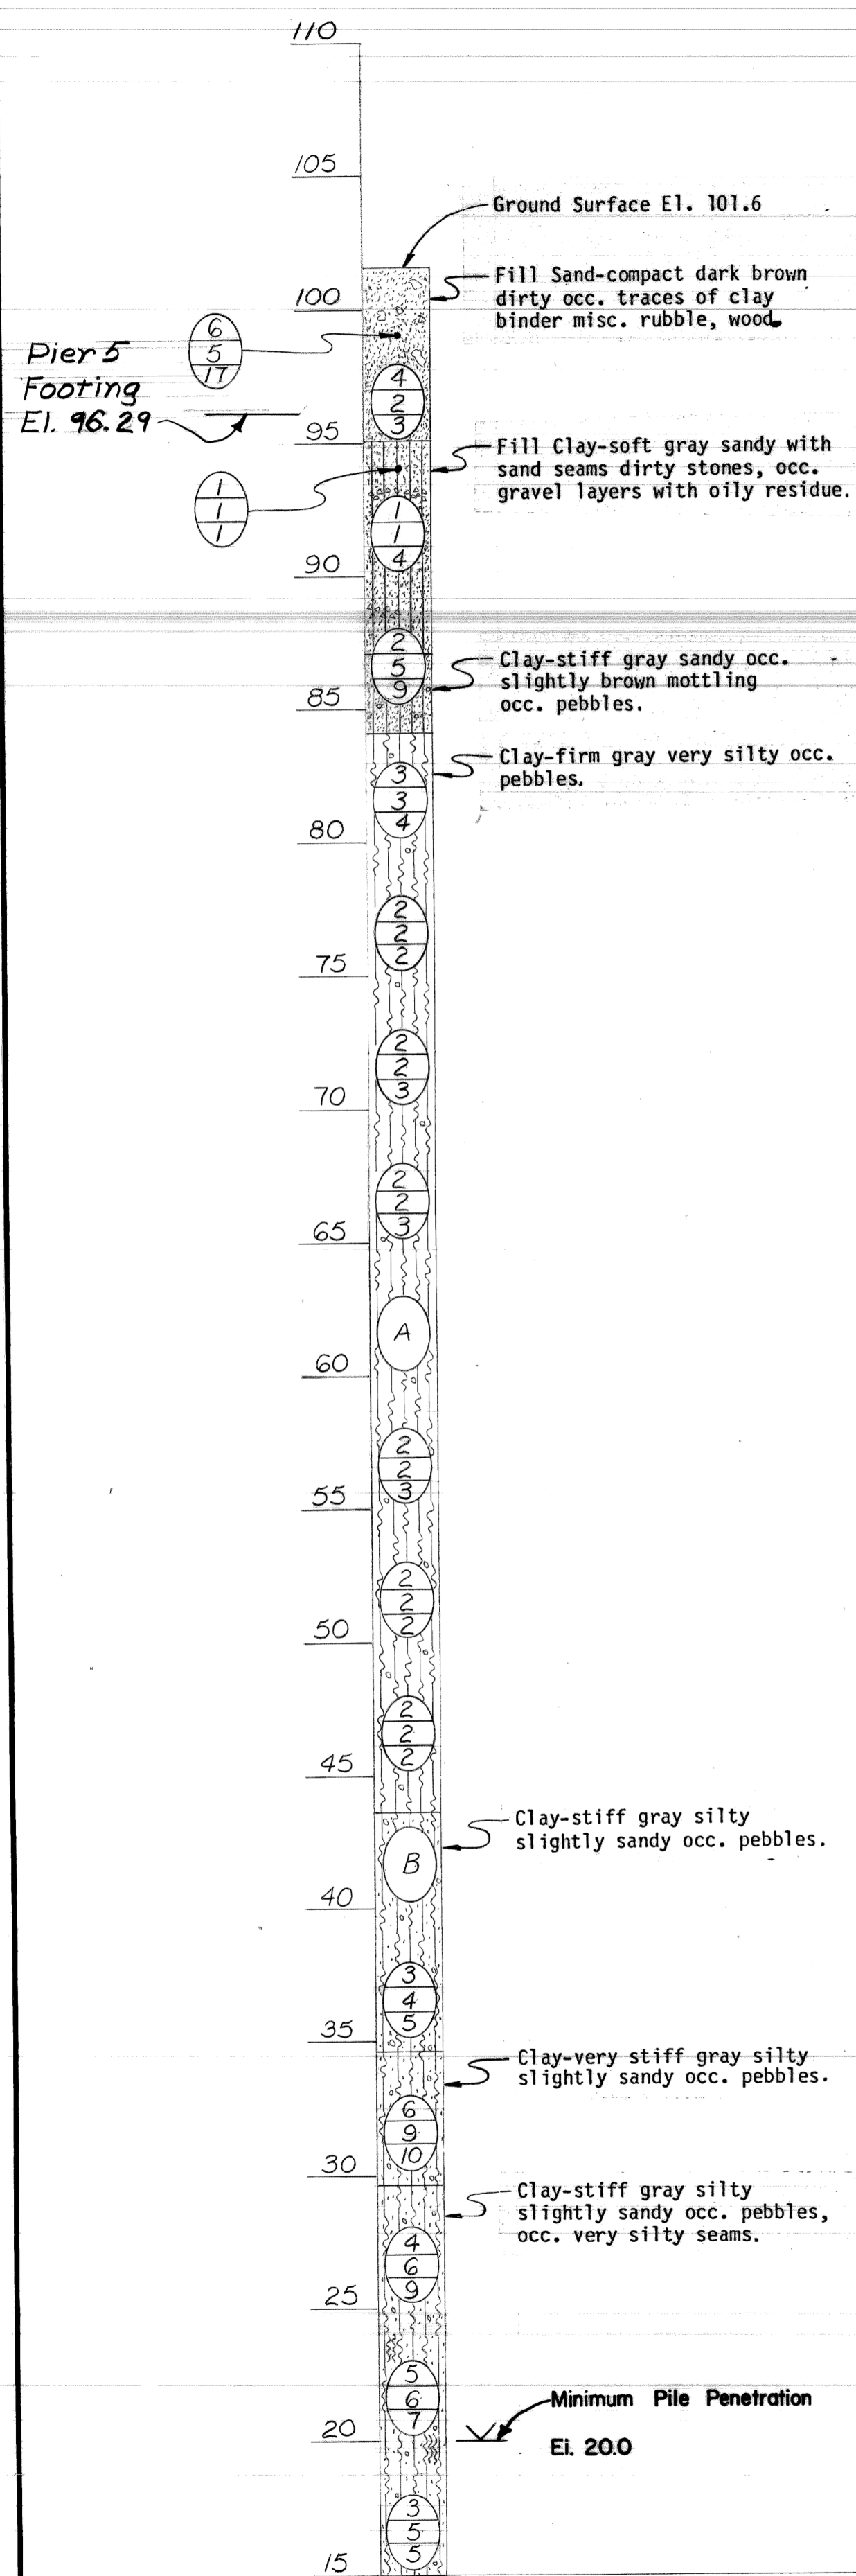

Consistency of borings was determined by inspection of samples & substantiated by soils resistance to drilling tools.

The soil boring logs represent point information. Presentation of this information in no way infers that subsurface conditions are the same at location other than the exact location of the boring.

0 = Number of blows required to drive a 2" O.D. split barrel sampler the 6" incremental distance shown using a 140# weight freefalling 30".

⊙ - Denotes number of blows for first 6"
 ⊙ - Denotes number of blows for second 6"
 ⊙ - Denotes number of blows for third 6"

Soil borings were performed starting on March 12, 1979 and ending on March 19, 1979 by Soil Structures, Inc.

If not otherwise indicated, the samples were taken by a split barrel liner, ASTM D 1587.

ⓐ ⓑ - Denotes Shelby tube sample, ASTM D 1587.

Work This Sheet With Sheets # SG 458

DATE: August, 1979

DSGN BY:	RGW
DR'N BY:	TCP
CK'D BY:	RGW
APP'D BY:	

REVISIONS	

CITY OF DETROIT, MICHIGAN




JOHN C. LODGE EXIT RAMP AND JEFFERSON AVENUE-
RECONSTRUCTION AT THE JOE LOUIS ARENA.

LOG OF BORINGS


SCALE: NONE

DRN. NO: S7


Test Hole #11
Location: 20' ± Left Sta. 136 + 09
on Jefferson Ave.

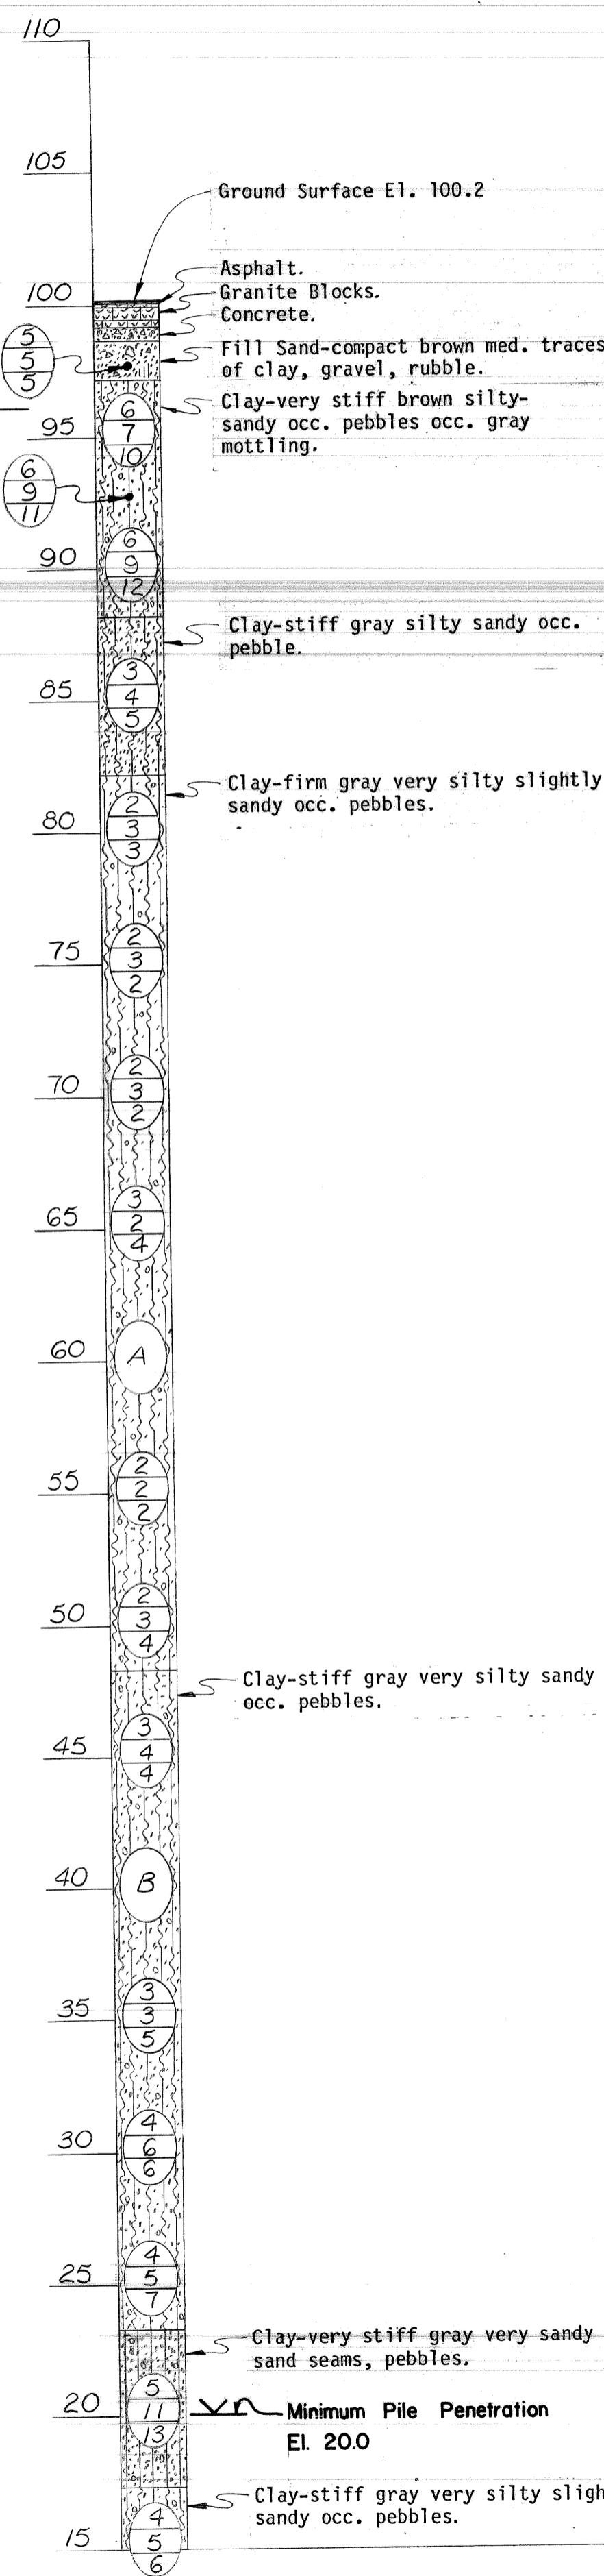


Test Hole #12
Location: 20' ± Left Sta. 135 + 47
on Jefferson Ave.

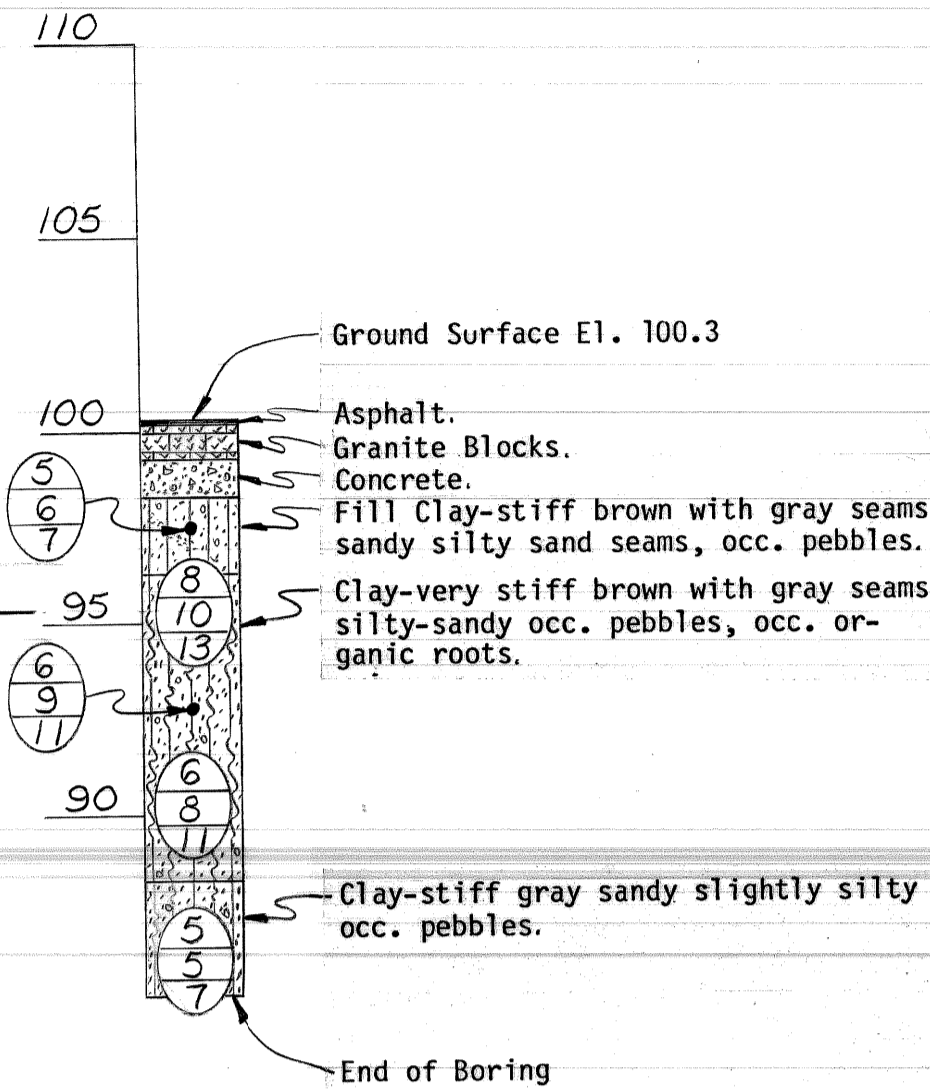


Test Hole #13
Location: 277' ± Left Sta. 141 + 06
on Jefferson Ave.

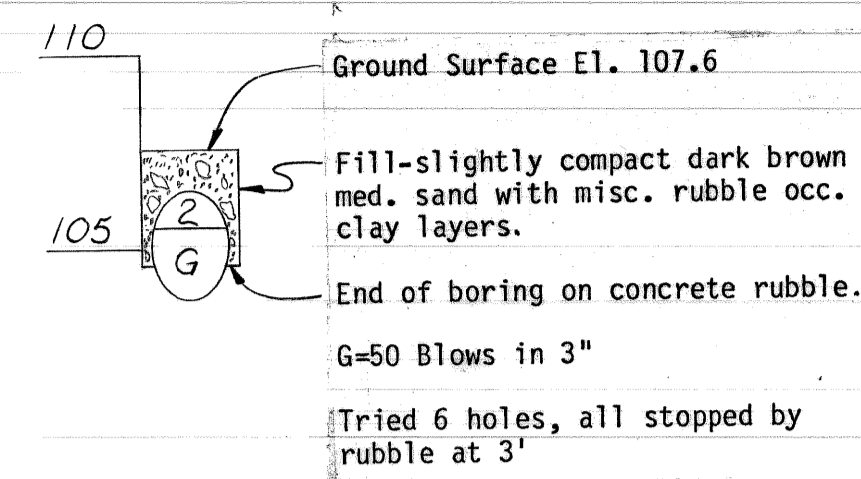

Test Hole #14
Location: 255' ± Left Sta. 140 + 76
on Jefferson Ave.


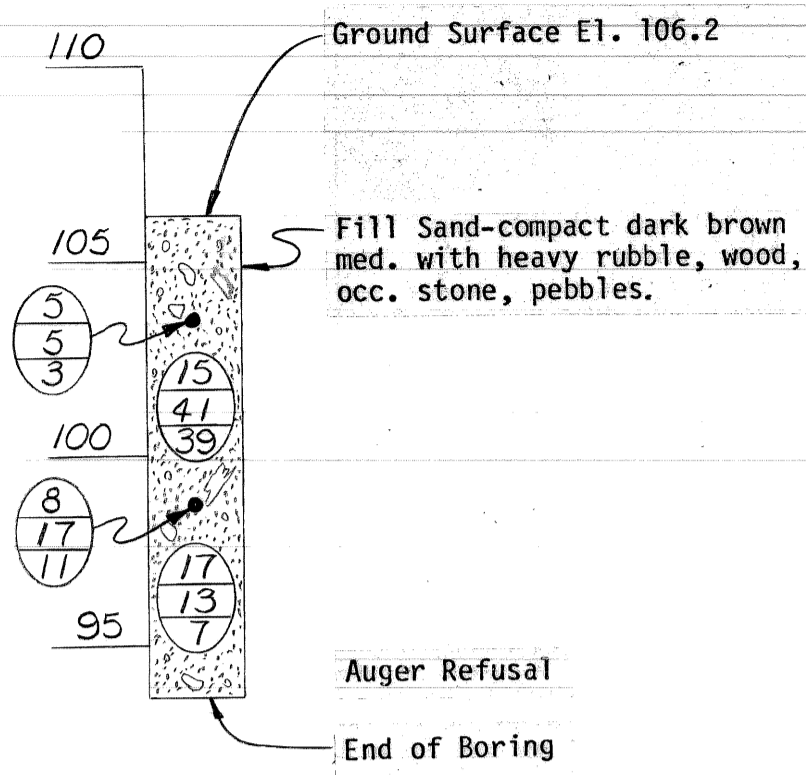


Test Hole #14A
Location: 223' ± Left Sta. 140 + 89
on Jefferson Ave.

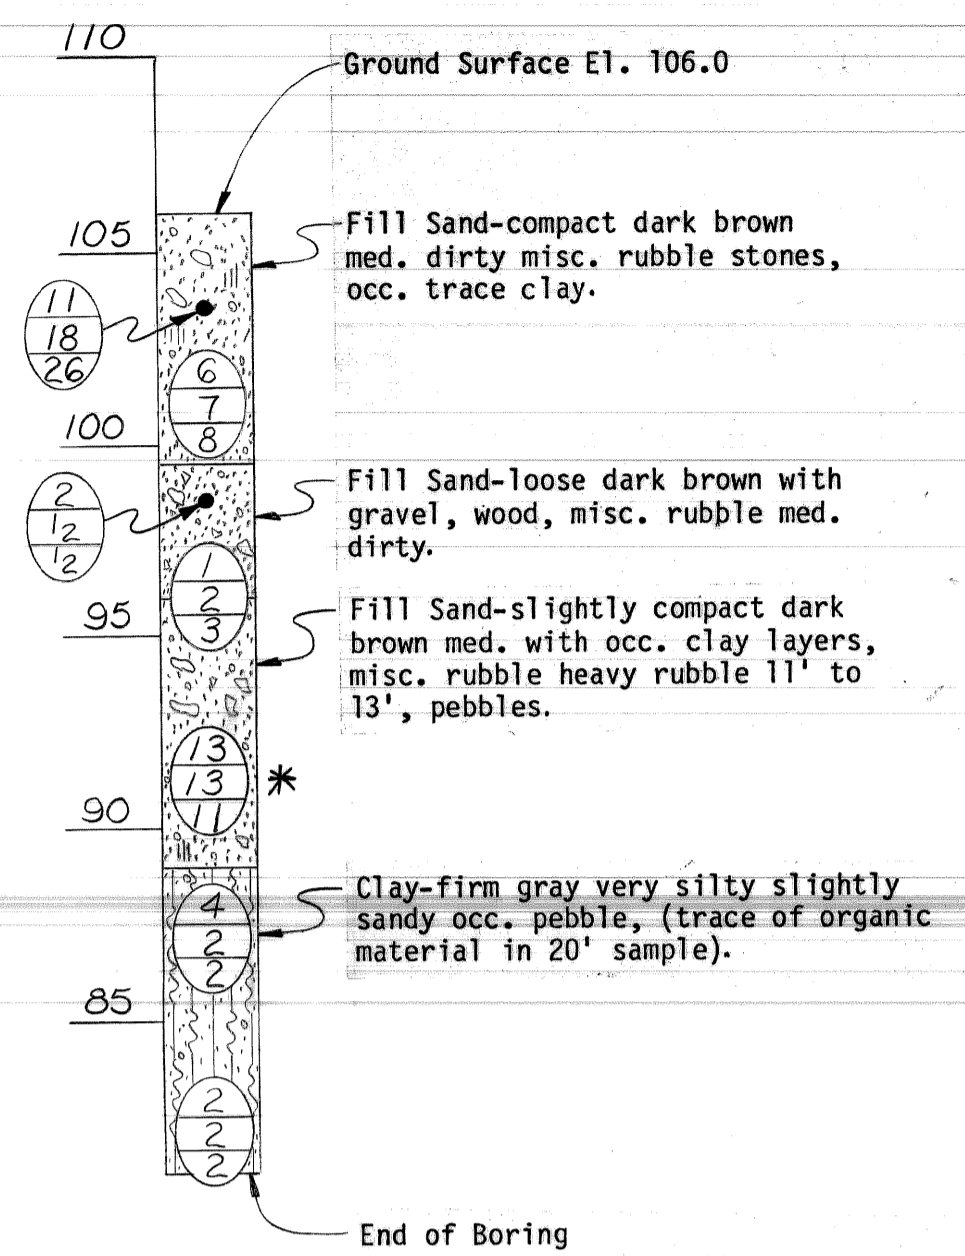

**Test Boring 14A located 33 feet south of Test Boring 14.
*15' sample bounced while being driven, blow counts were much higher than the material appeared, but there were not obstructions in the sampler.

Test Hole #15
Location: 436' ± Left Sta. 138 + 50
on Jefferson Ave.

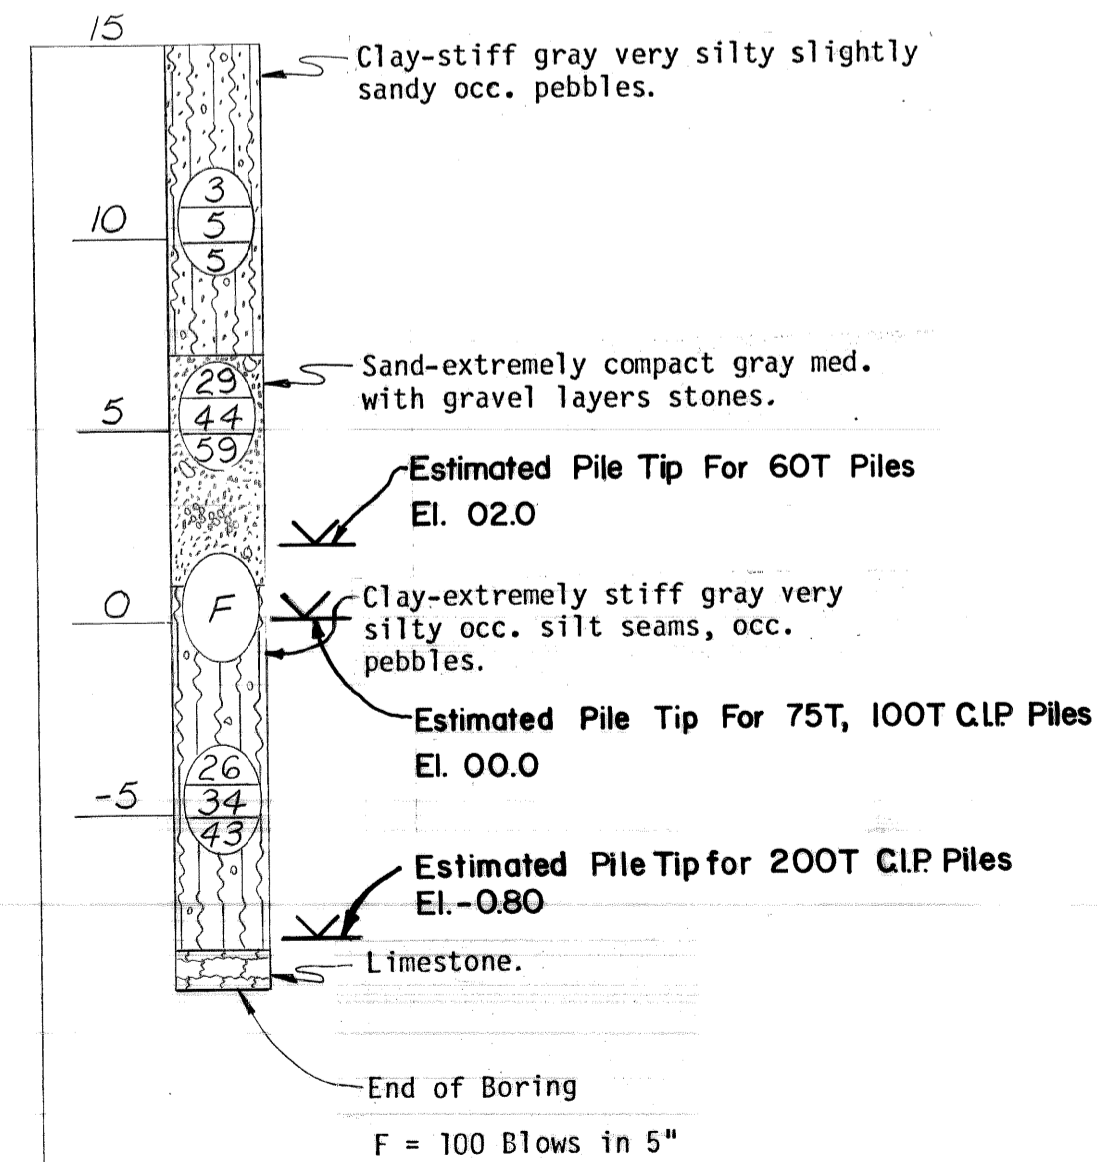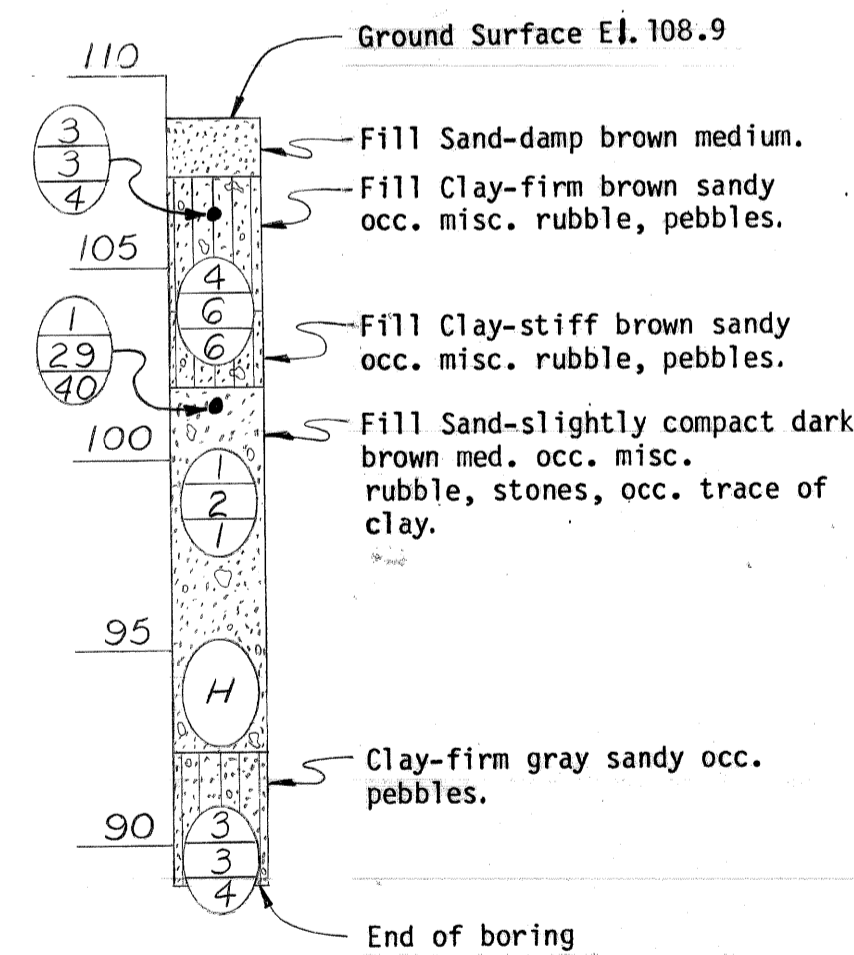

Work This Sheet With Sheets # S6 & S7

DATE: August, 1979

DSGN BY:	RGW
DRN BY:	TCP
CK'D BY:	RGW
APP'D BY:	

REVISIONS

CITY OF DETROIT, MICHIGAN





JOHN C. LODGE EXIT RAMP AND JEFFERSON AVENUE-
RECONSTRUCTION AT THE JOE LOUIS ARENA.

LOG OF BORINGS

SCALE: NONE

DRN. NO: S8

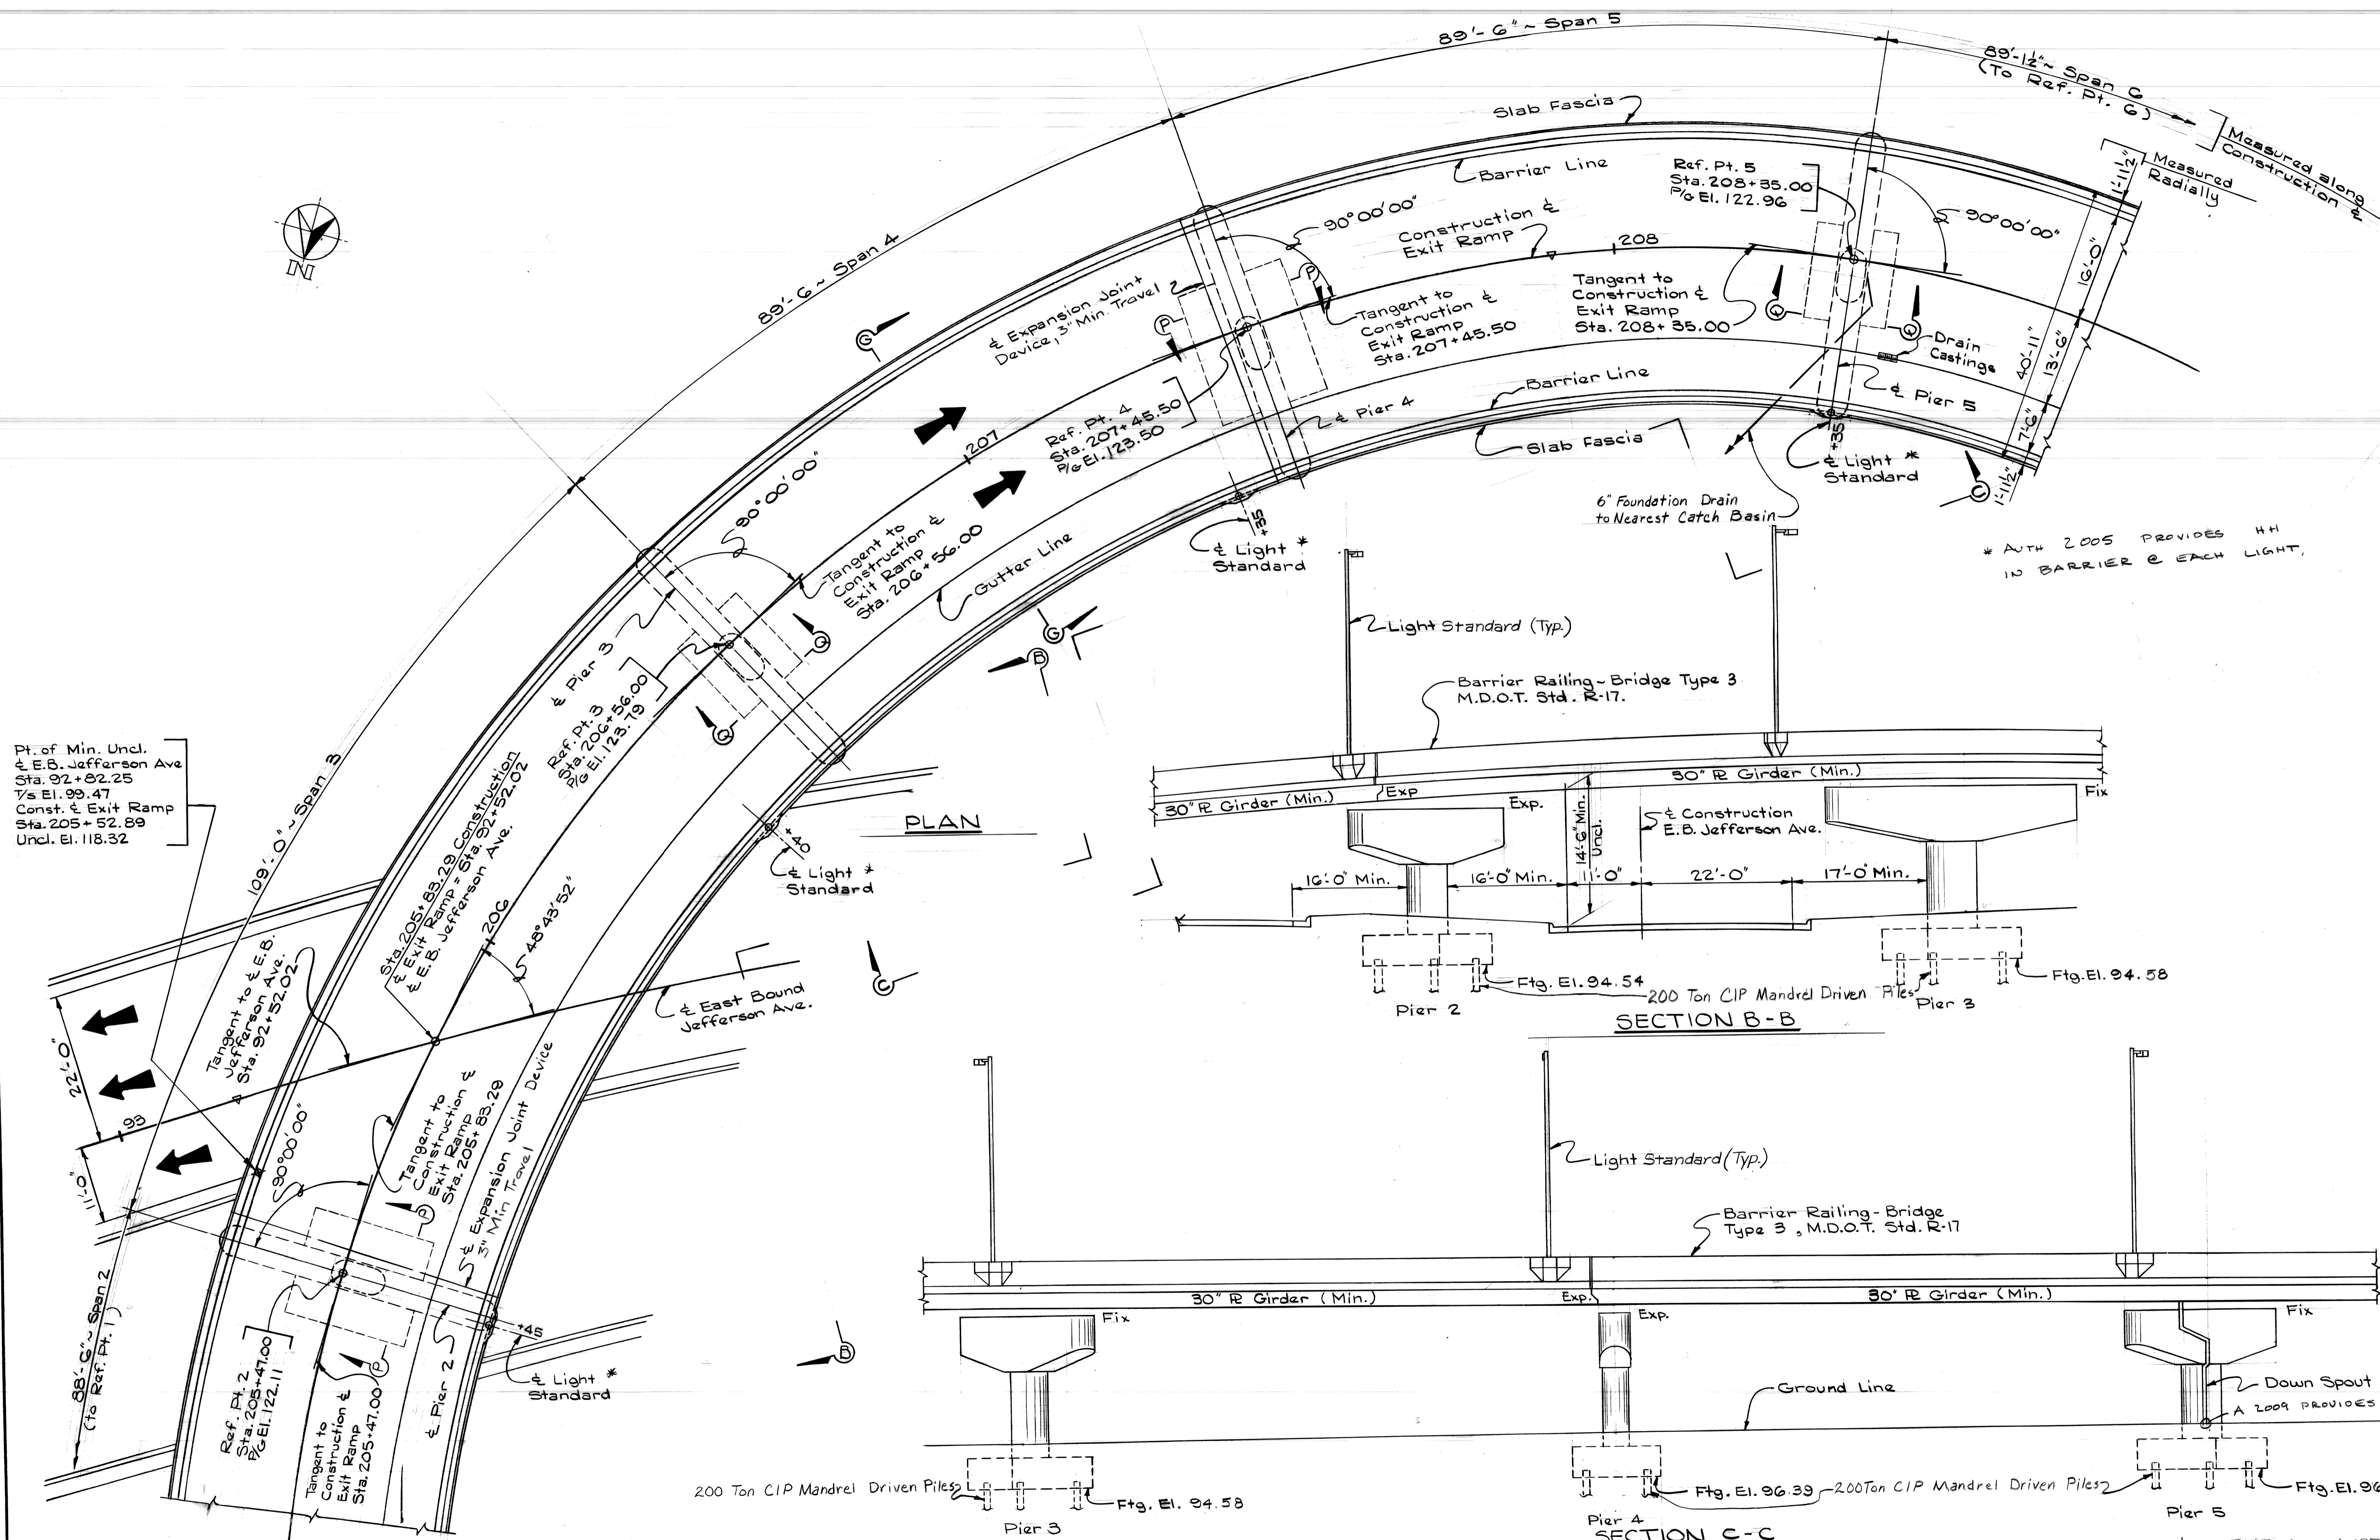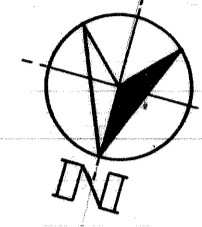

Pt. of Min. Uncl. & E.B. Jefferson Ave Sta. 92+82.25 1/2 El. 99.47 Const. & Exit Ramp Sta. 205+52.89 Uncl. El. 118.32

Sta. 205+83.29 Construction & Exit Ramp & E.B. Jefferson Ave. Sta. 92+52.02

Sta. 205+47.00 Construction & Exit Ramp & E.B. Jefferson Ave. Sta. 92+47.00

Sta. 207+45.50 Construction & Exit Ramp & E.B. Jefferson Ave. Sta. 92+45.50

Sta. 208+35.00 Construction & Exit Ramp & E.B. Jefferson Ave. Sta. 92+35.00

Sta. 206+56.00 Construction & Exit Ramp & E.B. Jefferson Ave. Sta. 92+56.00

Sta. 207+45.50 Construction & Exit Ramp & E.B. Jefferson Ave. Sta. 92+45.50

PLAN

SECTION B-B

SECTION C-C


* A111 2005 PROVIDES 4H IN BARRIER @ EACH LIGHT.

Work This Sheet With Sheets # 59, 511, 512, 516, 517 & 518 DATE: August, 1979

DSGN BY:	RCW, SEB, SJO
DRN BY:	SJP
CK'D BY:	RCW
APP'D BY:	

REVISIONS	


CITY OF DETROIT, MICHIGAN

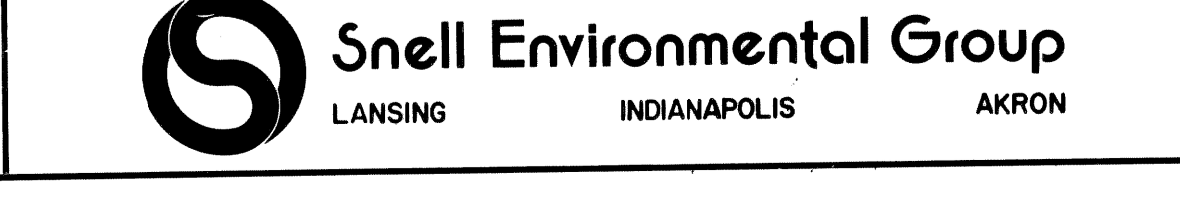

JOHN C. LODGE EXIT RAMP AND JEFFERSON AVENUE - RECONSTRUCTION AT THE JOE LOUIS ARENA

GENERAL PLAN OF STRUCTURE BRIDGE PLAN & ELEVATION

SCALE: NONE
DRN. NO: S10

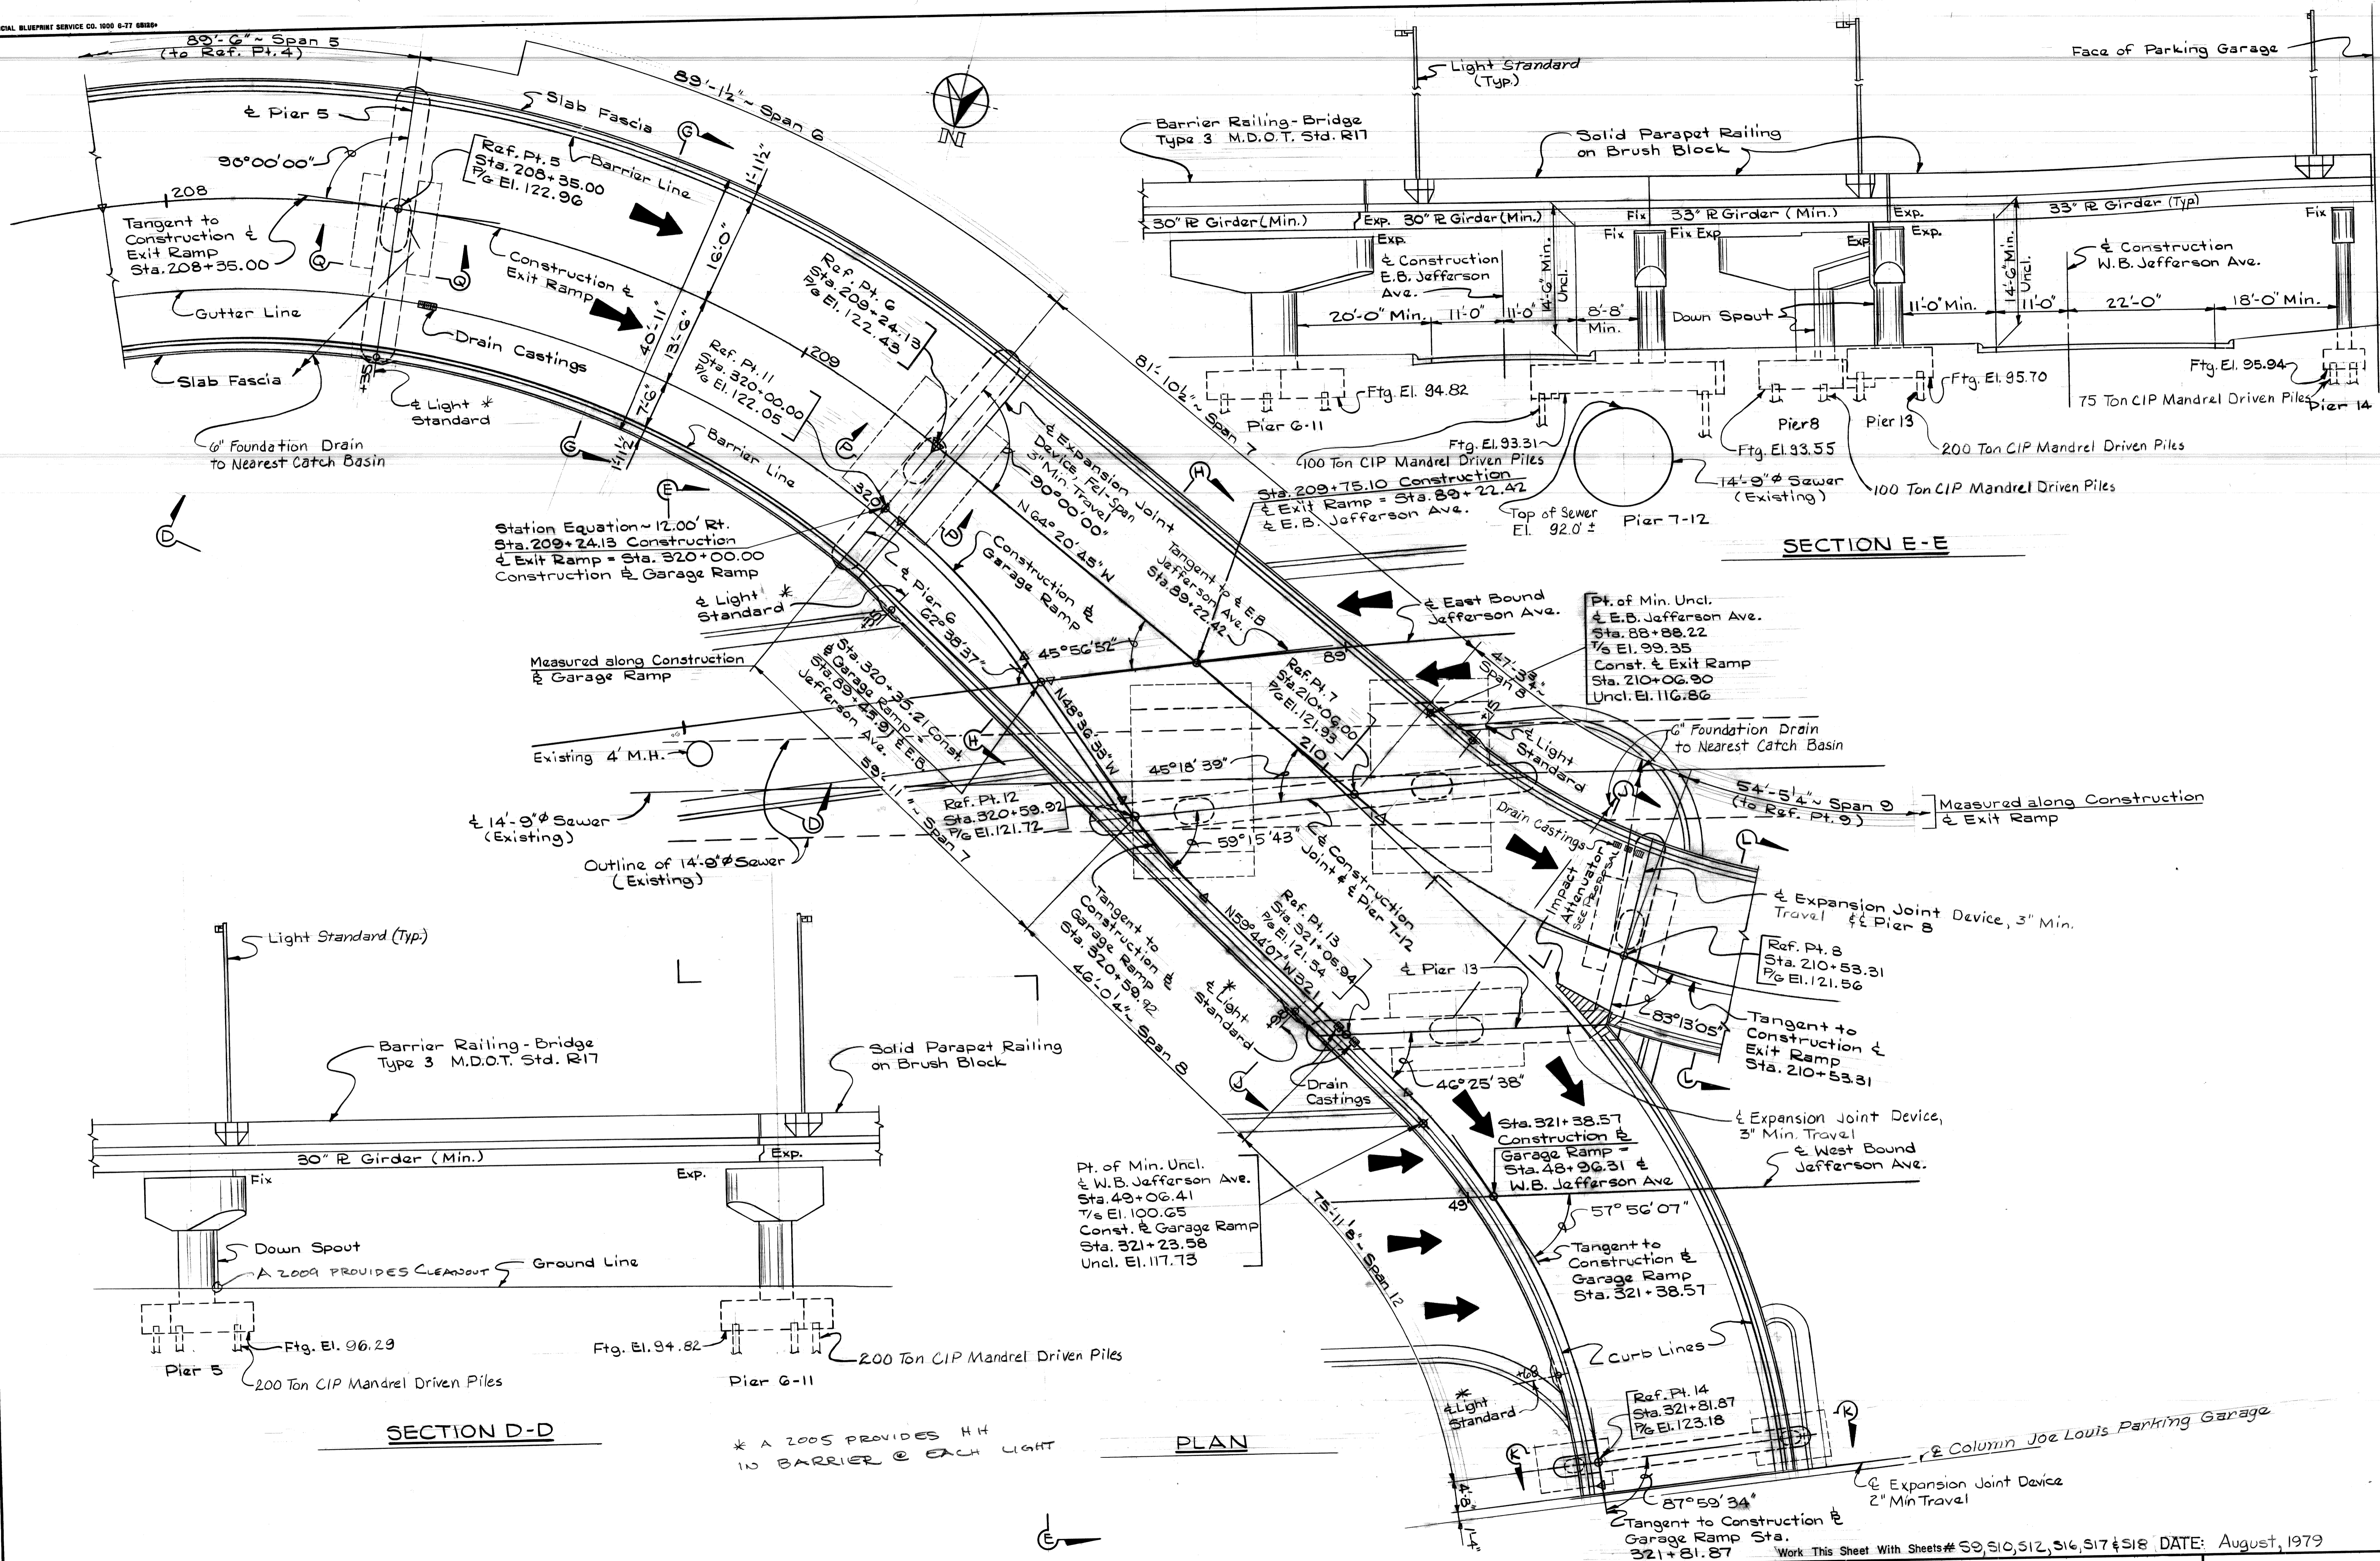

DSGN BY:	RGW/SJP
DRN BY:	SJP
CK'D BY:	RGW
APP'D BY:	

REVISIONS	


CITY OF DETROIT, MICHIGAN




JOHN C. LODGE EXIT RAMP AND JEFFERSON AVENUE RECONSTRUCTION AT THE JOE LOUIS ARENA.

GENERAL PLAN OF STRUCTURE BRIDGE PLAN & ELEVATION
 SCALE: NONE
 DRN. NO: S11


Work This Sheet With Sheets # S9, S10, S12, S16, S17 & S18 DATE: August, 1979

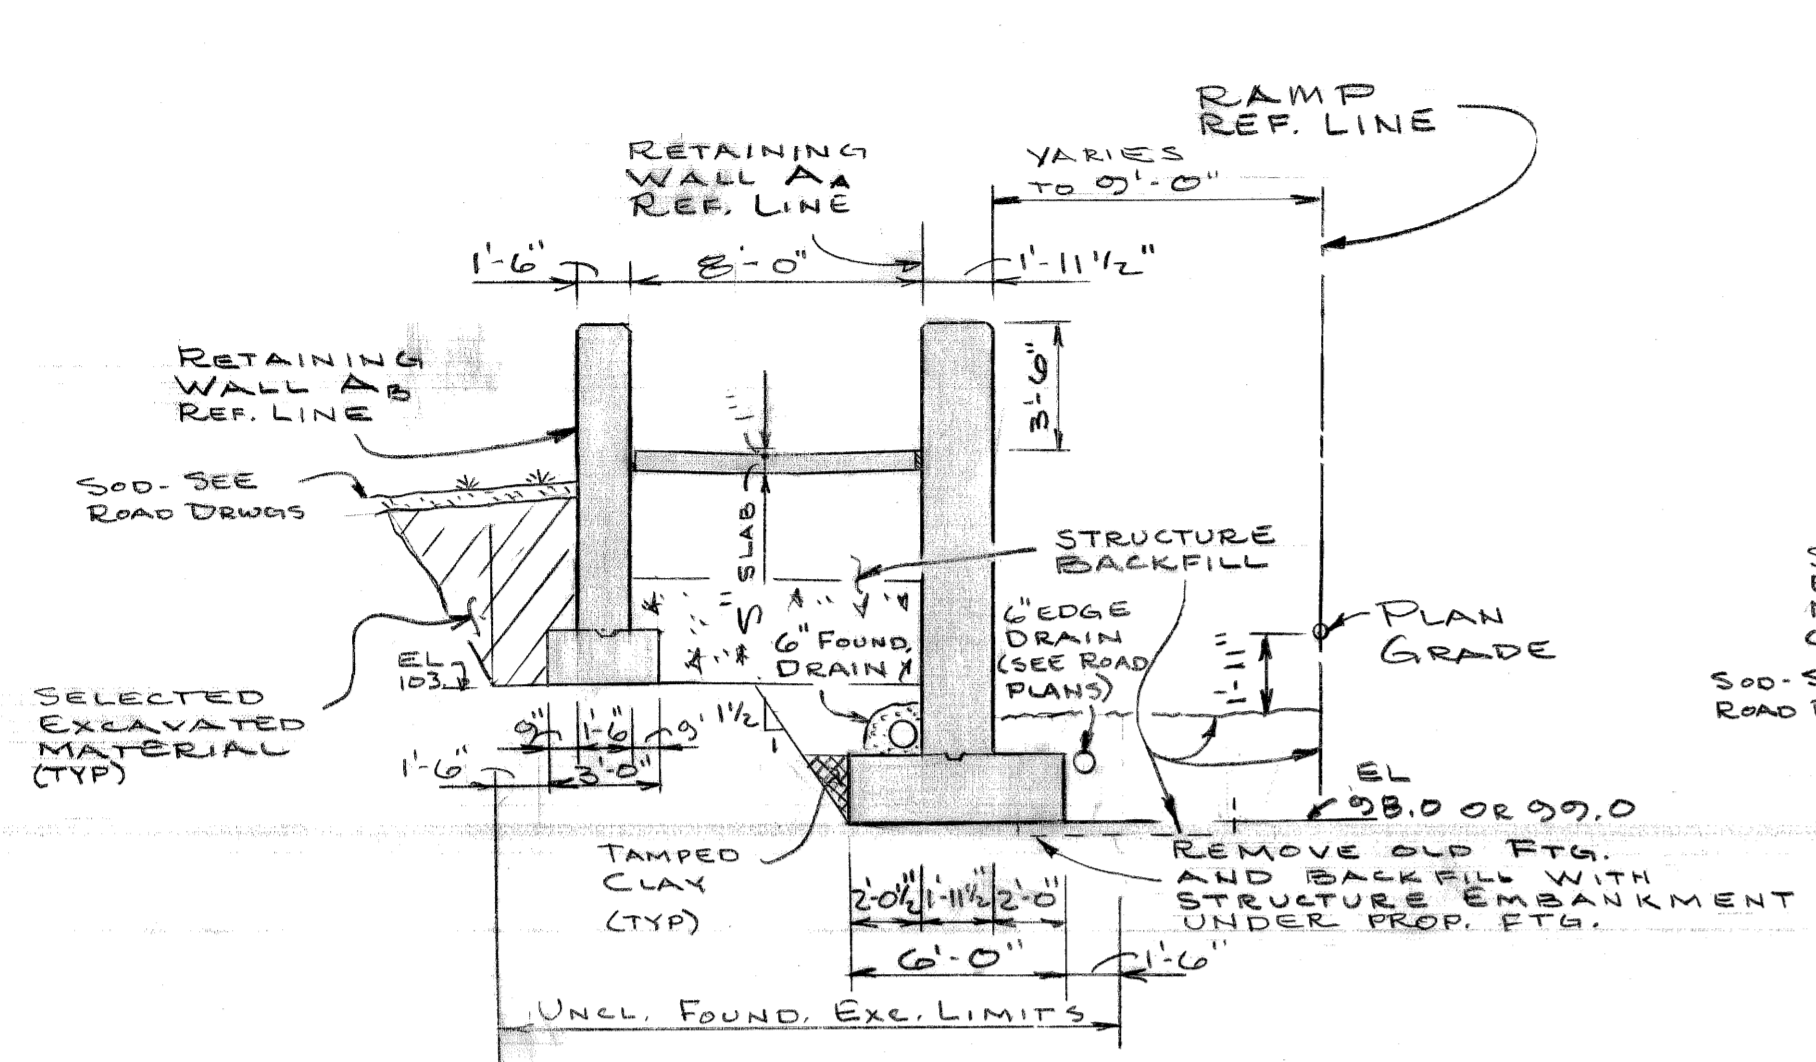


SECTION A
SCALE: 3/16" = 1'-0"

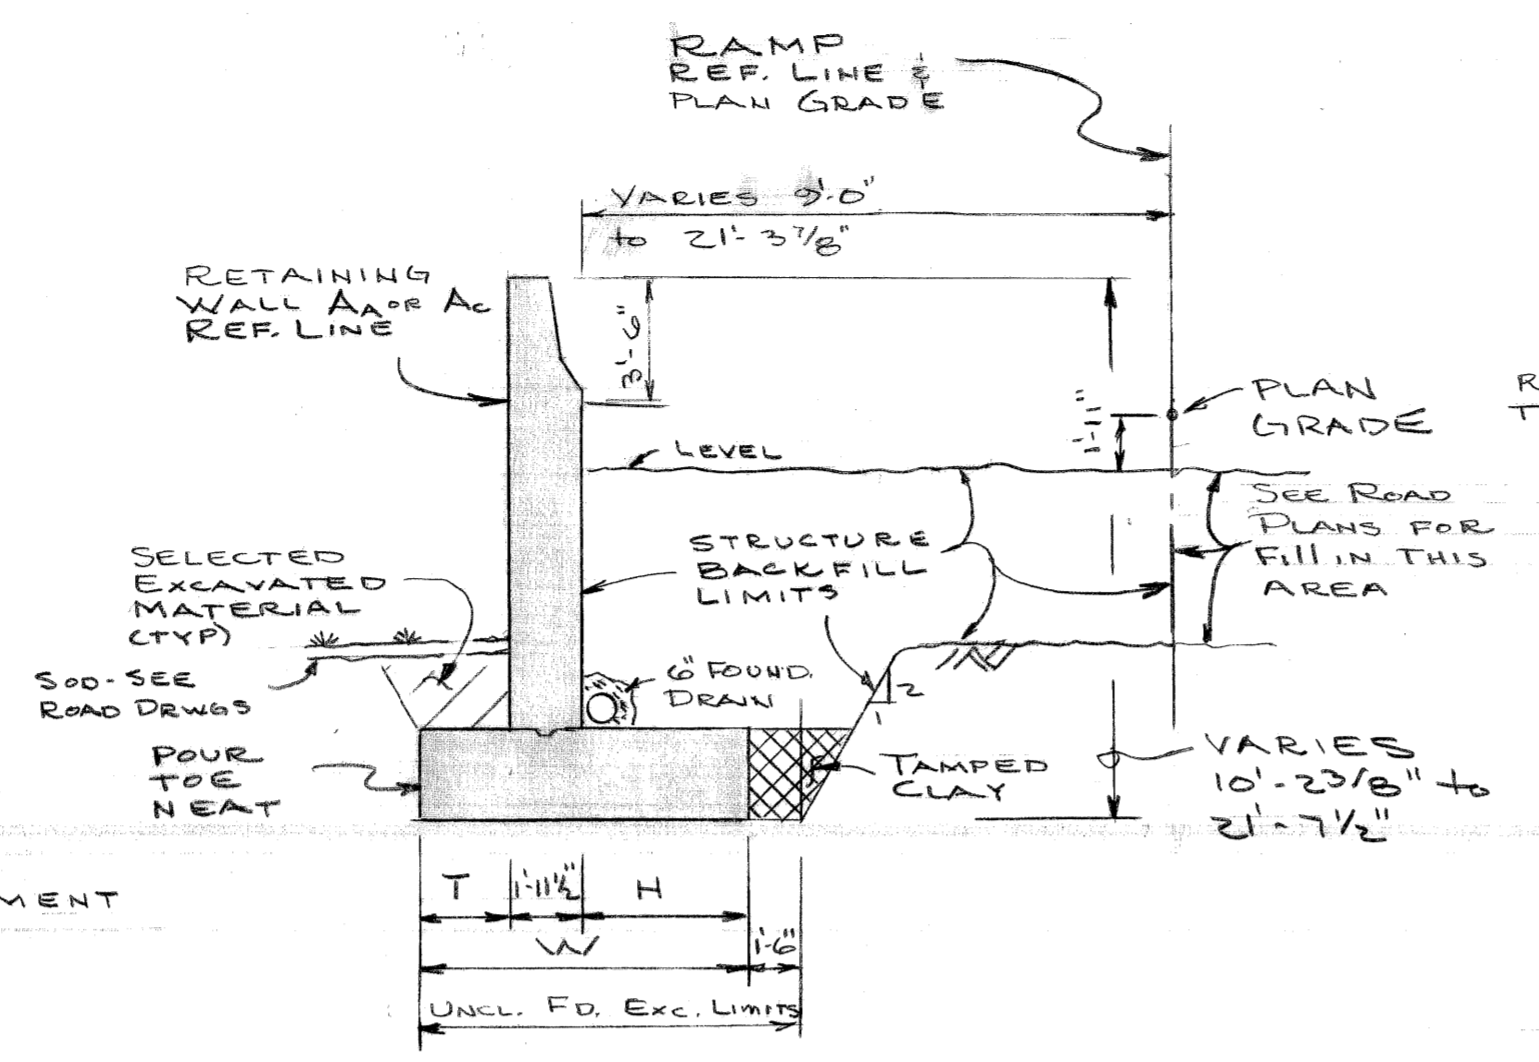


SECTION B
SCALE: 3/16" = 1'-0"

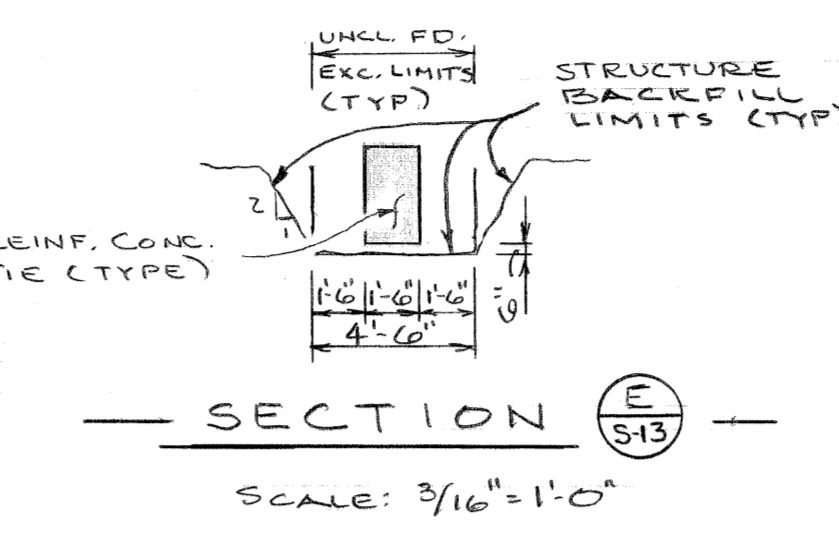


SECTION E
SCALE: 3/16" = 1'-0"

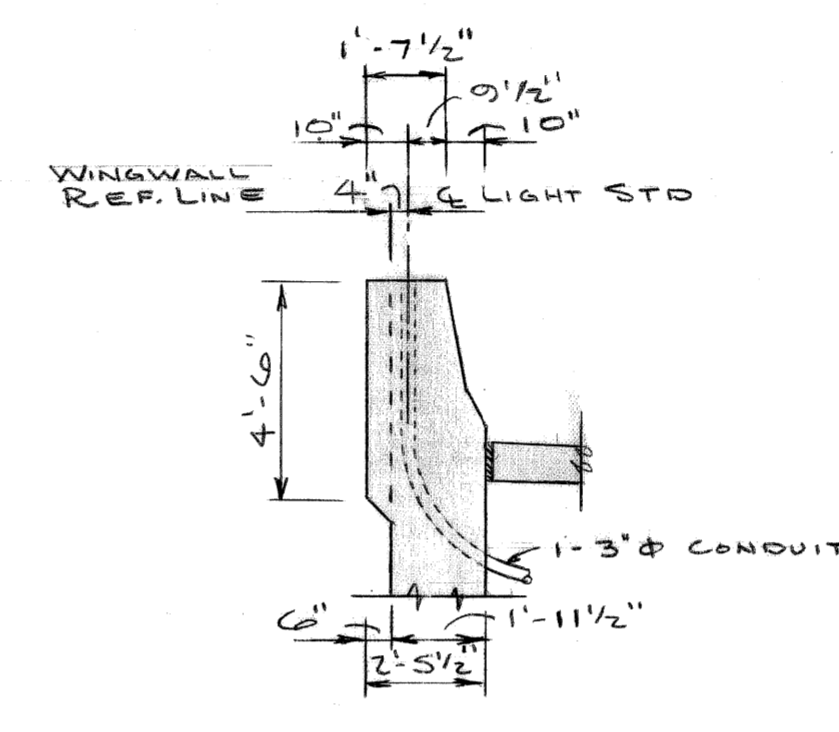


SECTION J
SCALE: 1/4" = 1'-0"

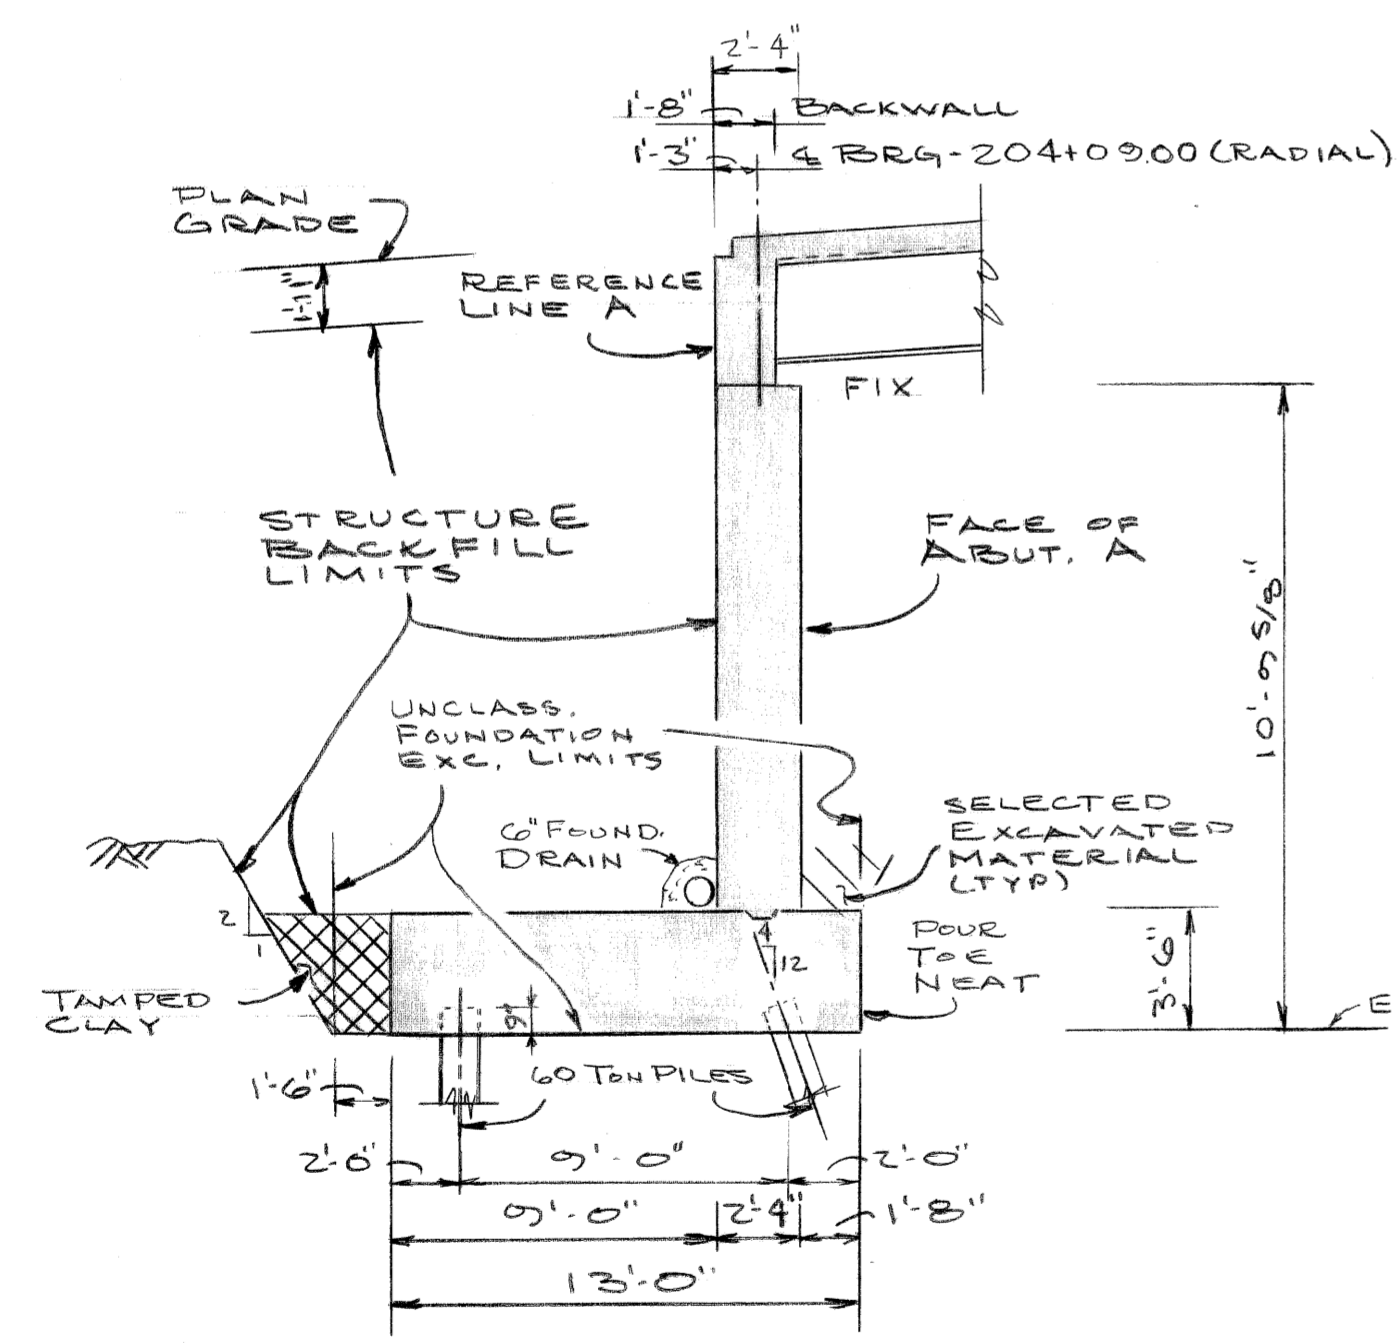

SECTION C
SCALE: 3/16" = 1'-0"

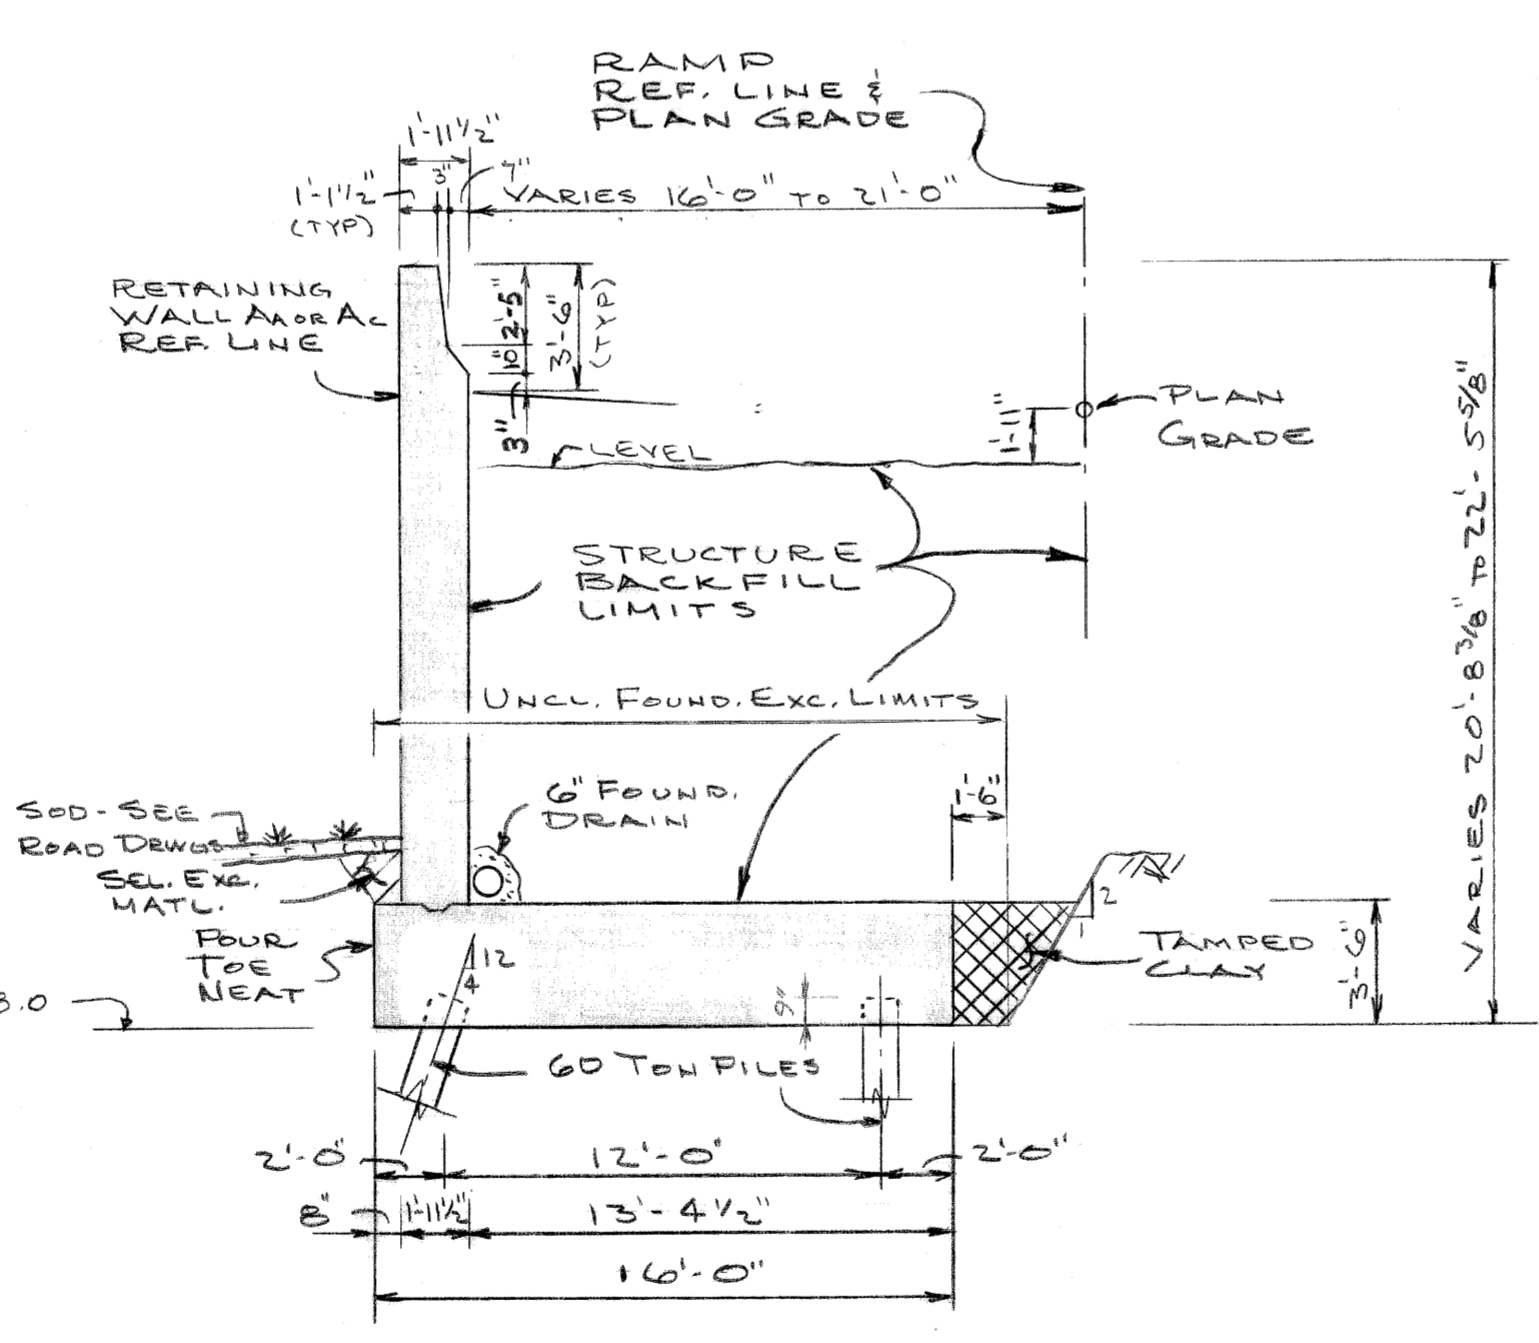

SECTION D
SCALE: 3/16" = 1'-0"

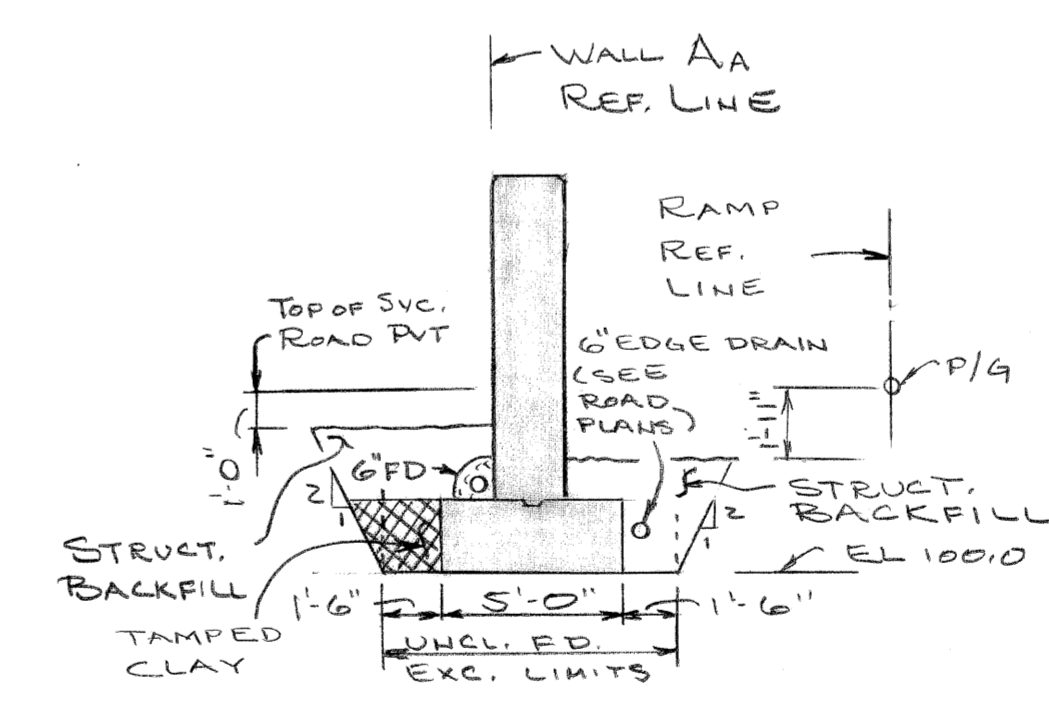

SECTION K
SCALE: 3/16" = 1'-0"

PANEL	TOE	WALL THICK.	HEEL	FTG. WIDTH	FTG. THICK.	B/ FTG. ELEV.	REMARKS
AA							
1-3	2'-0"	1'-11 1/2"	2'-0 1/2"	6'-0"	2'-6"	98.0	OMIT FTG. IN PANEL #2 AT SEWER.
4-5	2'-0"	1'-11 1/2"	2'-0 1/2"	6'-0"	2'-0"	99.0	
6-8	1'-6"	1'-11 1/2"	1'-6 1/2"	5'-0"	2'-0"	100.0	
9-12	2'-0"	1'-11 1/2"	2'-0 1/2"	6'-0"	2'-0"	99.0	
13-14	3'-6"	1'-11 1/2"	3'-6 1/2"	9'-0"	2'-6"	98.0	
15-16	4'-3"	1'-11 1/2"	5'-9 1/2"	12'-0"	2'-6"	98.0	
17	5'-0"	1'-11 1/2"	7'-0 1/2"	14'-0"	2'-6"	98.0	
18	0'-8"	1'-11 1/2"	13'-4 1/2"	16'-0"	3'-6"	98.0	ON PILES
AB							
1-5	0'-9"	1'-6"	0'-9"	3'-0"	1'-6"	103.0	
AC							
1	3'-0"	1'-11 1/2"	4'-0 1/2"	9'-0"	2'-0"	101.5	
2	4'-3"	1'-11 1/2"	5'-9 1/2"	12'-0"	2'-6"	99.0	
3	5'-0"	1'-11 1/2"	7'-0 1/2"	14'-0"	2'-6"	98.0	
4	0'-8"	1'-11 1/2"	13'-4 1/2"	16'-0"	3'-6"	98.0	ON PILES
AD							
1	0'-6"	1'-0"	2'-6"	4'-0"	1'-6"	103.0	

GENERAL NOTES:

THE DESIGN OF THIS STRUCTURE IS BASED ON MDOT SPECIFICATIONS FOR THE DESIGN OF HIGHWAY BRIDGES, 1958 EDITION, AND CURRENT AASHTO STANDARD SPECIFICATIONS FOR HIGHWAY BRIDGES - HS 25 LOADING. LIVE LOAD DEFLECTION DOES NOT EXCEED 1/800 OF SPAN LENGTH AND 1/300 OF THE CANTILEVER ARM.

THE TOP OF ROADWAY SLAB IS PARALLEL TO THE VERTICAL PROFILE EXCEPT AS MODIFIED BY SUPERELEVATION TRANSITIONS.

TAMPED CLAY AND SELECTED EXCAVATED MATERIAL ARE INCIDENTAL TO UNCLASSIFIED FOUNDATION EXCAVATION.

EXCEPT WHERE OTHERWISE INDICATED ON THESE PLANS OR IN THE PROPOSAL AND SUPPLEMENTAL SPECIFICATIONS, CONTAINED HEREIN, ALL MATERIALS AND WORKMANSHIP SHALL BE IN ACCORDANCE WITH MDOT STANDARD SPECIFICATIONS FOR HIGHWAY CONSTRUCTION, 1976 EDITION.

THE DESIGN OF SPREAD FOOTINGS FOR RETAINING WALLS AA, AB, AC AND AD IS BASED ON THE FOLLOWING MAXIMUM ALLOWABLE SOIL PRESSURES: DL = 1700 PSF; DL+LL = 2100 PSF

PREBORING PILES:
JEFFERSON INTERCEPTOR - NO PILES MAY BE DRIVEN WITHIN 5' OF THE SEWER AND ALL PILES WITHIN 25' SHALL BE PREBORED TO AT LEAST EL 65.0
THIRD ST. SEWER - NO PILES MAY BE DRIVEN WITHIN 15' OF THE SEWER AND ALL PILES WITHIN 25' SHALL BE PREBORED TO AT LEAST EL 80.0.
VOIDS AROUND PILES SHALL BE FILLED WITH SAND AND WATER



"STRUCTURE EMBANKMENT" IS INCIDENTAL TO "REMOVAL OF PORTIONS OF STRUCTURES"

THE STRUCTURE IS PARTLY ON A HORIZONTAL CURVE. THE FACIAL LINES AND BARRIER LINES ARE PARALLEL TO THE CURVES AND TANGENTS EXCEPT AS NOTED.
48" BULKHEADS SHALL BE OF BRICK AND AT LEAST 16" THICK. THEY SHALL BE CONSTRUCTED AS SPECIFIED UNDER S.14.03.C.11 OF THE STANDARD SPECIFICATIONS.


MISCELLANEOUS QUANTITIES

ITEM	QUANT.
REMOVAL OF PORTIONS OF STRUCTURES	LUMP SUM
TEMPORARY STEEL SHEET PILING	275 S. F.


DESIGNED BY <i>R. Fisher</i>	APPROVED: STRUCTURAL ENGINEER	CITY OF DETROIT CITY ENGINEERING DIVISION - EPMD	JOHN C. LODGE EXIT RAMP AND JEFFERSON AVE. RECONSTRUCTION AT THE JOE LOUIS ARENA	SHEET ___ OF ___ SHEETS
DRAWN BY <i>R. Fisher</i>				CONTRACT NO. 16563A
TRACED BY			RAMP - GENERAL PLAN OF STRUCTURE DETAILS	DRWG. NO. 5-15
CHECKED BY <i>M. Tice</i>				DATE AUG 1979

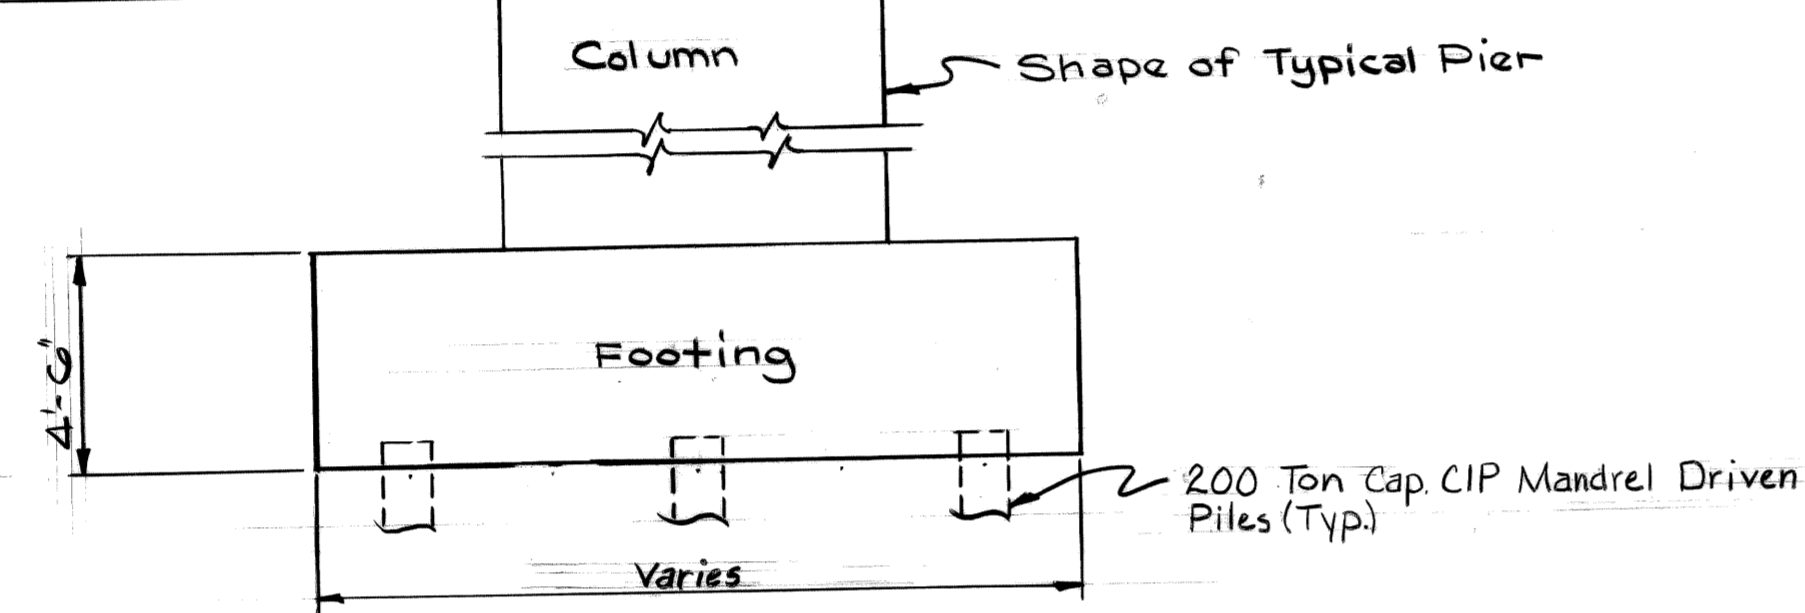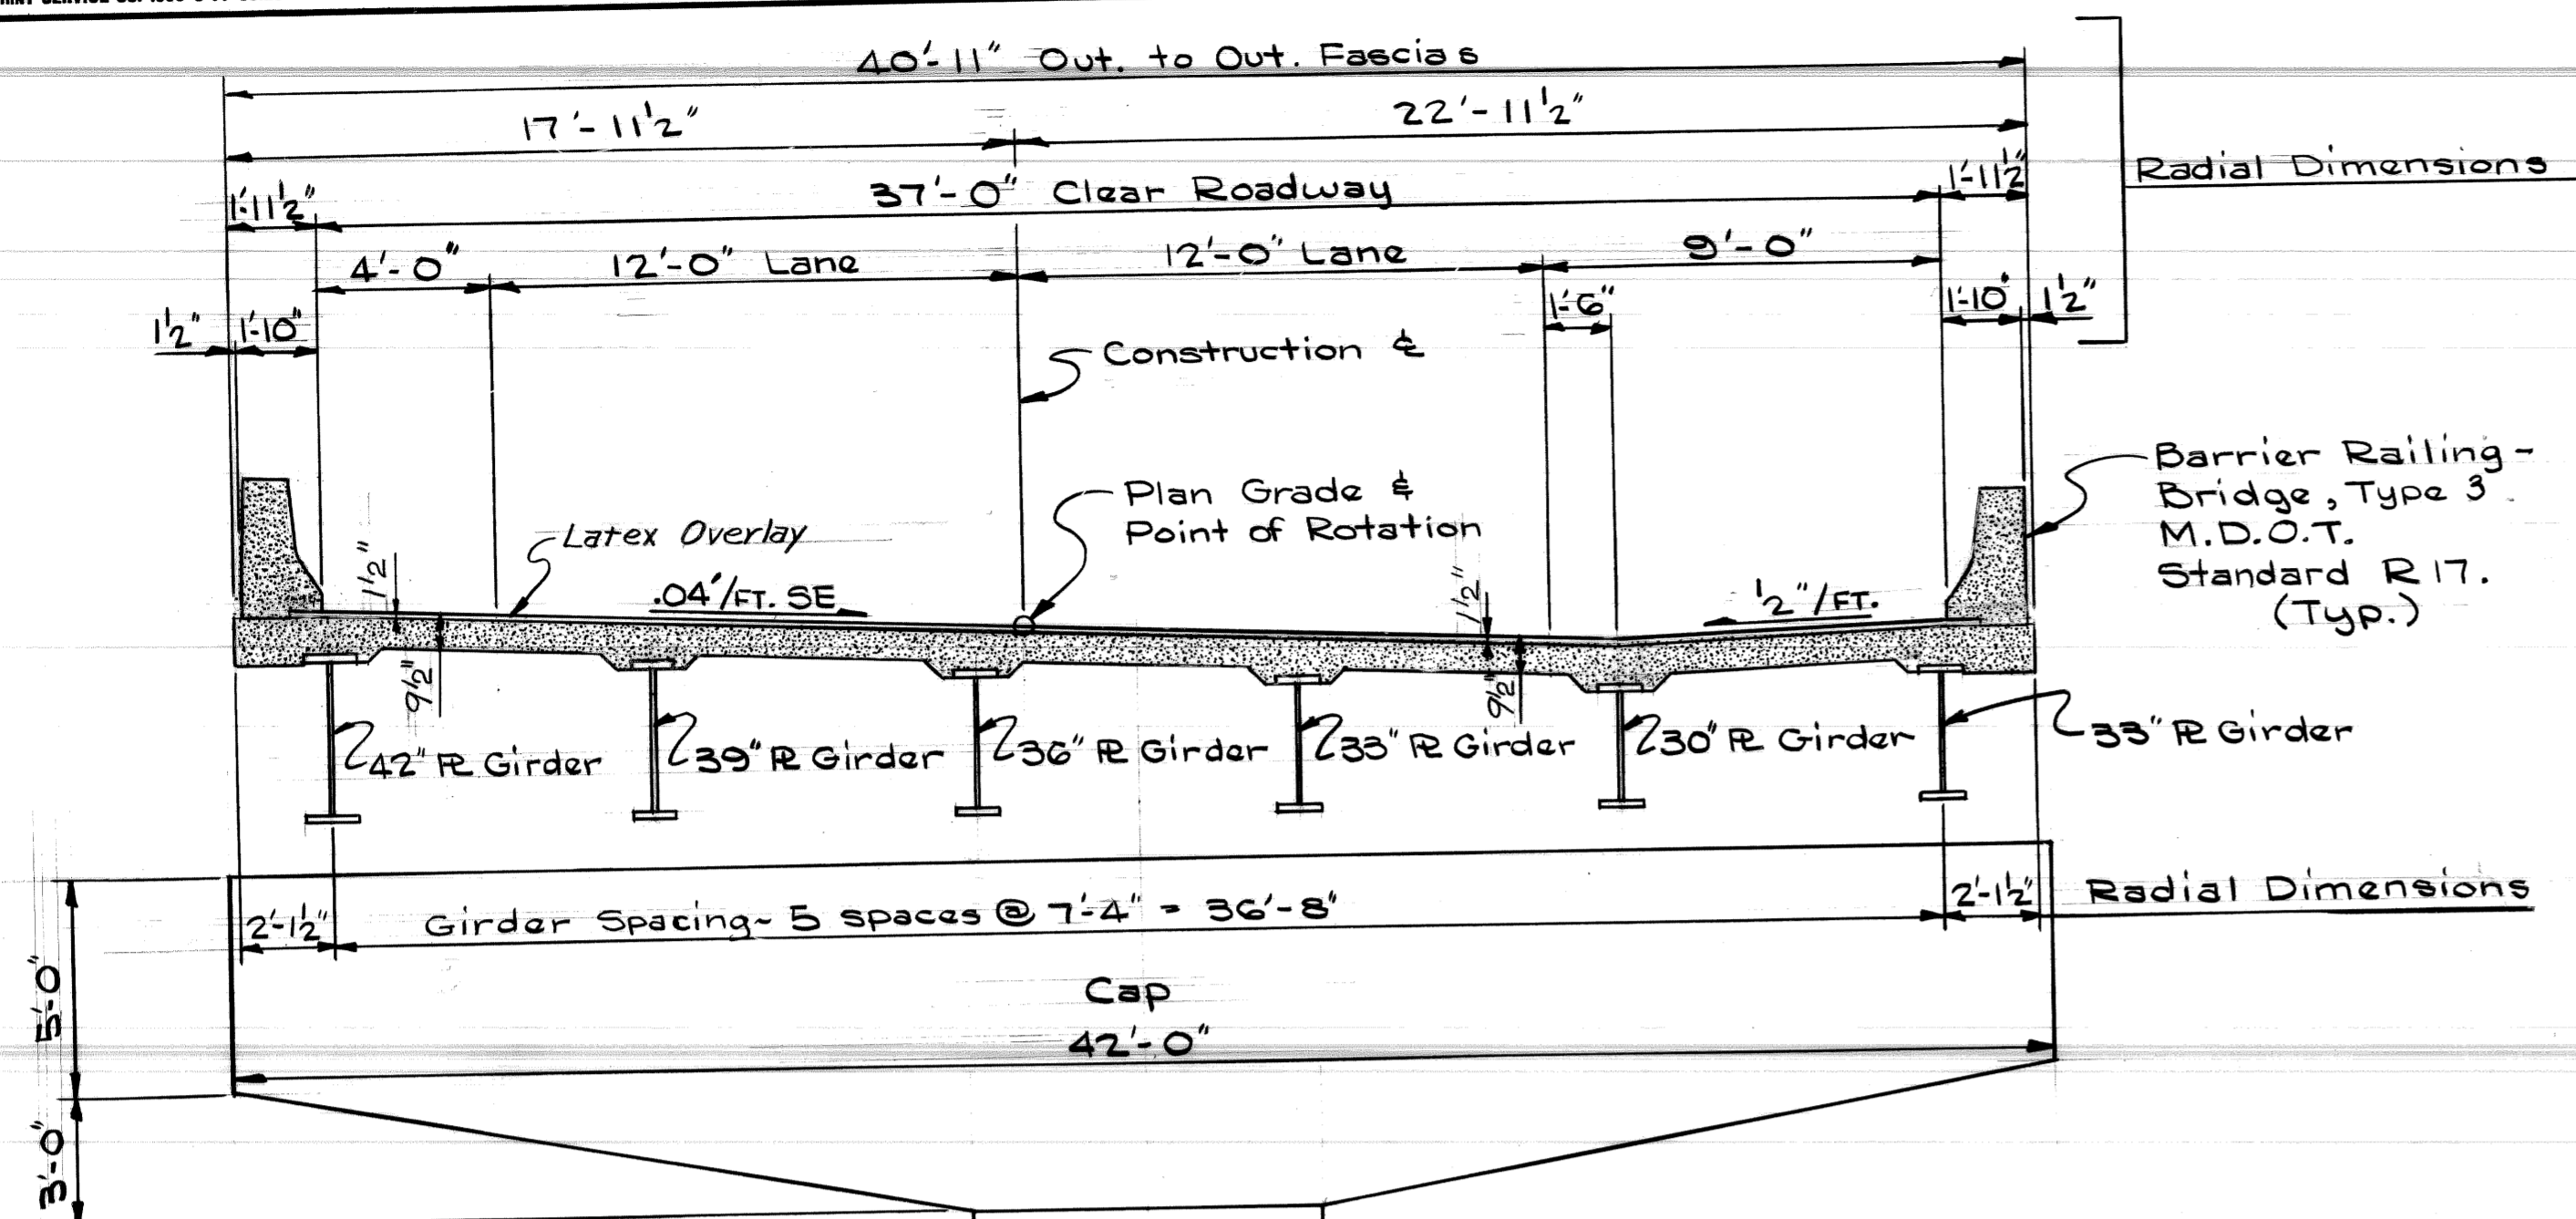


SECTION G-G
Applies Sta. 204+01.75 to 208+89.15

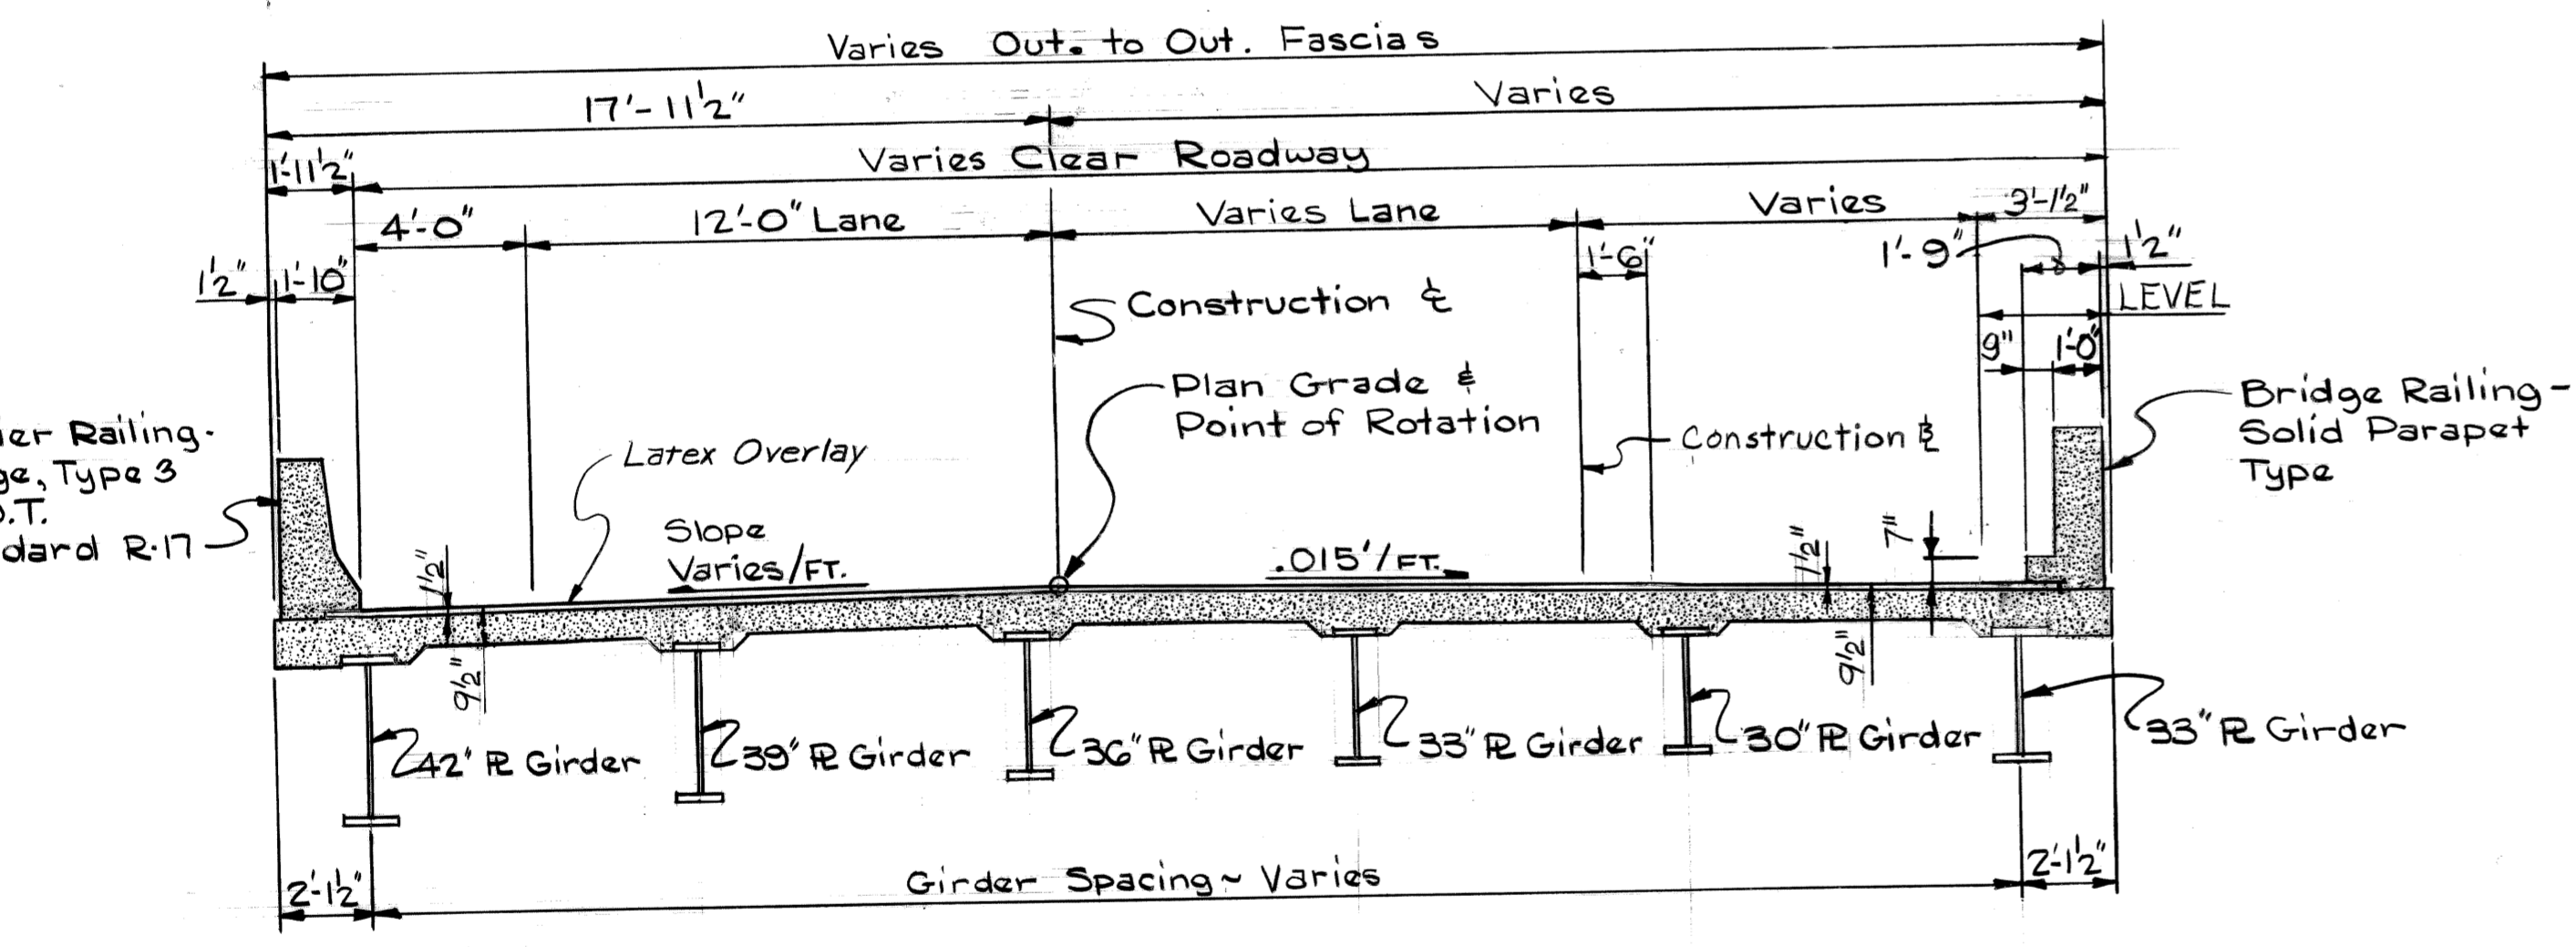

SECTION H-H
Applies Sta. 209+50.00

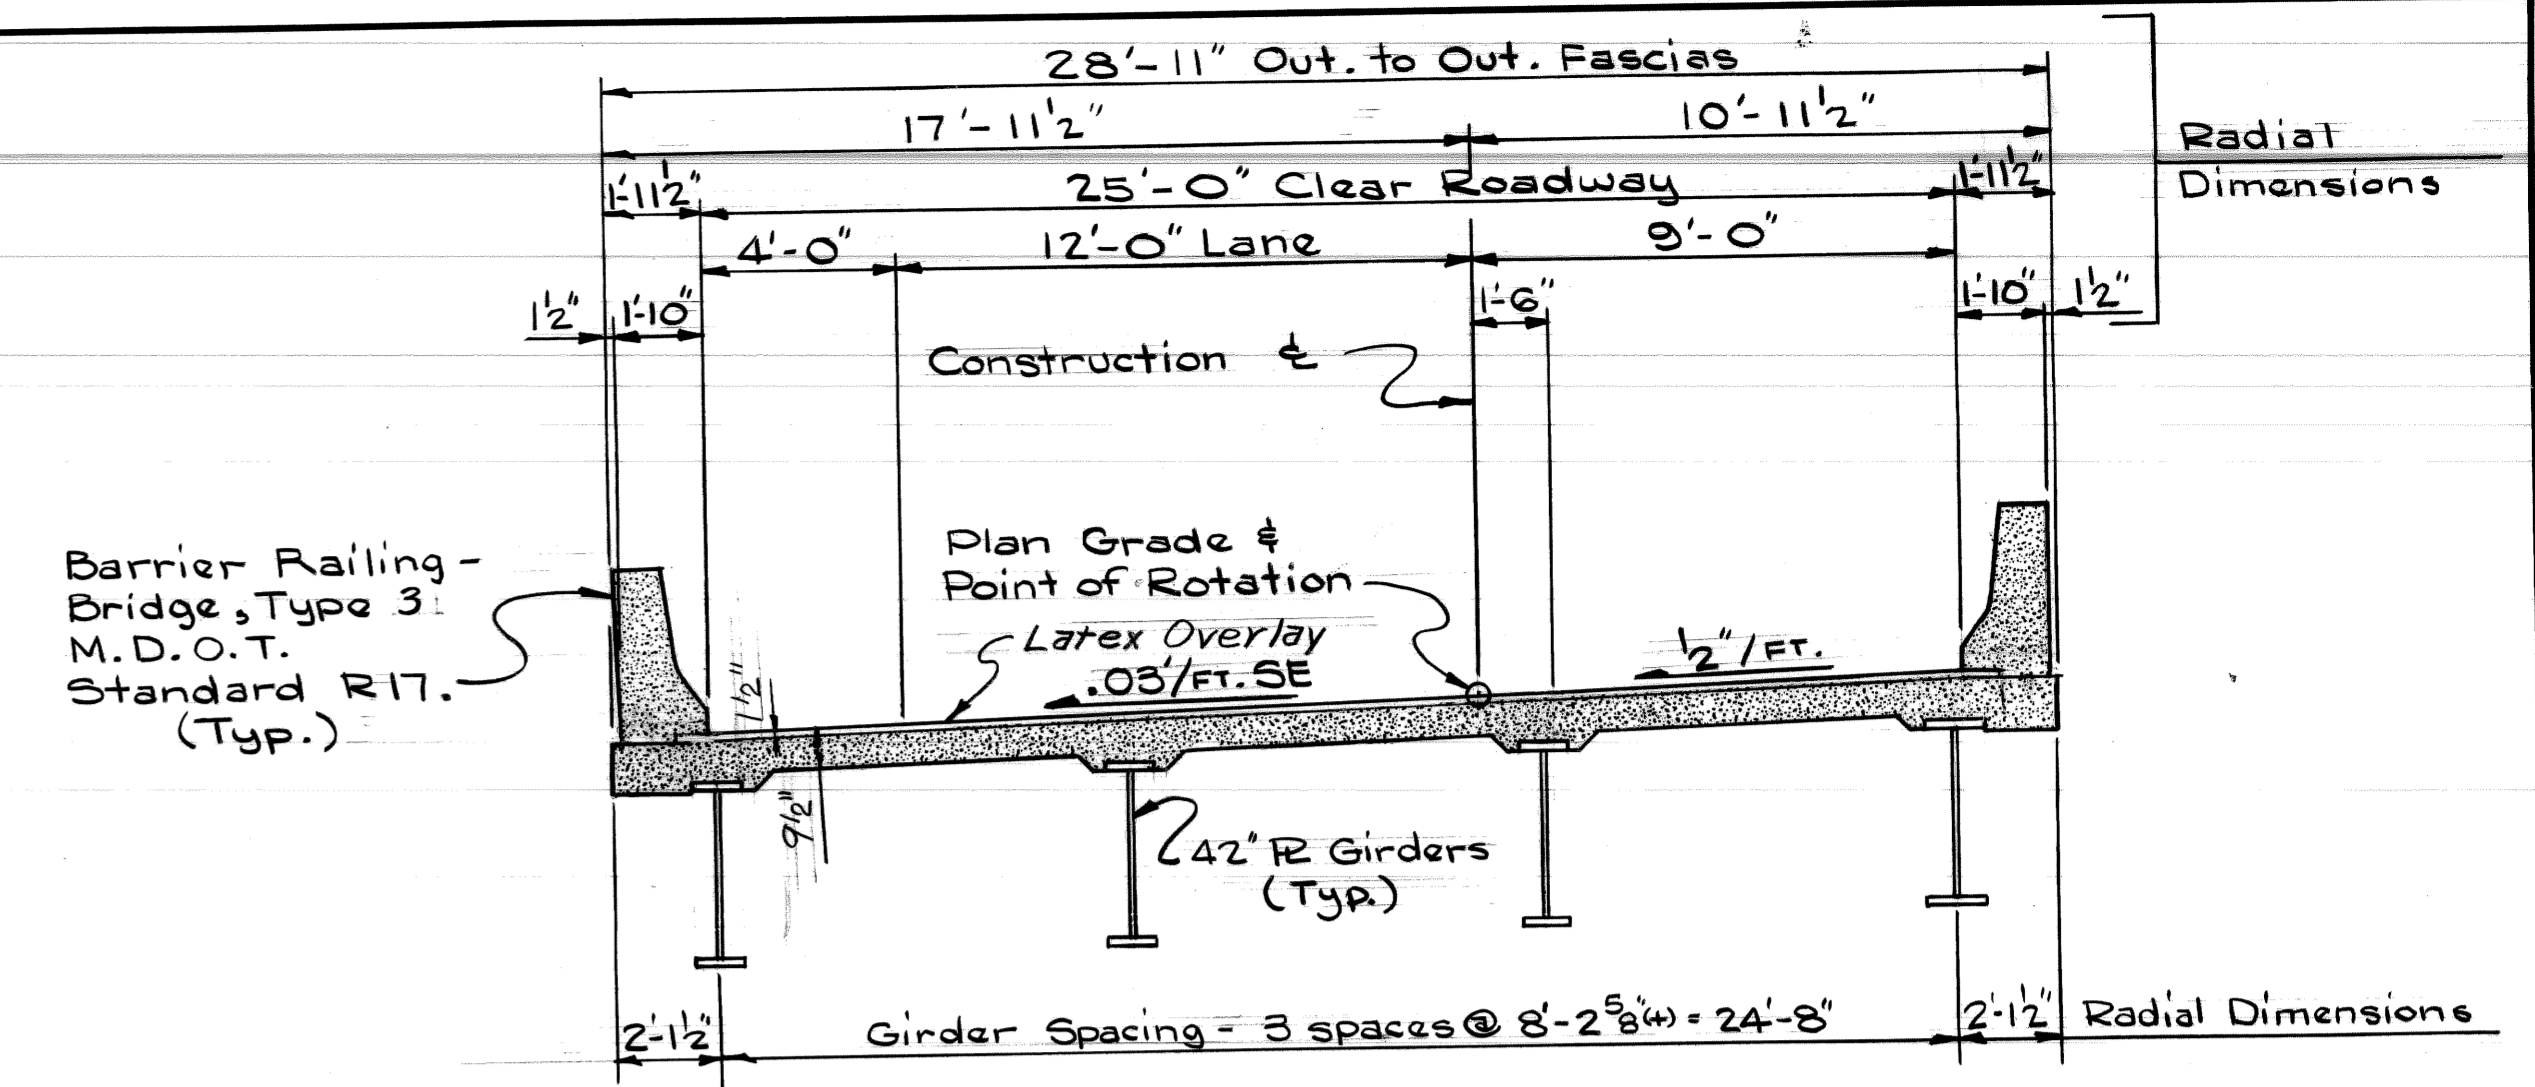

SECTION L-L
Applies Sta. 210+44.71 to 210+65.63

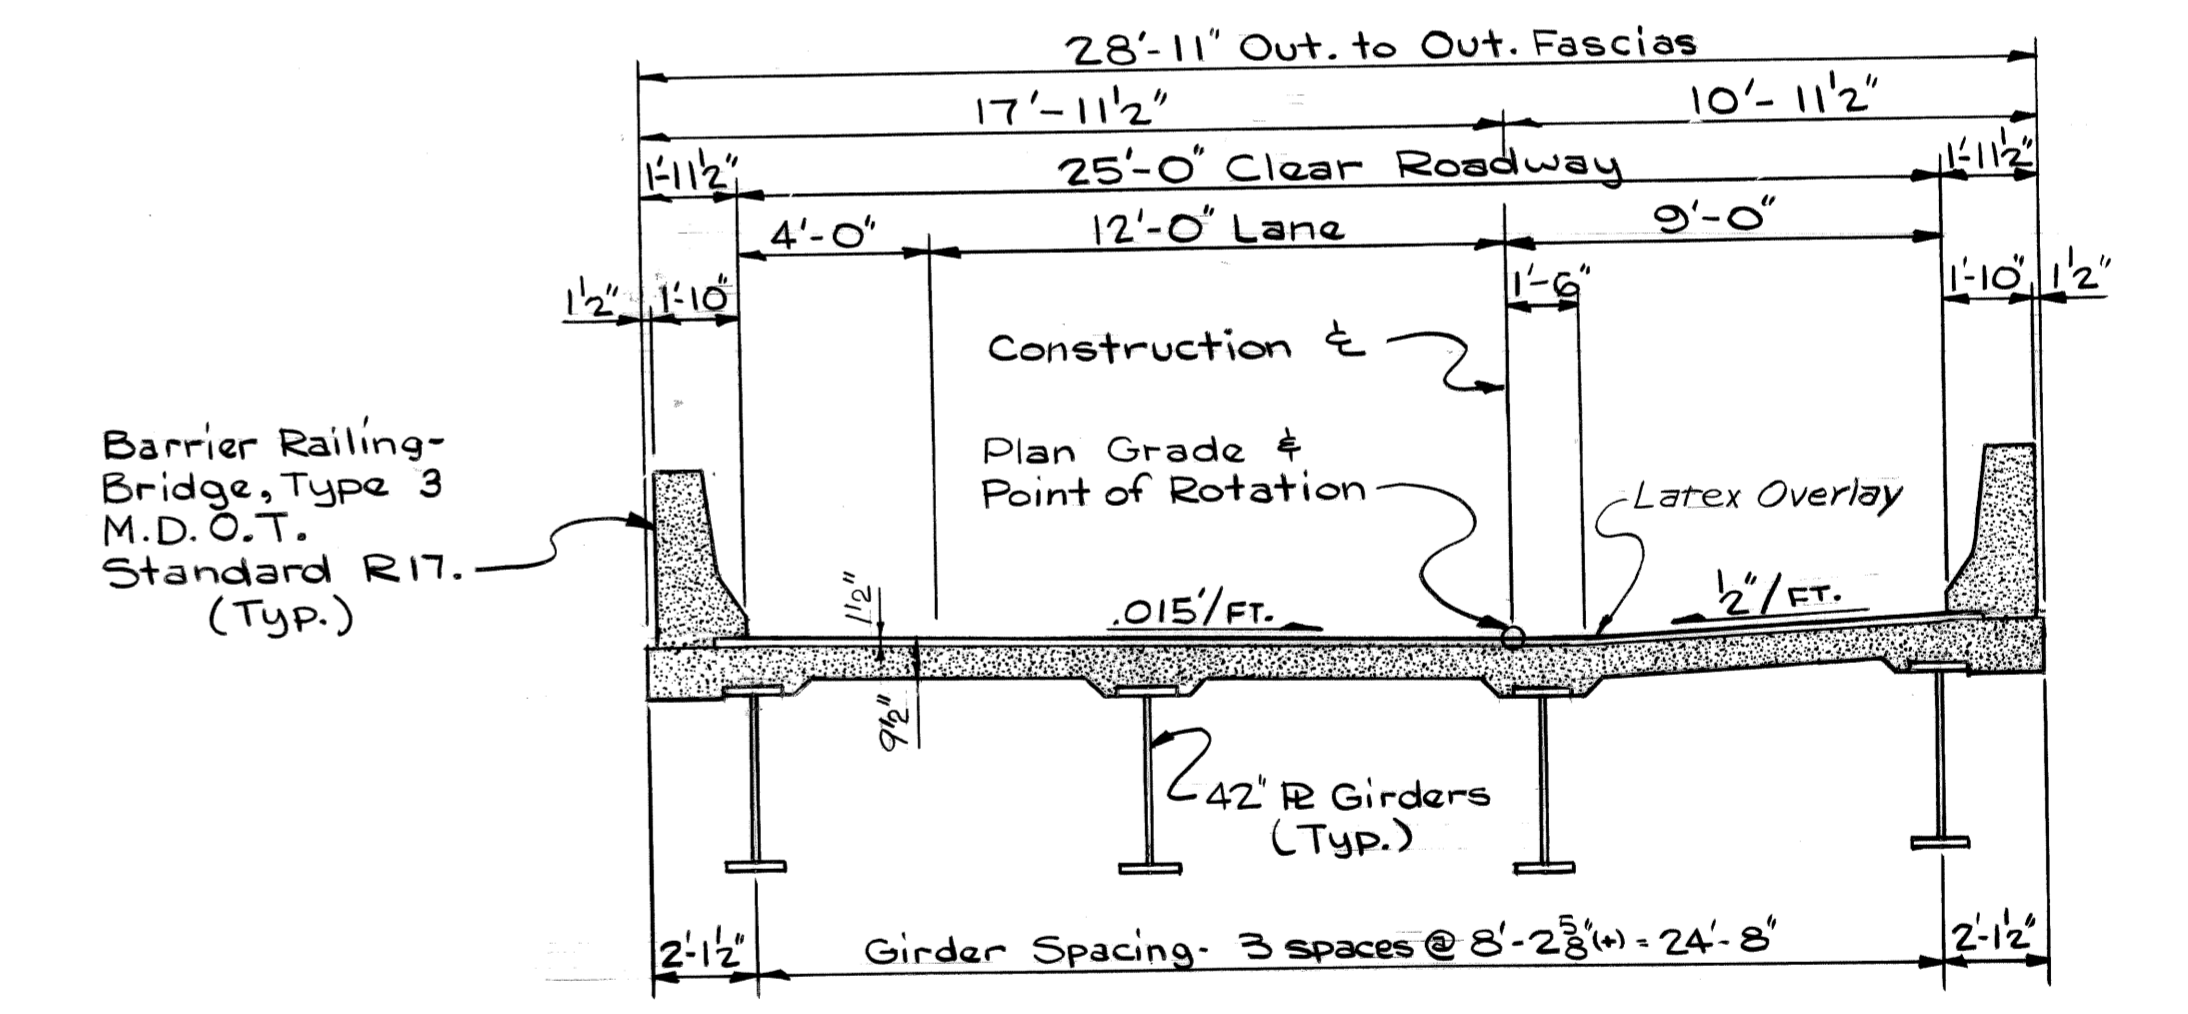

SECTION M-M
Applies Sta. 211+65.63 to 212+30.00

Work This Sheet With Sheets # S9 thru S12, S17 & S18

DATE: August, 1979

DSGN BY:	RGW, SJP
DR'N BY:	SJP
CK'D BY:	RGW
APP'D BY:	

REVISIONS	


CITY OF DETROIT, MICHIGAN



JOHN C. LODGE EXIT RAMP AND JEFFERSON AVENUE - RECONSTRUCTION AT THE JOE LOUIS ARENA.


GENERAL PLAN OF STRUCTURE
GENERAL DETAIL

SCALE: NONE
DRN. NO: S16

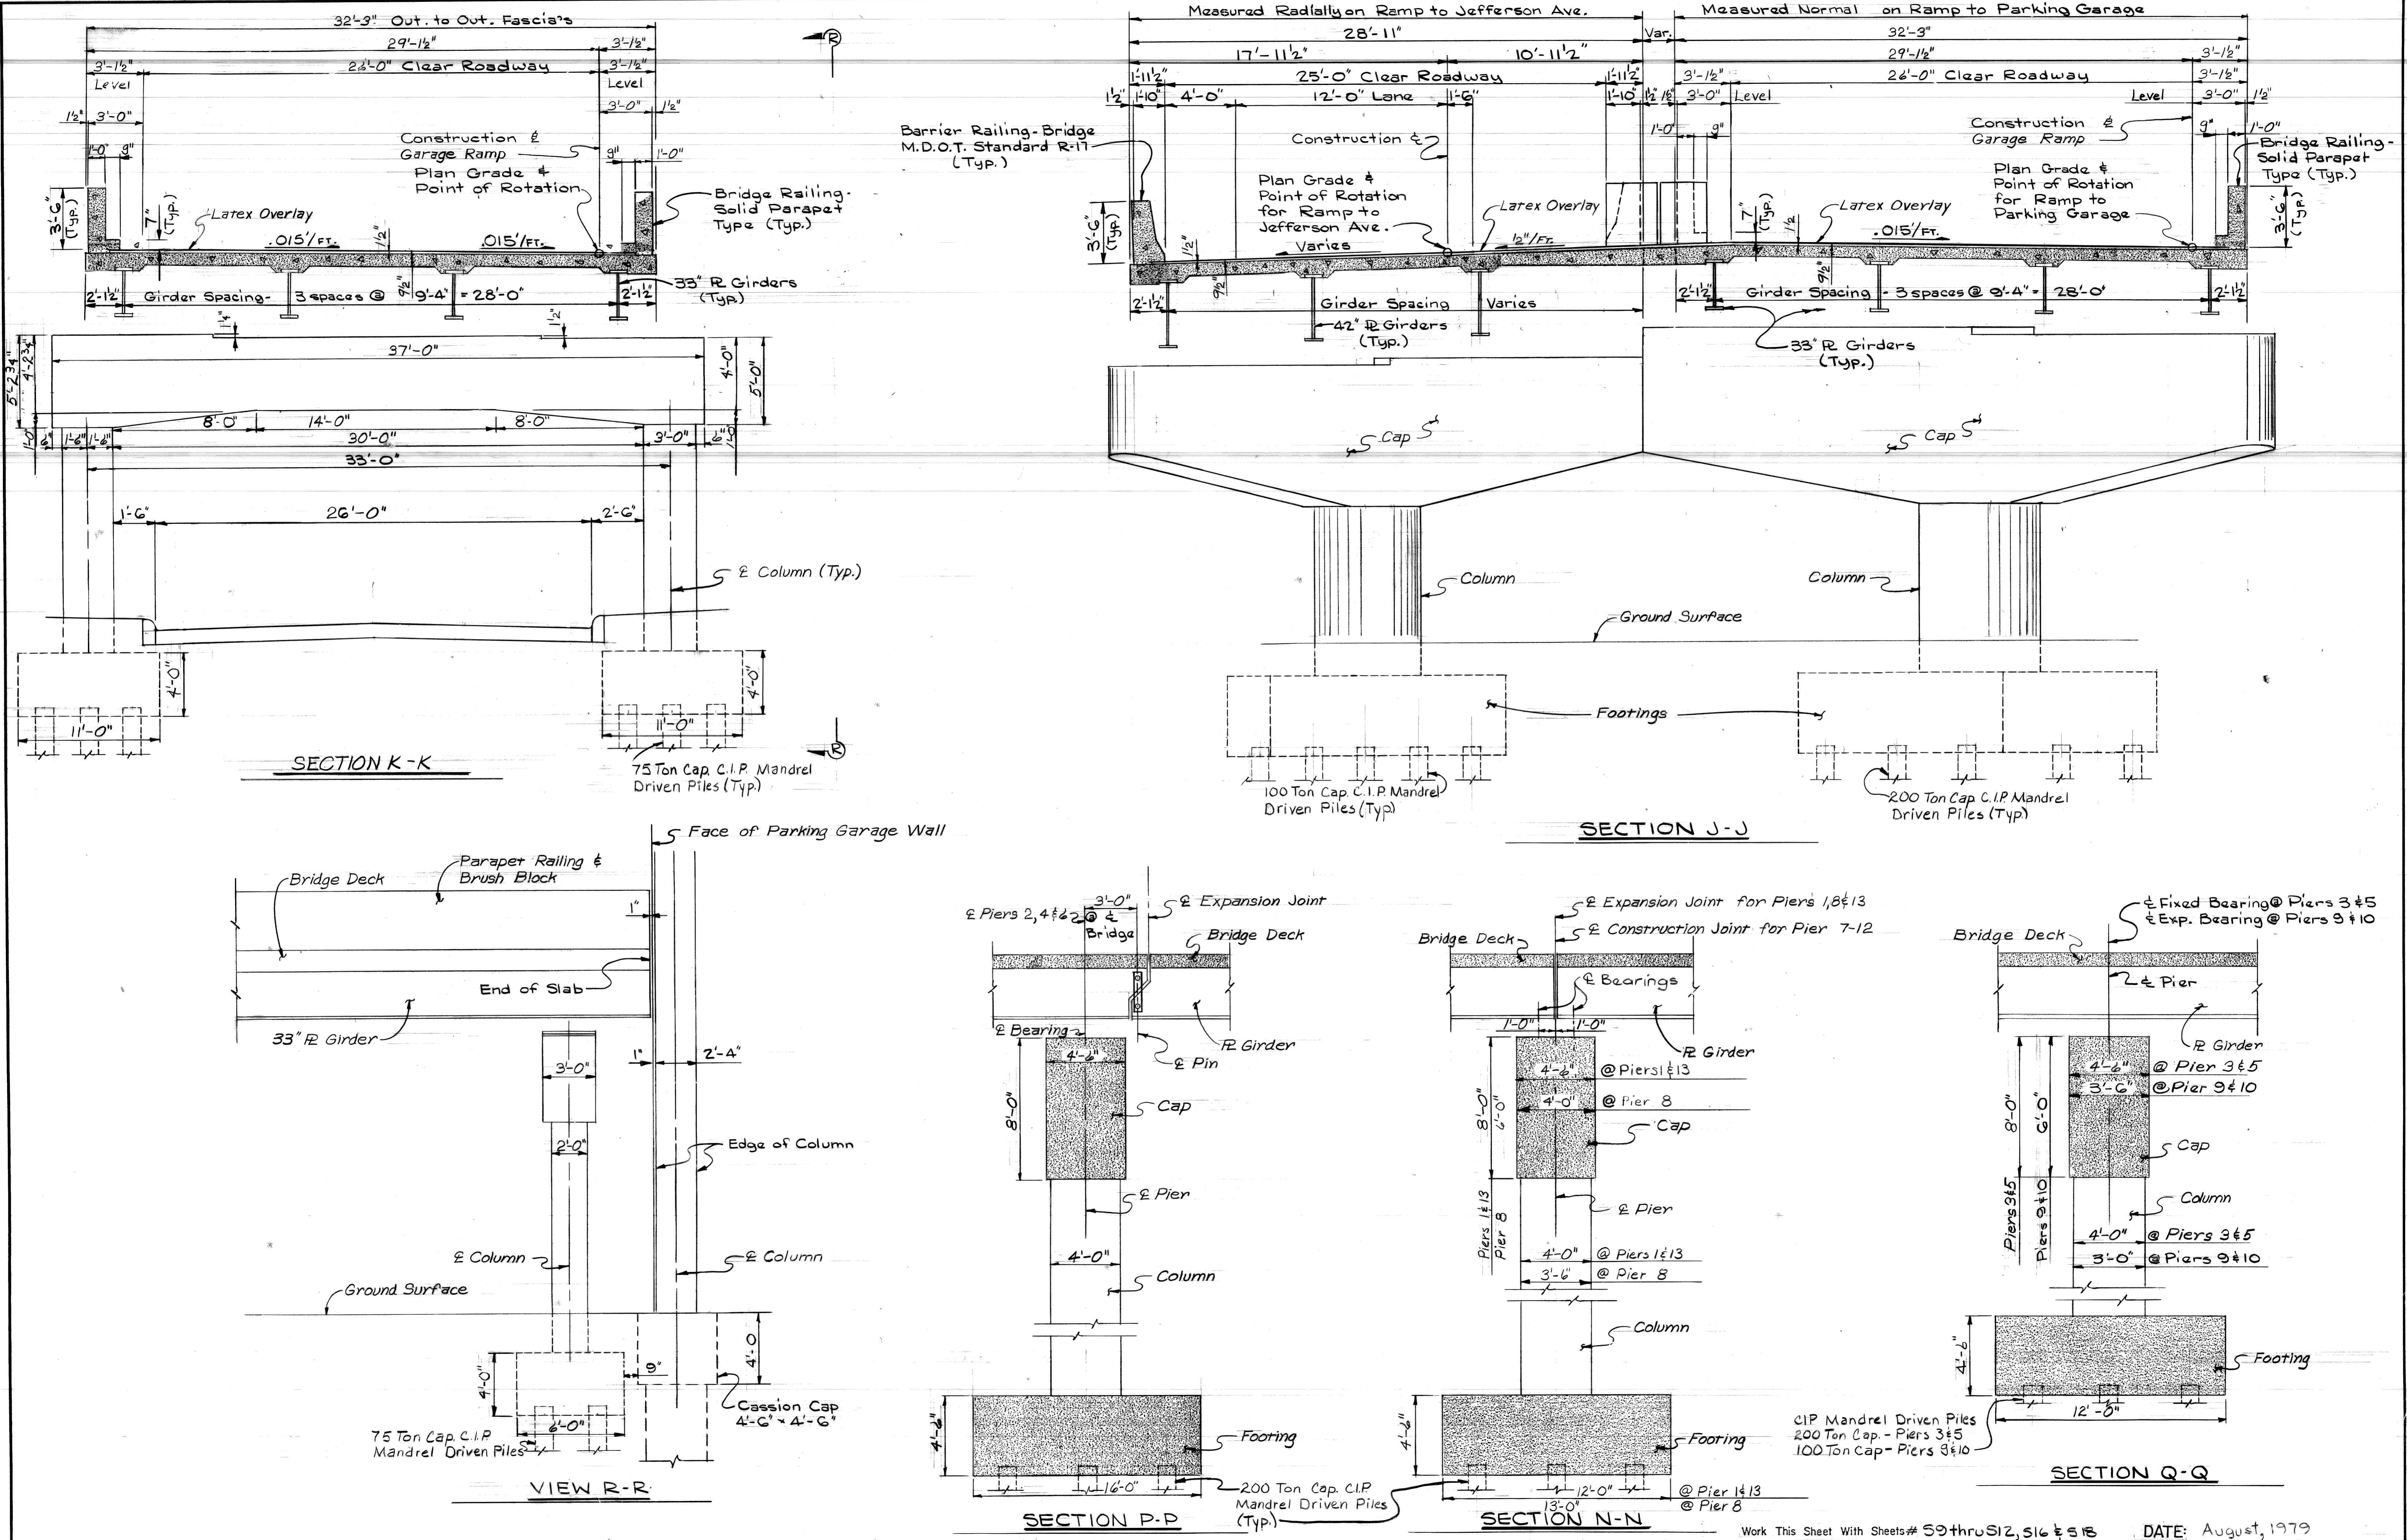


Work This Sheet With Sheets # 59 thru 512, 516 & 518 DATE: August, 1979


DSGN BY: EGW DRN BY: SJR/DE CK'D BY: RGW APP'D BY:	REVISIONS	CITY OF DETROIT, MICHIGAN	Snell Environmental Group LANSING INDIANAPOLIS AKRON	JOHN C. LODGE EXIT RAMP AND JEFFERSON AVENUE - RECONSTRUCTION AT THE JOE LOUIS ARENA.	GENERAL PLAN OF STRUCTURE GENERAL DETAIL	SCALE: NONE DRN. NO: 517
--	-----------	----------------------------------	--	--	--	------------------------------------

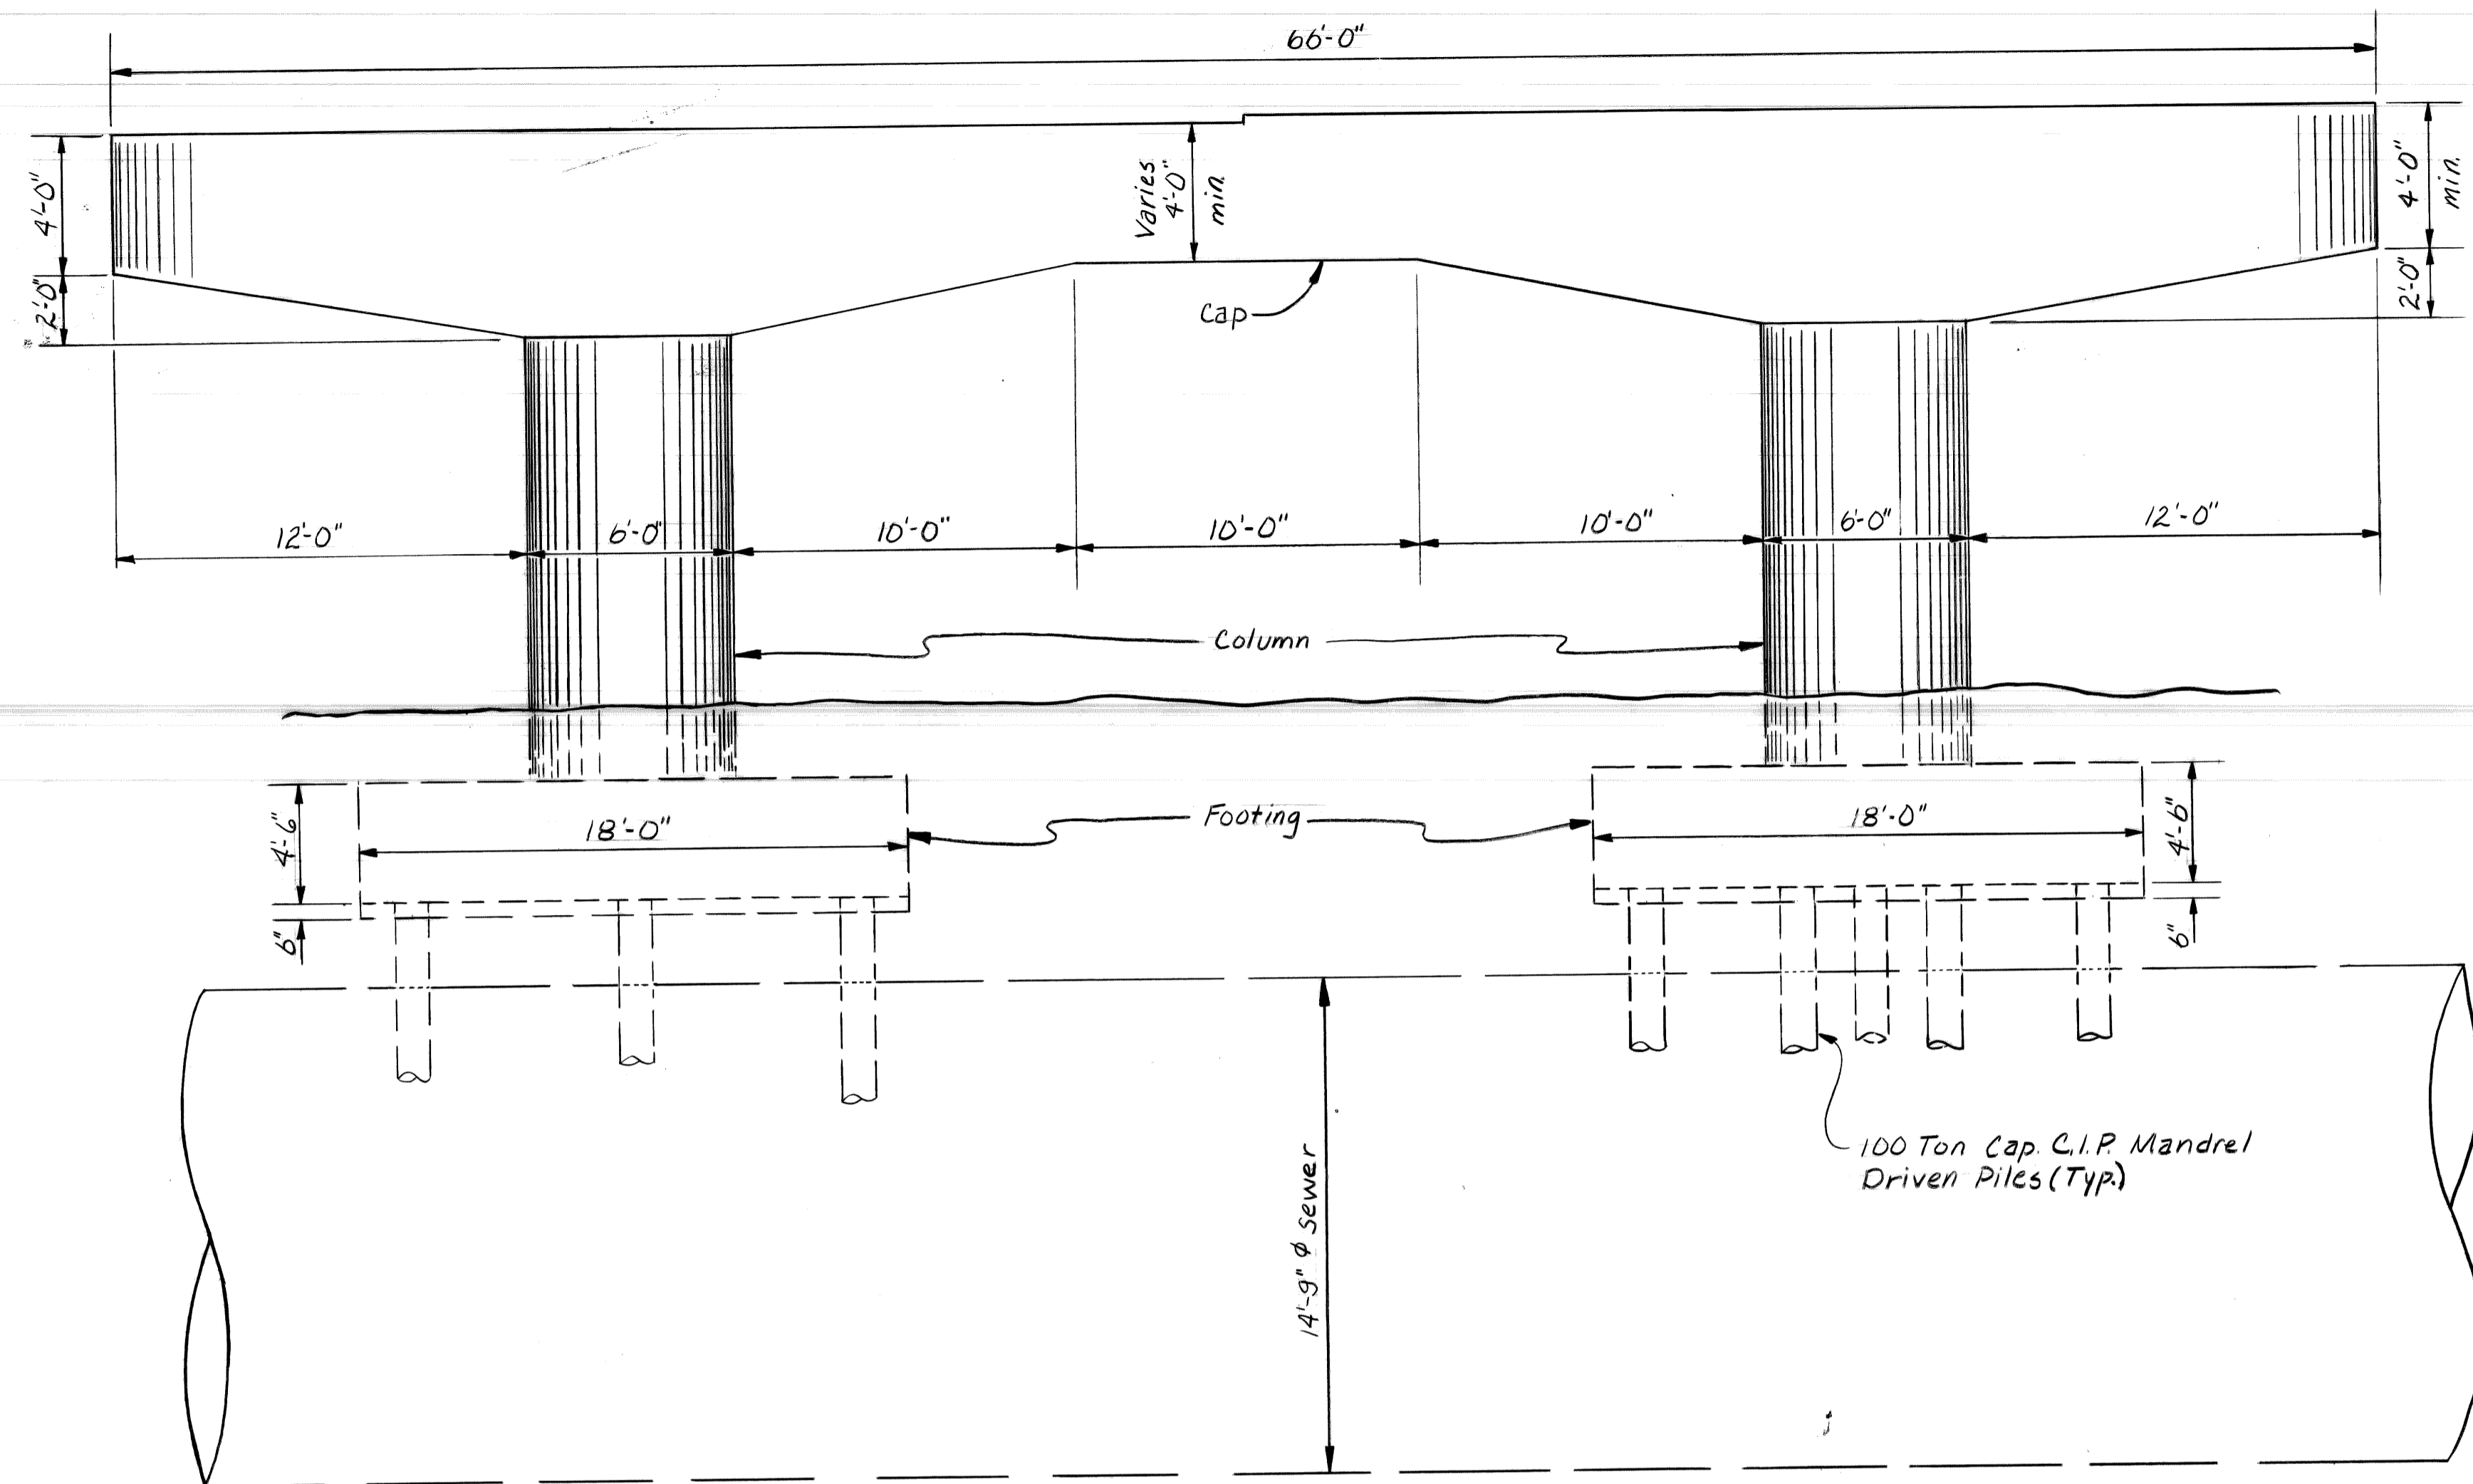

ELEVATION PIER 7-12

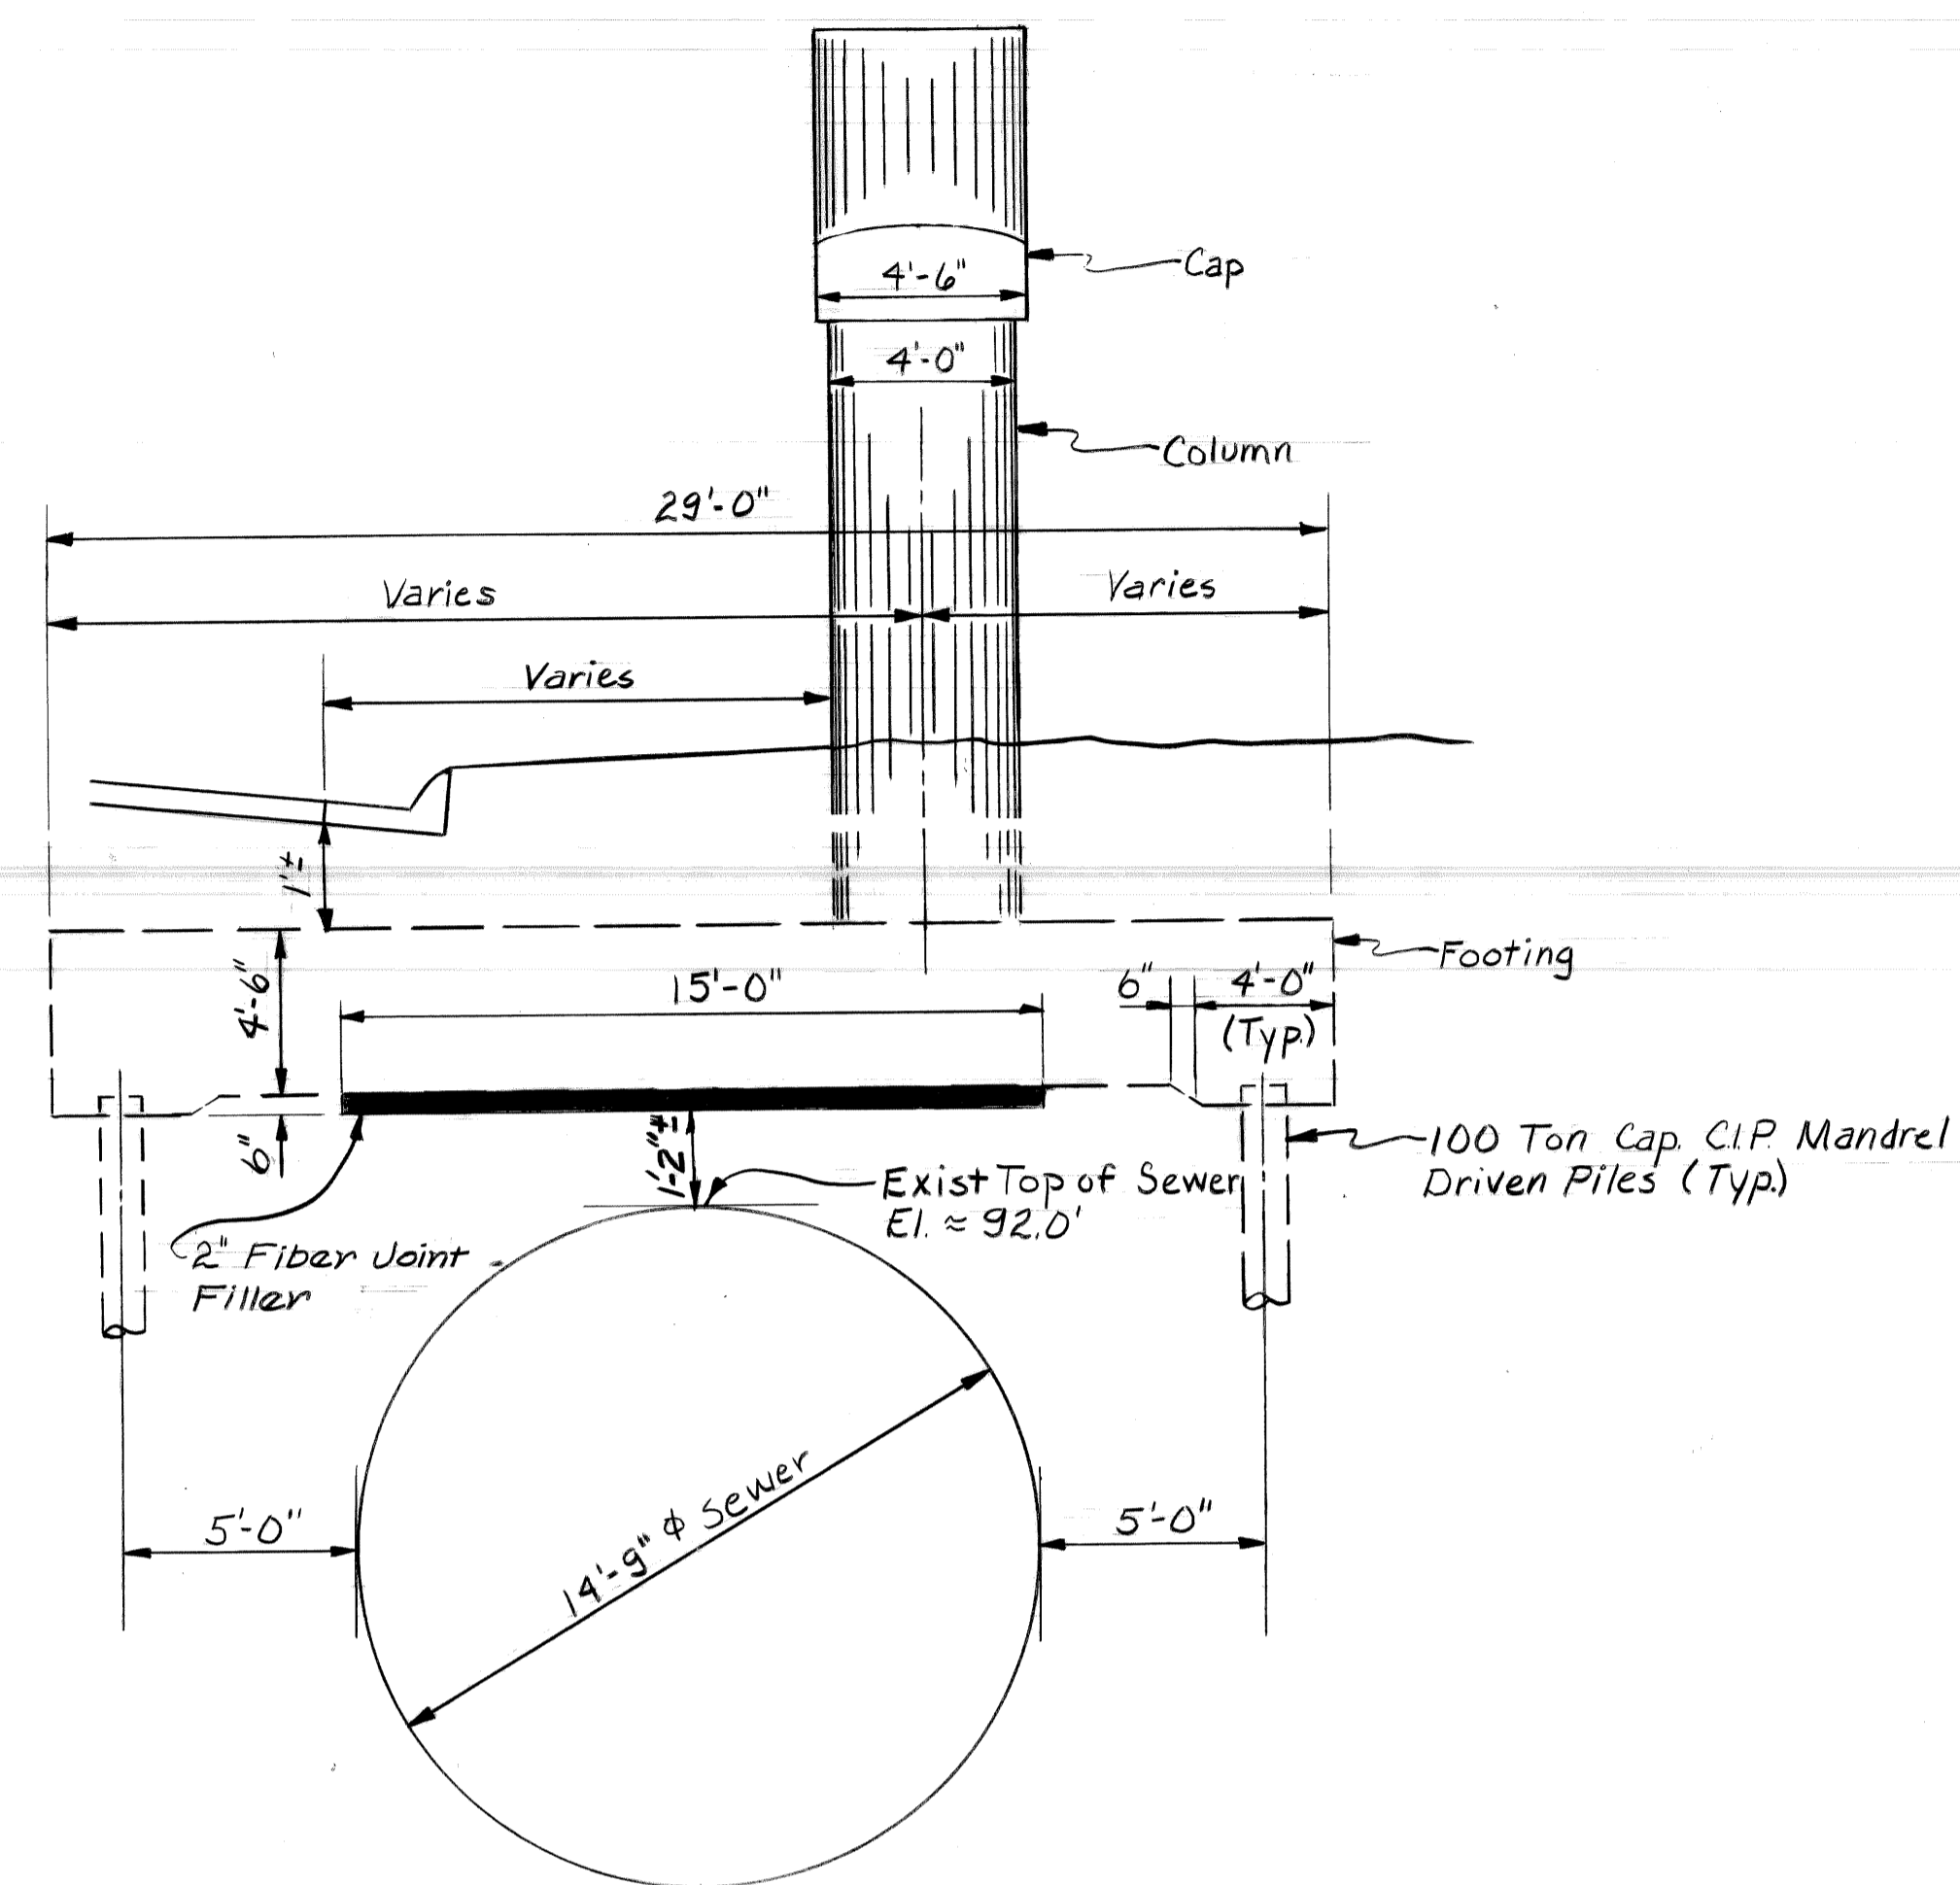

END VIEW

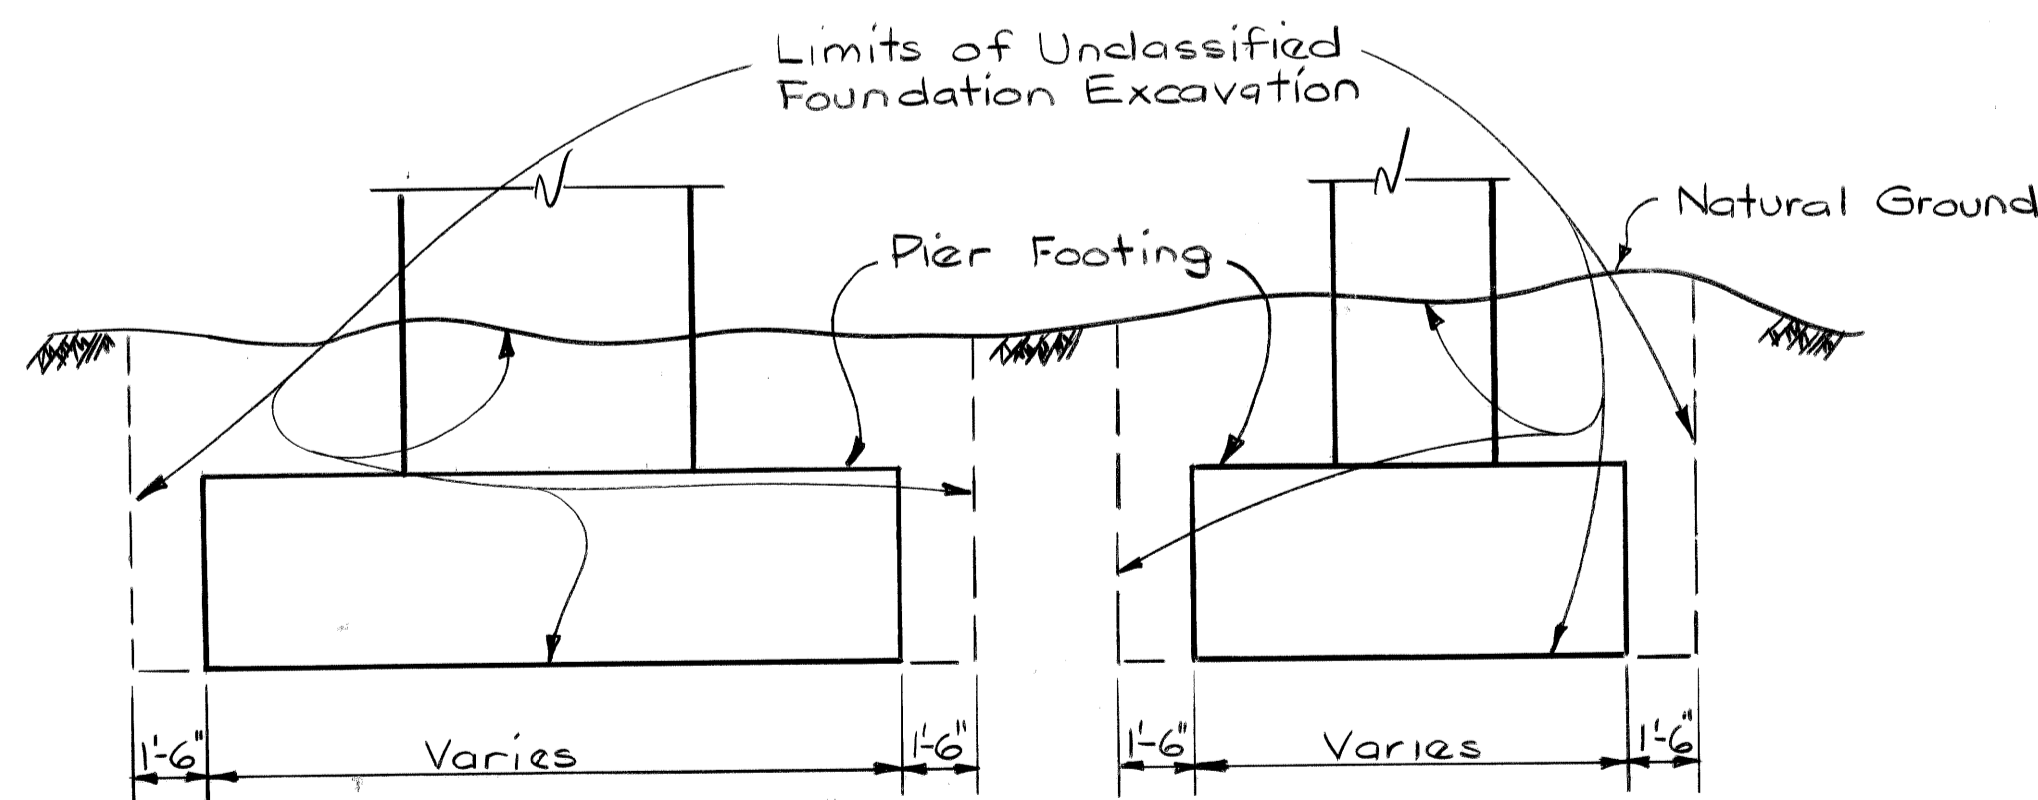

ELEVATION

END VIEW


LIMITS OF UNCLASSIFIED FOUNDATION EXCAVATION FOR ALL PIER FOOTINGS

Note:
Styroform Board may be substituted for Fiber Joint Filler.

DSGN BY:	RGW
DR'N BY:	RMO
CK'D BY:	RGW
APP'D BY:	

REVISIONS	

CITY OF DETROIT, MICHIGAN

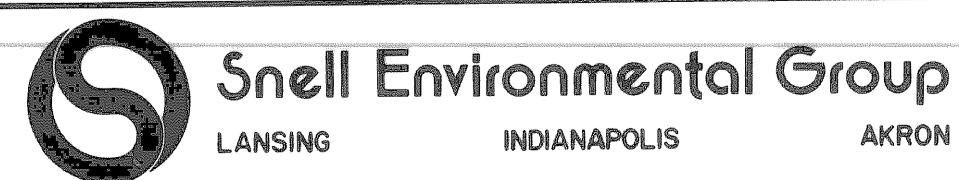








Work This Sheet With Sheets # 511 Thru 517
JOHN C. LODGE EXIT RAMP AND JEFFERSON AVENUE - RECONSTRUCTION AT THE JOE LOUIS ARENA.

GENERAL PLAN OF STRUCTURE
GENERAL DETAILS


DATE: August, 1979

SCALE: NONE


DRN. NO: S18

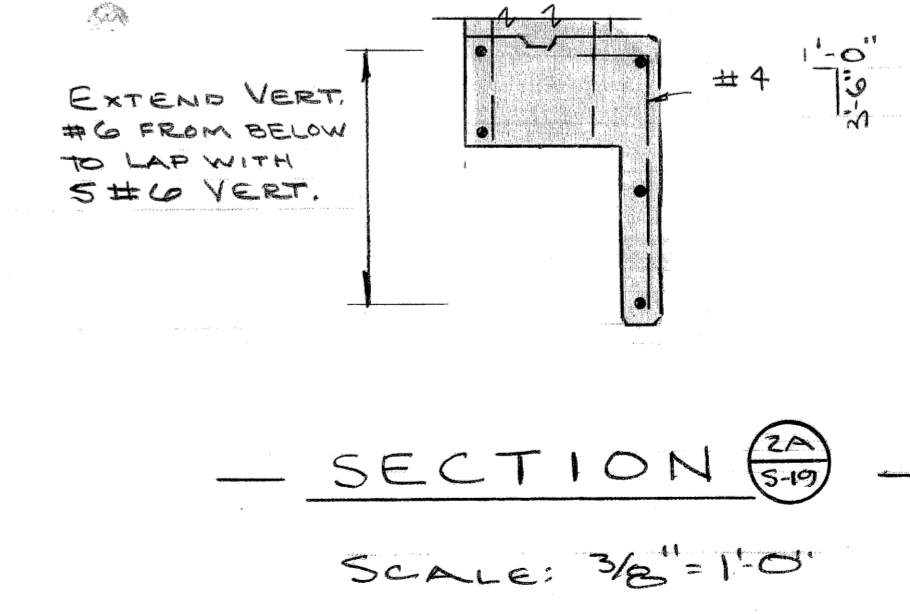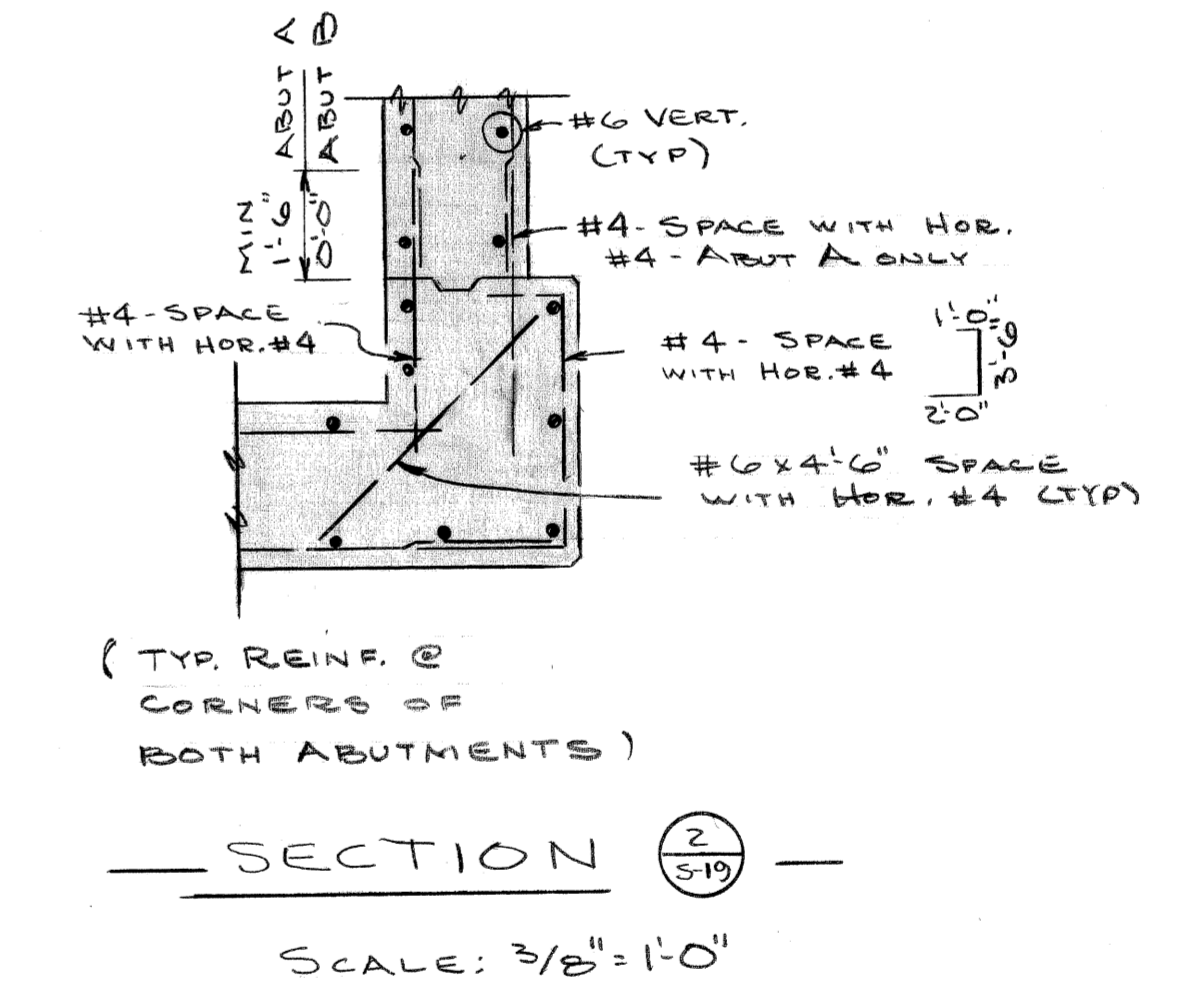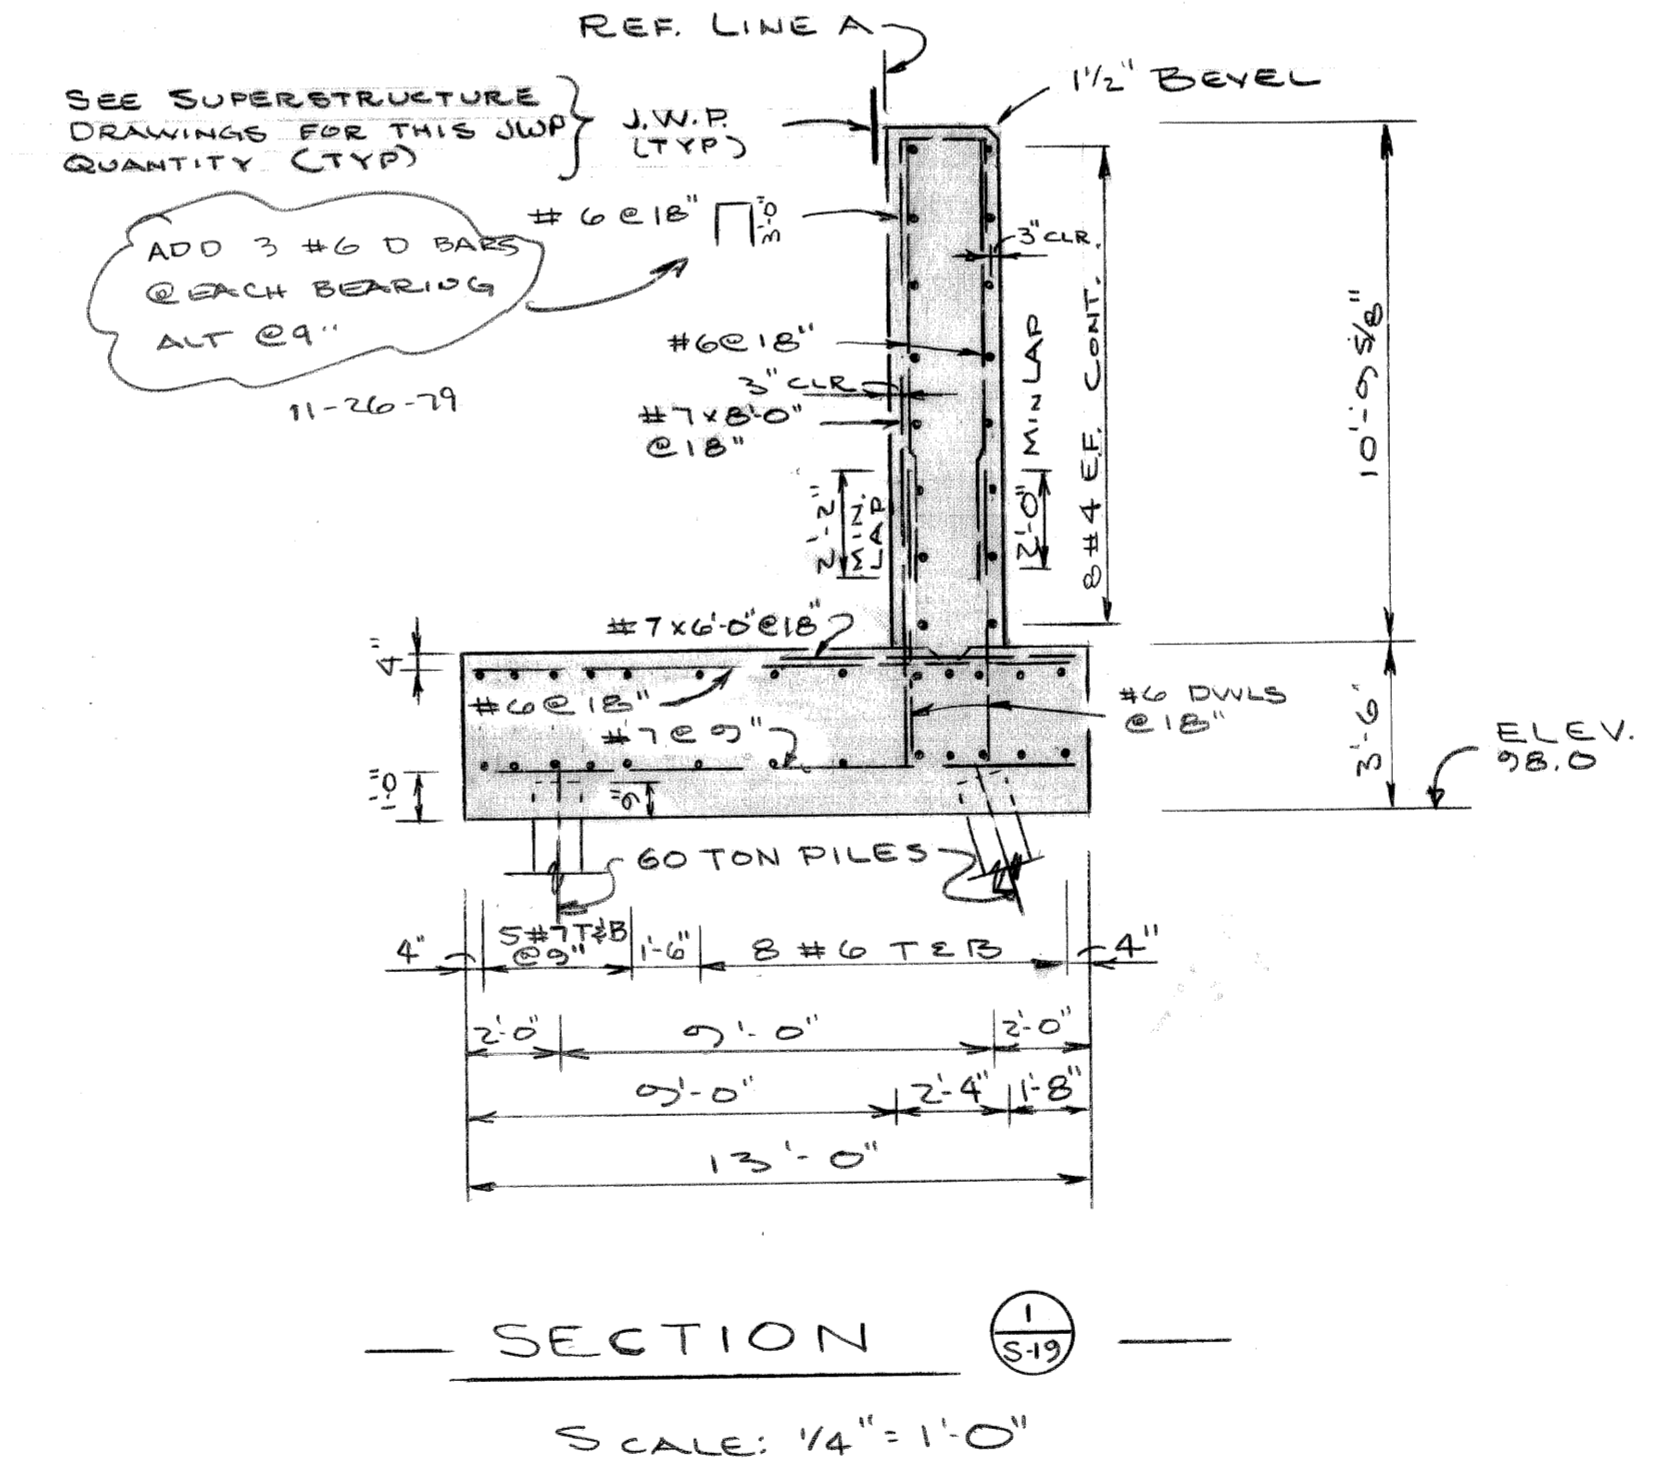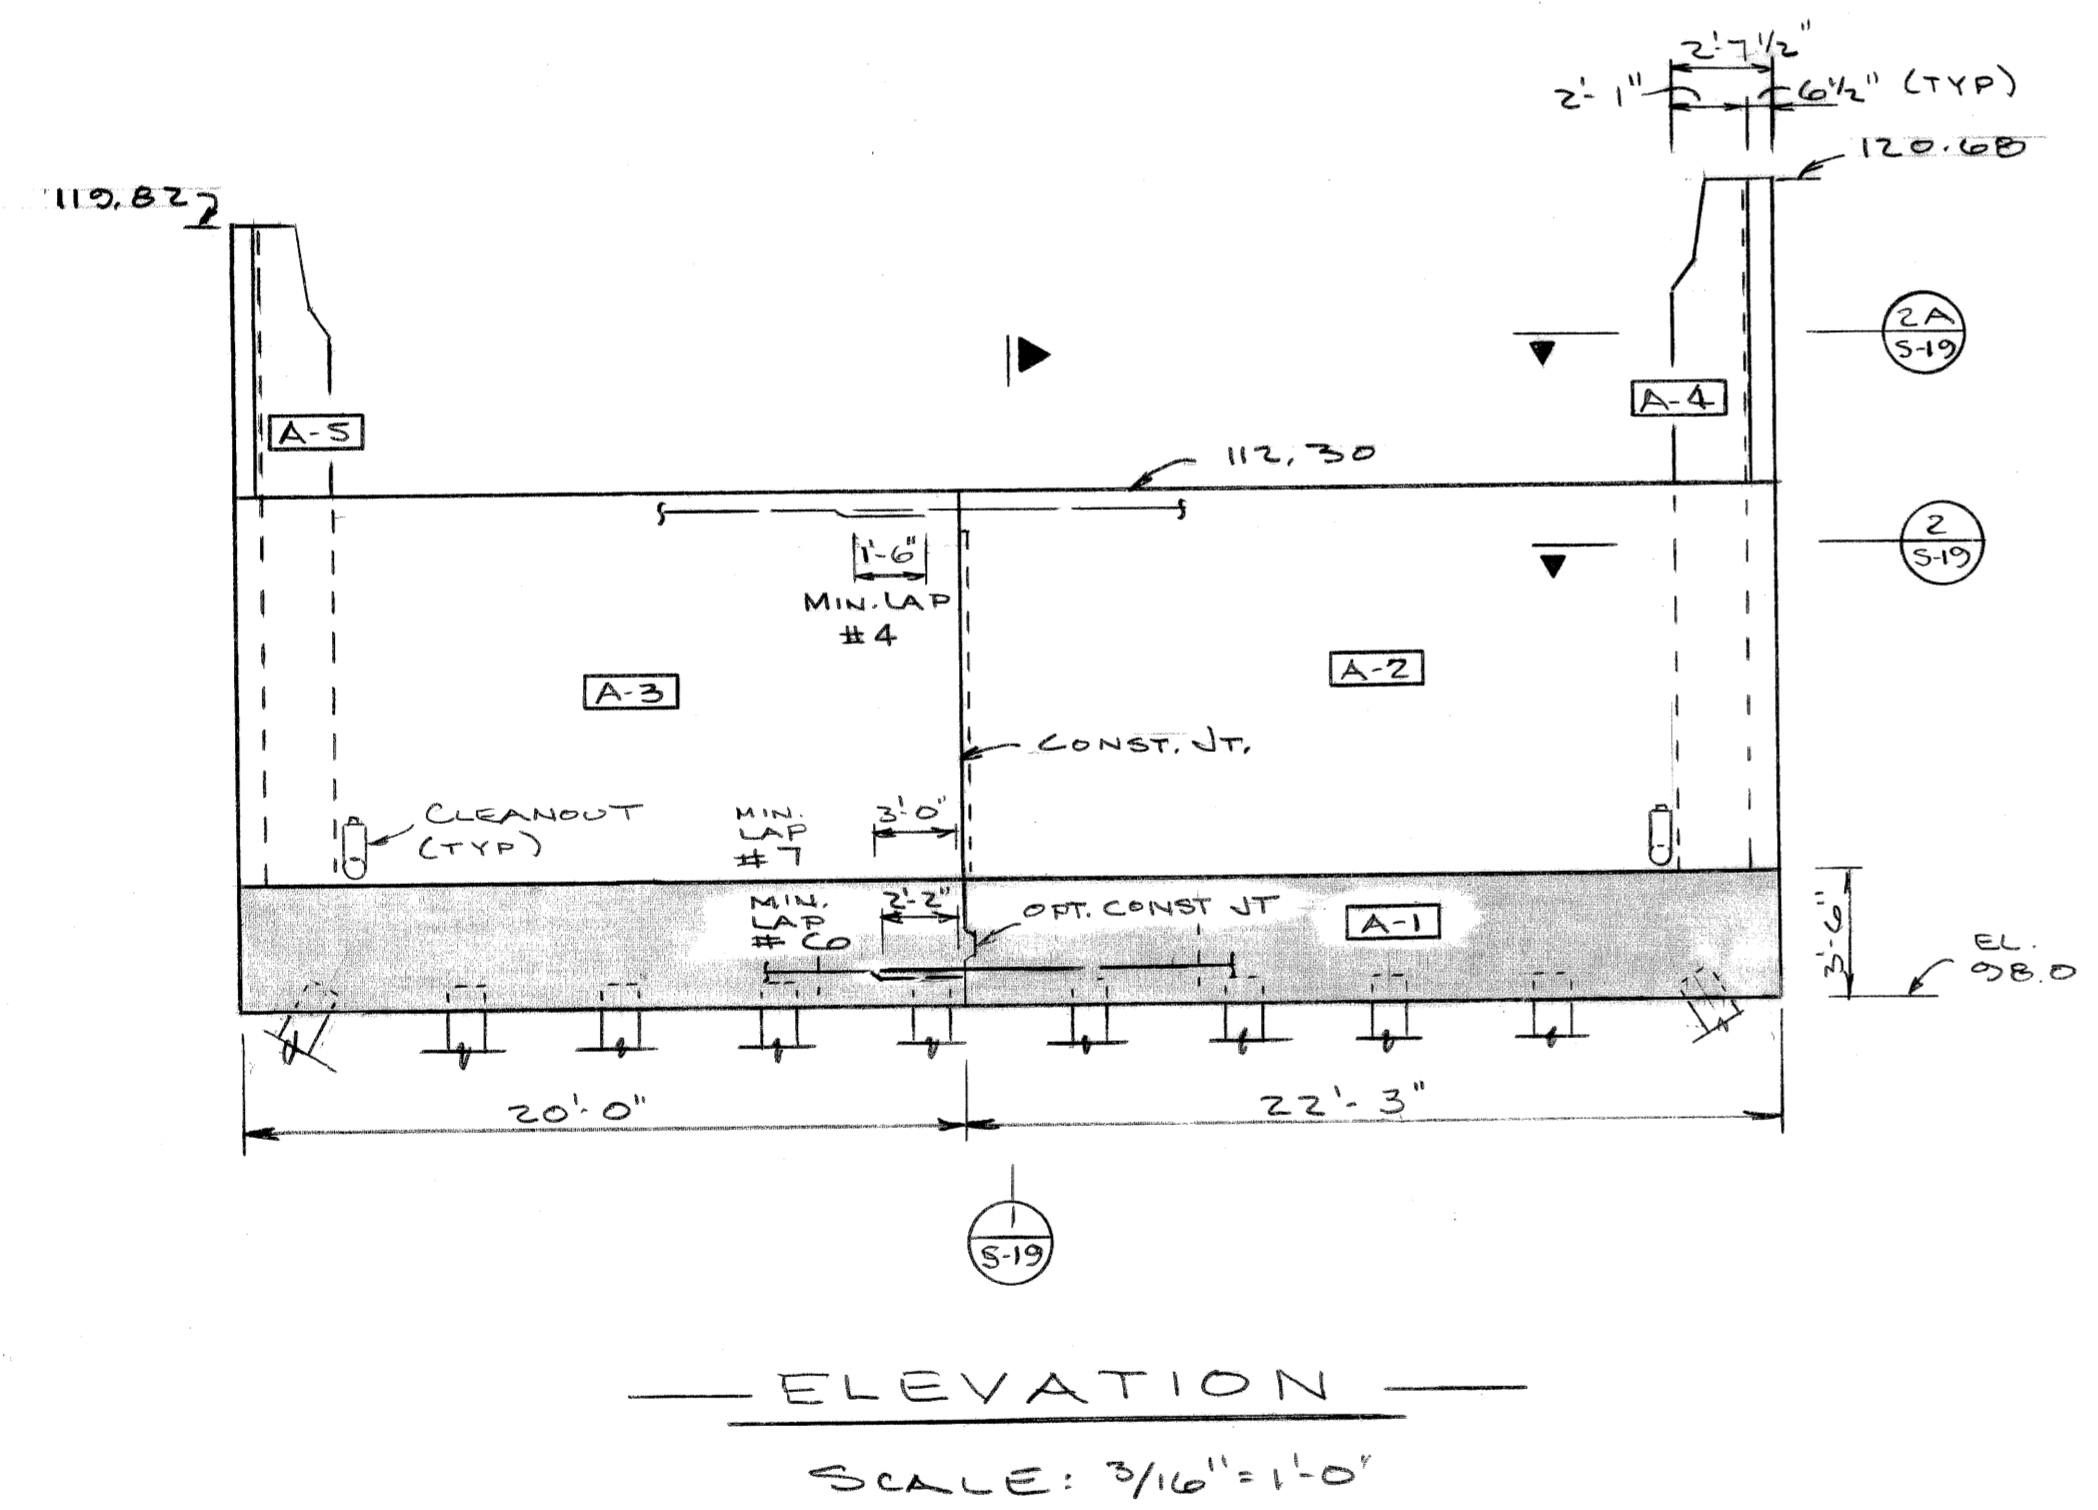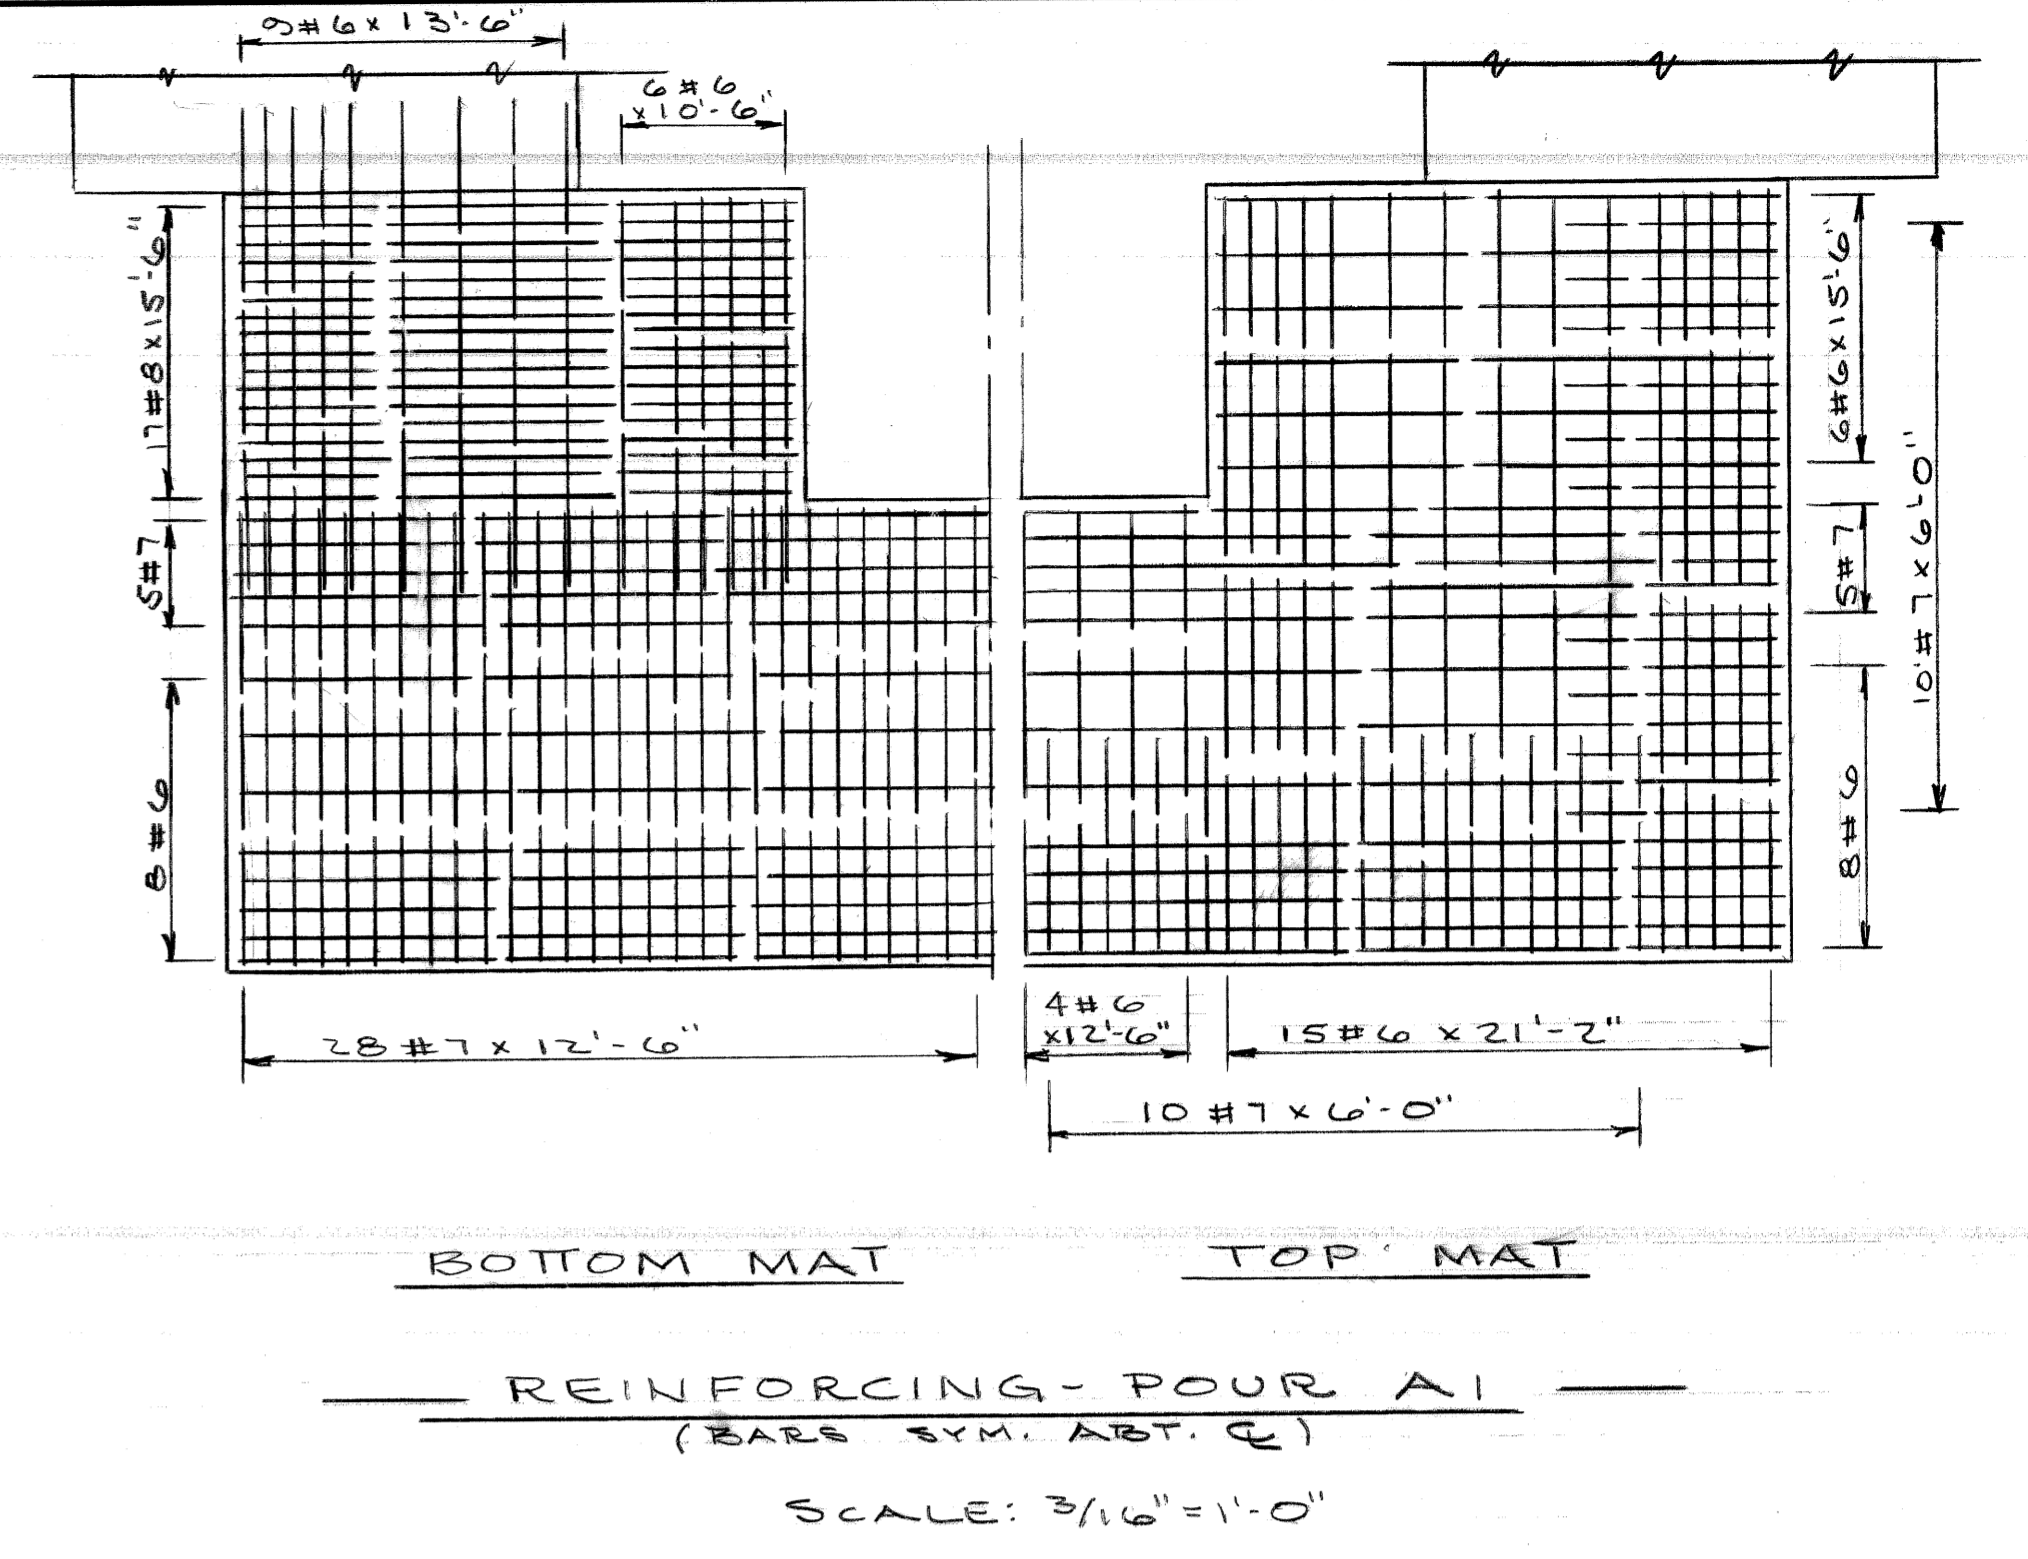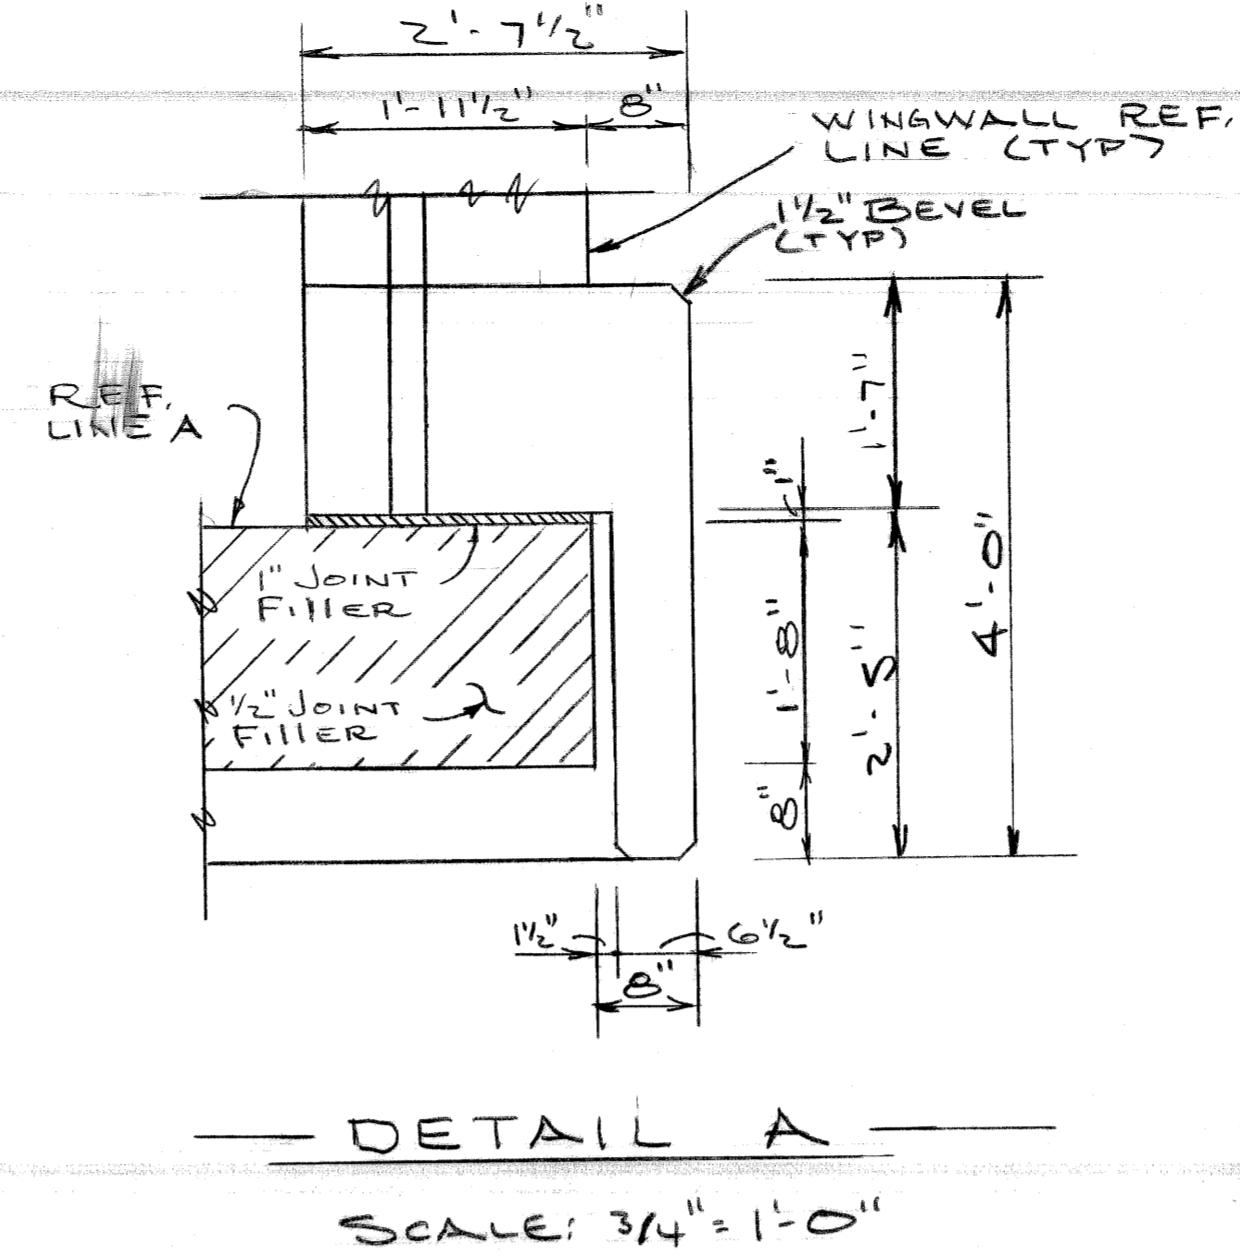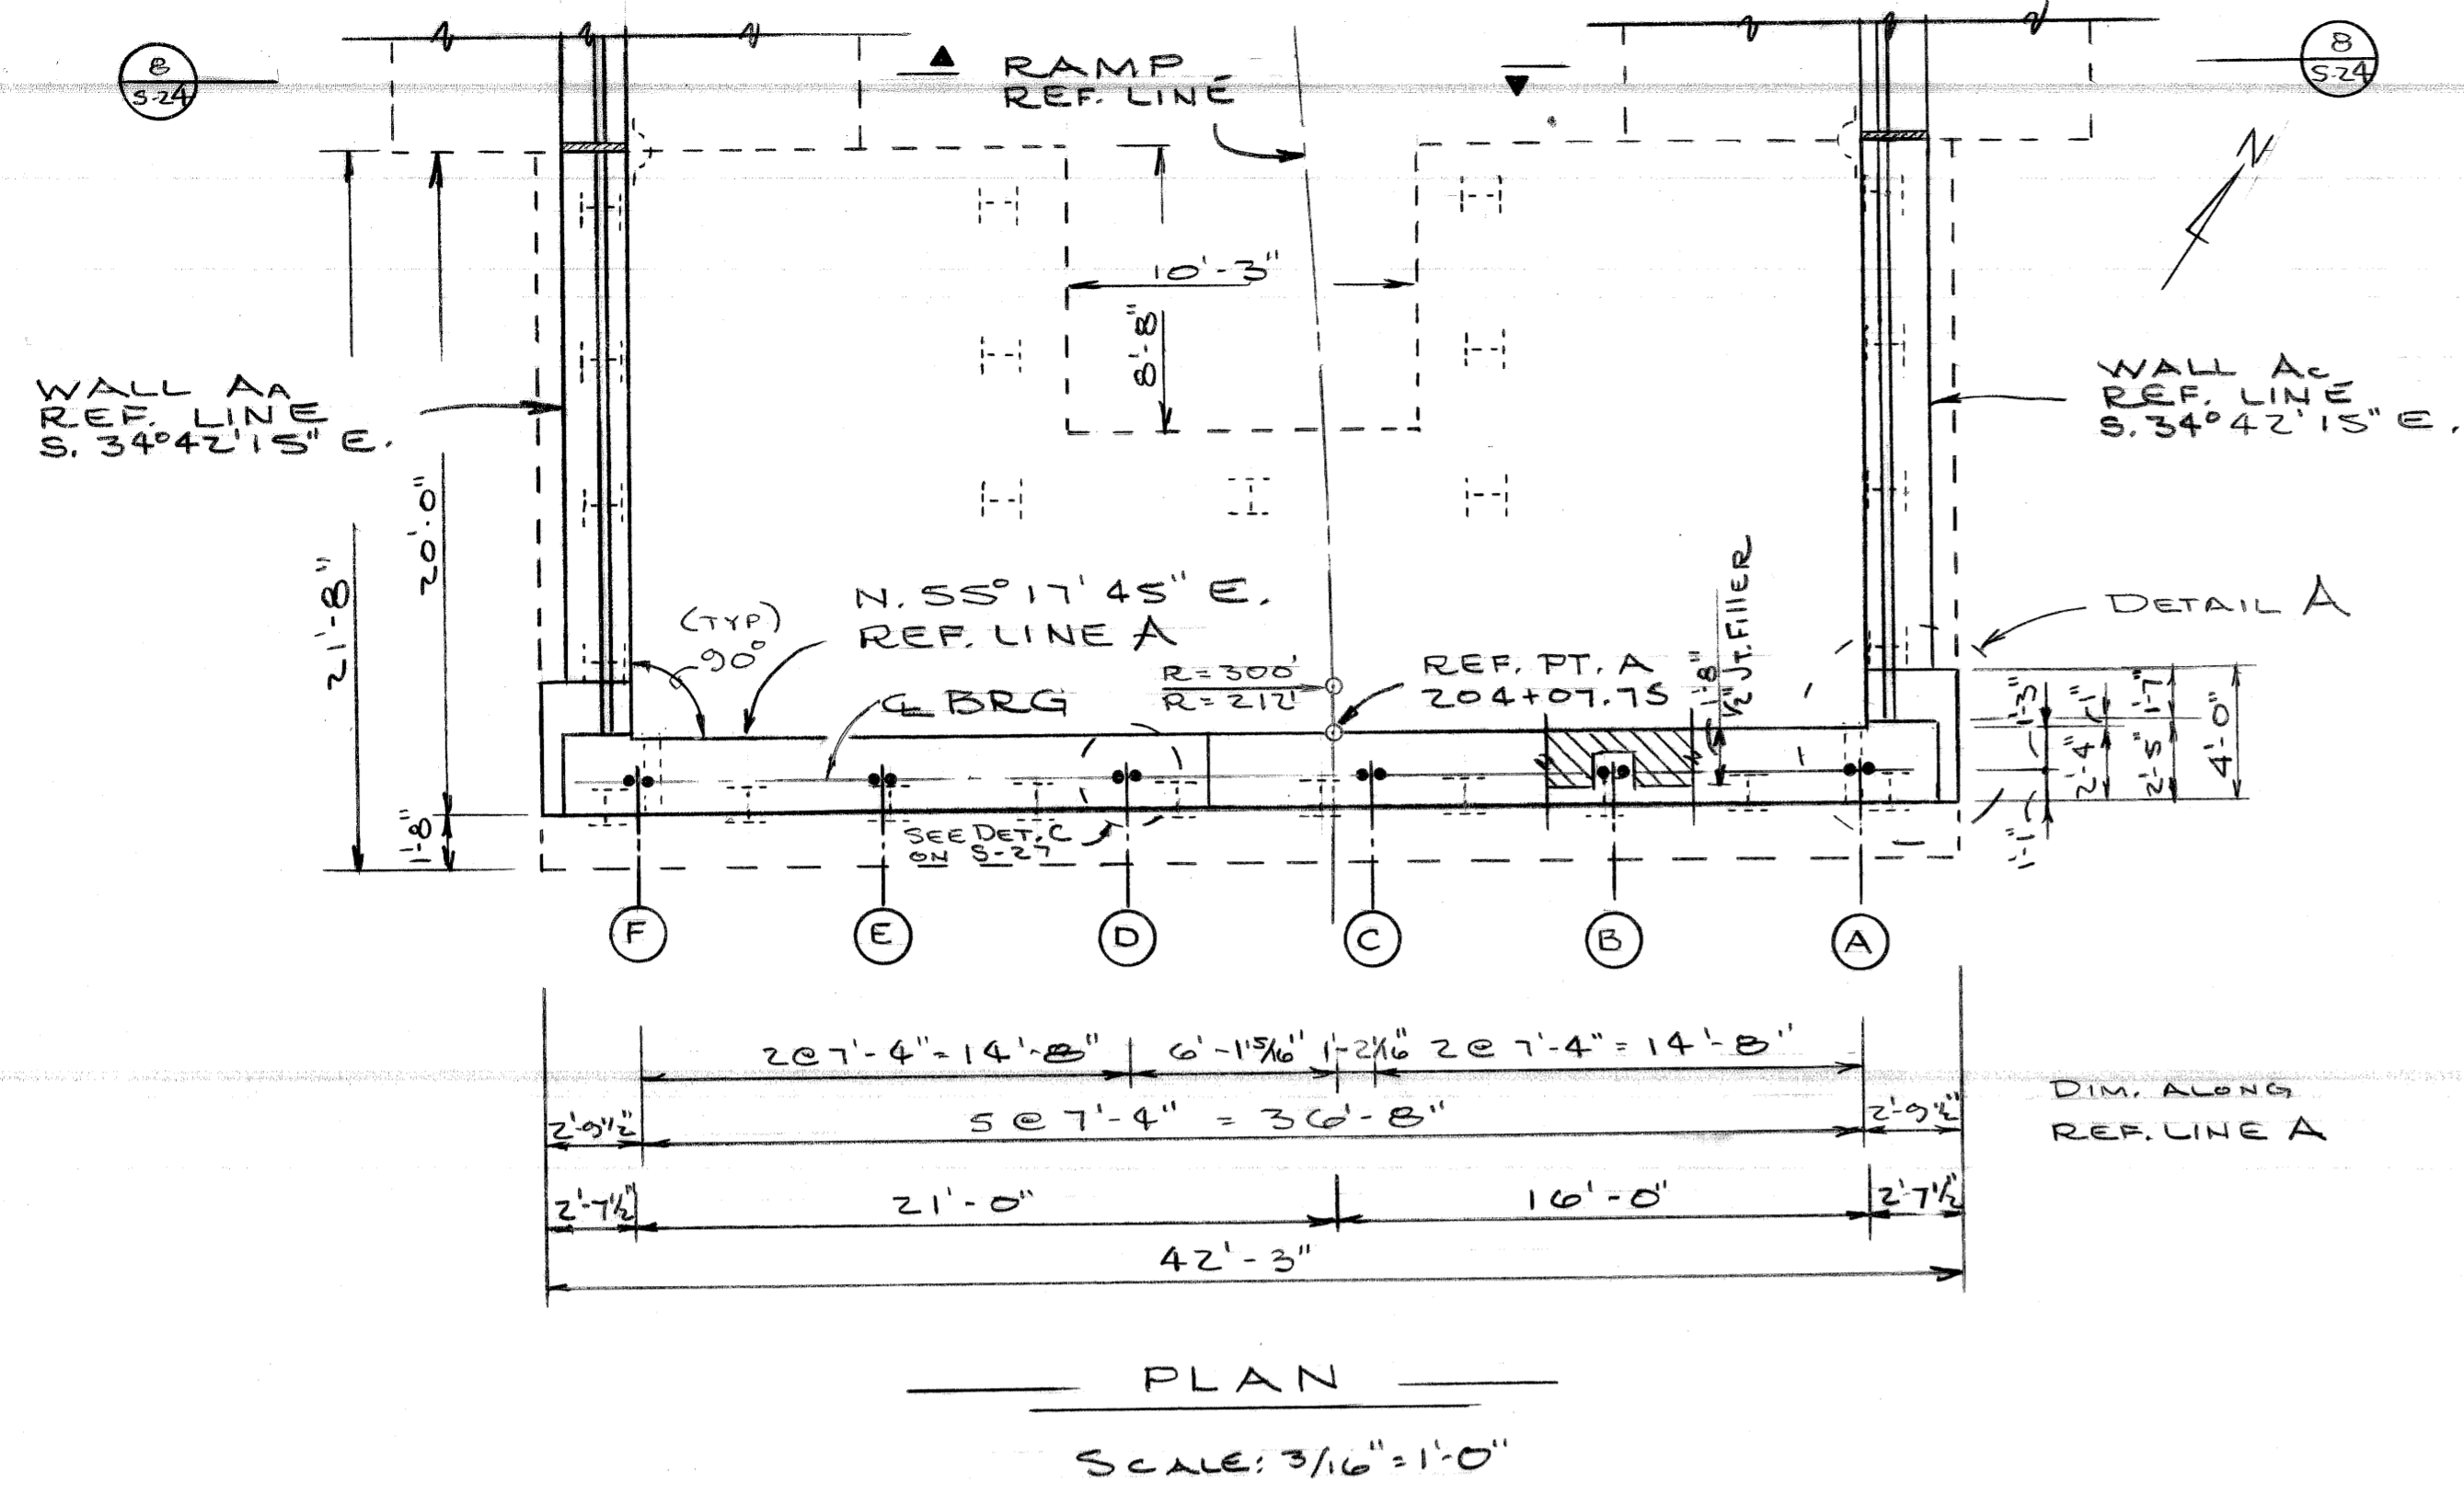


DESIGNED BY: <i>R. Fisher</i> DRAWN BY: <i>R. Fisher</i> TRACED BY: <i>-</i> CHECKED BY: <i>J. M. Gier</i>		APPROVED: STRUCTURAL ENGINEER		CITY OF DETROIT CITY ENGINEERING DIVISION - EPMD				JOHN C. LODGE EXIT RAMP AND JEFFERSON AVE RECONSTRUCTION AT THE JOE LOUIS ARENA RAMP- ABUTMENT A				SHEET <u> </u> OF <u> </u> SHEETS CONTRACT NO. 16563 A DRGW NO. S-19 DATE AUG. 1979	
REVISIONS LOCATED BY COORDINATES ON SHEET													

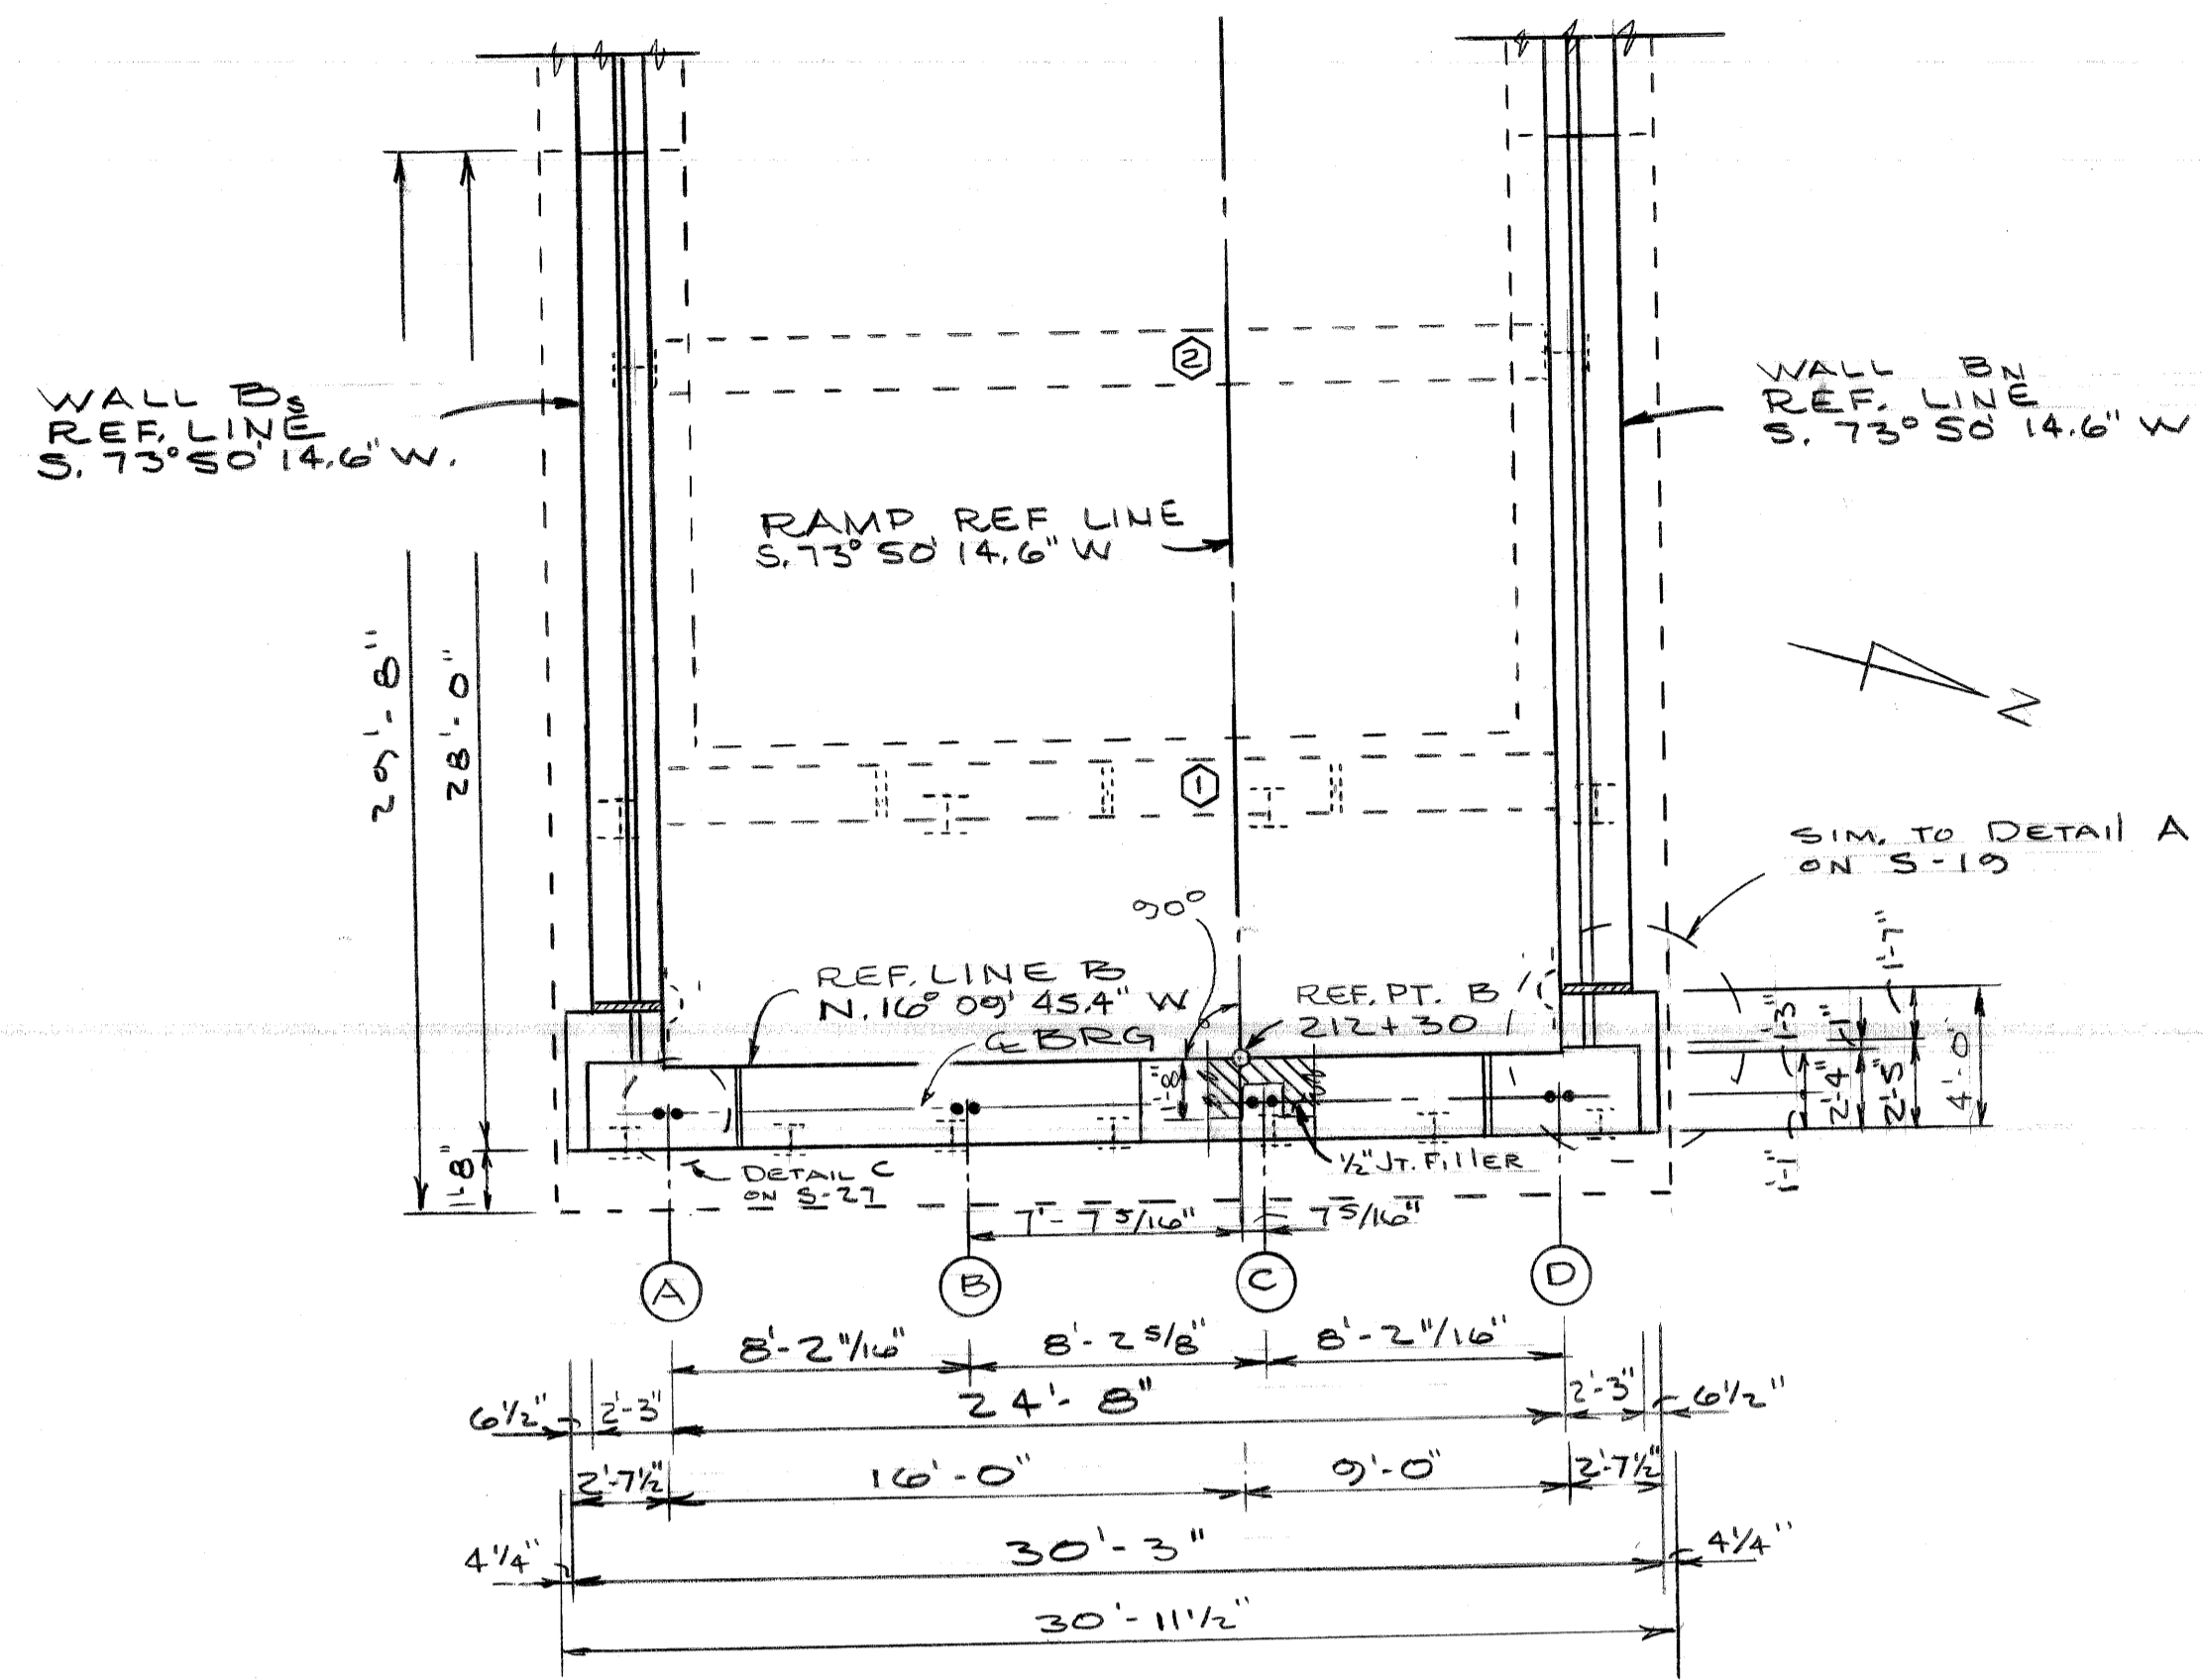


PLAN
SCALE: 3/16" = 1'-0"

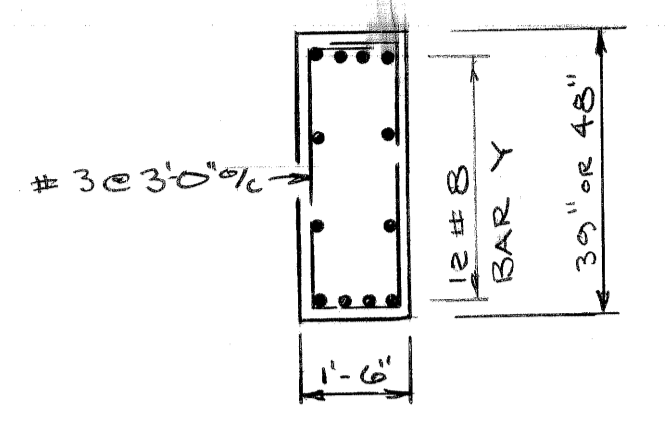


TIES 2-4

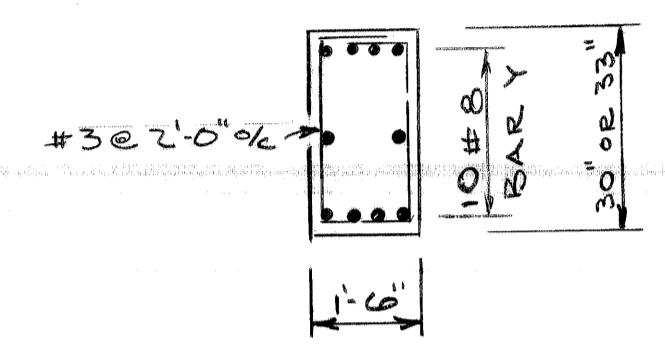


TIES 5-23

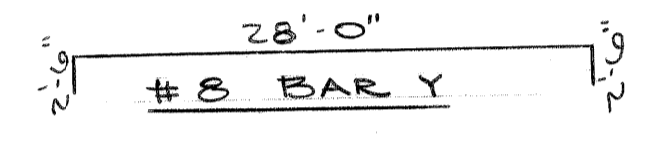


REINF. CONC. TIE DETAILS

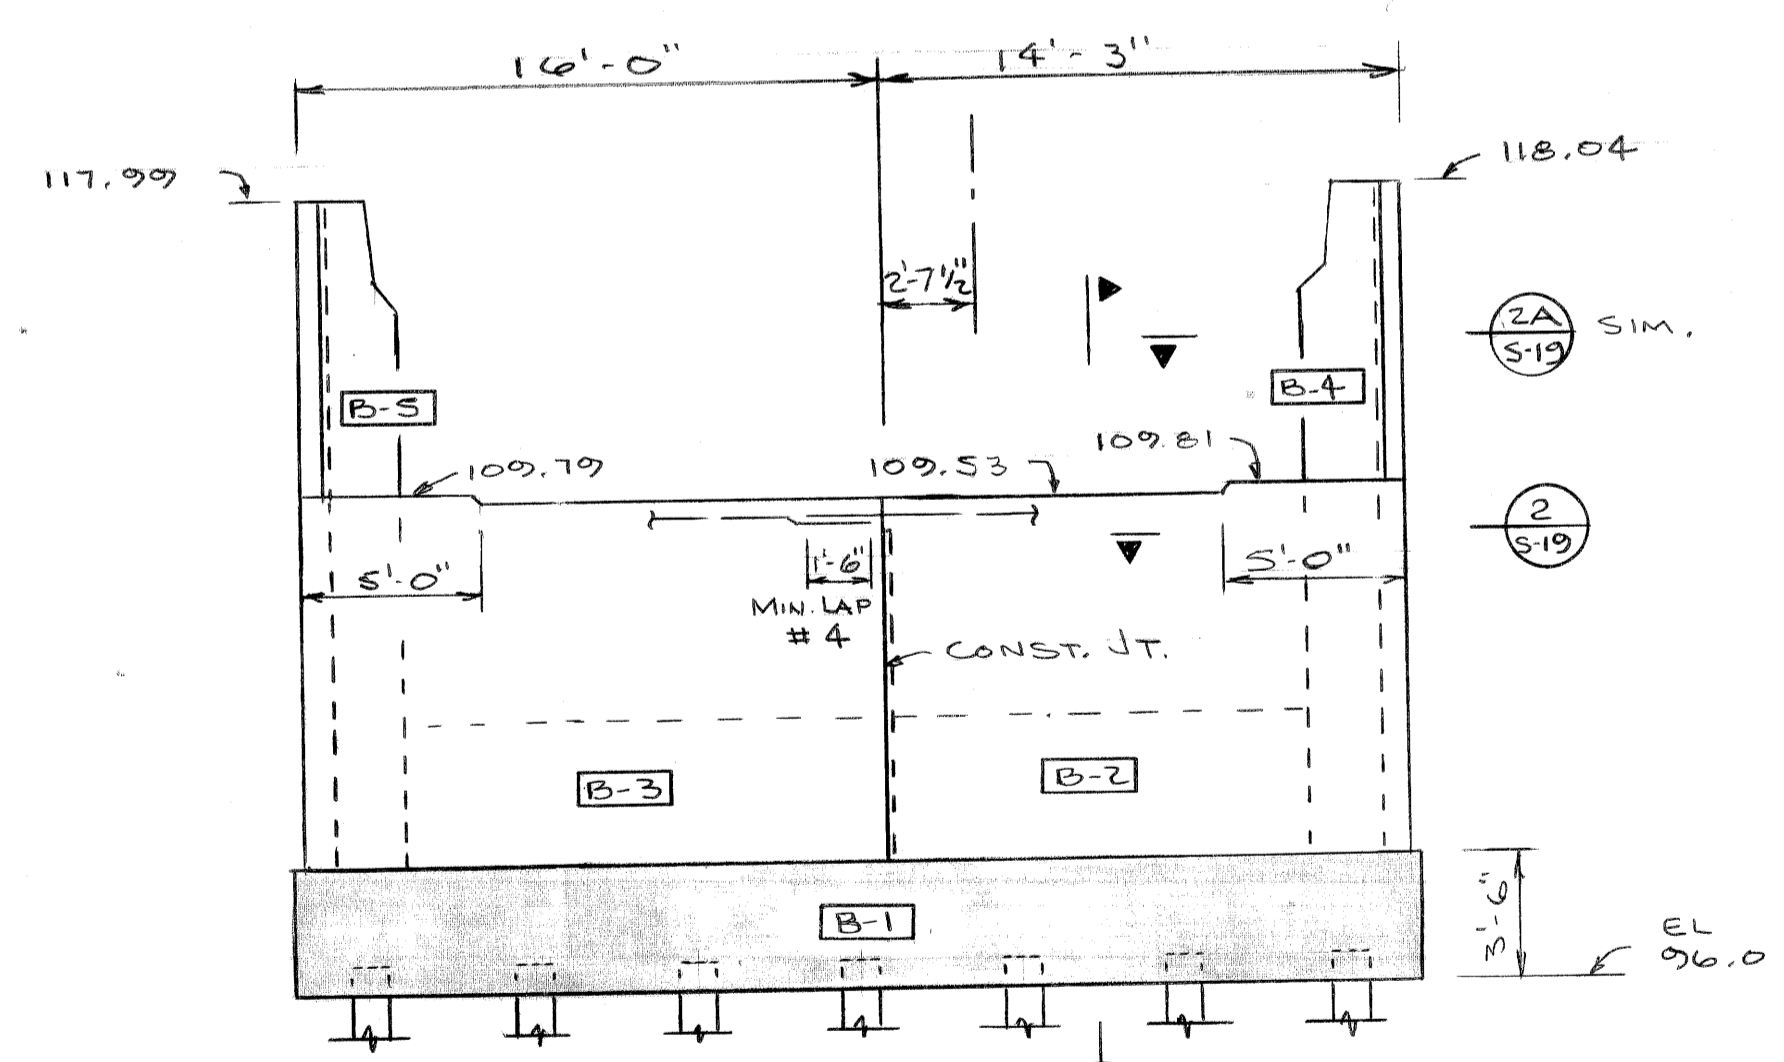

ELEVATION
SCALE: 3/16" = 1'-0"

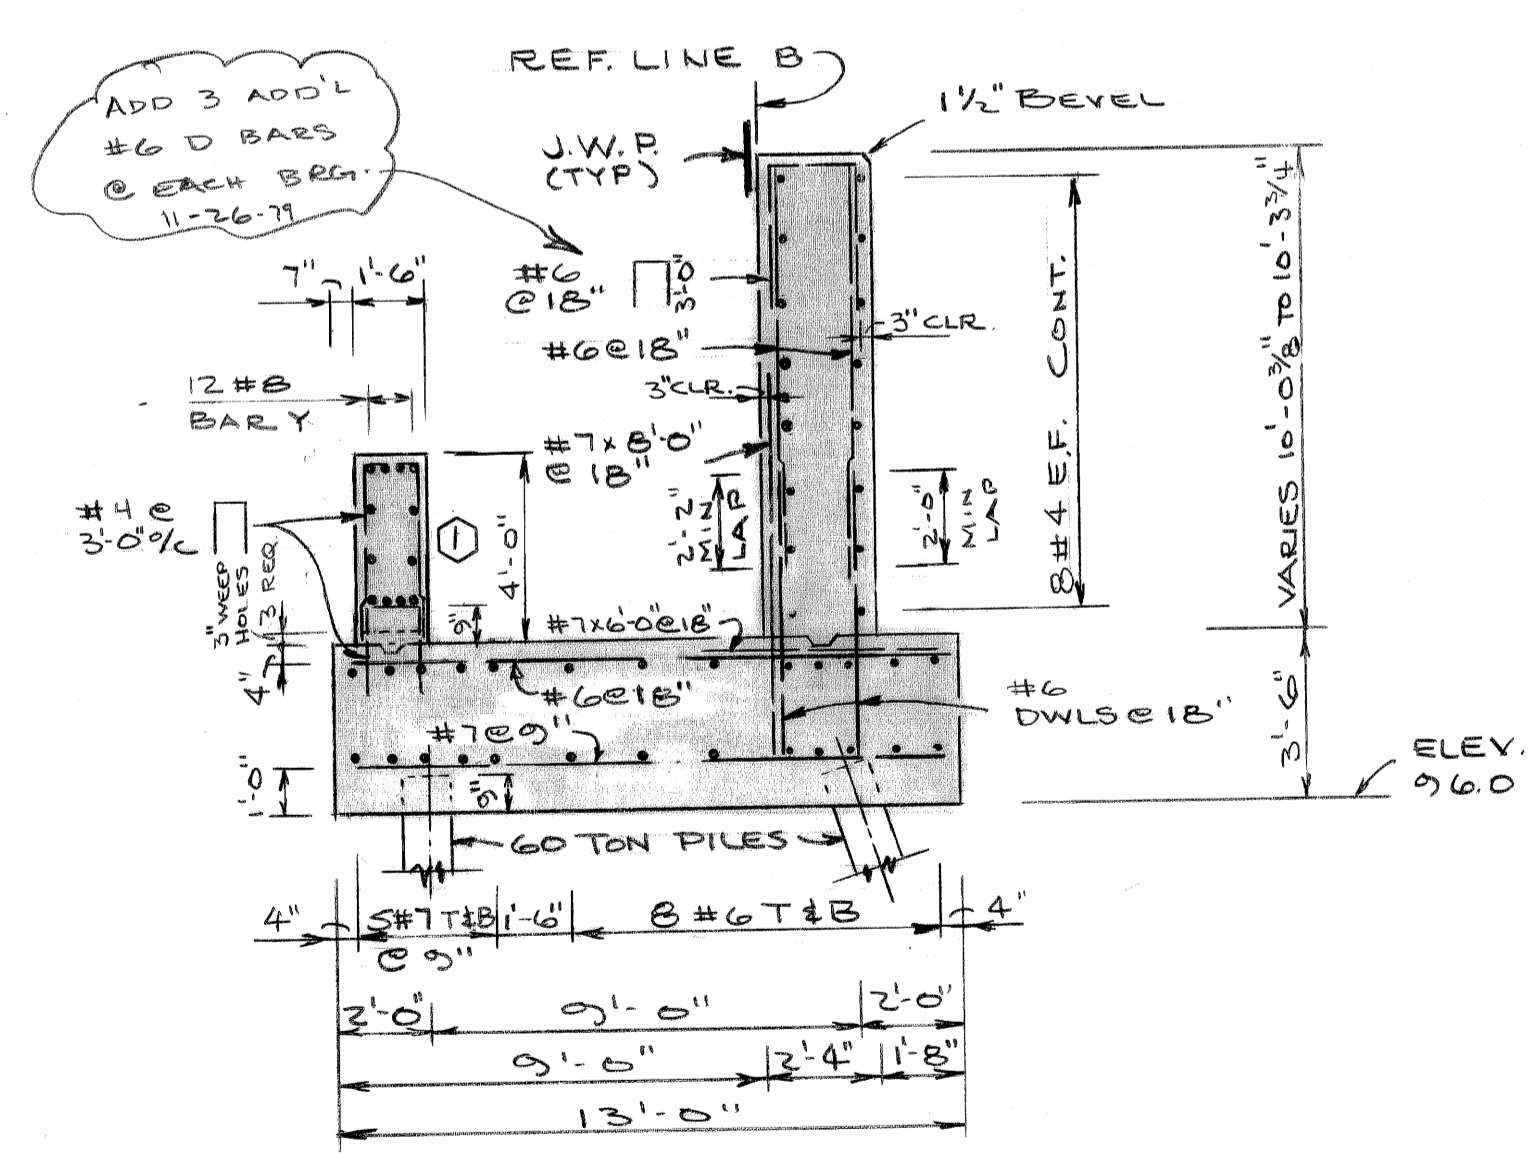

SECTION 3/520
SCALE: 1/4" = 1'-0"

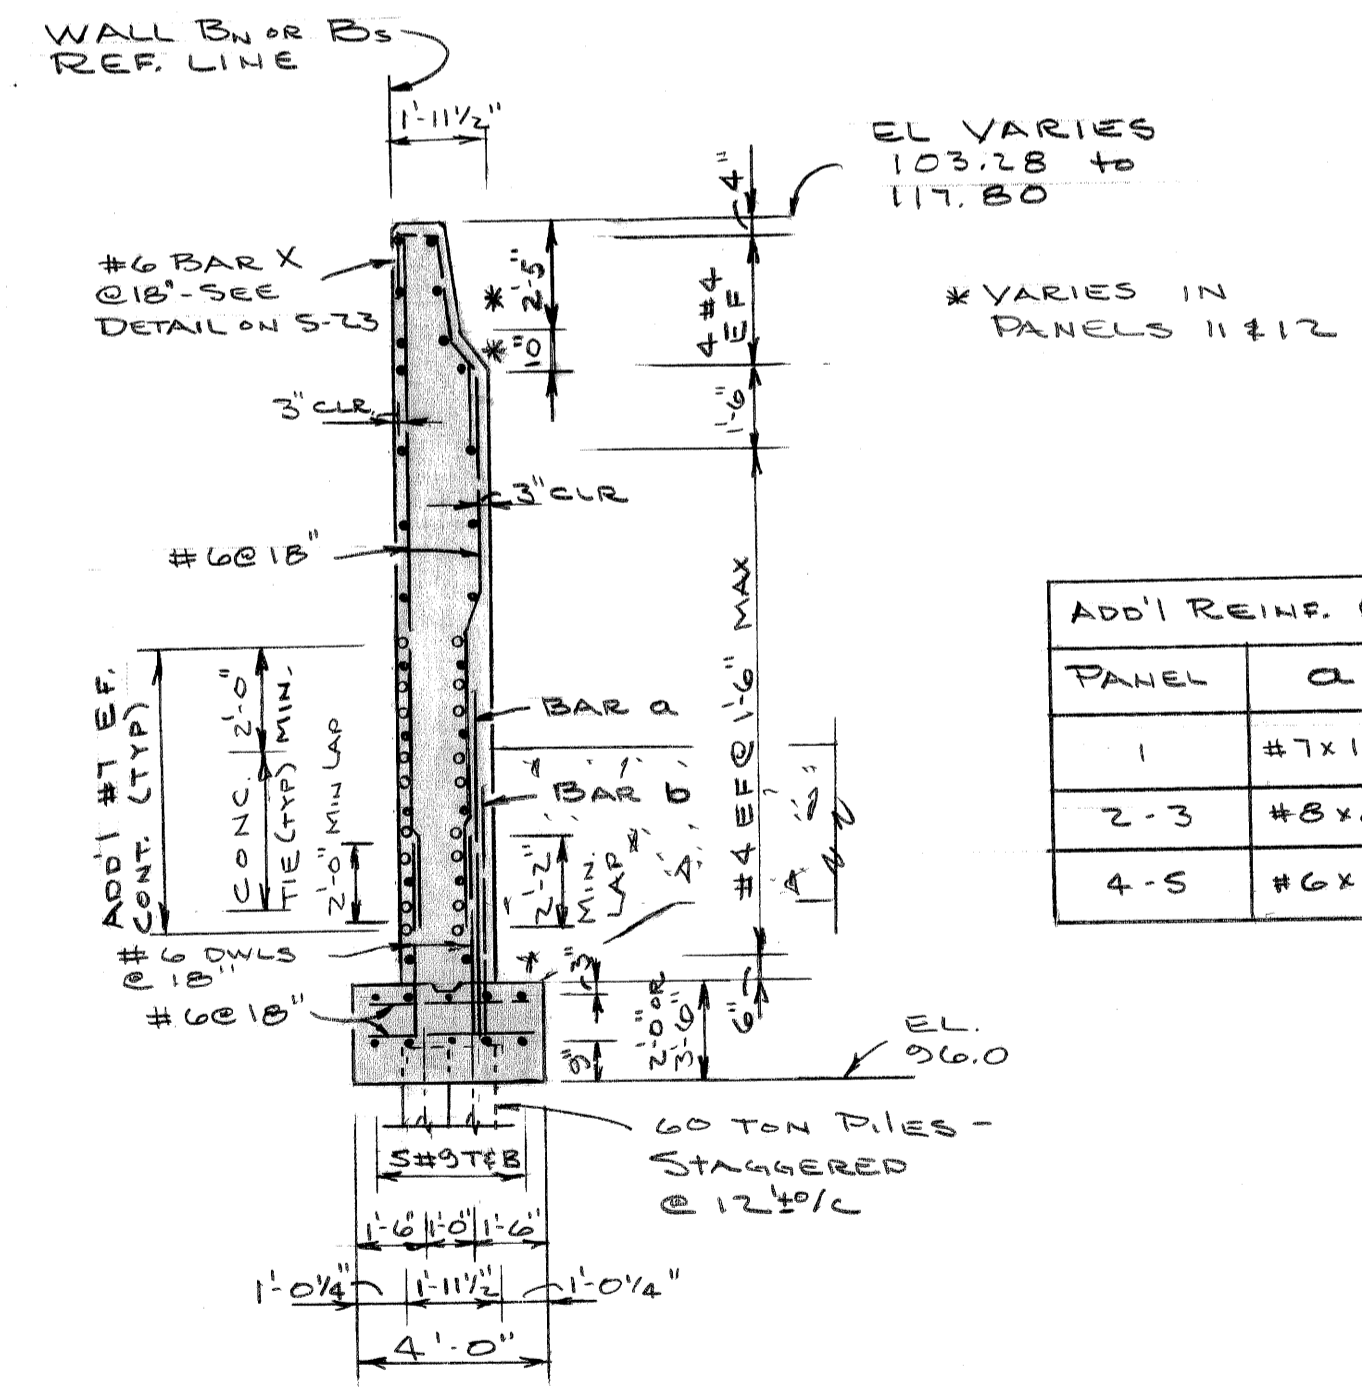


SECTION 9/525
SCALE: 1/4" = 1'-0"


ADD'L REINF. @ 18"

PANEL	a	b
1	#7x10'0"	#7x7'0"
2-3	#8x8'0"	-
4-5	#6x5'0"	-


REVISIONS LOCATED BY COORDINATES ON SHEET COORD DESCRIPTION DRN CKD APVD DATE		DESIGNED BY: <i>R. Parker</i> DRAWN BY: <i>R. Parker</i> TRACED BY: <i>J.M. [Signature]</i> CHECKED BY: <i>J.M. [Signature]</i>	APPROVED: STRUCTURAL ENGINEER	CITY OF DETROIT CITY ENGINEERING DIVISION - EPMD	JOHN C. LODGE EXIT RAMP AND JEFFERSON AVE RECONSTRUCTION AT THE JOE LOUIS ARENA RAMP - ABUTMENT B DETAILS	SHEET _____ OF _____ SHEETS CONTRACT NO. 16563 A DRWA NO. S-20 DATE AUG 1979
---	--	--	----------------------------------	---	--	---

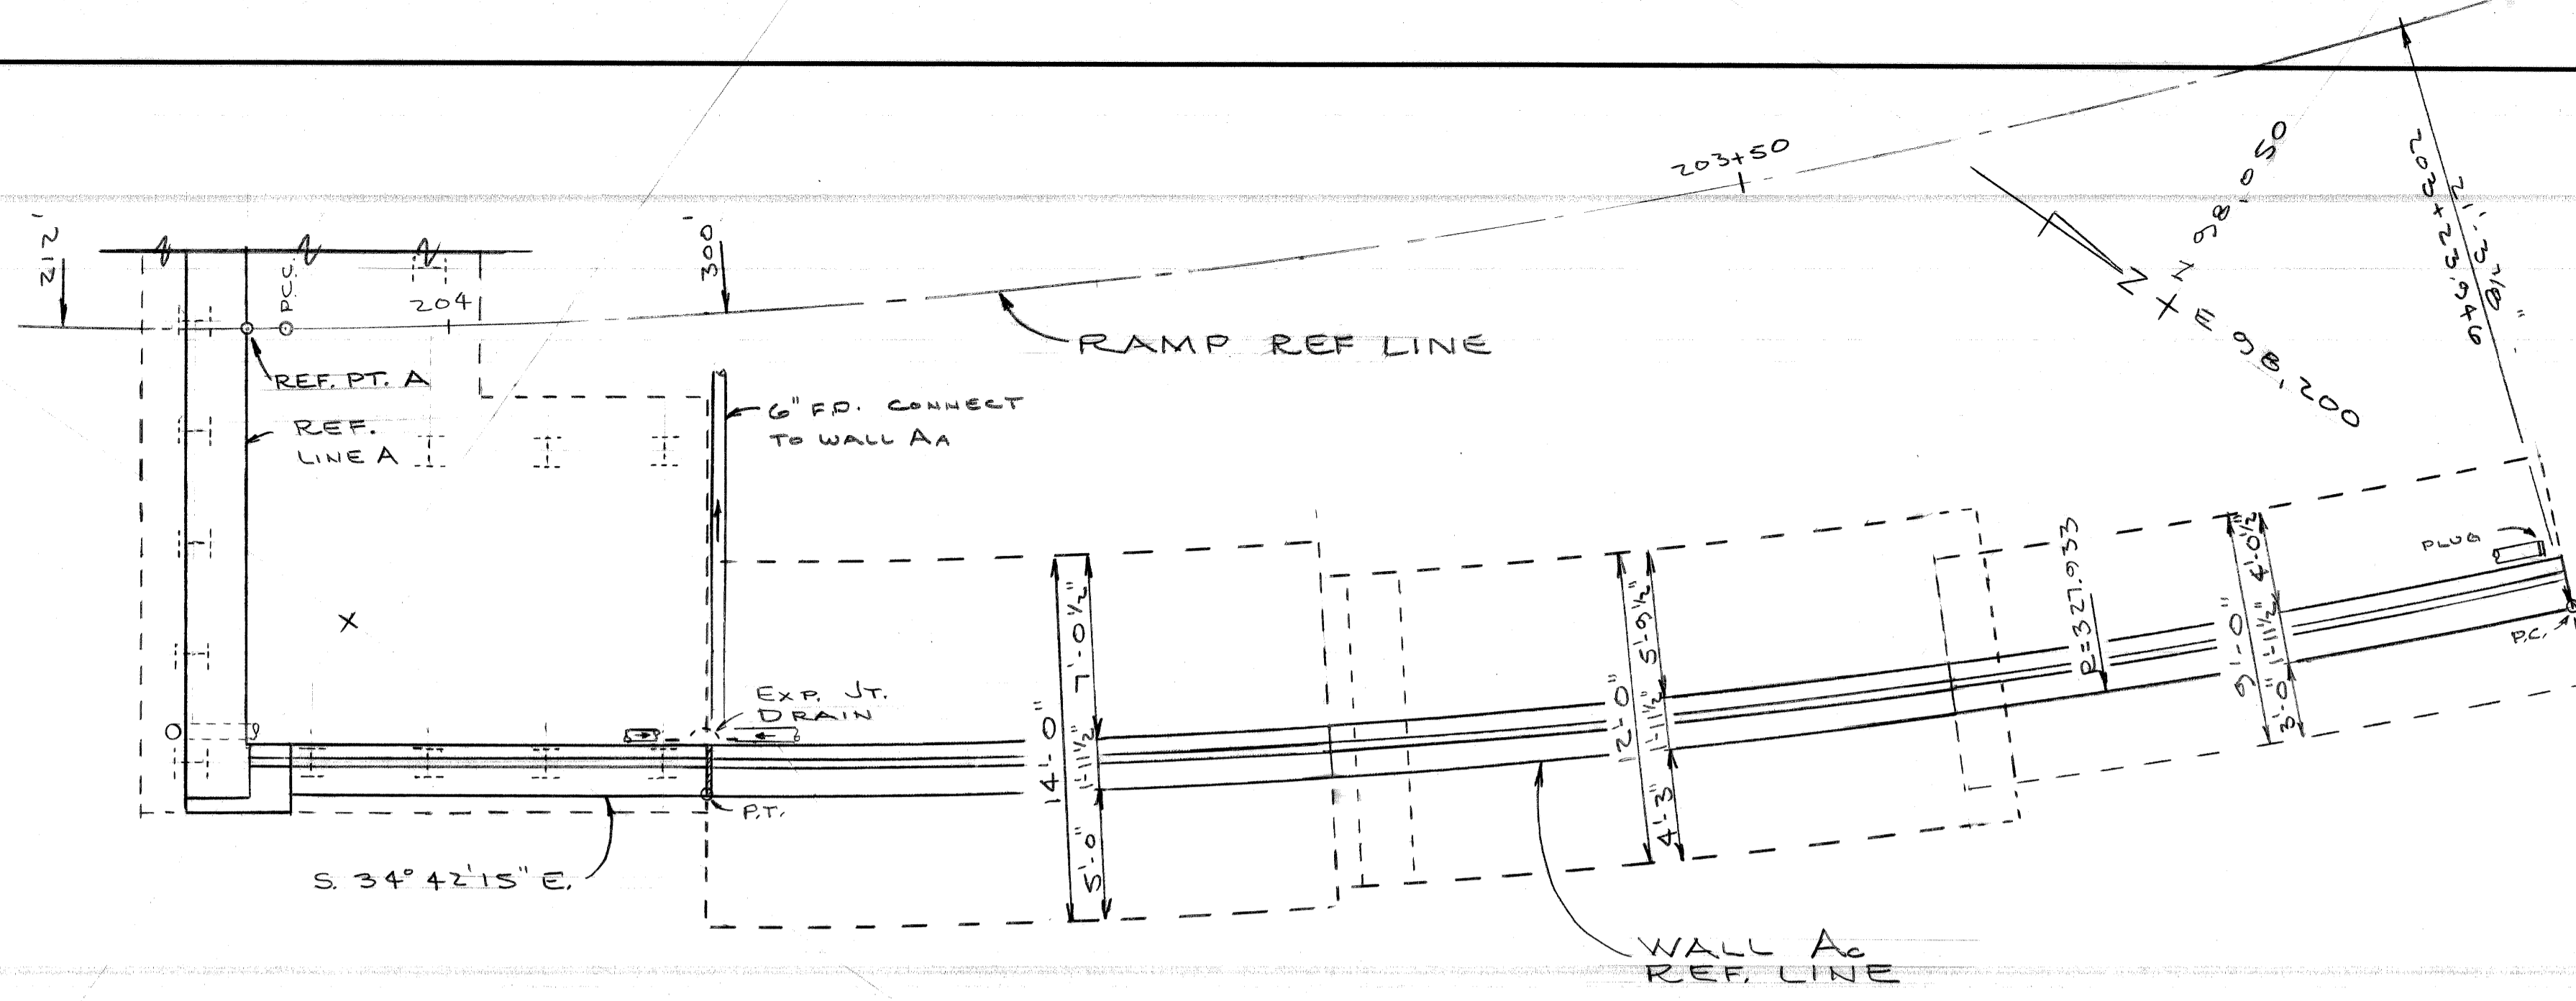

PLAN
SCALE: 3/16" = 1'-0"


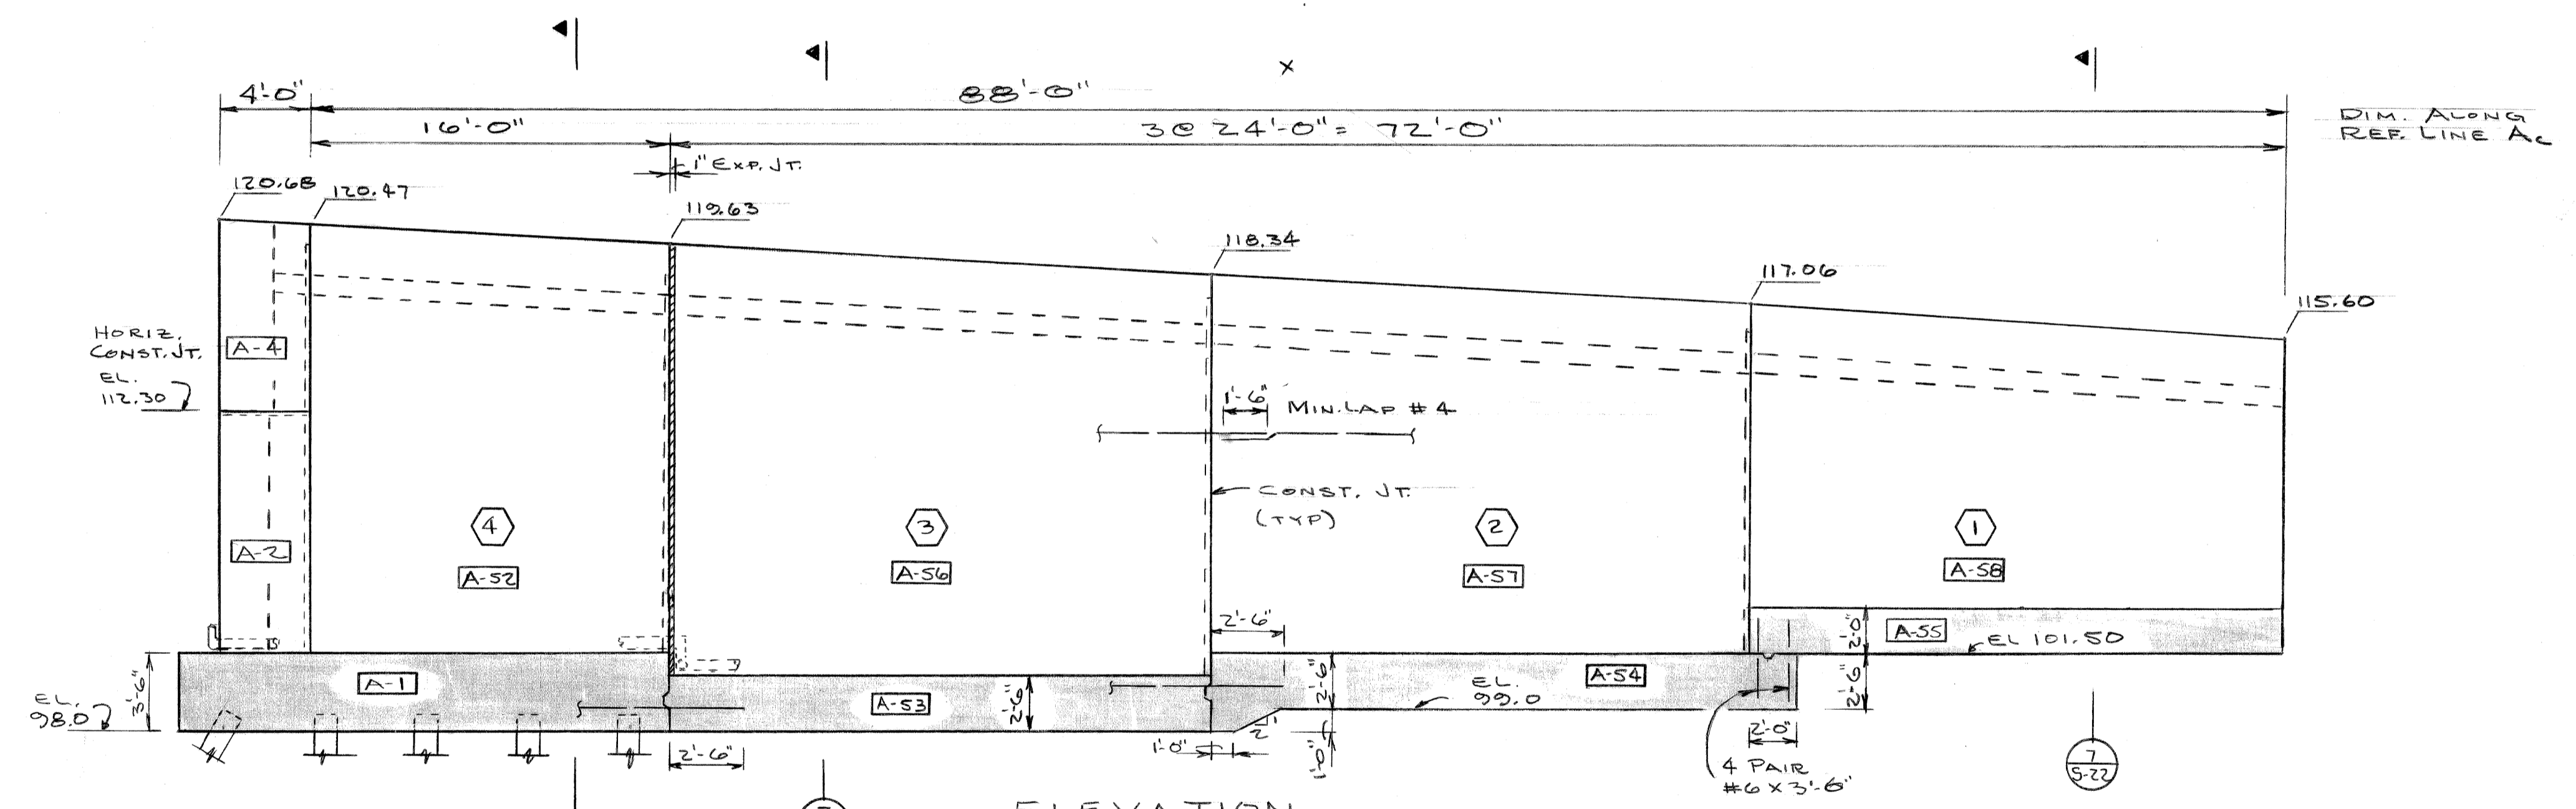


ELEVATION
SCALE: 3/16" = 1'-0"


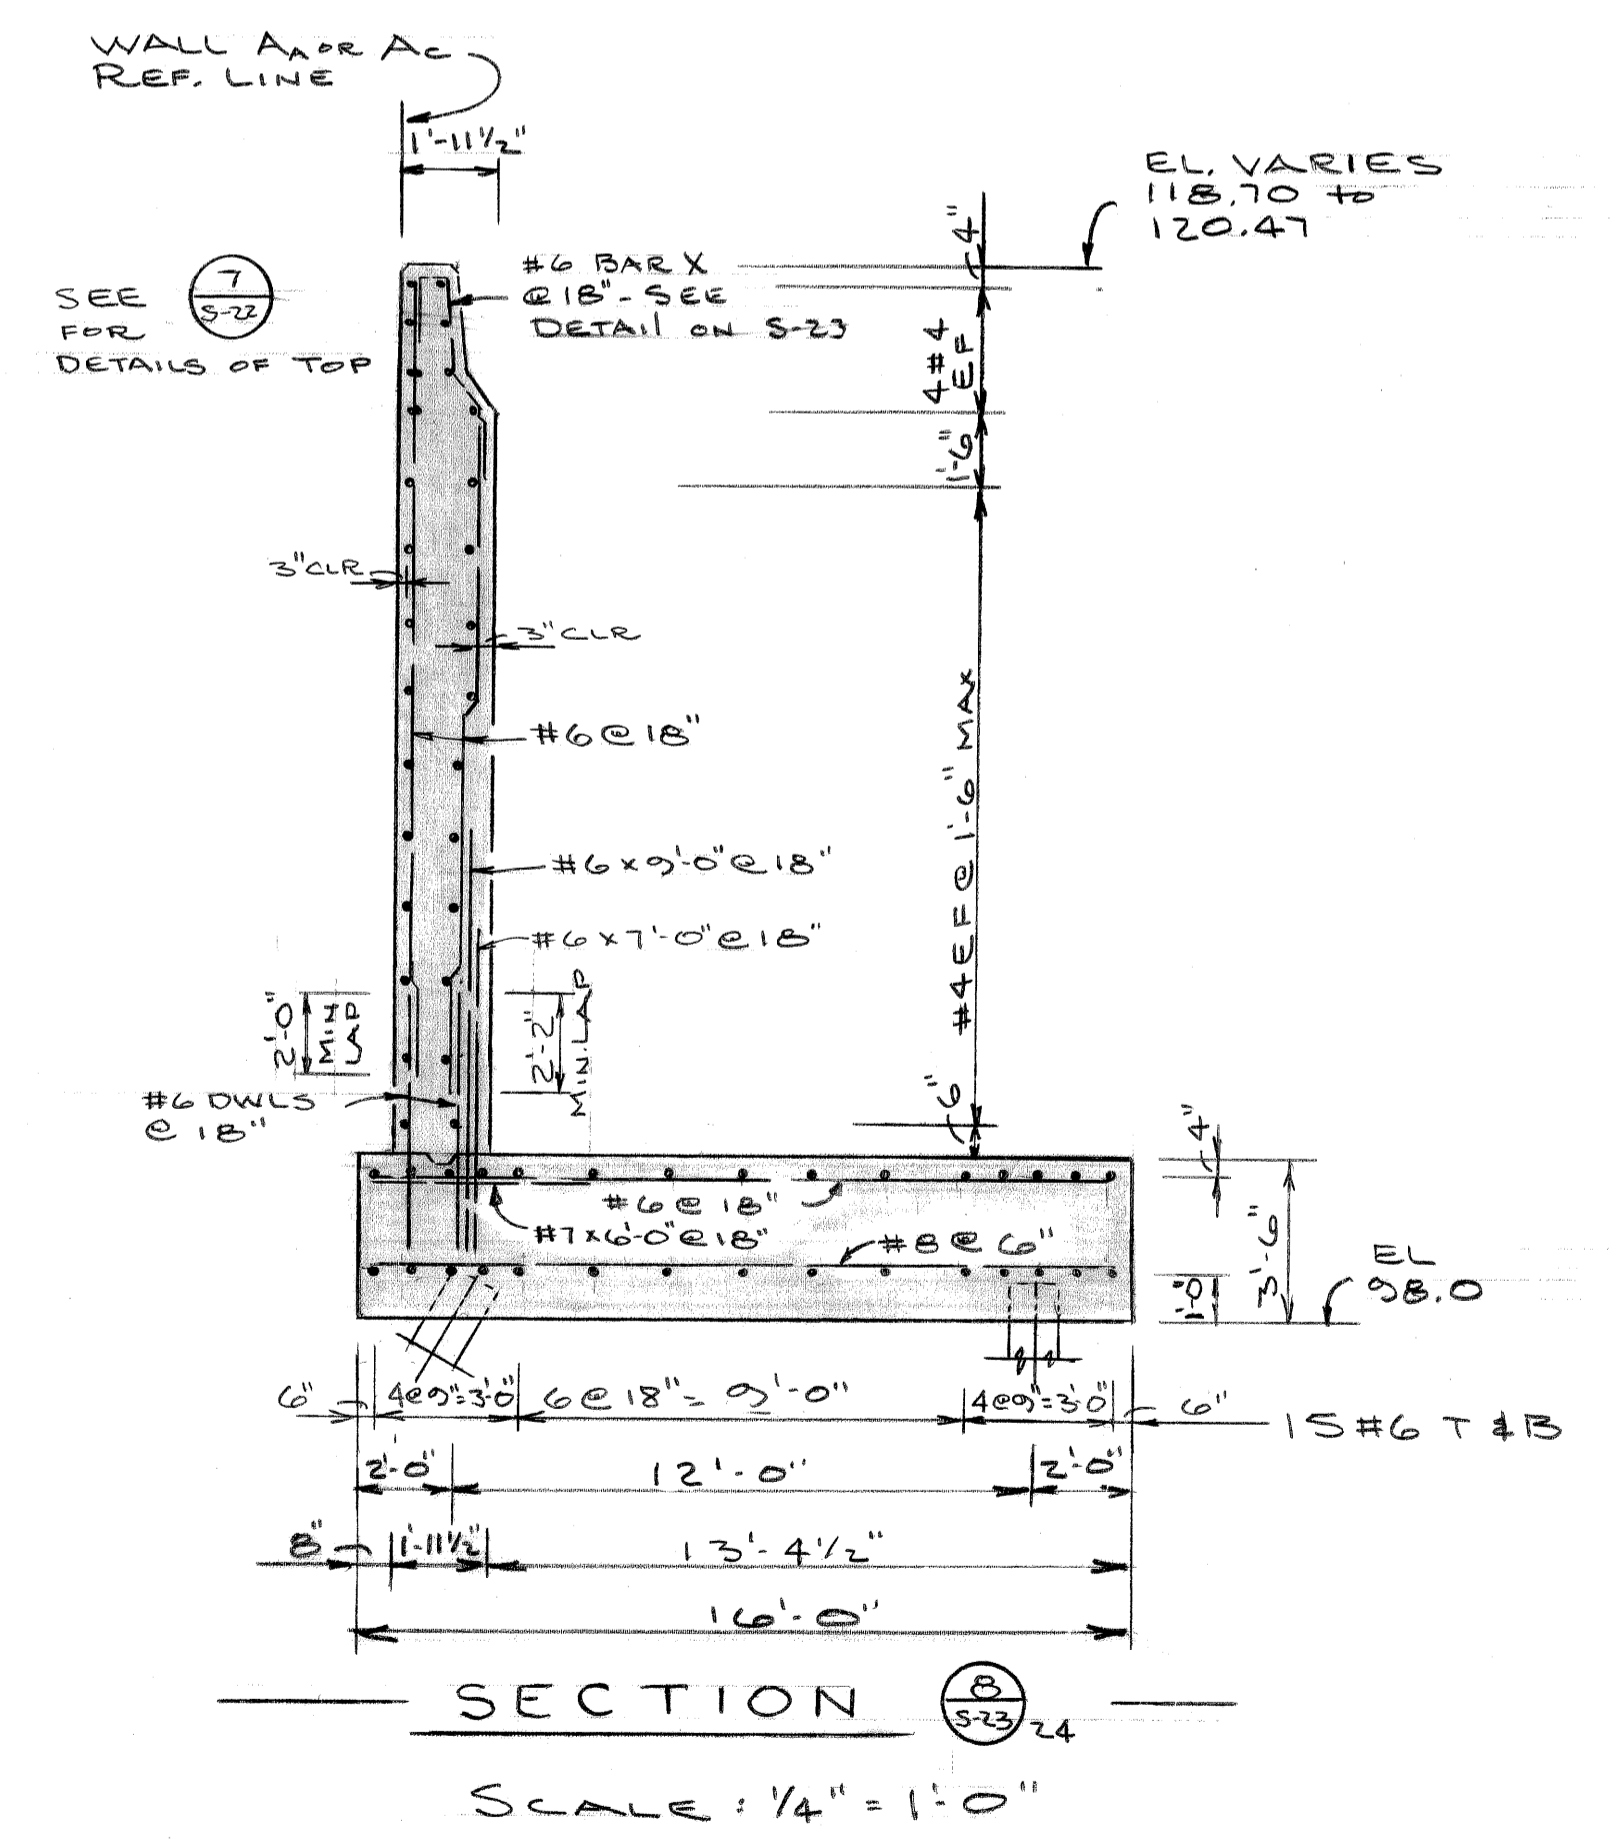


SECTION
SCALE: 1/4" = 1'-0"

REVISIONS LOCATED BY COORDINATES ON SHEET 1 2 3 4 5 6 7 8 9 10 11		REFERENCE DRAWINGS DESIGNED BY: <i>R. Parker</i> DRAWN BY: <i>R. Parker</i> TRACED BY: CHECKED BY: <i>J. M. Jure</i>	APPROVED: STRUCTURAL ENGINEER	CITY OF DETROIT CITY ENGINEERING DIVISION - EPM D	JOHN C. LODGE EXIT RAMP AND JEFFERSON AVE. RECONSTRUCTION AT THE JOE LOUIS ARENA RAMP - WALL A _c DETAILS	SHEET OF SHEETS CONTRACT NO. 16563 A DRWG NO. S-24 DATE AUG 1979
--	--	--	----------------------------------	--	--	---

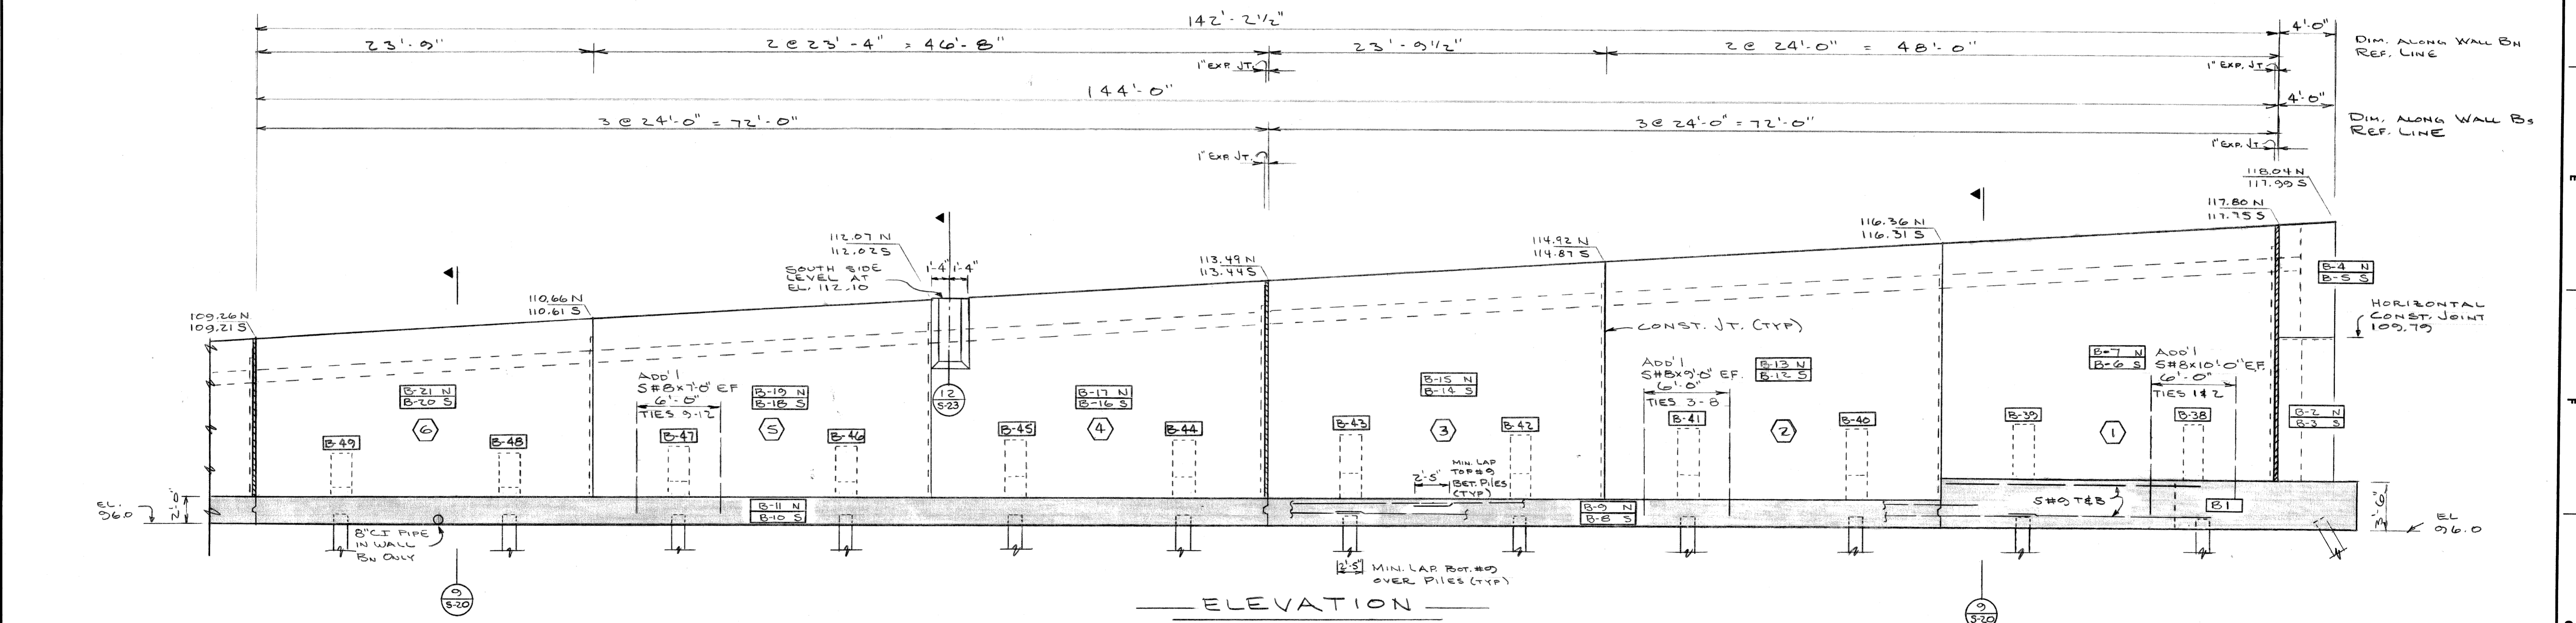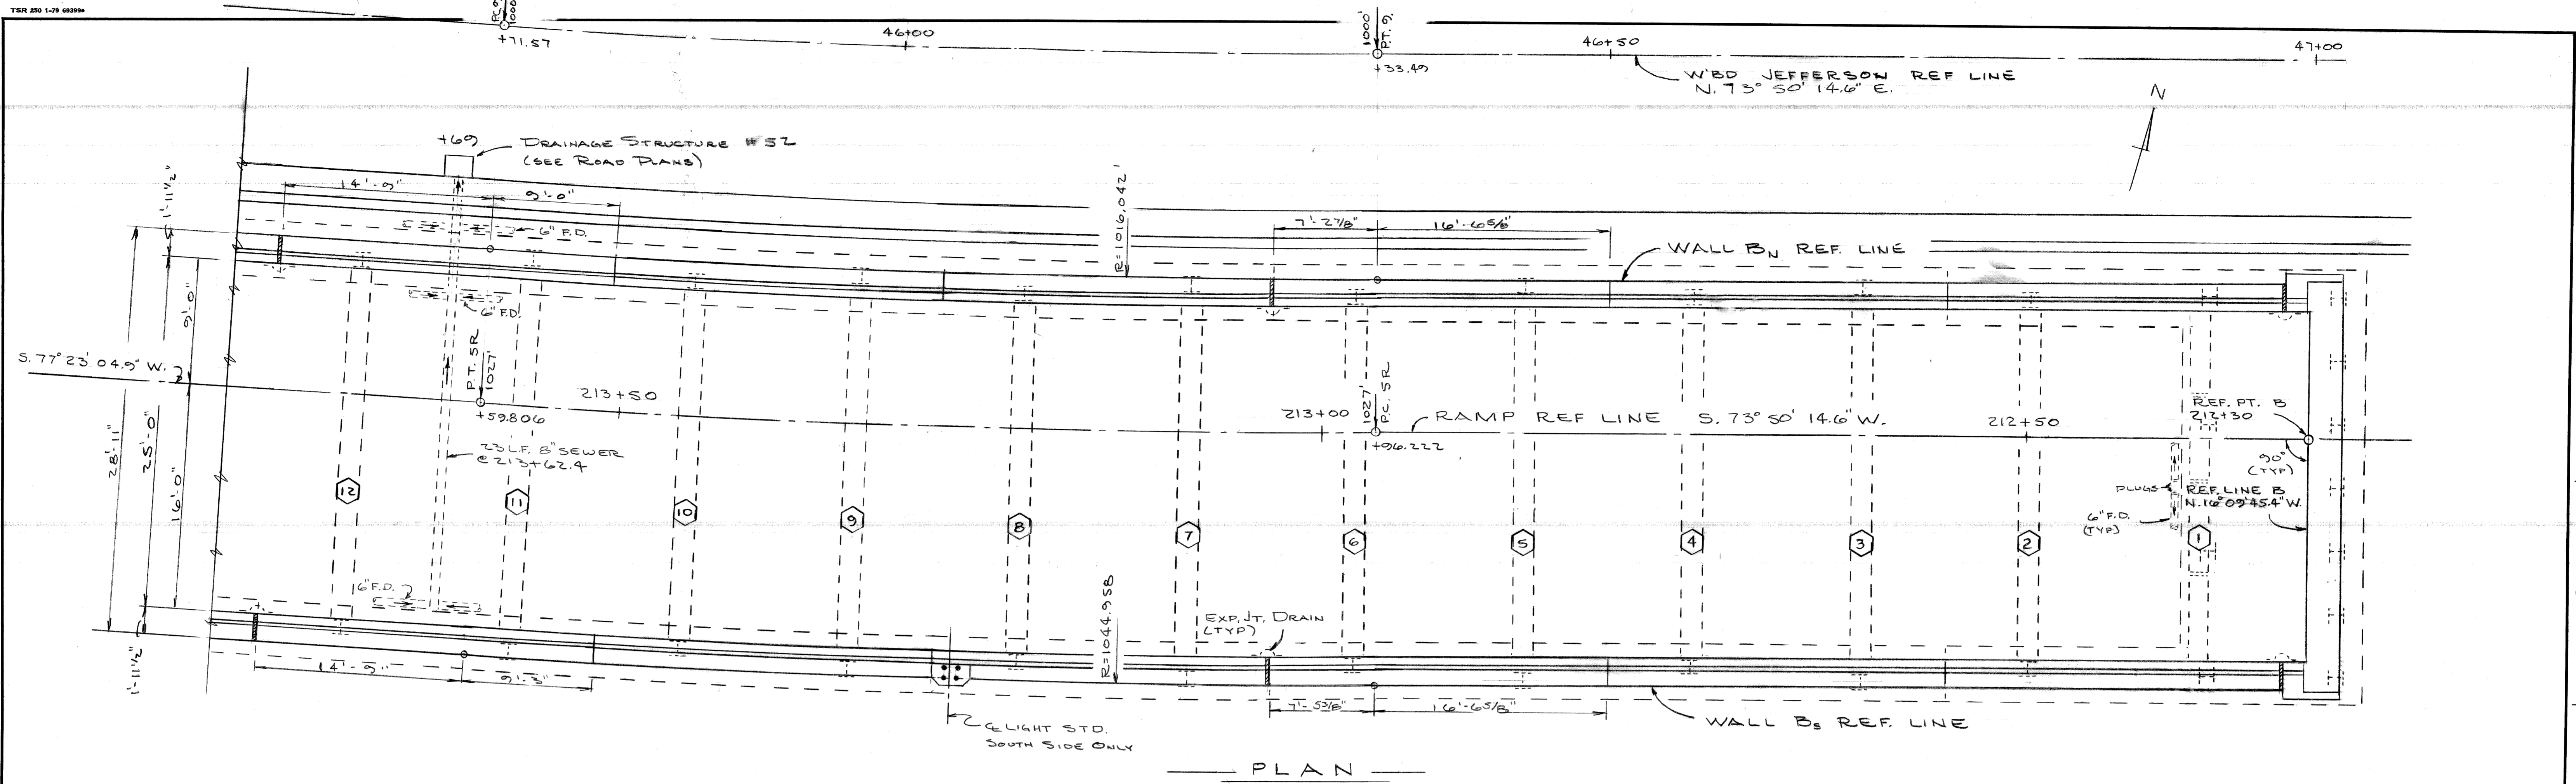


<table border="1"> <tr> <th>COORD</th> <th>DESCRIPTION</th> <th>DRN</th> <th>CHK'D</th> <th>APVD</th> <th>DATE</th> </tr> <tr> <td> </td> <td> </td> <td> </td> <td> </td> <td> </td> <td> </td> </tr> </table>		COORD	DESCRIPTION	DRN	CHK'D	APVD	DATE							REVISIONS LOCATED BY COORDINATES ON SHEET 1 2	REFERENCE DRAWINGS DESIGNED BY <i>R. Fisher</i> DRAWN BY <i>R. Fisher</i> TRACED BY CHECKED BY <i>J. M. Smith</i>	APPROVED: STRUCTURAL ENGINEER CITY OF DETROIT CITY ENGINEERING DIVISION - EPMD	JOHN C. LODGE EXIT RAMP AND JEFFERSON AVE RECONSTRUCTION AT THE JOE LOUIS ARENA WALLS B _n & B _s DETAILS	SCALE: 3/16" = 1'-0" SHEET ___ OF ___ SHEETS CONTRACT NO. 16563A DRWG. NO. S-25 DATE AUG 1979
COORD	DESCRIPTION	DRN	CHK'D	APVD	DATE													

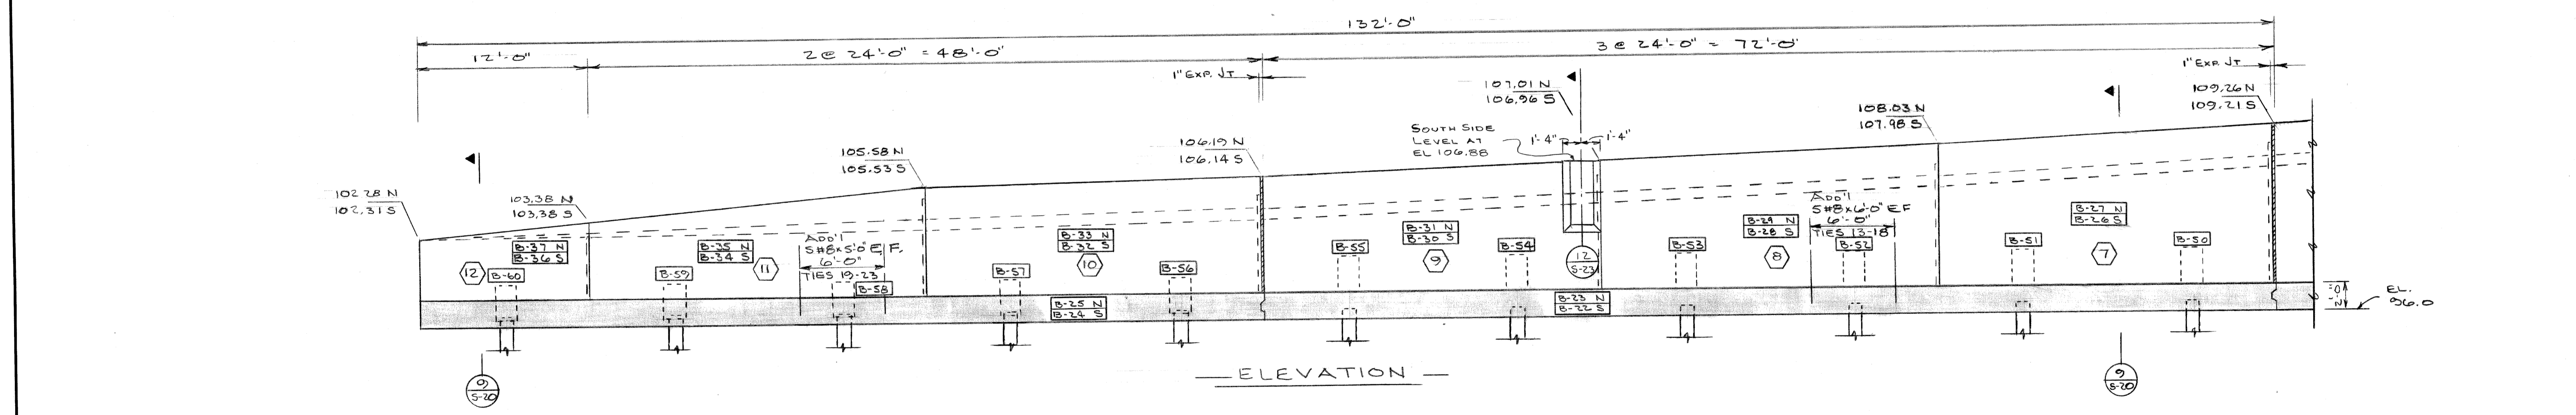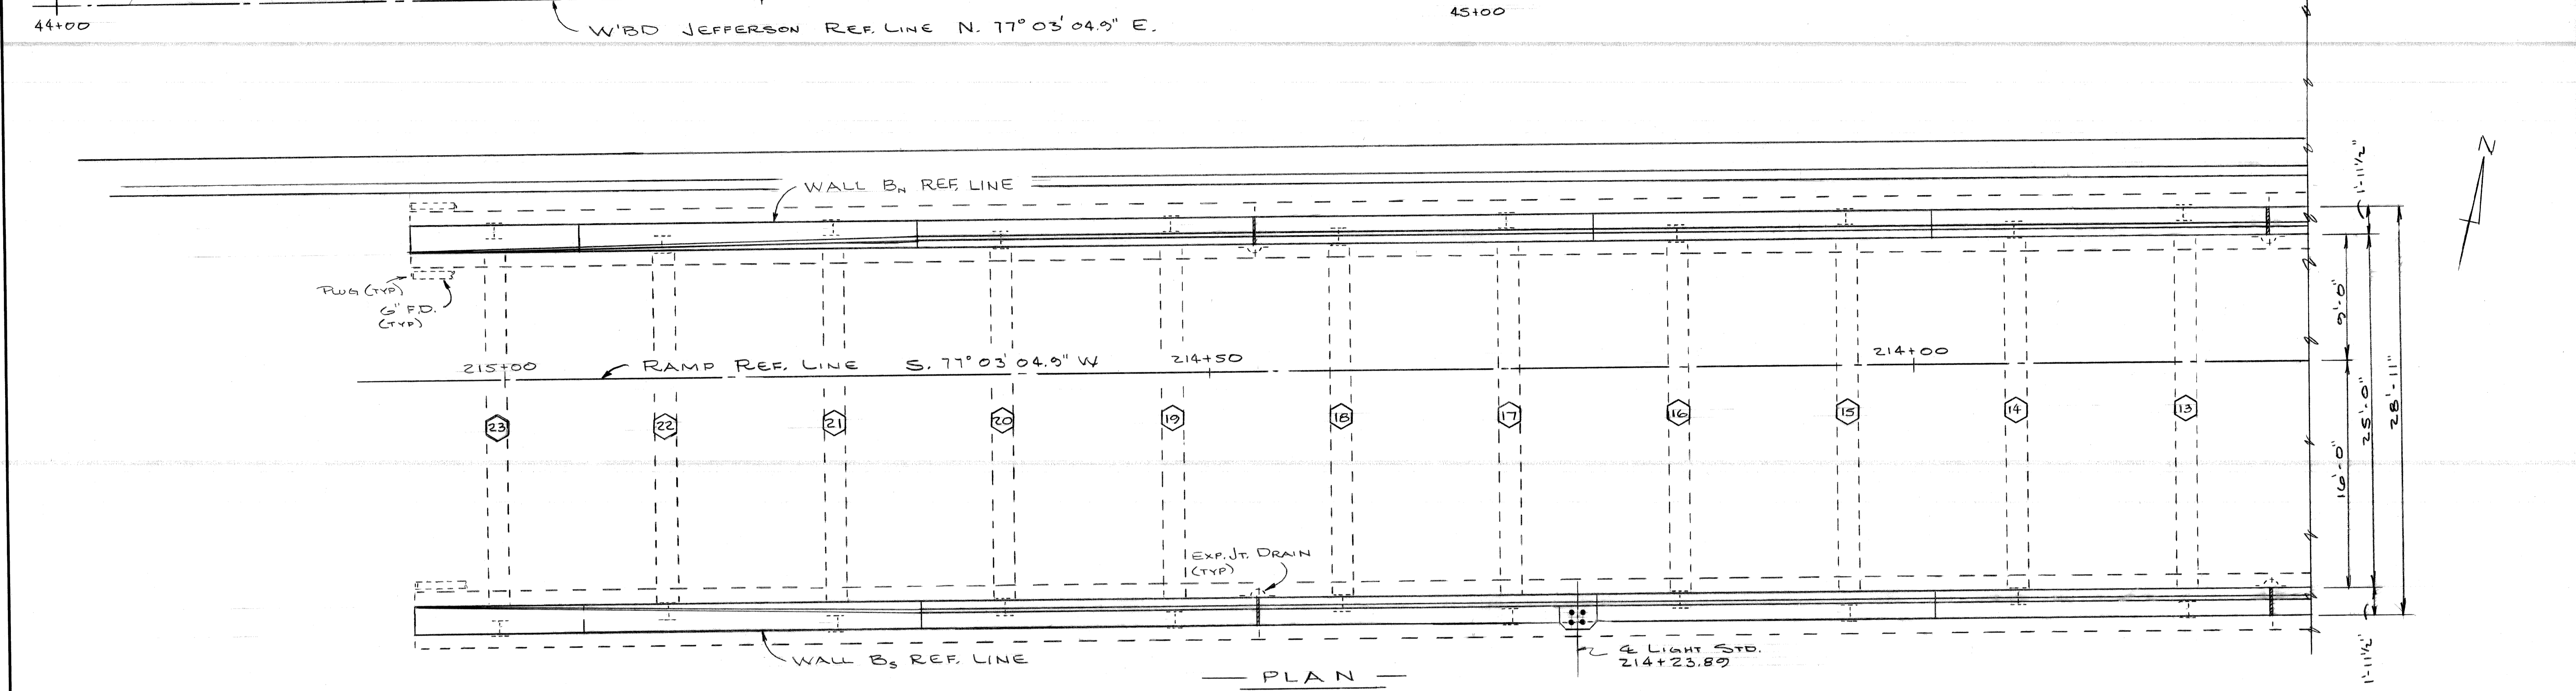


SCALE: 3/16" = 1'-0"

<table border="1"> <tr> <td>COORD</td> <td>DESCRIPTION</td> <td>DRN</td> <td>CK'D</td> <td>APVD</td> <td>DATE</td> </tr> <tr> <td> </td> <td> </td> <td> </td> <td> </td> <td> </td> <td> </td> </tr> </table>		COORD	DESCRIPTION	DRN	CK'D	APVD	DATE							<table border="1"> <tr> <td>REFERENCE DRAWINGS</td> <td>DESIGNED BY</td> <td>APPROVED:</td> </tr> <tr> <td> </td> <td><i>R. Fisher</i></td> <td> </td> </tr> <tr> <td> </td> <td>DRAWN BY</td> <td>STRUCTURAL ENGINEER</td> </tr> <tr> <td> </td> <td><i>R. Fisher</i></td> <td> </td> </tr> <tr> <td> </td> <td>TRACED BY</td> <td> </td> </tr> <tr> <td> </td> <td> </td> <td> </td> </tr> <tr> <td> </td> <td>CHECKED BY</td> <td> </td> </tr> <tr> <td> </td> <td><i>D. Miller</i></td> <td> </td> </tr> </table>	REFERENCE DRAWINGS	DESIGNED BY	APPROVED:		<i>R. Fisher</i>			DRAWN BY	STRUCTURAL ENGINEER		<i>R. Fisher</i>			TRACED BY						CHECKED BY			<i>D. Miller</i>		<p align="center">CITY OF DETROIT CITY ENGINEERING DIVISION - EPMD</p>	<p>JOHN C. LODGE EXIT RAMP AND JEFFERSON AVE RECONSTRUCTION AT THE JOE LOUIS ARENA</p> <p>WALLS B_N & B_S DETAILS</p>	<table border="1"> <tr> <td>SHEET</td> <td>OF</td> <td>SHEETS</td> </tr> <tr> <td> </td> <td> </td> <td> </td> </tr> <tr> <td>CONTRACT NO.</td> <td colspan="2">10563A</td> </tr> <tr> <td>DRWG NO.</td> <td colspan="2">S-26</td> </tr> <tr> <td>DATE</td> <td colspan="2">AUG 1979</td> </tr> </table>	SHEET	OF	SHEETS				CONTRACT NO.	10563A		DRWG NO.	S-26		DATE	AUG 1979	
COORD	DESCRIPTION	DRN	CK'D	APVD	DATE																																																			
REFERENCE DRAWINGS	DESIGNED BY	APPROVED:																																																						
	<i>R. Fisher</i>																																																							
	DRAWN BY	STRUCTURAL ENGINEER																																																						
	<i>R. Fisher</i>																																																							
	TRACED BY																																																							
	CHECKED BY																																																							
	<i>D. Miller</i>																																																							
SHEET	OF	SHEETS																																																						
CONTRACT NO.	10563A																																																							
DRWG NO.	S-26																																																							
DATE	AUG 1979																																																							


STOP VERTICAL KEYWAYS 1'-0" BELOW TOP OF ABUT. & WINGWALLS. STOP J.W.P. 4'-0" BELOW TOP OF WINGWALLS.

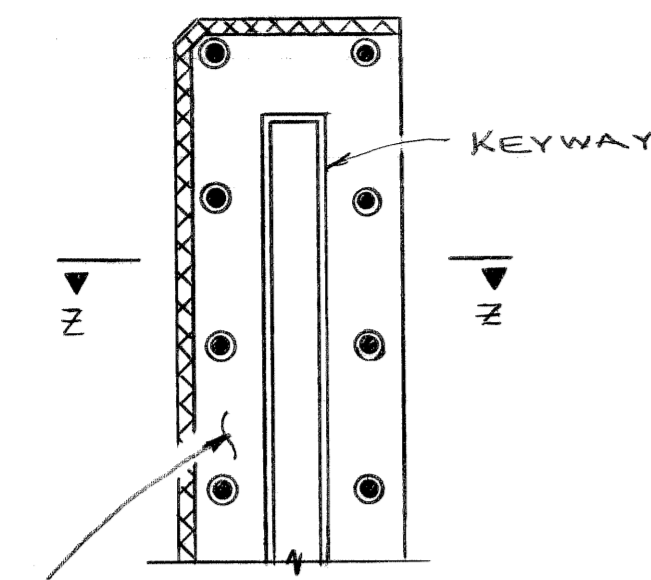

SECTION @ CONST. JT.

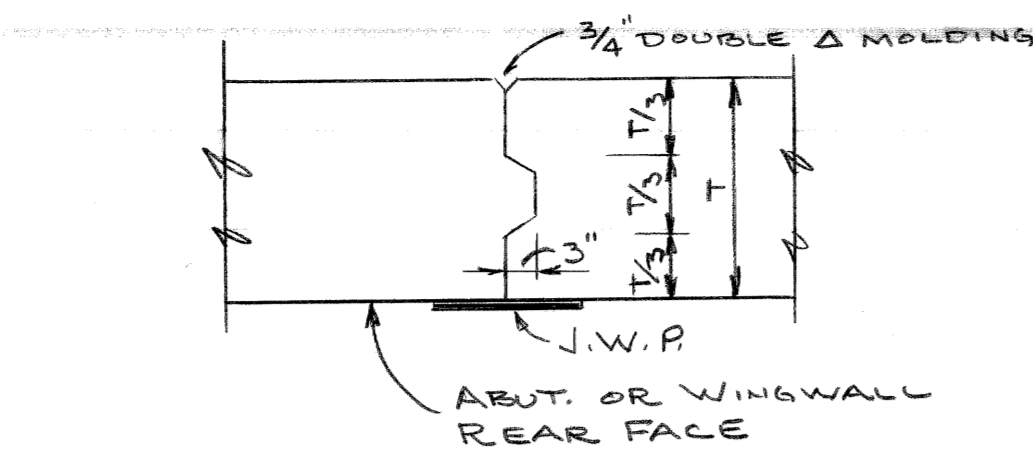


CONST. JOINT DETAIL

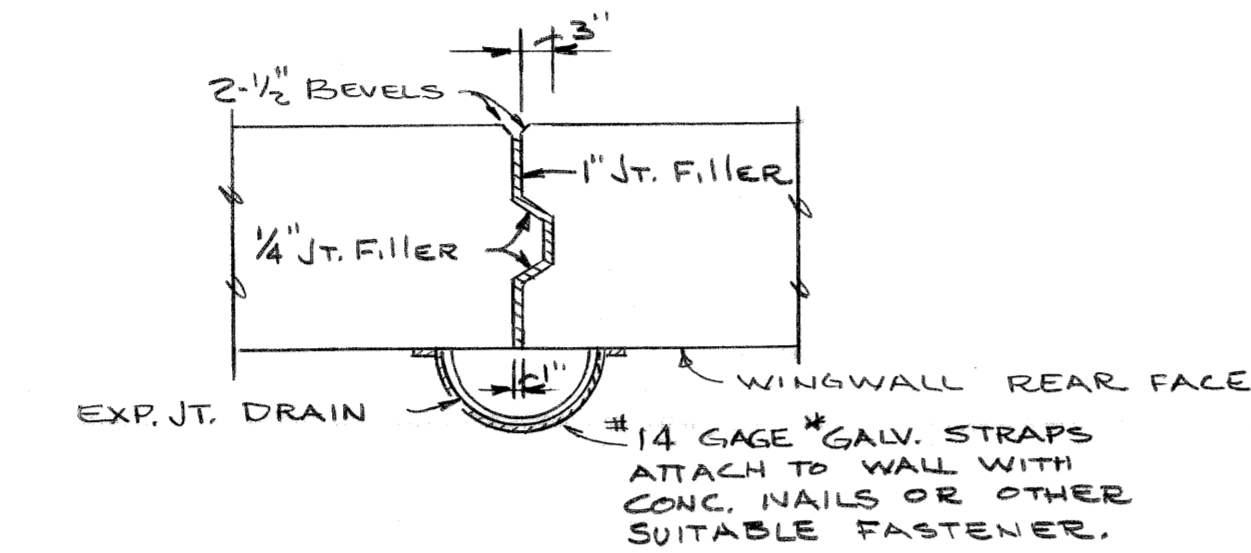


EXPANSION JOINT DETAIL AND SECTION Y-Y

12 GAGE PERFORMED STEEL OR ALUMINUM BULKHEAD SECURELY HELD IN PLACE. (NO TACK WELDING TO REINF. STEEL).

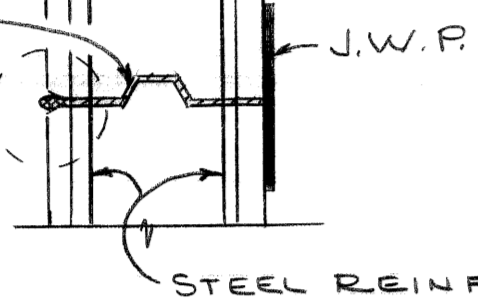


SECTION Z-Z

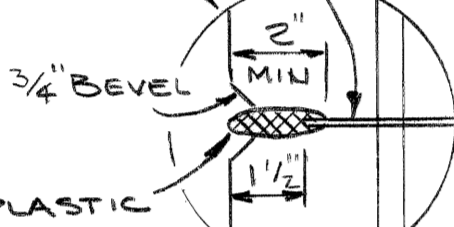


POLYVINYL PLASTIC EDGING (AS APPROVED BY THE ENGINEER)

THE METAL BULKHEAD MAY BE USED AS AN ALTERNATE CONST. JT. AT CONTRACTOR'S EXPENSE. CARE IS TO BE USED IN CASTING CONC. AROUND BULKHEAD TO PREVENT DISLOCATION OR MISALIGNMENT OF BULKHEAD. CUT HOLES IN METAL BULKHEAD FOR REINF. STEEL.

METAL BULKHEAD FOR WALL STEM CONSTRUCTION JOINT

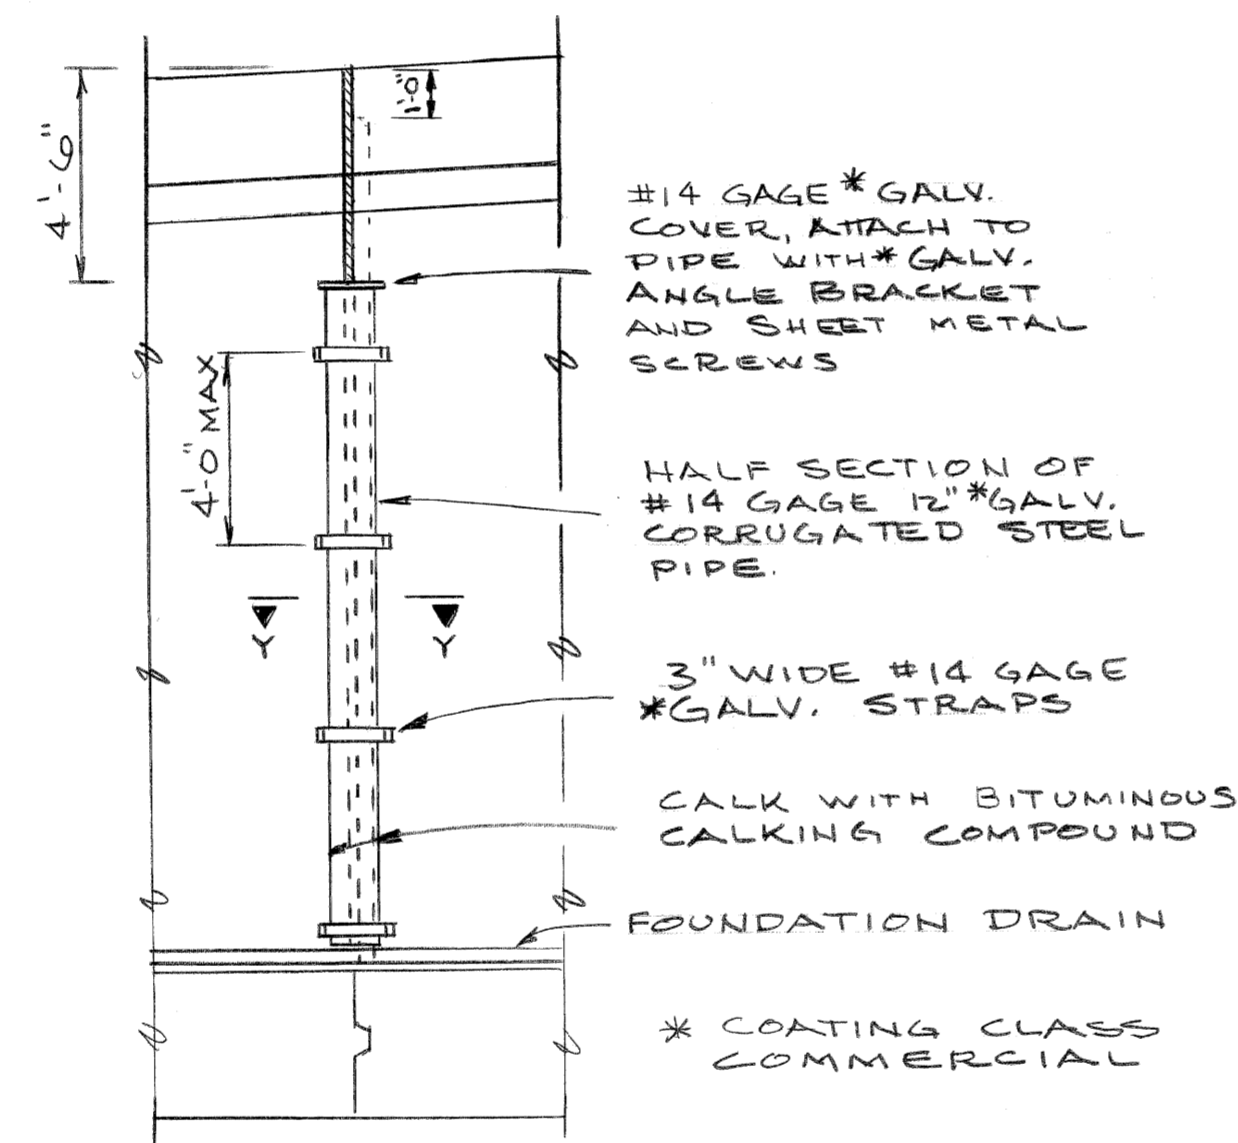


EXPANSION JOINT, DRAIN

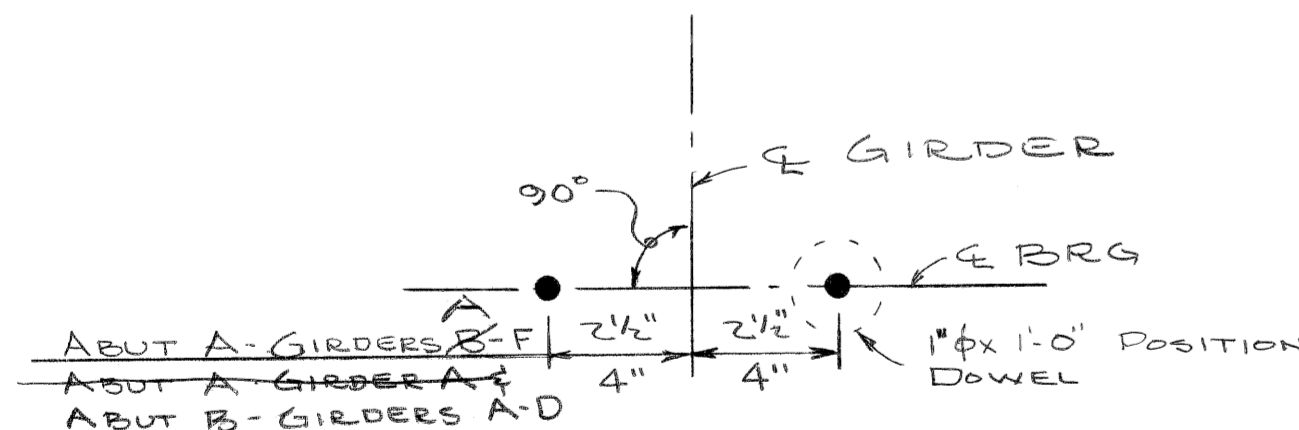


ABUT.	A	B	C	D	E	F
A	2 3/4"	2"	1 1/2"	1"	1"	1 1/2"
B	1"	2 1/2"	1"	1"	-	-

DETAIL C

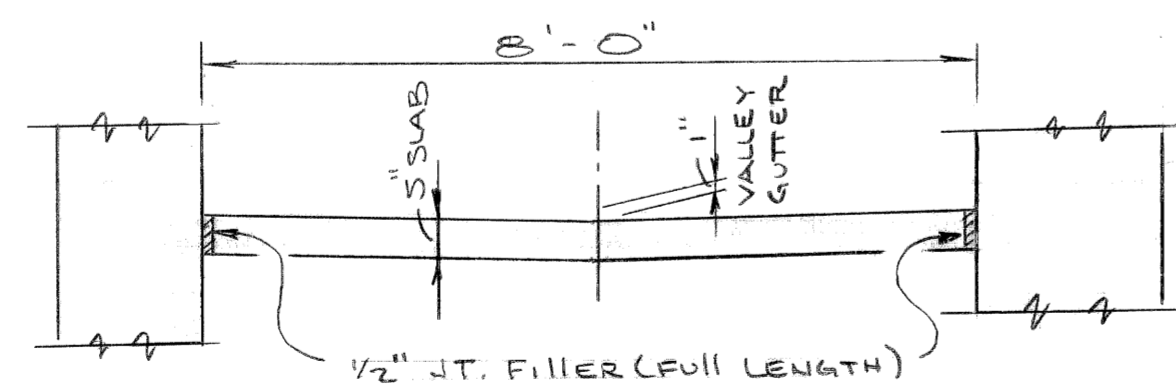

SECTION

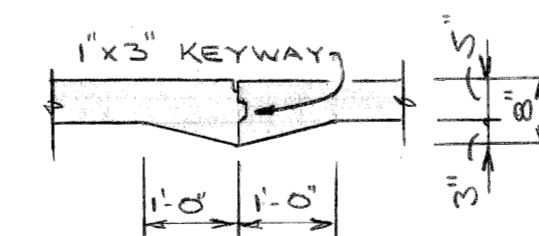

CONST. JT.

WALK DETAILS

SCALE: 1/2" = 1'-0"

PAY QUANTITIES

PAY ITEM	ABUT. A	ABUT. B	TOTAL	UNIT
UNCLASSIFIED FOUNDATION EXCAV.	1548	690	2238	CY
STRUCTURE BACKFILL (CIP)	1791	1039	2830	CY
CONCRETE GRADE X	3	-	3	CY
SUBSTRUCTURE CONCRETE	1032.2	780.6	1812.8	CY
STEEL REINFORCEMENT	67,572	102,556	170,128	LBS
LOW TEMP. PROT. - SUBSTR. CONC.	1032.2	780.6	1812.8	CY
CLEAR PROT. COATING - SUBSTR. CONC.	487	339	826	S.F.
EXPANSION JOINT DRAIN	9	8	17	EA
JOINT WATERPROOFING	282	191	473	SF
8" CLASS A SEWER - TRENCH DETAIL	60	23	83	LF
48" BULKHEAD	2	2	4	EA
FOUNDATION DRAINS 6"	571	837	1408	LF
5" CONCRETE SIDEWALK	1165	-	1165	SF

CONCRETE QUANTITIES

POUR	ABUTMENT A				ABUTMENT B			
	SH.	DISC.	C.Y.	POUR	SH.	DISC.	C.Y.	
A-1	S-19	ABUT. FTG.	118.7	B-1	S-20	ABUT. FTG.	69.4	
A-2	S-19	ABUT. WALL	22.6	B-2	S-20	ABUT. WALL	14.1	
A-3	S-19	ABUT. WALL	20.4	B-3	S-20	ABUT. WALL	15.6	
A-4	S-24	WALL	1.6	B-4	S-25	WALL	1.6	
A-5	S-23	WALL	1.4	B-5	S-25	WALL	1.6	
A-6	S-23	WALL	19.4	B-6	S-25	WALL	28.8	
A-7	S-23	FTG.	31.1	B-7	S-25	WALL	28.9	
A-8	S-23	FTG.	43.3	B-8	S-25	FTG.	14.2	
A-9	S-23	FTG.	39.1	B-9	S-25	FTG.	14.2	
A-10	S-23	WALL	26.9	B-10	S-25	FTG.	21.3	
A-11	S-23	WALL	26.7	B-11	S-25	FTG.	20.9	
A-12	S-23	WALL	15.2	B-12	S-25	WALL	29.0	
A-13	S-23	WALL	21.7	B-13	S-25	WALL	29.1	
A-14	S-23	WALL	20.9	B-14	S-25	WALL	26.5	
A-15	S-22	FTG.	18.2	B-15	S-25	WALL	26.4	
A-16	S-22	FTG.	21.3	B-16	S-25	WALL	24.1	
A-17	S-22	FTG.	15.2	B-17	S-25	WALL	23.4	
A-18	S-22	WALL	18.2	B-18	S-25	WALL	21.5	
A-19	S-22	WALL	11.1	B-19	S-25	WALL	21.0	
A-20	S-22	WALL	15.5	B-20	S-25	WALL	19.1	
A-21	S-22	WALL	14.3	B-21	S-25	WALL	19.0	
A-22	S-22	WALL	6.6	B-22	S-26	FTG.	21.3	
A-23	S-22	WALL	14.8	B-23	S-26	FTG.	21.3	
A-24	S-21	FTG.	9.3	B-24	S-26	FTG.	17.8	
A-25	S-21	FTG.	21.8	B-25	S-26	FTG.	17.8	
A-26	S-21	FTG.	20.1	B-26	S-26	WALL	16.8	
A-27	S-21	FTG.	15.4	B-27	S-26	WALL	16.8	
A-28	S-21	WALL	16.8	B-28	S-26	WALL	14.9	
A-29	S-21	WALL	20.7	B-29	S-26	WALL	14.9	
A-30	S-21	WALL	4	B-30	S-26	WALL	13.4	
A-31	S-21	WALL	25.7	B-31	S-26	WALL	13.3	
A-32	S-21	WALL	26.4	B-32	S-26	WALL	12.0	
A-33	S-21	WALL	29.8	B-33	S-26	WALL	12.1	
A-34	S-21	FTG.	8.1	B-34	S-26	WALL	10.1	
A-35	S-21	FTG.	15.1	B-35	S-26	WALL	10.1	
A-36	S-21	WALL	9.2	B-36	S-26	WALL	4.8	
A-37	S-21	WALL	13.0	B-37	S-26	WALL	4.8	
A-38	S-21	WALL	14.6	B-38	S-25	TIE 1	5.6	
A-39	S-21	WALL	16.0	B-39	S-25	TIE 2	5.6	
A-40	S-21	WALL	17.6	B-40	S-25	TIE 3	4.9	
A-41	S-21	TIE 24	1.7	B-41	S-25	TIE 4	4.9	
A-42	S-21	TIE 25	1.7	B-42	S-25	TIE 5	4.2	
A-43	S-21	TIE 26	1.7	B-43	S-25	TIE 6	4.2	
A-44	S-21	TIE 27	1.7	B-44	S-25	TIE 7	3.8	
A-45	S-21	TIE 28	1.0	B-45	S-25	TIE 8	3.8	
A-46	S-21	TIE 29	1.0	B-46	S-25	TIE 9	3.6	
A-47	S-21	TIE 30	1.0	B-47	S-25	TIE 10	3.6	
A-48	S-21	TIE 31	1.0	B-48	S-25	TIE 11	3.5	
A-49	S-21	TIE 32	1.0	B-49	S-25	TIE 12	3.5	
A-50	S-21	TIE 33	1.0	B-50	S-26	TIE 13	3.5	
A-51	S-21	PED WALK	14.8	B-51	S-26	TIE 14	3.5	
A-52	S-24	WALL	20.4	B-52	S-26	TIE 15	3.5	
A-53	S-24	FTG.	30.9	B-53	S-26	TIE 16	3.5	
A-54	S-24	FTG.	29.6	B-54	S-26	TIE 17	3.5	
A-55	S-24	FTG.	15.9	B-55	S-26	TIE 18	3.5	
A-56	S-24	WALL	30.3	B-56	S-26	TIE 19	3.3	
A-57	S-24	WALL	26.5	B-57	S-26	TIE 20	3.3	
A-58	S-24	WALL	20.6	B-58	S-26	TIE 21	3.3	
A-59	S-21	WALL	4.7	B-59	S-26	TIE 22	3.3	
A-60	S-21	SLAB	3.2	B-60	S-26	TIE 23	3.3	
SUB-TOTAL			10902	SUB-TOTAL			780.6	
GRAND TOTAL				GRAND TOTAL			11,830.8	

GENERAL NOTES:

J.W.P. DENOTES JOINT WATERPROOFING

N.S. DENOTES NEAR SIDE

F.S. DENOTES FAR SIDE

E.F. DENOTES EACH FACE

FOR PILE LAYOUT, QUANT. & NOTES, SEE S-26.

REMOVAL OF PORTIONS OF EXISTING SUBSTRUCTURE WITHIN THE OUTLINE OF THE FOUND. EXCAVATION AND BETWEEN GROUND ELEV. AND BOT. OF PROP. EXCAVATION IS INCLUDED IN QUANTITY "UNCL. EXC." REMOVAL OF ALL OTHER PORTIONS OF THE EXISTING WATER MAINS, SEWERS & STRUCTURES IS INCLUDED IN THE ITEM "REMOVAL OF PORTIONS OF STRUCTURES".

THE EXPOSED FACES OF THE ABUTMENTS AND RETAINING WALLS SHALL HAVE SPECIAL ARCHITECTURAL TREATMENT IN ACCORDANCE WITH SECTION 5.03.06(C) OF THE STANDARD SPECIFICATIONS.

"CLEAR PROTECTIVE COATING FOR SUBSTRUCTURE CONCRETE" IS TO BE APPLIED TO THE BRIDGE SEAT AND FRONT FACE OF THE ABUTMENTS BETWEEN FASCIA LINES TO 6" BELOW FINISHED GROUND LINE.

FOUR DESIGNATIONS SHALL NOT BE CONSTRUED AS A REQUIRED FOUR SEQUENCE.

1", 1/2" AND 1/4" JOINT FILLER ARE INCIDENTAL TO "SUBSTRUCTURE CONC."

"SELECTED EXCAVATED MATERIAL" IS INCIDENTAL TO "UNCLAS. FOUNDATION EXCAVATION".

BUILD WALLS ON THE CURVES. FOOTINGS MAY BE BUILT ON A MAXIMUM OF 25' CHORDS.

THE CONTRACTOR SHALL SUBMIT COMPLETE SHOP DRAWINGS OF THE REINFORCING STEEL FOR APPROVAL BY THE ENGINEER IN ACCORDANCE WITH THE SPECIAL PROVISIONS.


CAST IRON PIPES AND FITTINGS SHALL BE USED FOR FOUNDATION DRAIN CLEANOUTS AND PASSAGE THROUGH WALLS OR FOOTINGS. ENDS OF CLEANOUTS SHALL HAVE A THREADED BRASS PLUG. ALL INCIDENTAL TO "FOUNDATION DRAIN 6" ADJUST RESTER AS NEC.

FOUR TOES AGAINST UNDISTURBED SOIL WHERE SHOWN ON DRAWINGS. NO ALLOWANCE WILL BE MADE IN CONCRETE QUANTITIES DUE TO EXCAVATION OUTSIDE OF THE FOOTING NEAT LINES.


ADJUST ABUTMENT WALL RESTEEL TO MISS THE POSITION DOWELS.

DESIGNED BY		APPROVED:		CITY OF DETROIT		JOHN C. LODGE EXIT RAMP AND JEFFERSON AVE		SHEET _____ OF _____ SHEETS	
DRAWN BY		STRUCTURAL ENGINEER		CITY ENGINEERING DIVISION - EPMD		RECONSTRUCTION AT THE JOE LOUIS ARENA		CONTRACT NO. 16563A	
TRACED BY						RAMP - ABUTMENTS AND WINGWALLS		DRAWG NO. S-27	
CHECKED BY						MISC. DETAILS, NOTES AND QUANTITIES		DATE AUG 1979	


*NOTE: SET UPPER SPICE SECTION IN PLACE WITH UPPER SPICE PLATES ATTACHED, TAP SEVERAL TIMES WITH THE HAMMER TO IMPROVE BEARING CONTACT THEN COMPLETE WELDING OF PLATES TO LOWER SECTION.

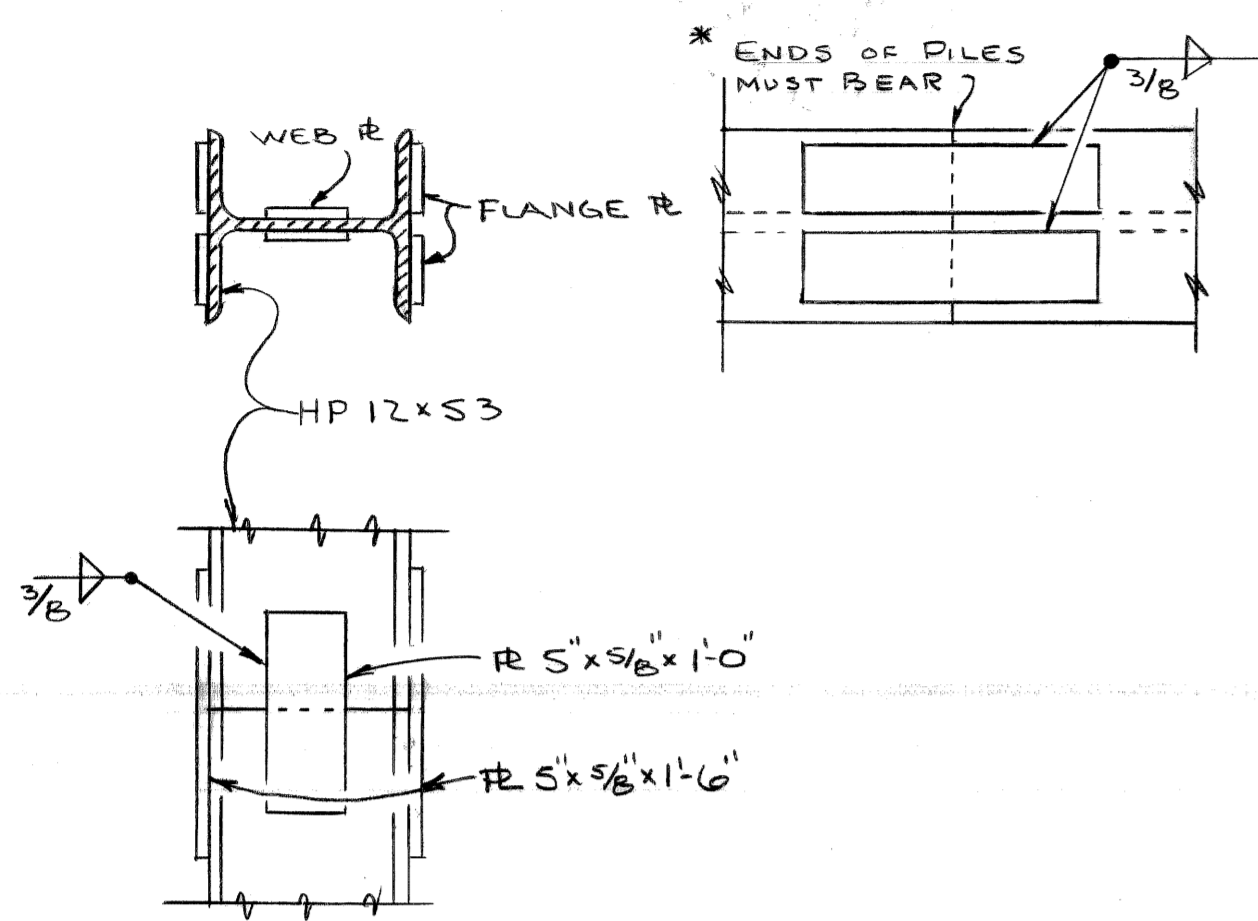


— SPICE DETAILS —

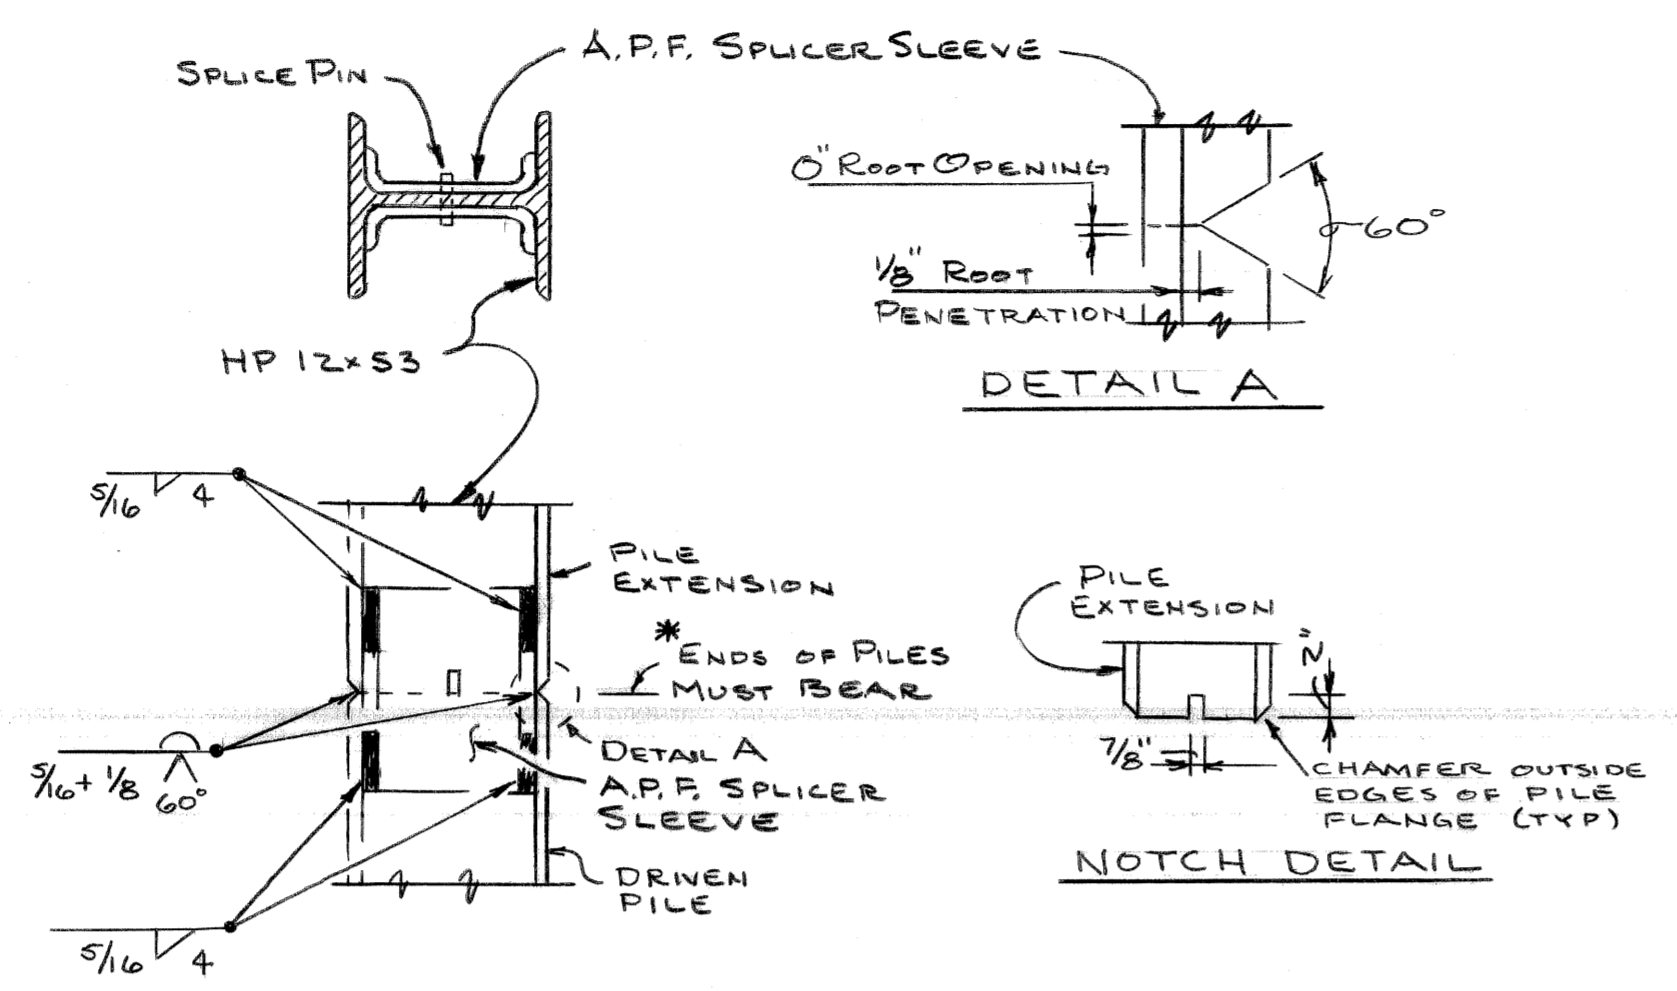

— ALTERNATE SPICE DETAILS —
(A.P.F. - ASSOCIATED PIPE & FITTING CO.)

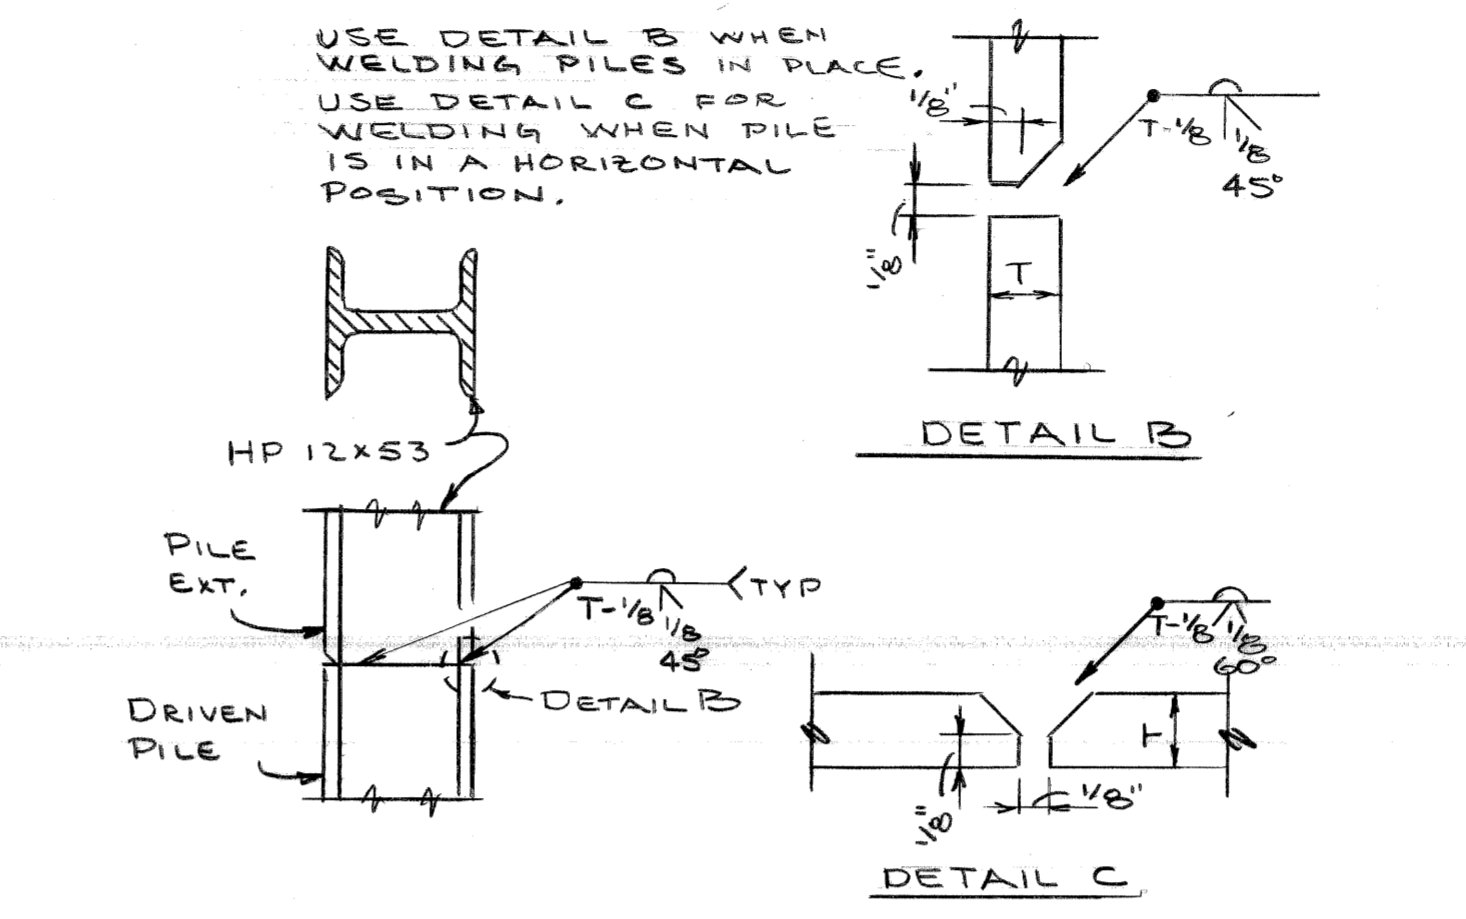

— BUTT WELD SPICE DETAIL —

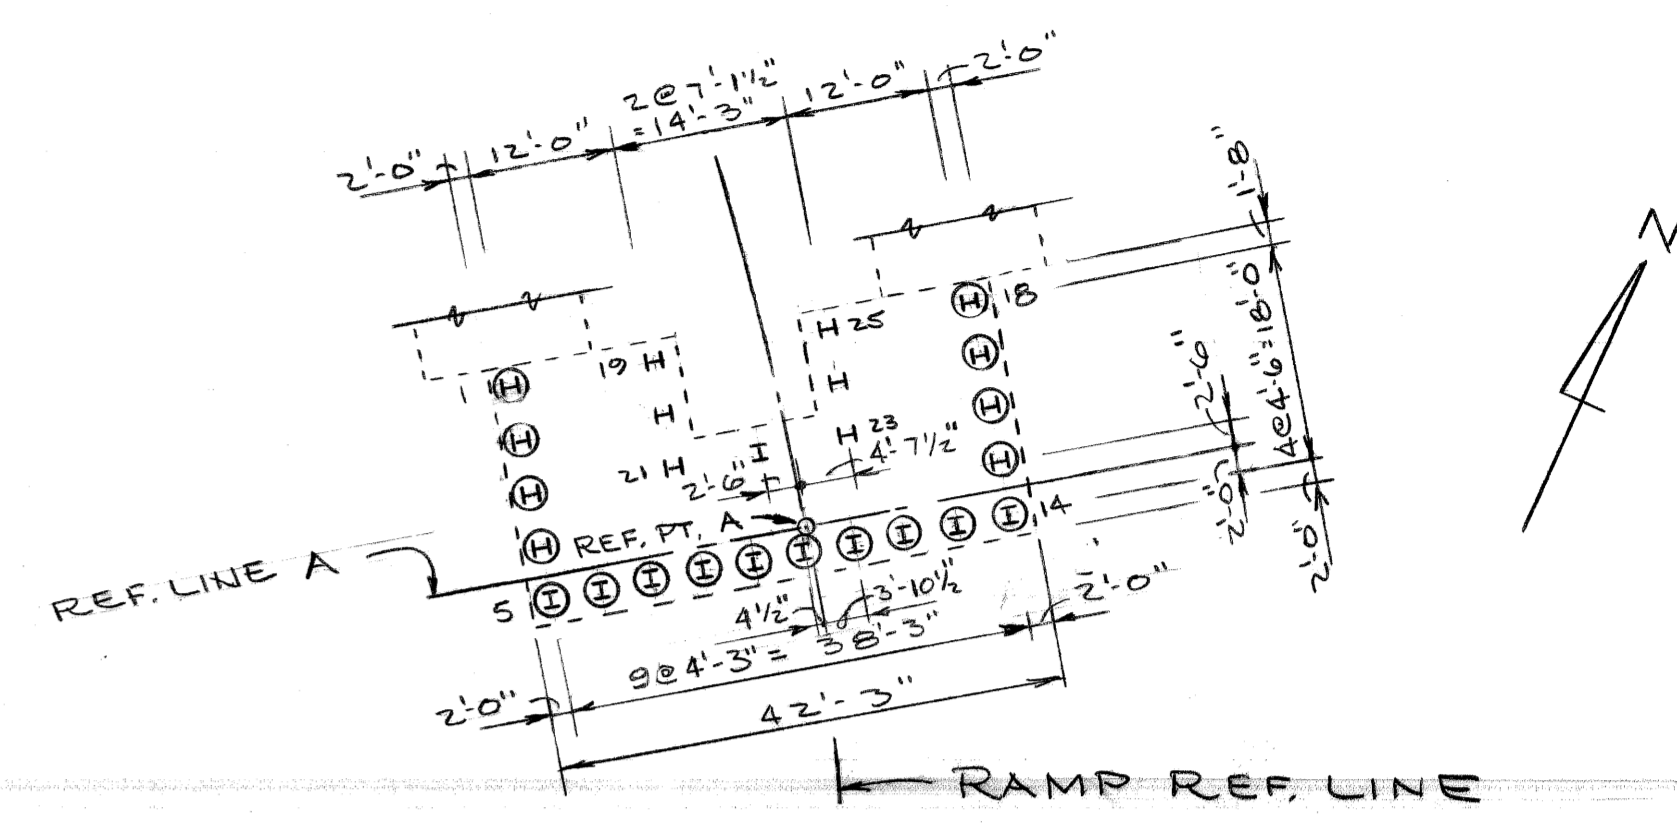

— PLAN AT ABUTMENT A —
SCALE: 1/16" = 1'-0"

— GENERAL NOTES —

ALL H-PILES SHALL BE DRIVEN TO A MINIMUM BEARING CAPACITY OF 60 TONS IN ACCORDANCE WITH M.D.O.T. STANDARD SPECIFICATIONS

STEEL H-PILES SHALL BE HP 12x53

PREBORE PILES 13 THRU 18 TO EL 80.0 (MIN.)

PREBORE PILES 26 THRU 30, 33 THRU 35 AND 59 THRU 80 TO ELEV 65.0 (MIN.)

VOIDS AROUND PILES SHALL BE BACKFILLED BY SLUICING AND/OR JETTING SAND AS REQ.


PREBORING AND BACKFILLING ARE INCIDENTAL TO "STEEL PILES, FURN. & DRIVEN (12')"

PILE CUT-OFF ELEV.
ABUT A = 58.75
ABUT B = 56.75

ESTIMATED BOTTOM OF PILE ELEV = +2.0

⊕ DENOTES BATTERED PILE - SEE GEN. PLAN OF STR. SECTIONS C, D & G ON S-14 & 15 FOR PILE BATTER.



TEST PILES WILL NOT BE REQUIRED FOR THIS PROJECT

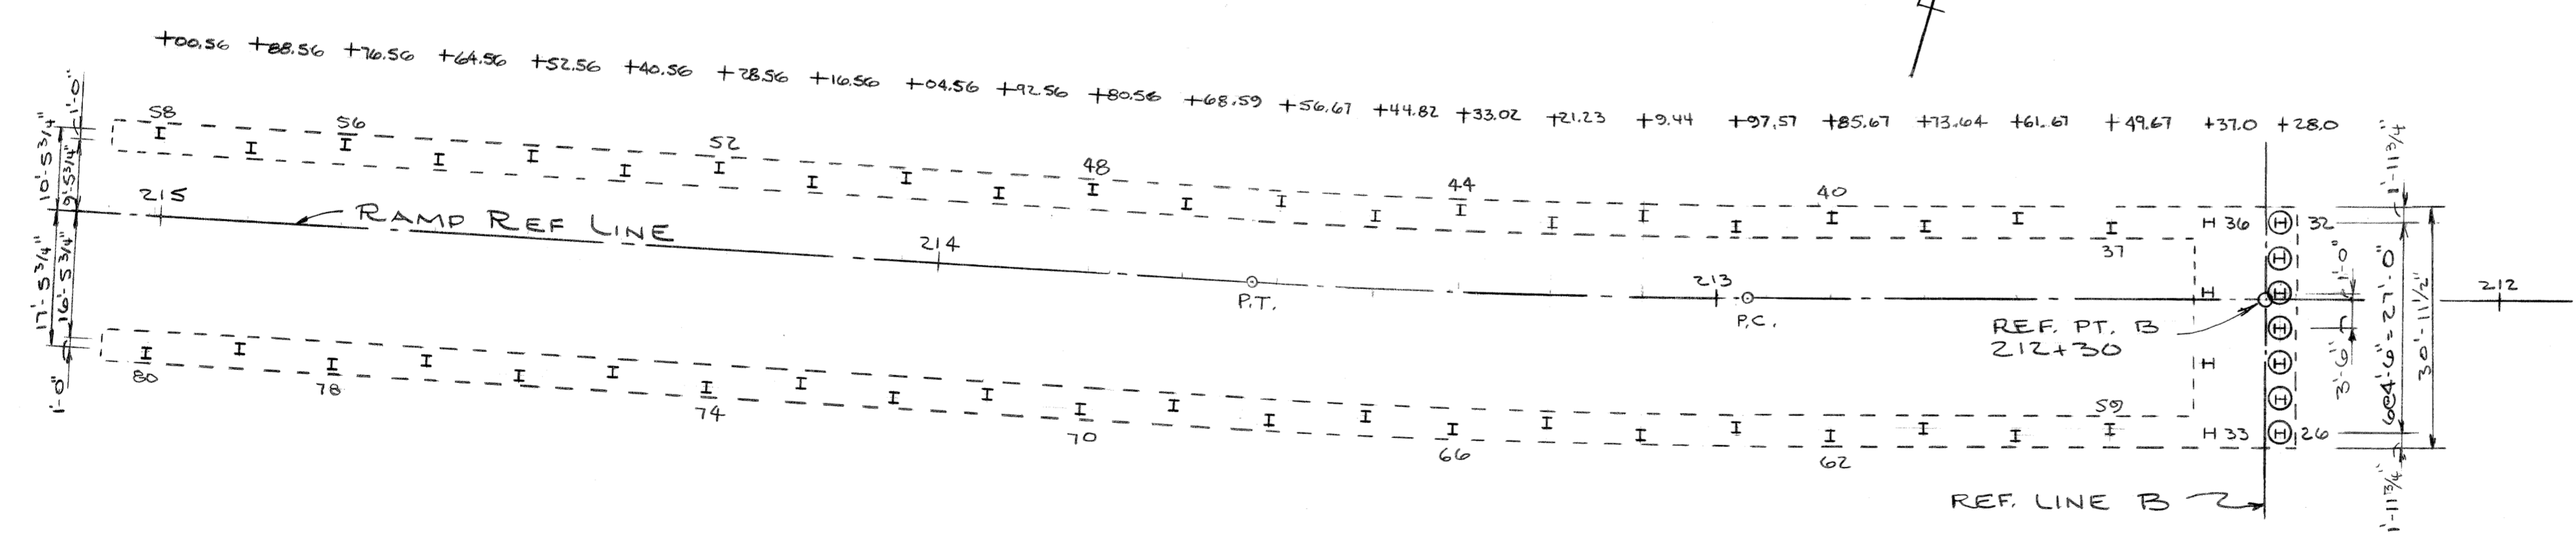

— PLAN AT ABUTMENT B —
SCALE: 1/16" = 1'-0"

PILE QUANTITIES				
ITEM	UNIT	AMOUNT		
		ABUT. A	ABUT. B	TOTAL
LENGTH OF EA. PILE FURN. & DRIVEN (EST.)	L.F.	9675'	9475'	-
STEEL PILES - FURN. & DRIVEN (12')	EA.	2530	2554	5084
	L.F.	2419'	5211'	7630'
SPICES STEEL PILES (12')	EA.	59	128	187

DESIGNED BY: <i>R. K. ...</i> DRAWN BY: <i>R. K. ...</i> TRACED BY: <i>-</i> CHECKED BY: <i>J. M. ...</i>		APPROVED: STRUCTURAL ENGINEER	CITY OF DETROIT CITY ENGINEERING DIVISION - EPMD	JOHN C LODGE EXIT RAMP AND JEFFERSON AVE RECONSTRUCTION AT THE JOE LOUIS ARENA RAMP - 60 TON H-PILES PLAN AND DETAILS	SHEET <u> </u> OF <u> </u> SHEETS CONTRACT NO. 16563A DRWG NO. S-28 DATE AUG 1979
--	--	----------------------------------	---	--	--

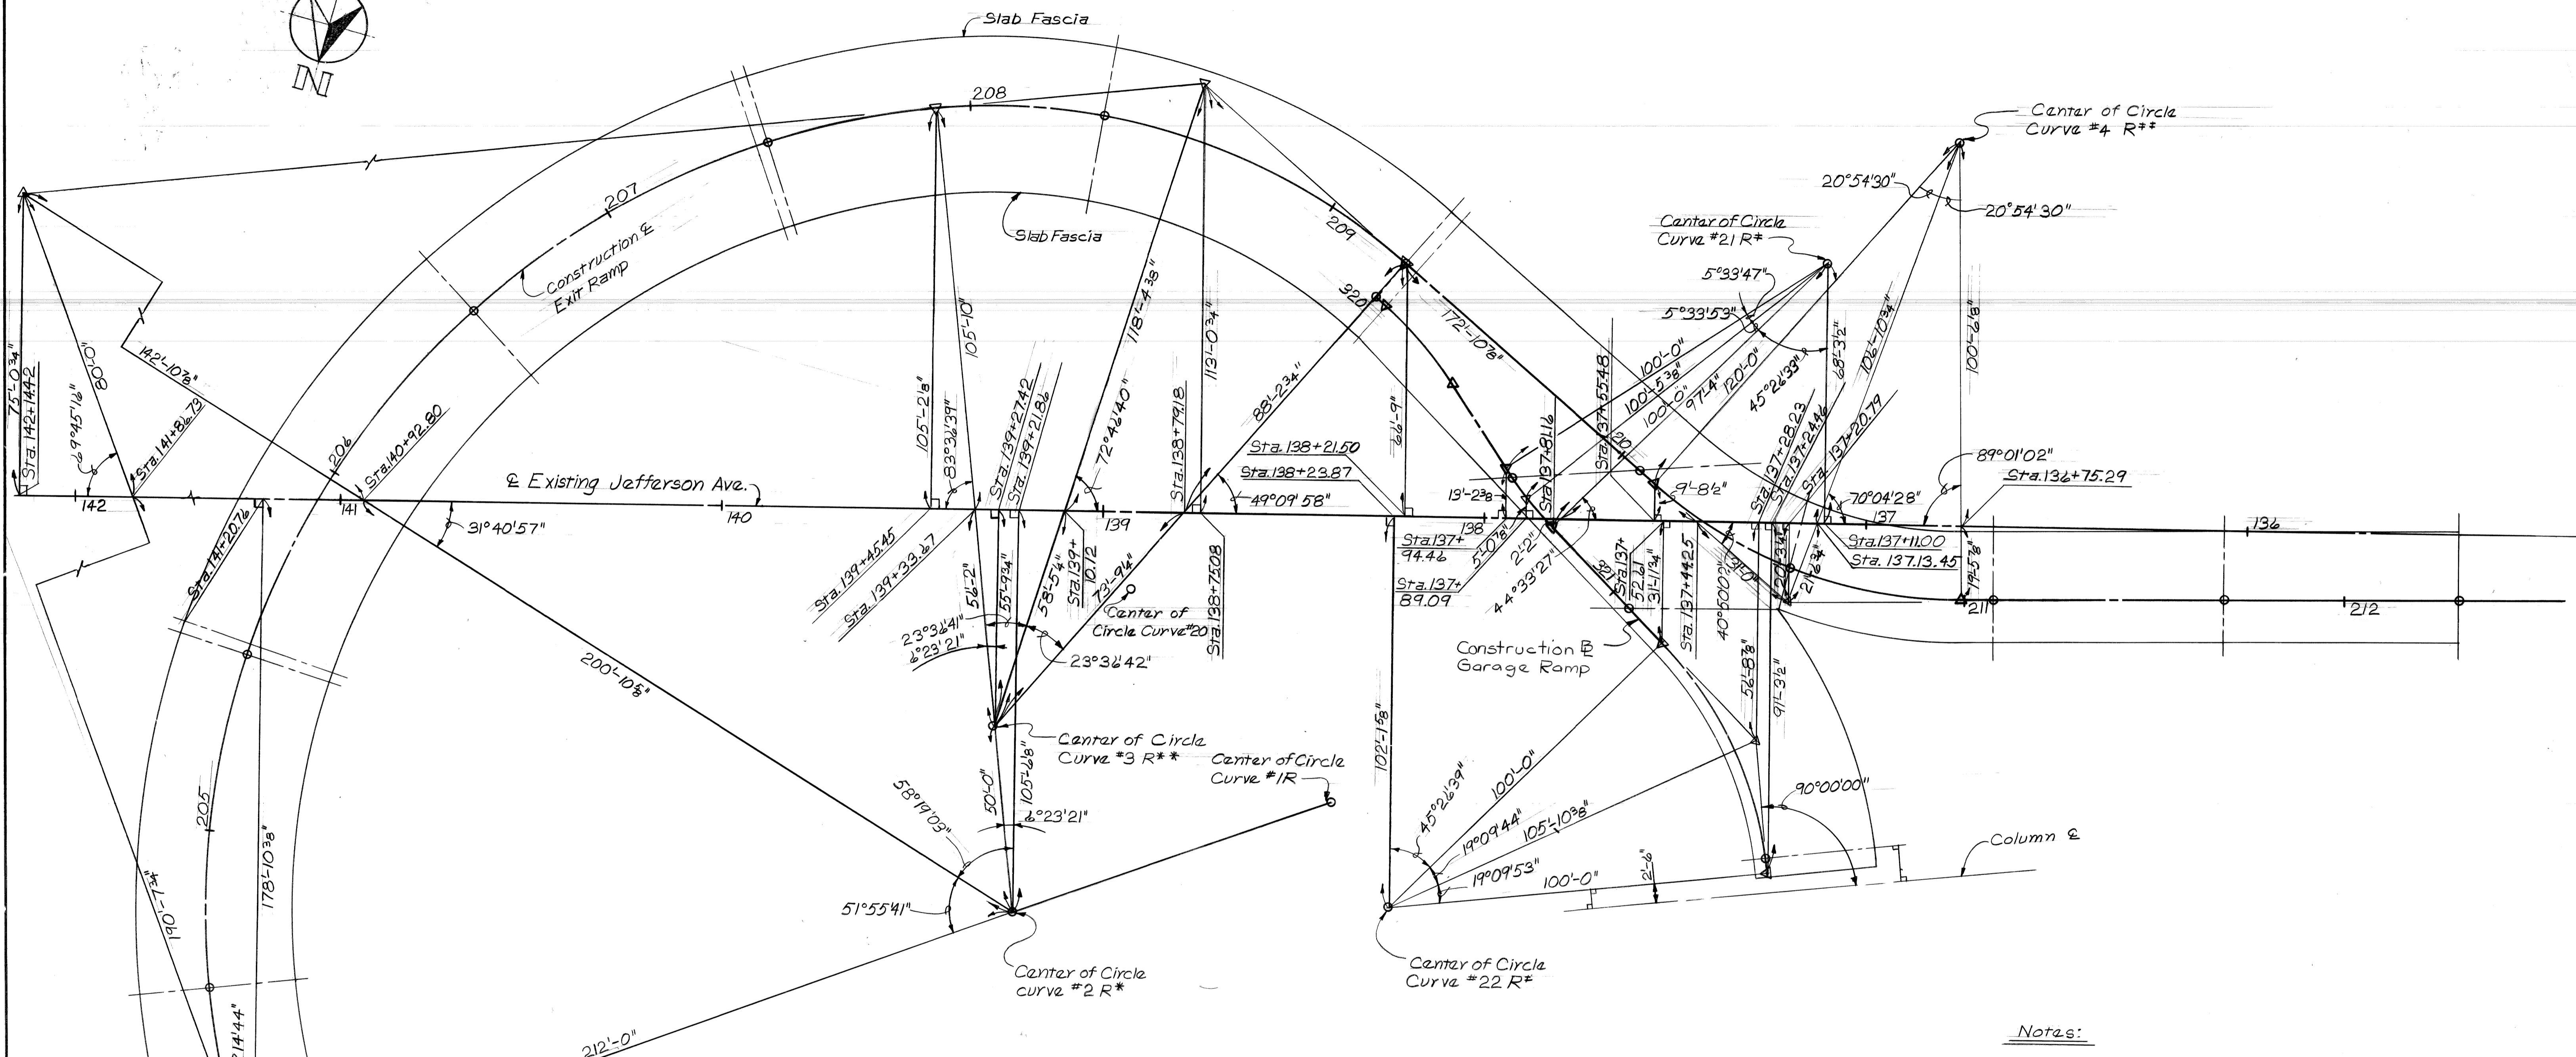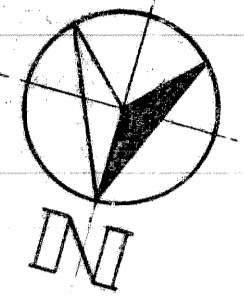

STAKE OUT DIAGRAM

- Notes:**
- * 212'-0" Radius to Construction & Exit Ramp.
 - ** 162'-0" Radius to Construction & Exit Ramp
 - + 100'-0" Radius to Construction & Garage Ramp
 - # 120'-0" Radius to Construction & Exit Ramp

The Joe Louis Sports Arena Parking Garage shall be checked at the time of starting construction on the John C. Lodge Exit Ramp, to see that its relationship to the proposed work is as shown on these plans. Any discrepancies requiring changes in the new work shall be reported to the Engineer immediately. All layout work shall be discontinued until the discrepancies are resolved.

The proposed Joe Louis Sports Arena Parking Garage floor elevations shall be checked at the location of the Exit Ramp, as soon as possible, to ensure proper vertical alignment as shown on these plans. Any discrepancies shall be promptly reported to the Engineer. Should a discrepancy be found all work in the vicinity of the Garage shall be discontinued until notified by the Engineer to proceed.

DATE: August, 1979

Work This Sheet With Sheets # S30 & S31

DSGN BY:	SJP
DRN BY:	SJP & DE
CK'D BY:	CA
APP'D BY:	

REVISIONS	



CITY OF DETROIT, MICHIGAN



JOHN C. LODGE EXIT RAMP AND JEFFERSON AVENUE
RECONSTRUCTED AT THE JOE LOUIS ARENA.

STAKE OUT DIAGRAM
CURVE LAYOUT

SCALE: NONE
DRN. NO: S29

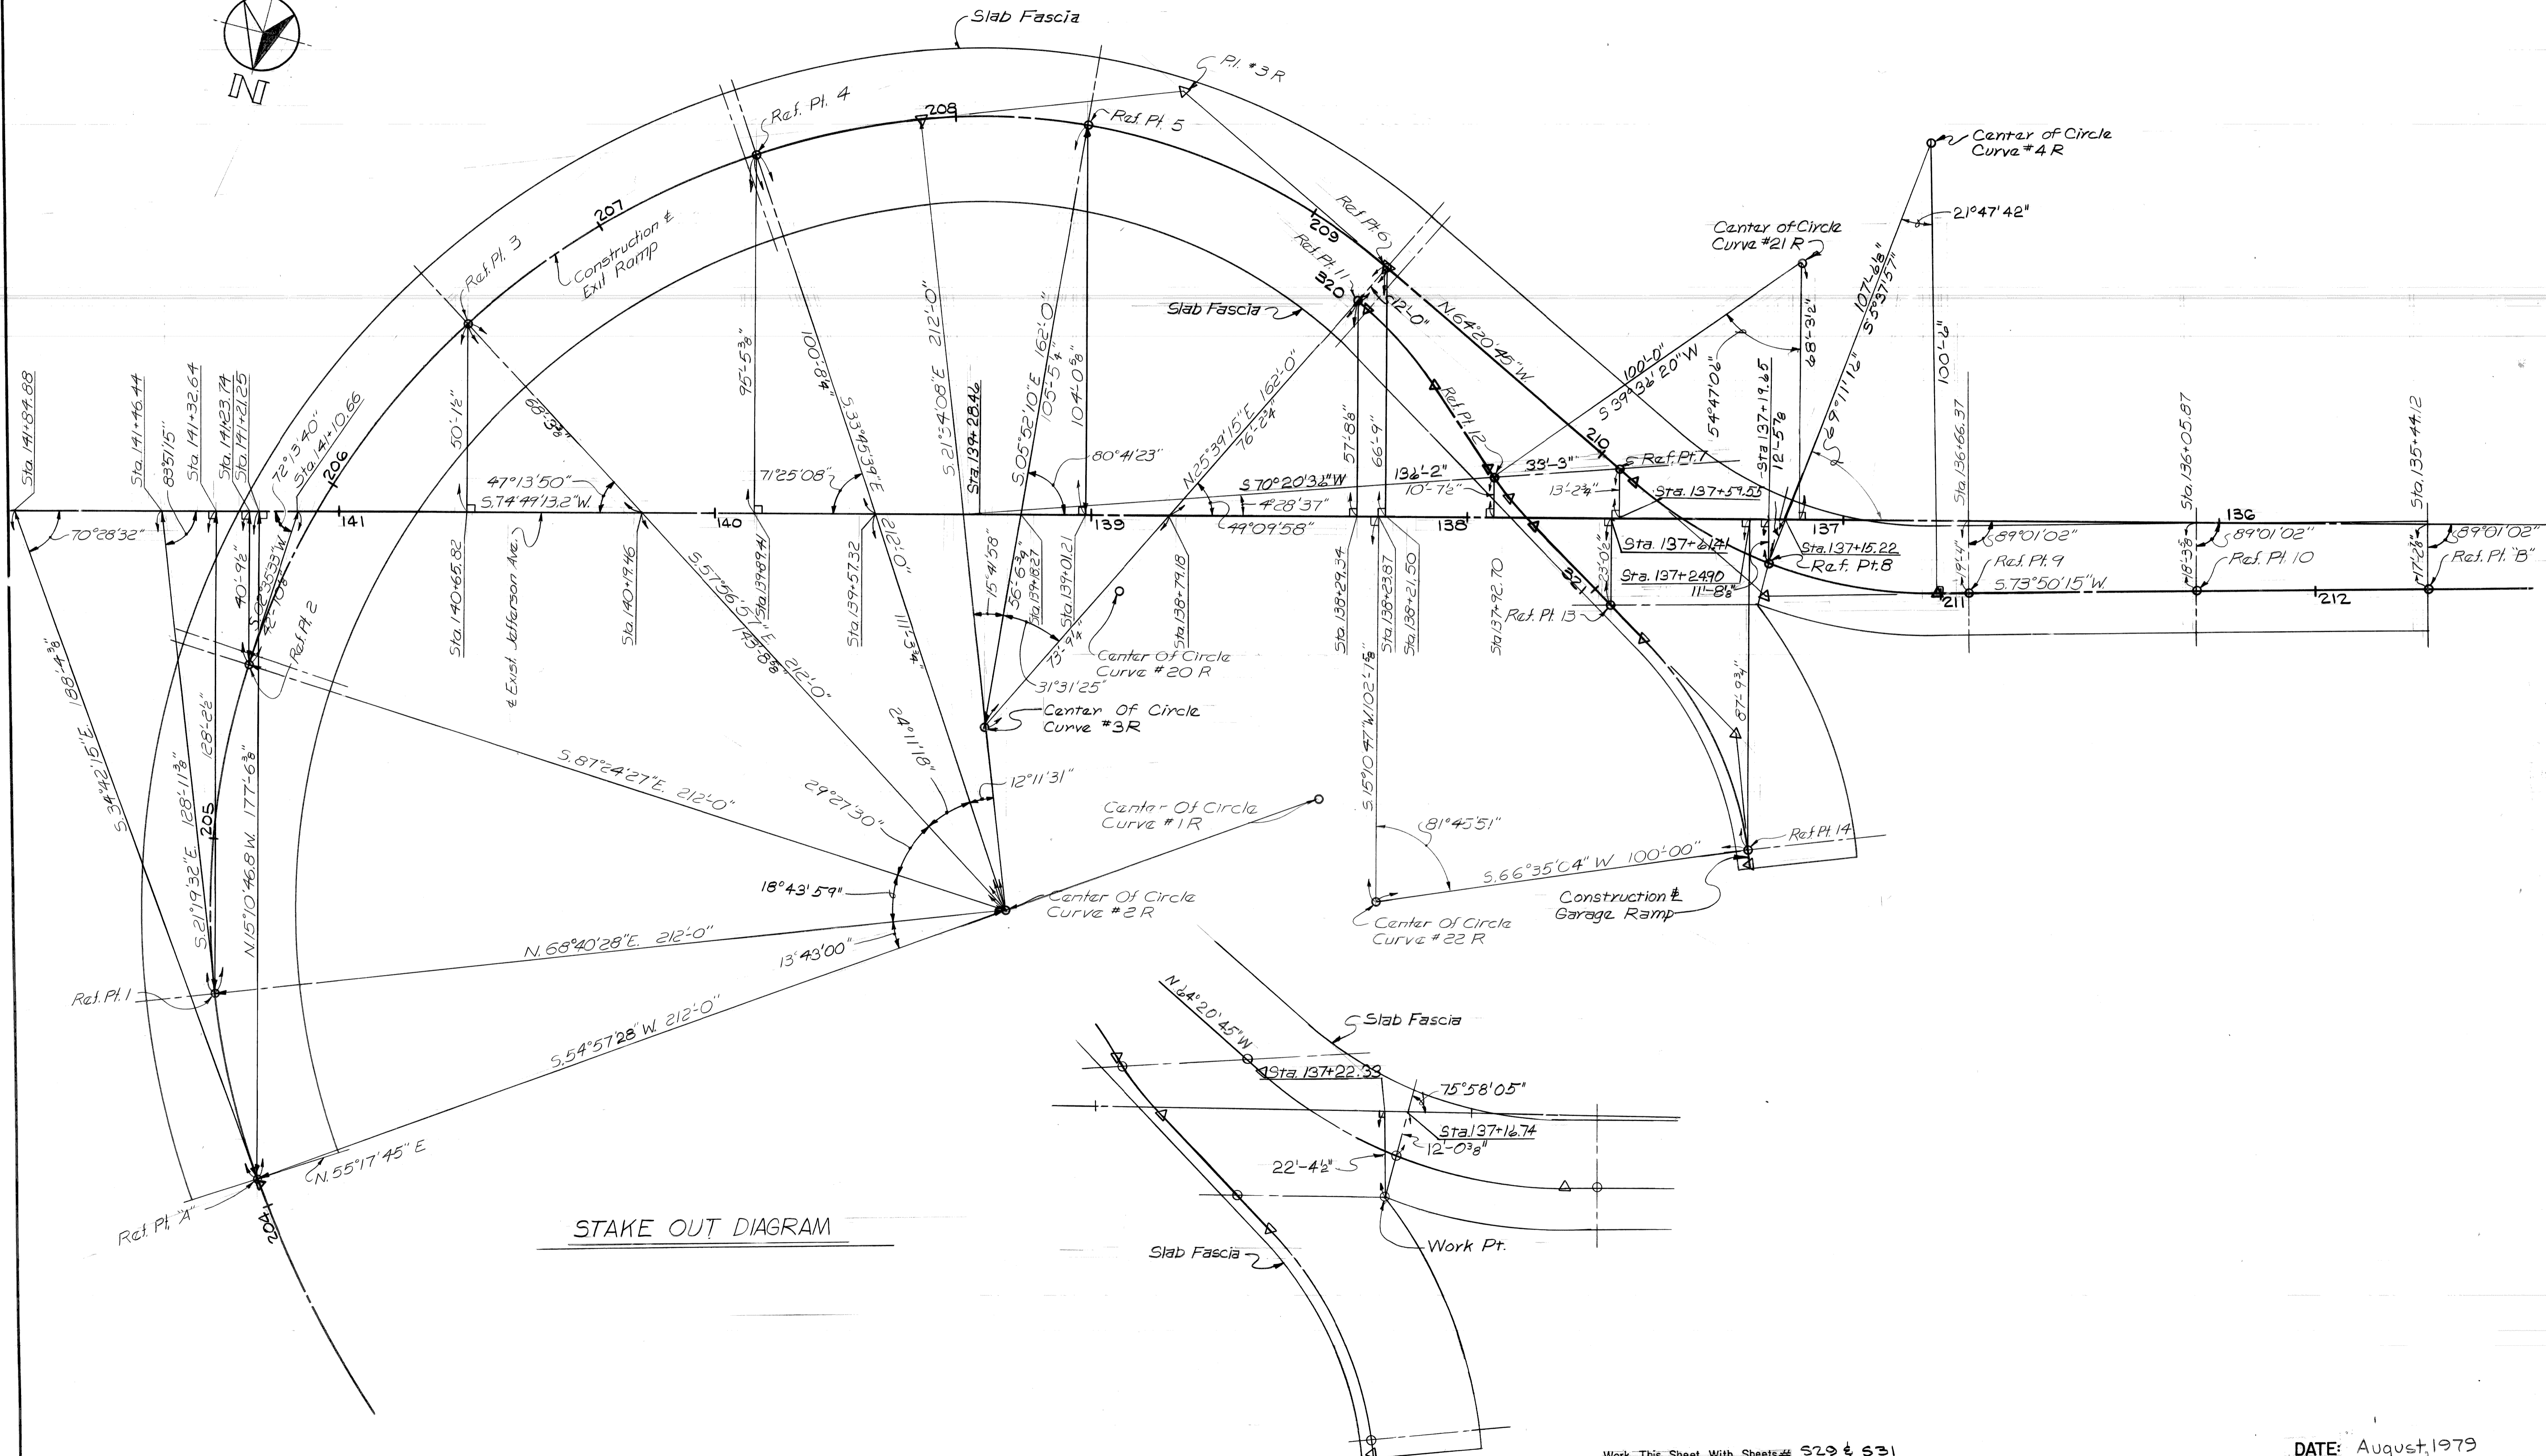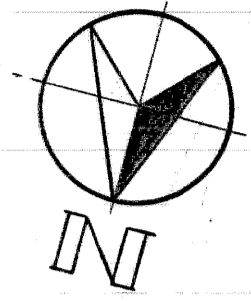

STAKE OUT DIAGRAM


Work This Sheet With Sheets# S29 & S31

DATE: August, 1979

DESIGNED BY:	SJP
DRAWN BY:	SJP/DE
CHECKED BY:	CA
APP'D BY:	

REVISIONS	


CITY OF DETROIT, MICHIGAN

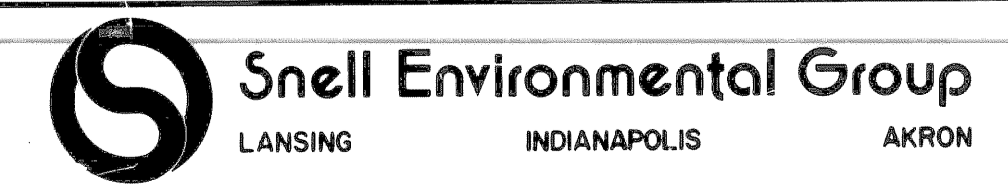

JOHN C. LODGE EXIT RAMP AND JEFFERSON AVENUE - RECONSTRUCTED AT THE JOE LOUIS ARENA

STAKE OUT DIAGRAM
REFERENCE POINT LAYOUT


SCALE: NONE
DRN. NO: S30

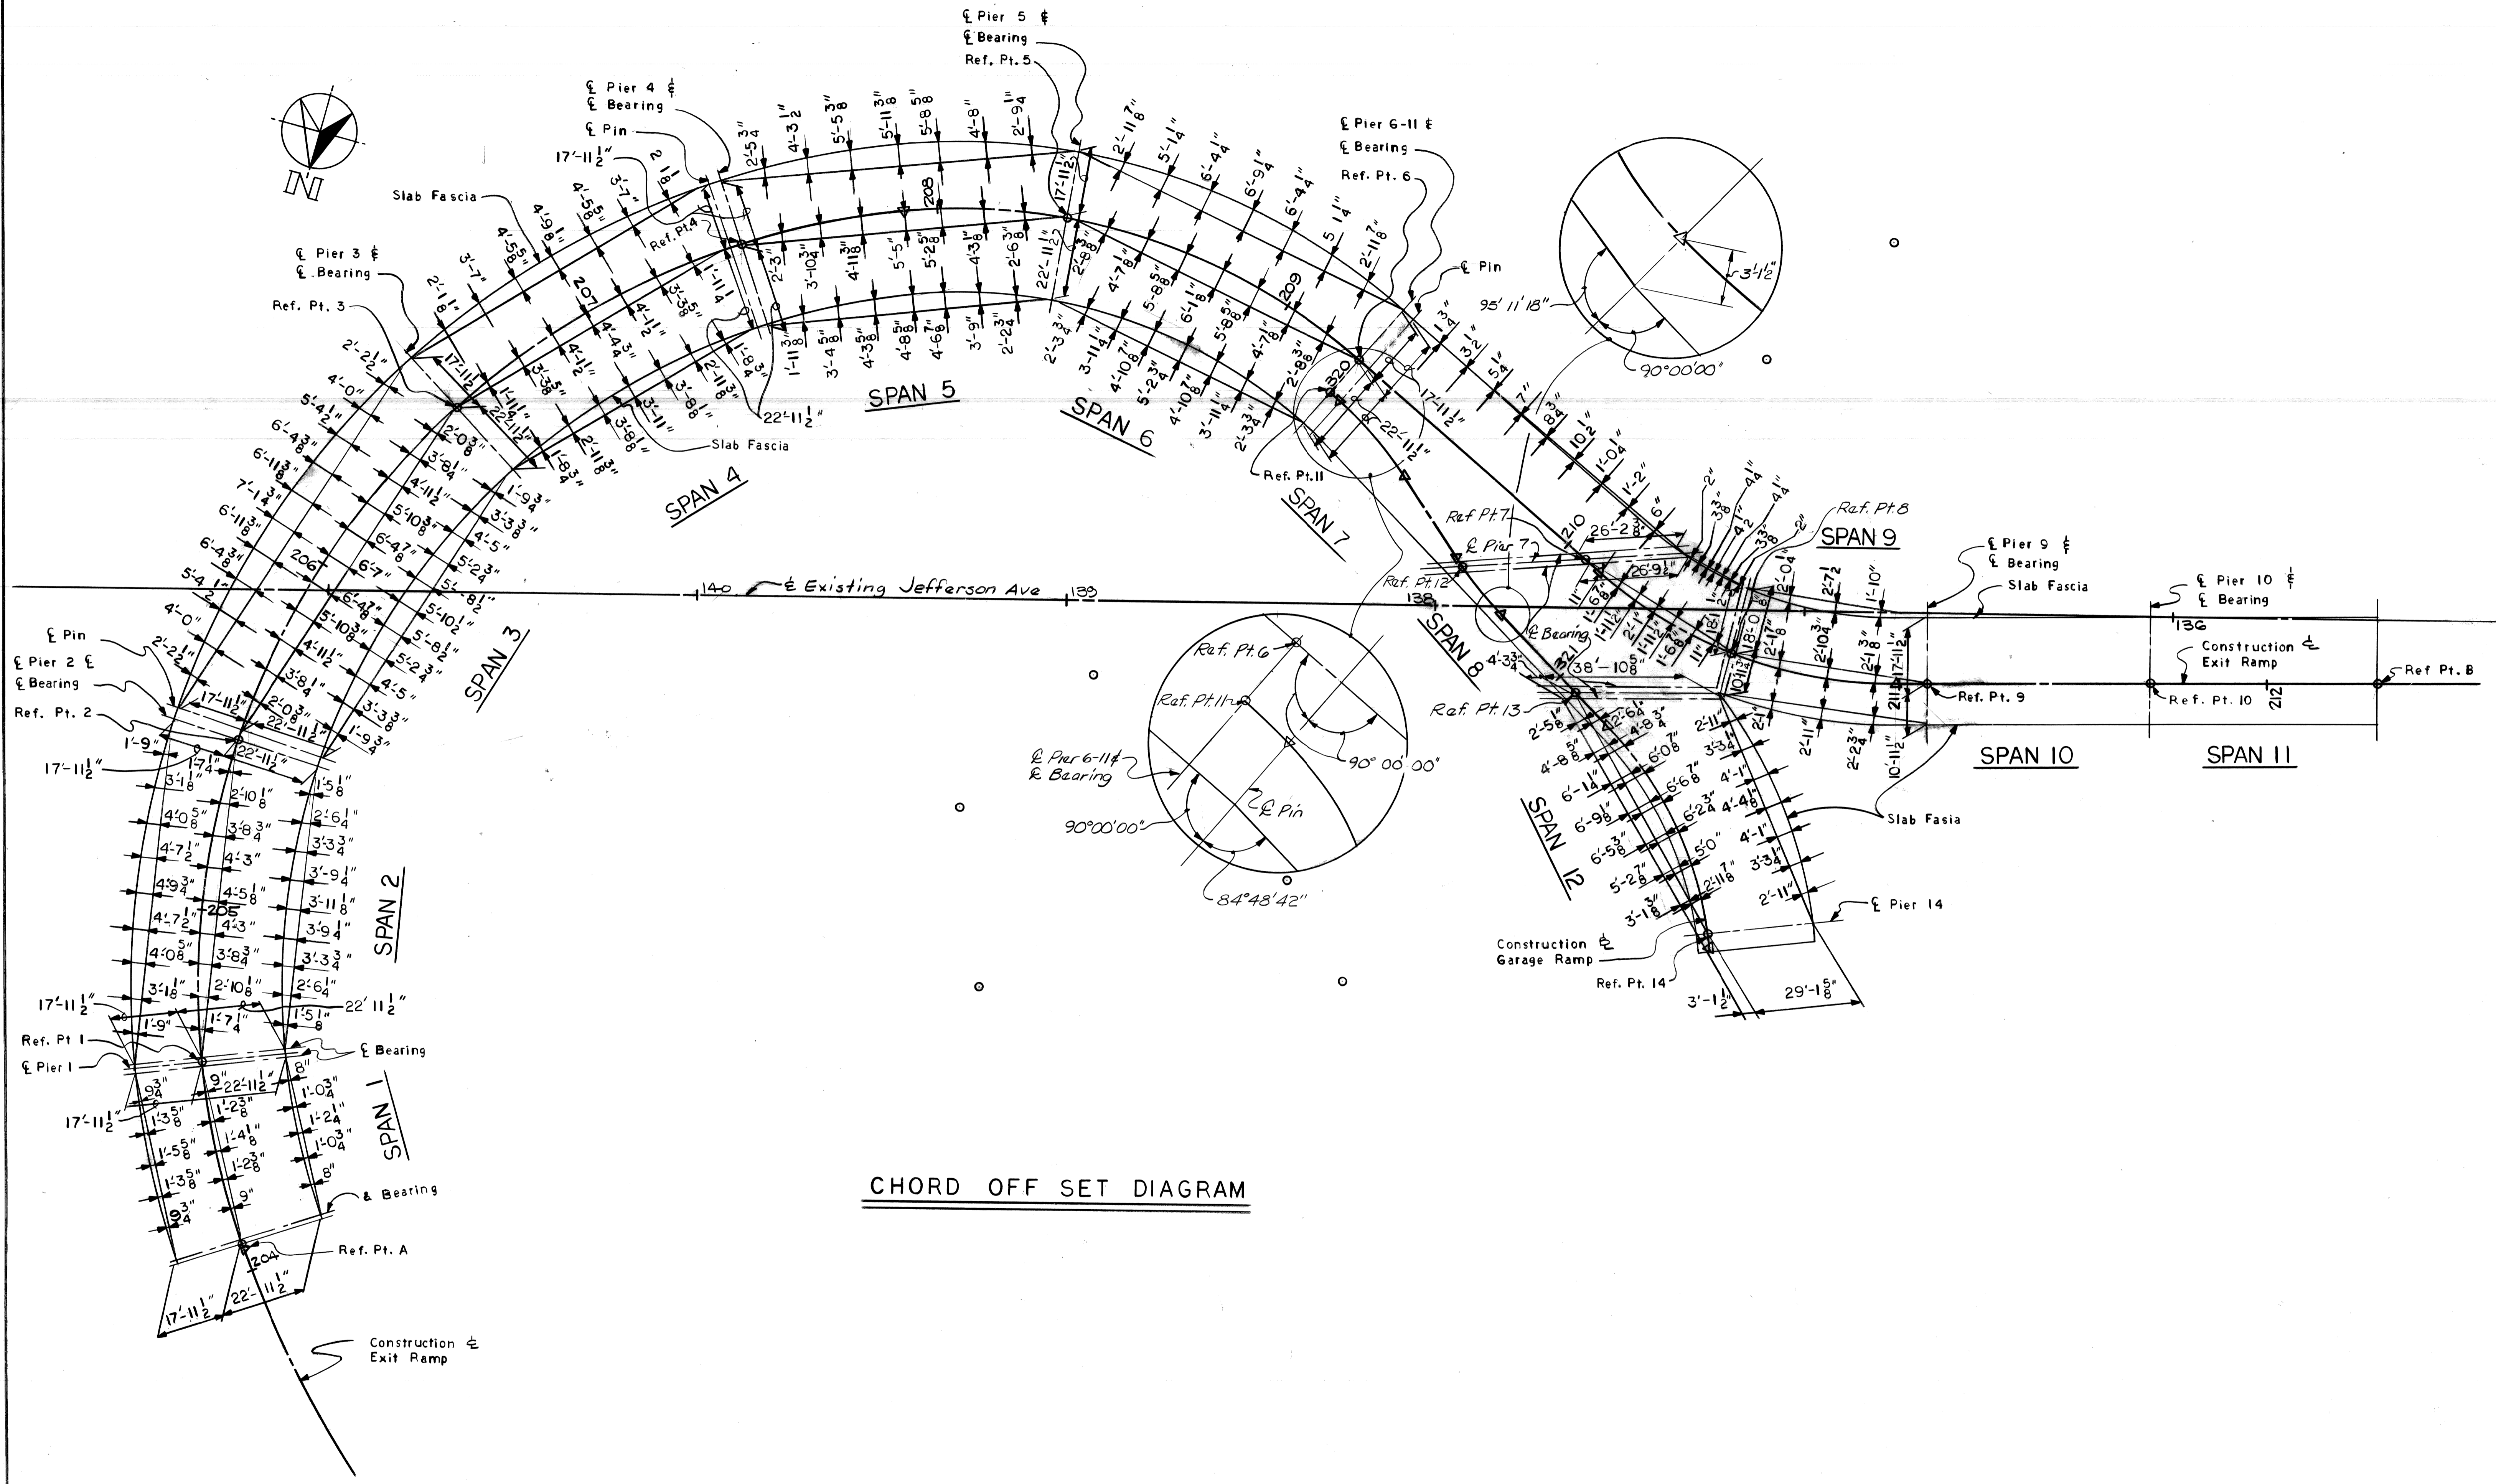

DSGN BY:	SJPRGW
DRW BY:	SJP, CA
CK'D BY:	SJP, CA
APP'D BY:	

REVISIONS	

CITY OF DETROIT, MICHIGAN

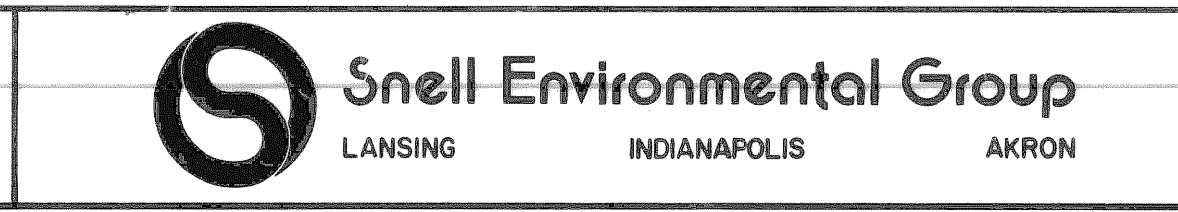

Work This Sheet With Sheets # 629 & 630



JOHN C. LODGE EXIT RAMP AND JEFFERSON AVENUE RECONSTRUCTION AT THE JOE LOUIS ARENA.

STAKE OUT DIAGRAM
CHORD OFF-SETS

DATE: August, 1979

SCALE: NONE

DRN. NO: S31

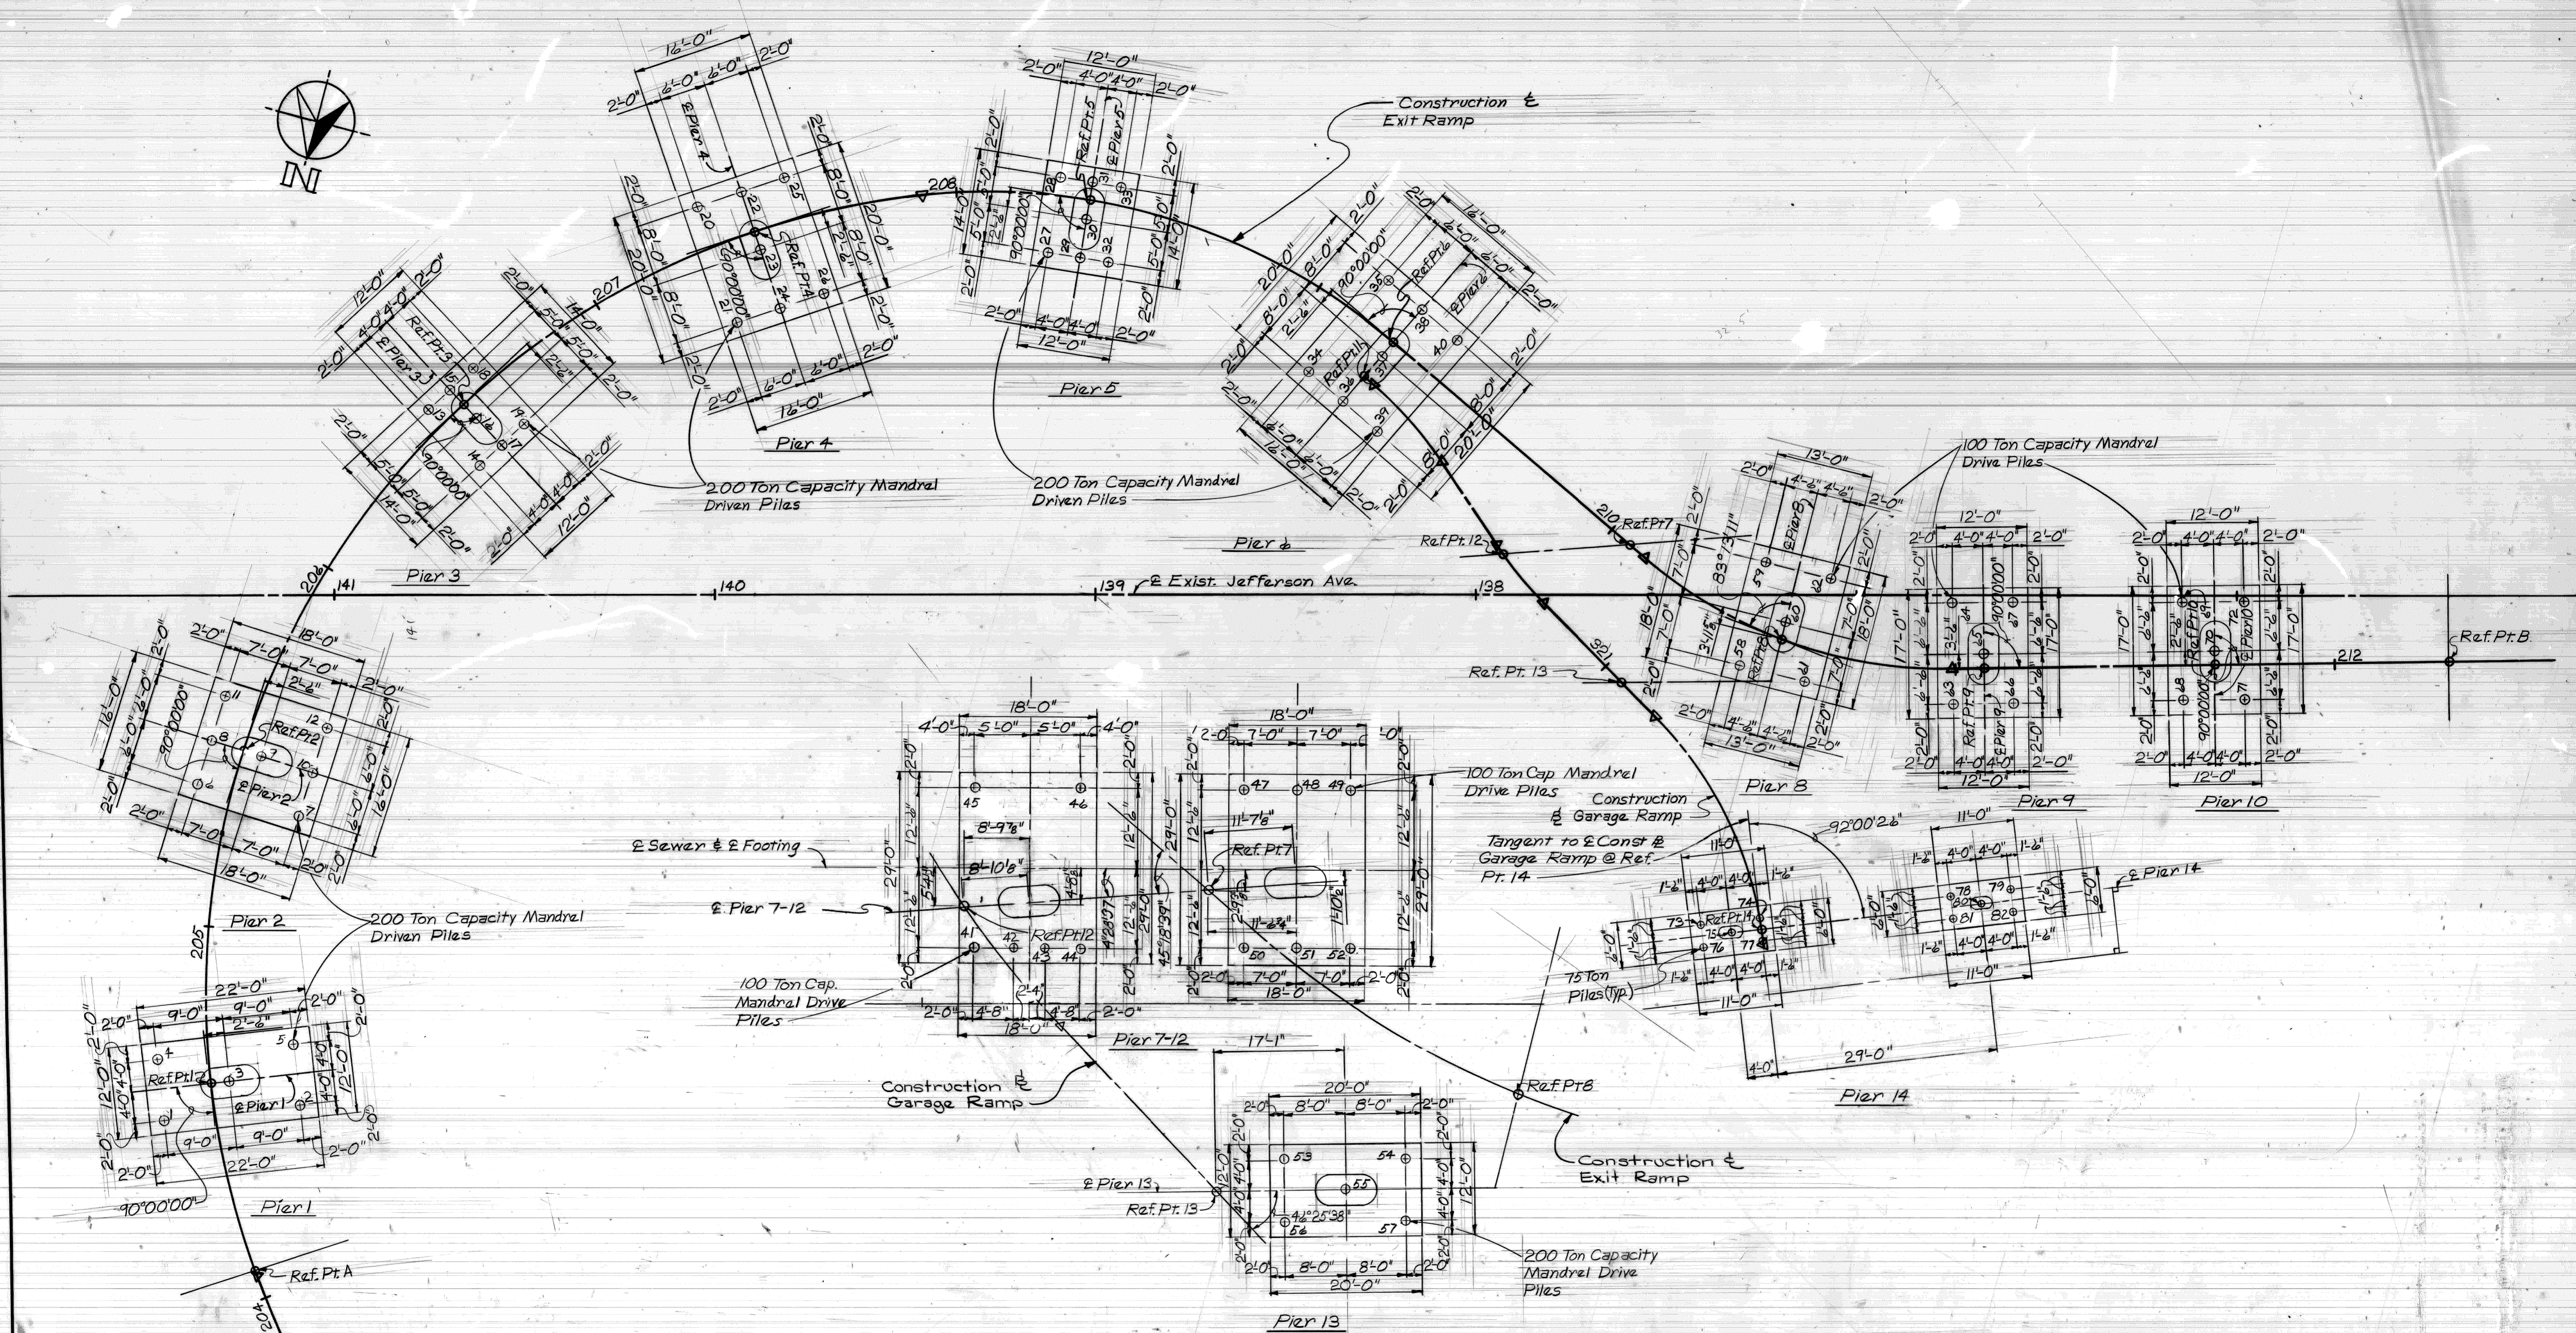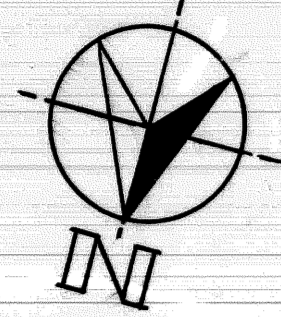

Before any foundation piling is driven, the existing 14'-9" Ø Jefferson Avenue Sewer shall be located and any deviation from its location shown on these plans shall be promptly reported to the Engineer. The design office shall be notified and adjustments made accordingly before any foundation piling is driven.

Work This Sheet With Sheets # 533

DATE: August, 1979

DESIGN BY:	RGW, SUP
DRN BY:	SUP, DE
CK'D BY:	RGW
APP'D BY:	

REVISIONS	

CITY OF DETROIT, MICHIGAN



JOHN C. LODGE EXIT RAMP AND JEFFERSON AVENUE RECONSTRUCTION AT THE JOE LOUIS ARENA.

FILE DETAILS
FILE LAYOUT


SCALE: NONE
DRN. NO: S32

C.I.P. CONCRETE PILES FURNISHED & DRIVEN 75 TON					
Pier No.	Type of Pile	No. of Piles	Length Each Furnished & Driven	Total Length Furnished & Driven	Pile Cut-Off Elevation
14	Vertical	10	95'	950'	96.44
Total =				950 Lin. Ft.	

C.I.P. CONCRETE PILES FURNISHED & DRIVEN 200 TON					
Pier No.	Type of Pile	No. of Piles	Length Each Furnished & Driven	Total Length Furnished & Driven	Pile Cut-Off Elevation
1	Vertical	5	105'	525'	96.62
2	Vertical	7	105'	735'	95.04
3	Vertical	7	105'	735'	95.08
4	Vertical	7	105'	735'	96.89
5	Vertical	7	105'	735'	96.79
6-11	Vertical	7	105'	735'	95.32
13	Vertical	5	105'	525'	96.20
Total =				4725 Lin. Ft.	

C.I.P. CONCRETE PILES FURNISHED & DRIVEN 100 TON					
Pier No.	Type of Pile	No. of Piles	Total Length Furnished & Driven	Total Length Furnished & Driven	Pile Cut-Off Elevation
7-12	Vertical	12	75'	1,140'	93.31
8	Vertical	5	95'	475'	94.05
9	Vertical	5	95'	475'	95.69
10	Vertical	5	95'	475'	96.48
Total =				2565 Lin. Ft.	

AS BUILT
 80 - 60 ton H-PILES AVE TIP EL +0.8
 10 - 75 ton SHELL PILES - 3.2
 27 - 100 ton SHELL PILES - 7.3
 45 - 200 ton SHELL PILES - 8.3

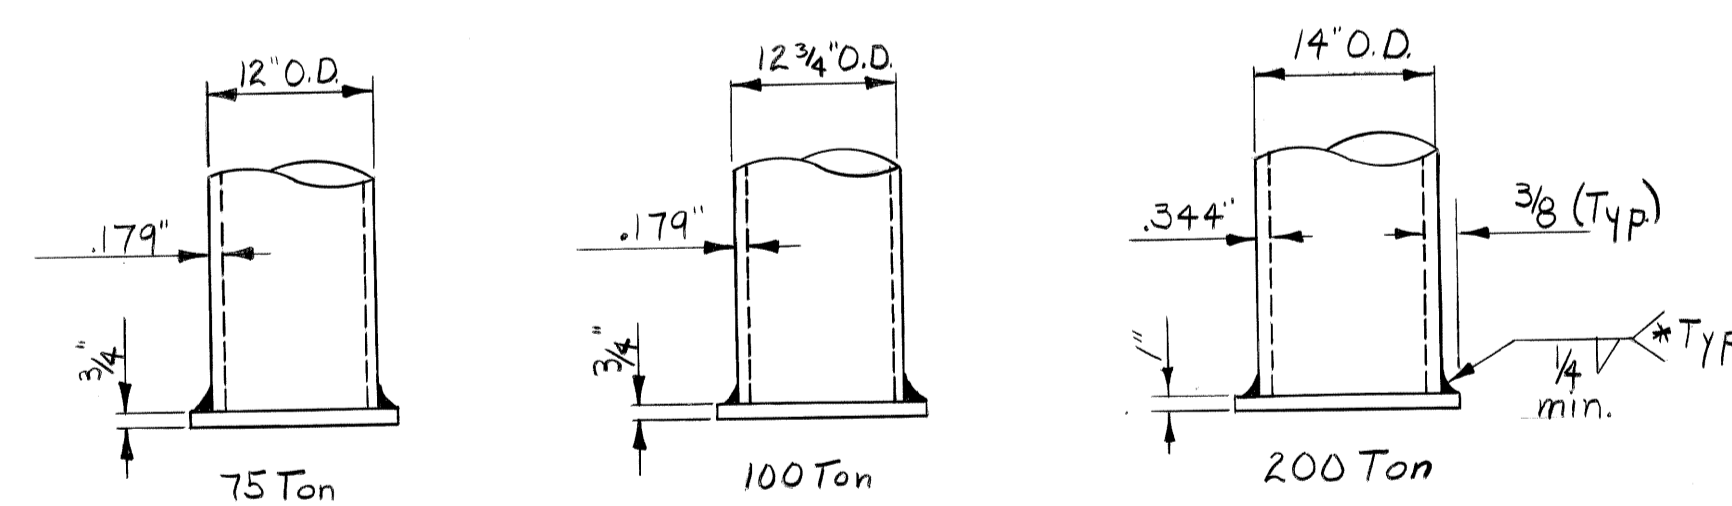

Cast in Place Concrete Piles

R thickness shown above for mandrel driven piles.
 Over boots attached by mechanical means, may be used.

Split chill rings as recommended by the manufacturer shall be used for splicing of pile shells.

*Weld size and/or reinforcement required to withstand driving forces shall be determined by the Contractor subject to the approval of the Engineer.

Pile Notes:

All piles shall be driven to the minimum bearing capacity as shown on the detail sheets. In addition, the 200 ton piles shall be driven to sound rock.

The contractor shall exert extreme caution to avoid disturbance of the existing 177" Jefferson Avenue sewer and the existing Third Street 38BL-4'R semicircular sewer.

The contractor is warned that soil conditions are such that wet drilling may be necessary to maintain holes.

The contractor may substitute pile shells for those shown on the Plans if the substitution will result in a pile of a strength equal to or greater than that of the pile detailed.

Concrete for Cast-in-Place piles shall have a compressive strength of 4500 psi. See Supplemental Specifications.


Work This Sheet With Sheets # 532

DATE: August, 1979

DSGN BY:	SJP,REW
DRN BY:	MG
CK'D BY:	REW
APP'D BY:	

REVISIONS	

CITY OF DETROIT, MICHIGAN

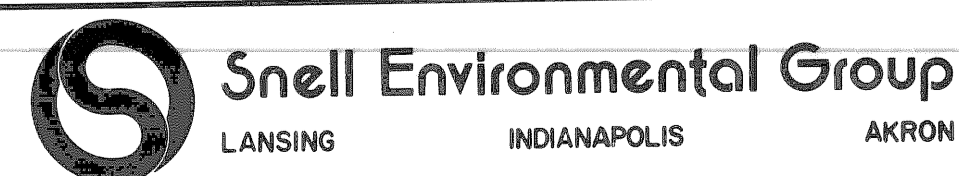


JOHN C. LODGE EXIT RAMP AND JEFFERSON AVENUE-RECONSTRUCTION AT THE JOE LOUIS ARENA.


PILE DETAILS

SCALE: NONE


DRN. NO: S33

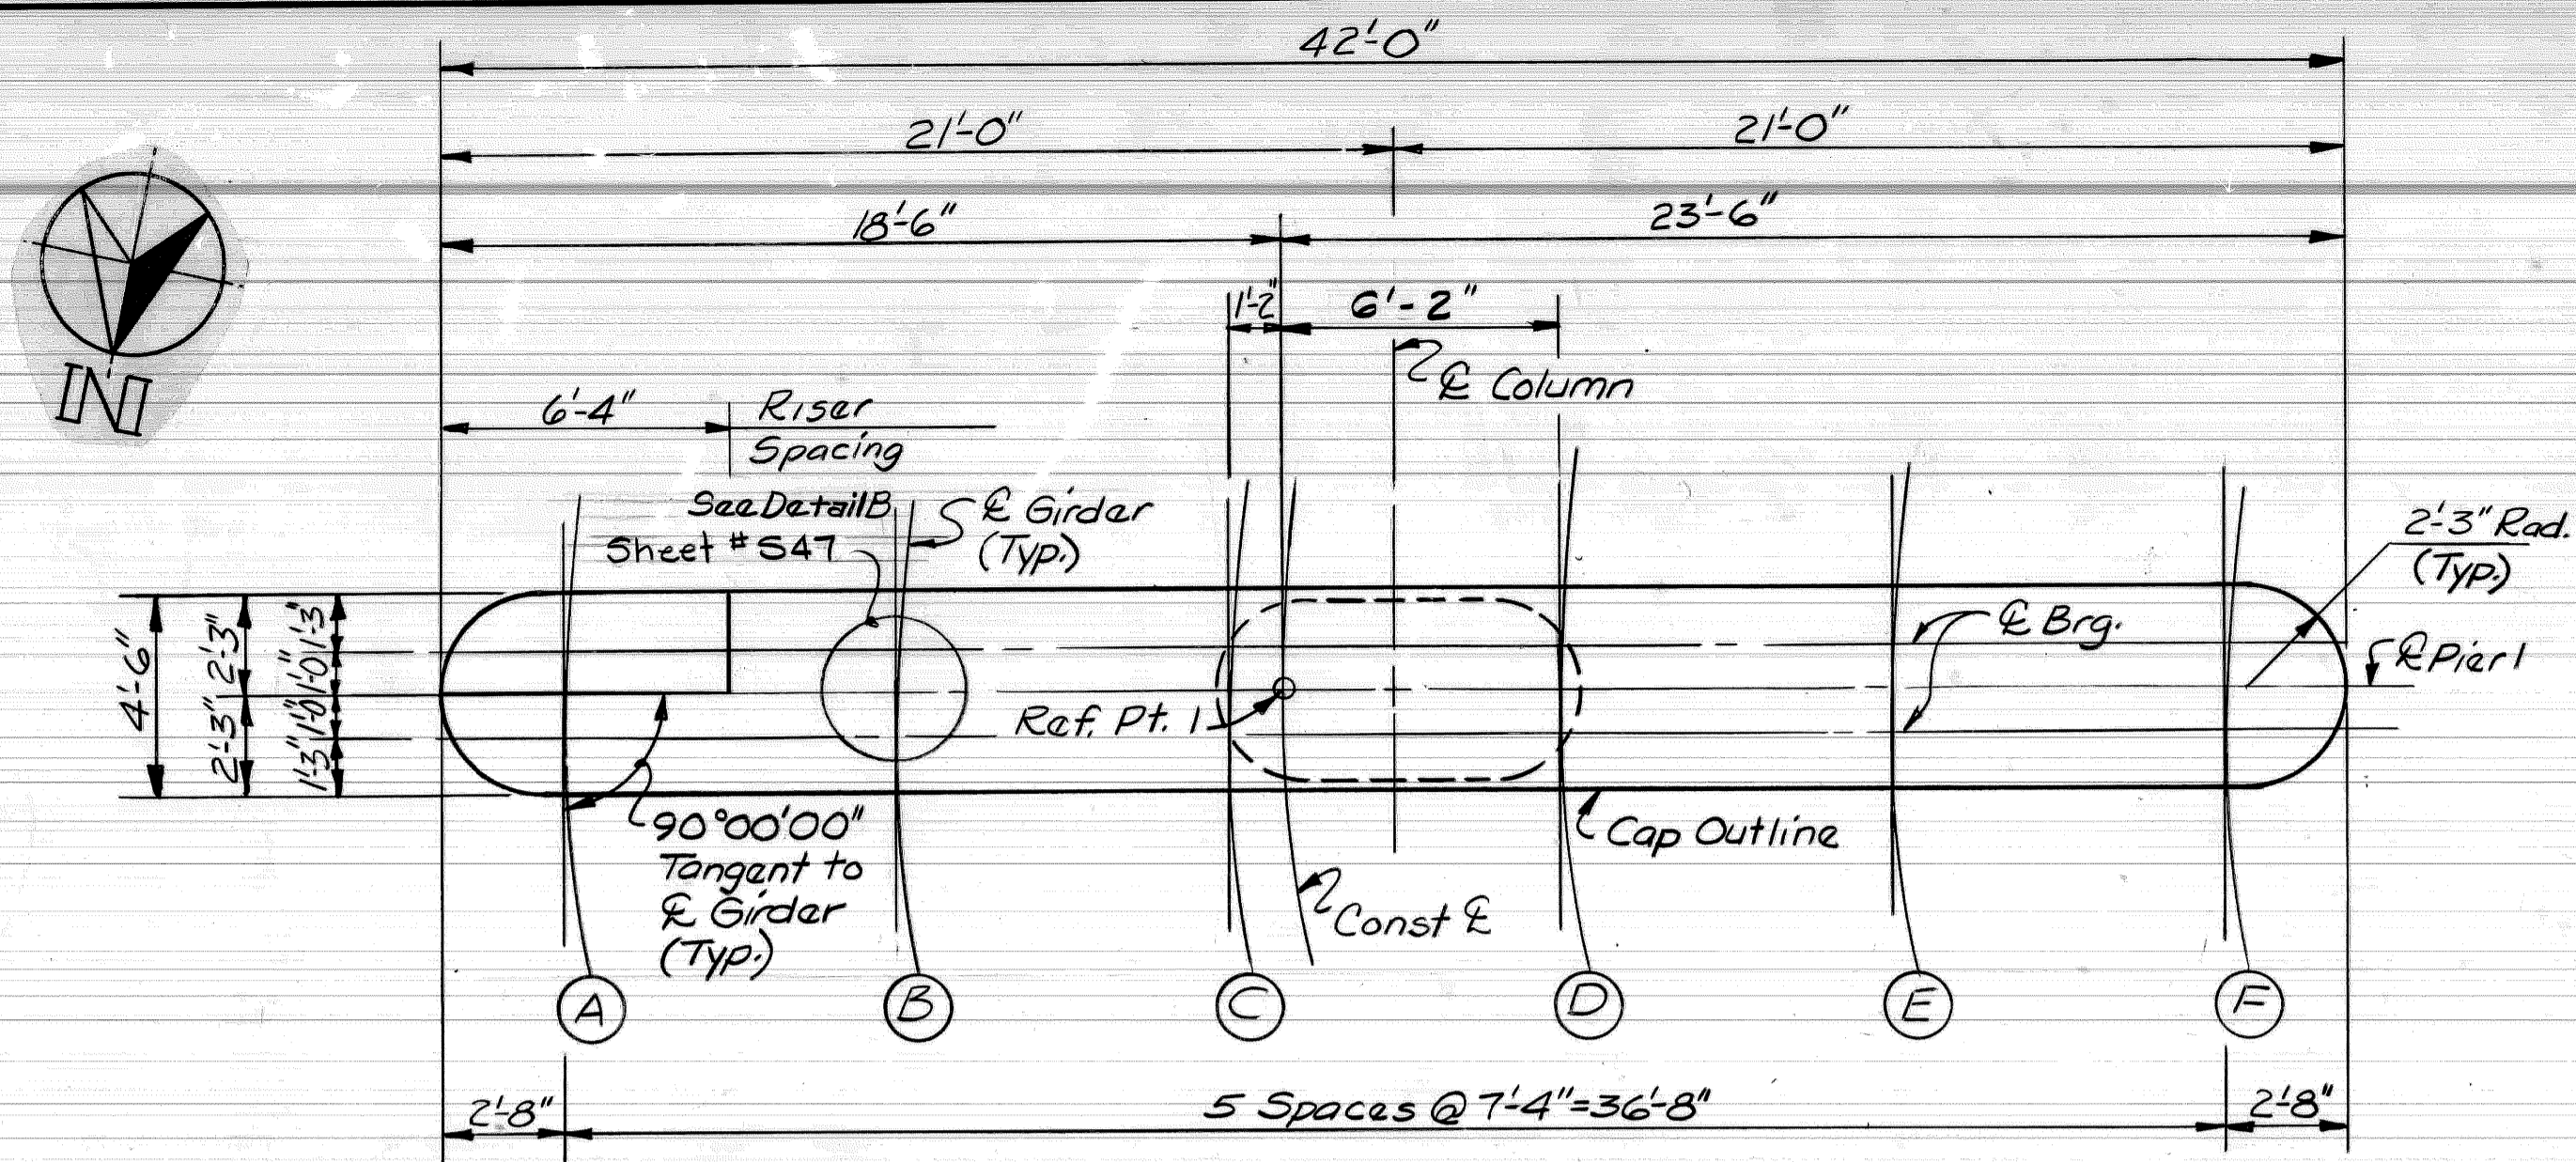


PLAN OF CAP

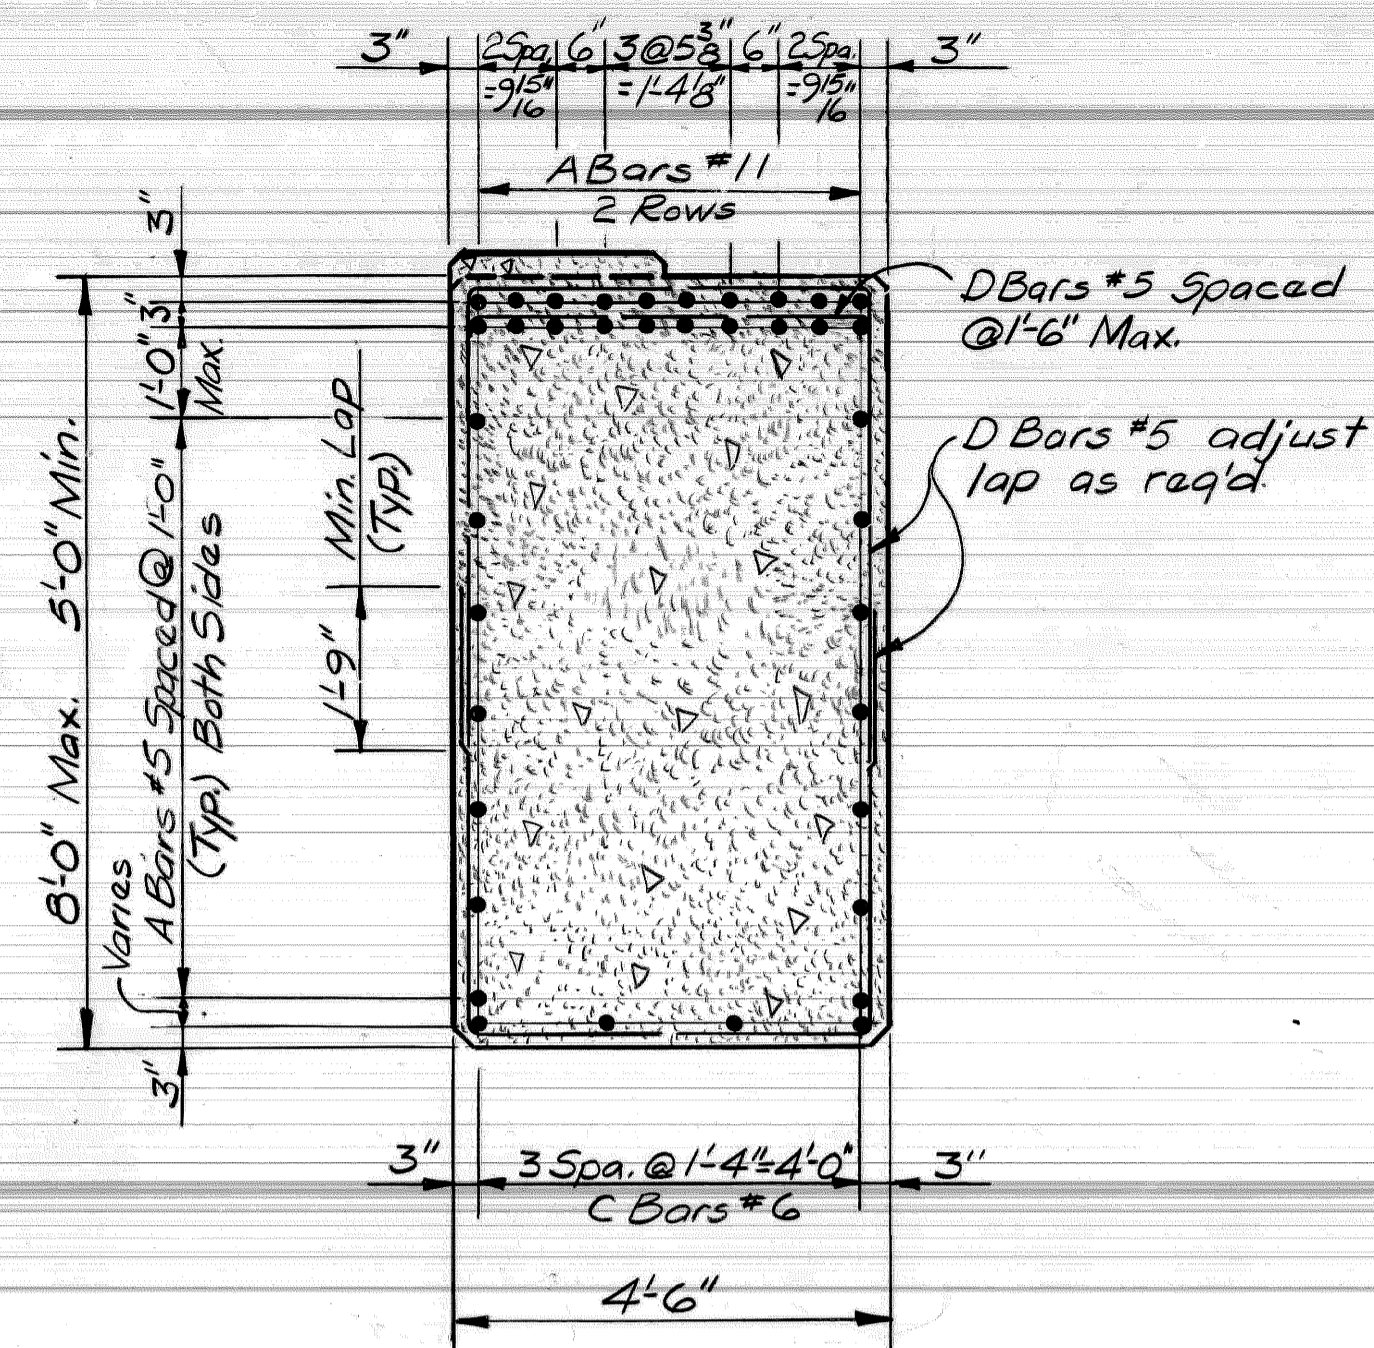


SECTION AA

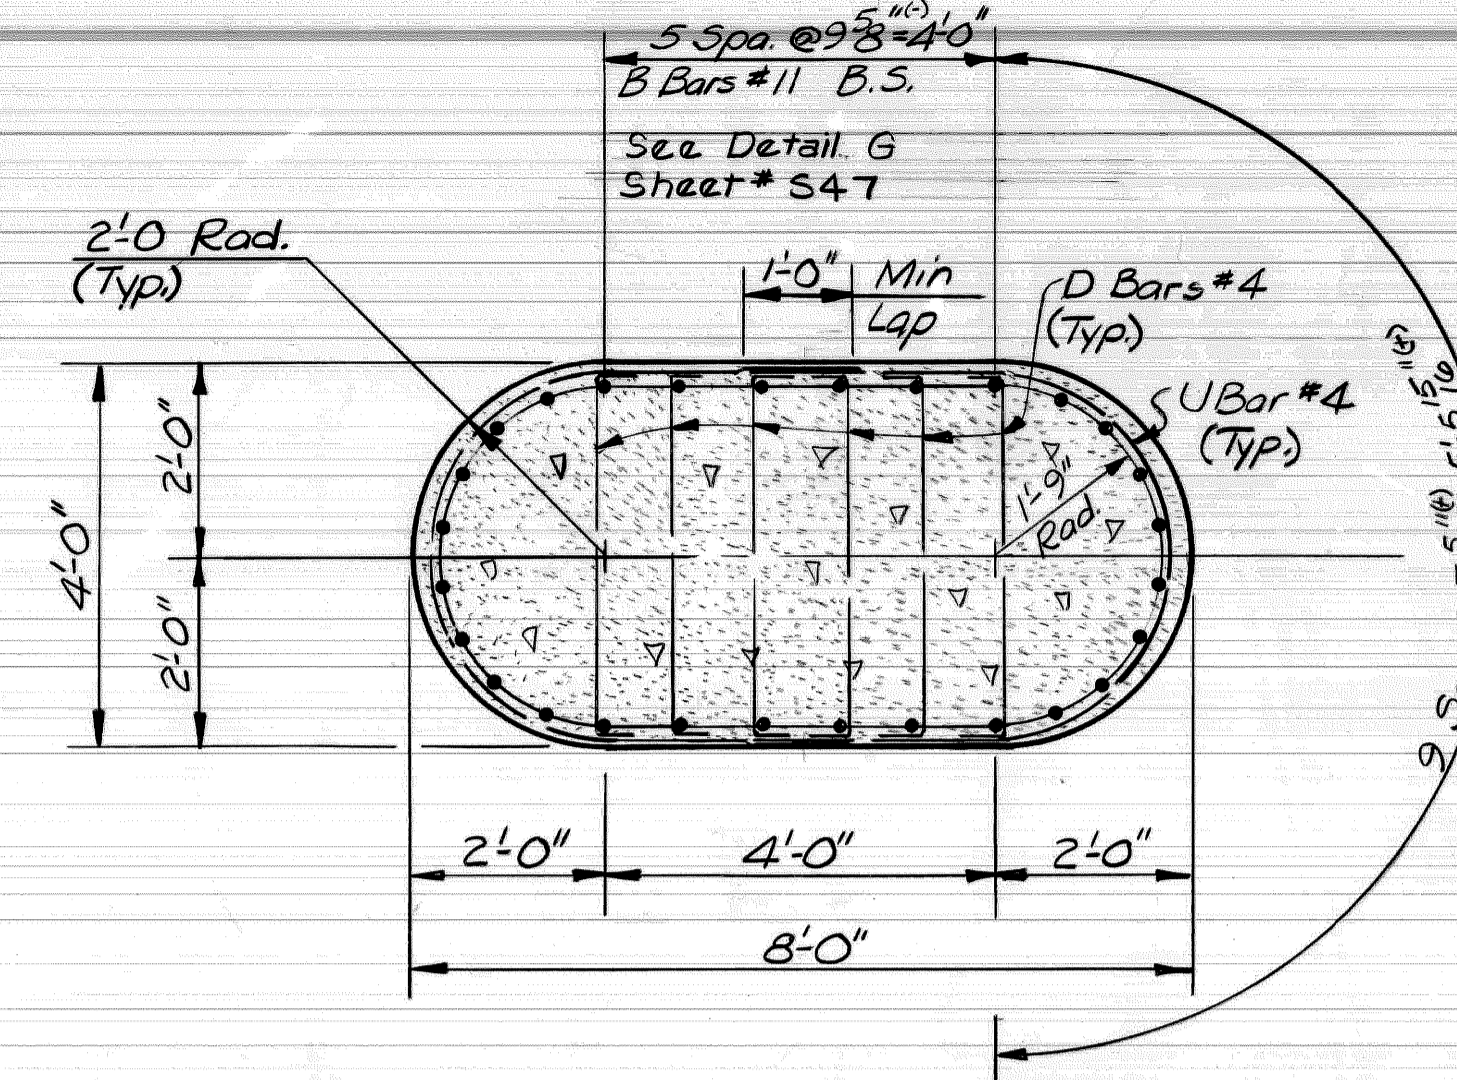


SECTION B-B

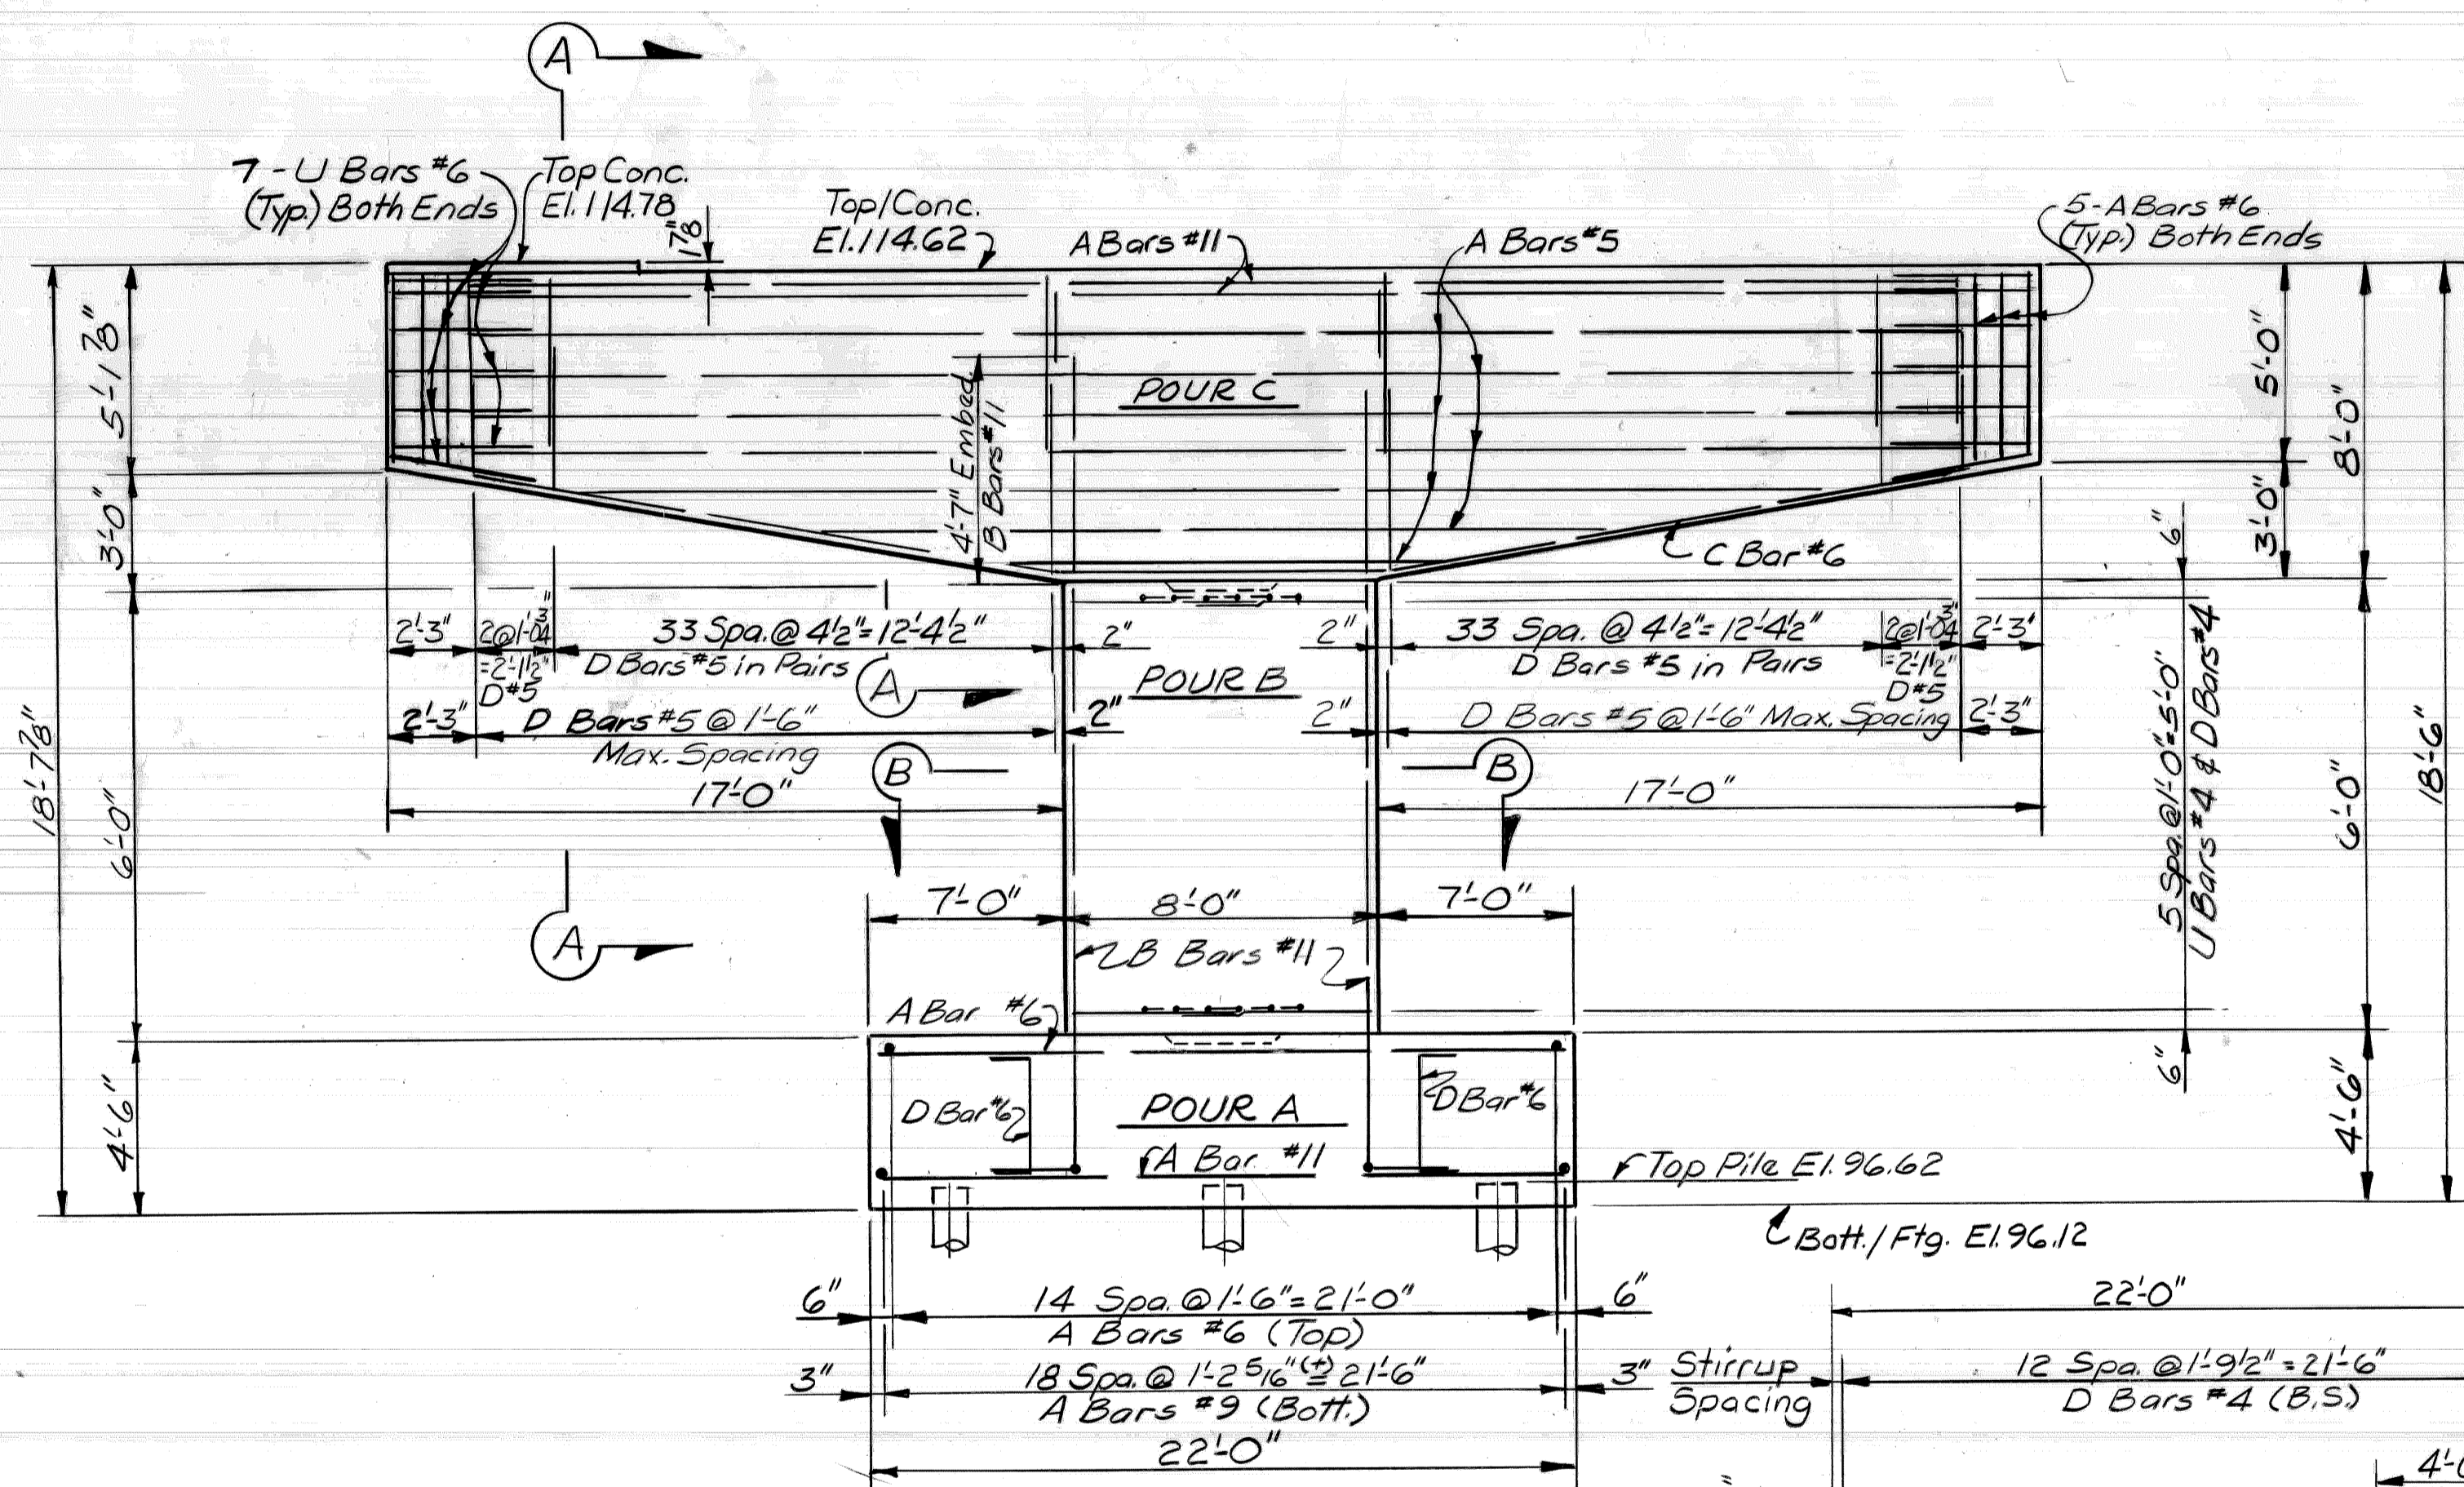

ELEVATION

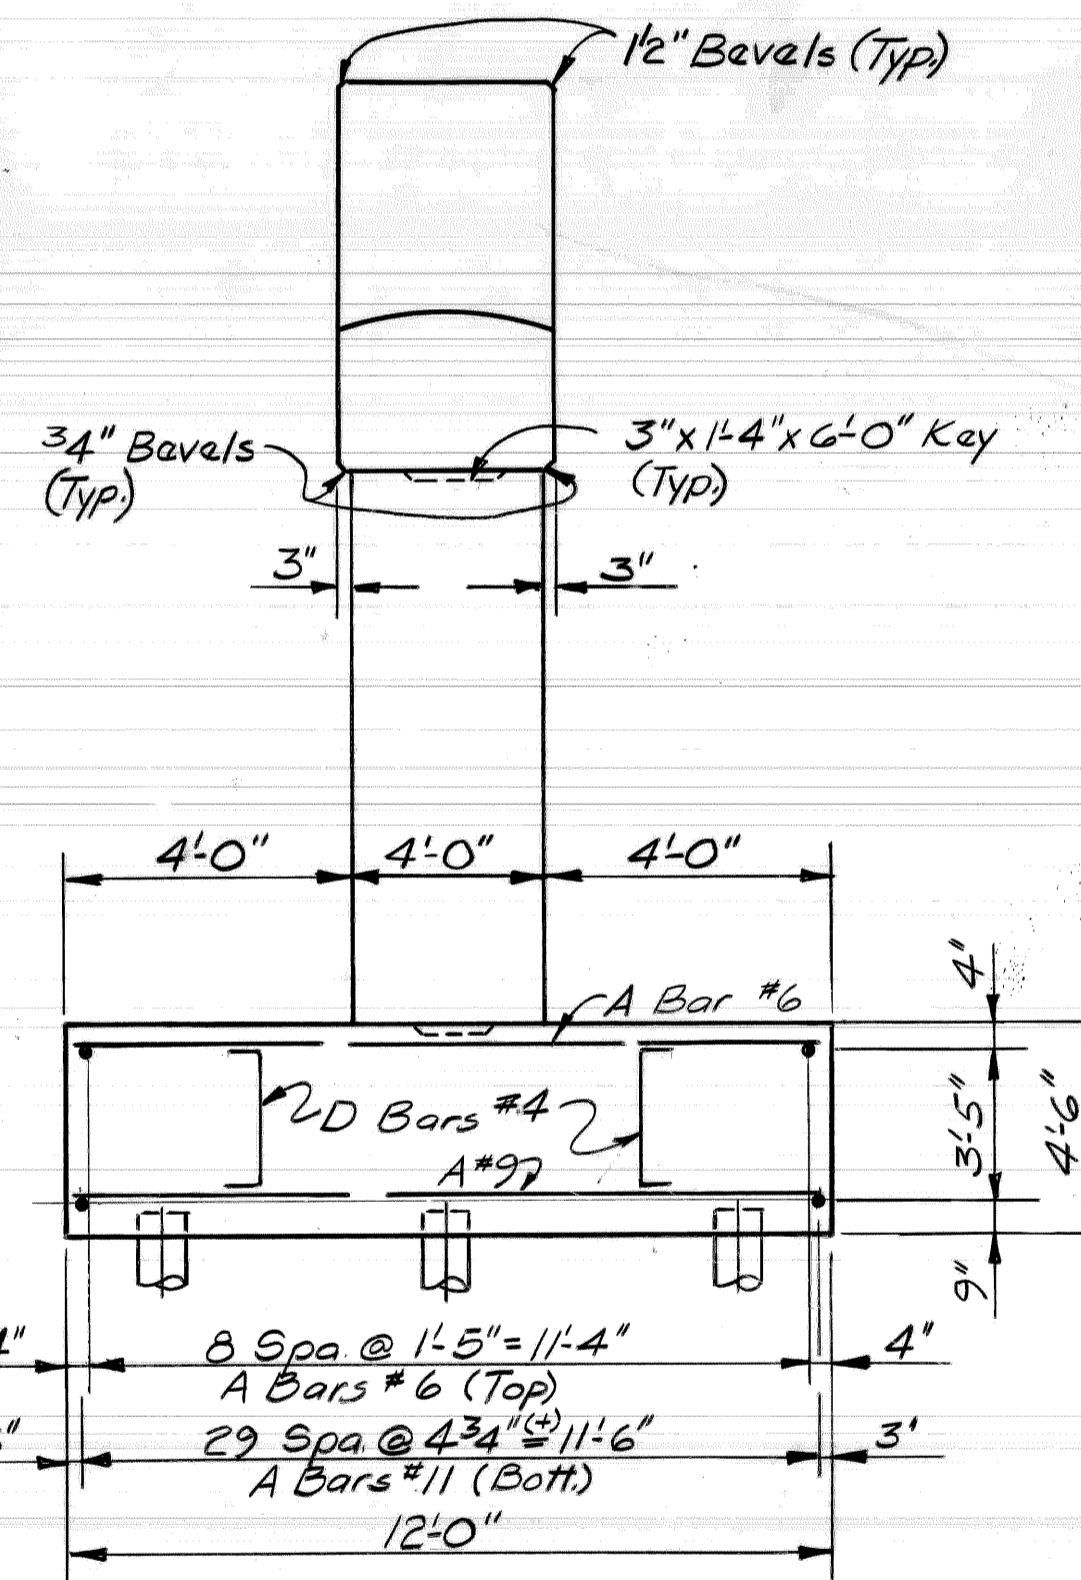

END VIEW

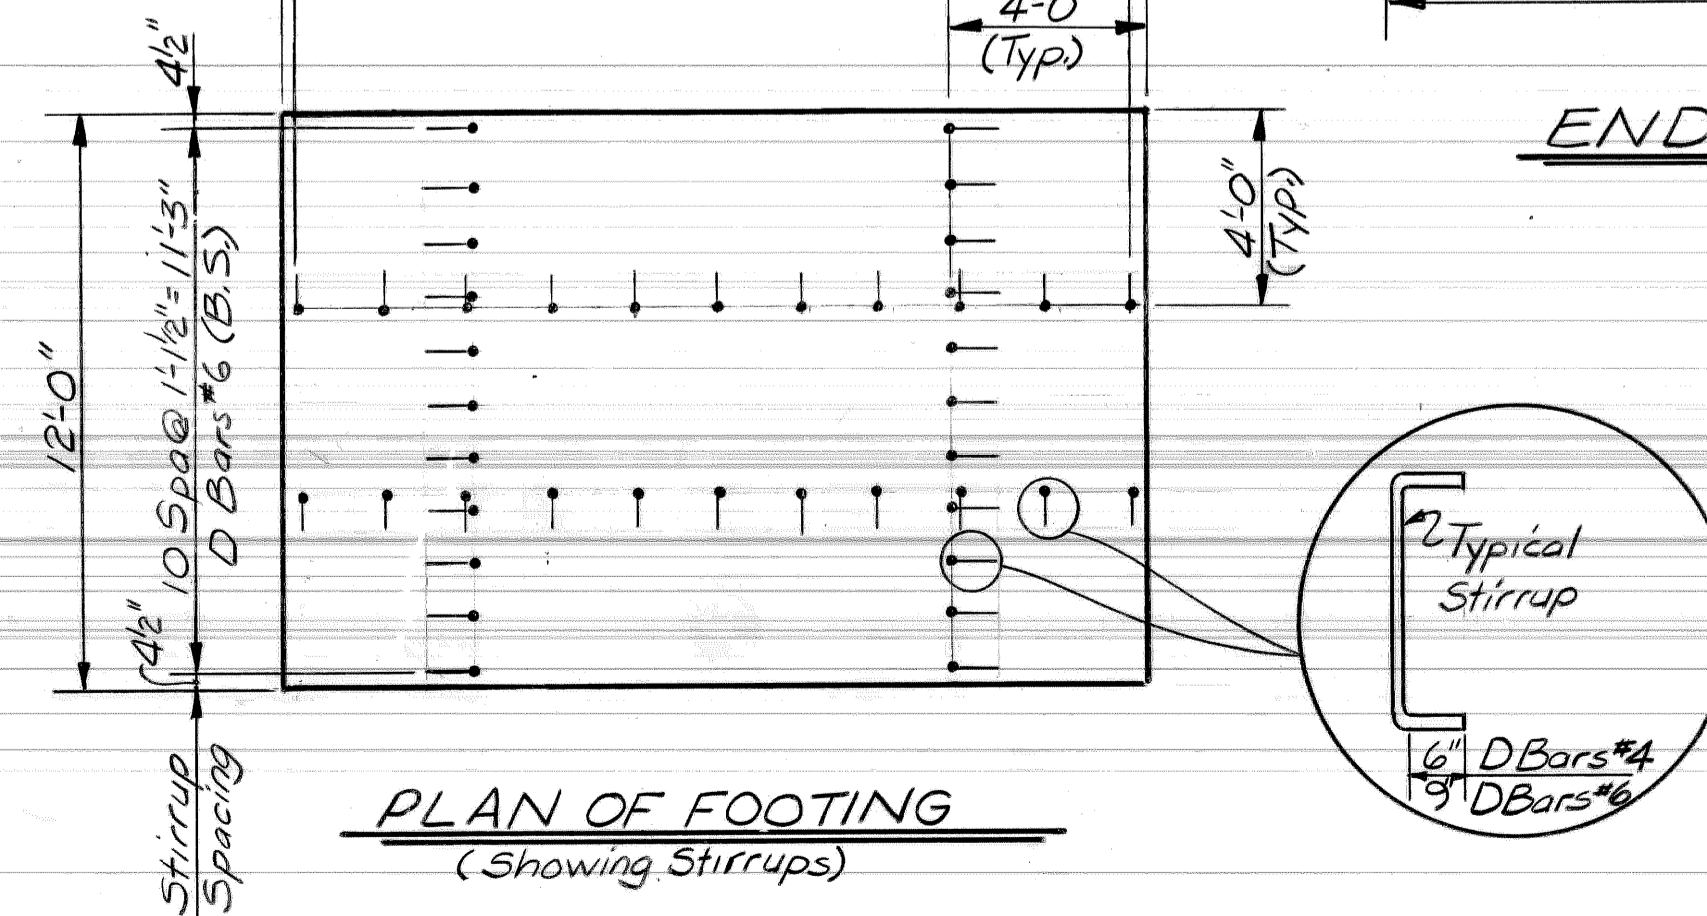

PLAN OF FOOTING
(Showing Stirrups)

DSGN BY:	RGW, MH
DRN BY:	MH
CK'D BY:	RGW
APP'D BY:	

REVISIONS	

CITY OF DETROIT, MICHIGAN



JOHN C. LODGE EXIT RAMP AND JEFFERSON AVENUE-
RECONSTRUCTION AT THE JOE LOUIS ARENA



PIER DETAILS
PIER 1

DATE: August, 1979


SCALE: NONE

DRN. NO: S34


Work This Sheet With Sheets # S35 thru S48

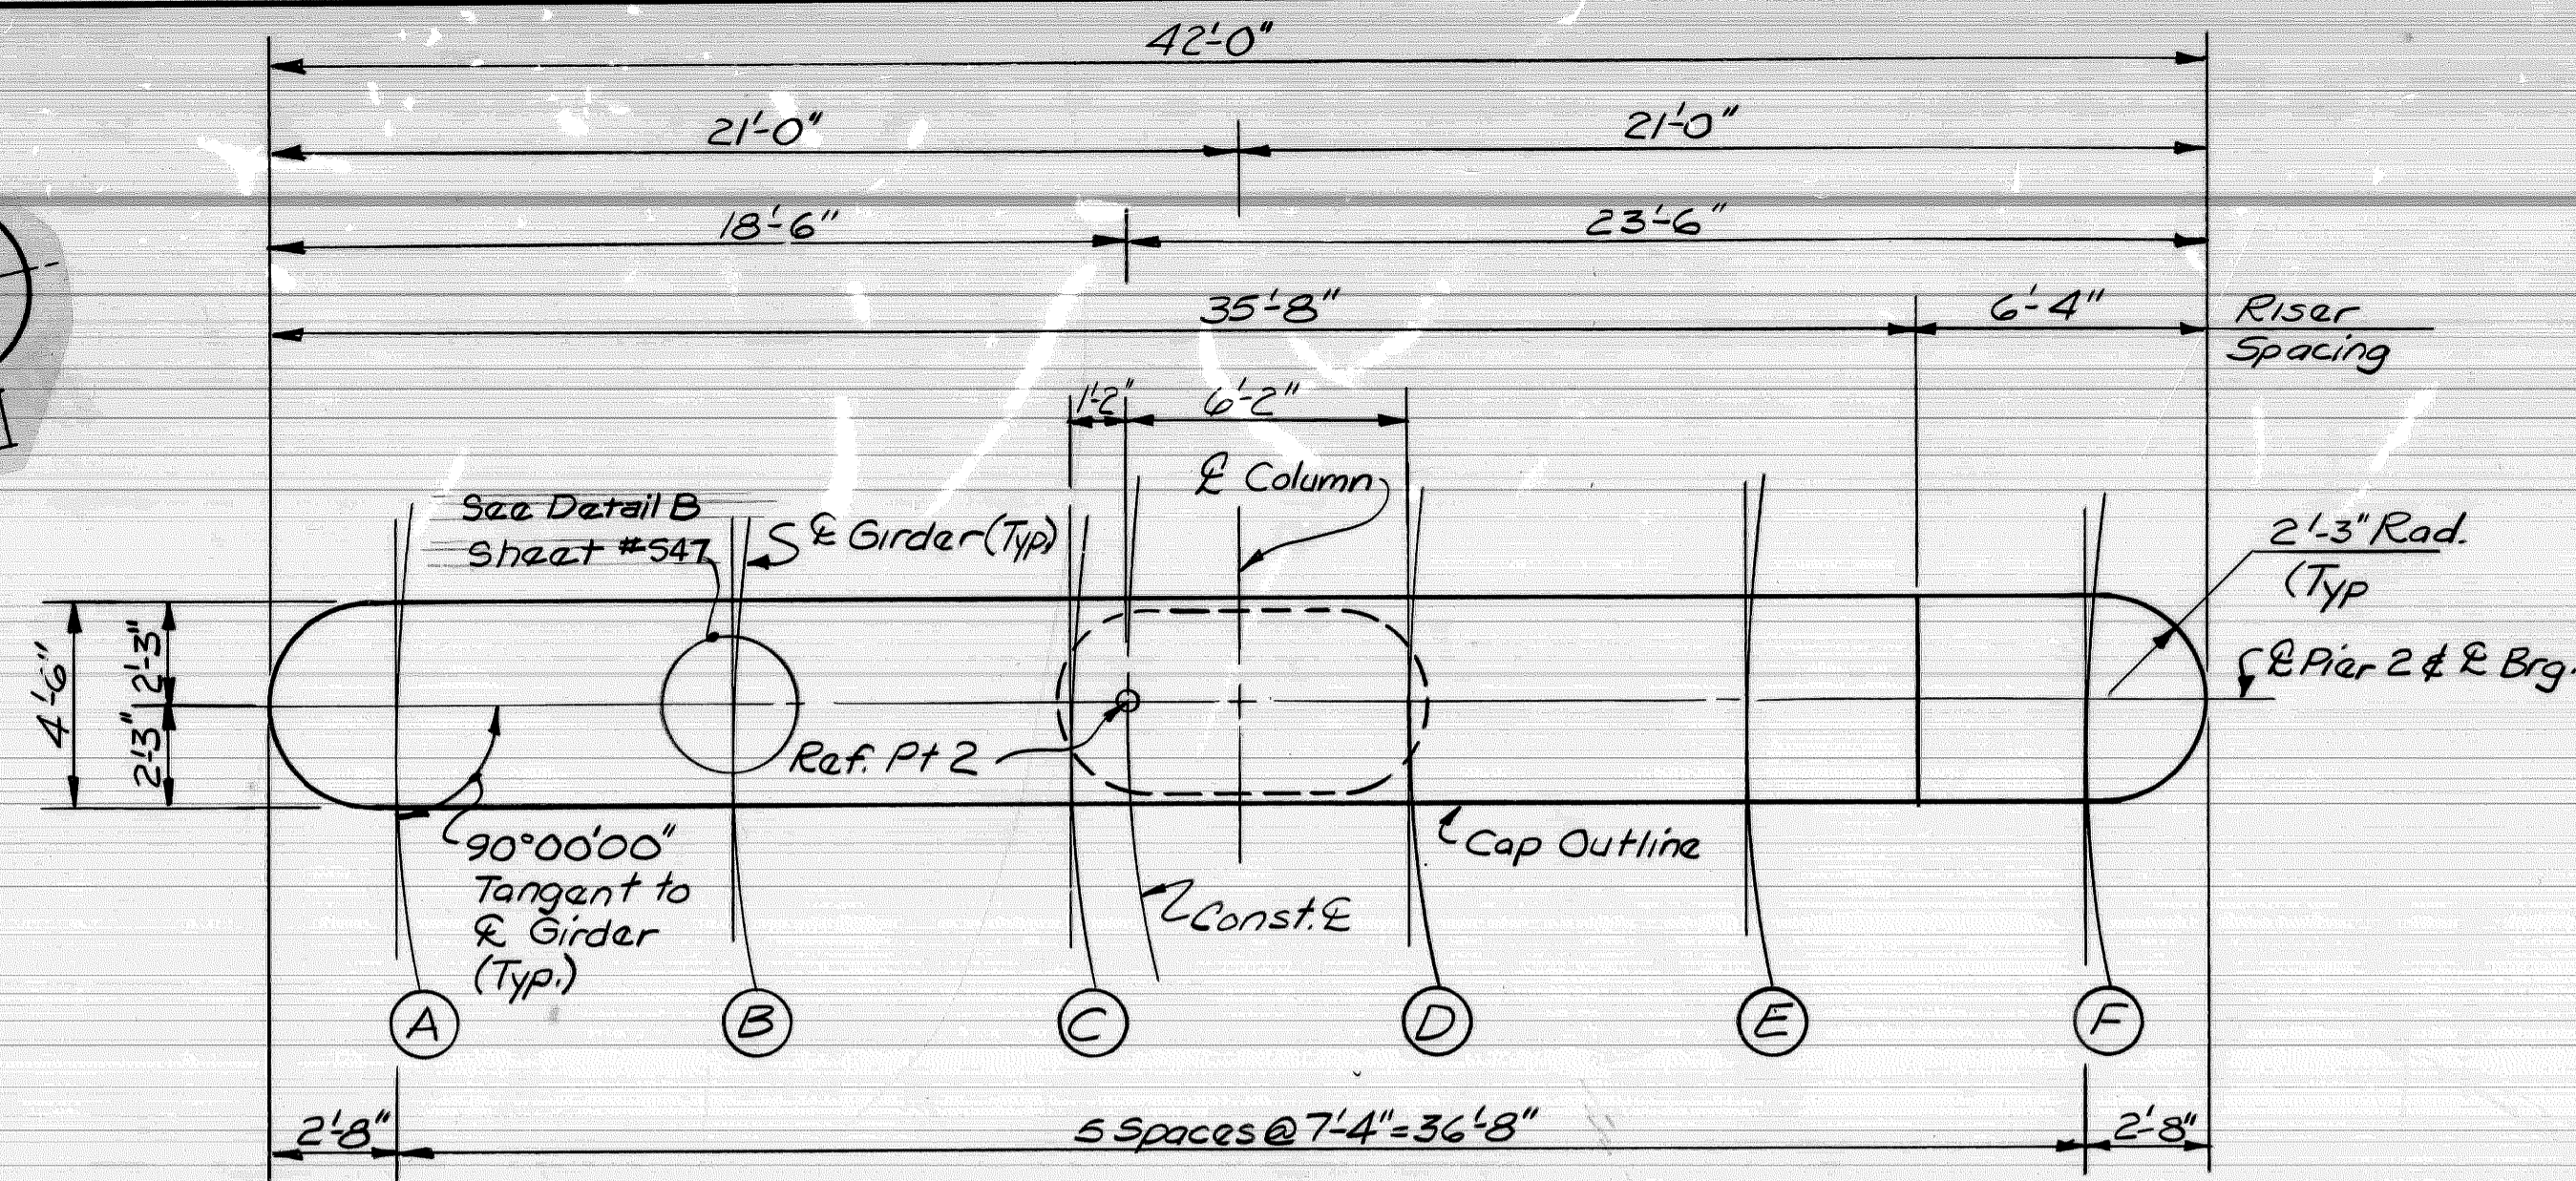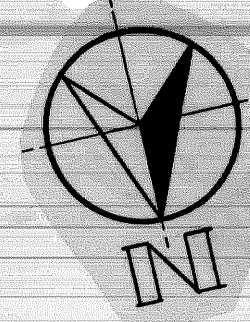


PLAN OF CAP

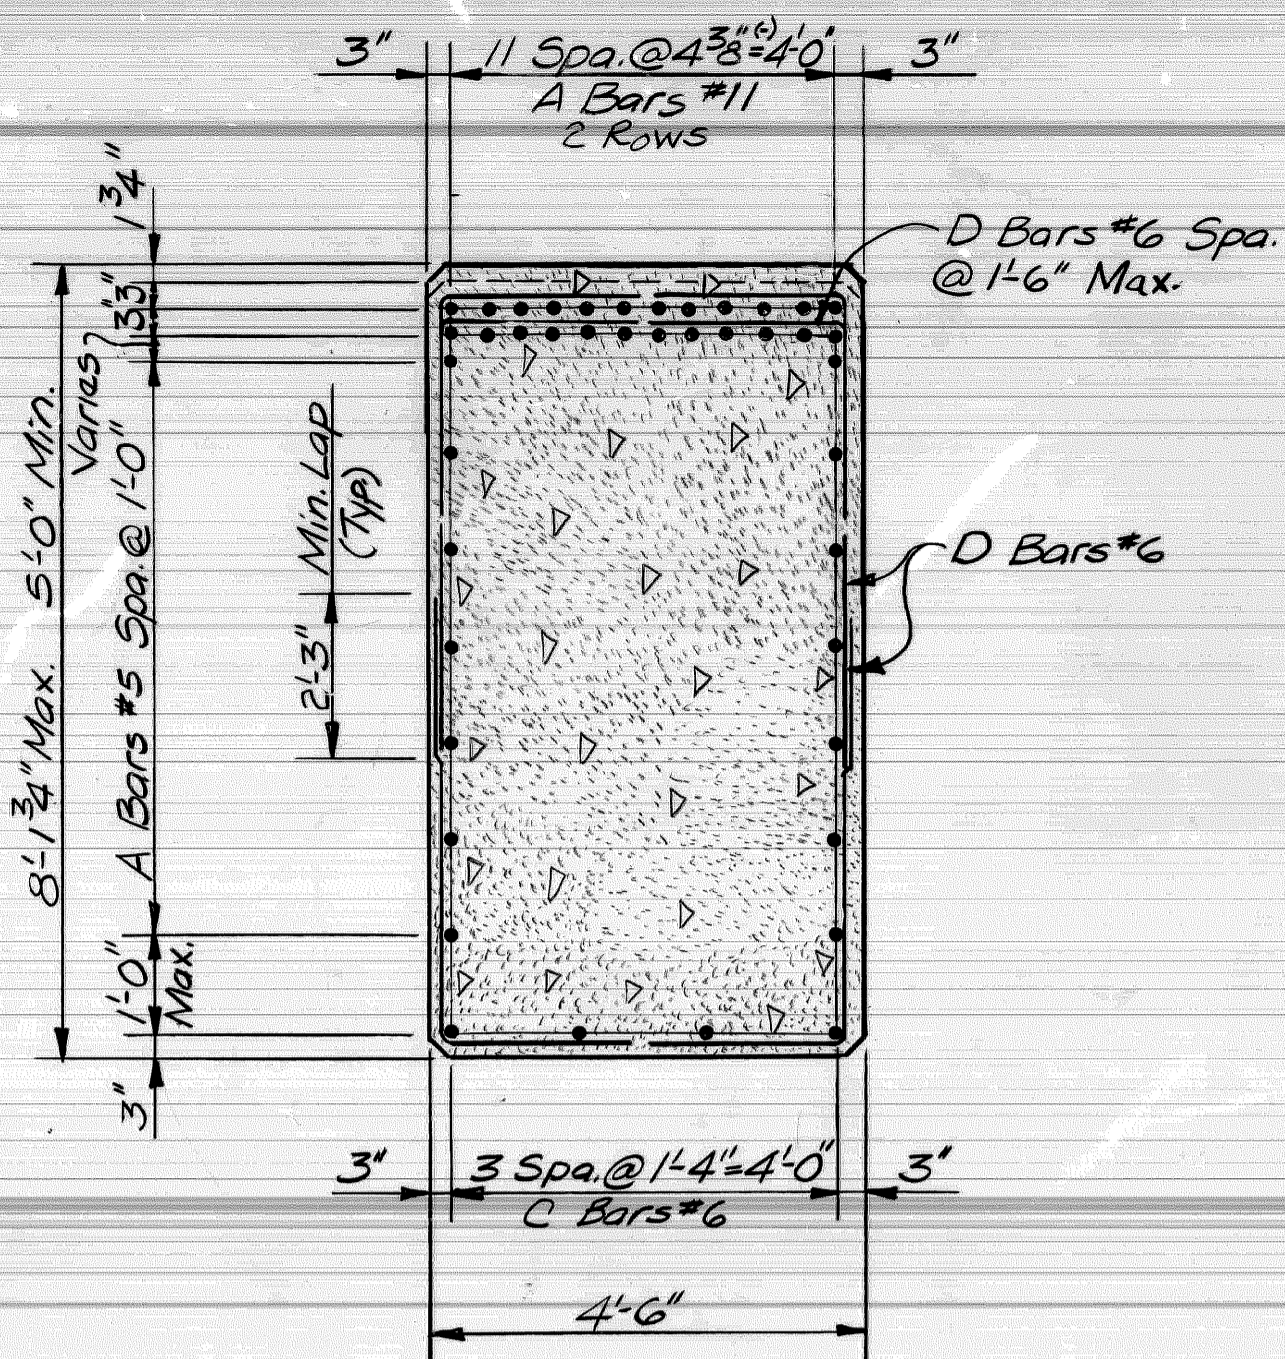


SECTION A-A

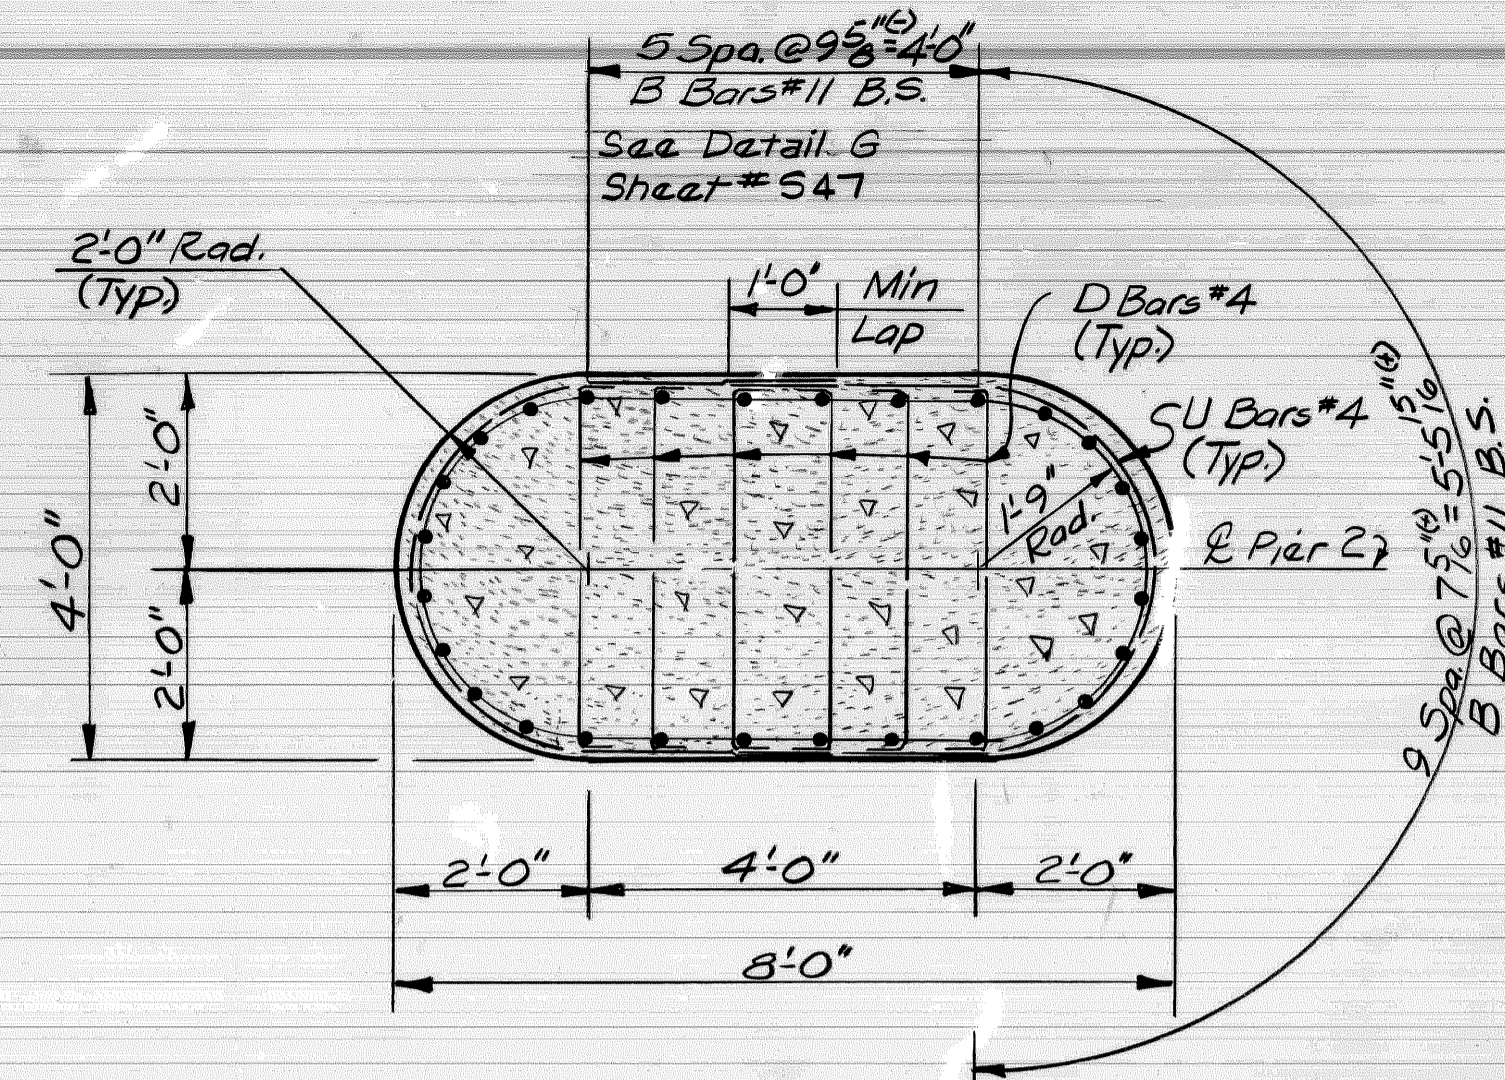


SECTION B-B

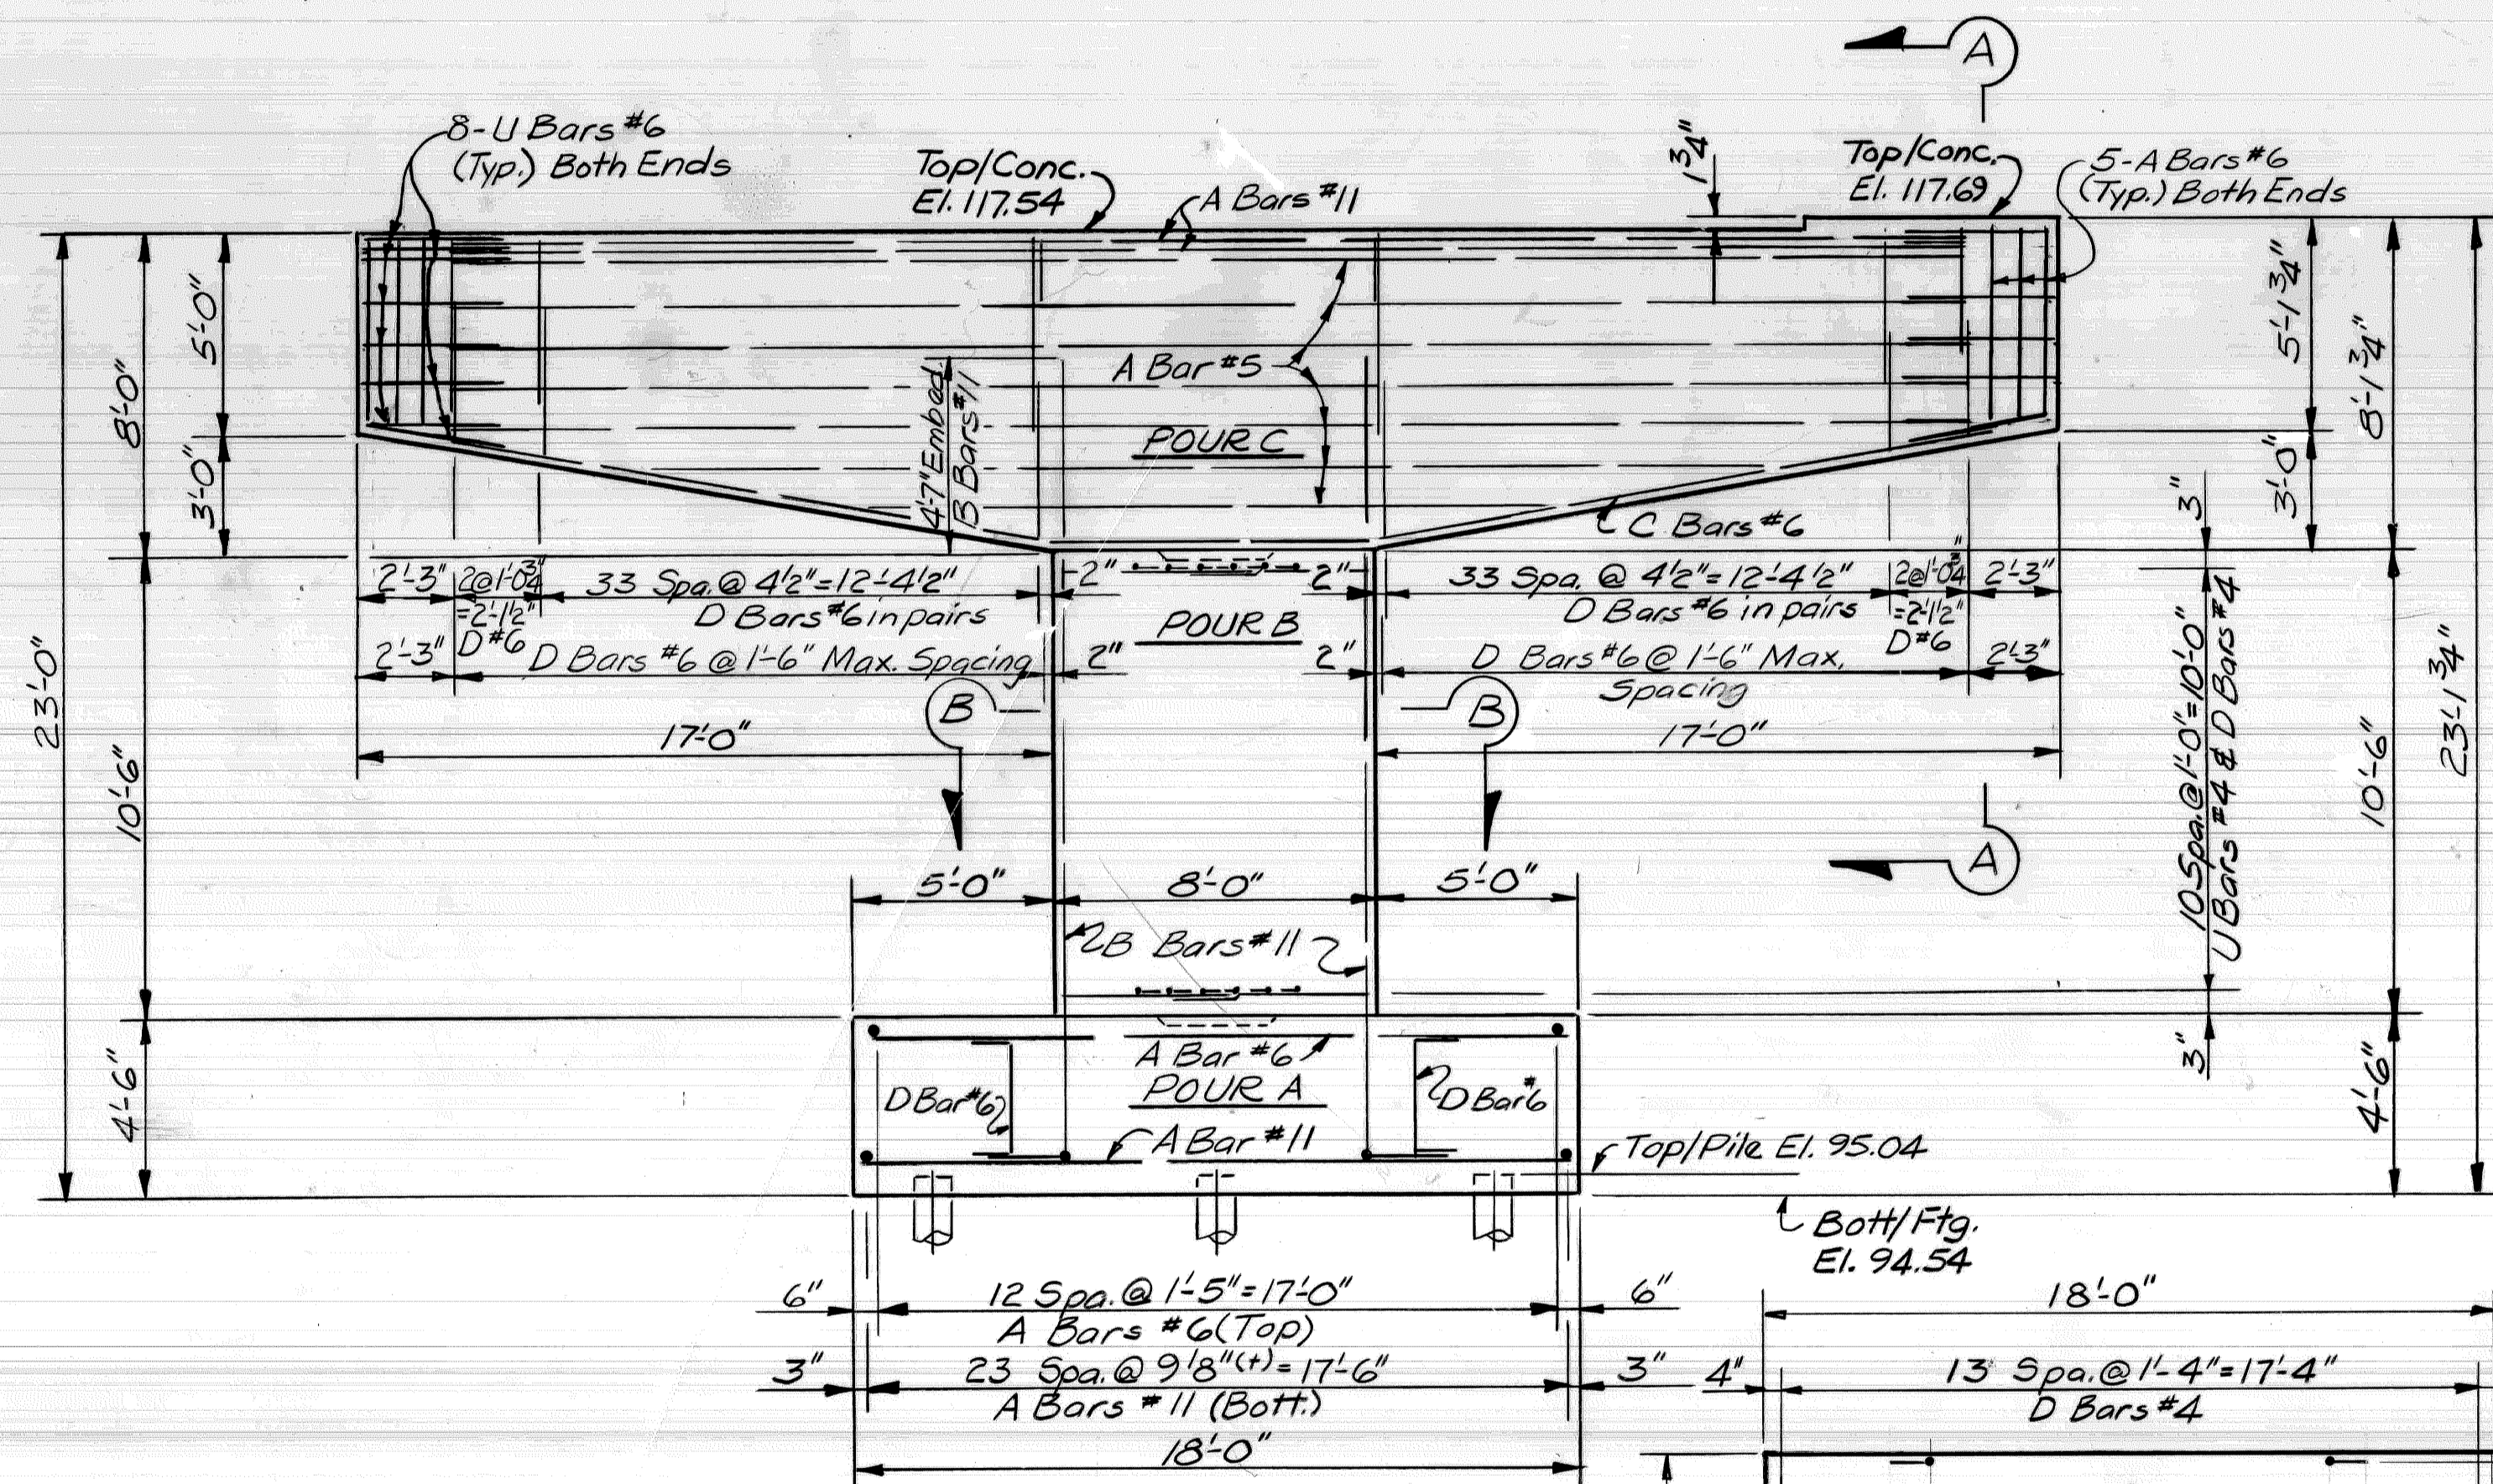

ELEVATION

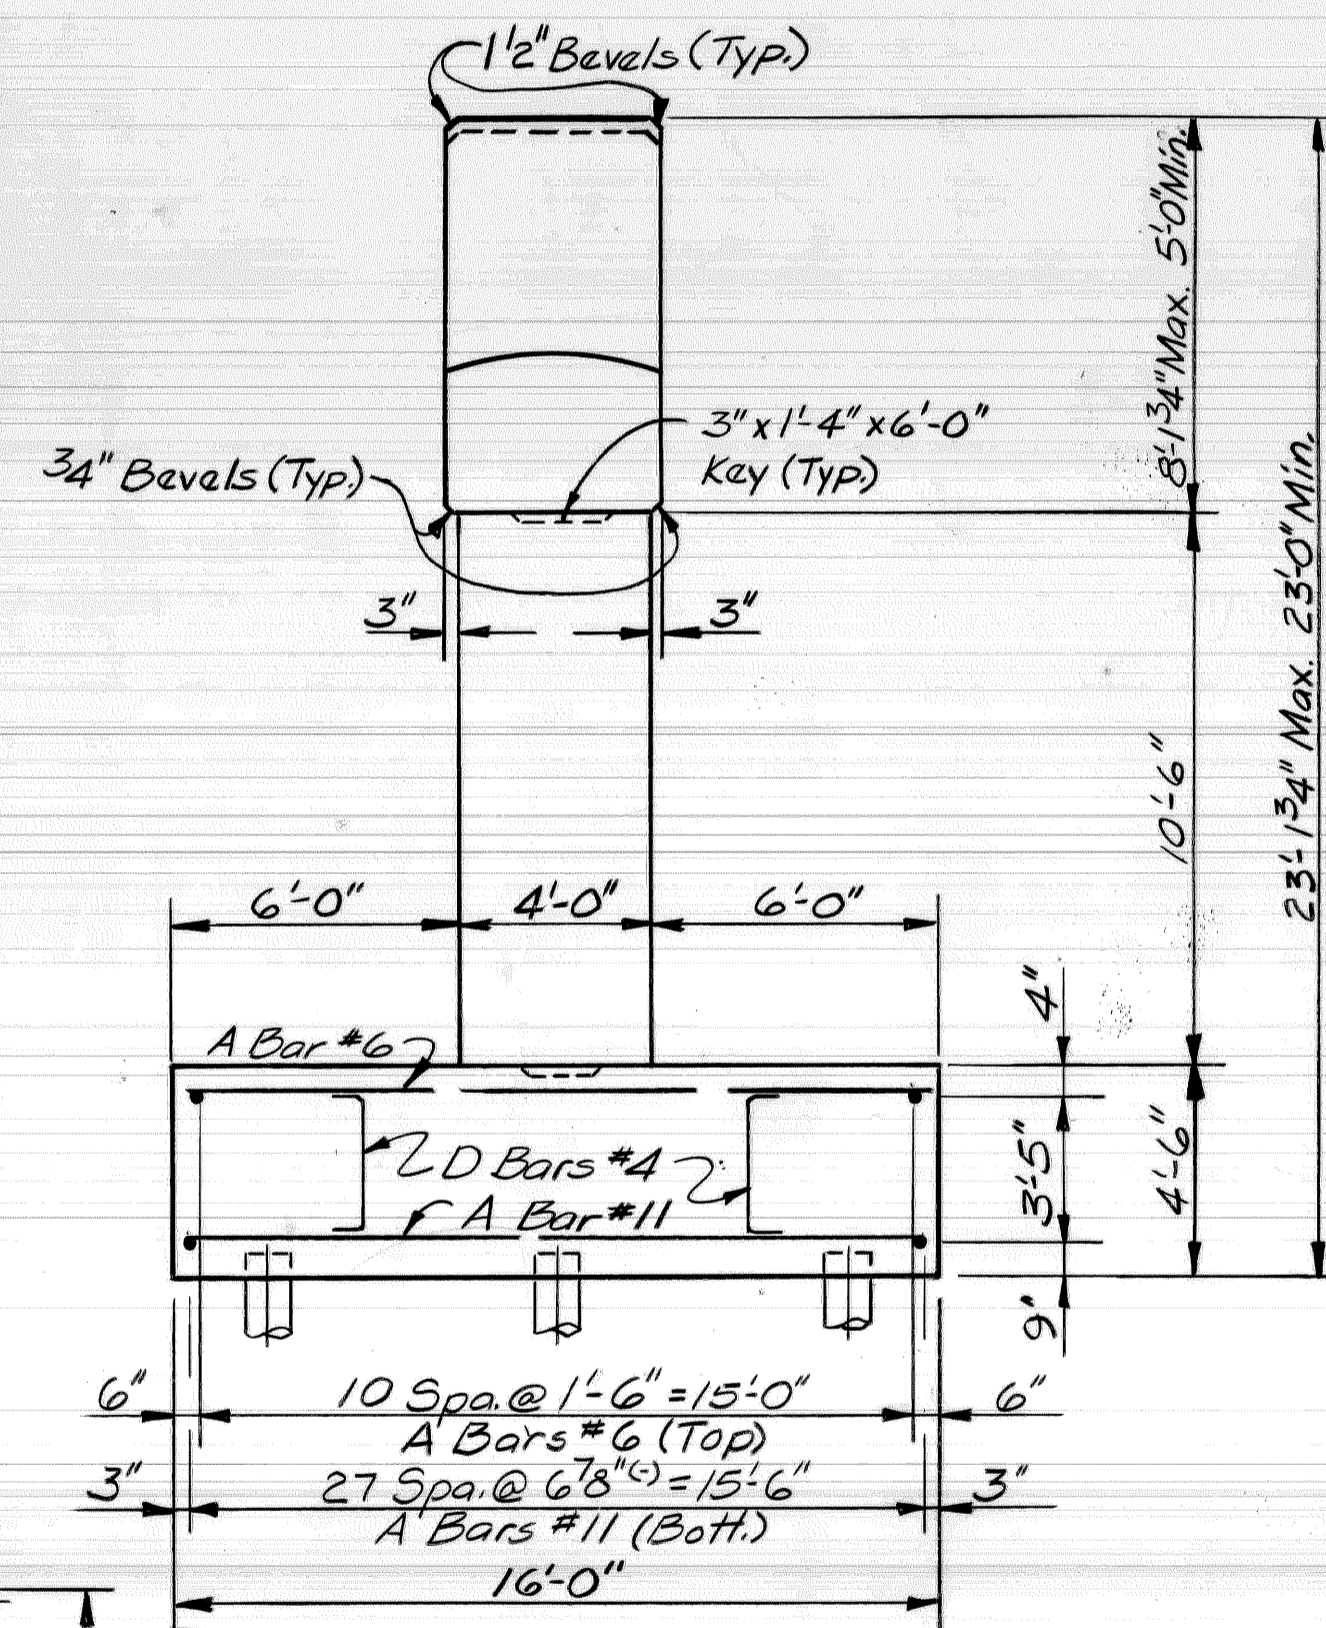

END VIEW

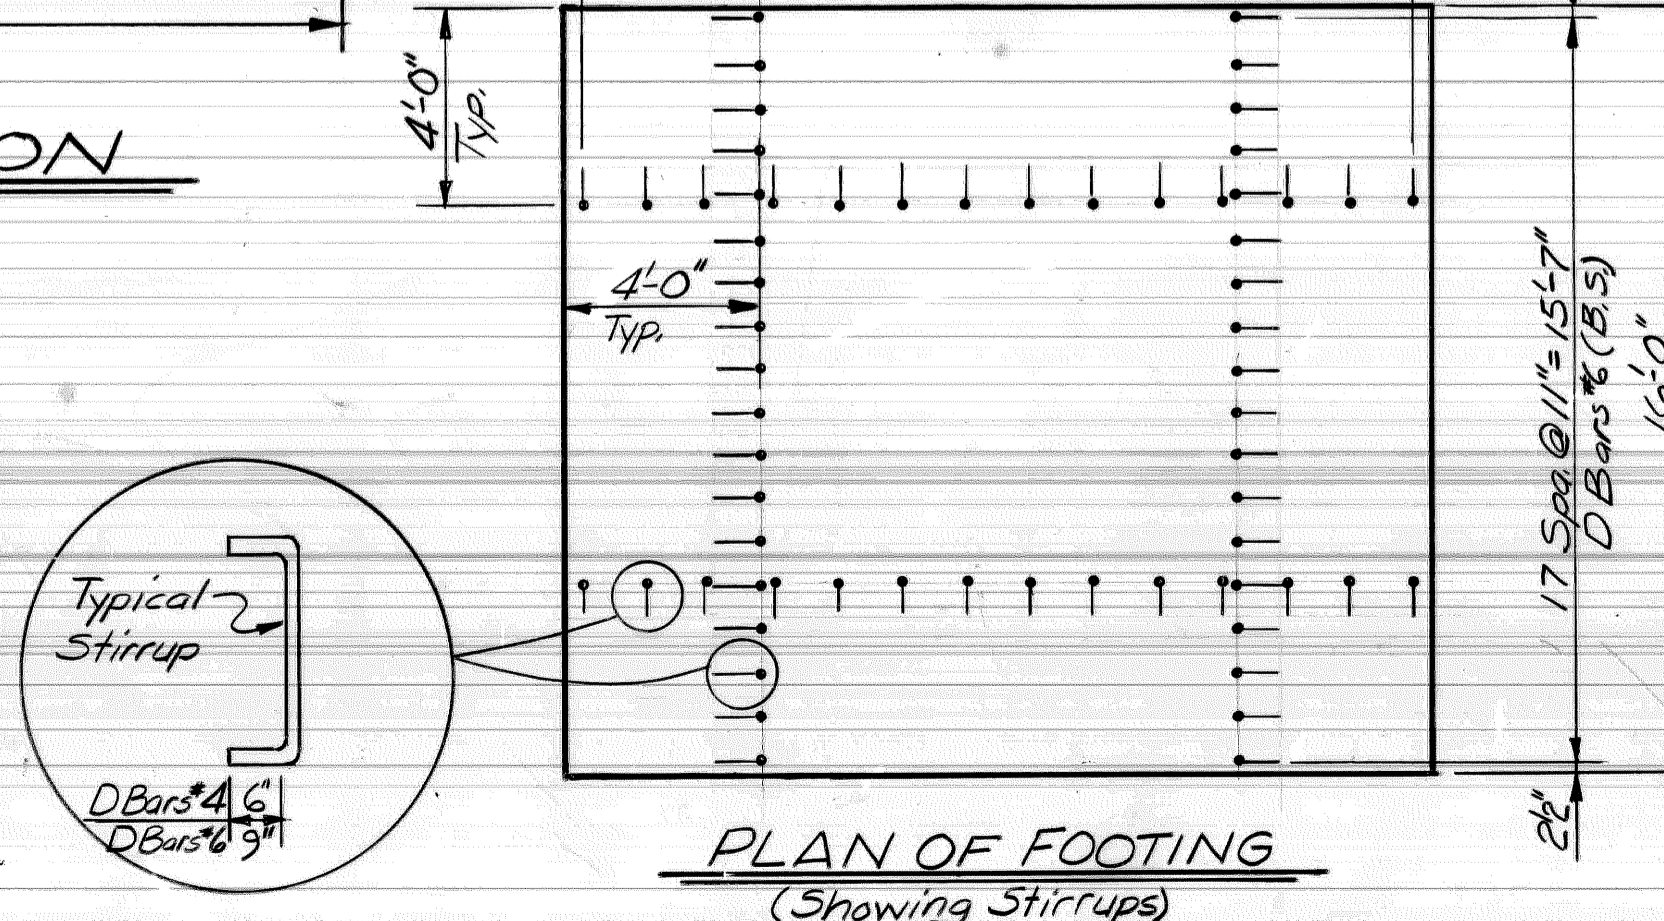

PLAN OF FOOTING
(Showing Stirrups)


Work This Sheet With Sheets # S34, S35, S36 thru S48

DATE: August, 1979

DSGN BY: RGW, MH	
DRN BY: MH	
CK'D BY: RGW	
APP'D BY:	

REVISIONS

CITY OF DETROIT, MICHIGAN


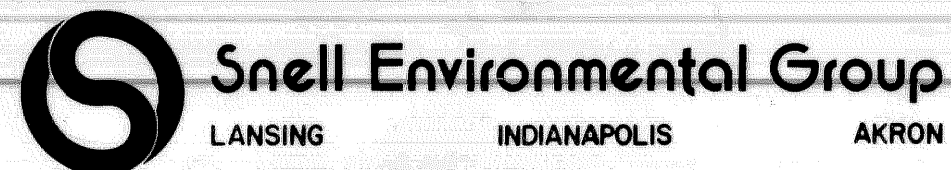


JOHN C. LODGE EXIT RAMP AND JEFFERSON AVENUE-
RECONSTRUCTION AT THE JOE LOUIS ARENA


PIER DETAILS
PIER 2

SCALE: NONE


DRN. NO. S35

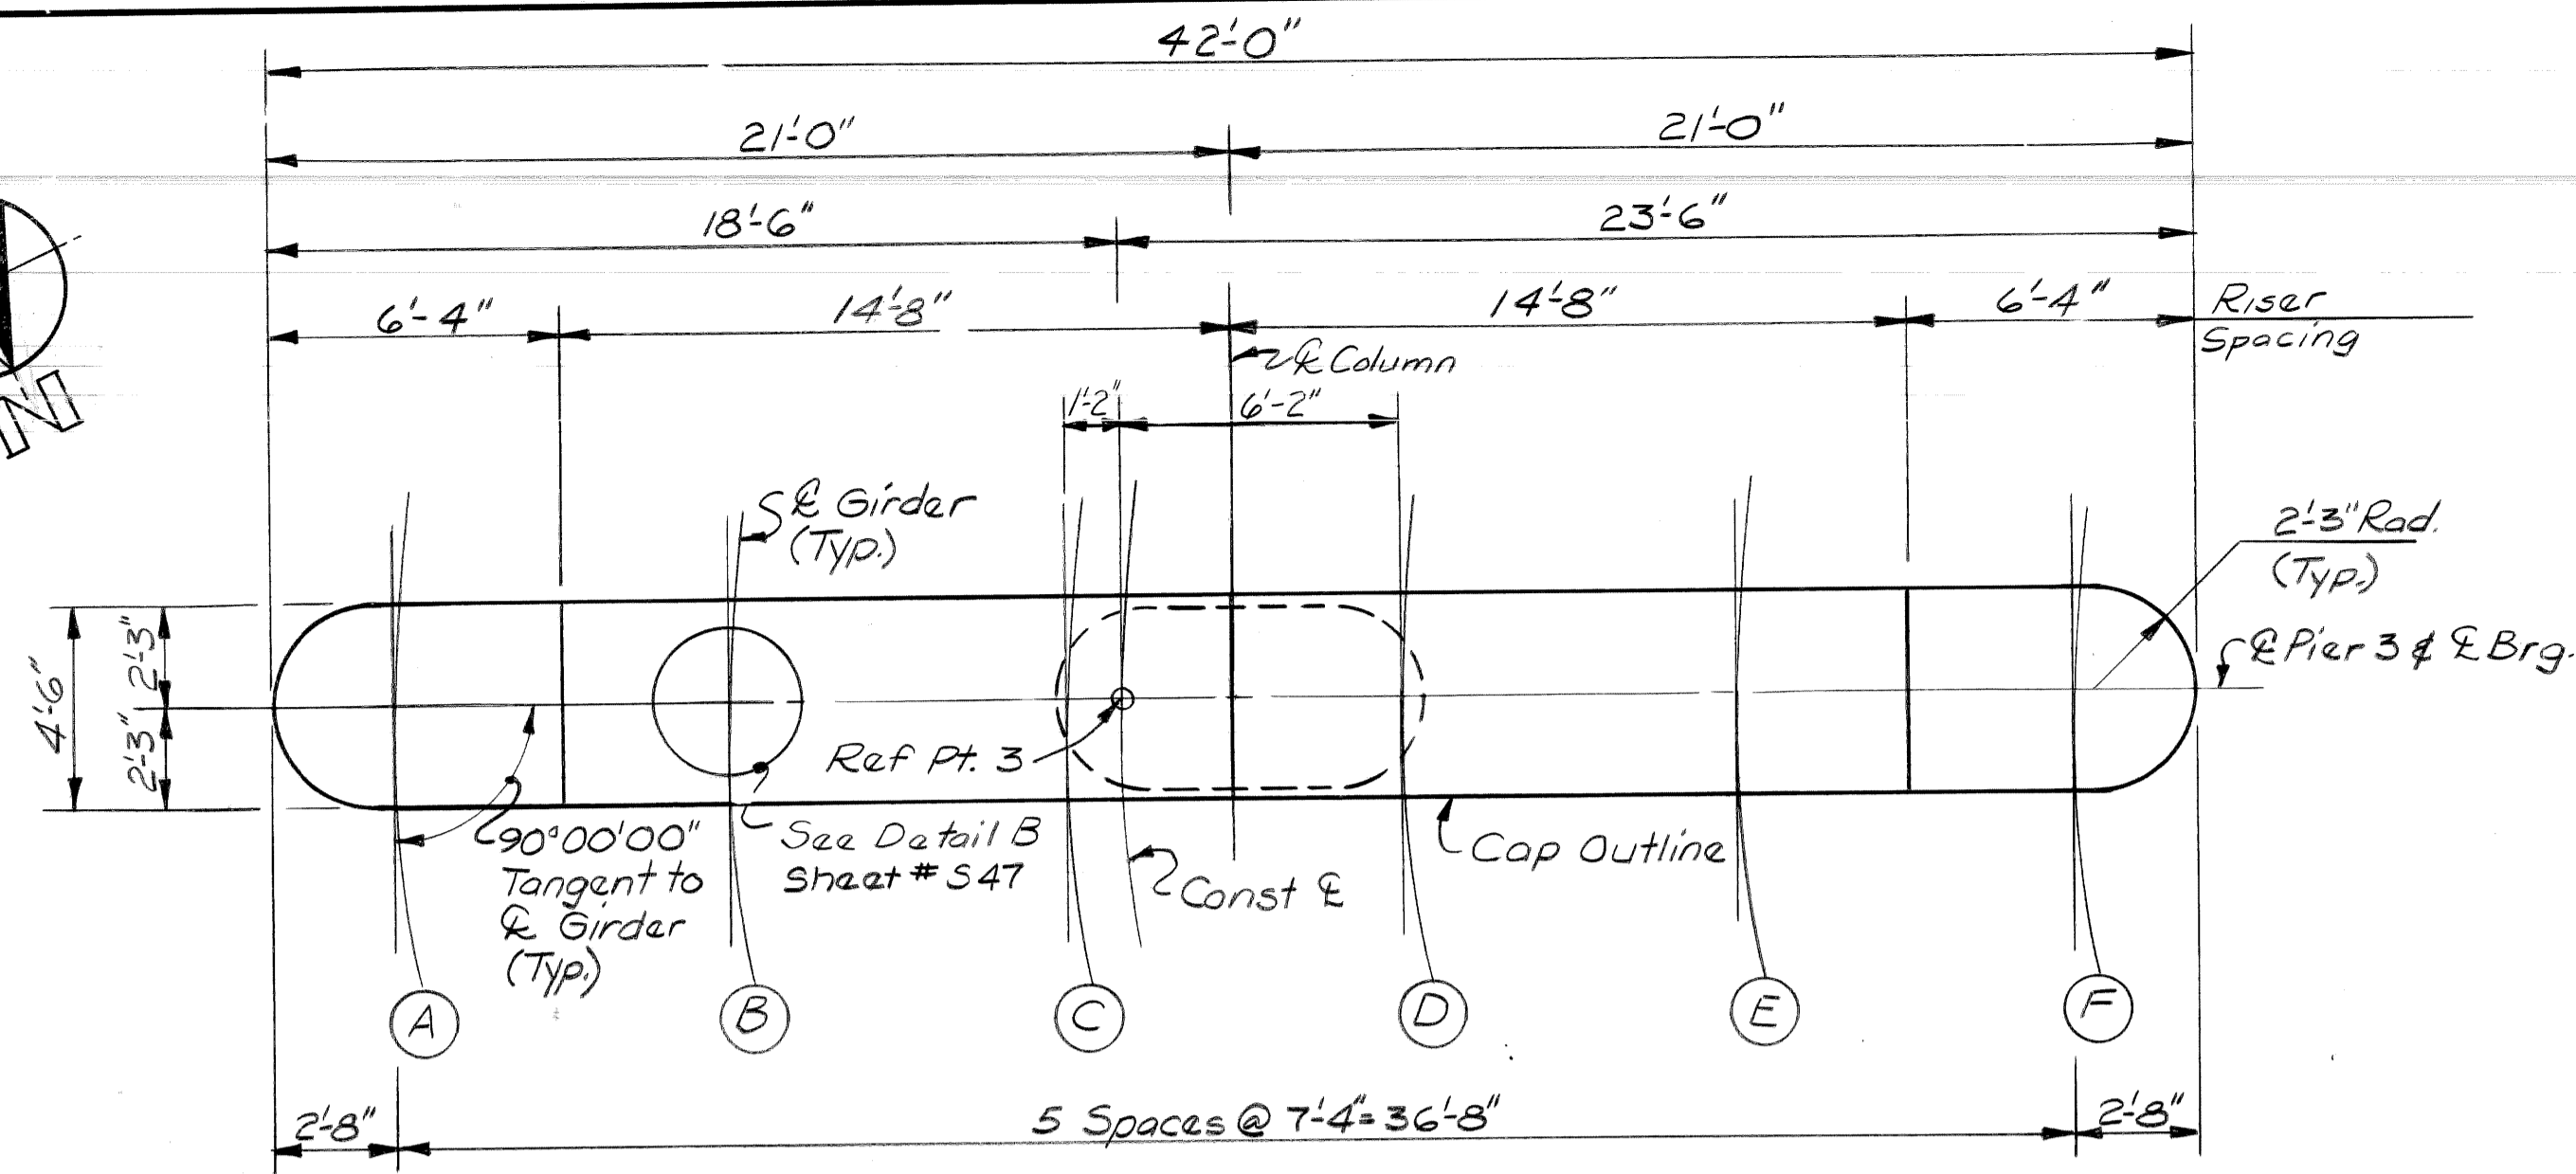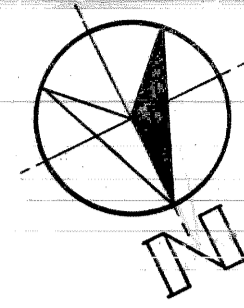


PLAN OF CAP

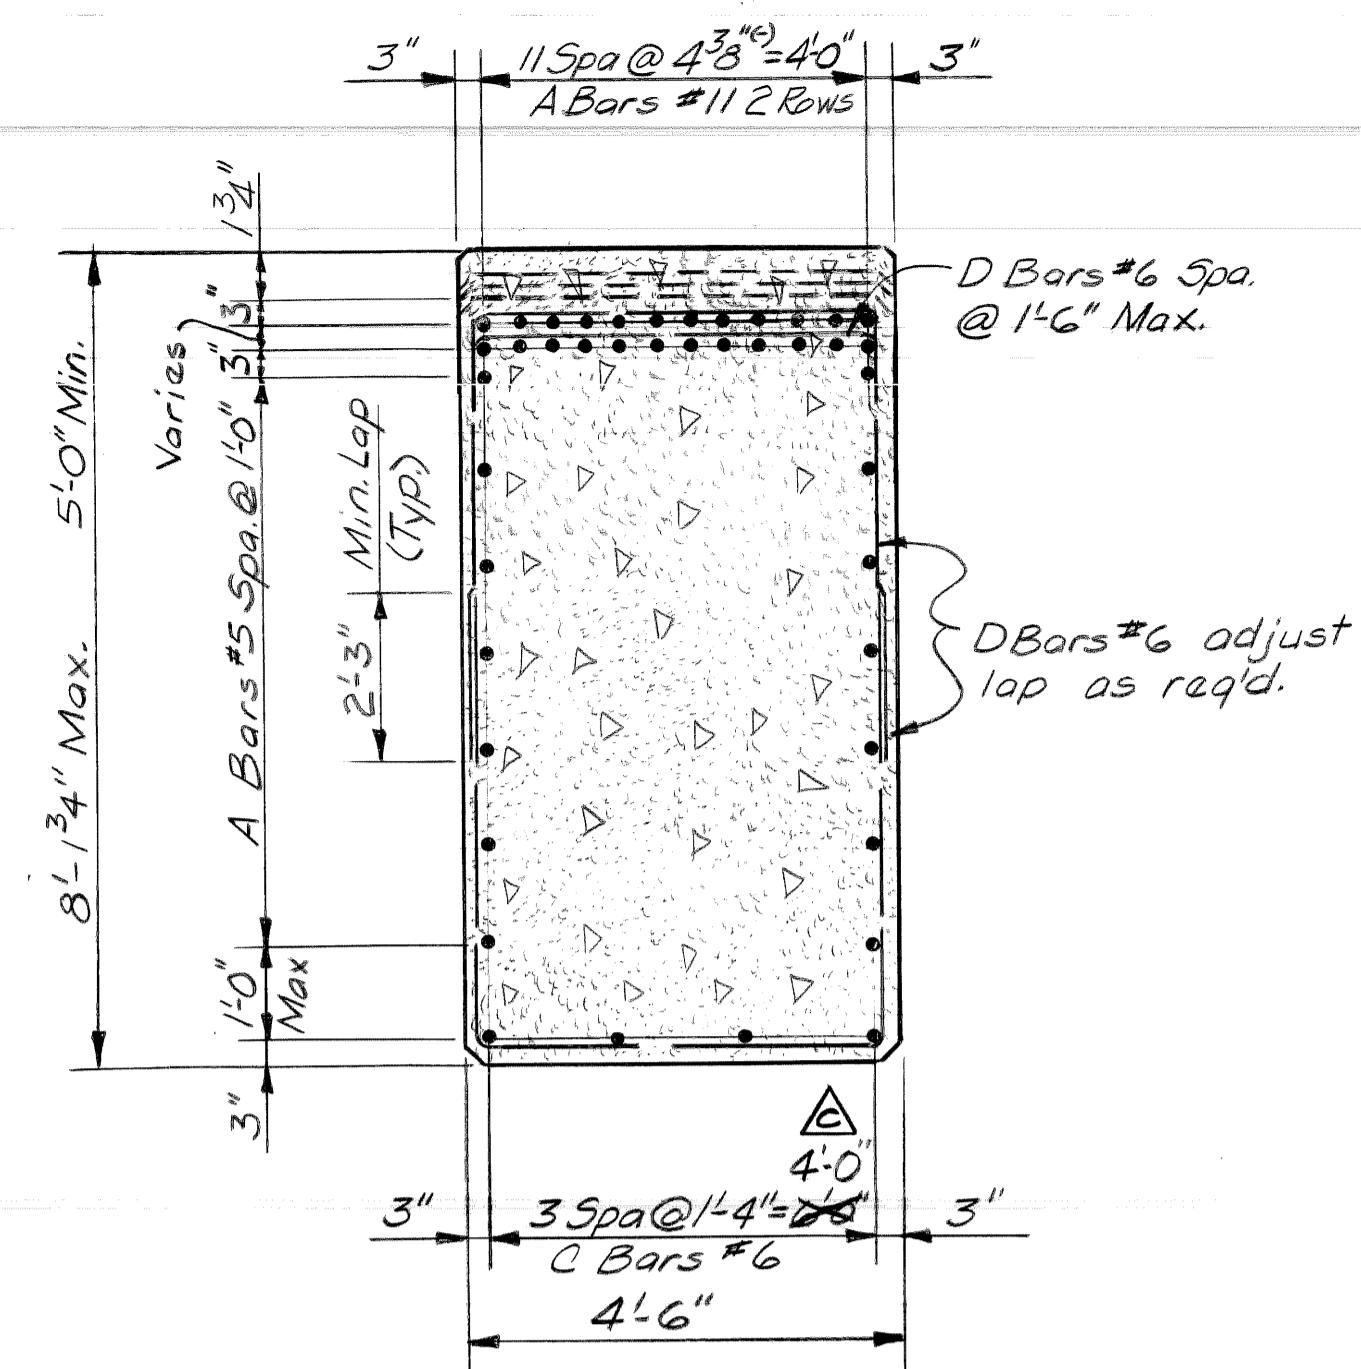


SECTION A-A

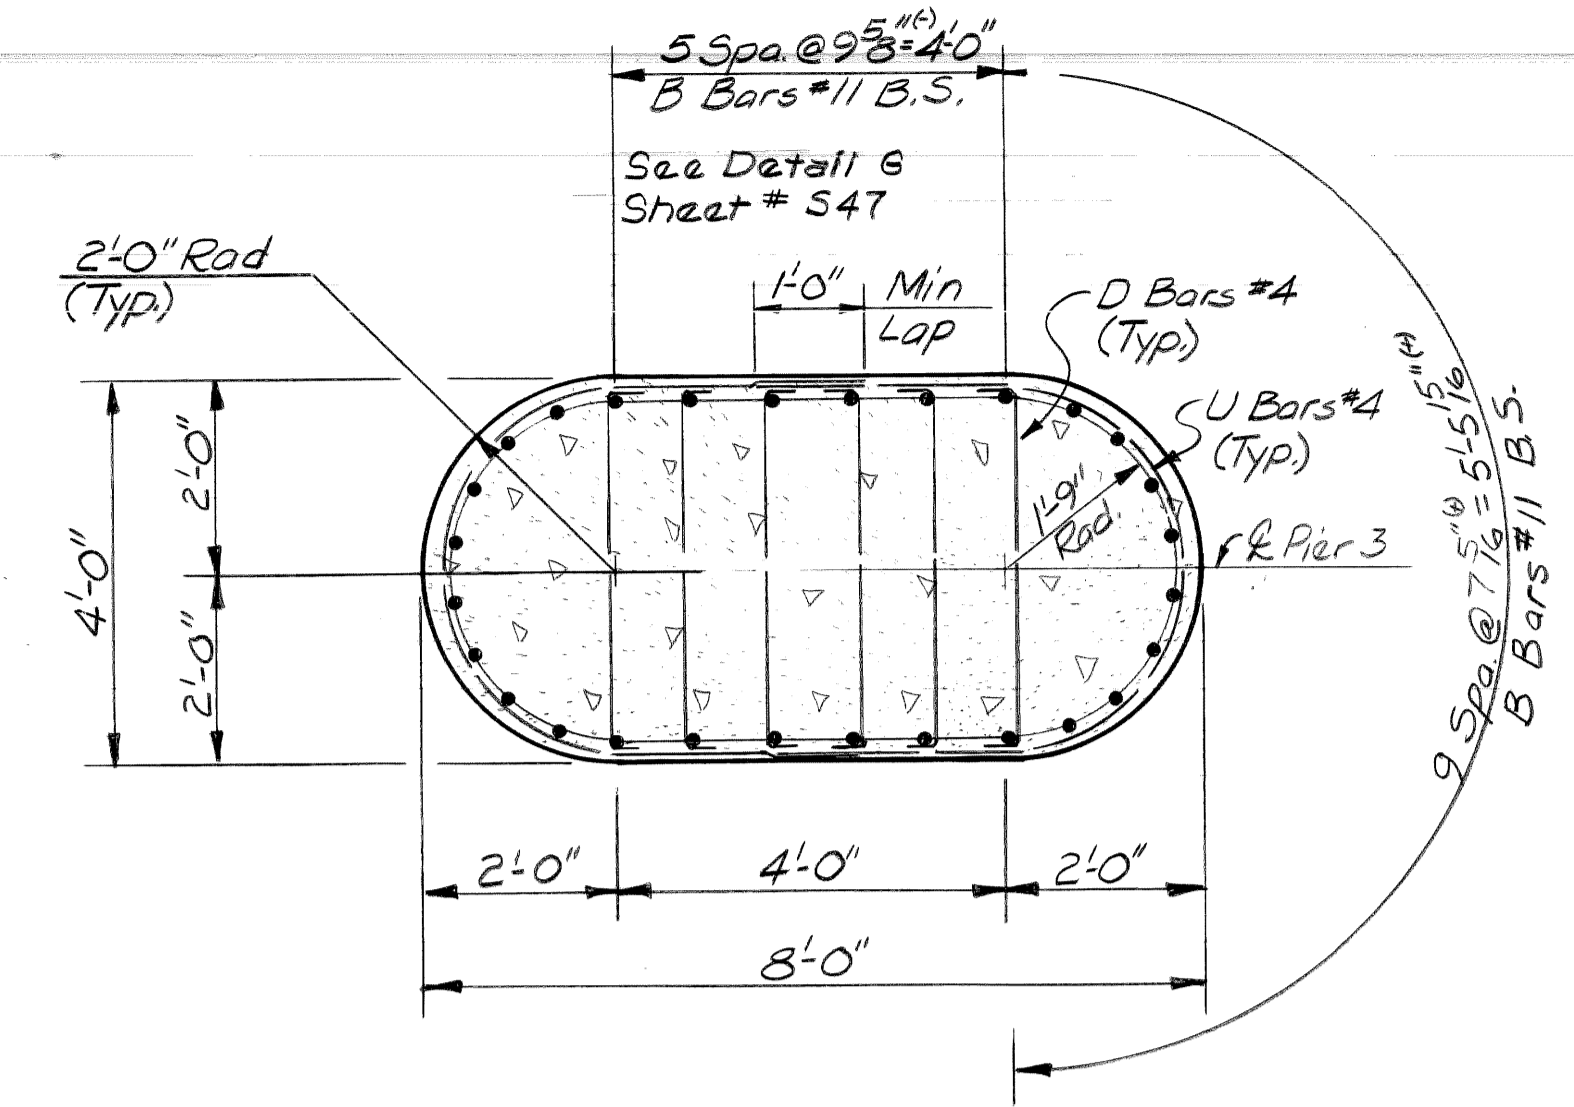



SECTION B-B

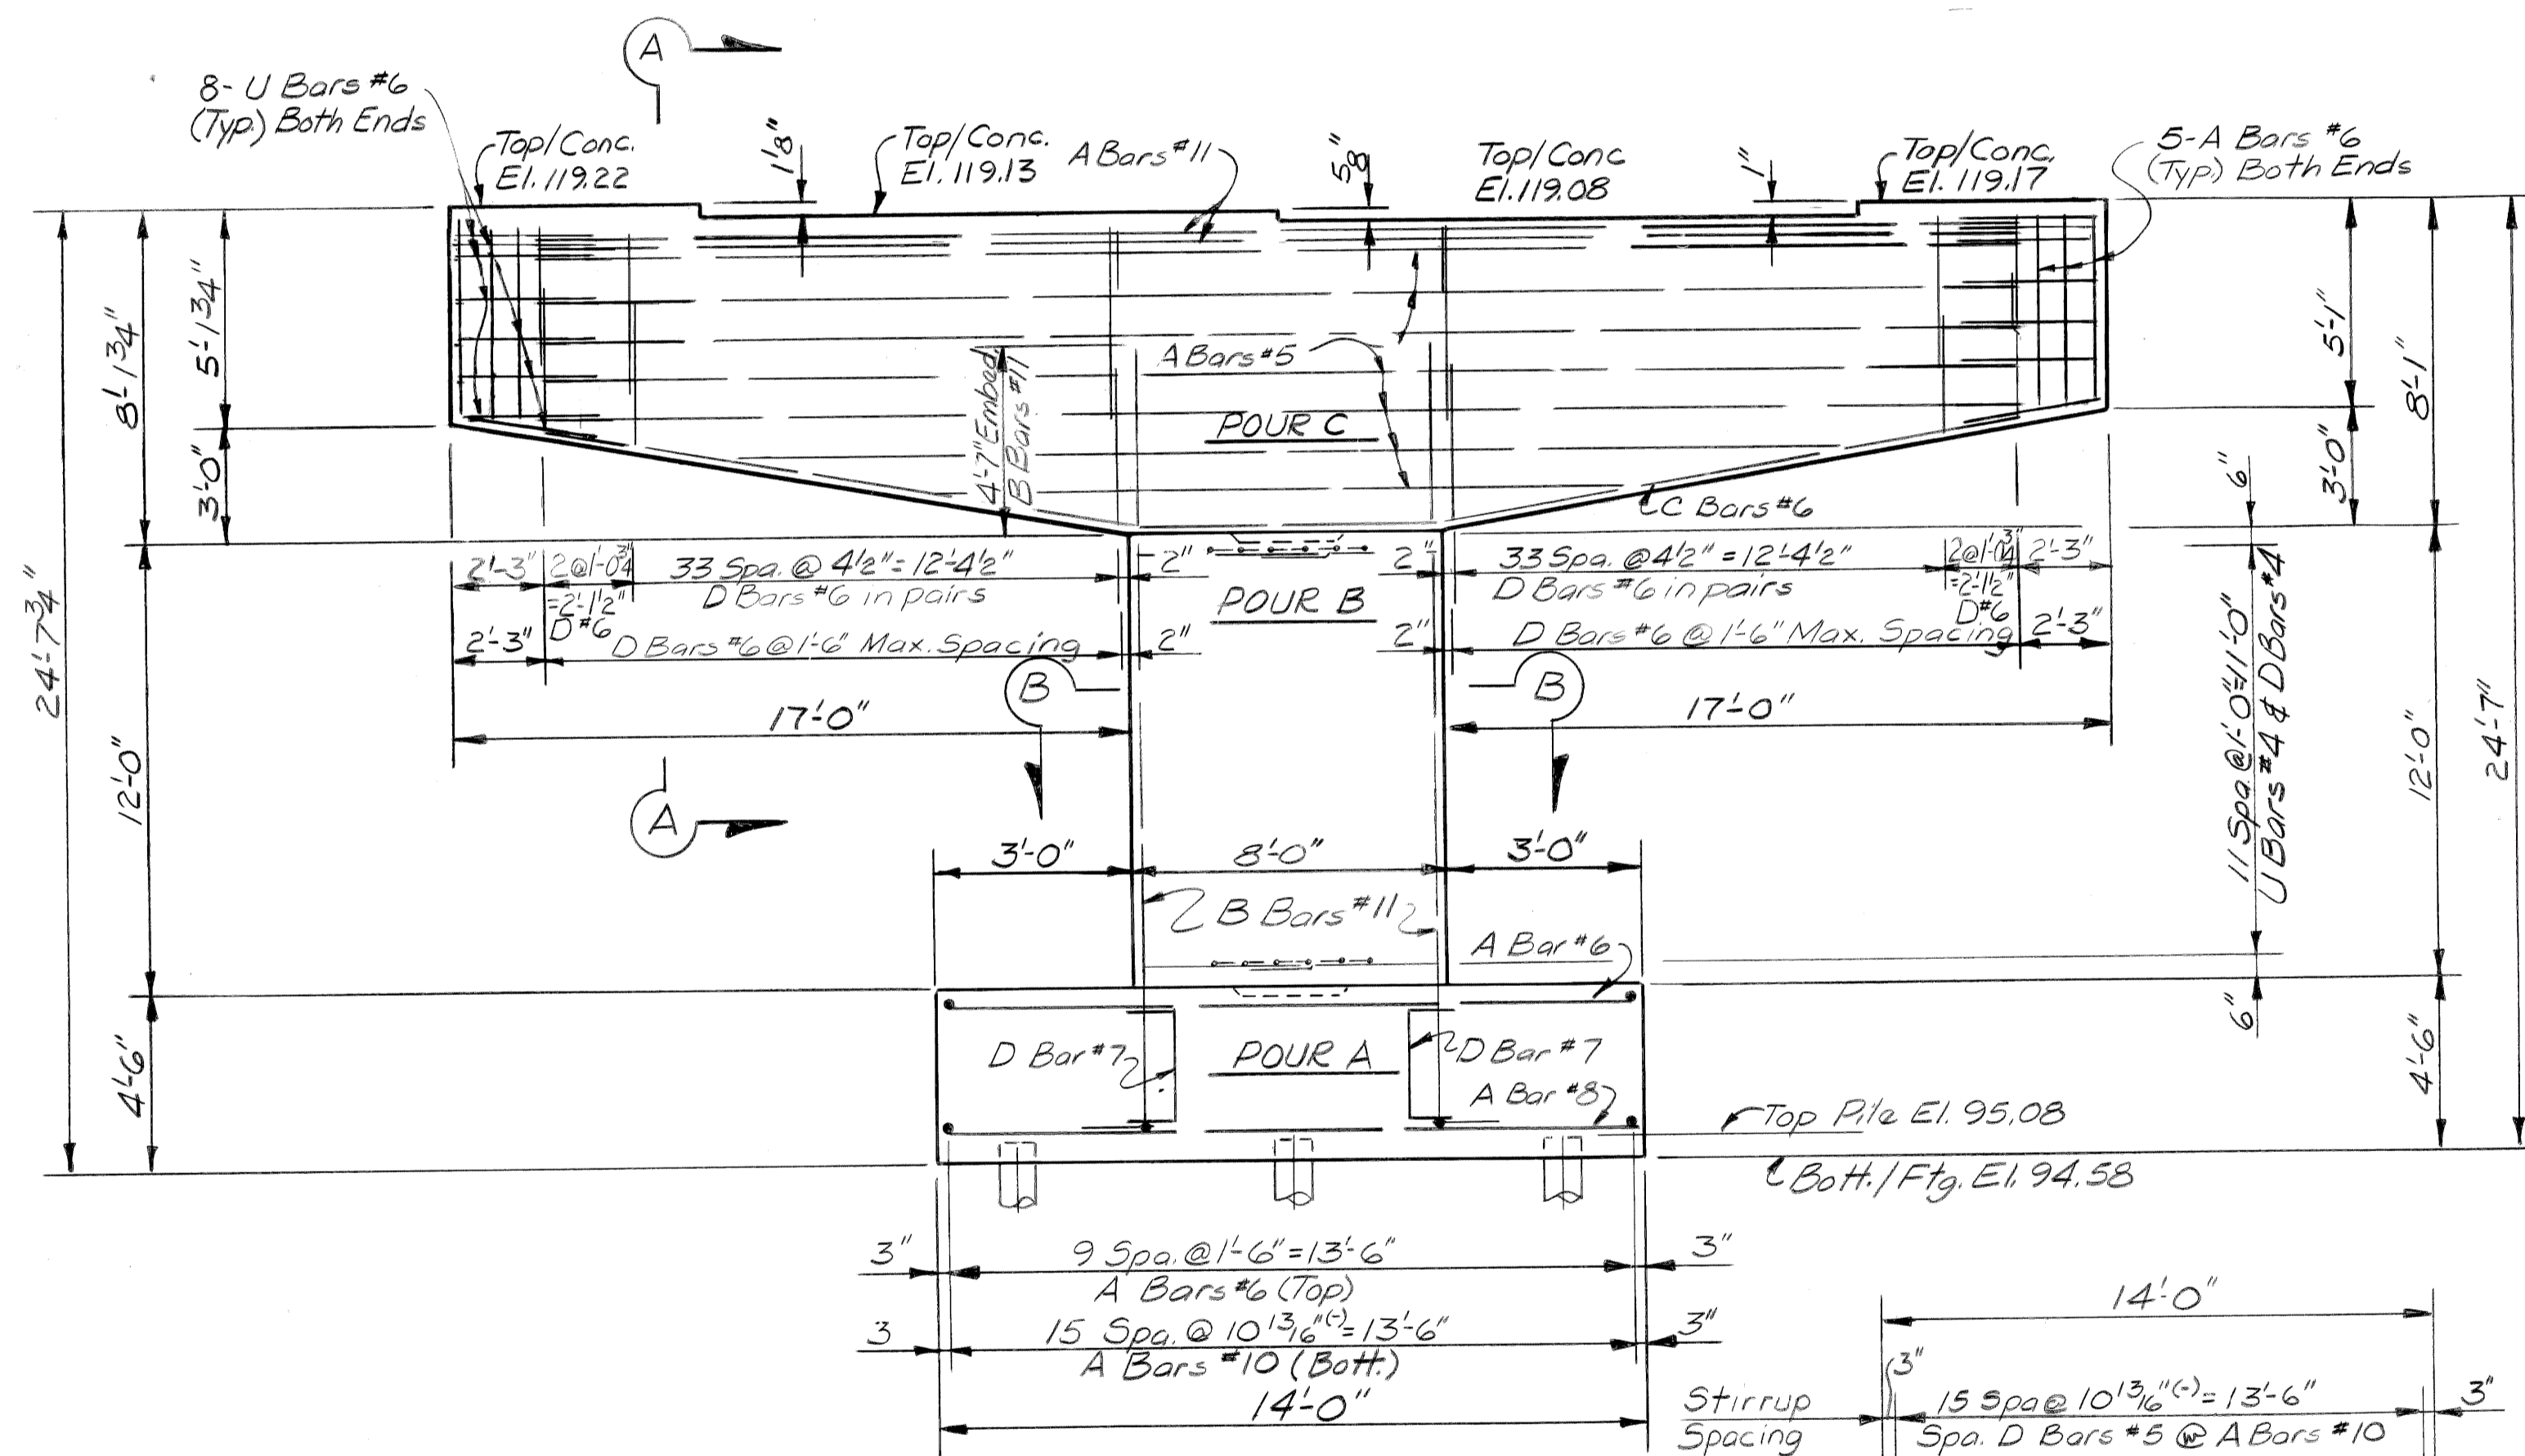

ELEVATION

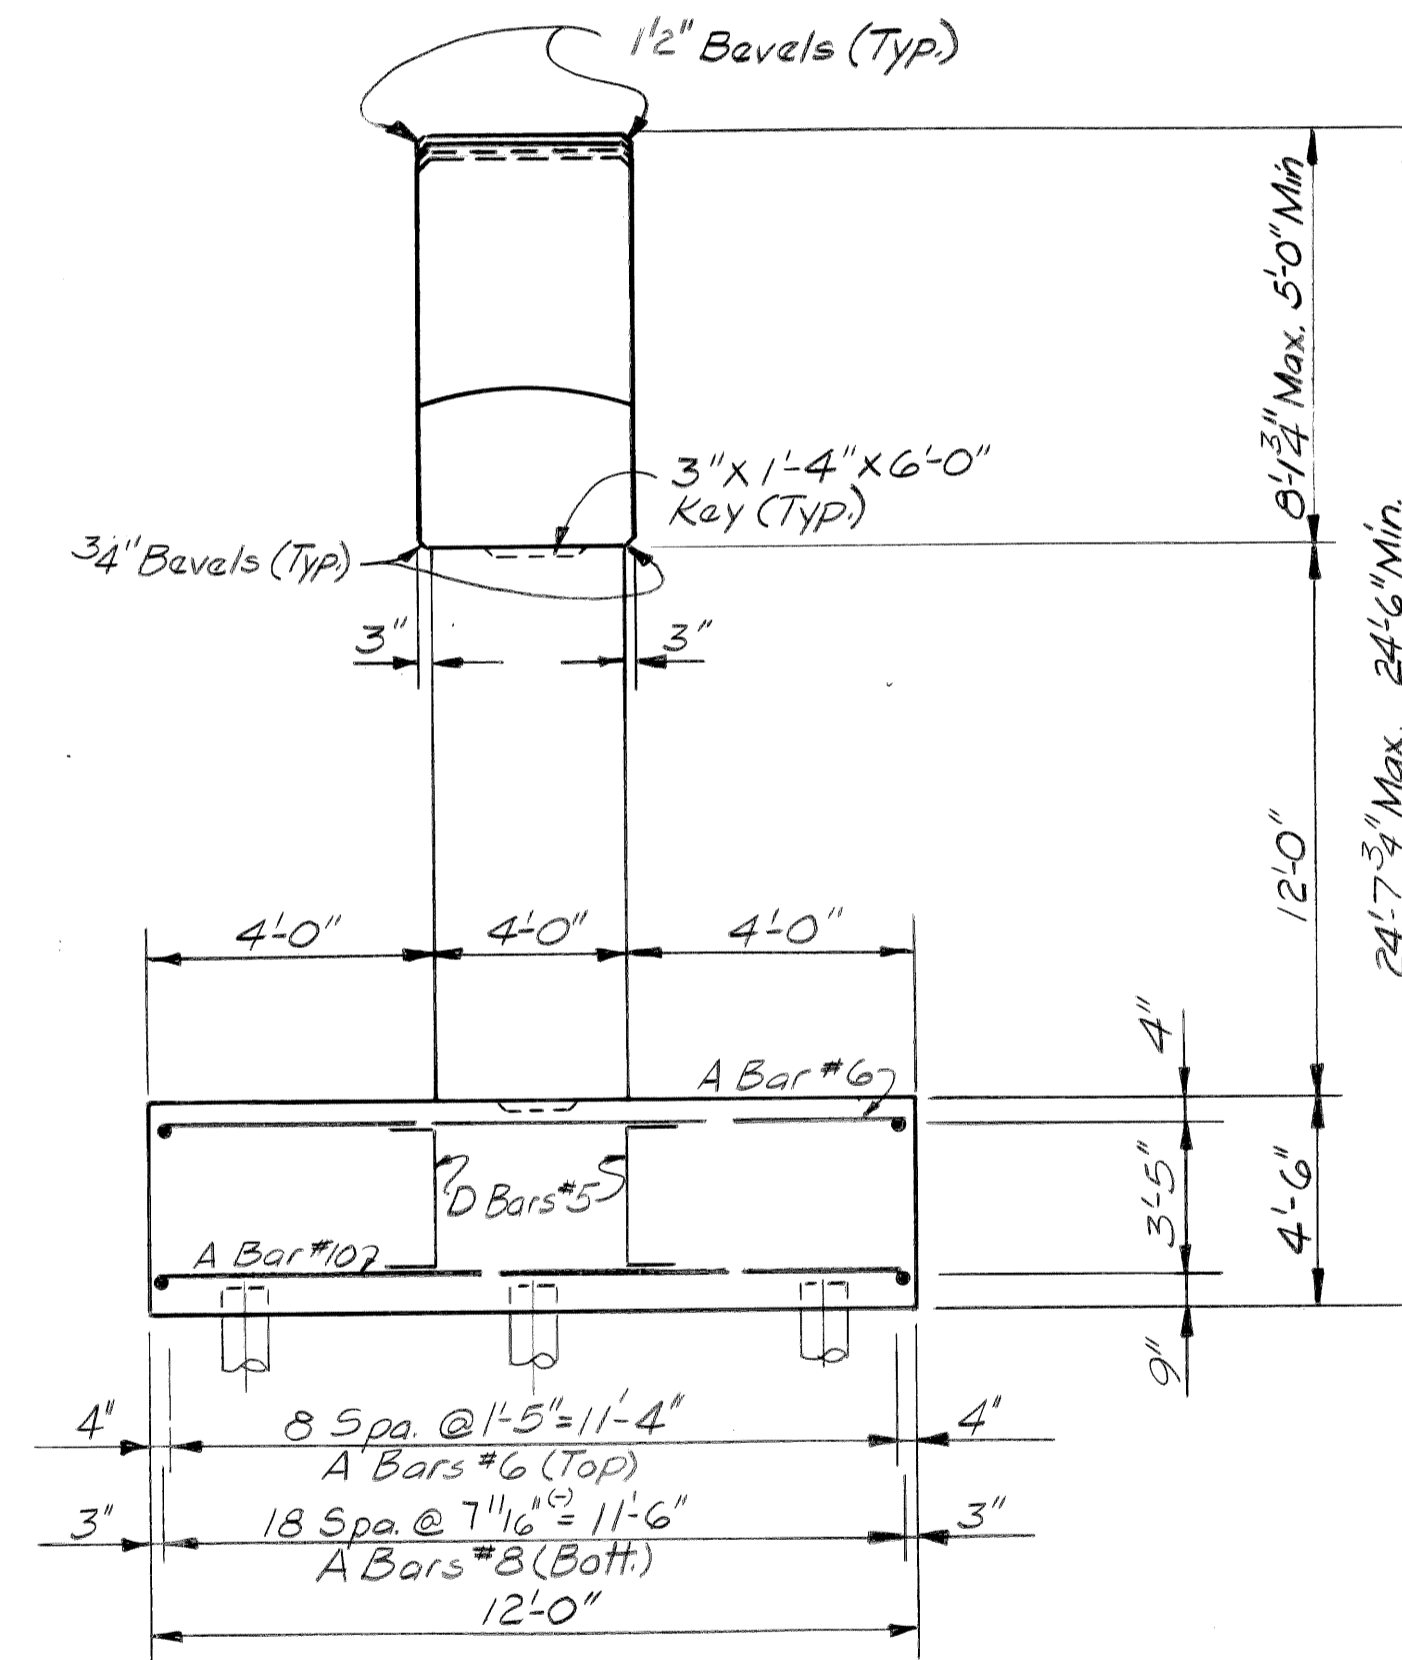

END VIEW

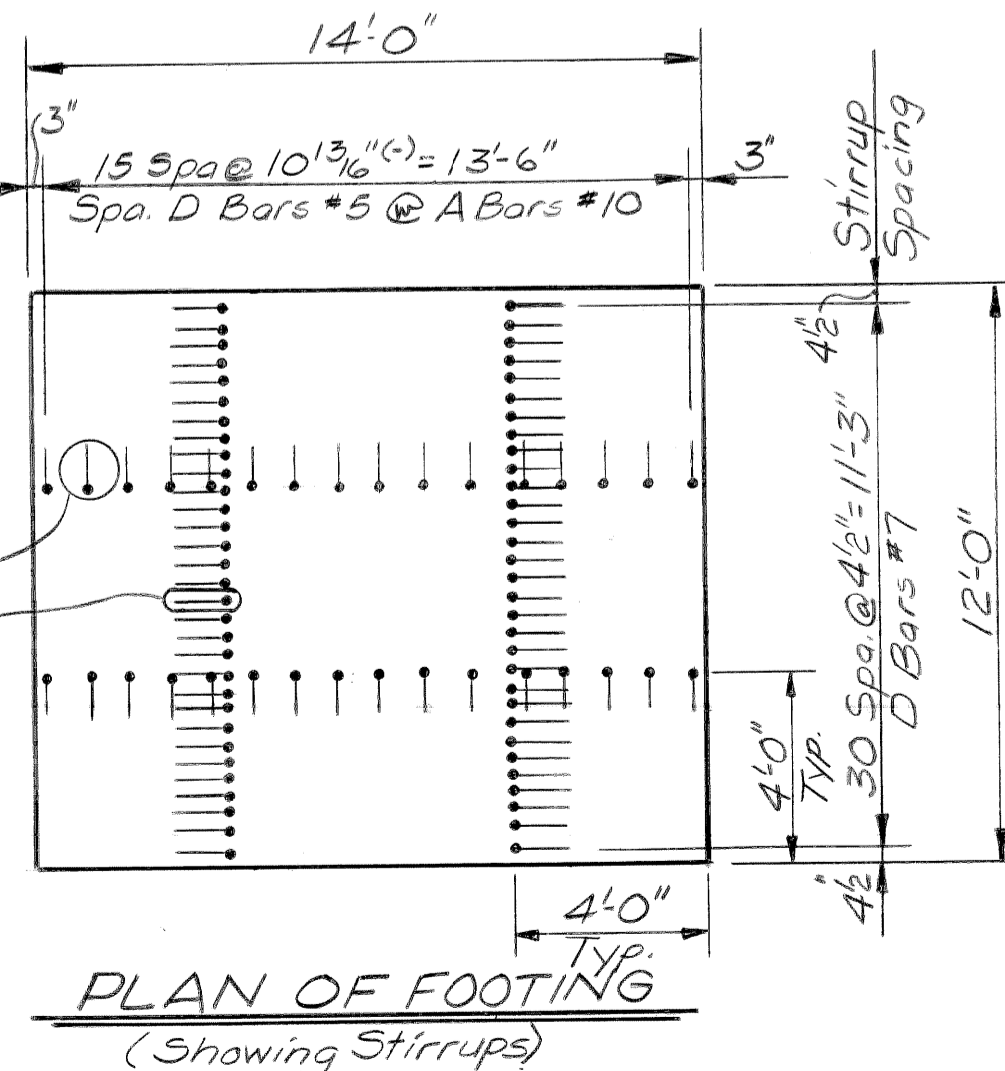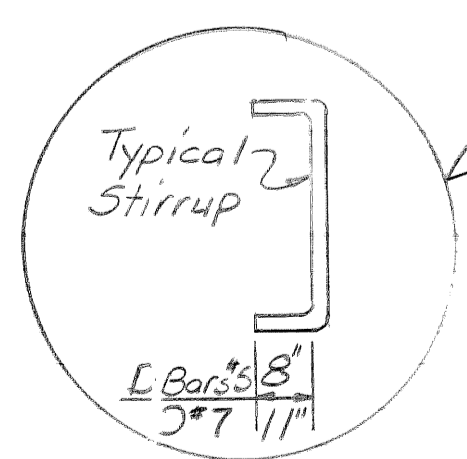

PLAN OF FOOTING
(Showing Stirrups)

Work This Sheet With Sheets # 534, 535 & 537 thru 548

DATE: August, 1977

DSGN BY:	RGW, MH
DRN BY:	MH
CK'D BY:	RCN
APP'D BY:	

REVISIONS	Revise Dimension SSP 1-22-1980
-----------	--------------------------------



CITY OF DETROIT, MICHIGAN




JOHN C. LODGE EXIT RAMP AND JEFFERSON AVENUE-
RECONSTRUCTION AT THE JOE LOUIS ARENA

PIER DETAILS
PIER 3


SCALE: NONE
DRN. NO: S36

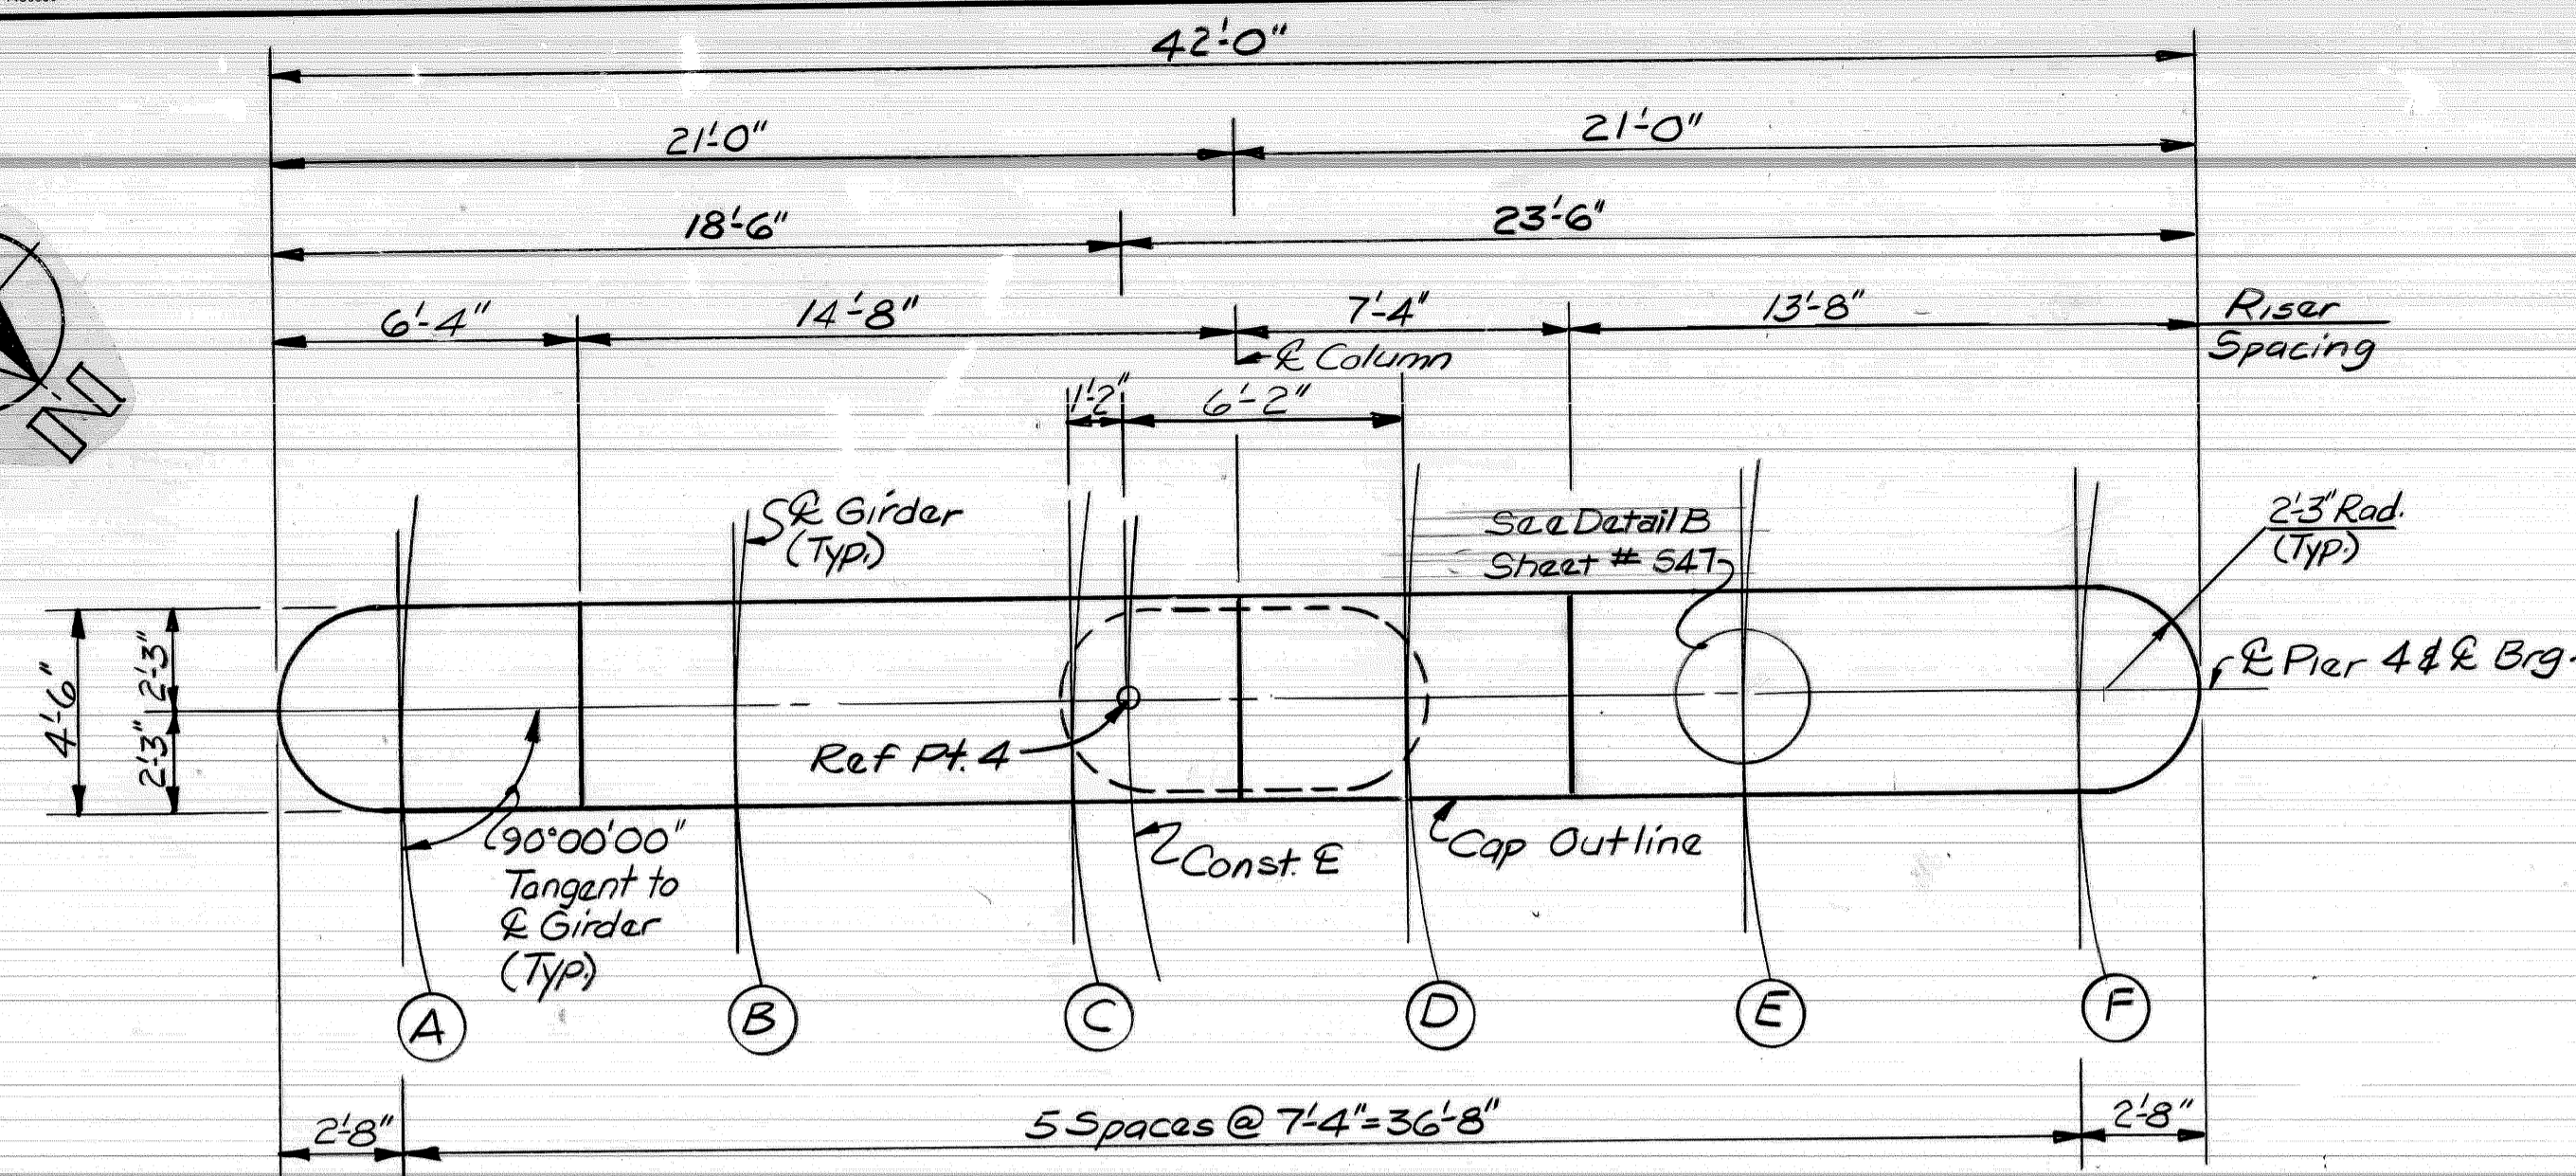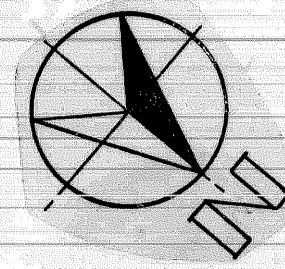


PLAN OF CAP

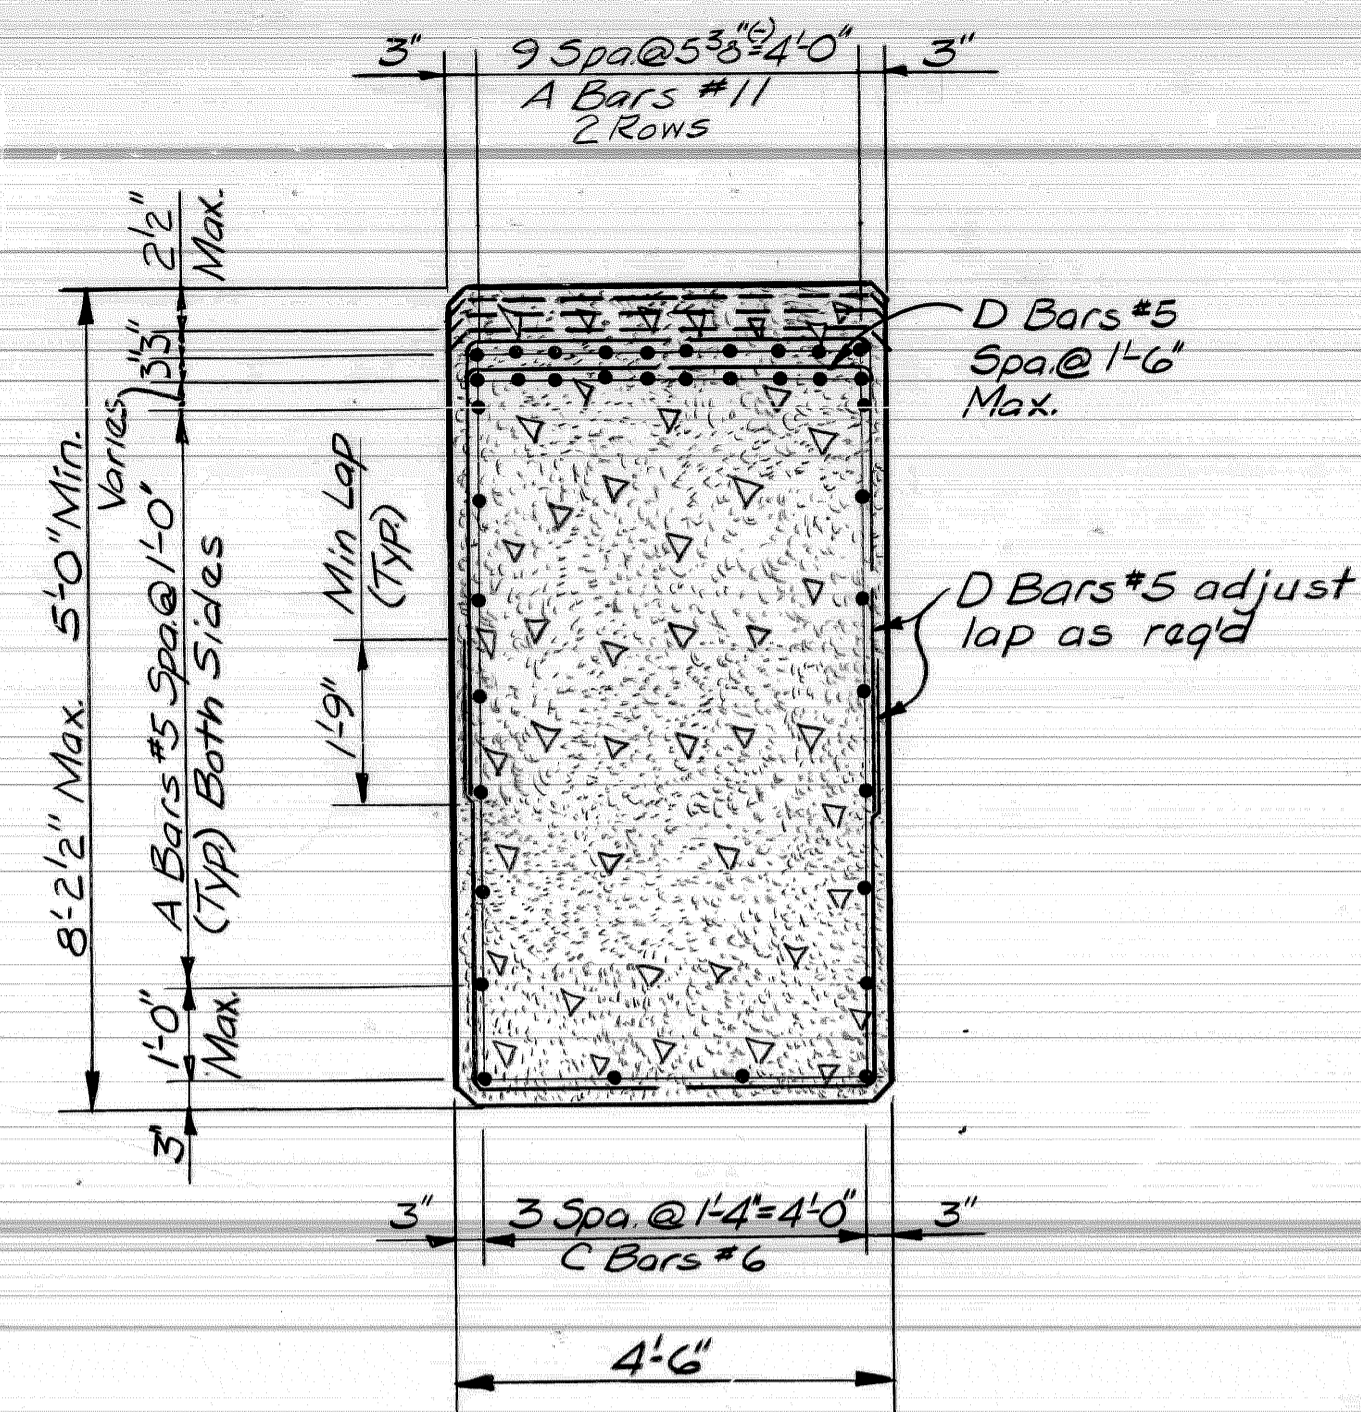


SECTION A-A

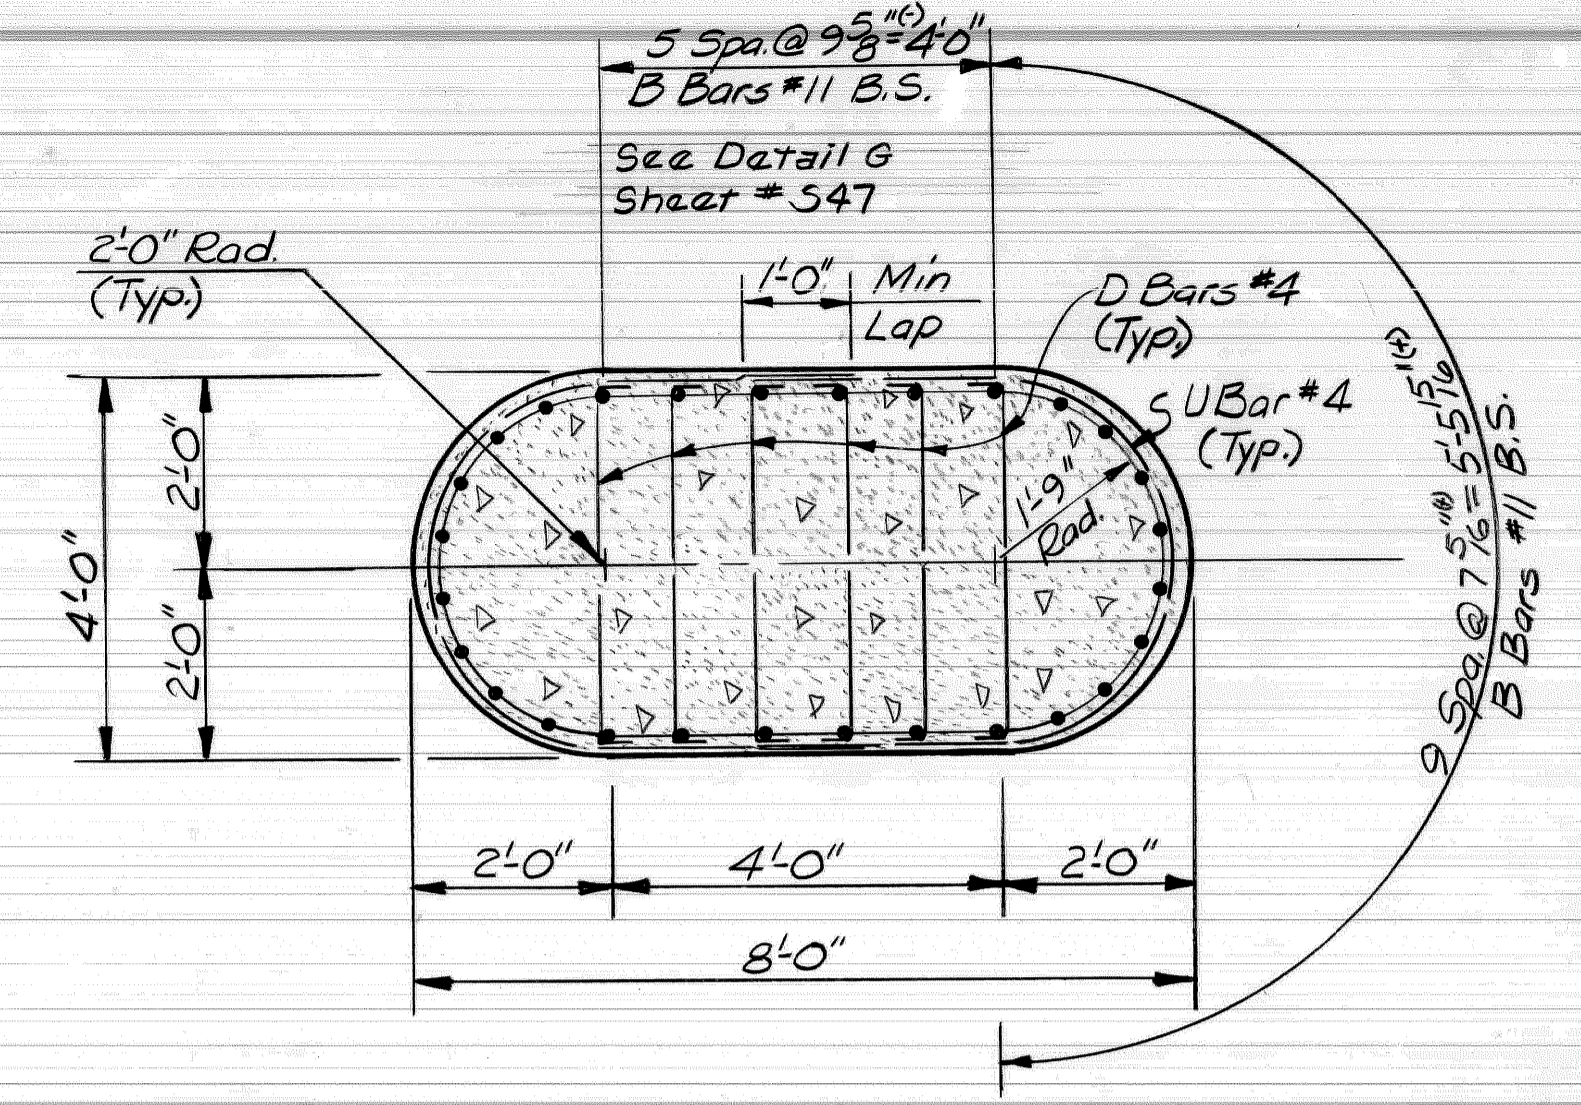


SECTION B-B

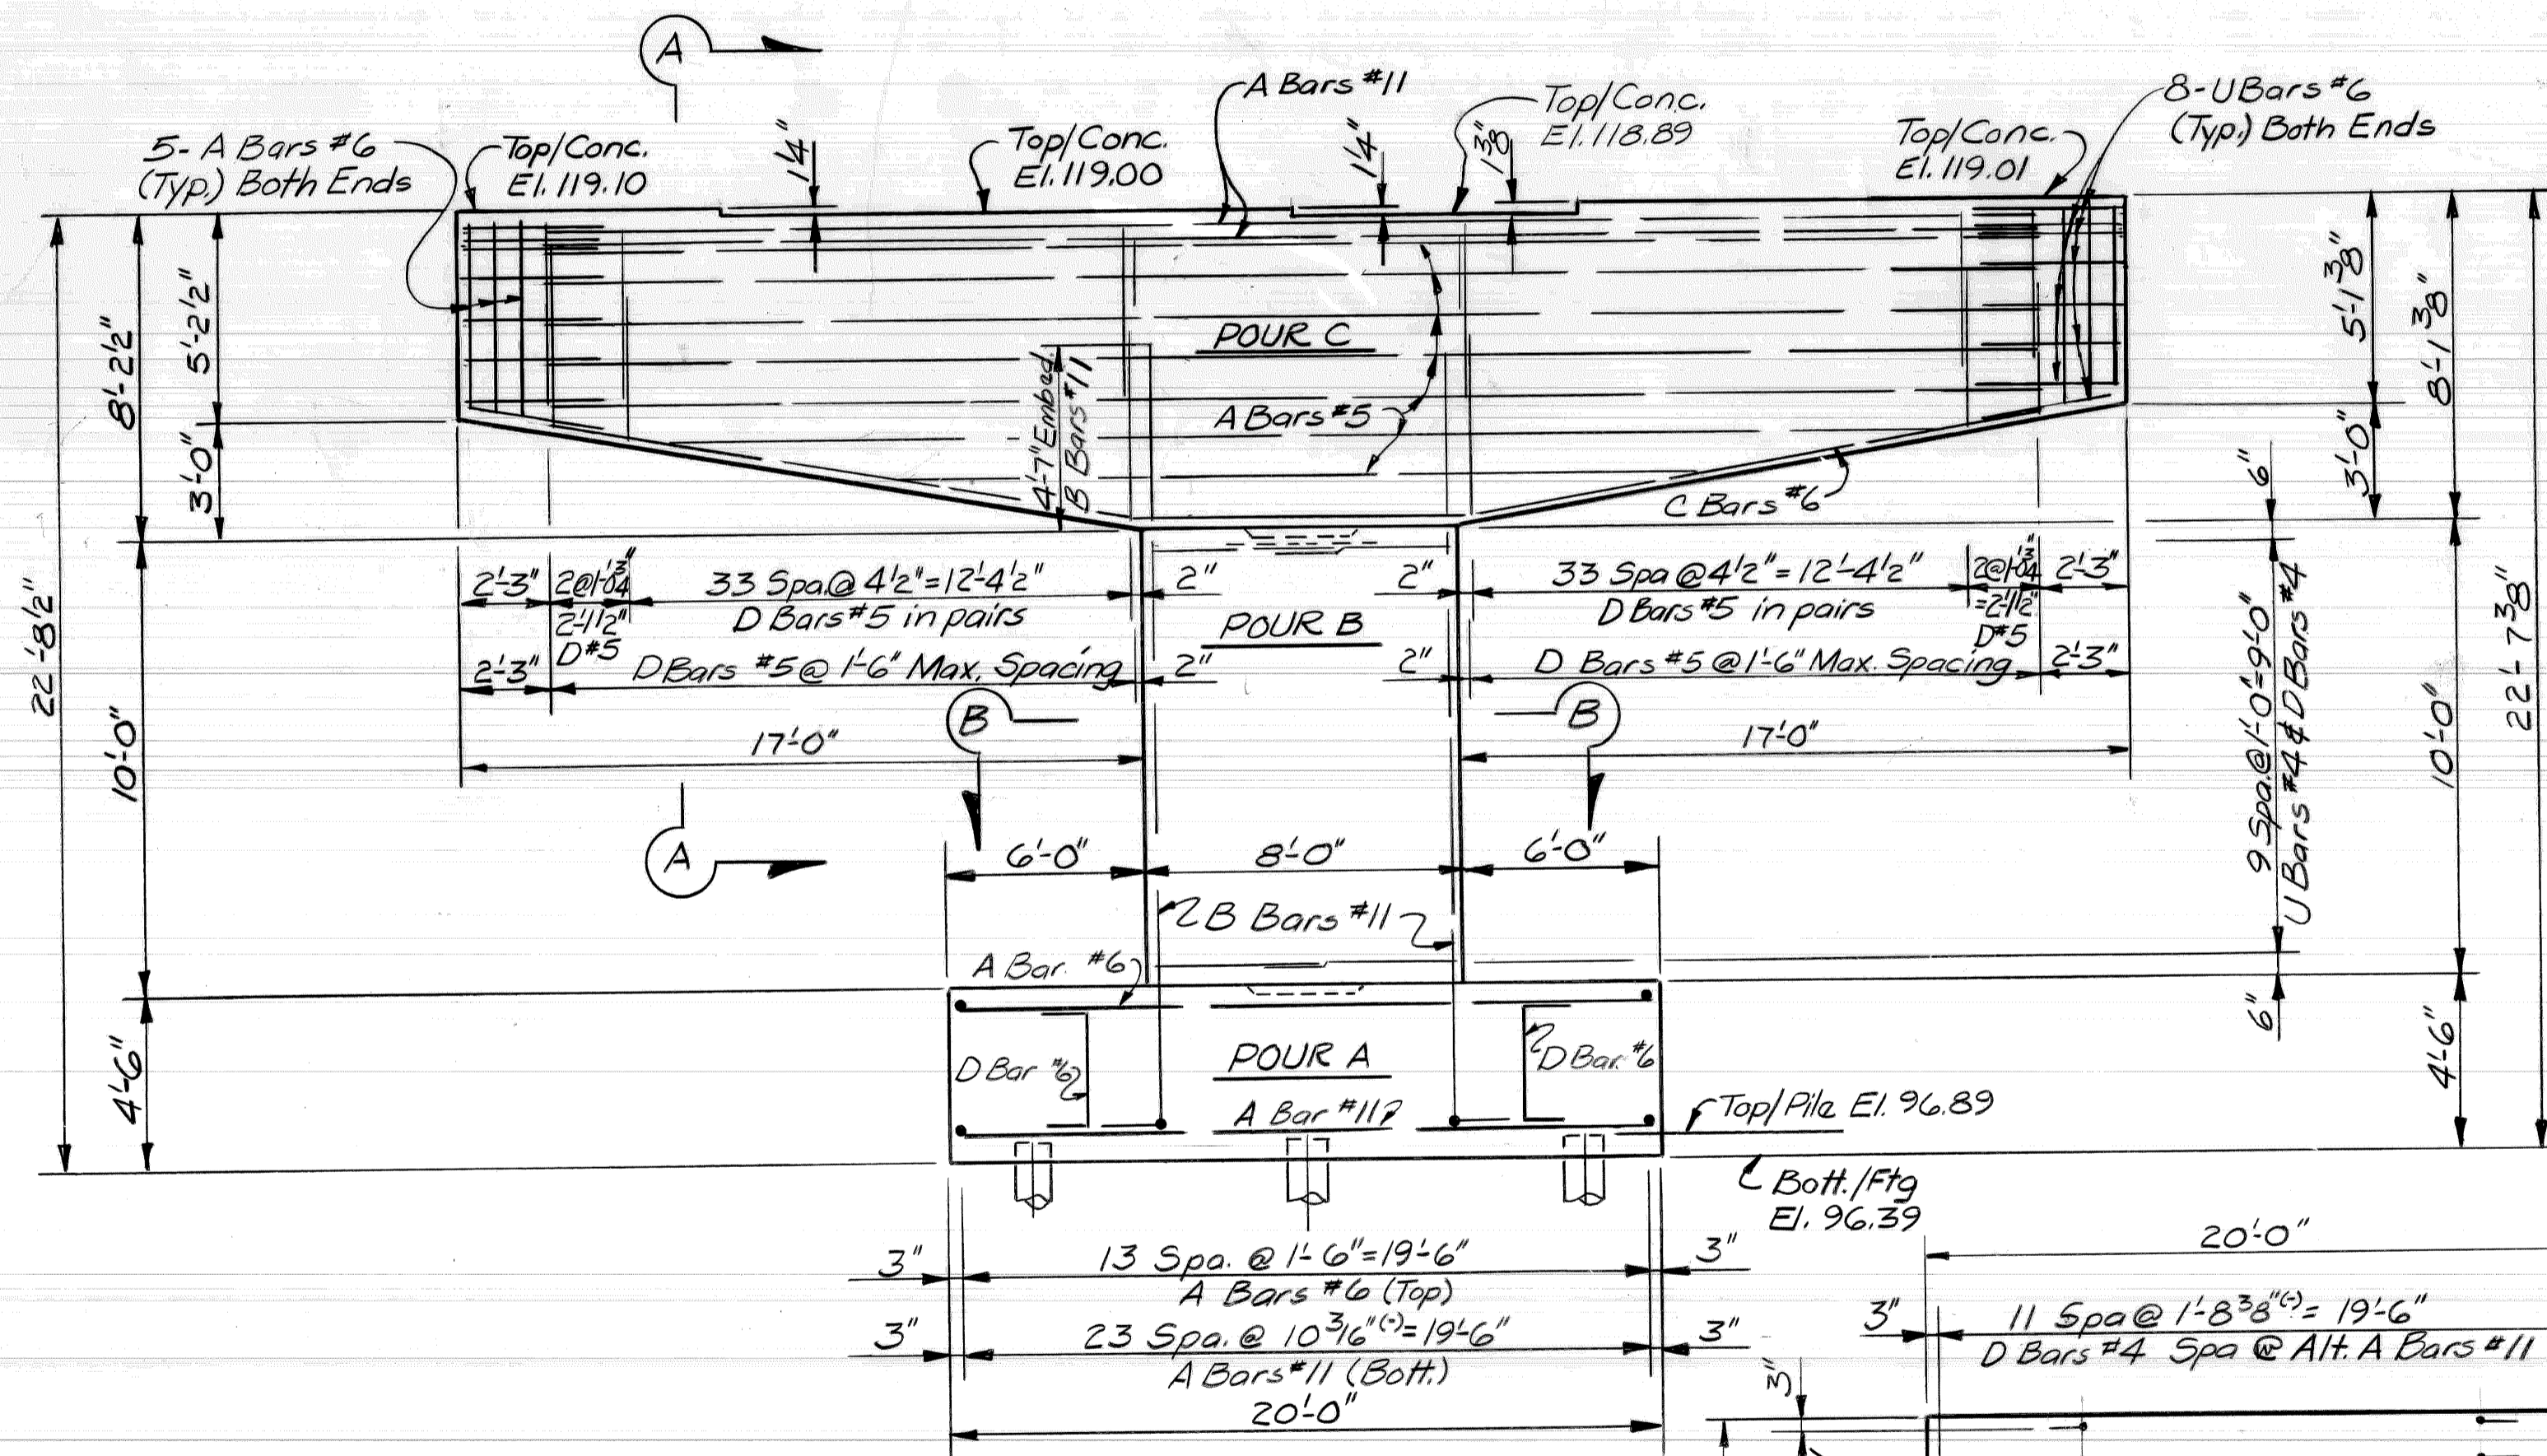

ELEVATION

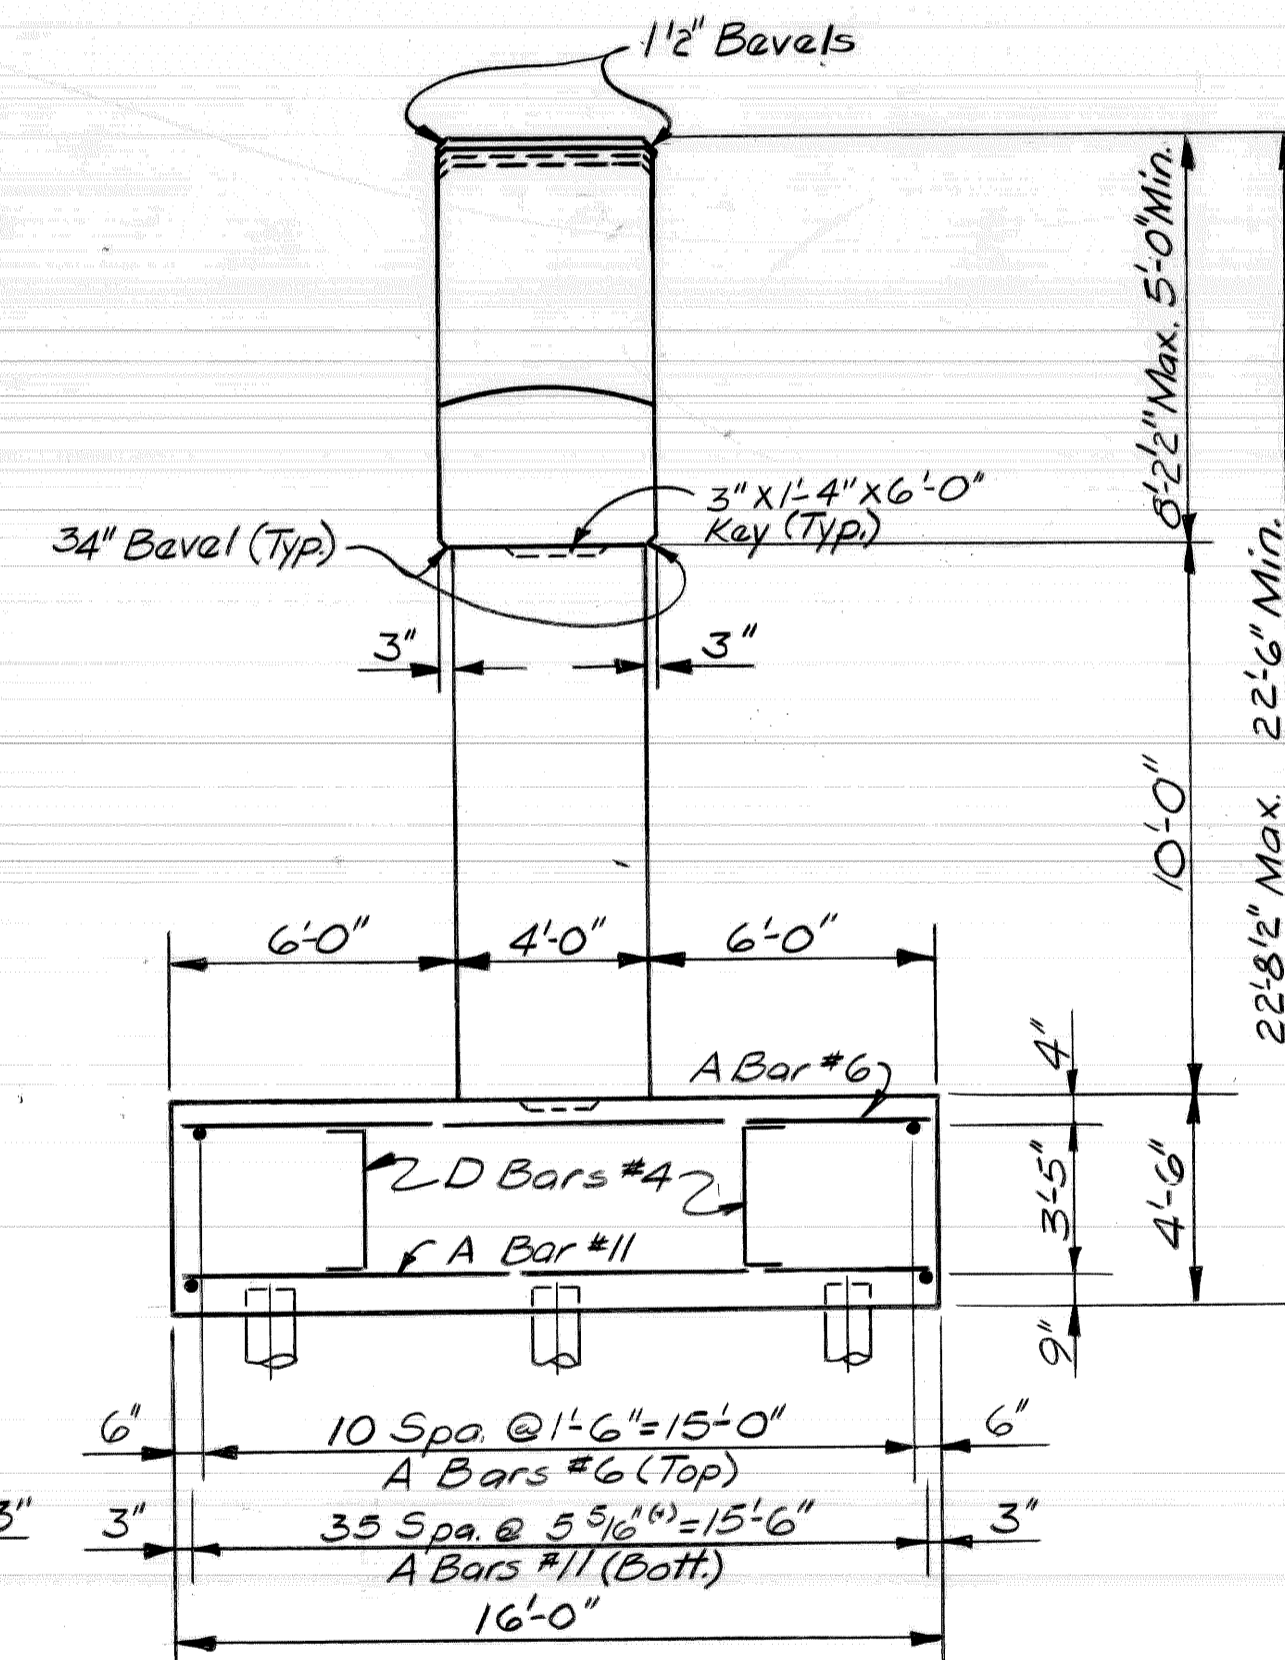

END VIEW

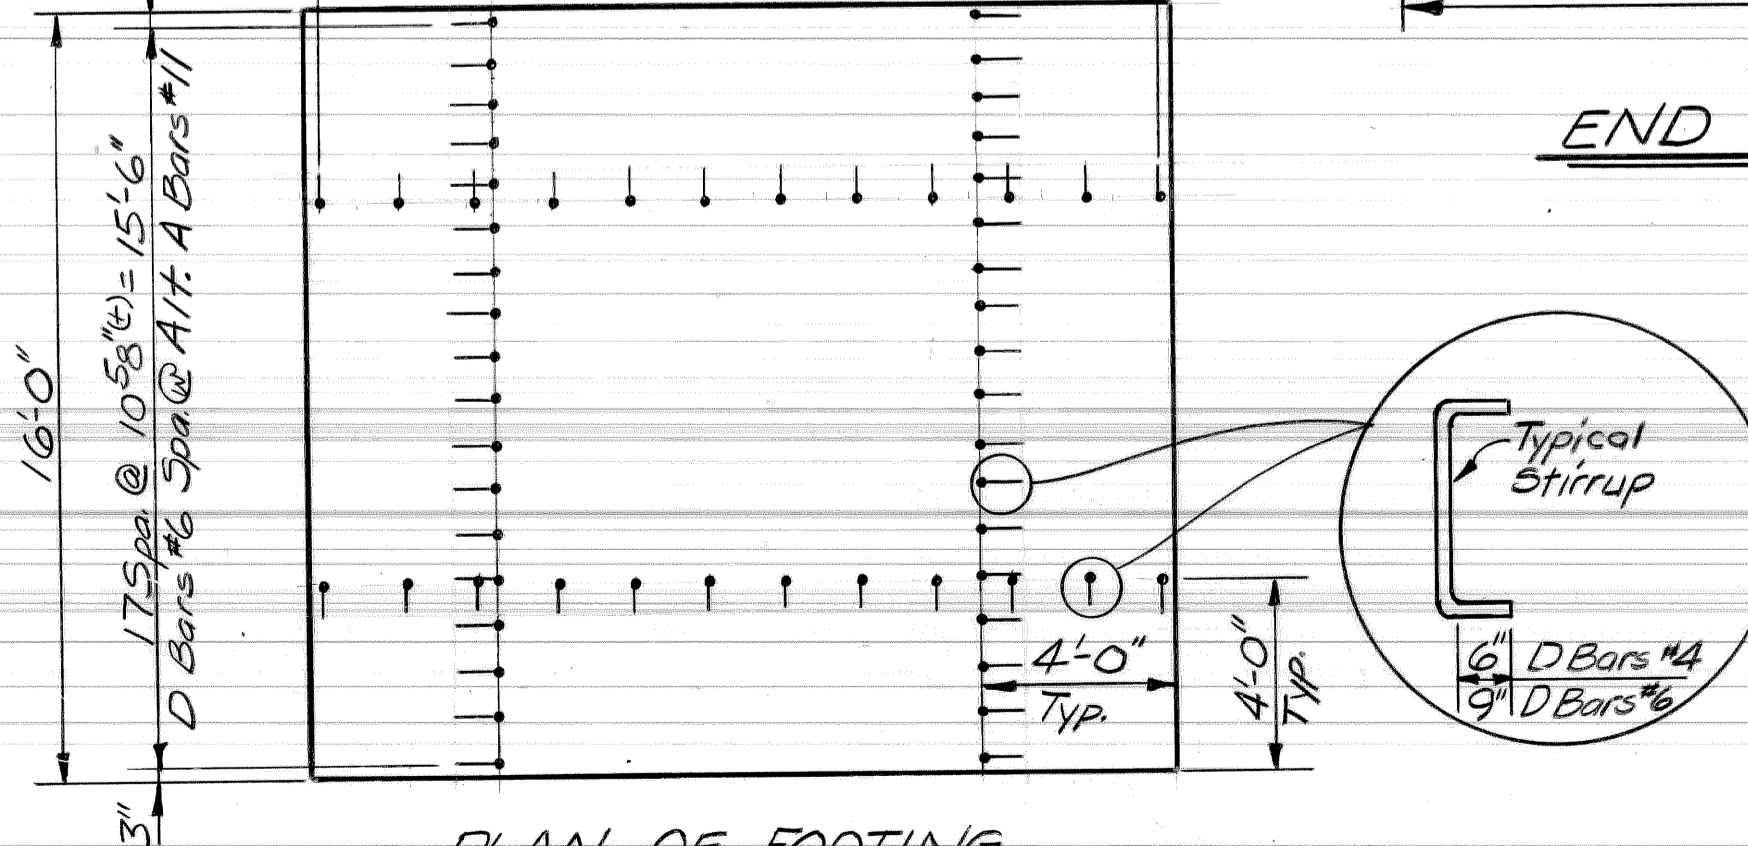

PLAN OF FOOTING
(Showing Stirrups)


Work This Sheet With Sheets # S34 thru S36 & S38 thru S48

DATE: August, 1979

DSGN BY:	RGW, MH
DR'N BY:	MH
CK'D BY:	RGW
APP'D BY:	

REVISIONS	


CITY OF DETROIT, MICHIGAN

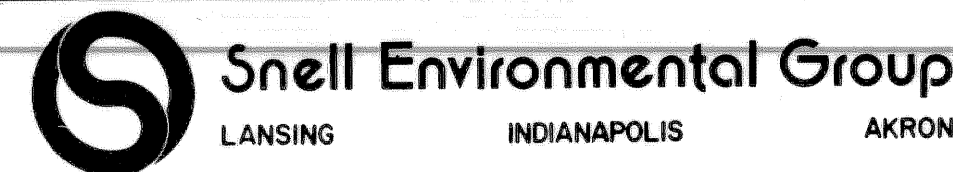


JOHN C. LODGE EXIT RAMP AND JEFFERSON AVENUE-
RECONSTRUCTION AT THE JOE LOUIS ARENA

PIER DETAILS
PIER 4


SCALE: NONE
DRN. NO: S37

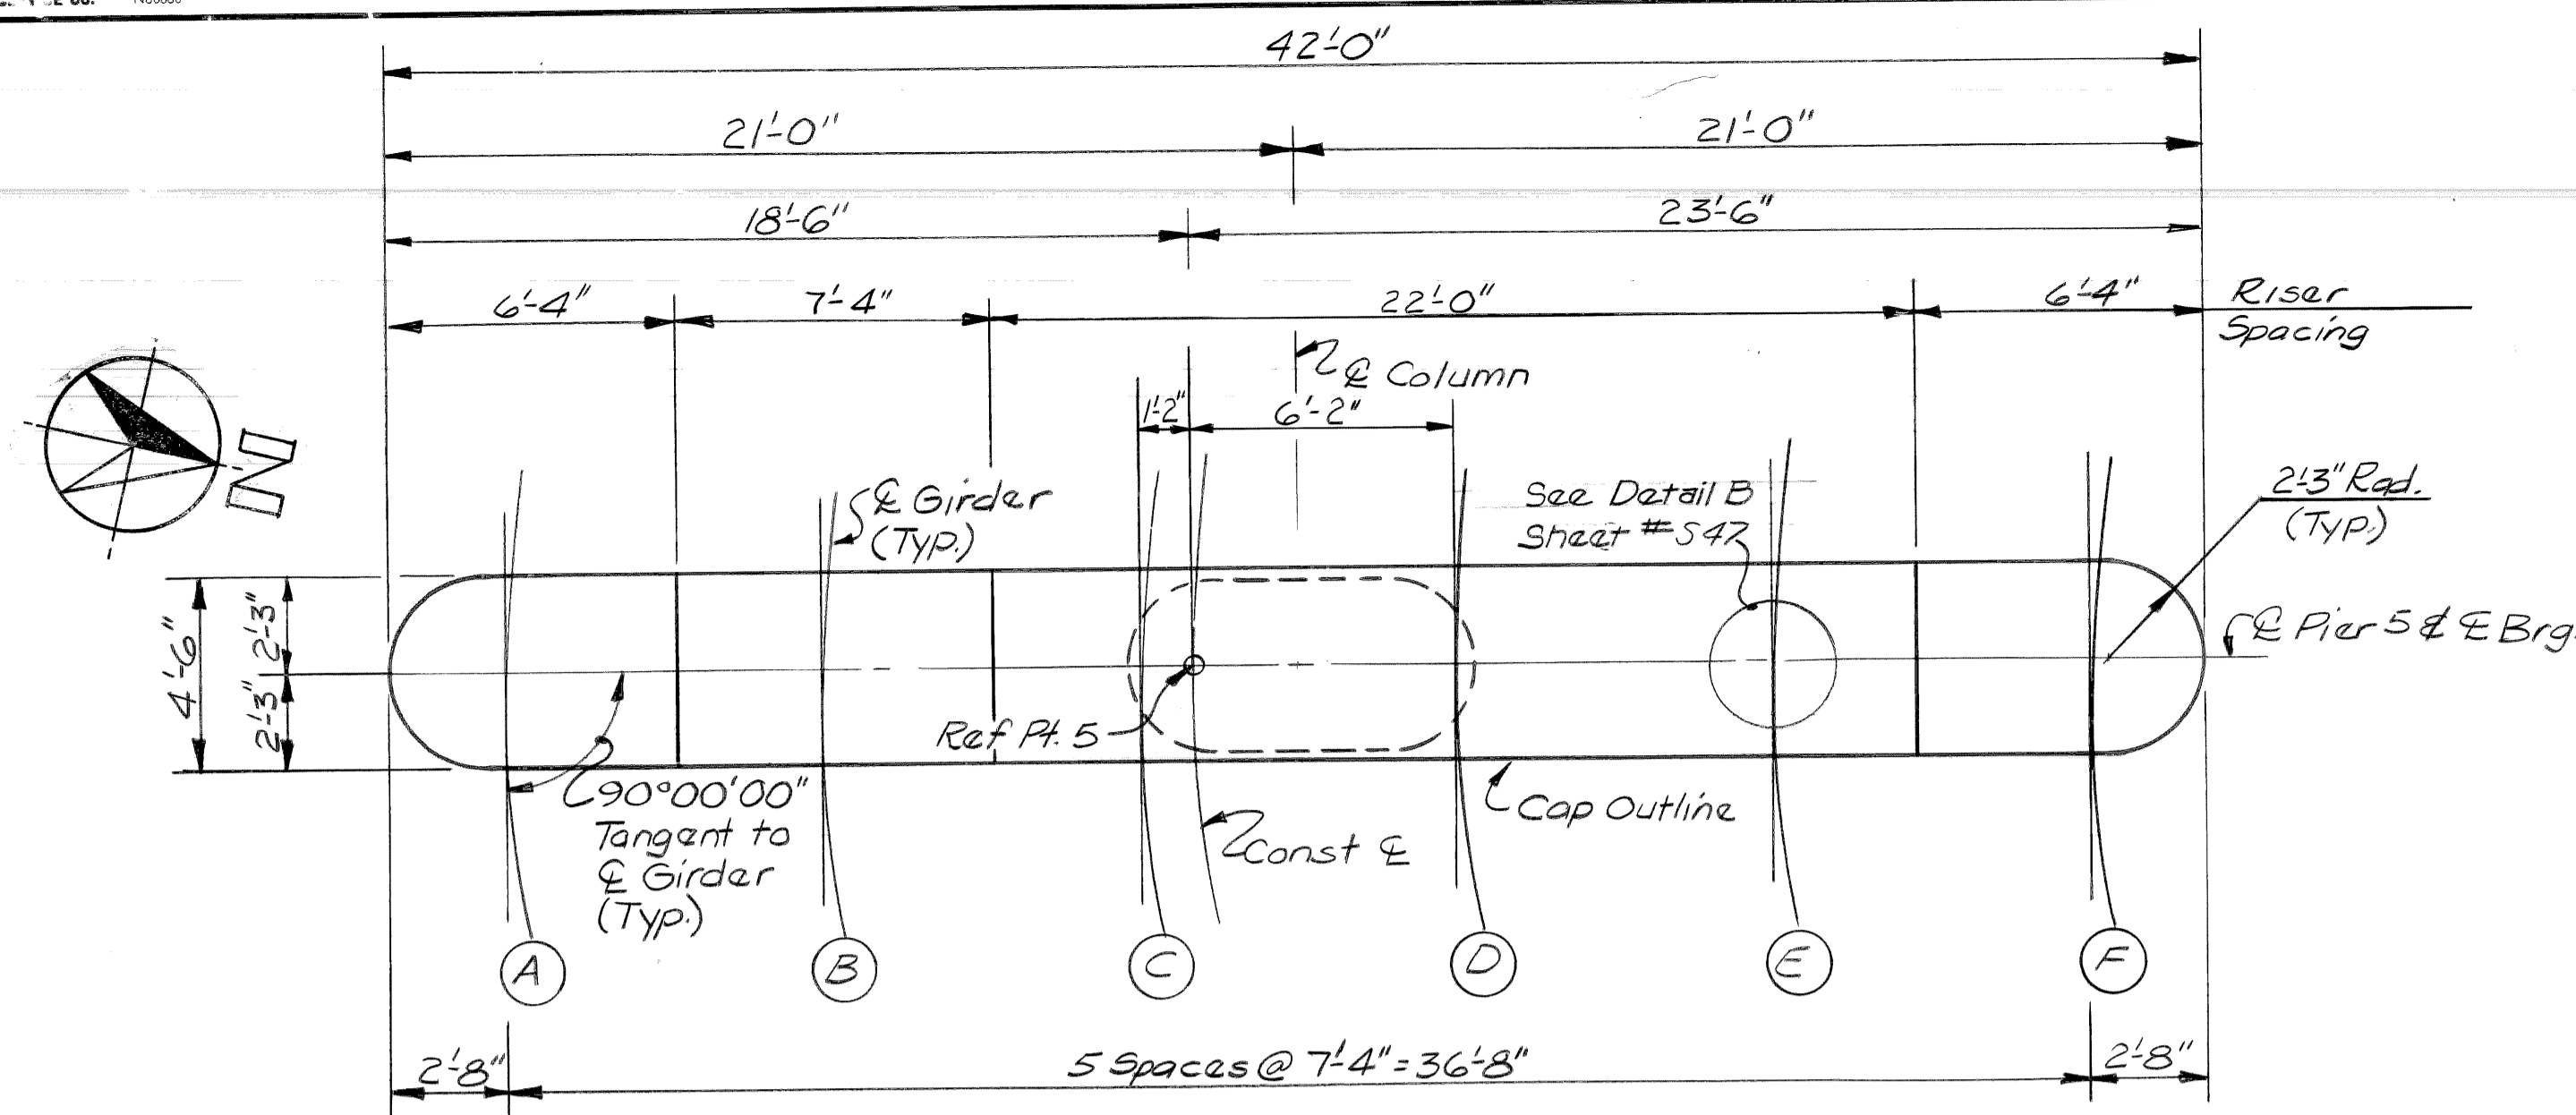


PLAN OF CAP

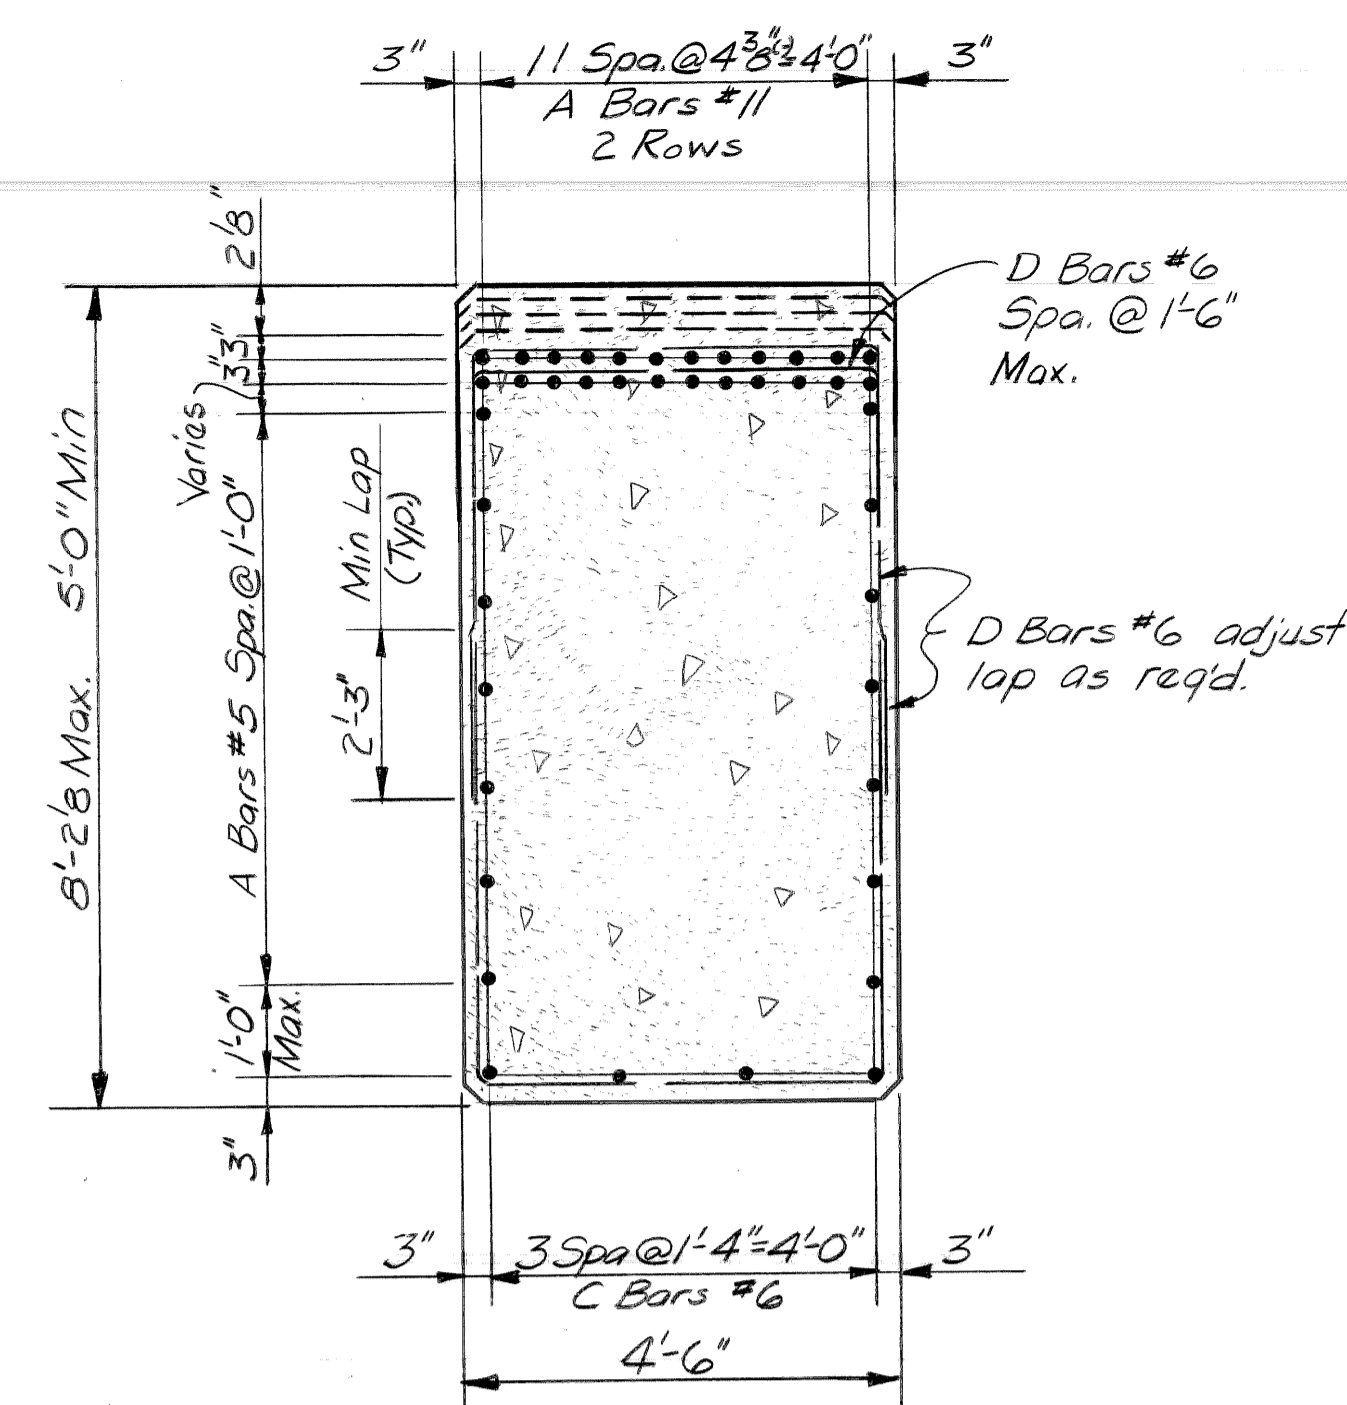


SECTION A-A

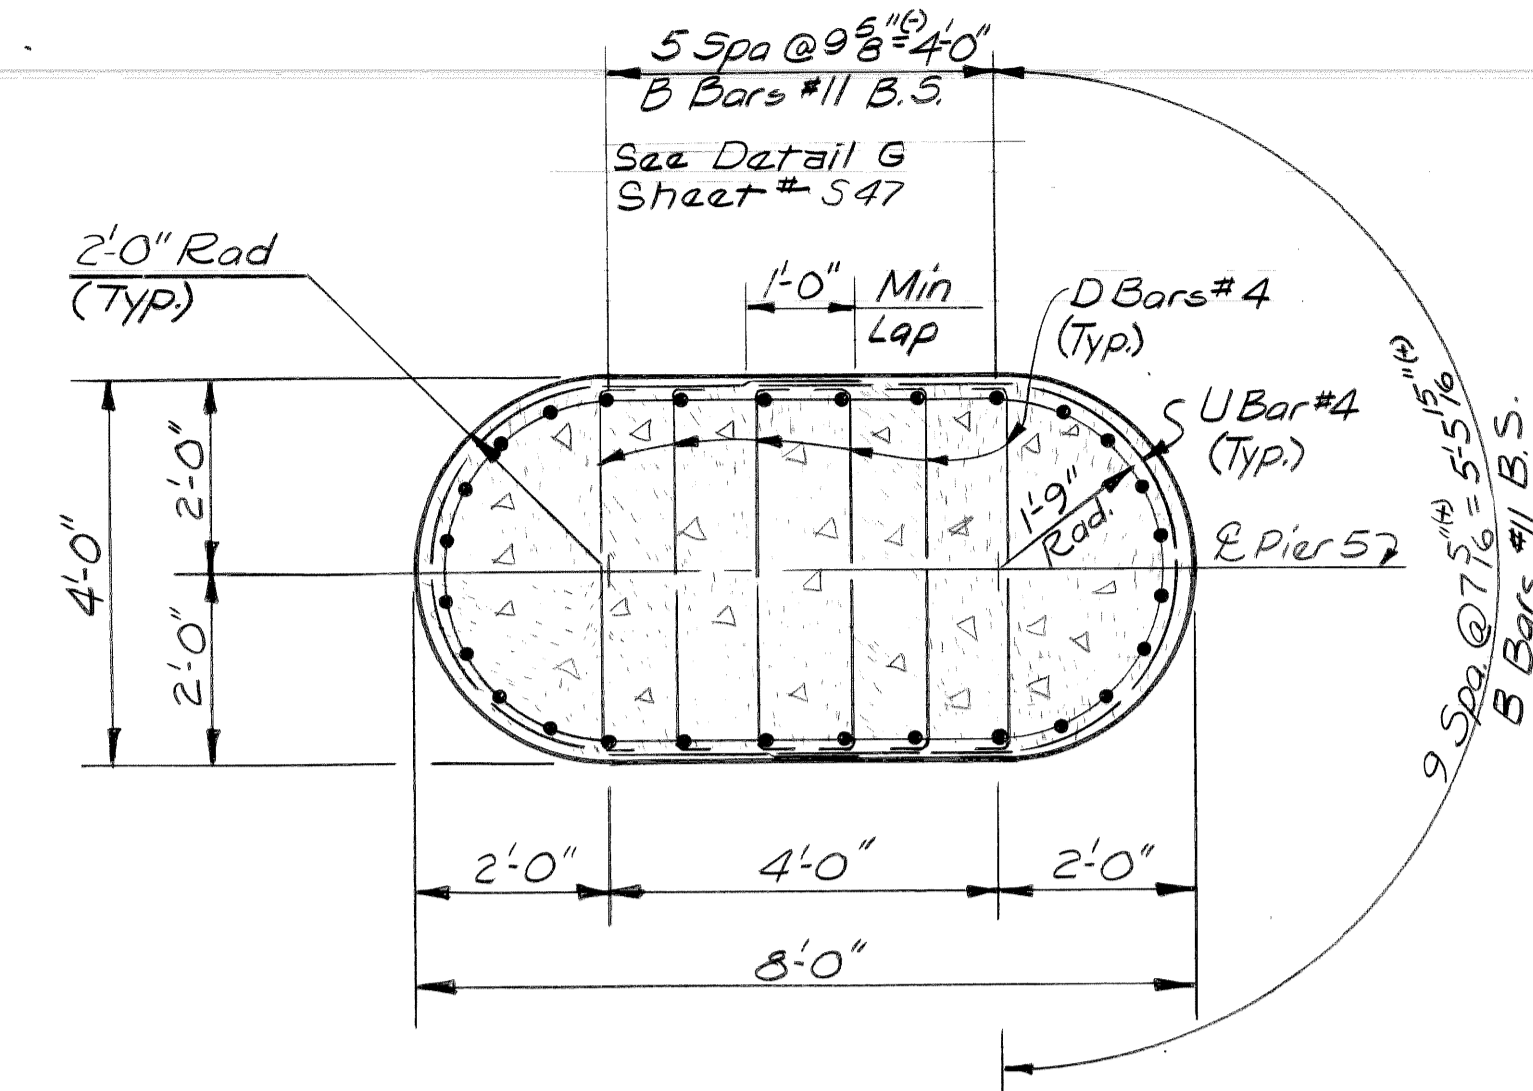

SECTION B-B

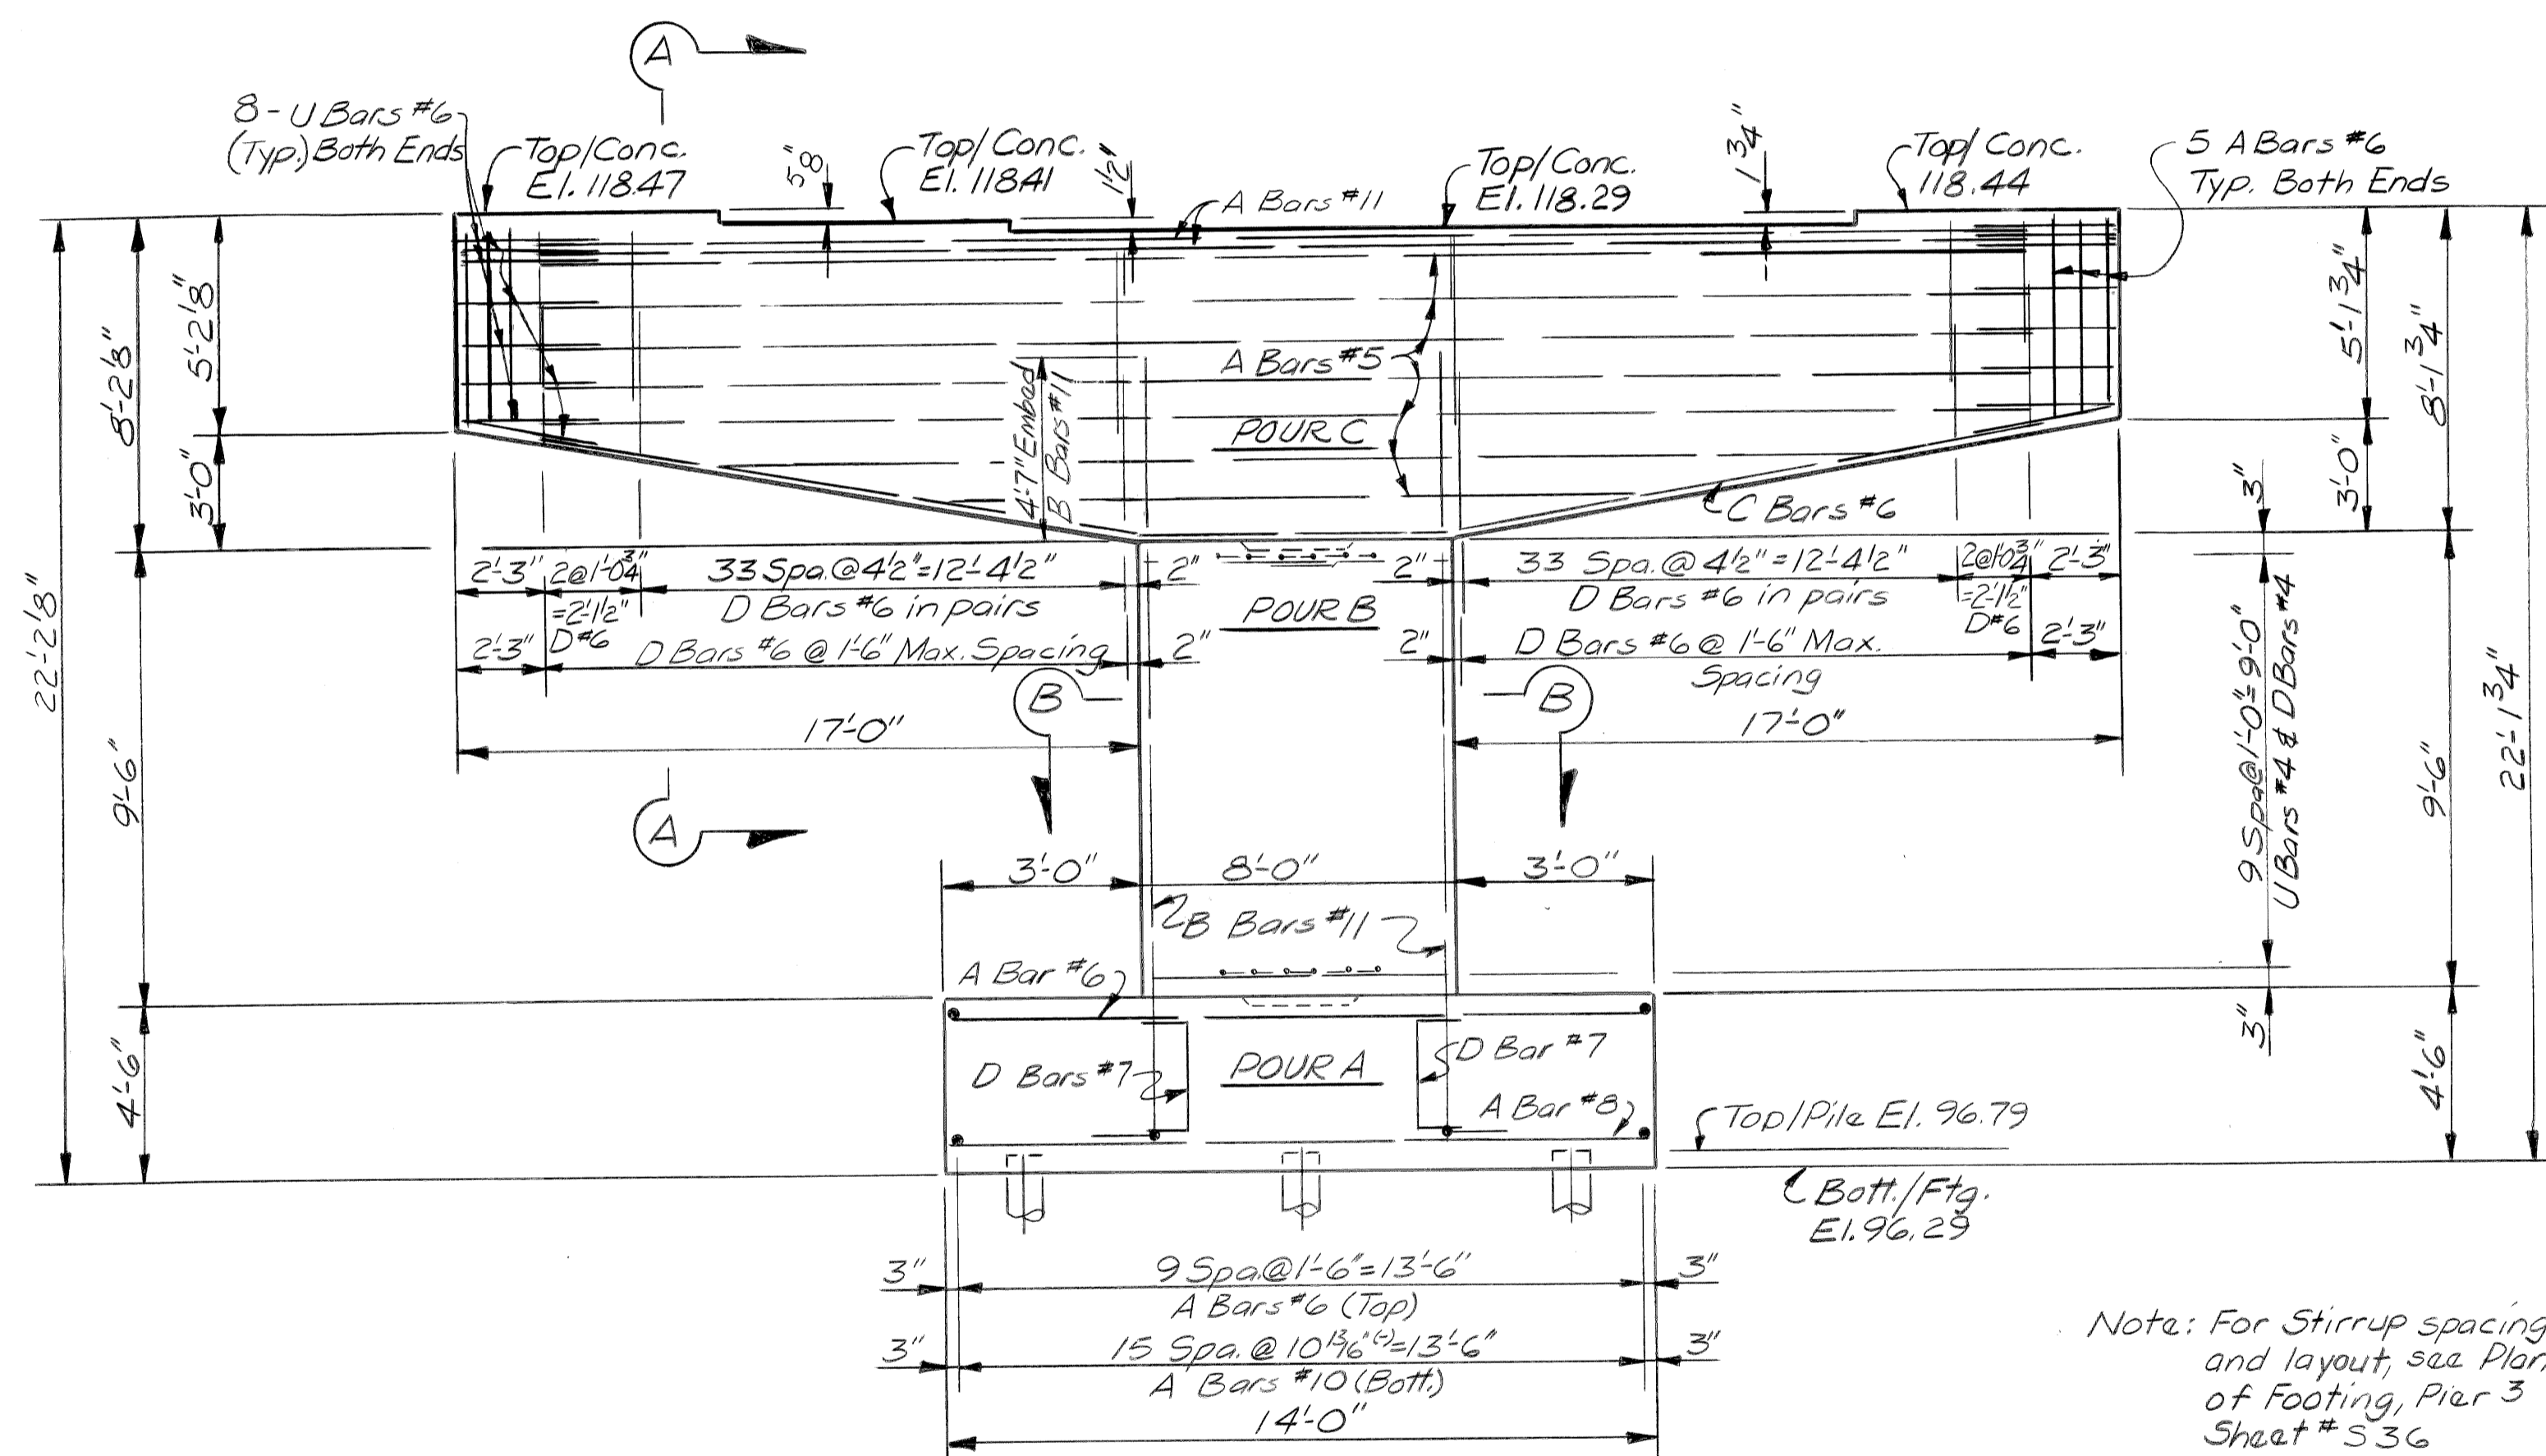

ELEVATION

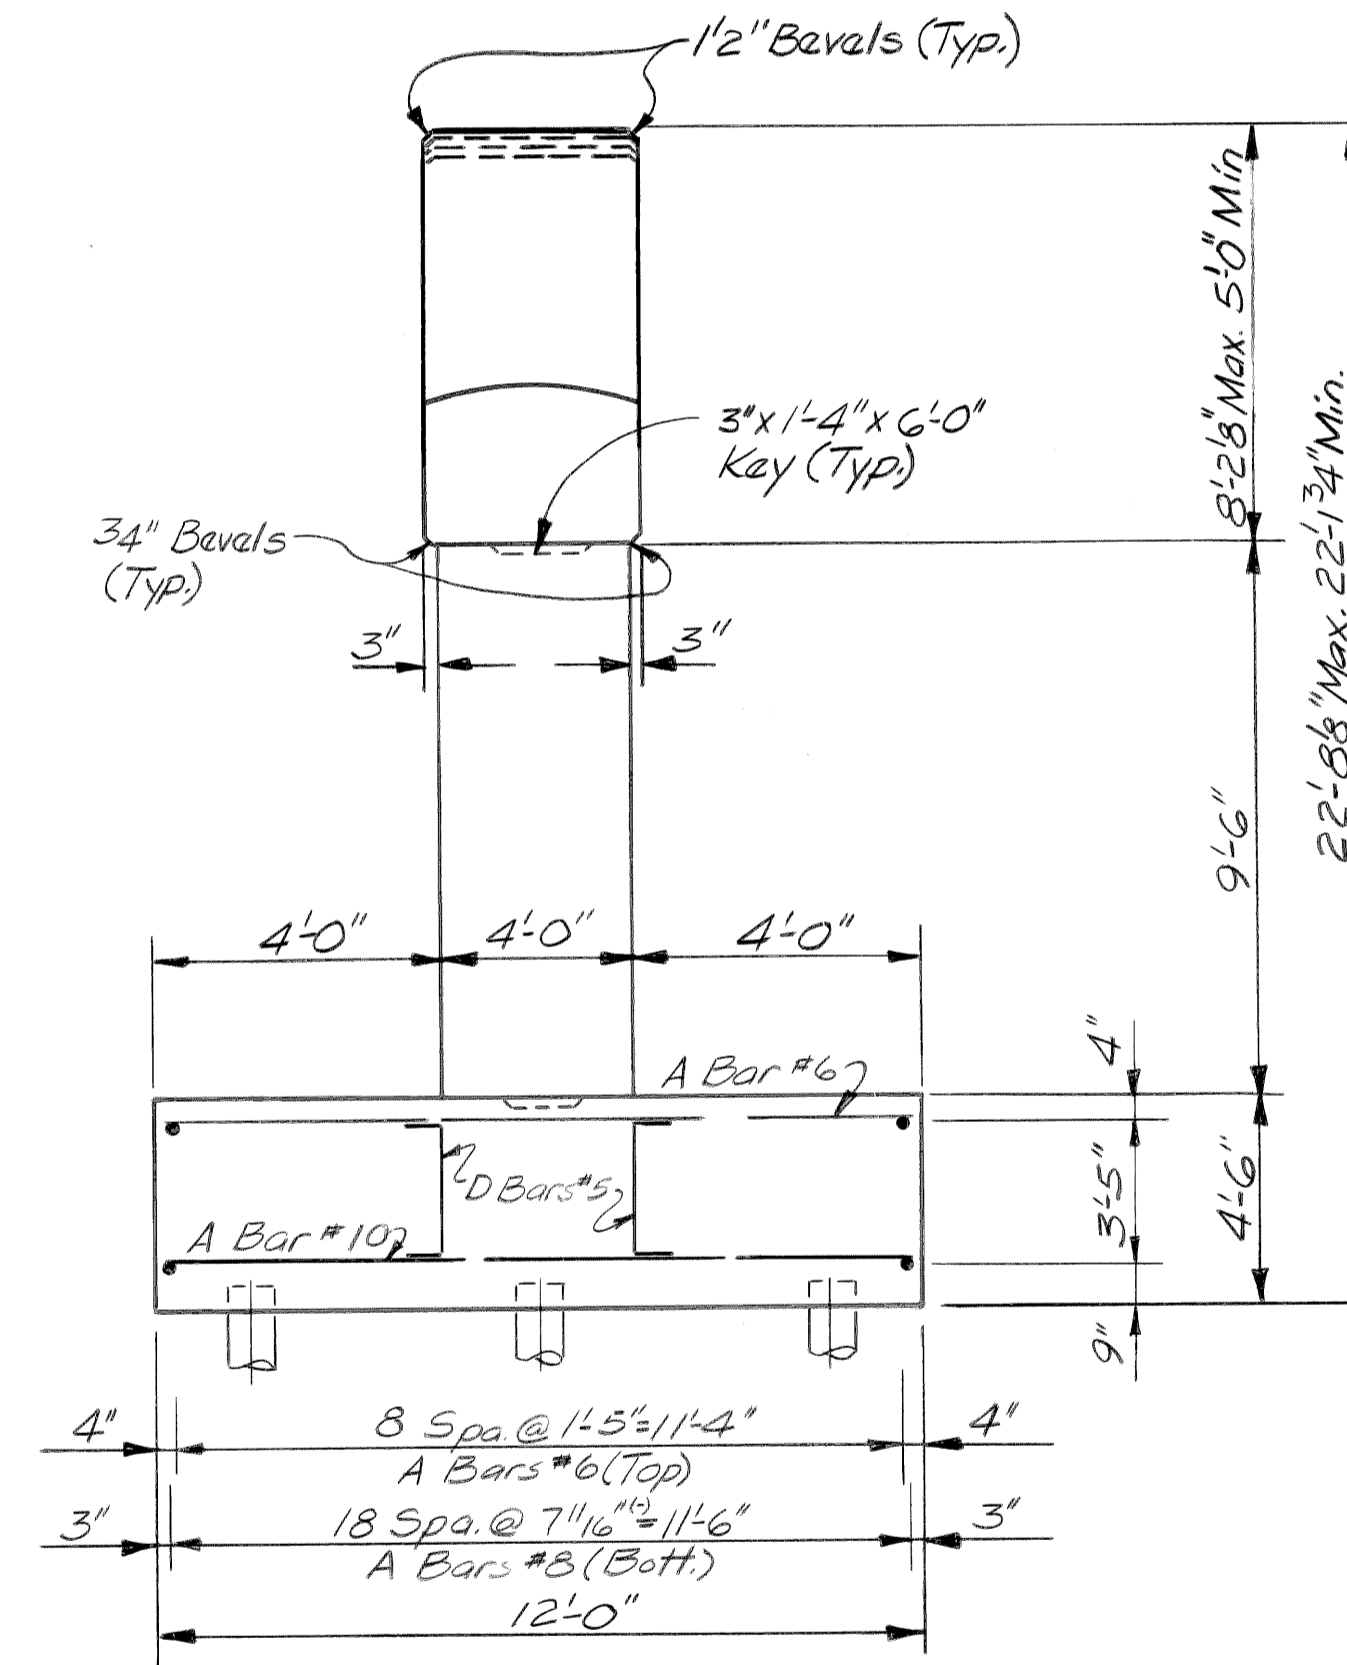

END VIEW

Note: For Stirrup spacing and layout, see Plan of Footing, Pier 3 Sheet # S36


Work This Sheet With Sheets # S34 thru S37 & S39 thru S48

DATE: August, 1979

DSGN BY:	RGW, MH
DRN BY:	MH
CK'D BY:	RGW
APP'D BY:	

REVISIONS	

CITY OF DETROIT, MICHIGAN

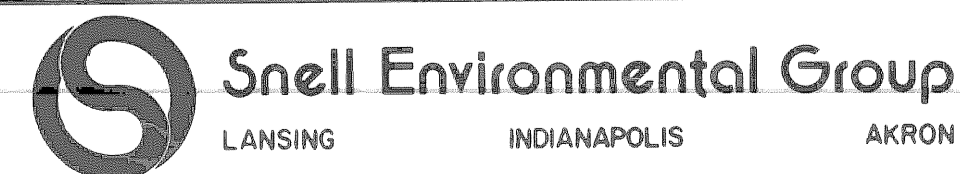


JOHN C. LODGE EXIT RAMP AND JEFFERSON AVENUE-
RECONSTRUCTION AT THE JOE LOUIS ARENA


PIER DETAILS
PIER 5

SCALE: NONE

DRN. NO. S38

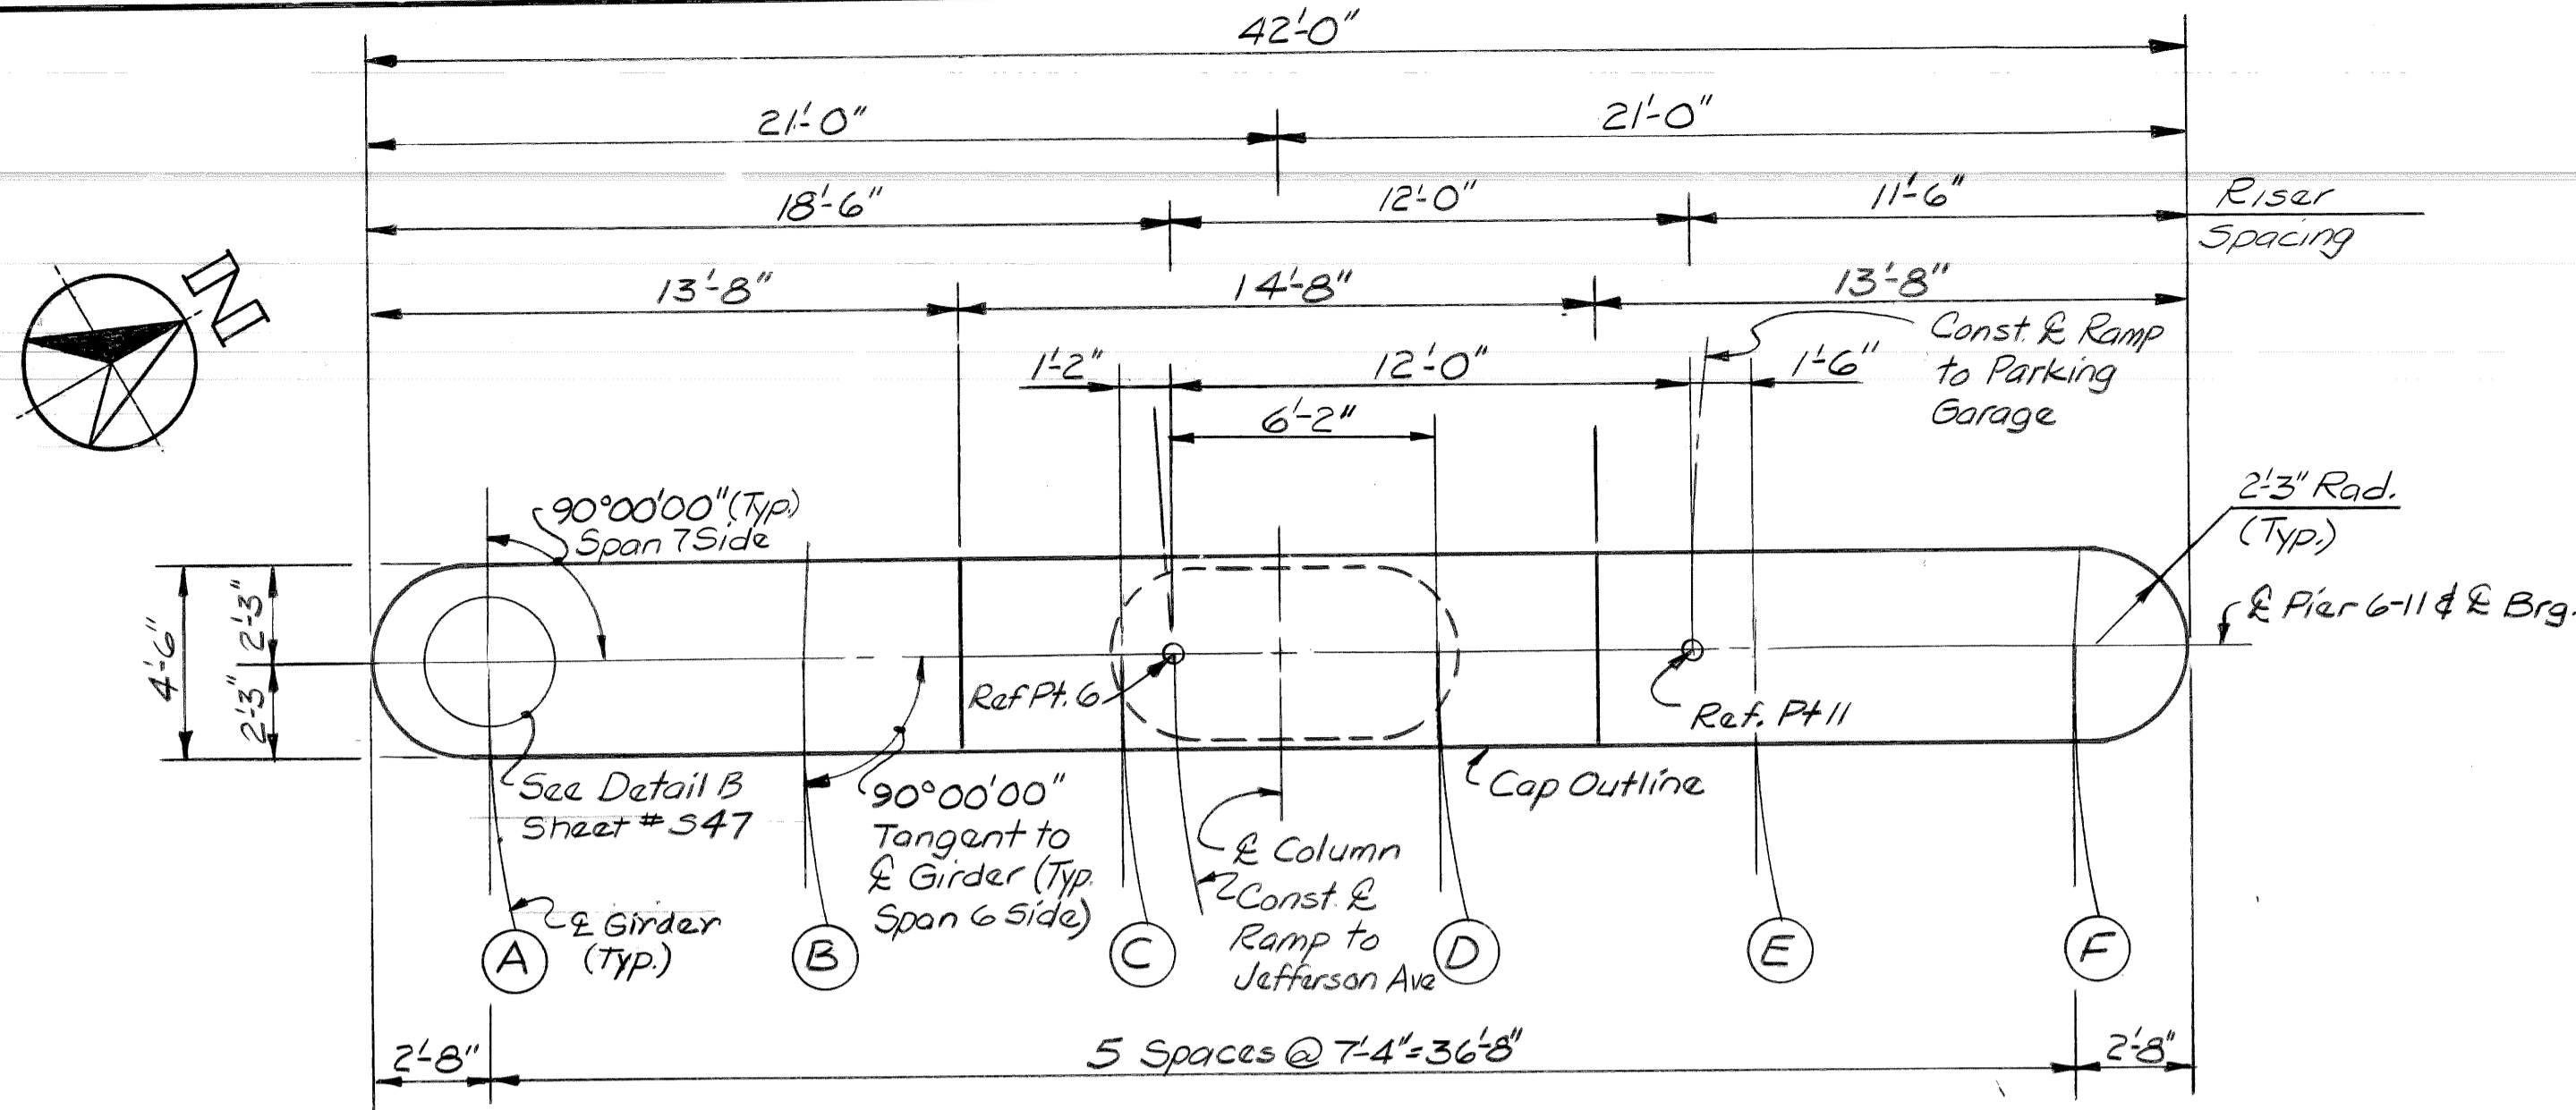


PLAN OF CAP

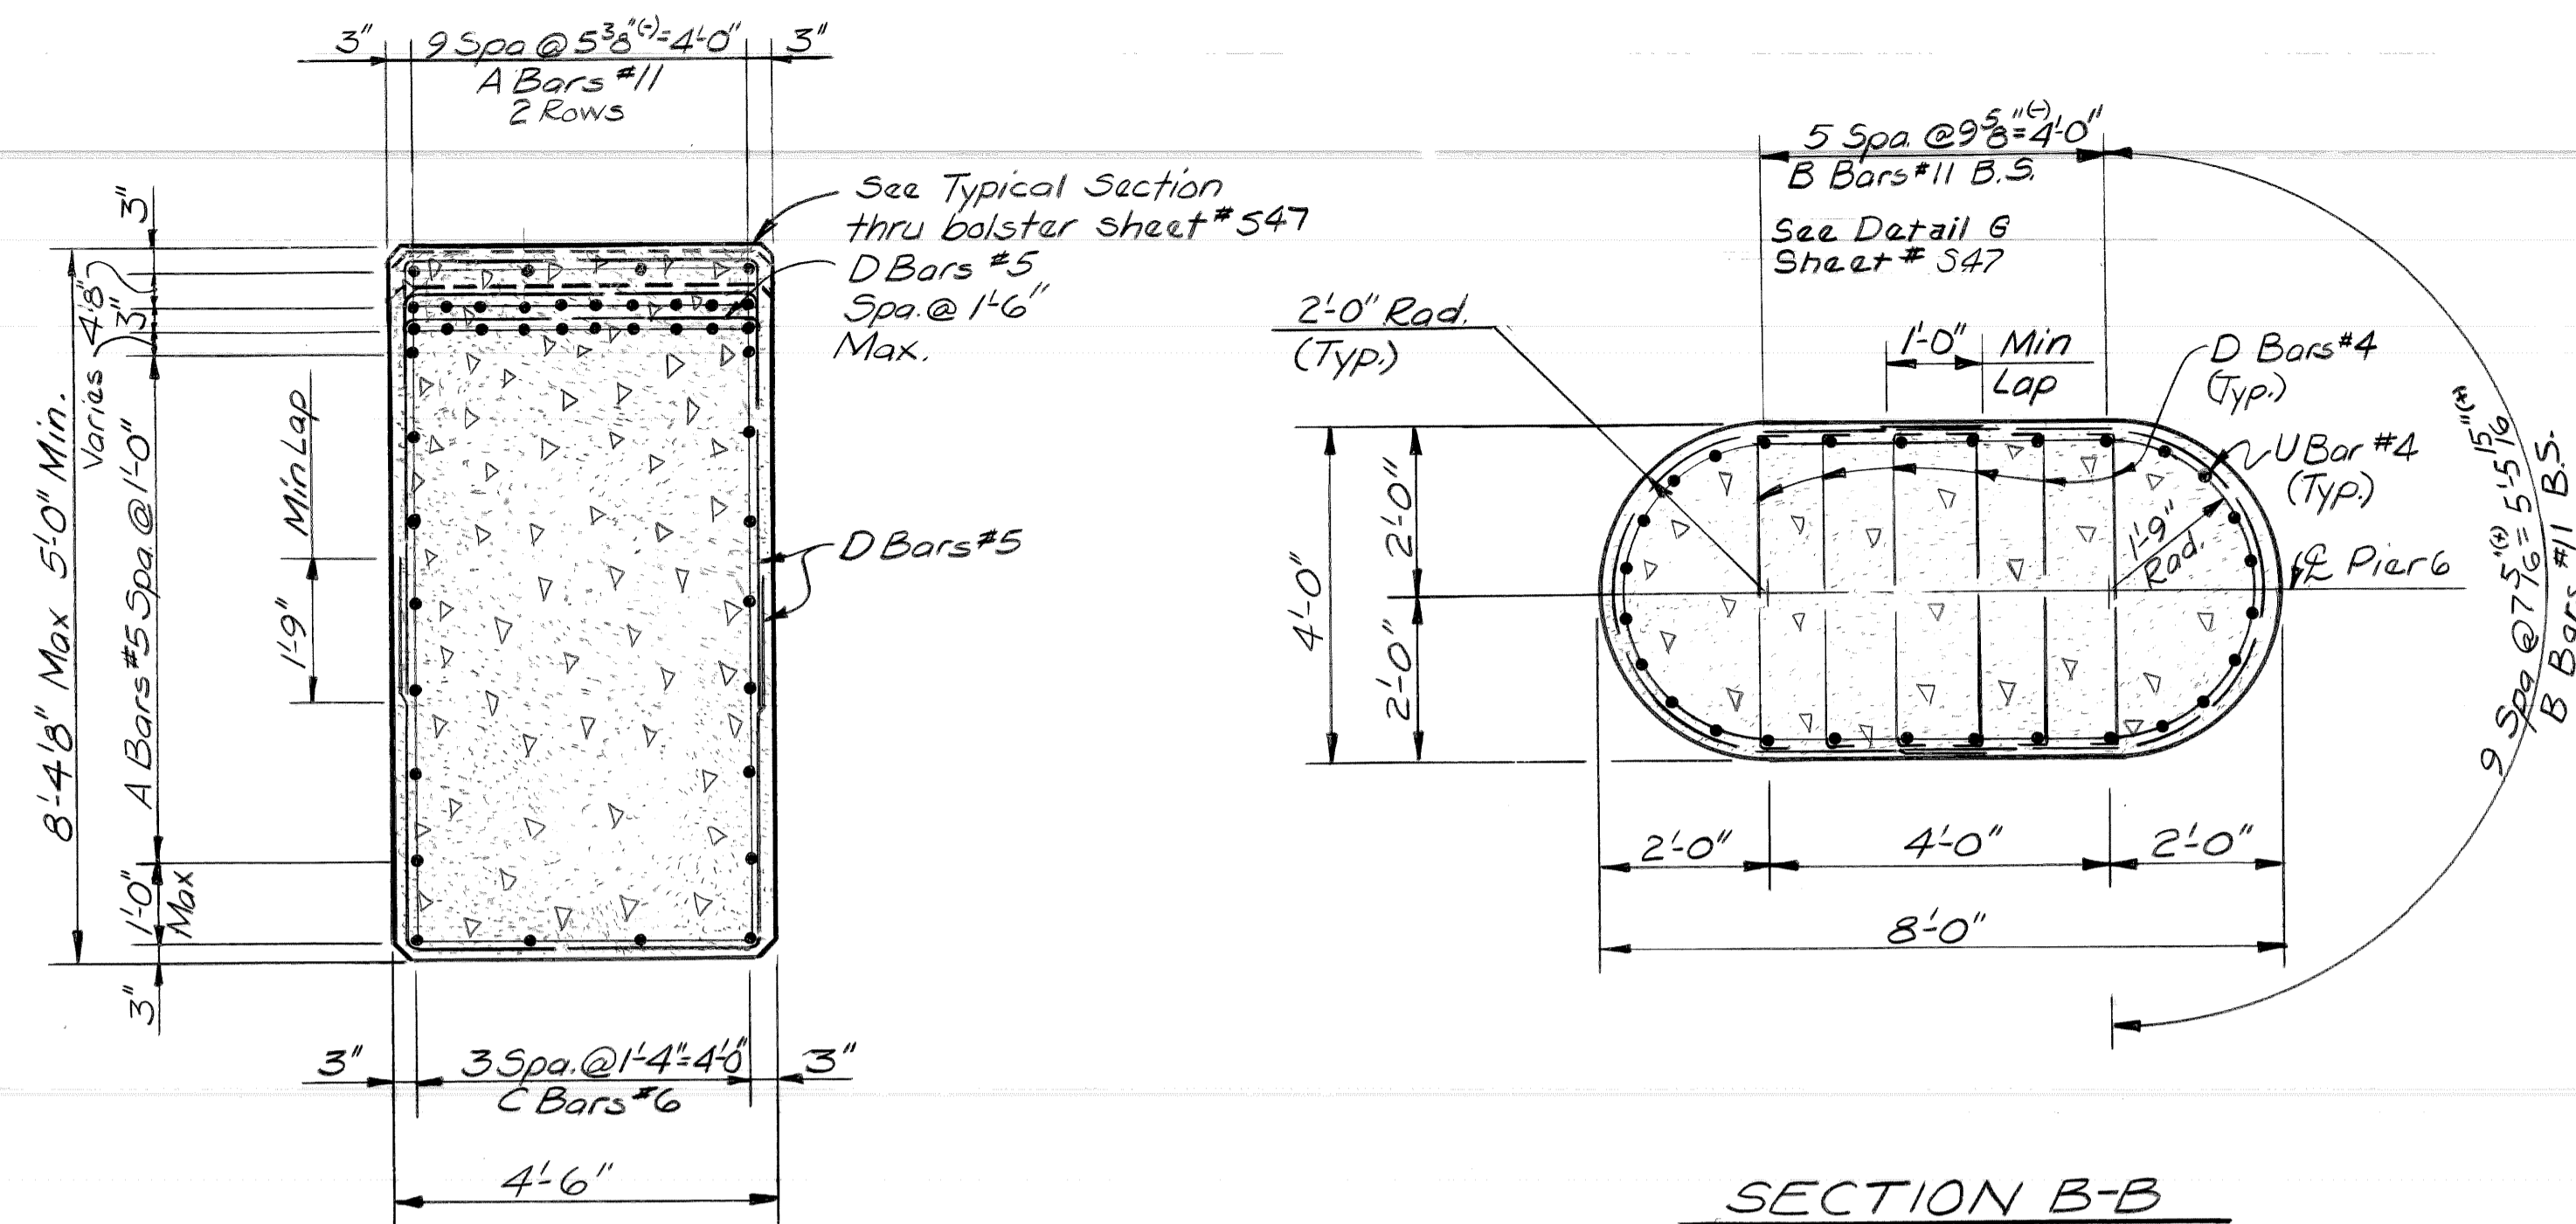


SECTION A-A

SECTION B-B

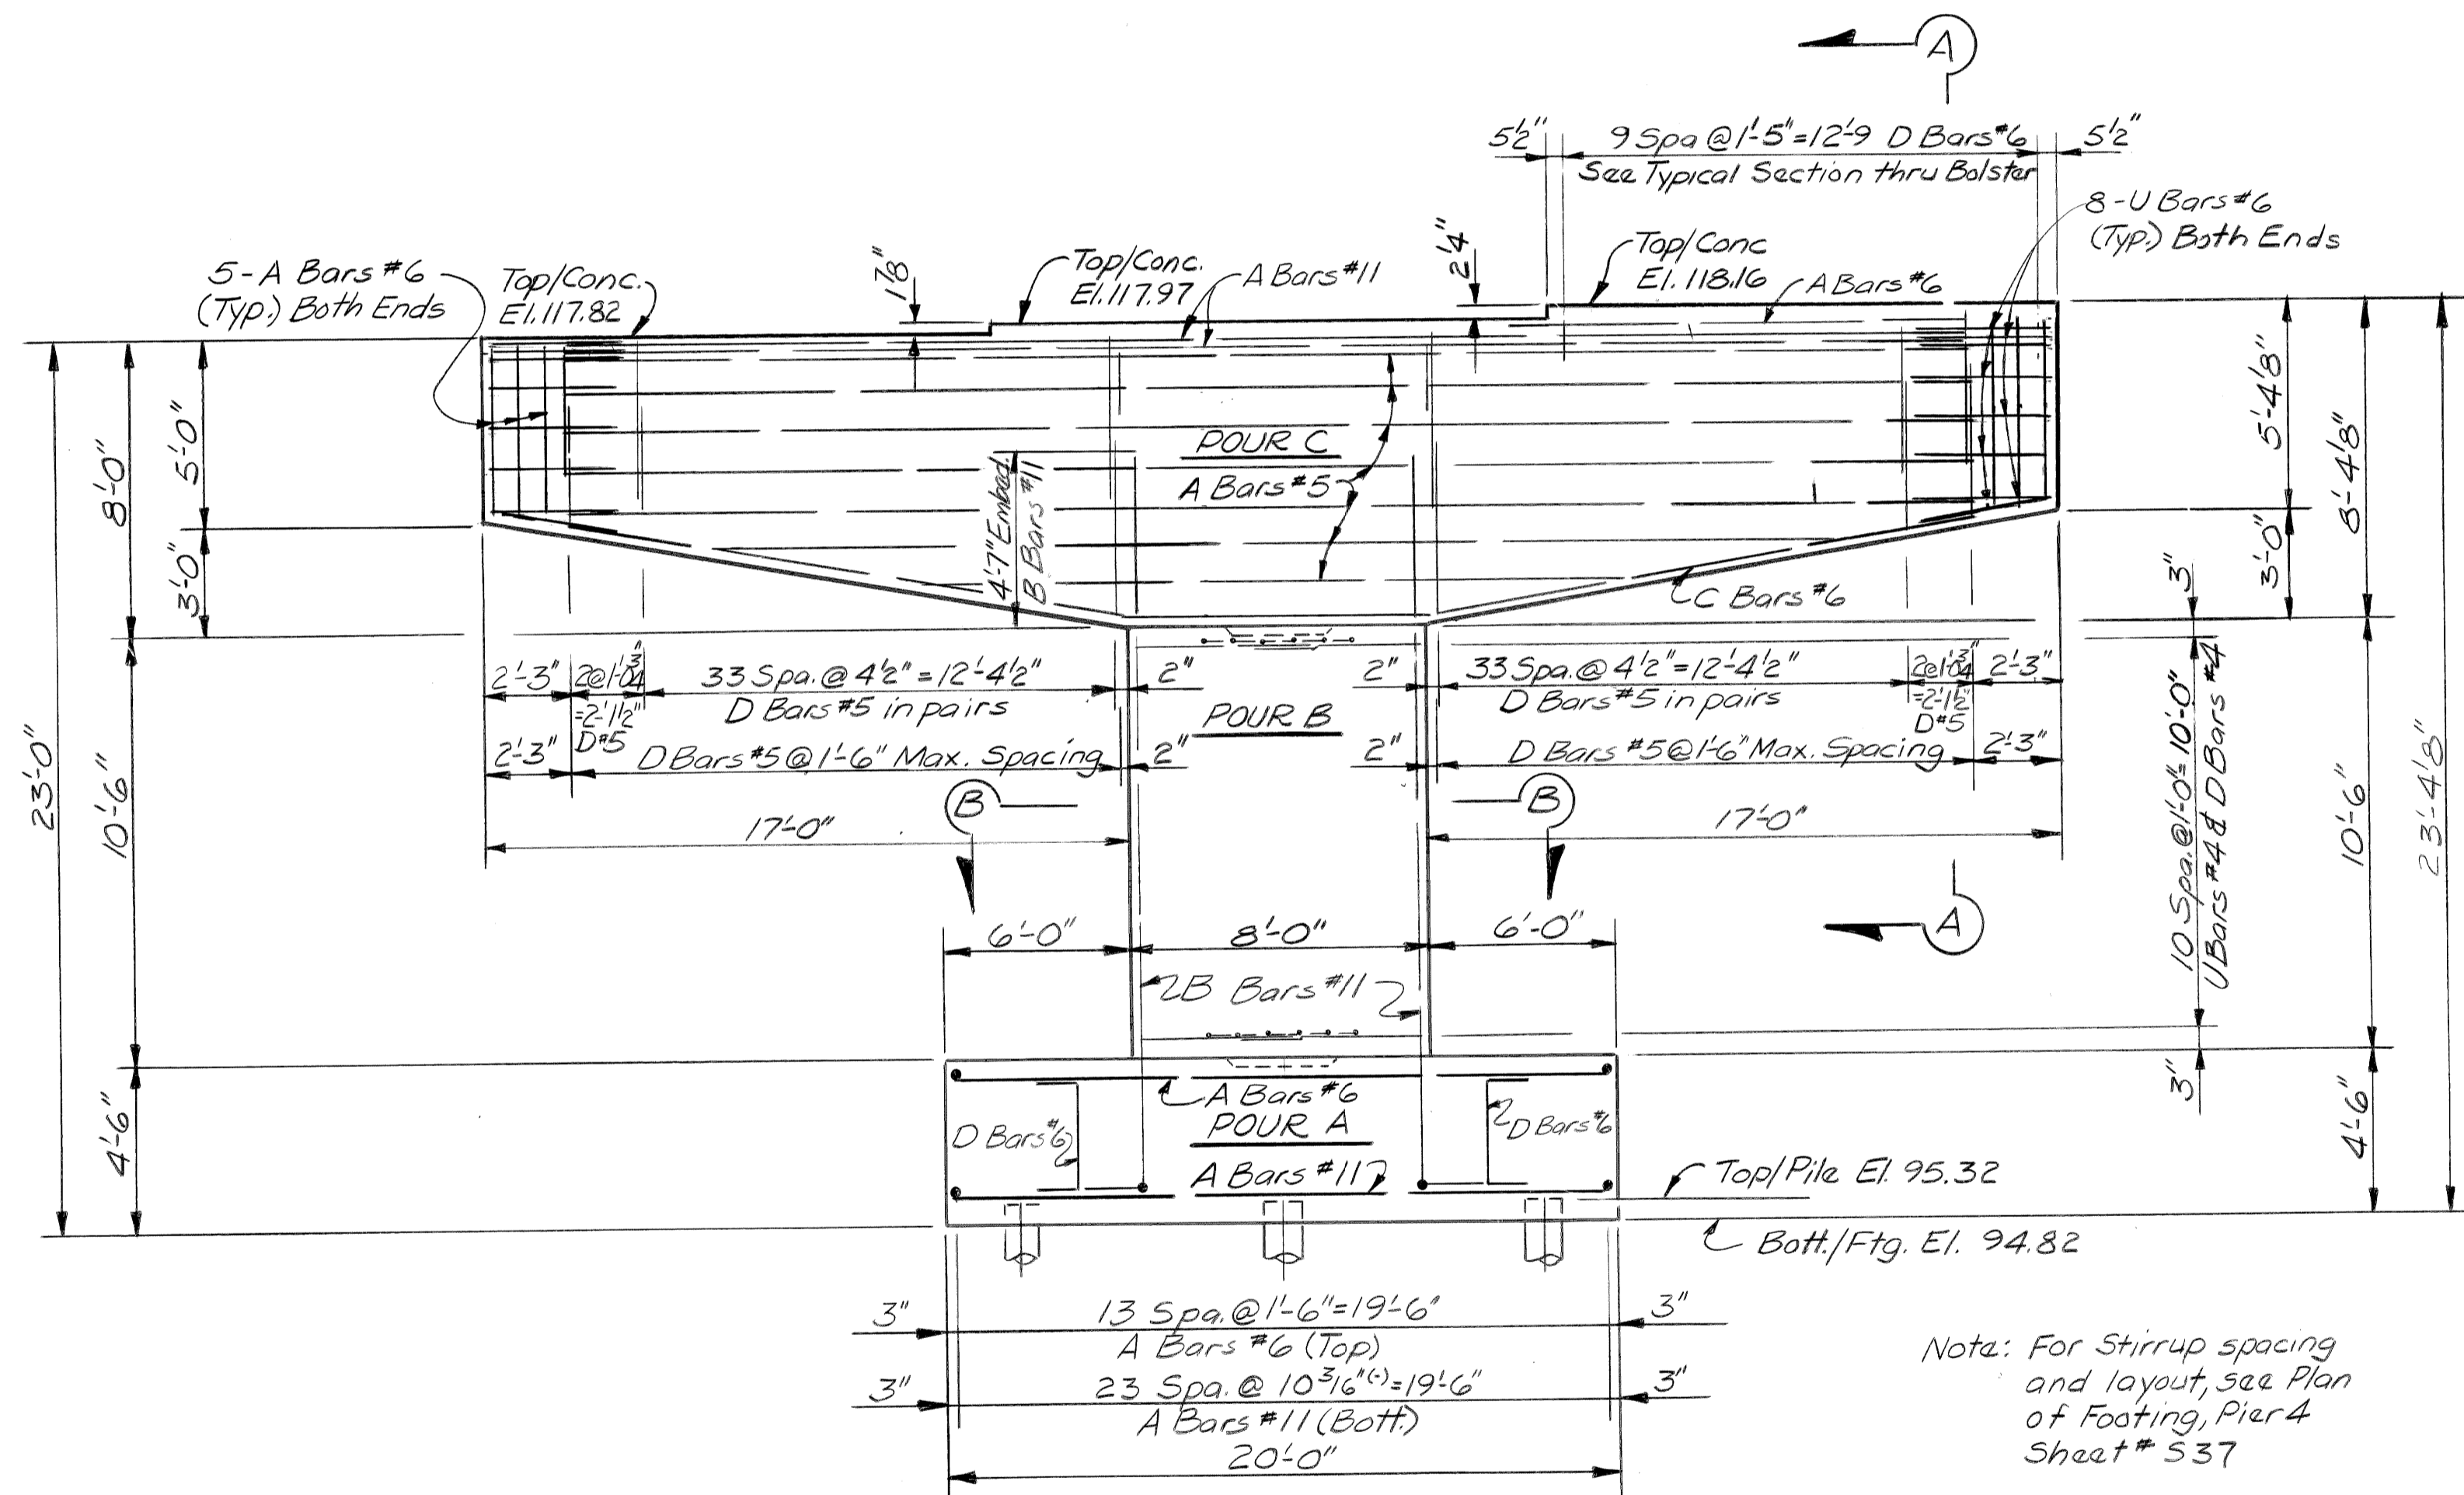

ELEVATION

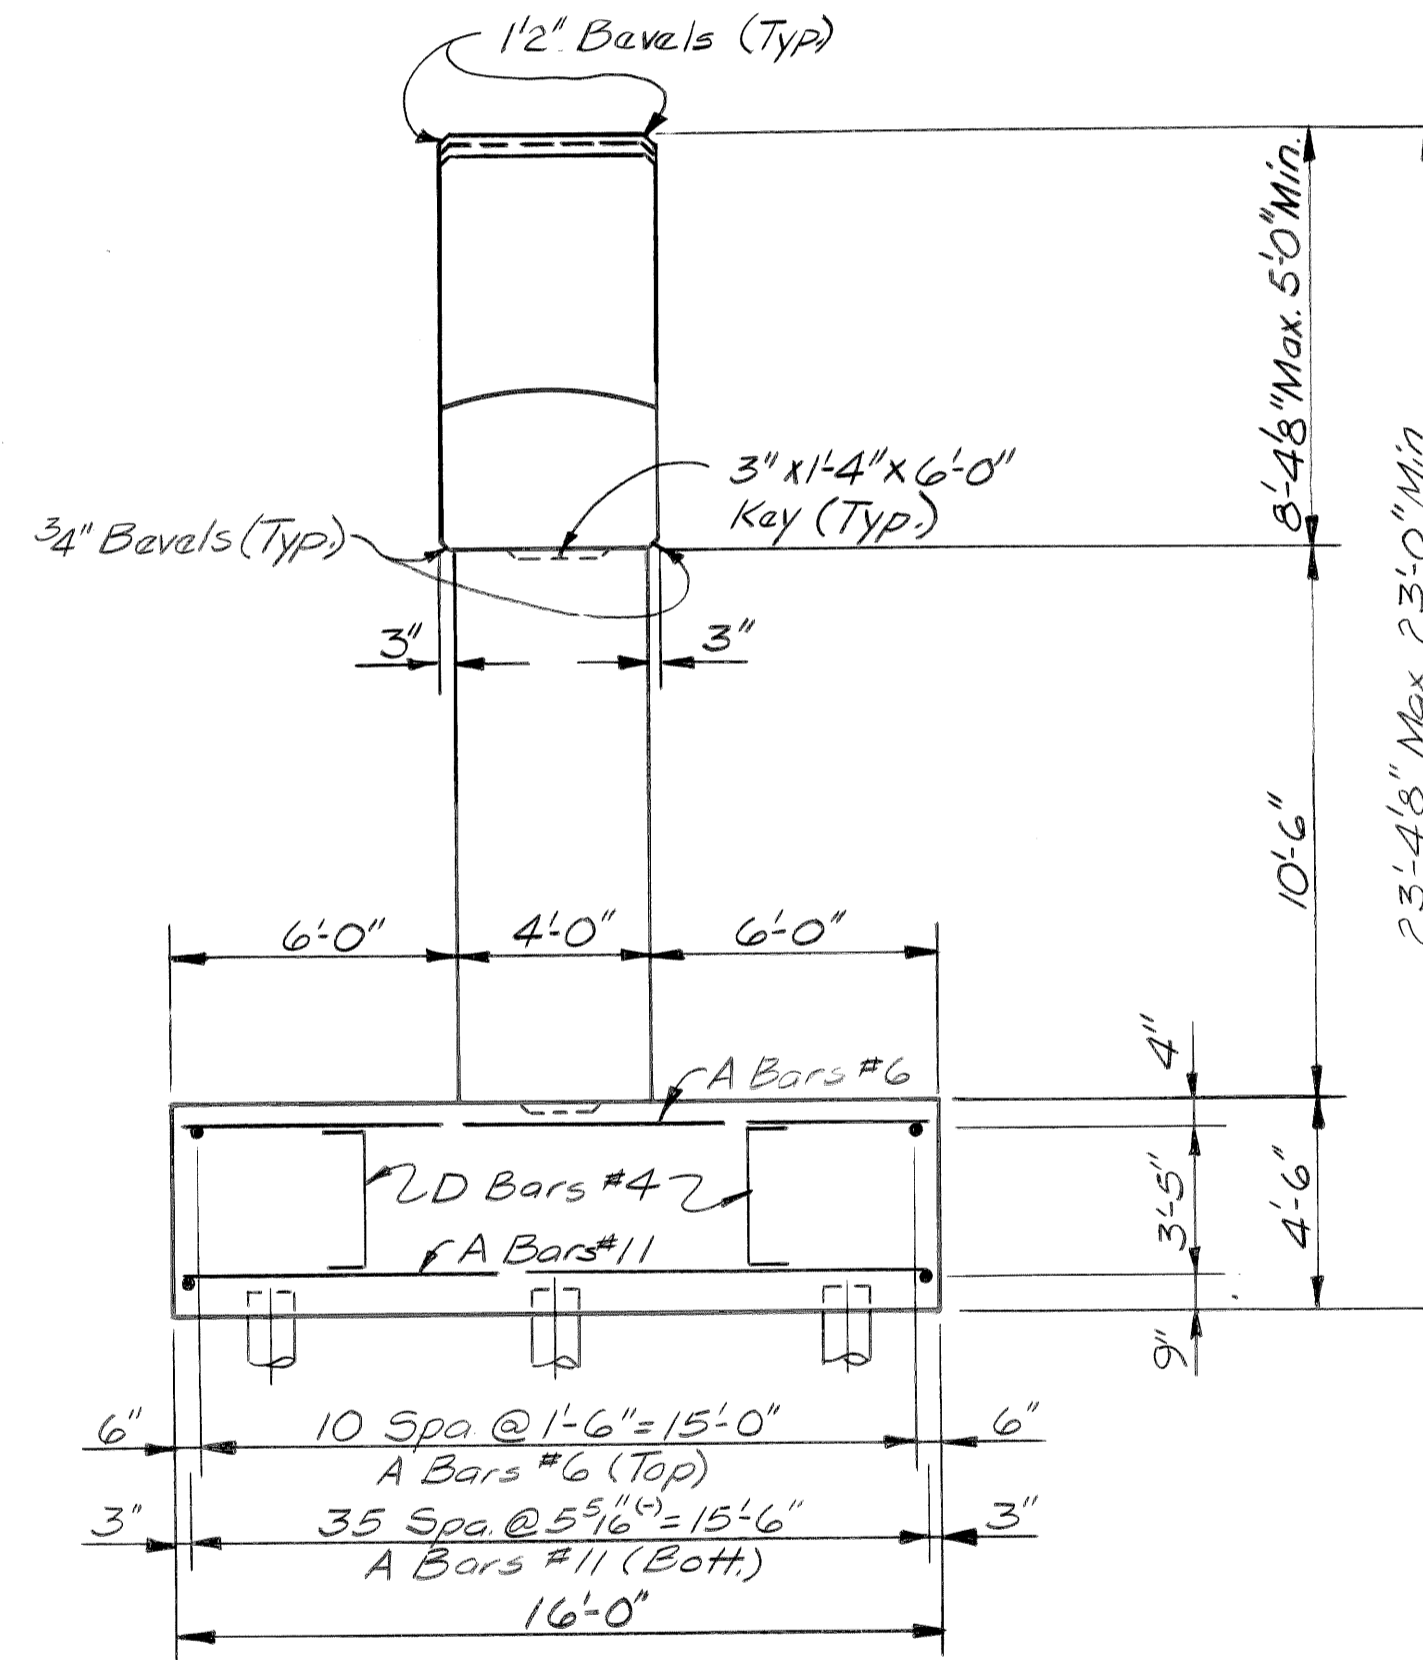

END VIEW

Work This Sheet With Sheets # 534 thru 538 & 540 thru 548

DATE: August, 1979

DSGN BY:	RGW, MH
DRN BY:	MH
CK'D BY:	RGW
APP'D BY:	

REVISIONS	

CITY OF DETROIT, MICHIGAN




JOHN C. LODGE EXIT RAMP AND JEFFERSON AVENUE-
RECONSTRUCTION - AT THE JOE LOUIS ARENA


PIER DETAILS
PIER 6-II

SCALE: NONE


DRN. NO: S39

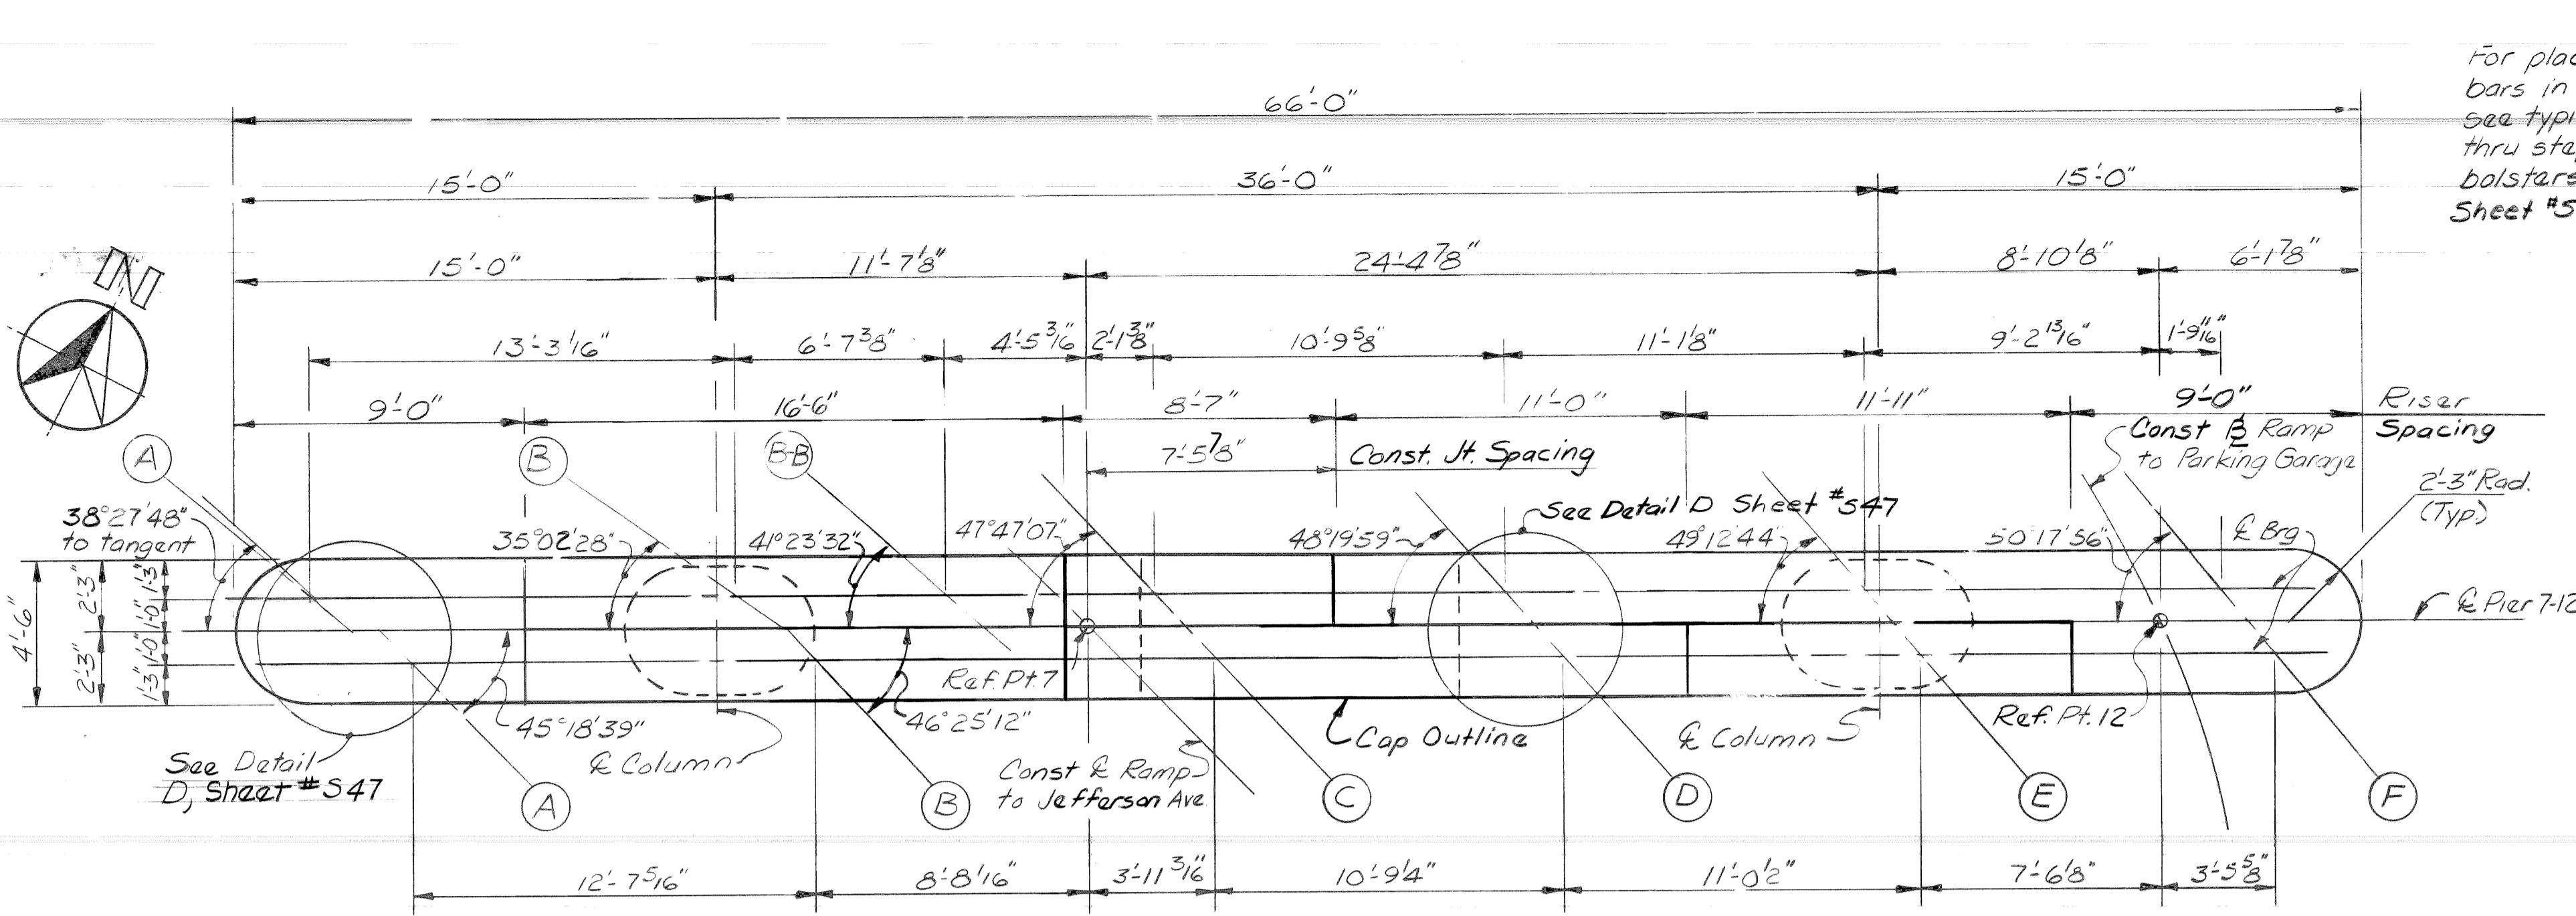


PLAN OF CAP

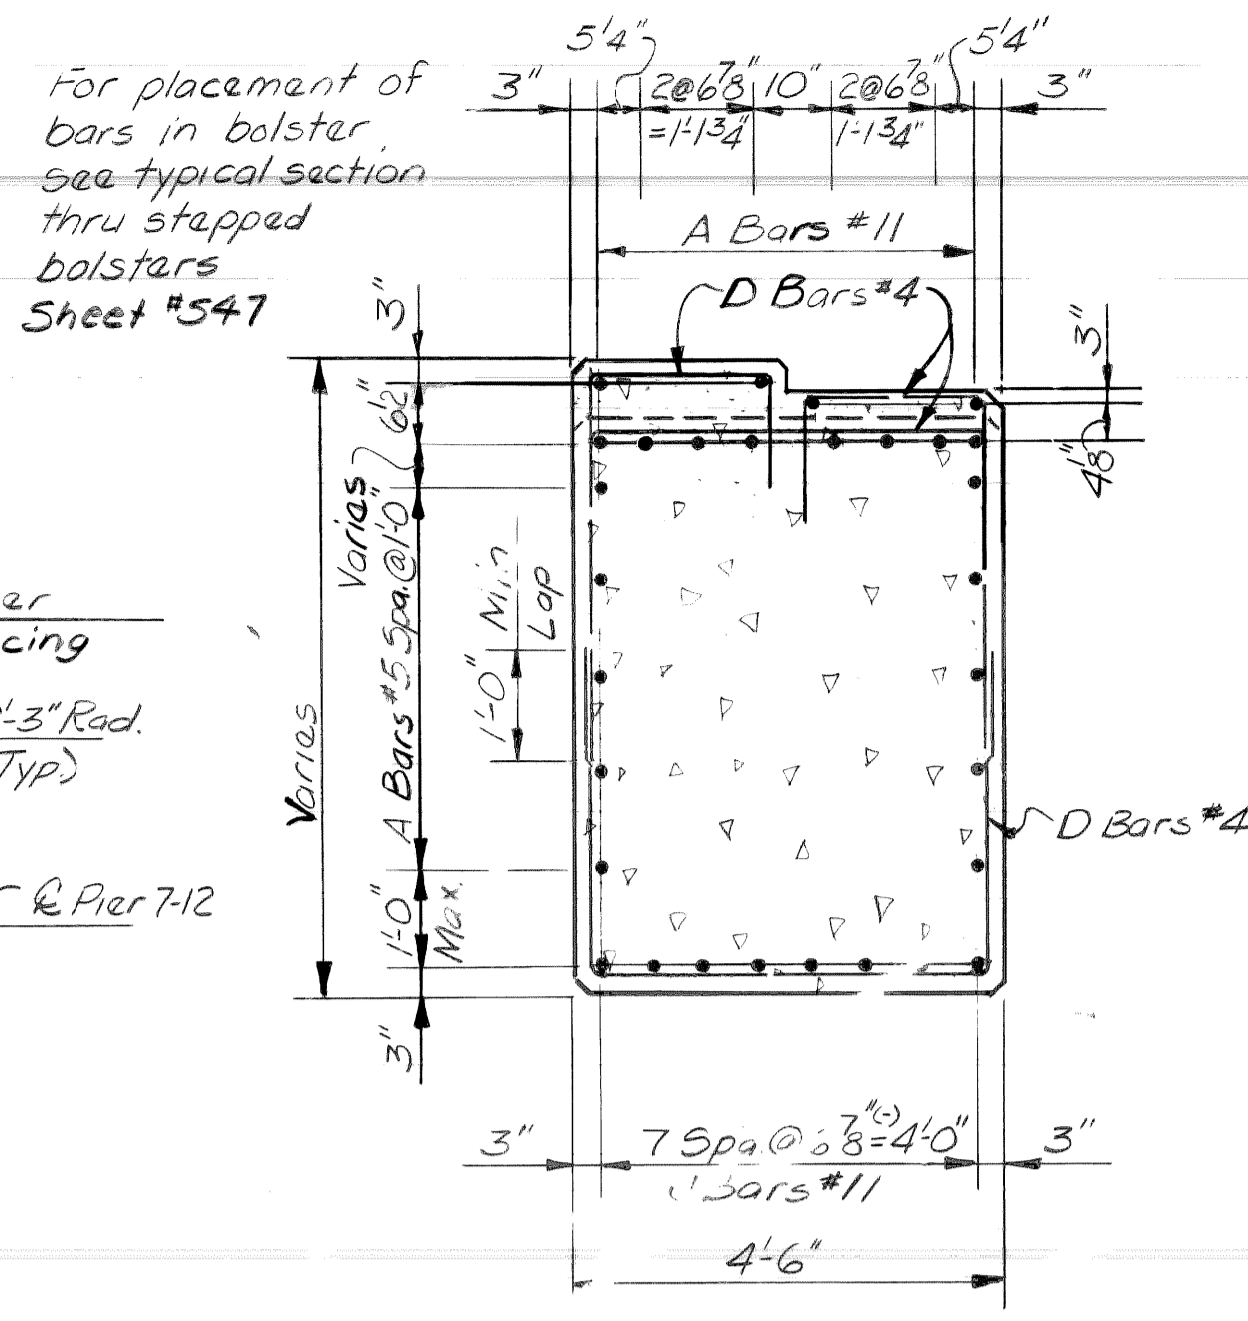


SECTION A-A

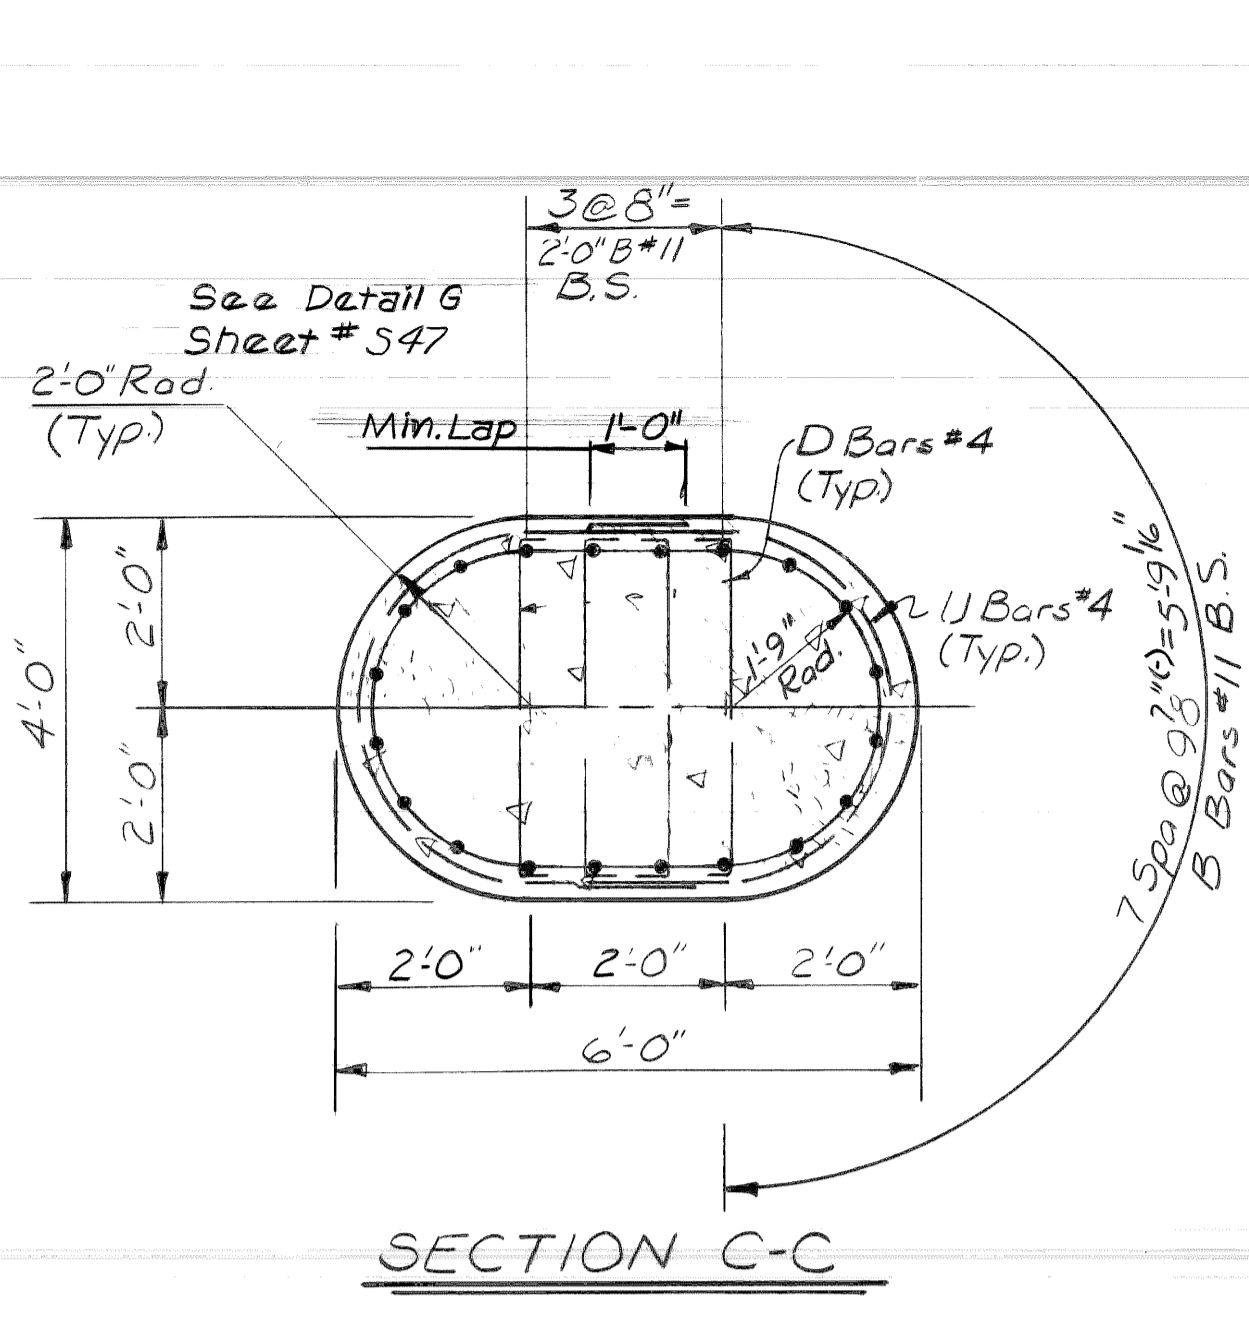

SECTION C-C

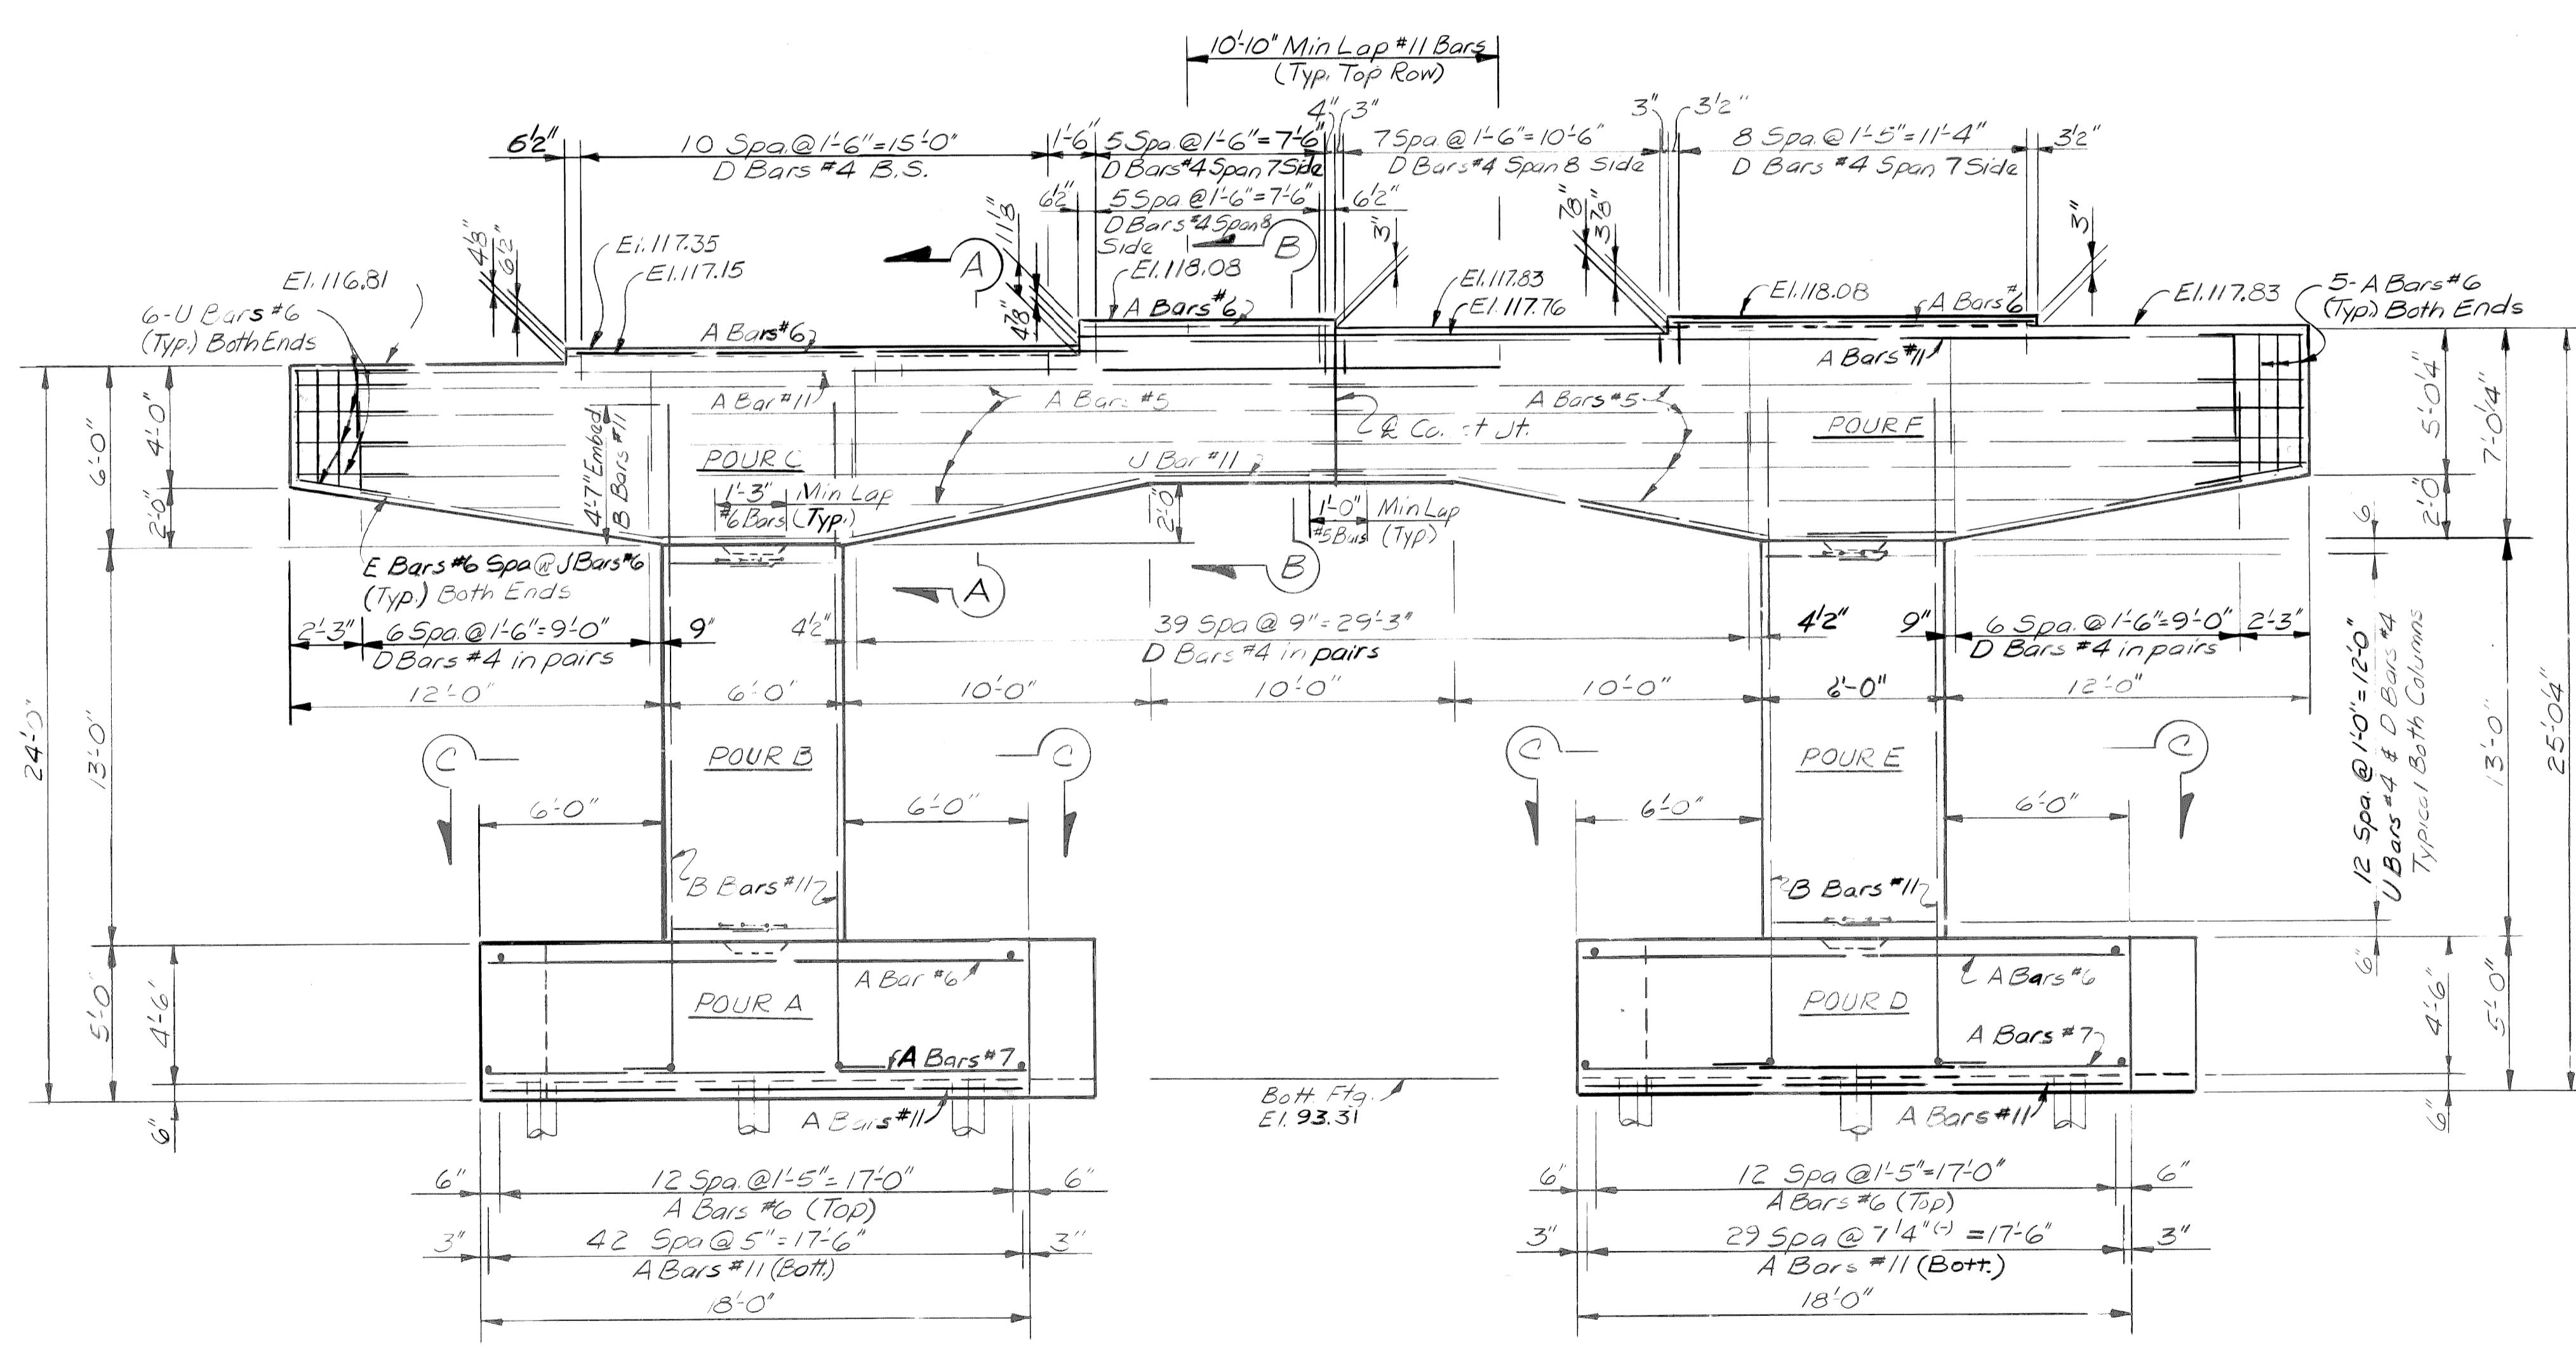

ELEVATION
(Shown Normal to E Pier)

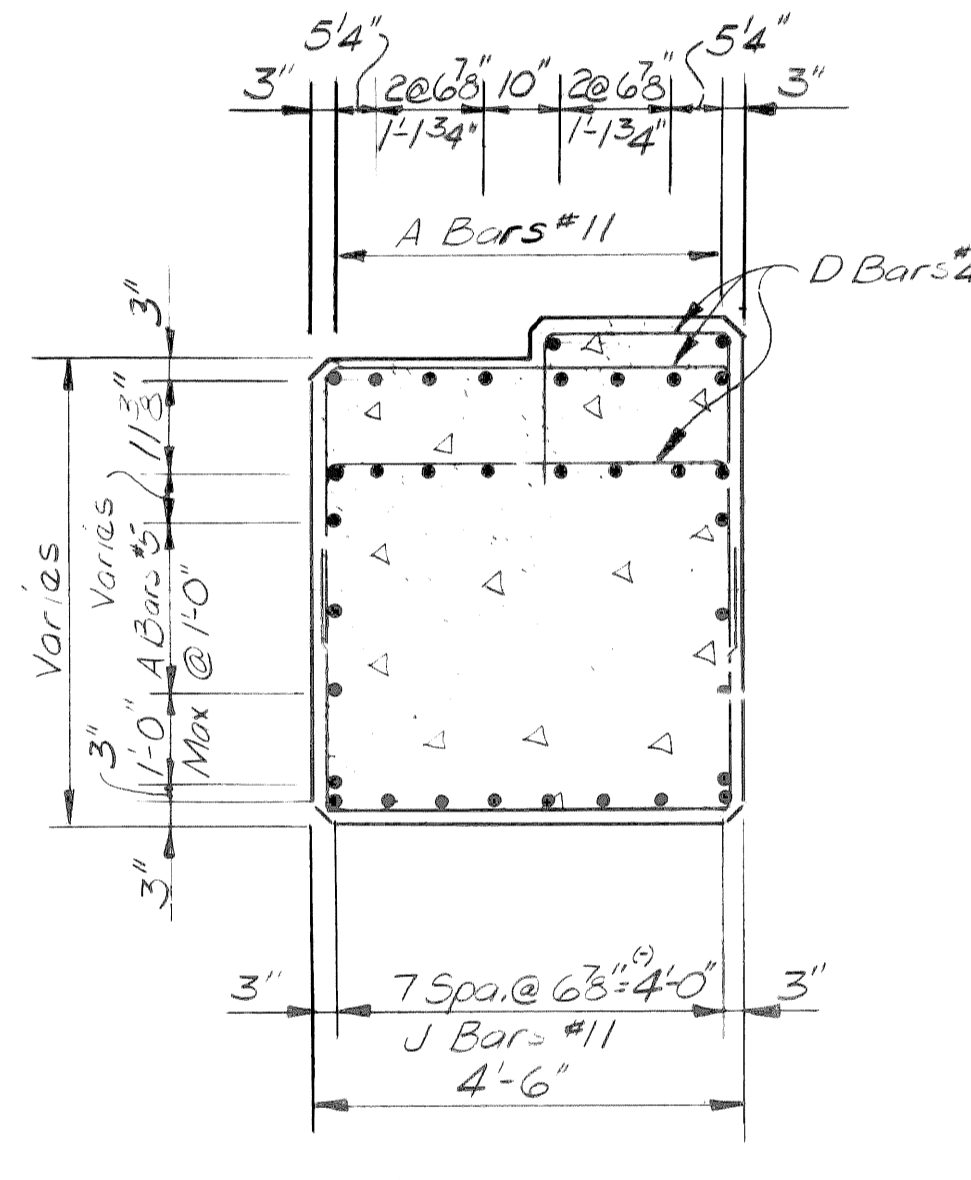

SECTION B-B

Work This Sheet With Sheets # S34 thru S39 & S41 thru S48

DATE: August, 1979

DSGN BY:	RGW, MH
DRN BY:	MH
CK'D BY:	RGW
APP'D BY:	

REVISIONS:	


CITY OF DETROIT, MICHIGAN




JOHN C. LODGE EXIT RAMP AND JEFFERSON AVENUE-RECONSTRUCTION AT THE JOE LOUIS ARENA.

PIER DETAILS
PIER 7-12


SCALE: NONE
DRN. NO: S40

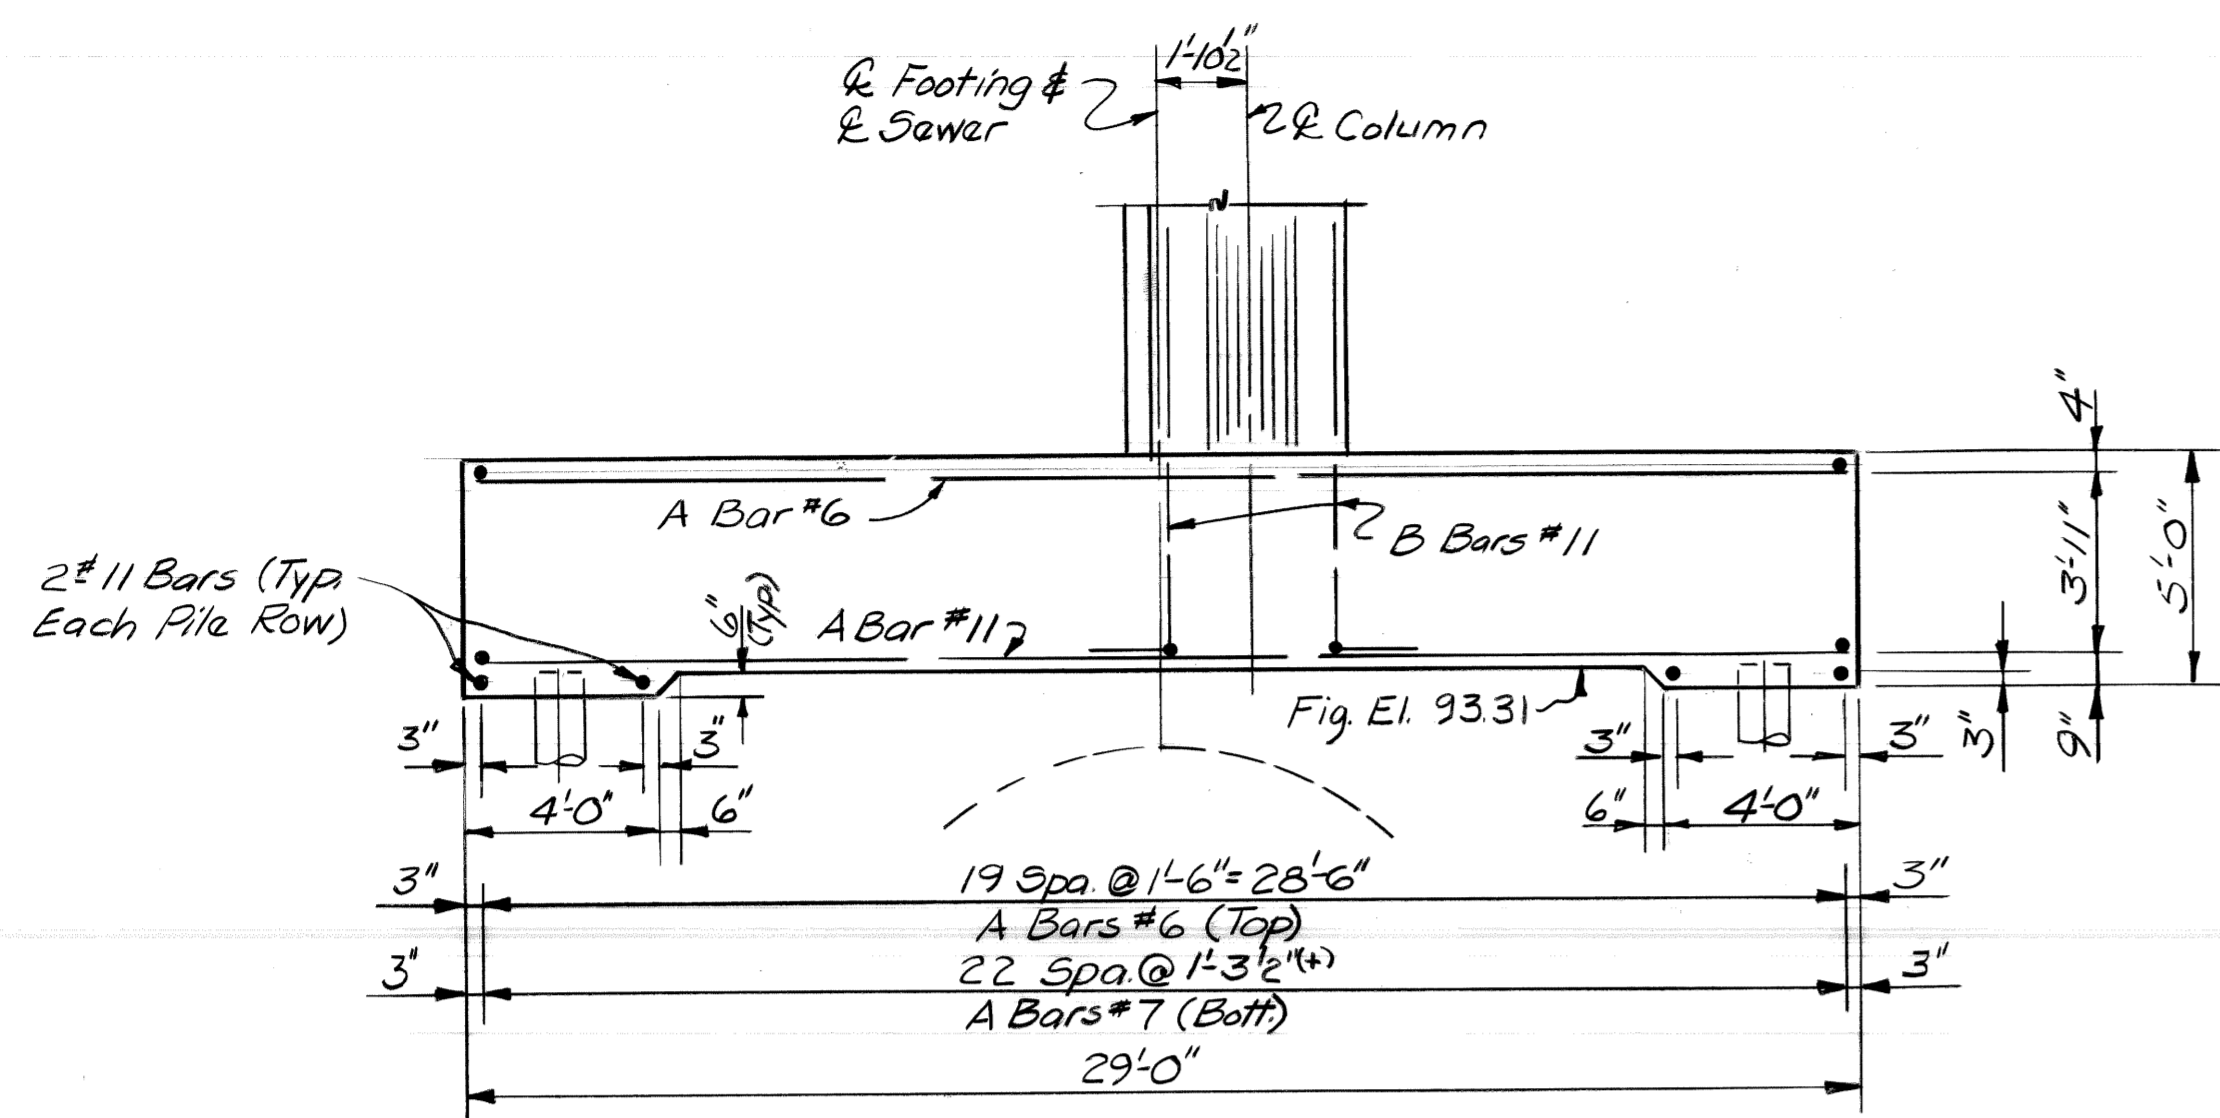

SECTION D-D

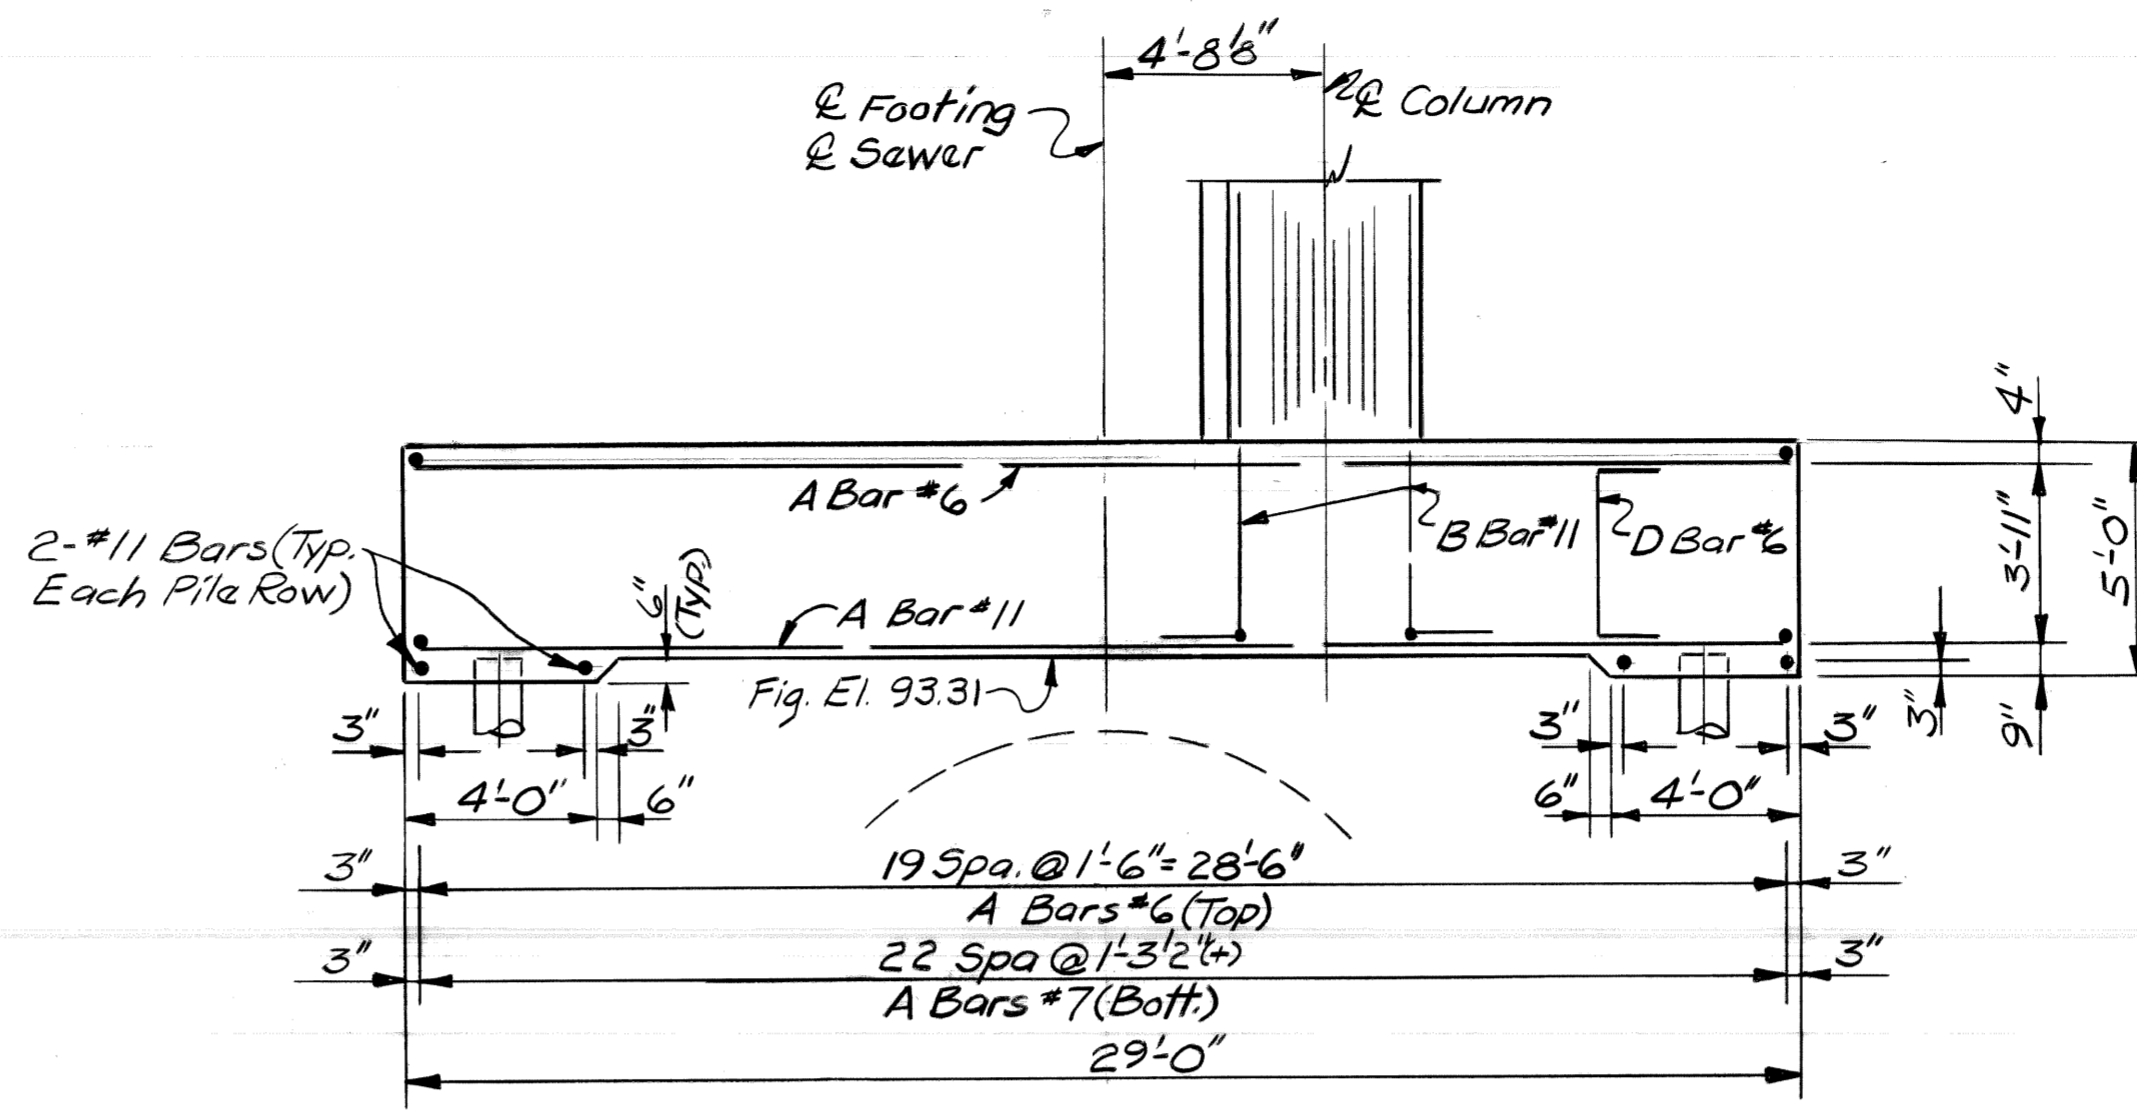

SECTION E-E

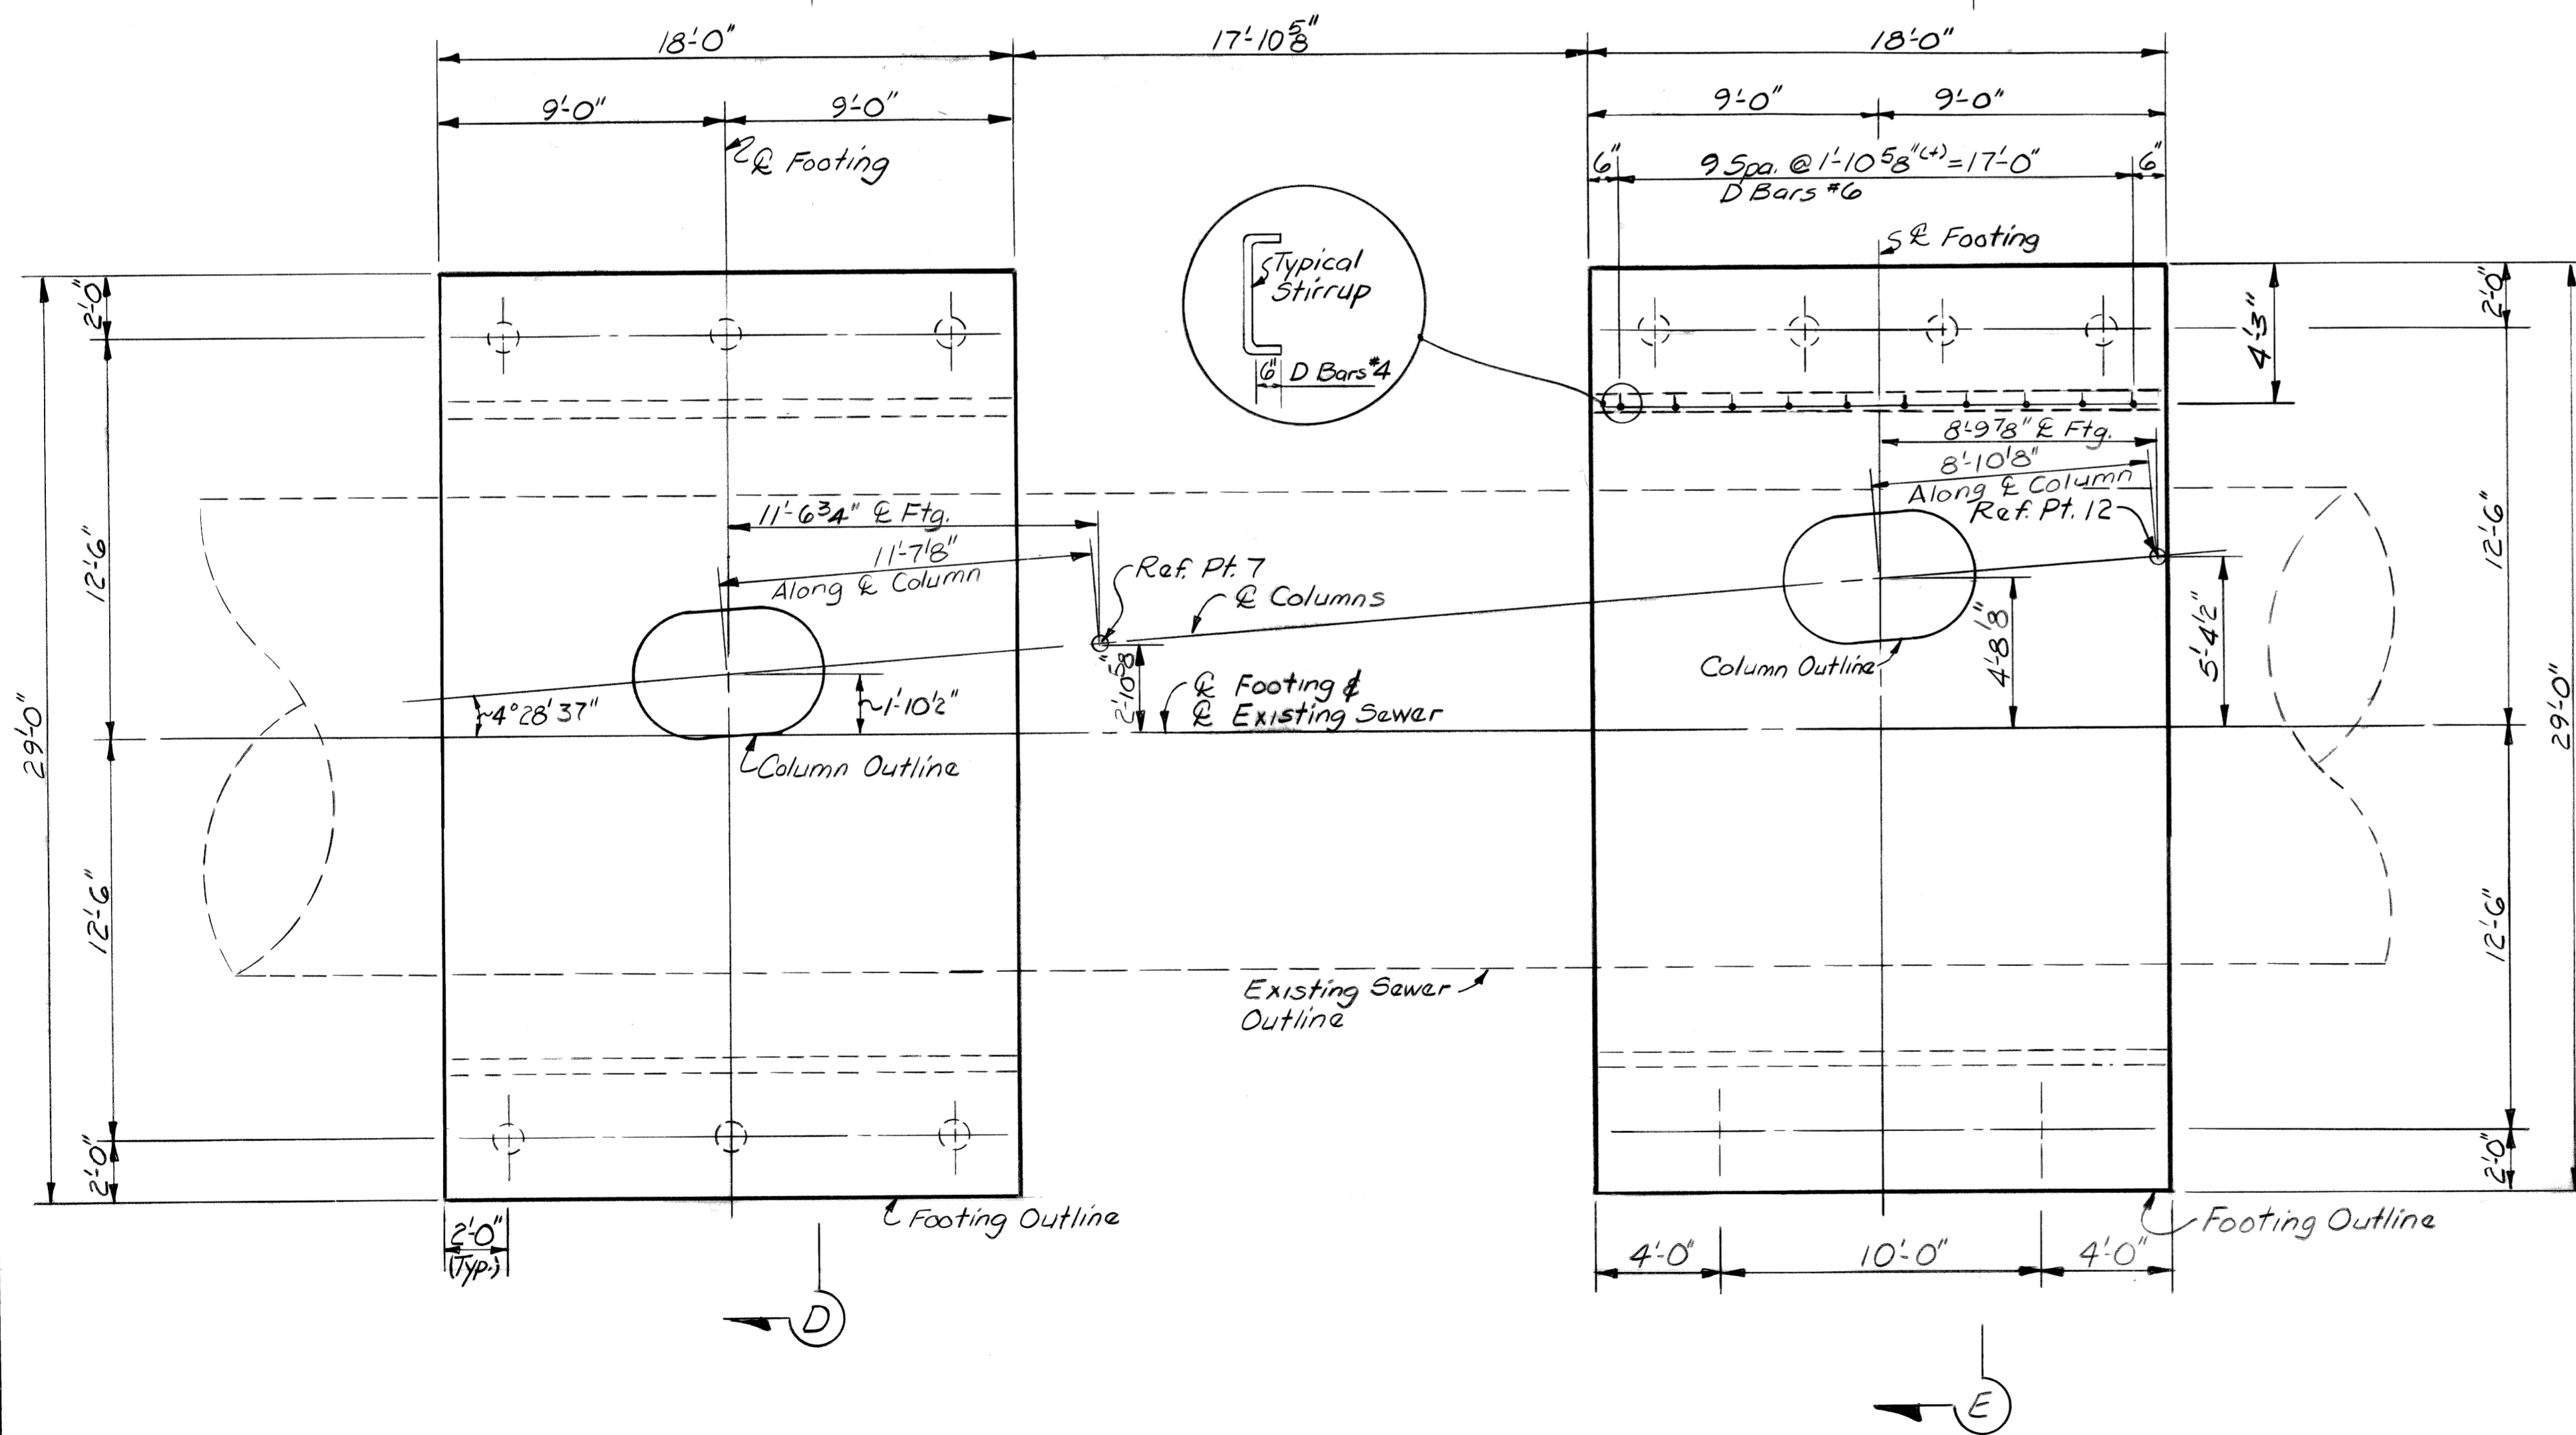

PLAN OF FOOTINGS
(Shown normal to R Sewer)

Work This Sheet With Sheets # S34 thru S40 & S42 thru S48

DATE: August, 1979

DSGN BY:	RGW, MH
DRN BY:	MH
CK'D BY:	RGW
APP'D BY:	

REVISIONS	

CITY OF DETROIT, MICHIGAN




JOHN C. LODGE EXIT RAMP AND JEFFERSON AVENUE - RECONSTRUCTION AT THE JOE LOUIS ARENA.


PIER DETAILS
PIER 7-12 FOOTING PLANS AND SECTIONS

SCALE: NONE


DRN. NO: S41

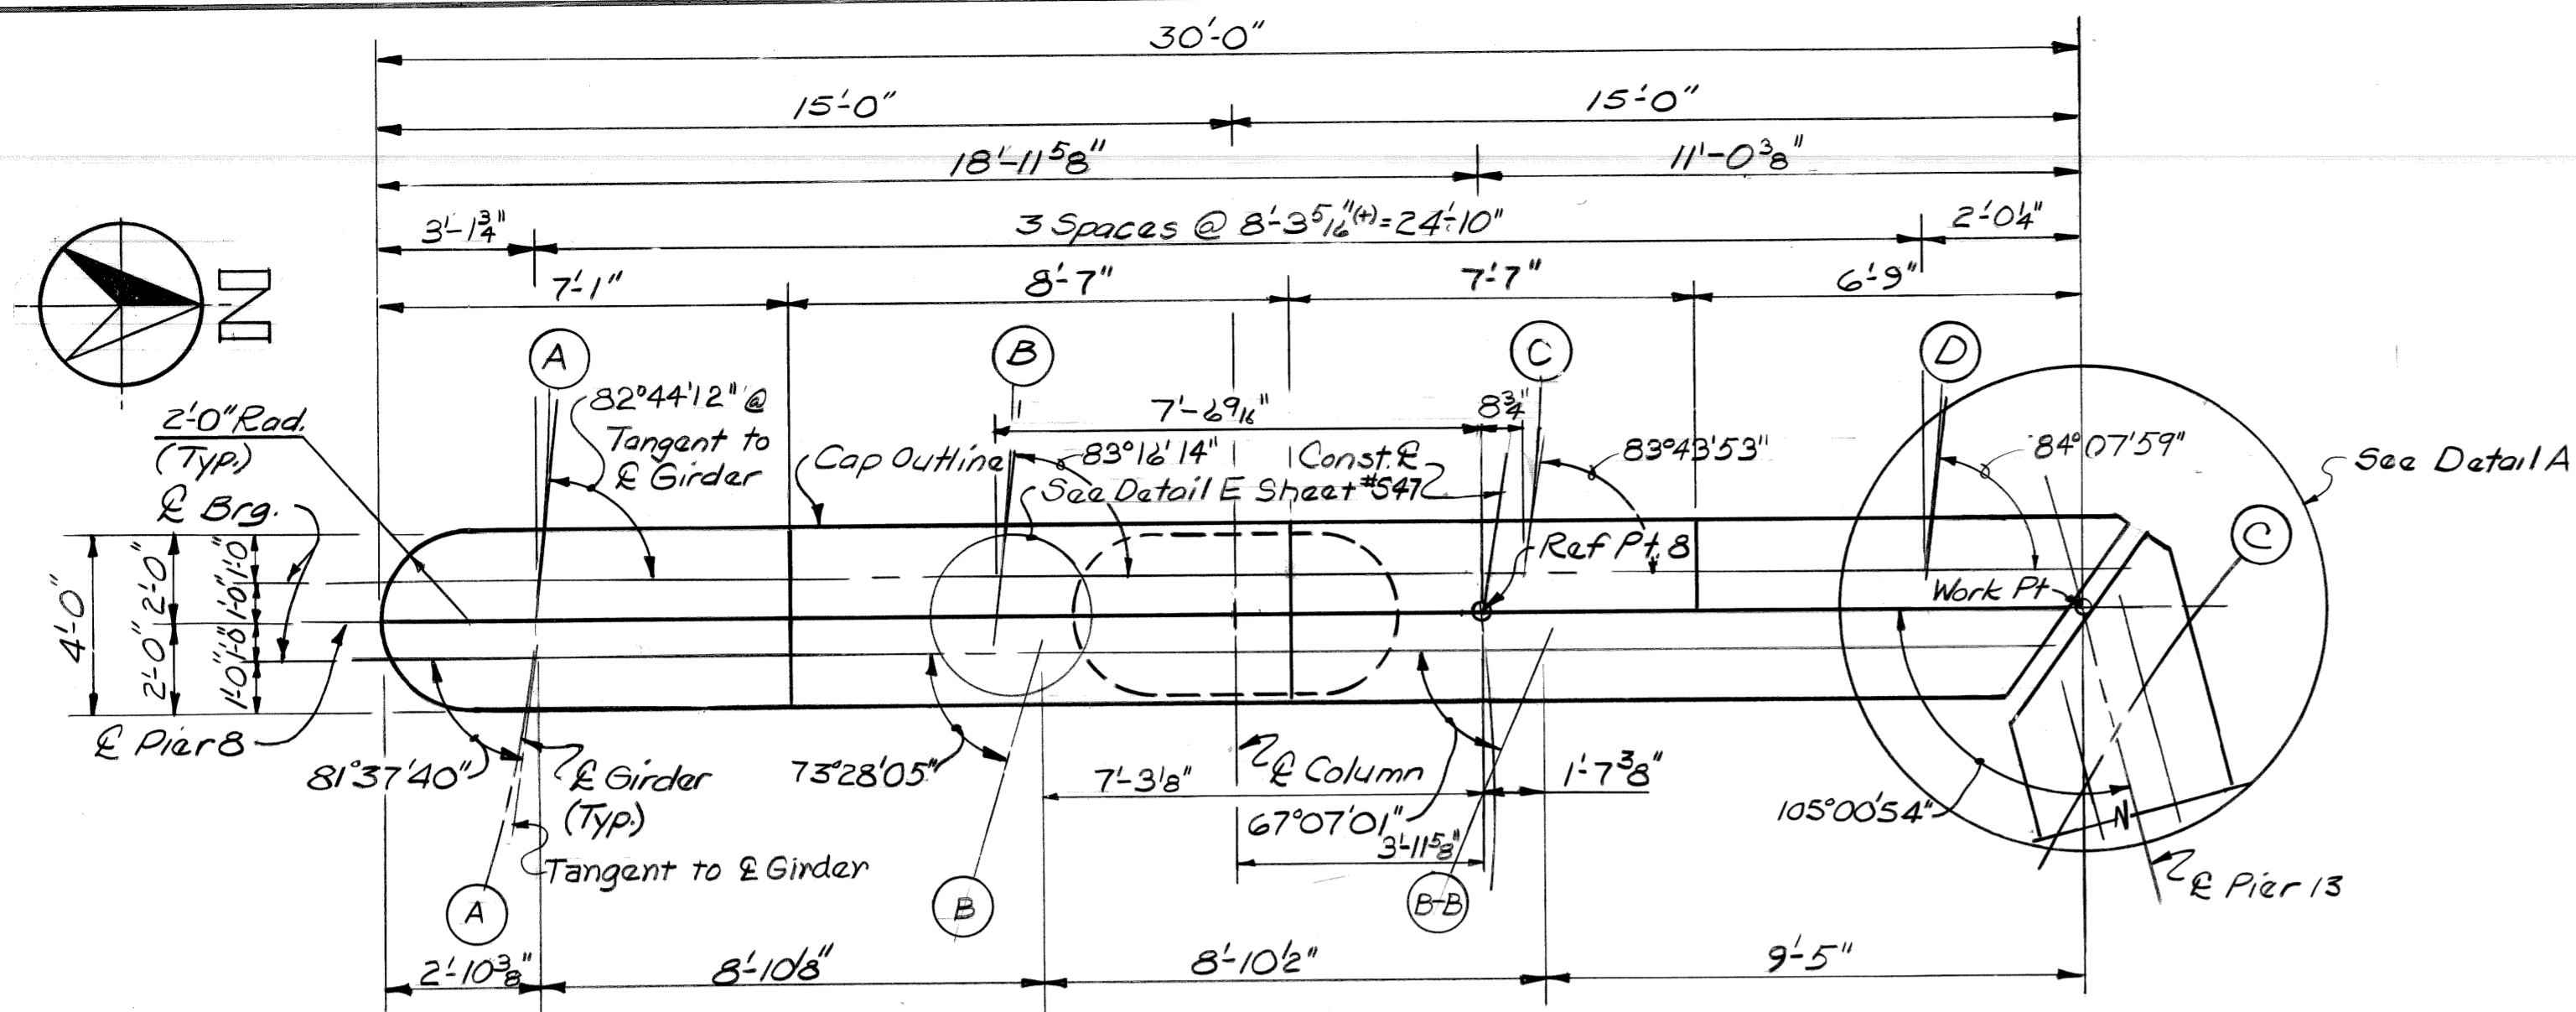


PLAN OF CAP

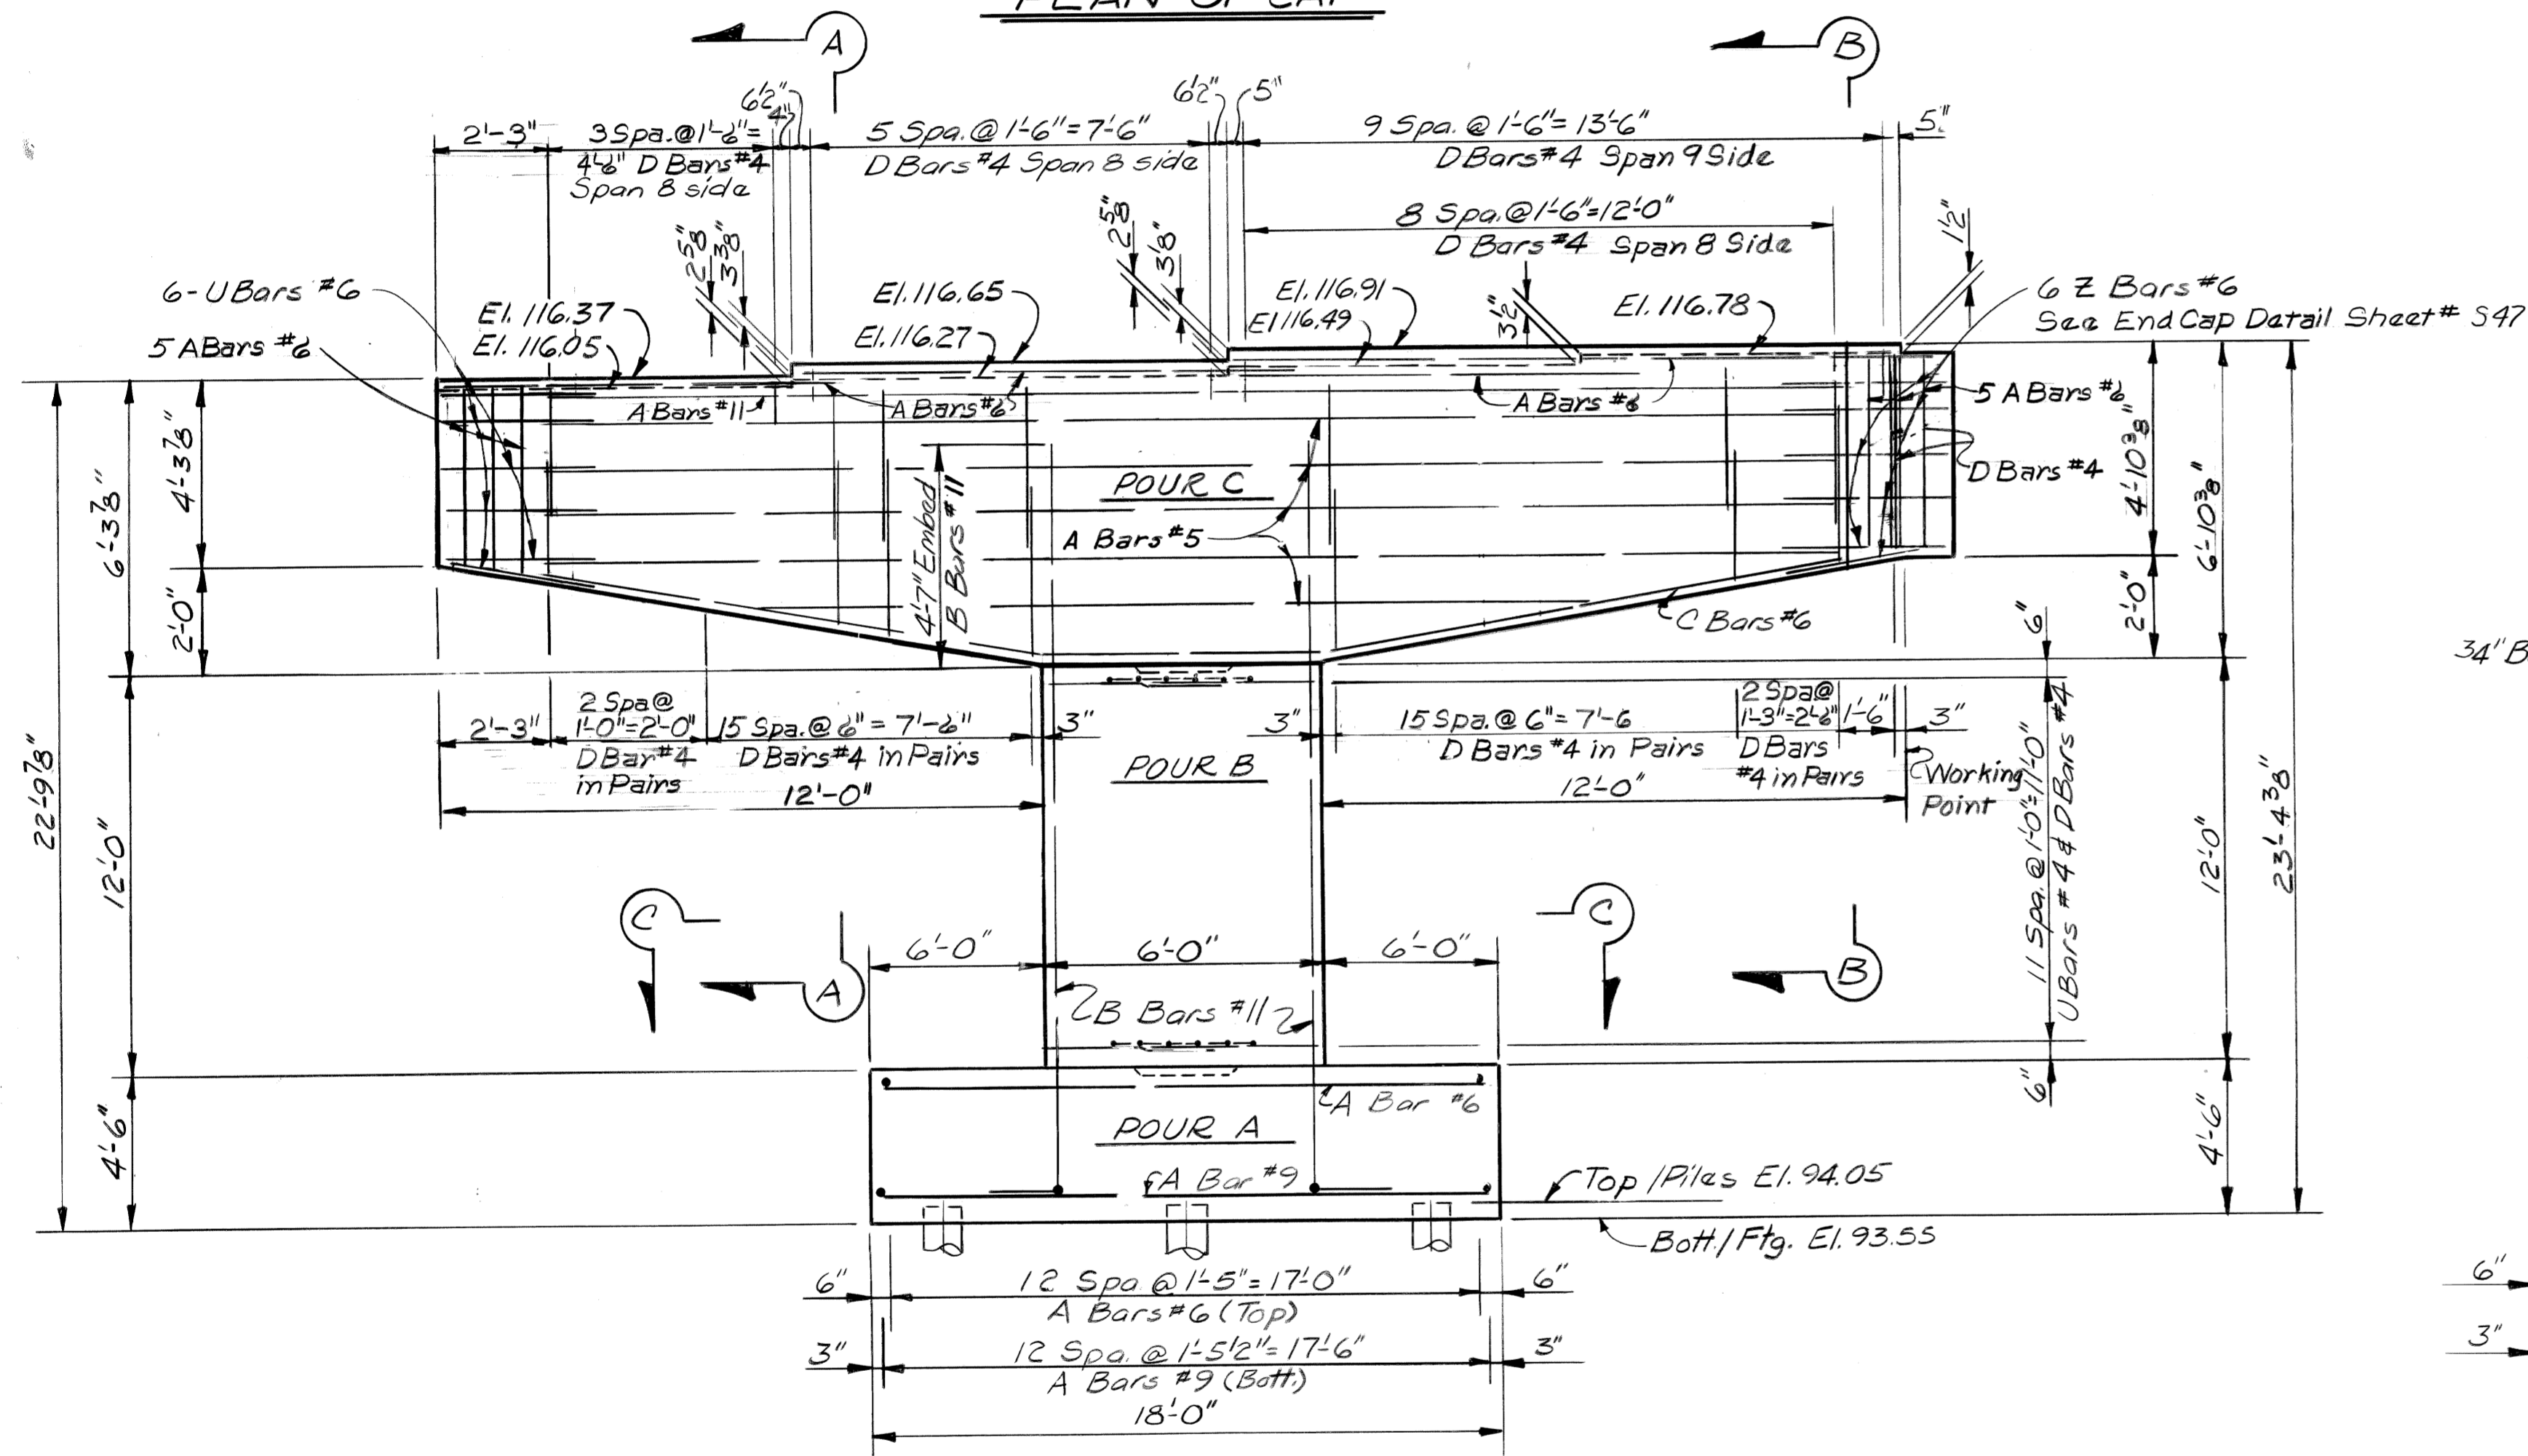


ELEVATION

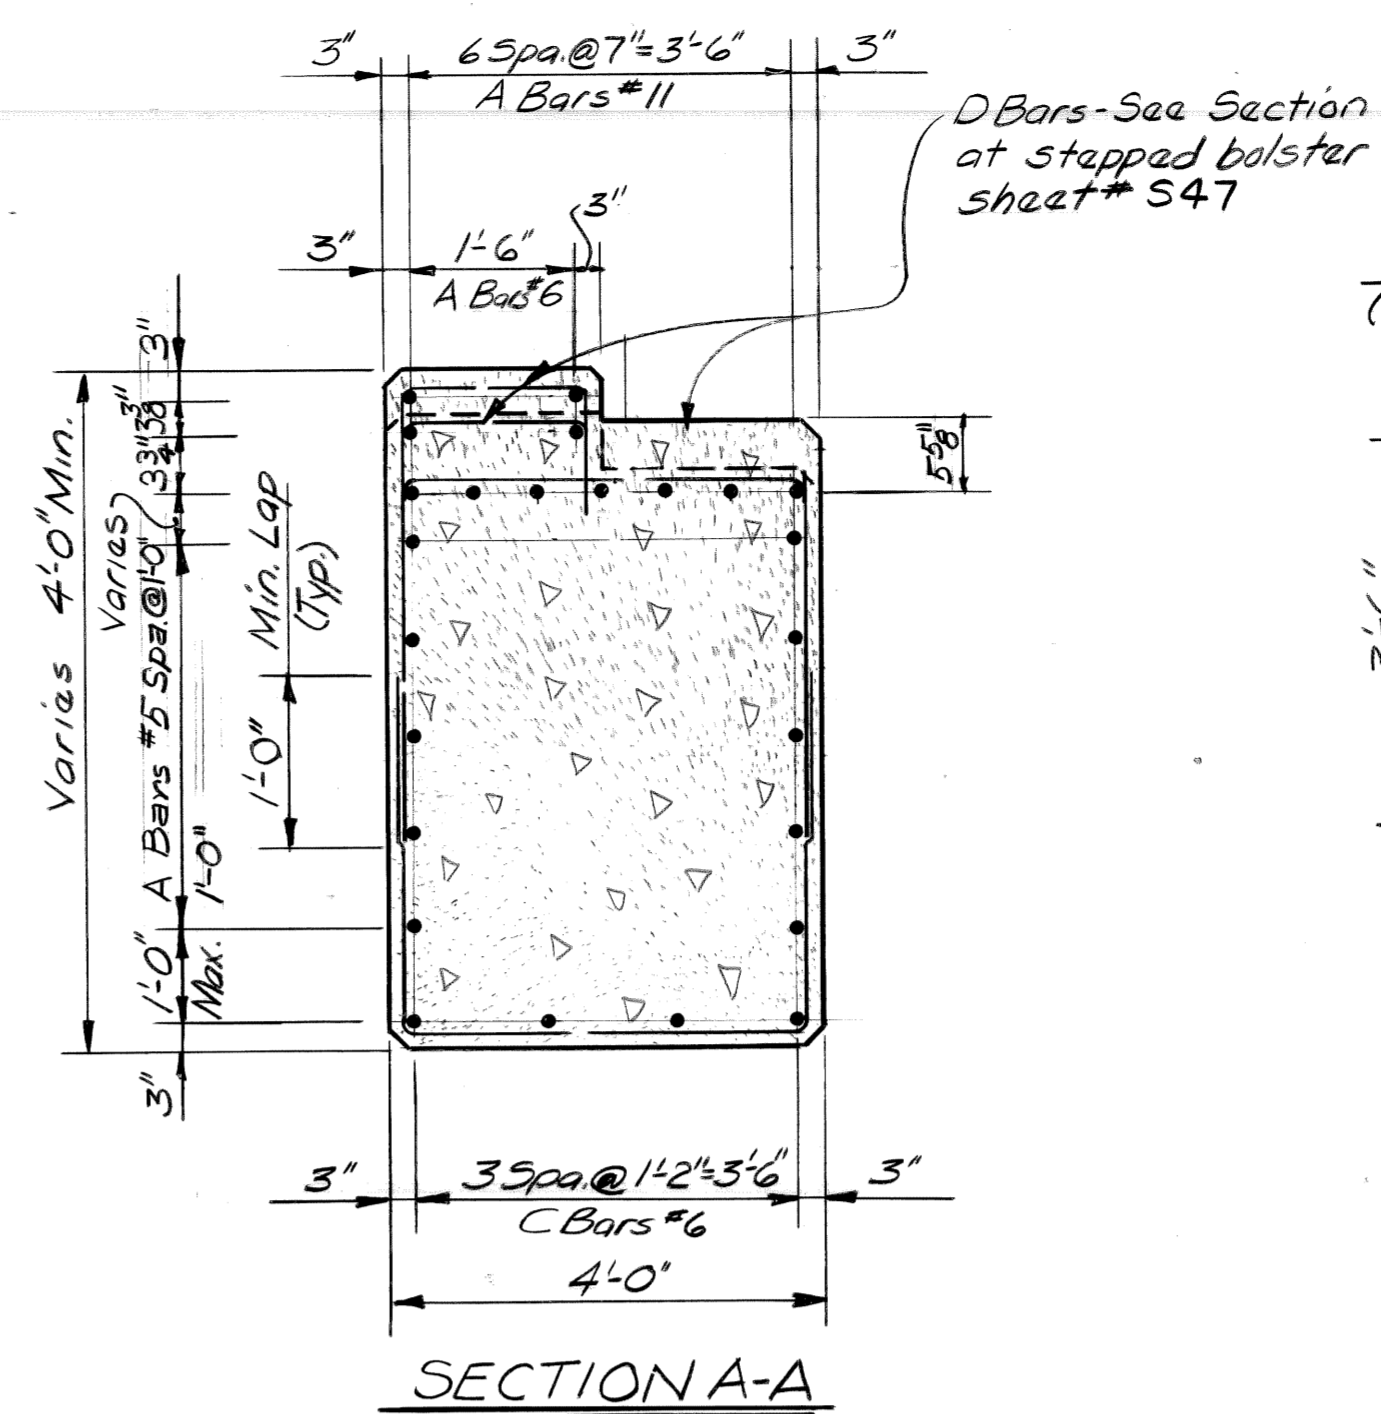


SECTION A-A

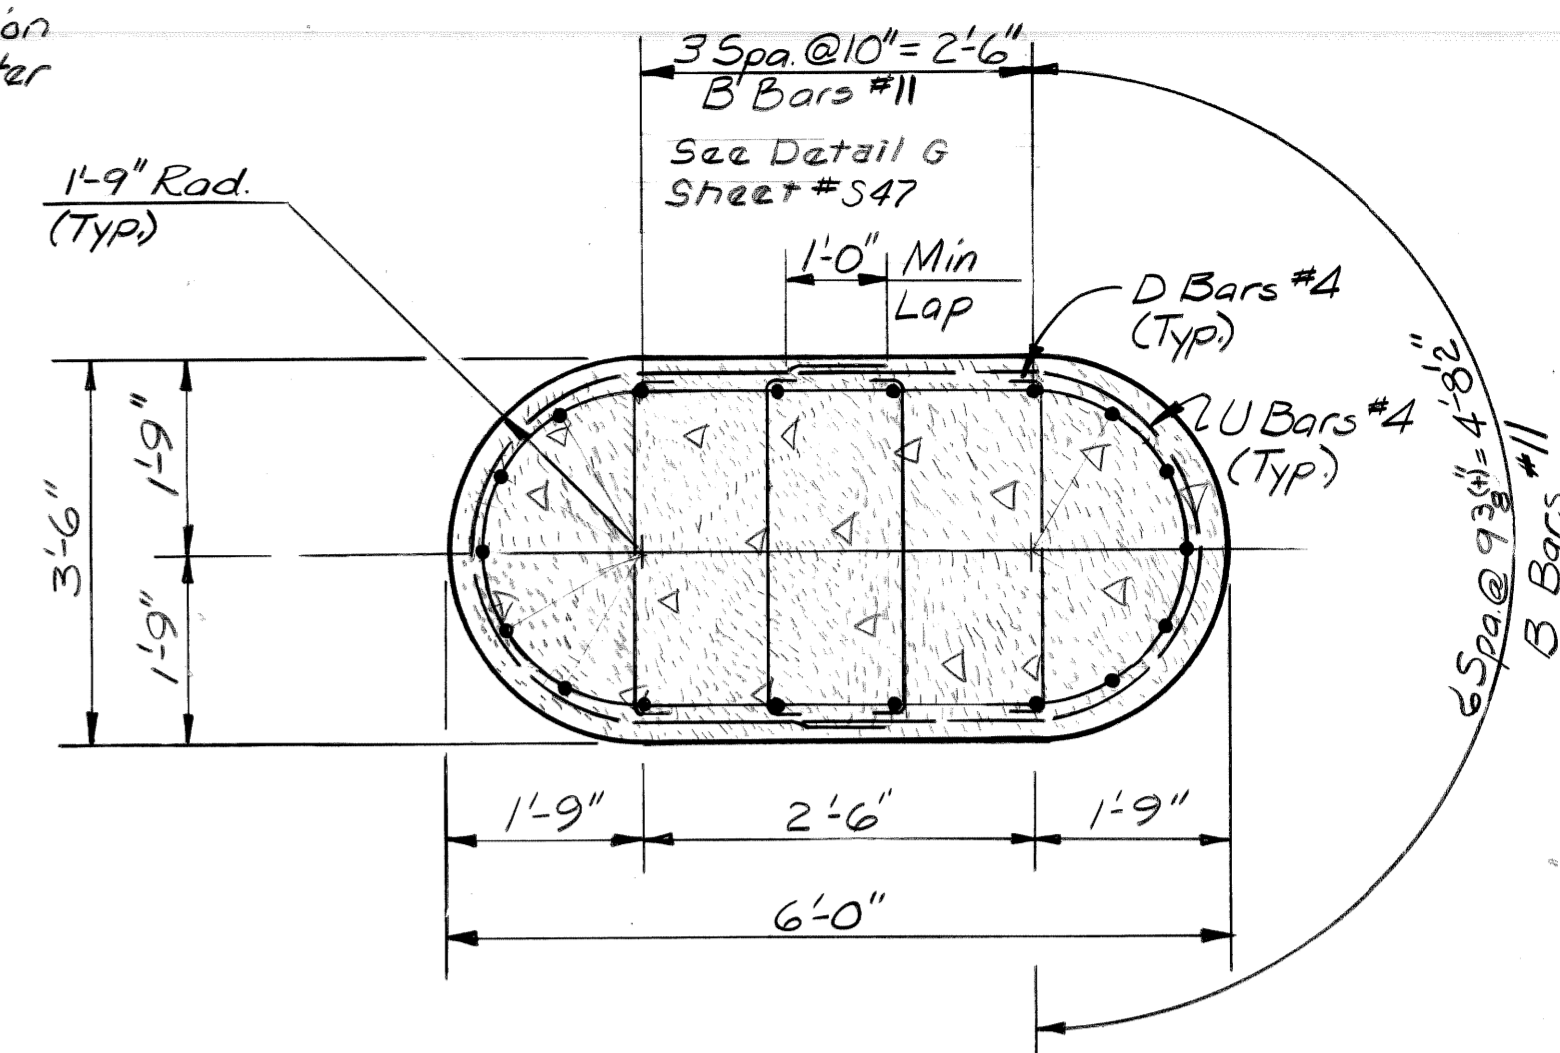


SECTION B-B

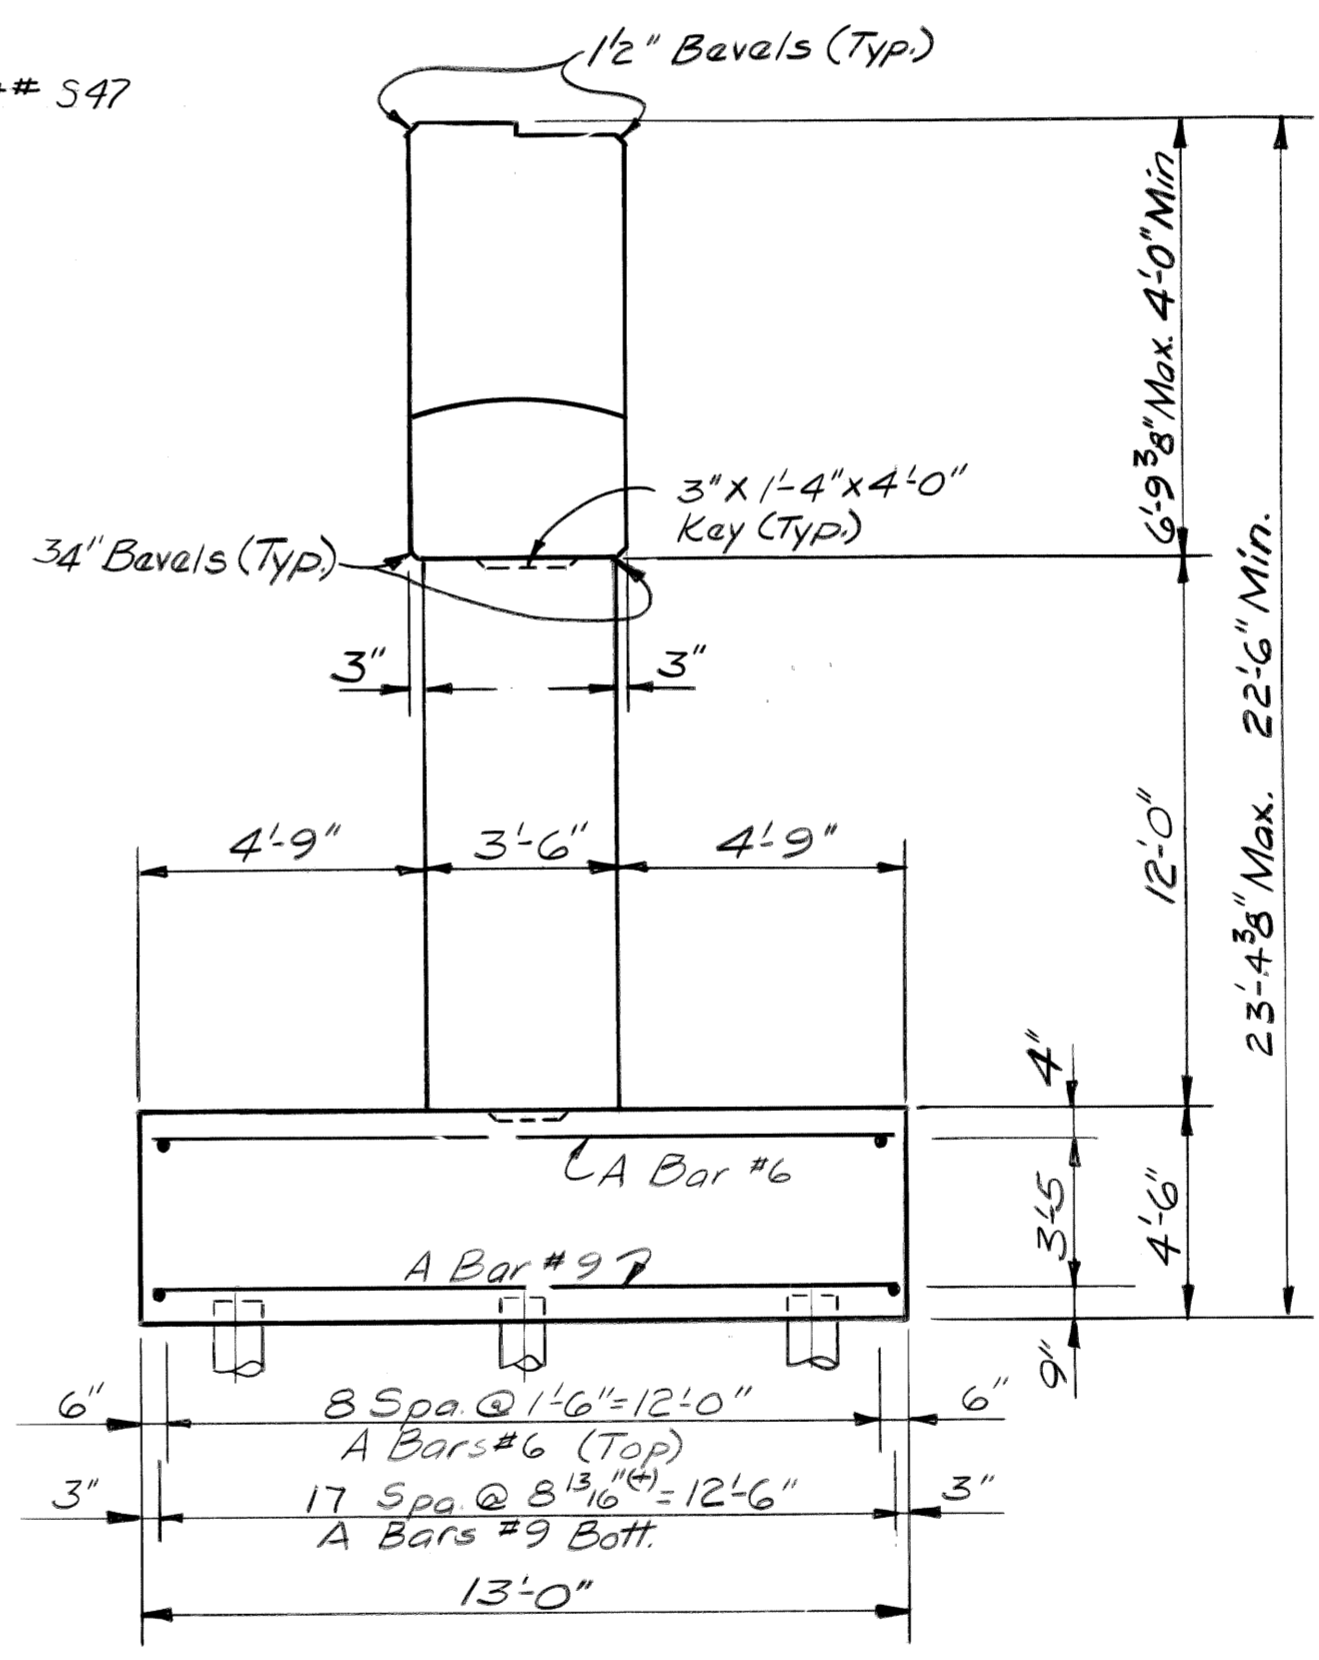

END VIEW

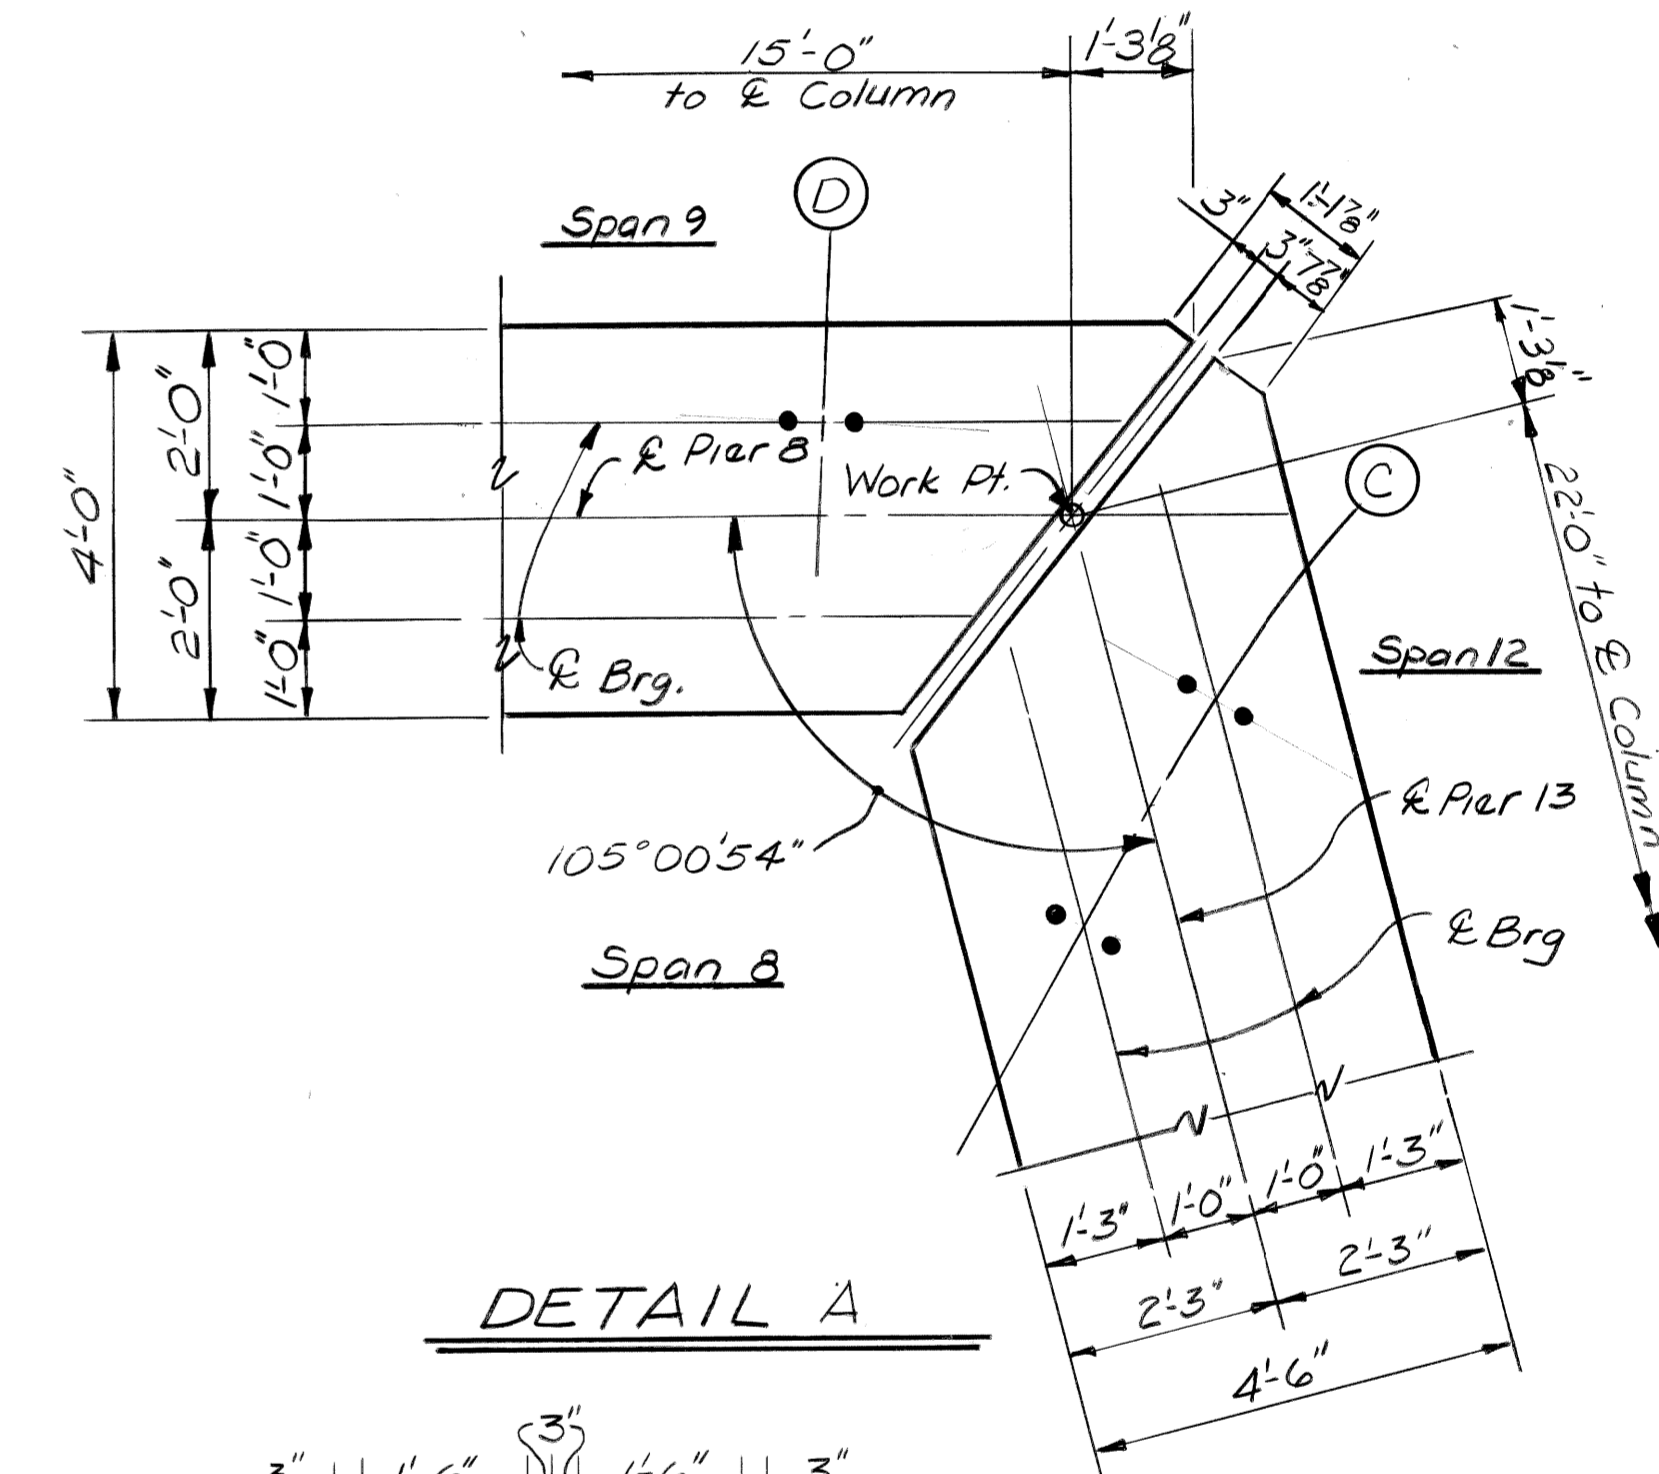

DETAIL A

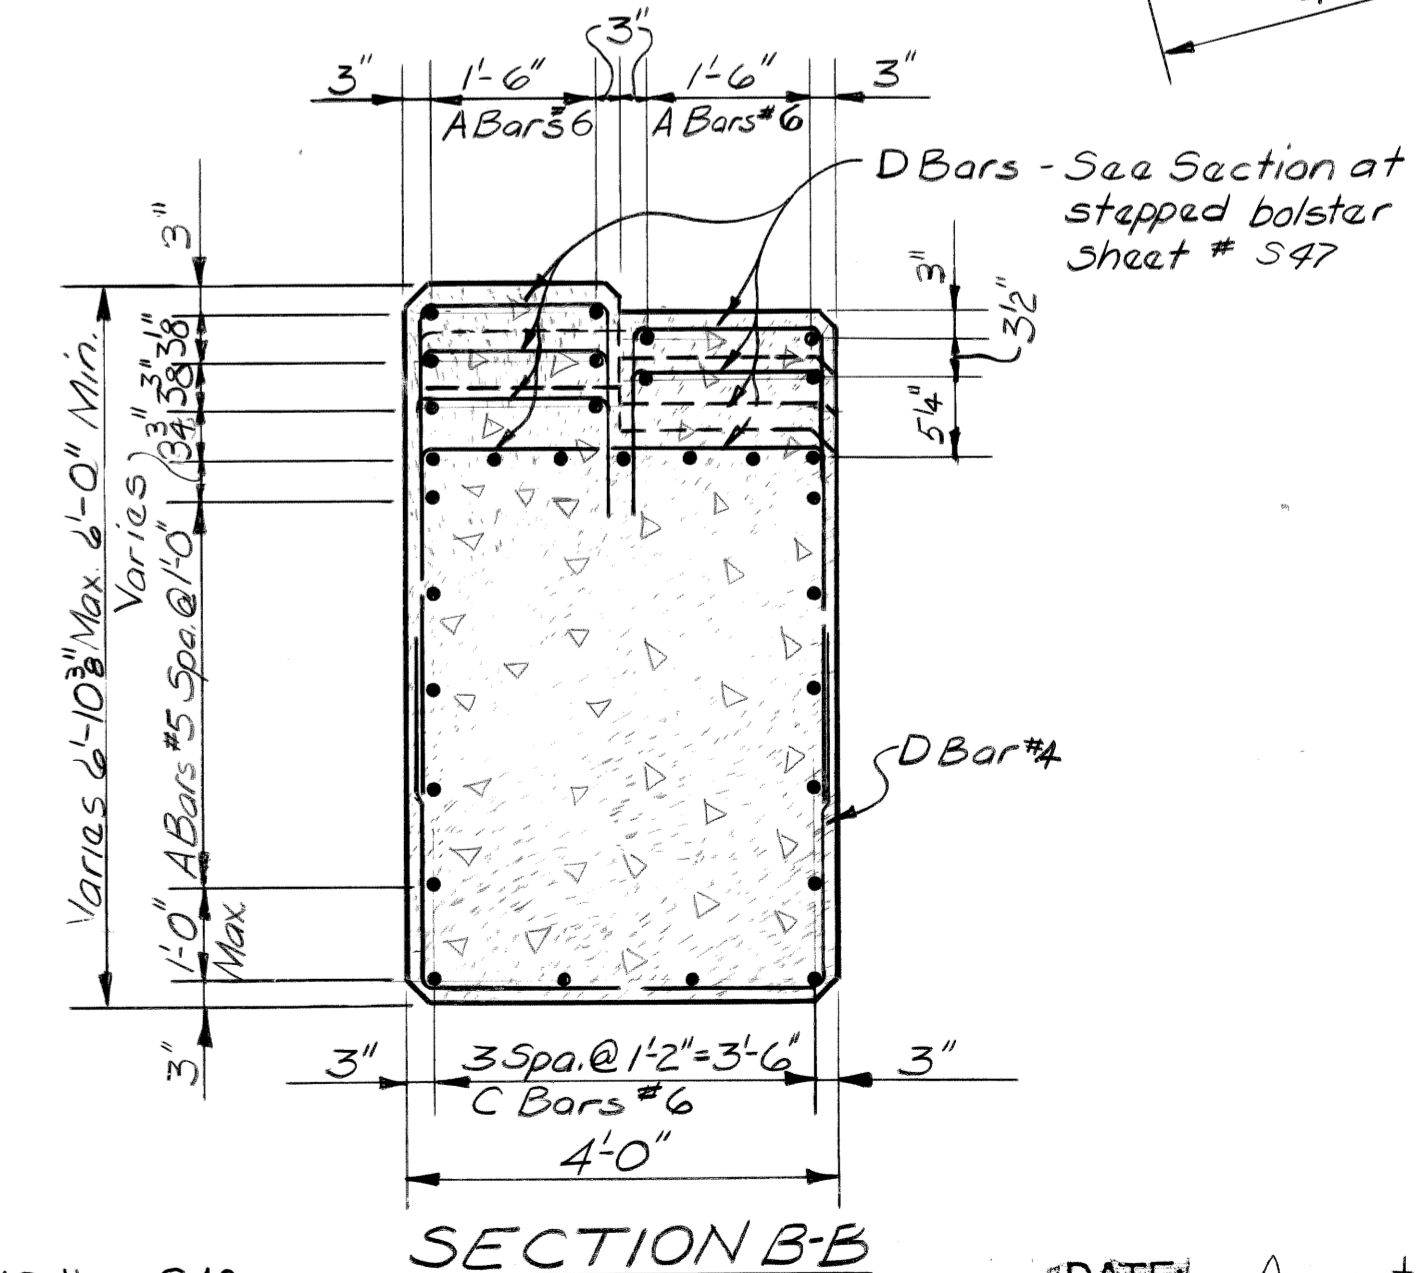

SECTION B-B

Work This Sheet With Sheets # S34 thru S41 & S43 thru S48

DATE: August, 1979

DSGN BY:	RGW, MH
DRN BY:	MH
CK'D BY:	RGW
APP'D BY:	

REVISIONS	


CITY OF DETROIT, MICHIGAN




JOHN C. LODGE EXIT RAMP AND JEFFERSON AVENUE-
RECONSTRUCTION AT THE JOE LOUIS ARENA

PIER DETAILS
PIER 8


SCALE: NONE
DRN. NO: S42

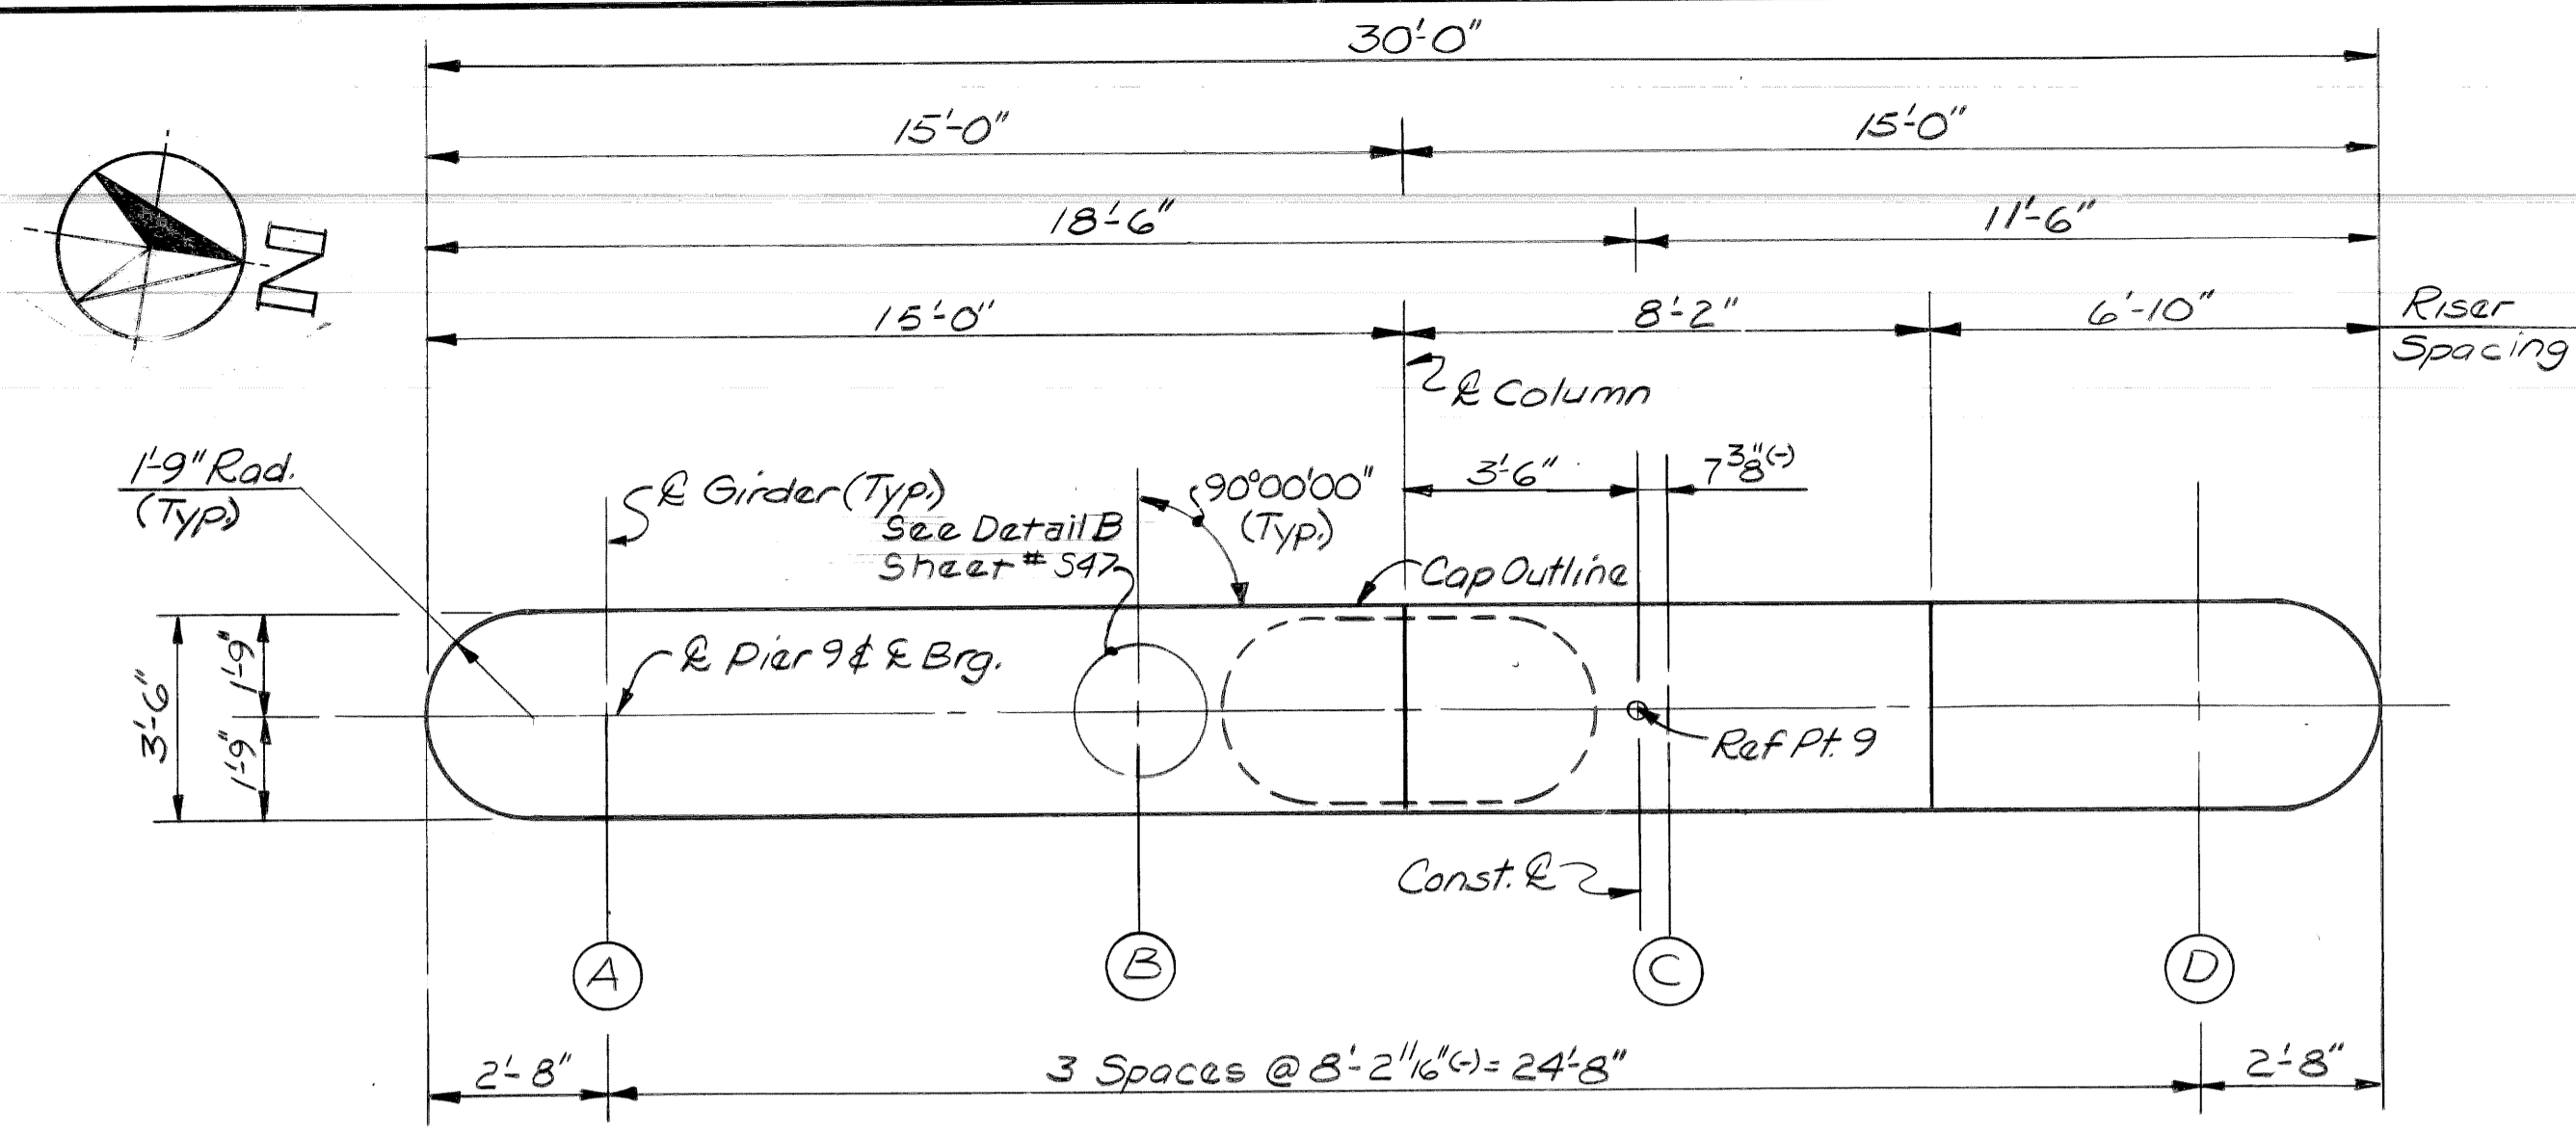


PLAN OF CAP

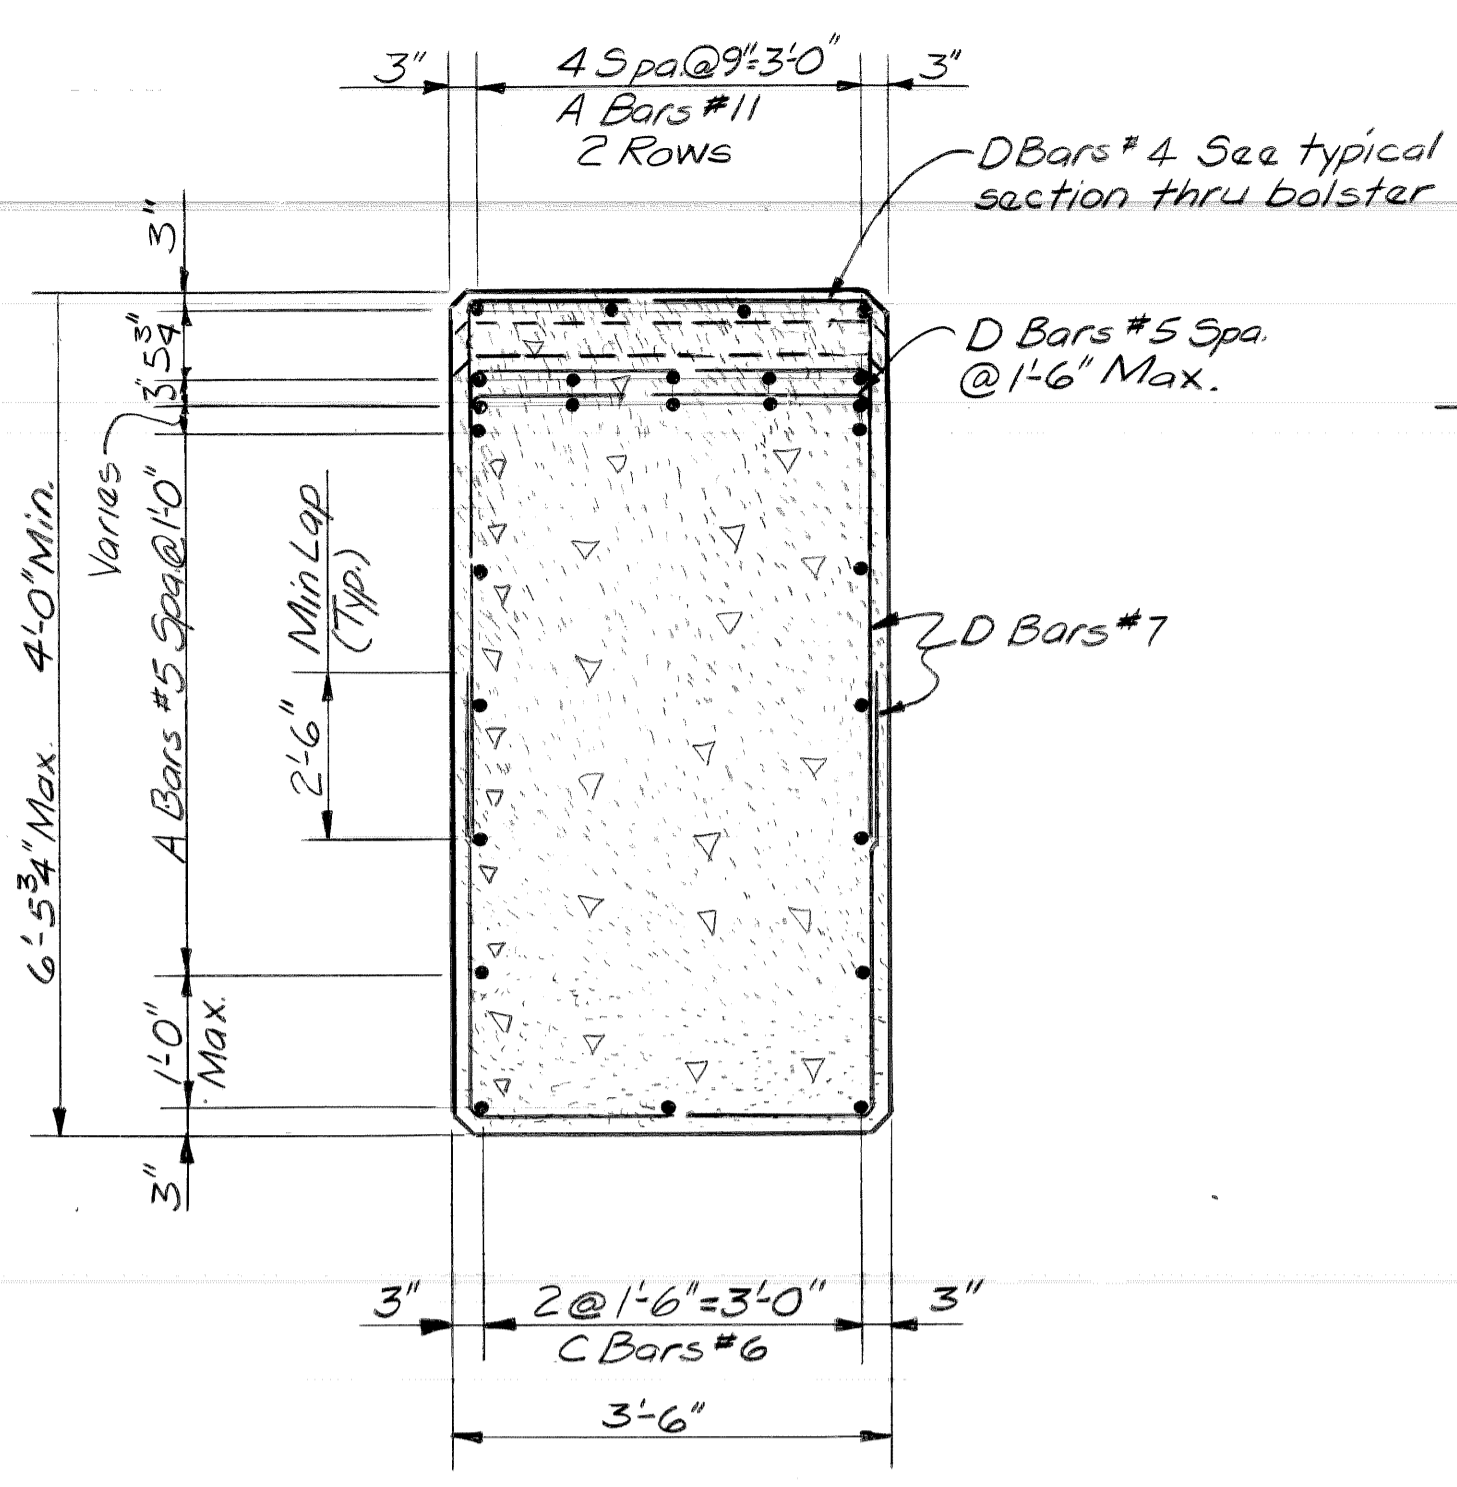


SECTION A-A

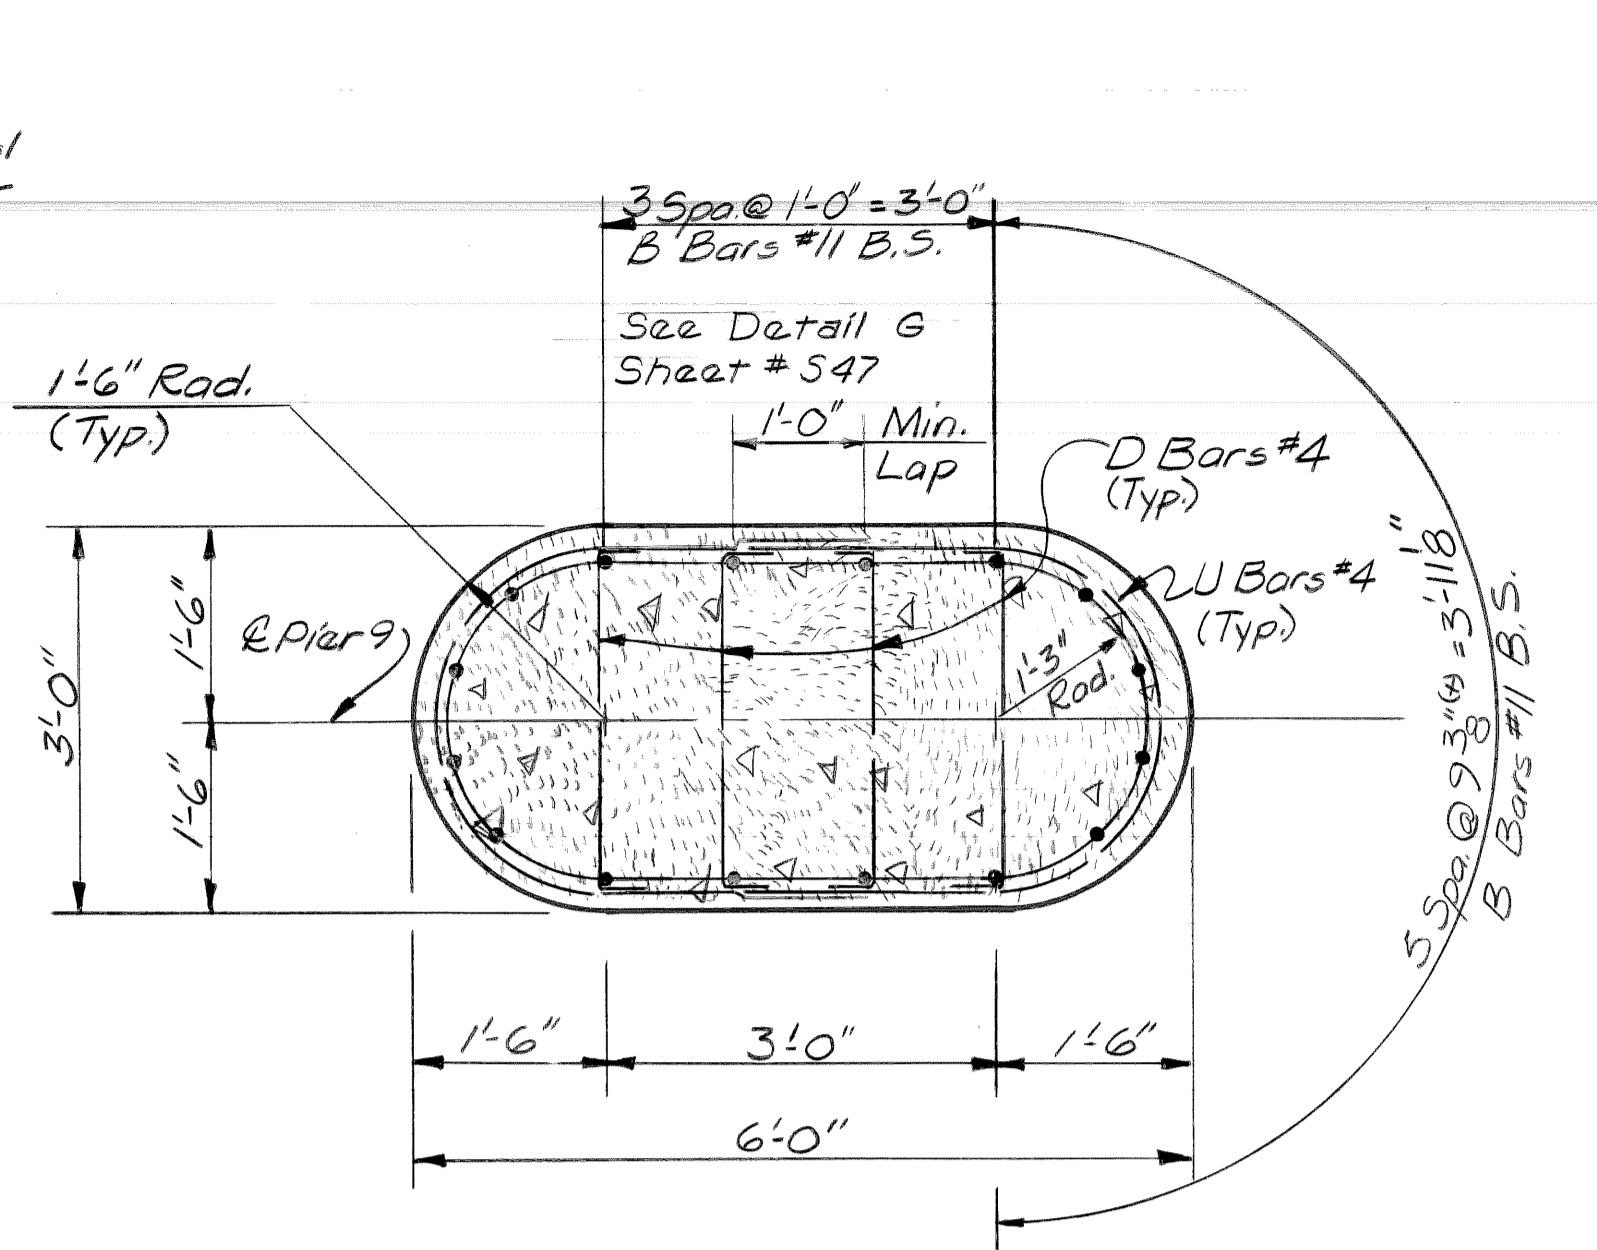

SECTION B-B

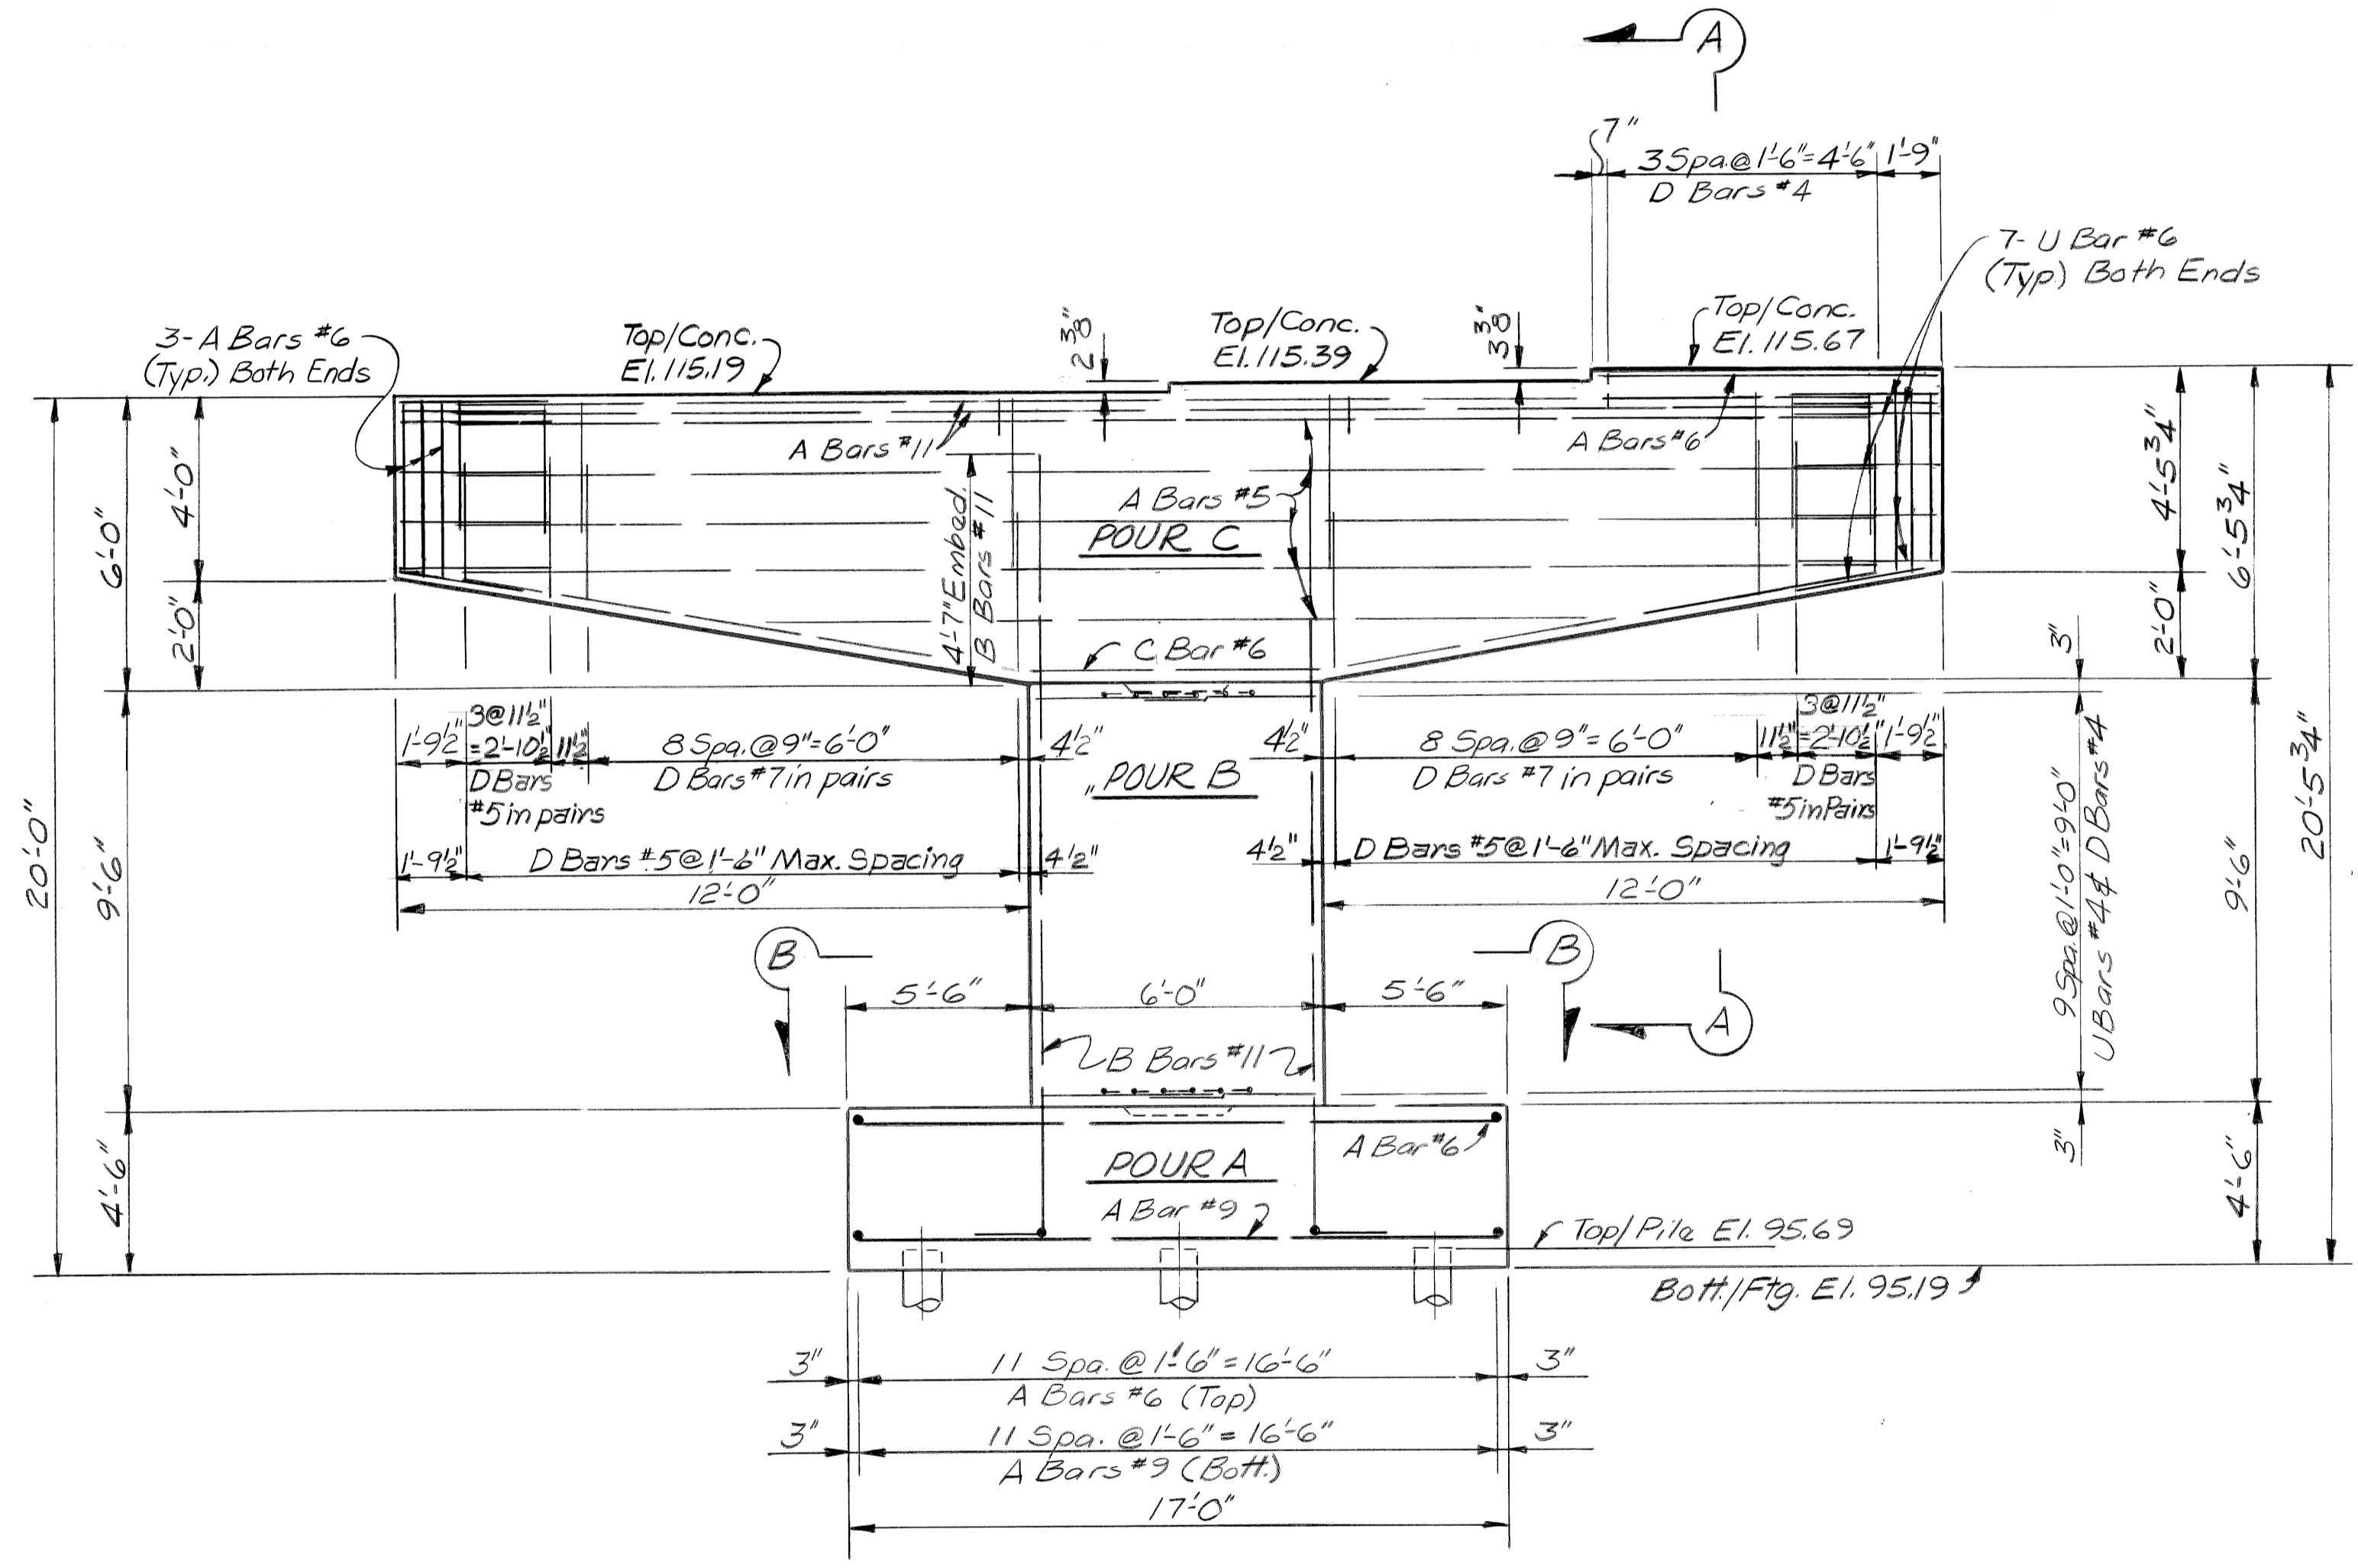

ELEVATION

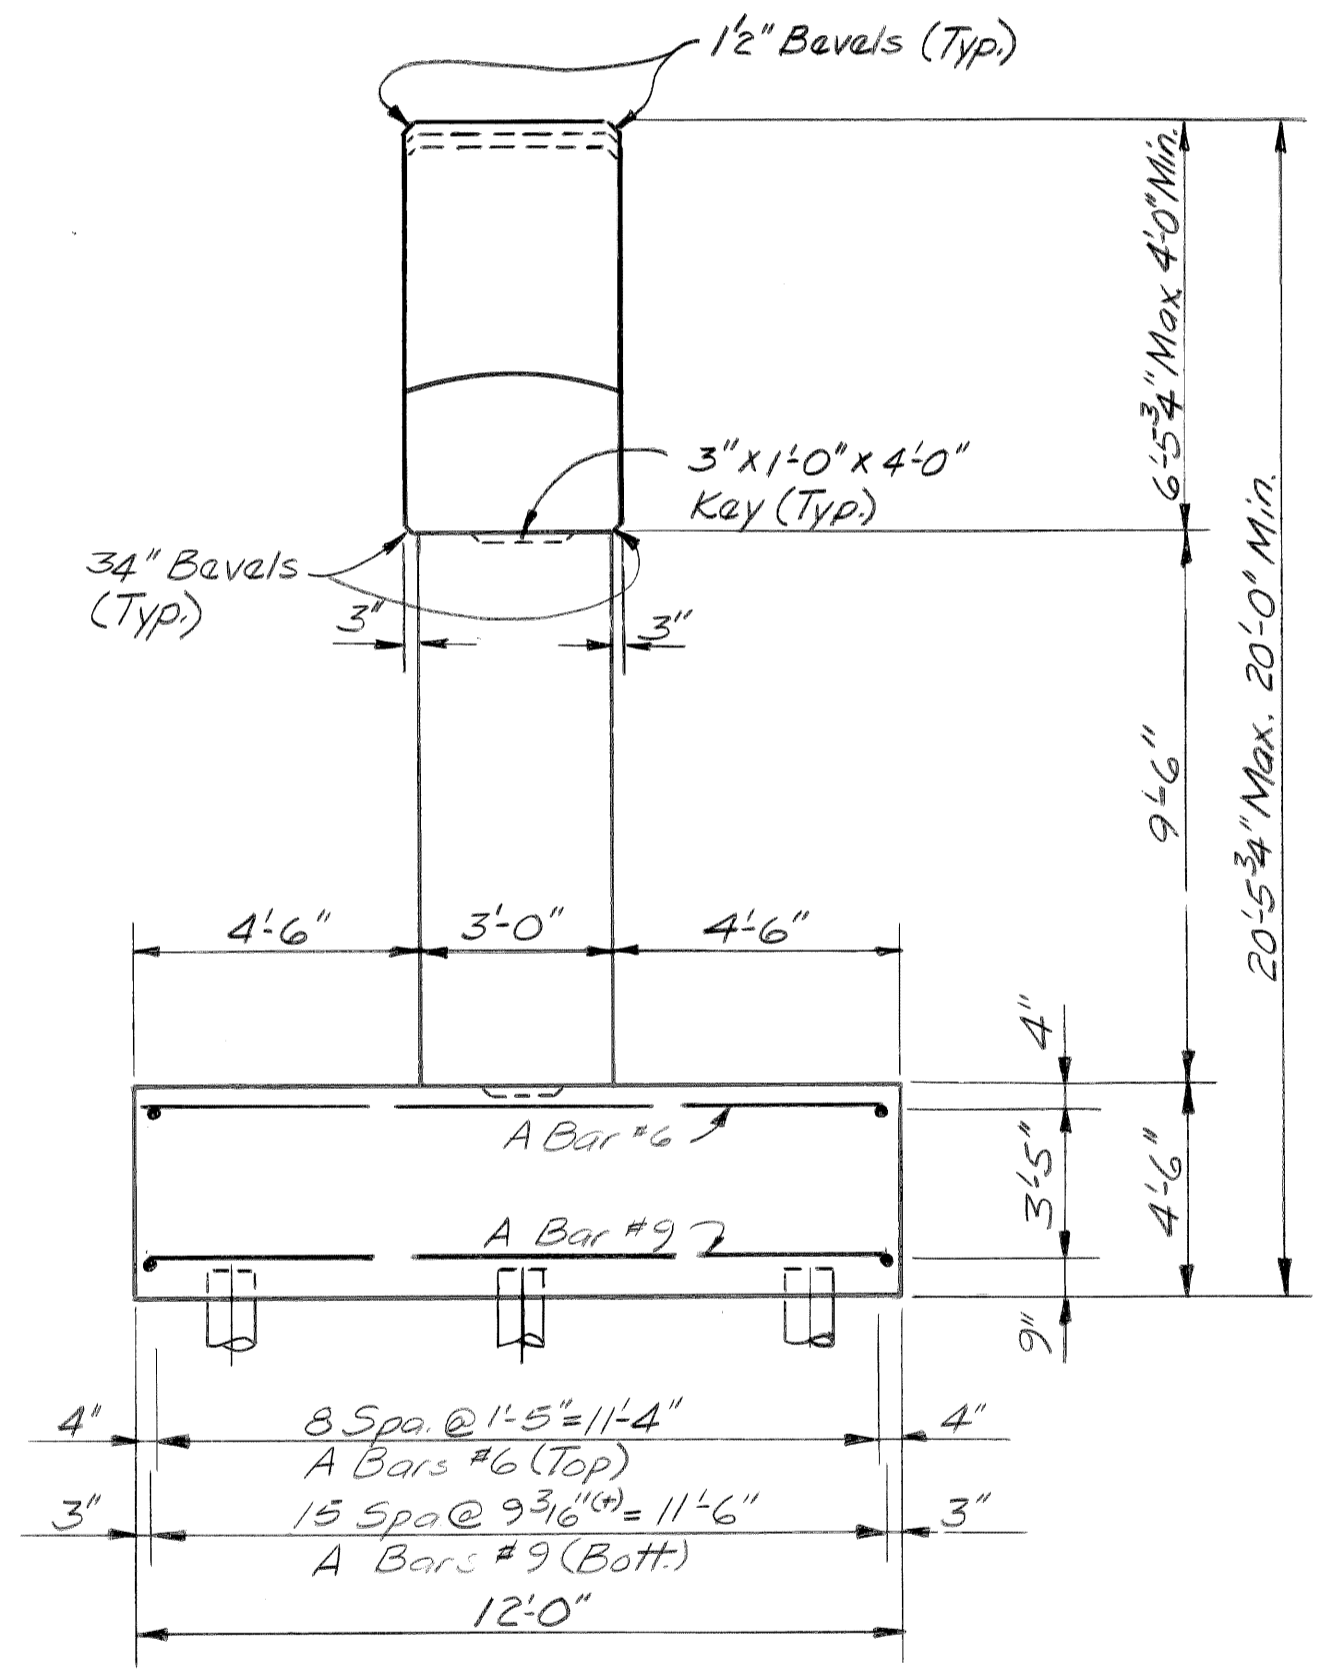


END VIEW

DSGN BY:	RGW, MH
DRN BY:	MH
CK'D BY:	RGW
APP'D BY:	

REVISIONS	


CITY OF DETROIT, MICHIGAN

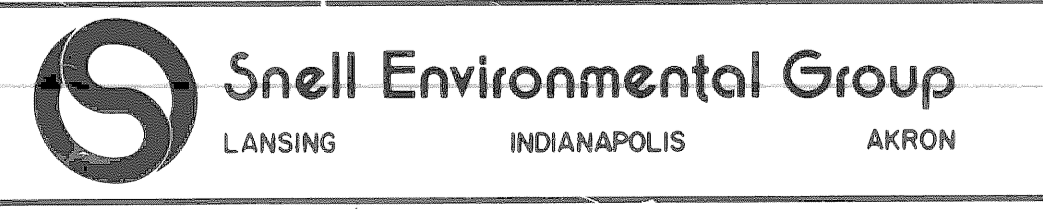


Work This Sheet With Sheets # 534 thru 542 & 544 thru 548
 JOHN C. LODGE EXIT RAMP AND JEFFERSON AVENUE-
 RECONSTRUCTION AT THE JOE LOUIS ARENA

PIER DETAILS
 PIER 9


DATE: August, 1979
 SCALE: NONE
 DRN. NO. S43

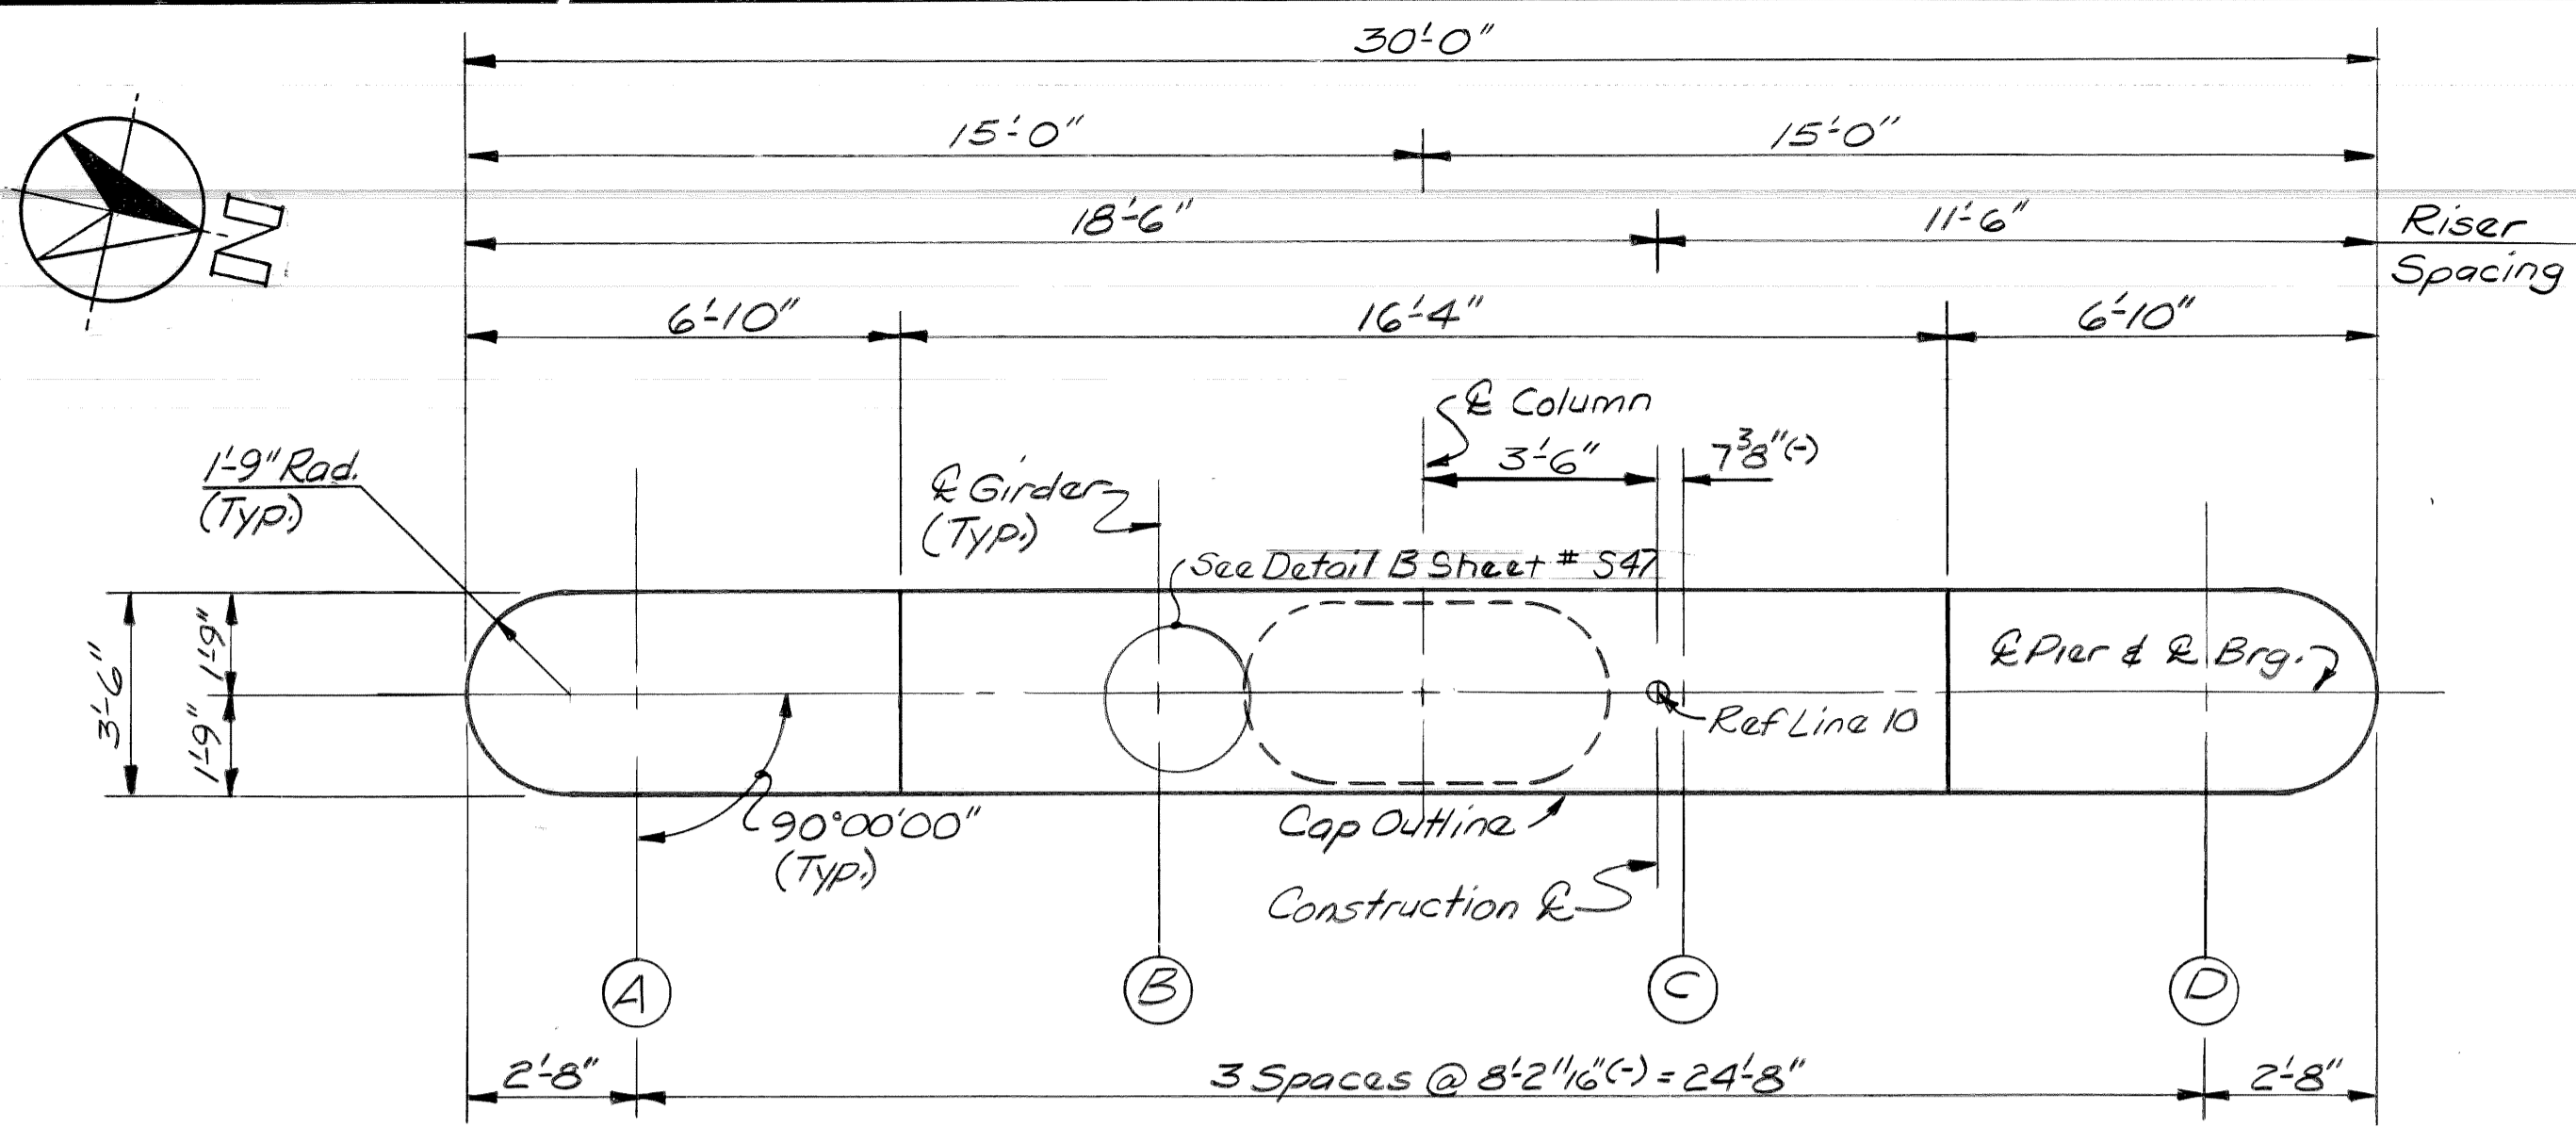


PLAN OF CAP

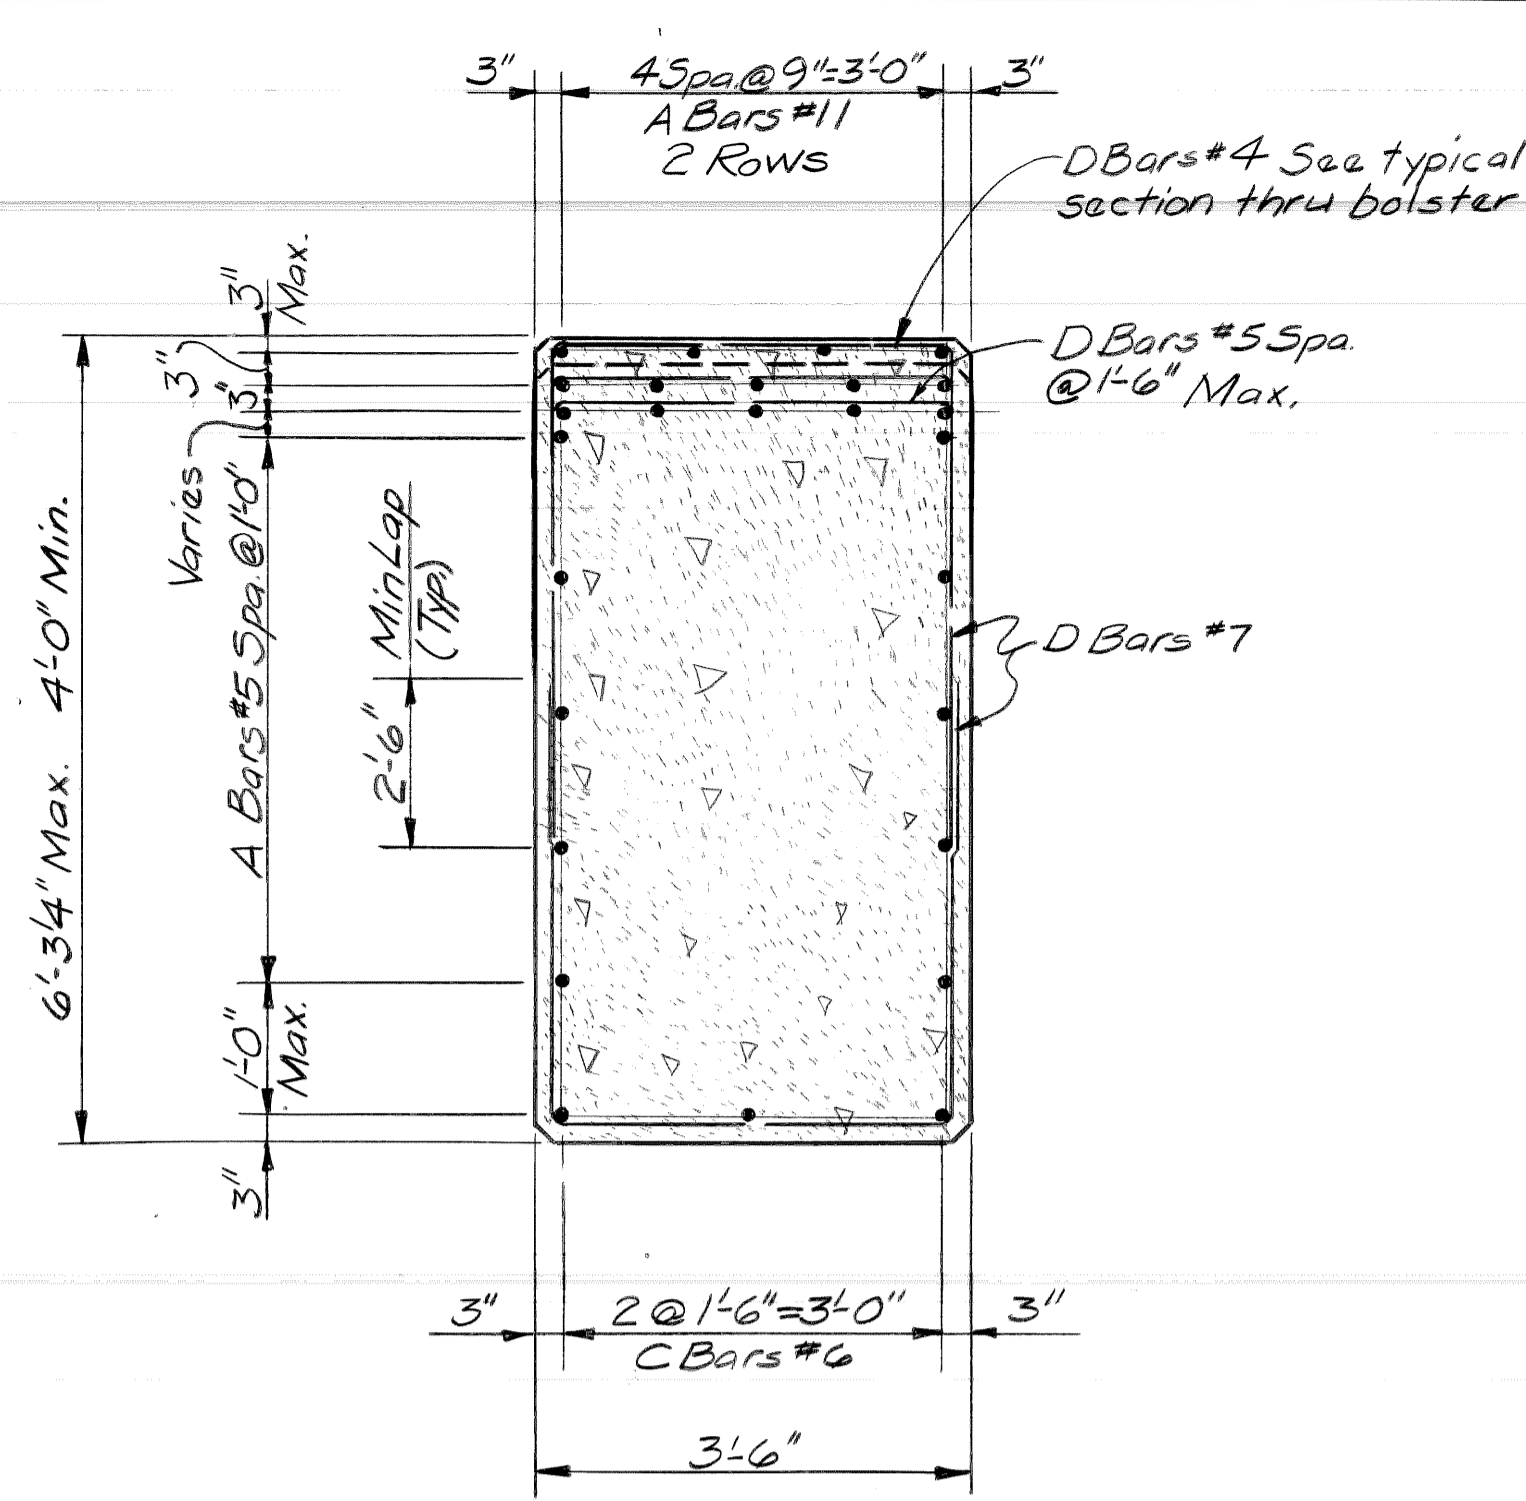


SECTION A-A

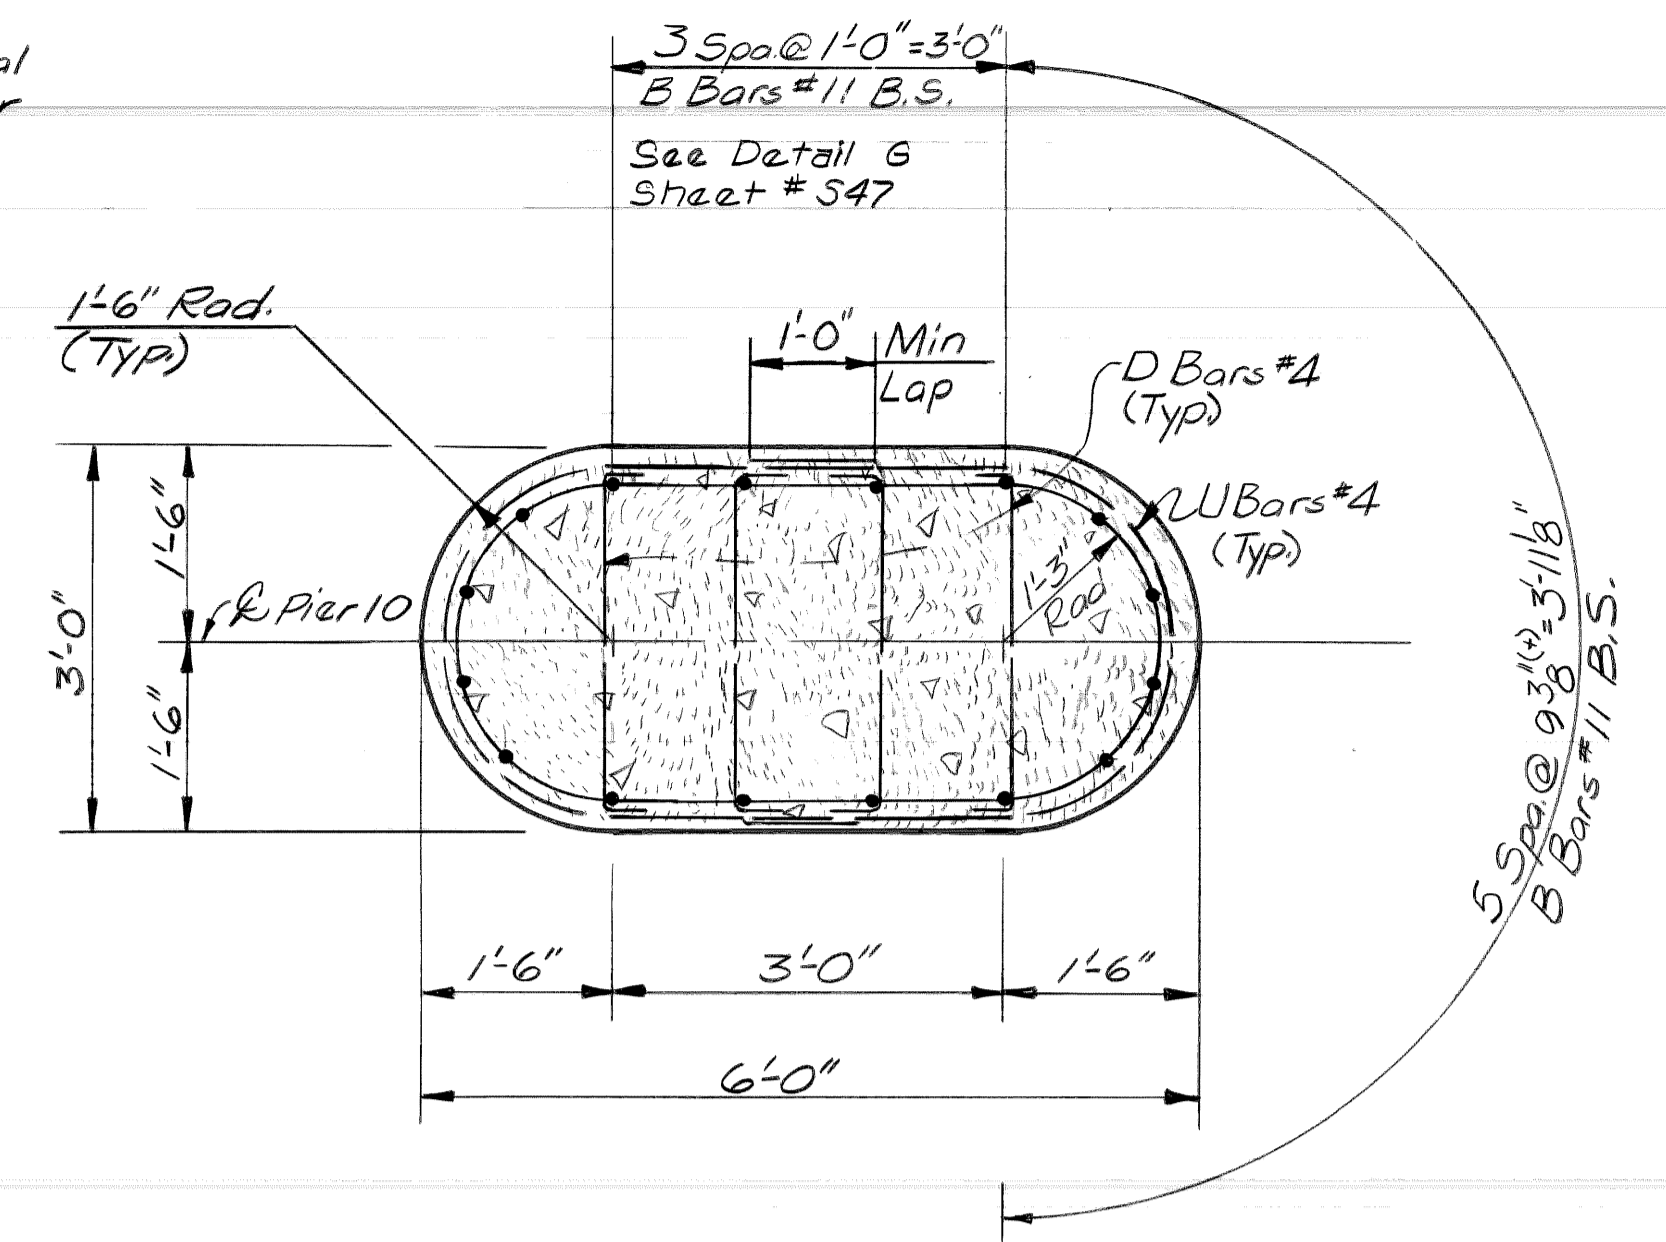

SECTION B-B

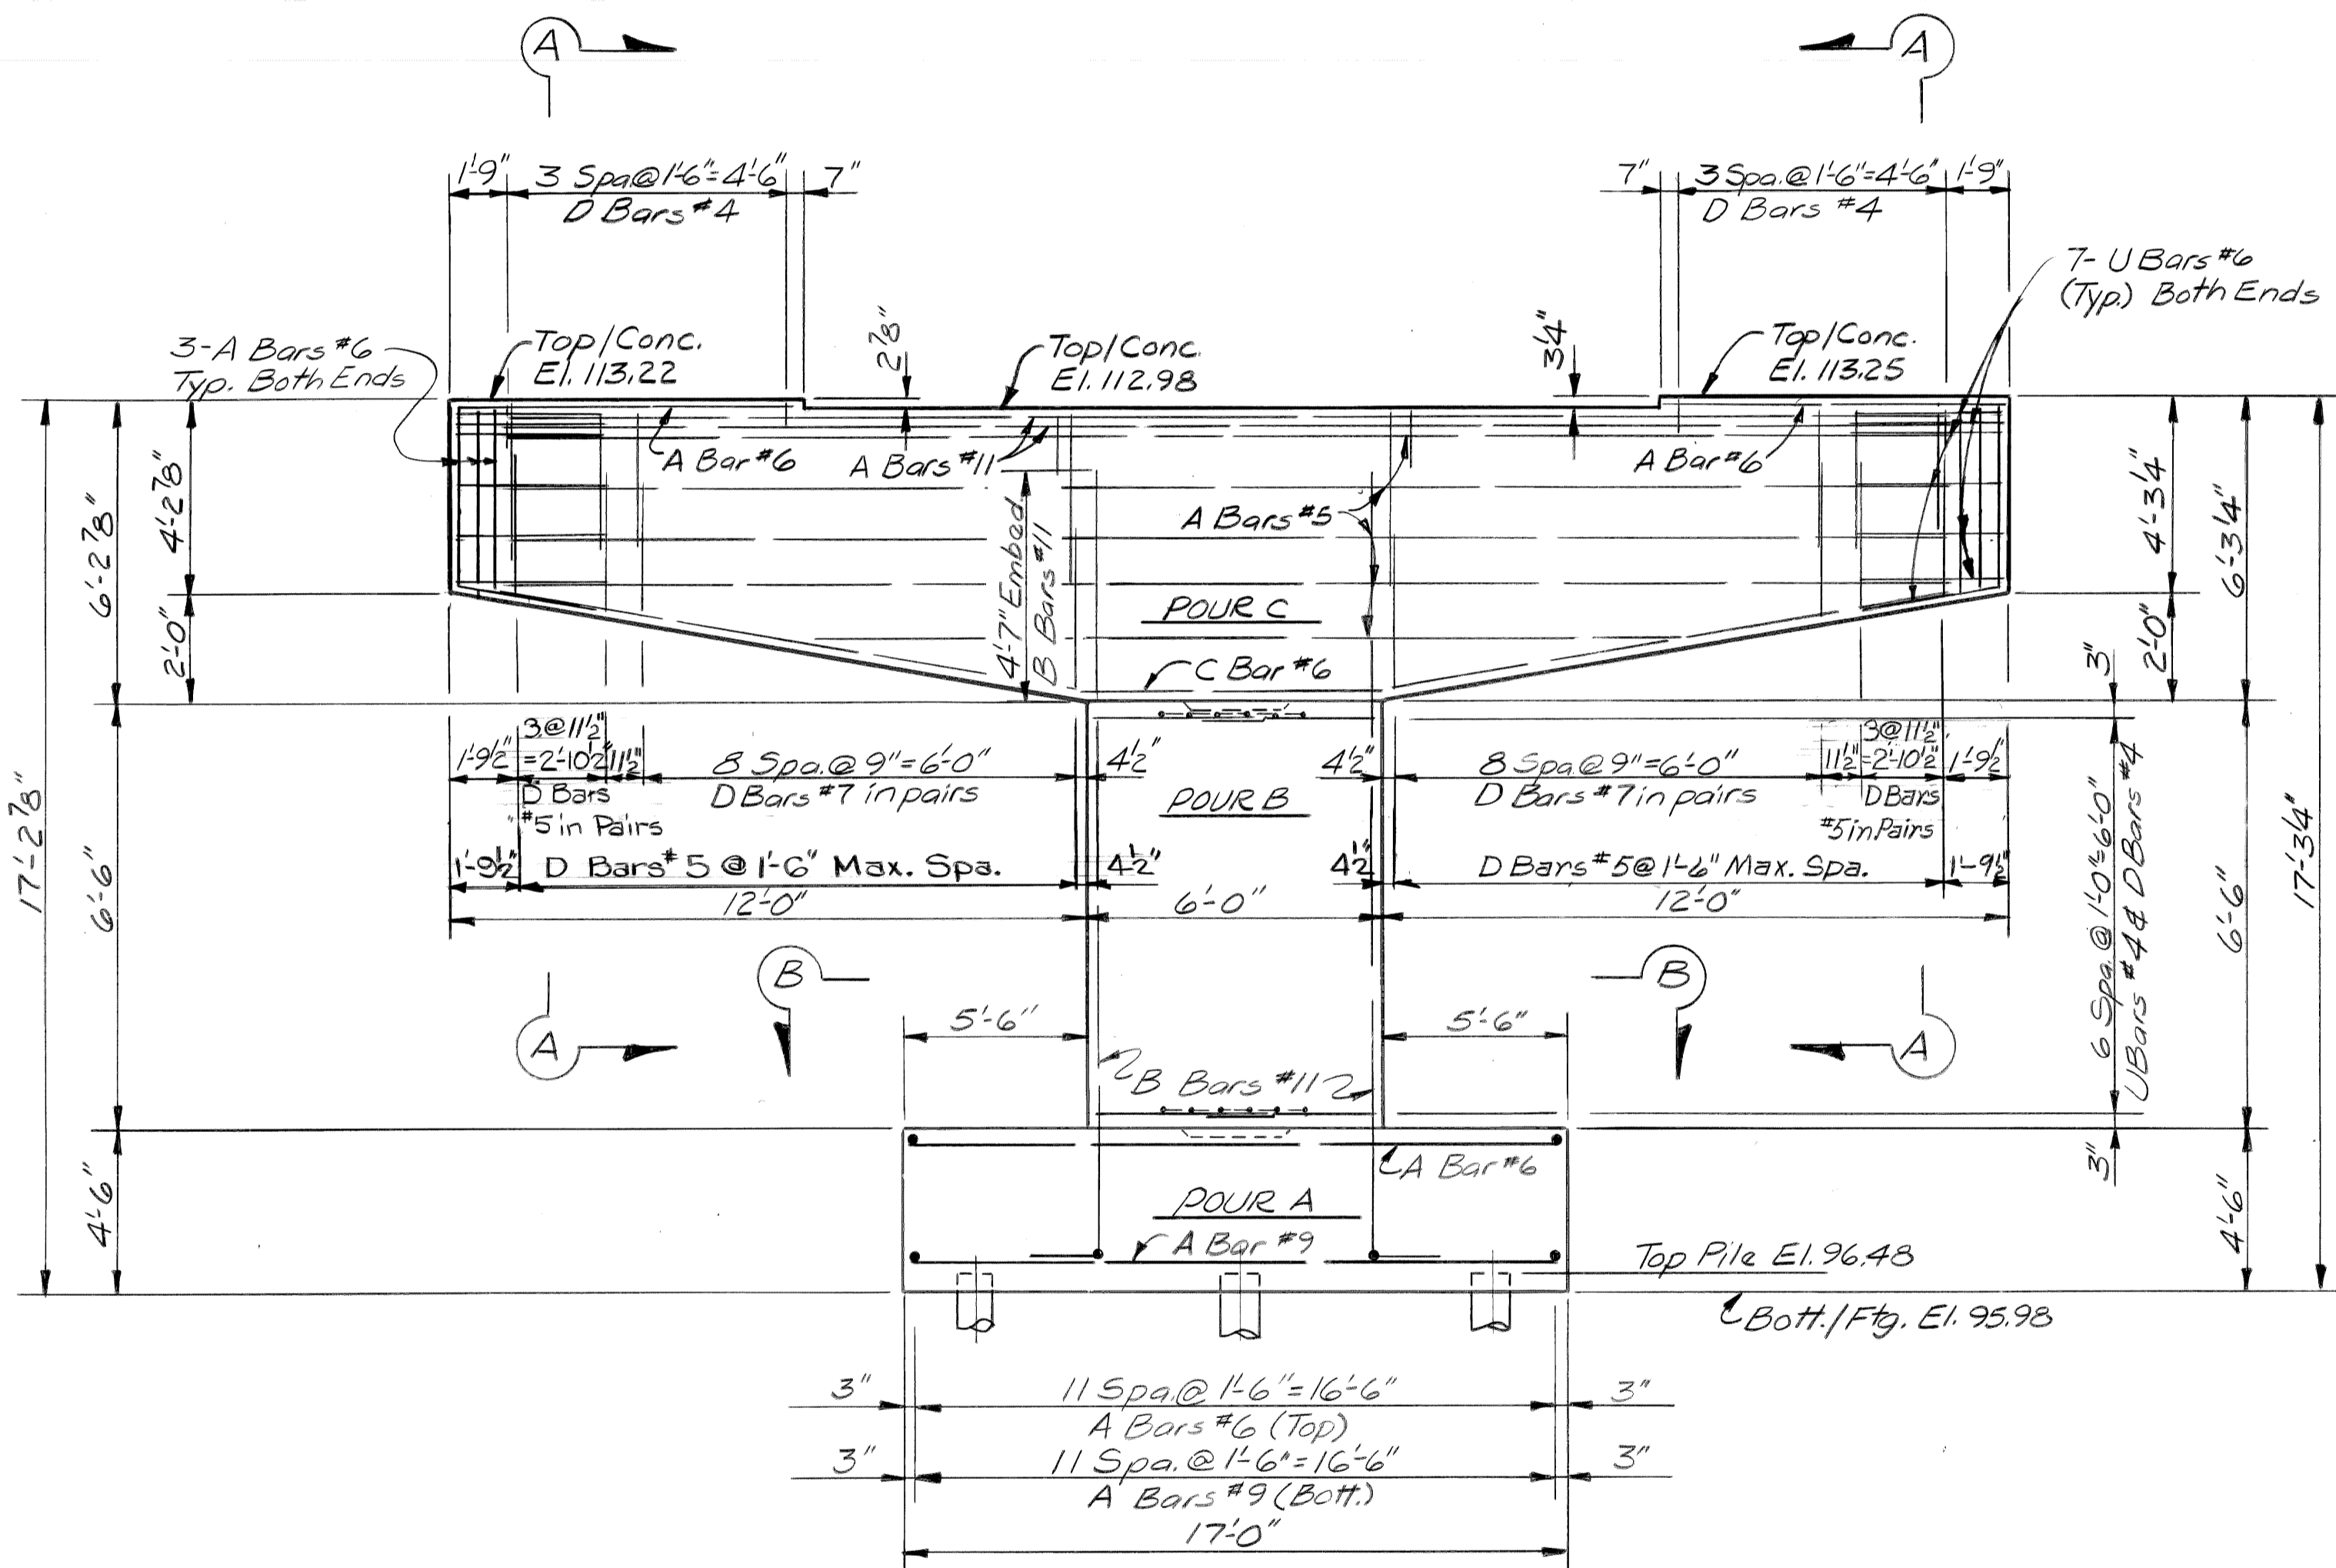

ELEVATION

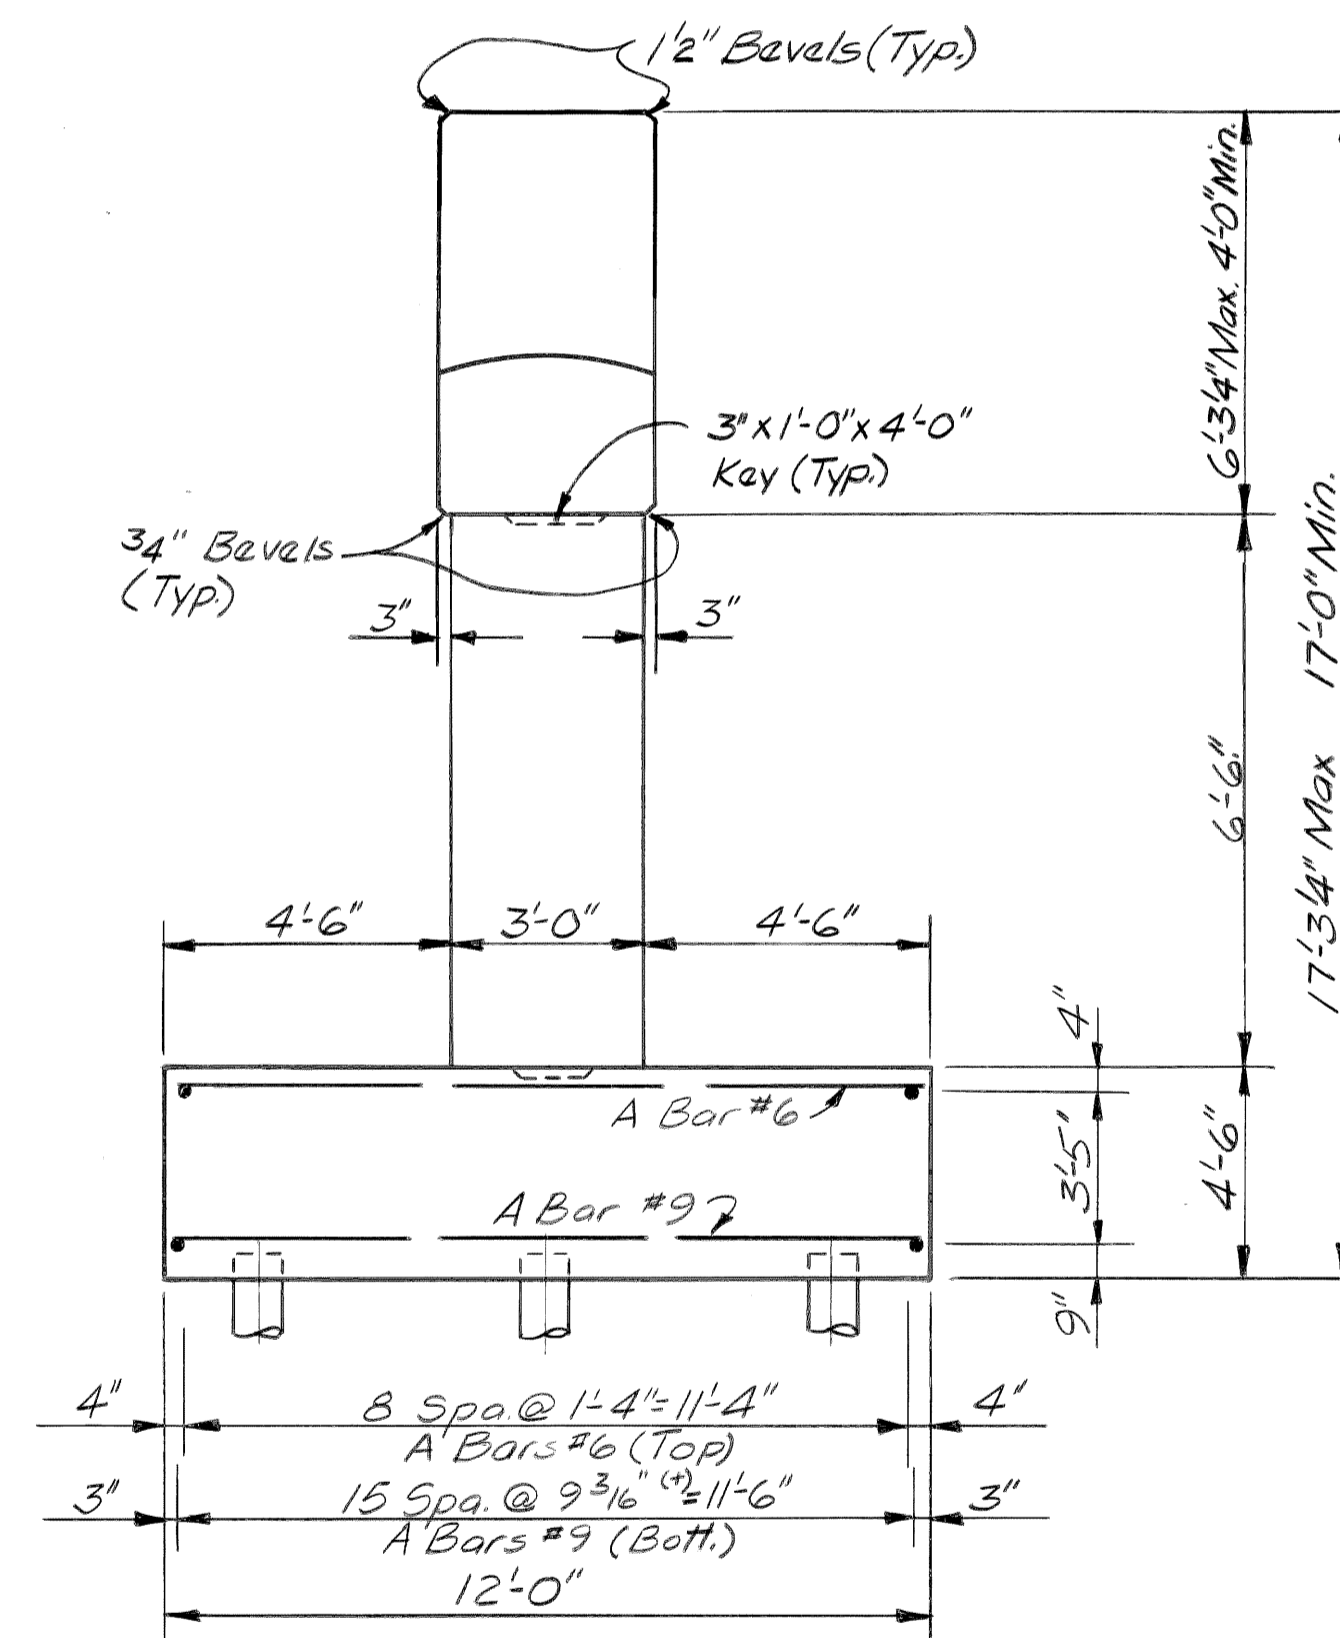


END VIEW

DSGN BY:	RGW, MH
DRN BY:	MH
CK'D BY:	RGW
APP'D BY:	

REVISIONS	

CITY OF DETROIT, MICHIGAN







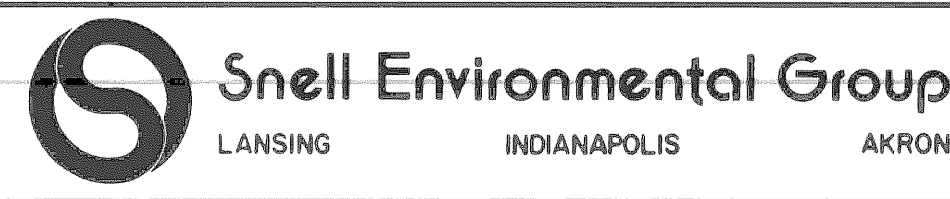




Work This Sheet With Sheets # S34 thru S43, S45, thru S48
 JOHN C. LODGE EXIT RAMP AND JEFFERSON AVENUE-
 RECONSTRUCTION AT THE JOE LOUIS ARENA

PIER DETAILS
 PIER 10


DATE: August, 1979

SCALE: NONE
 DRN. NO: S44

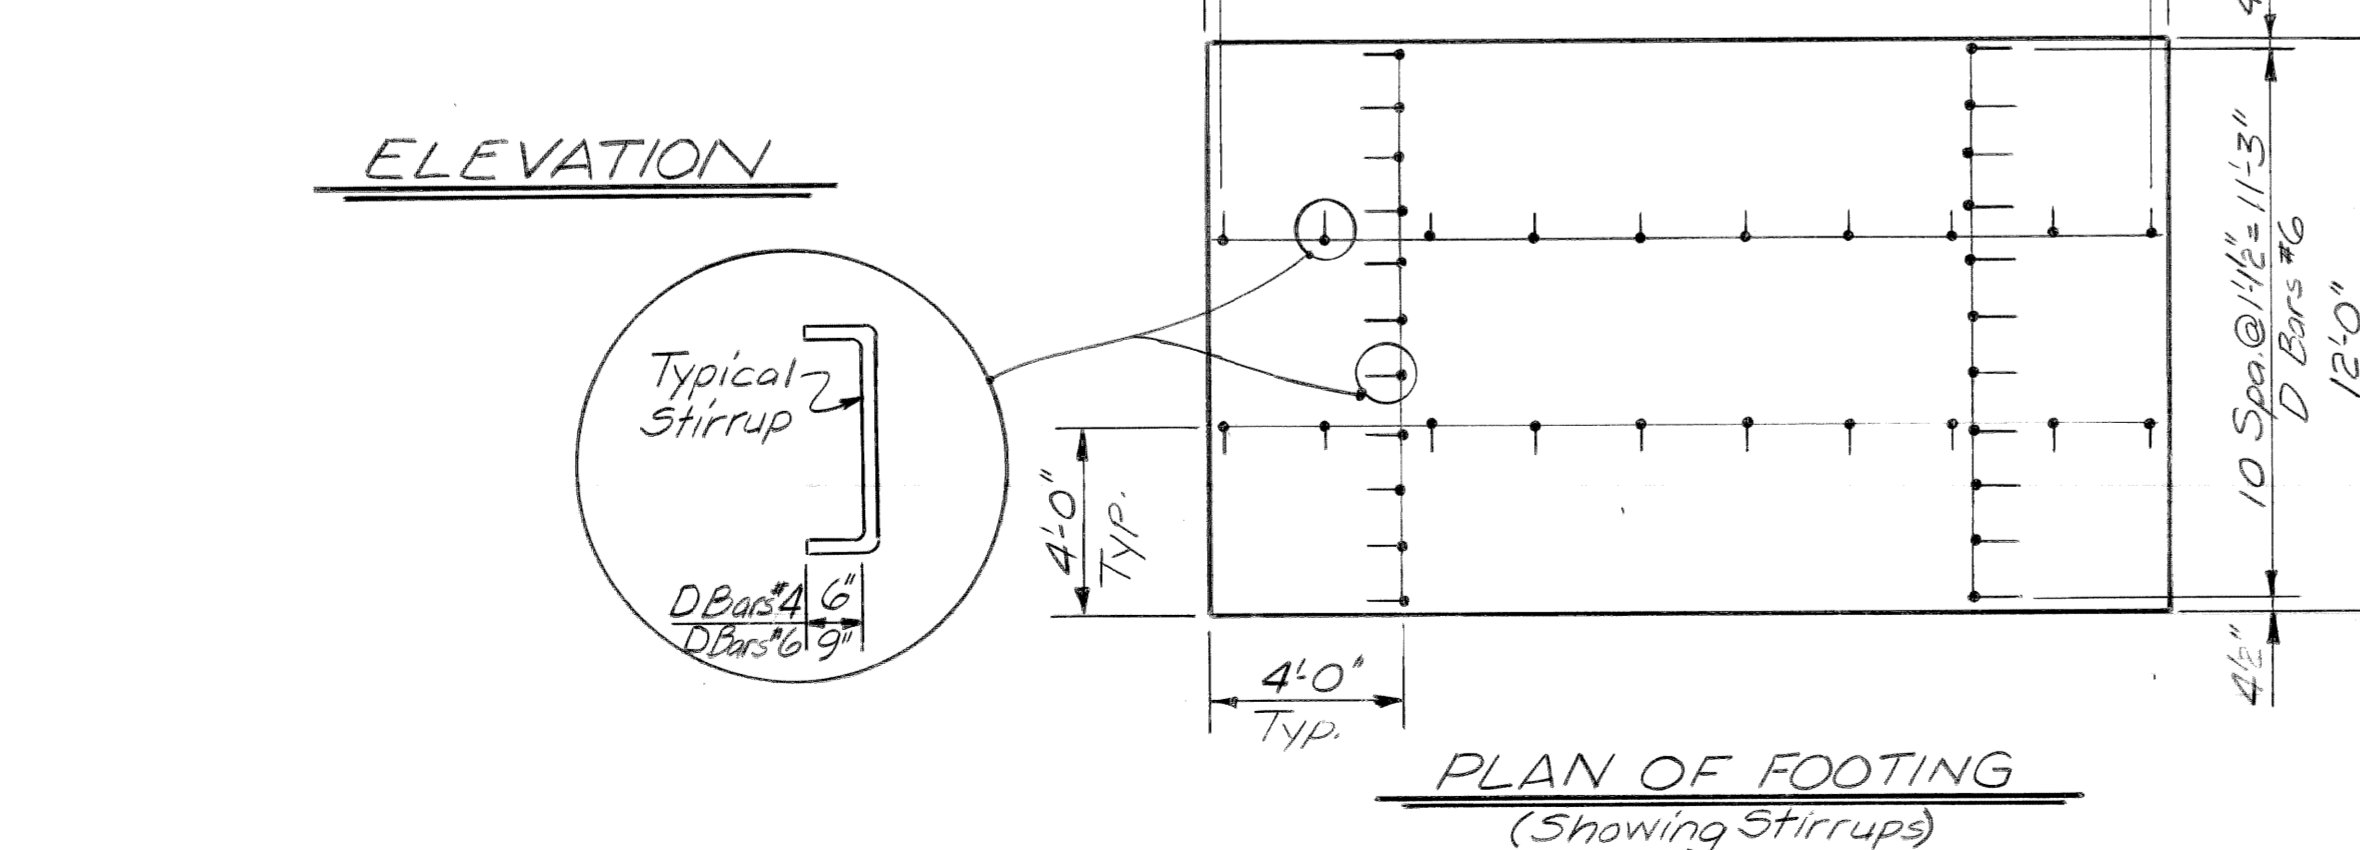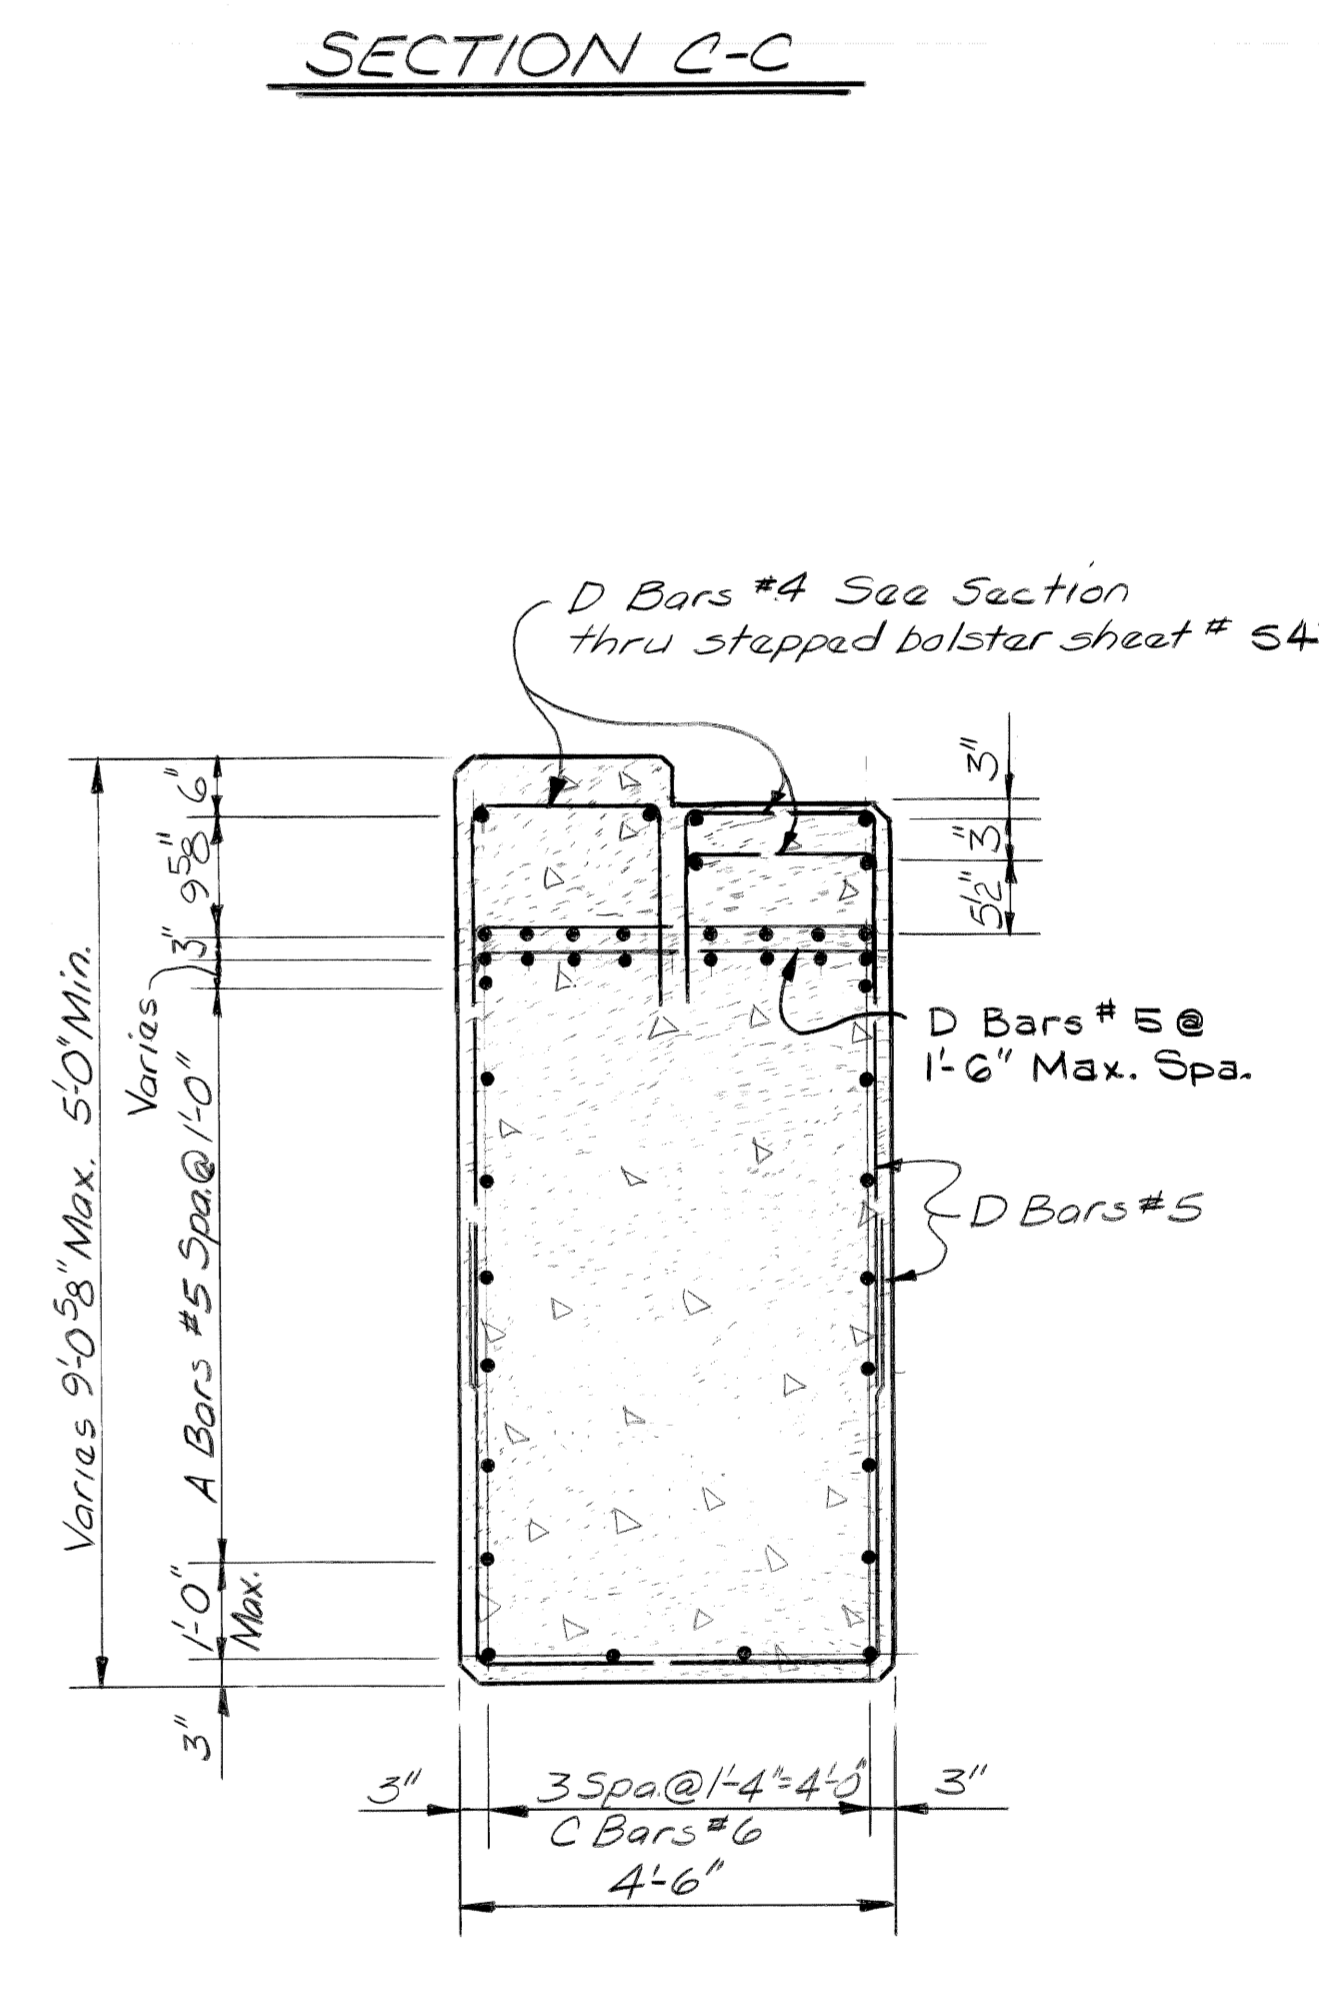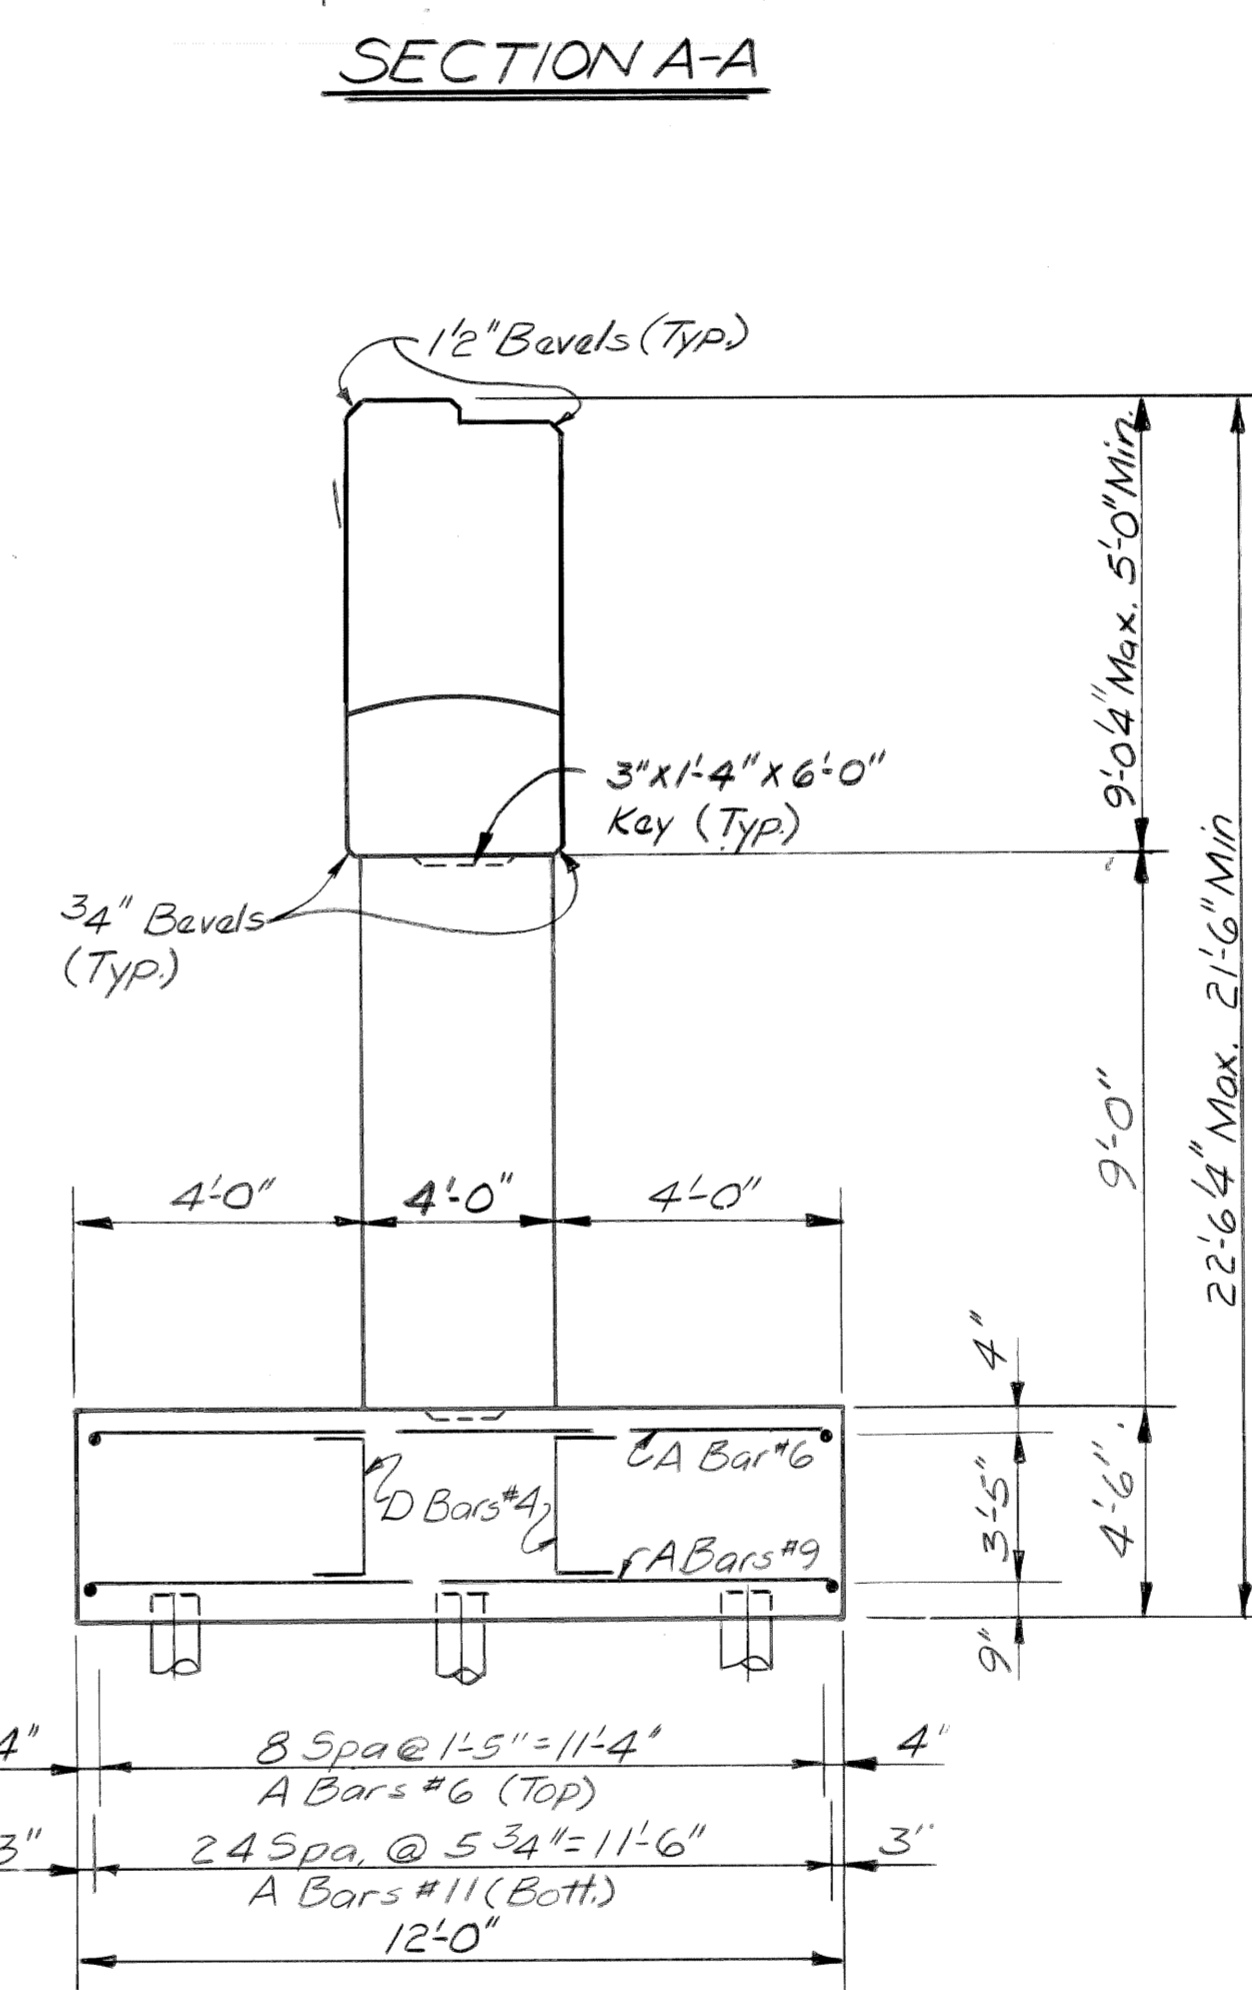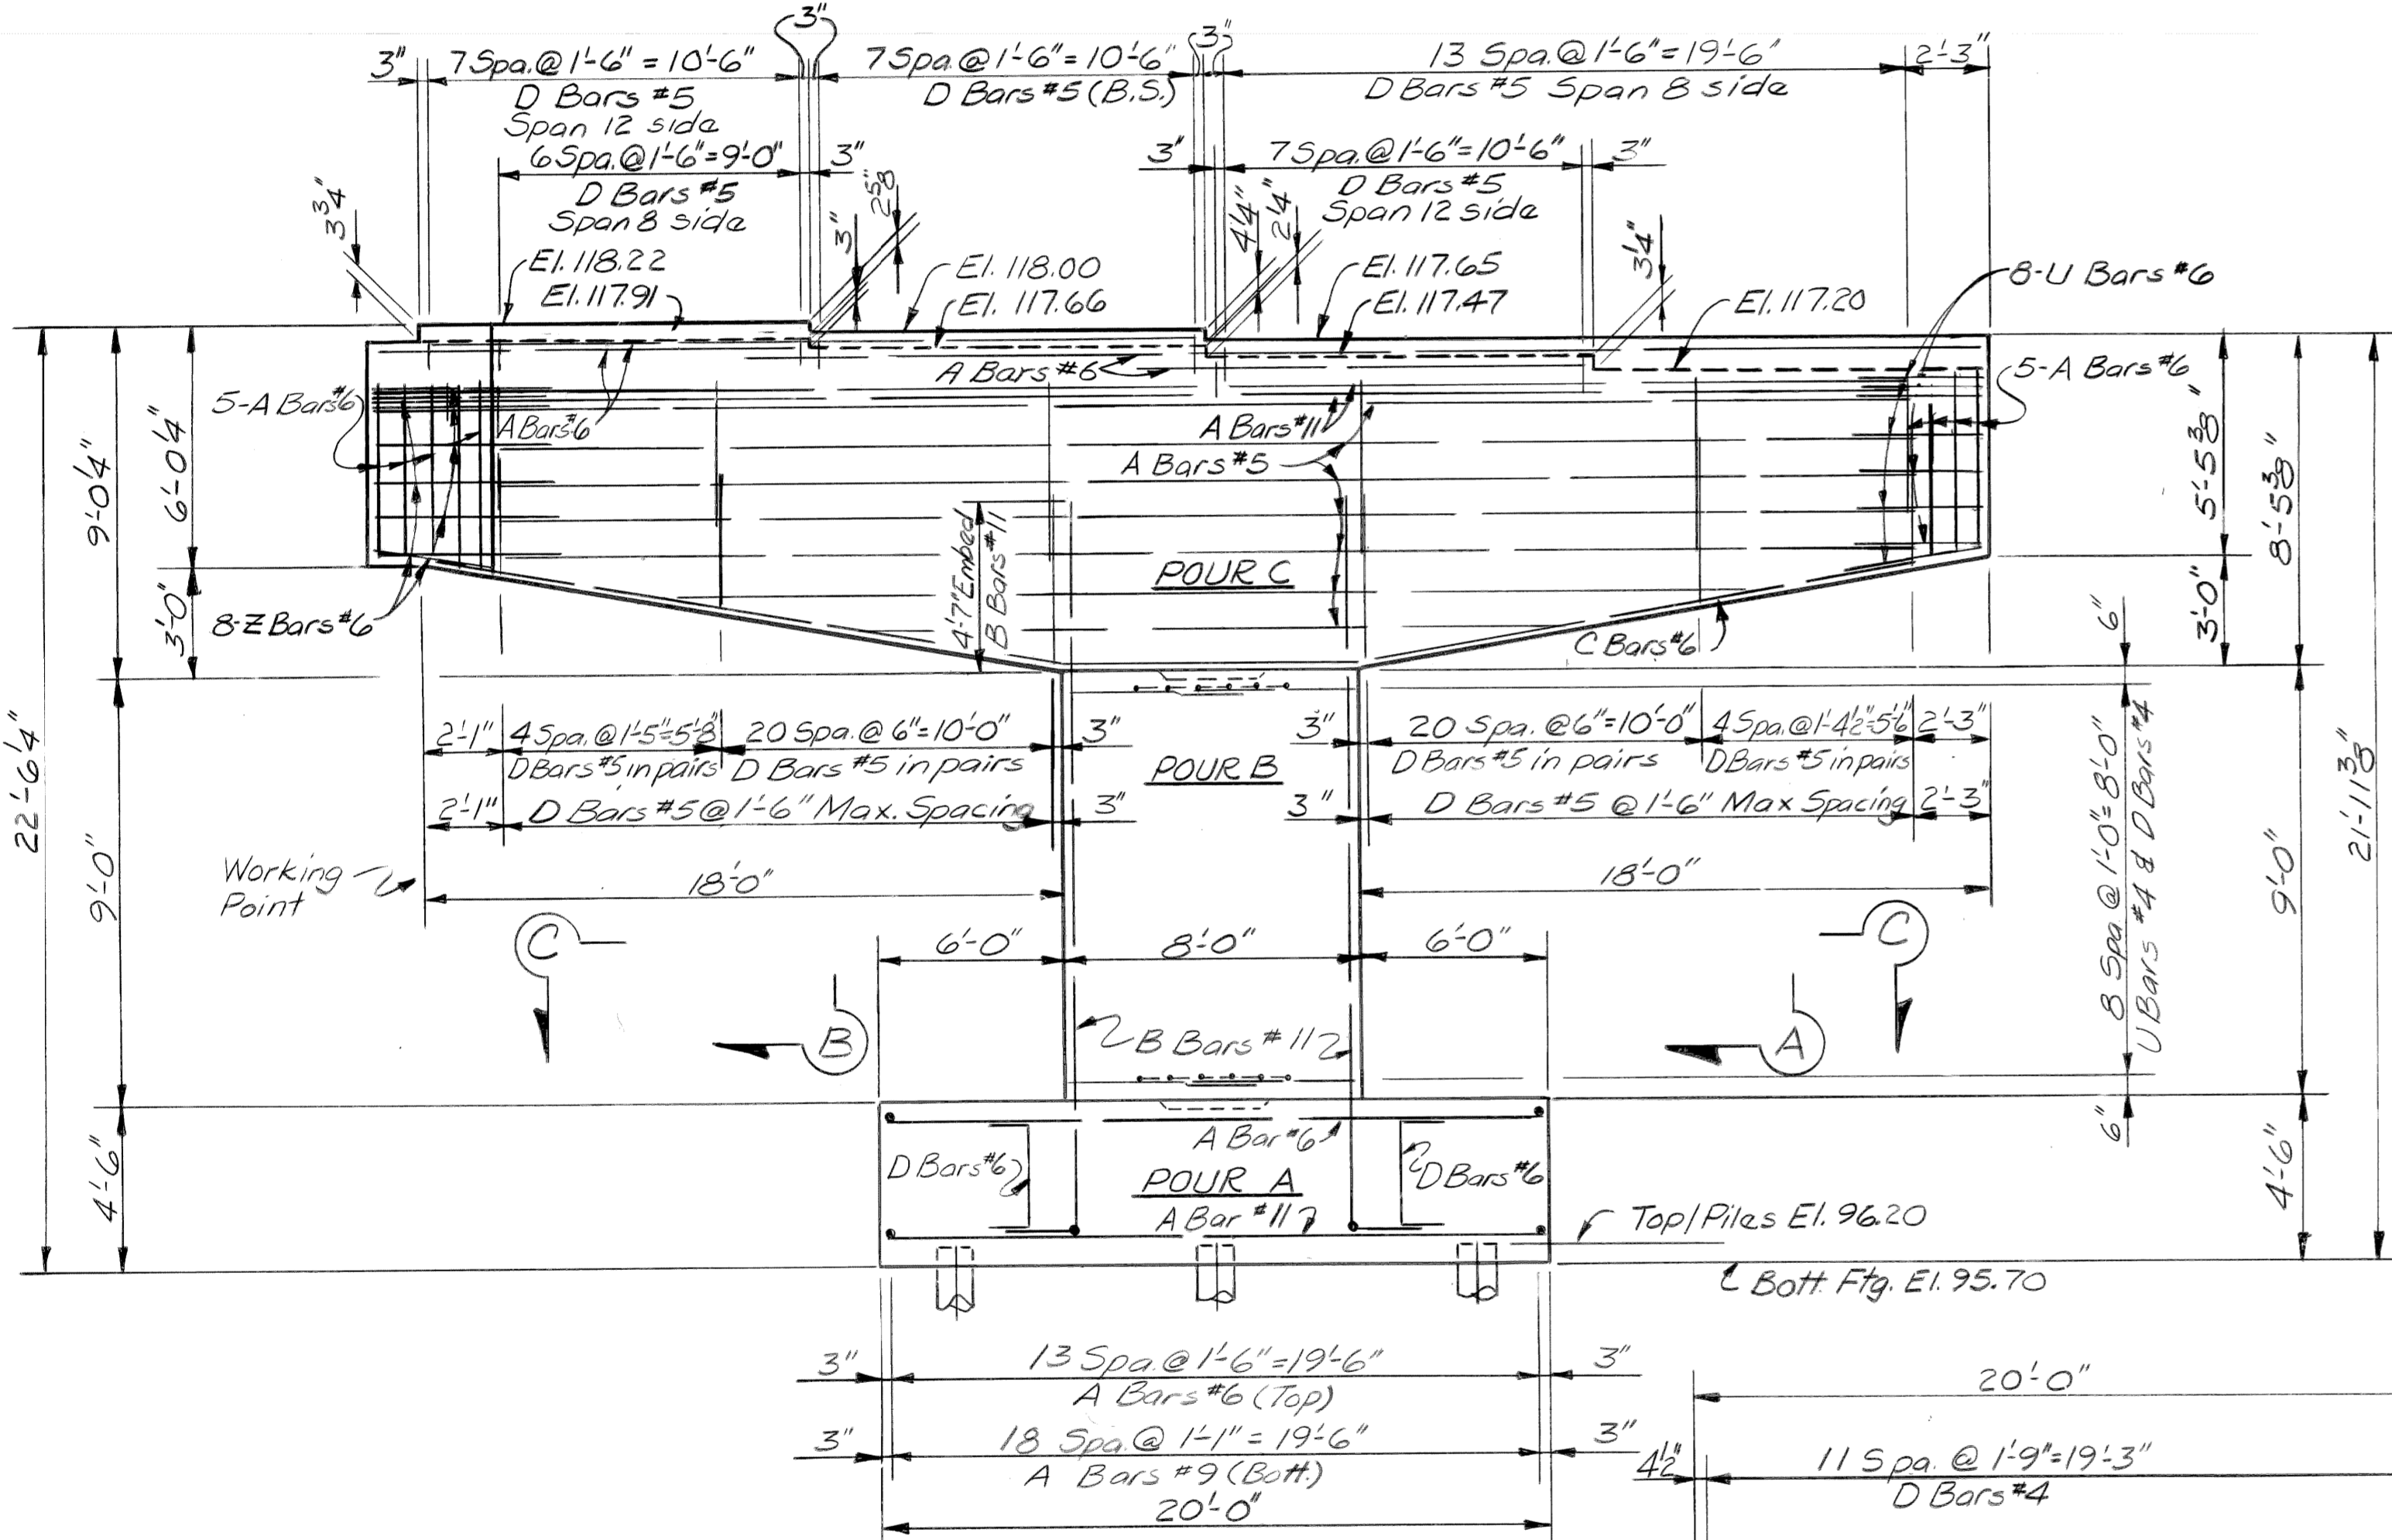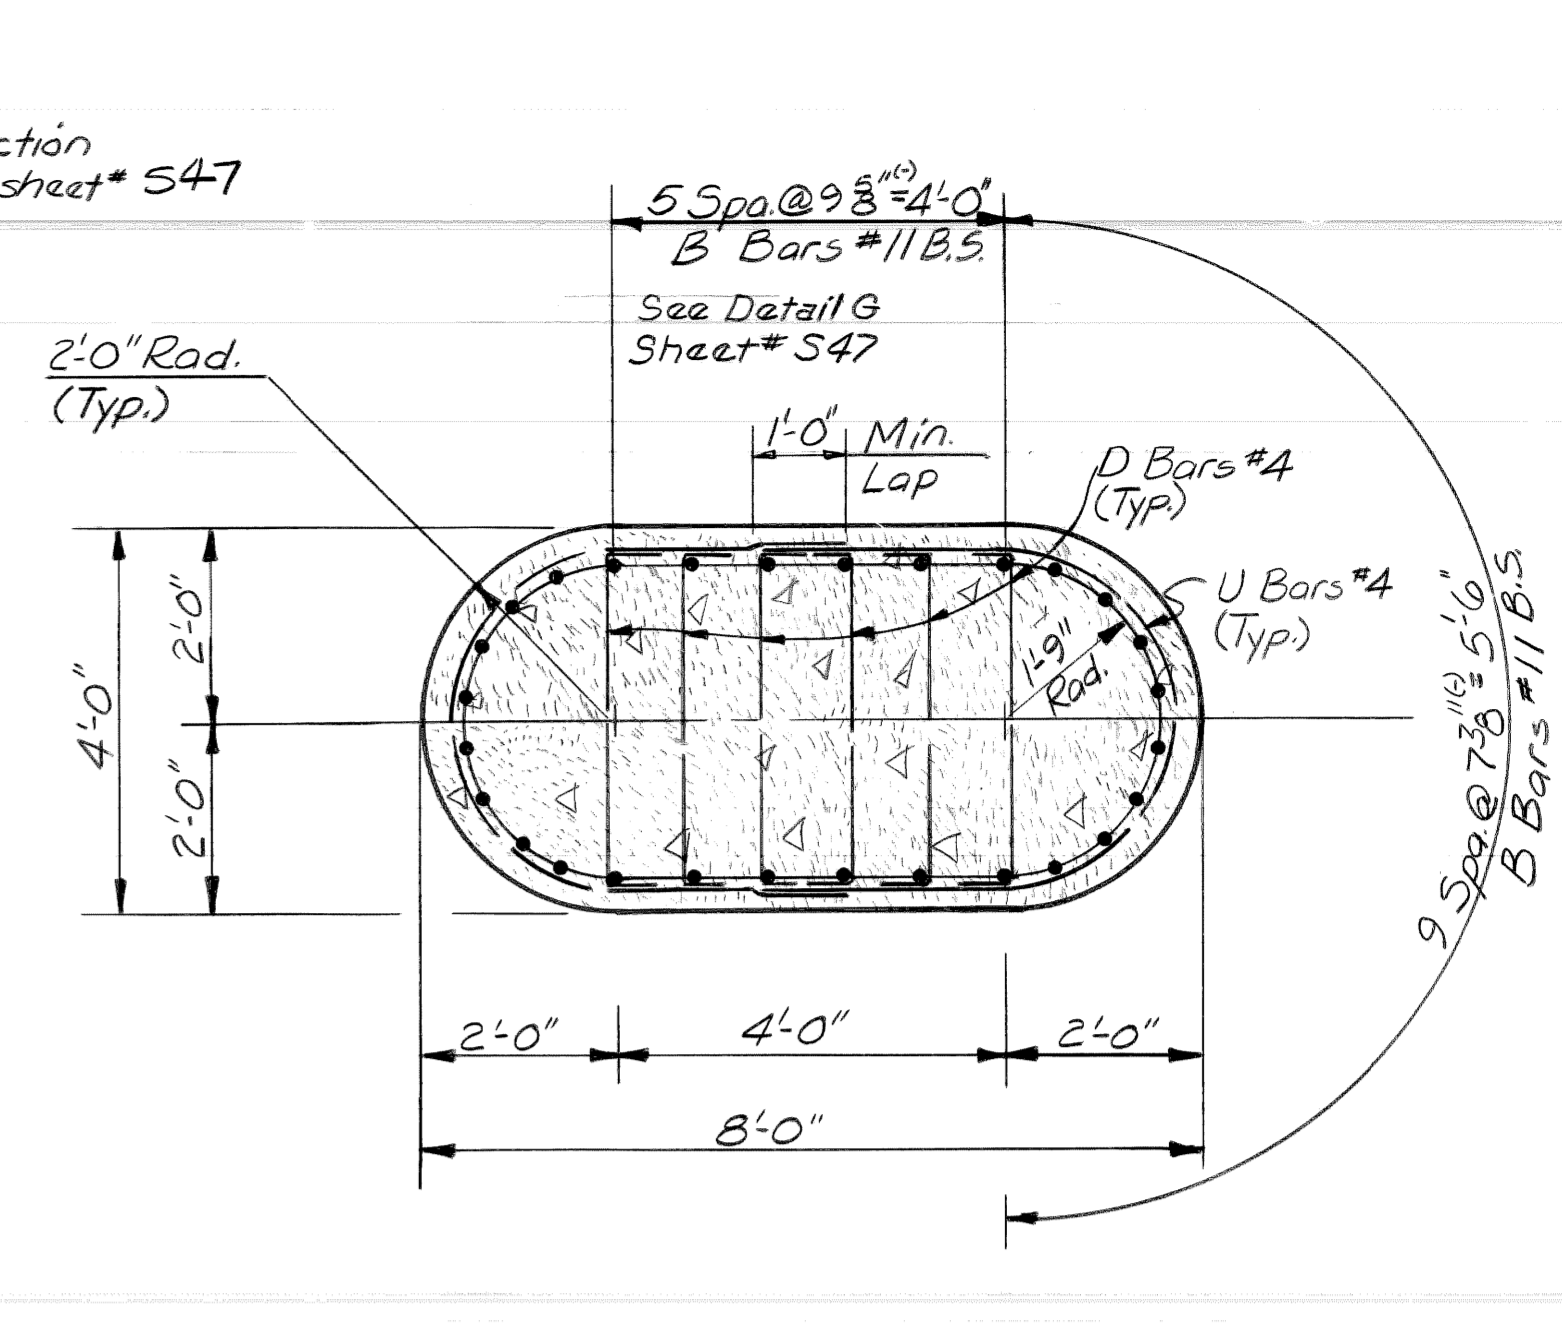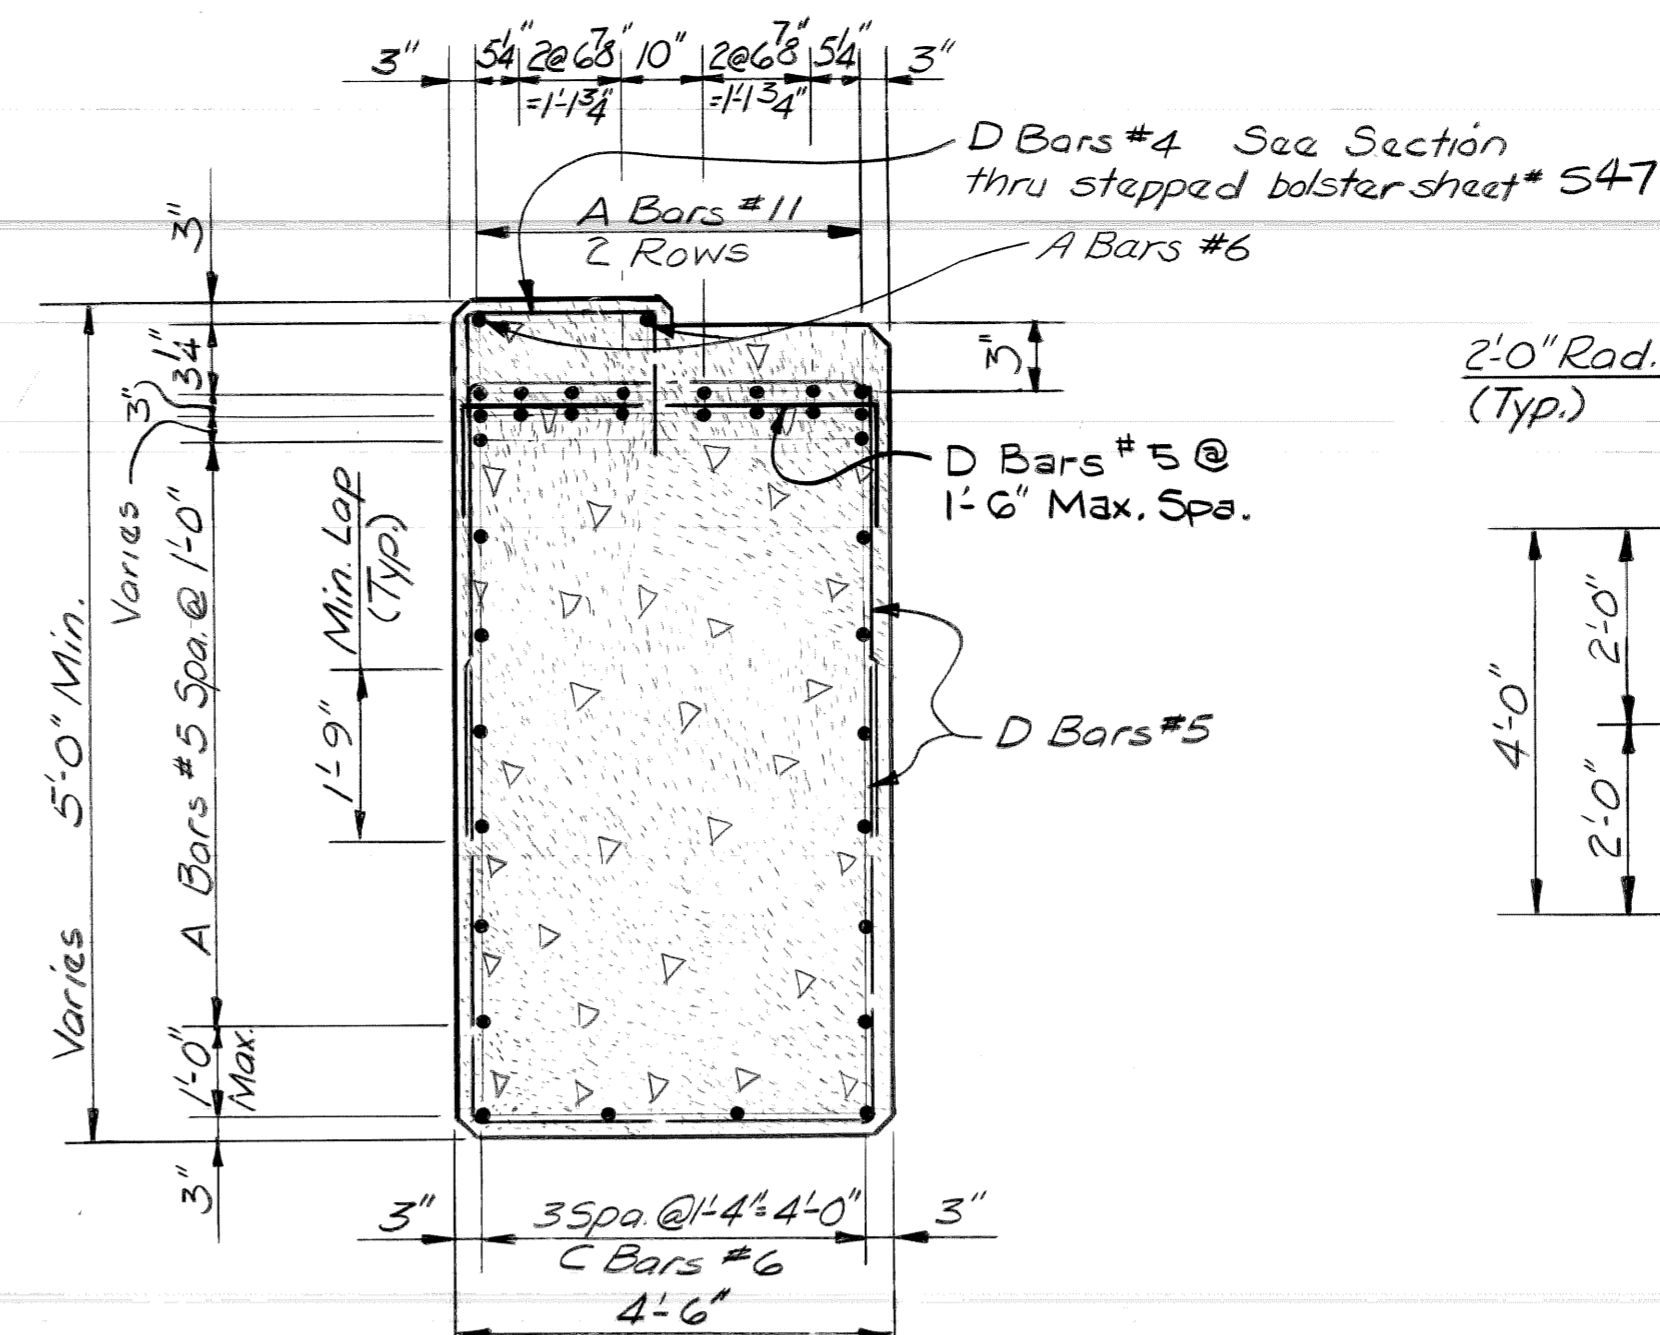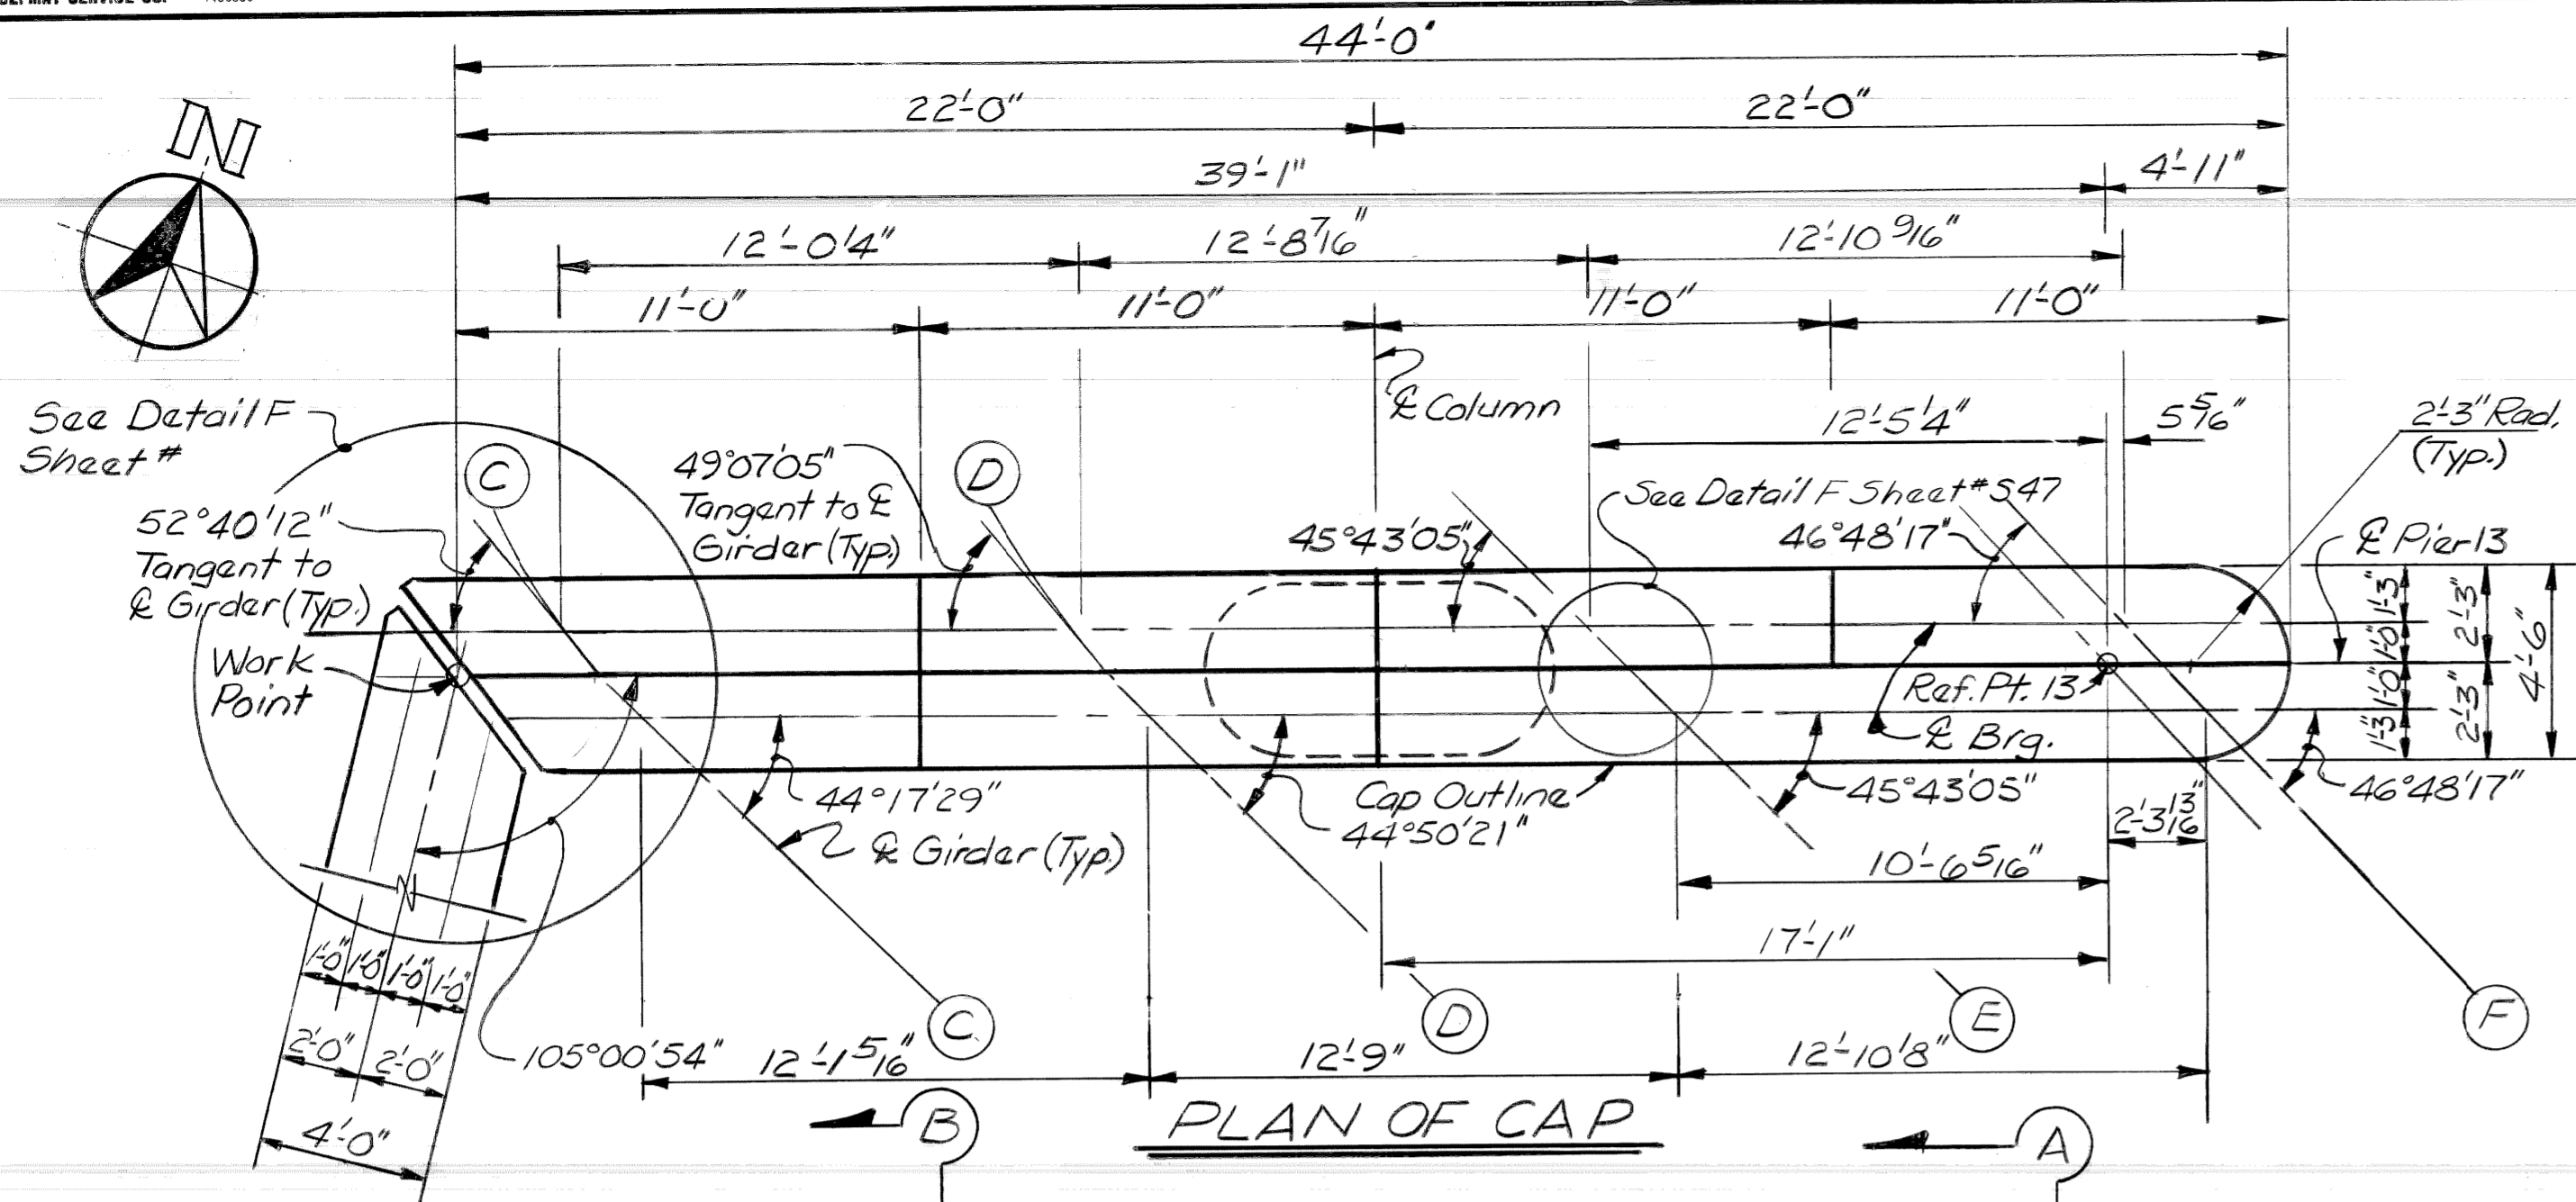


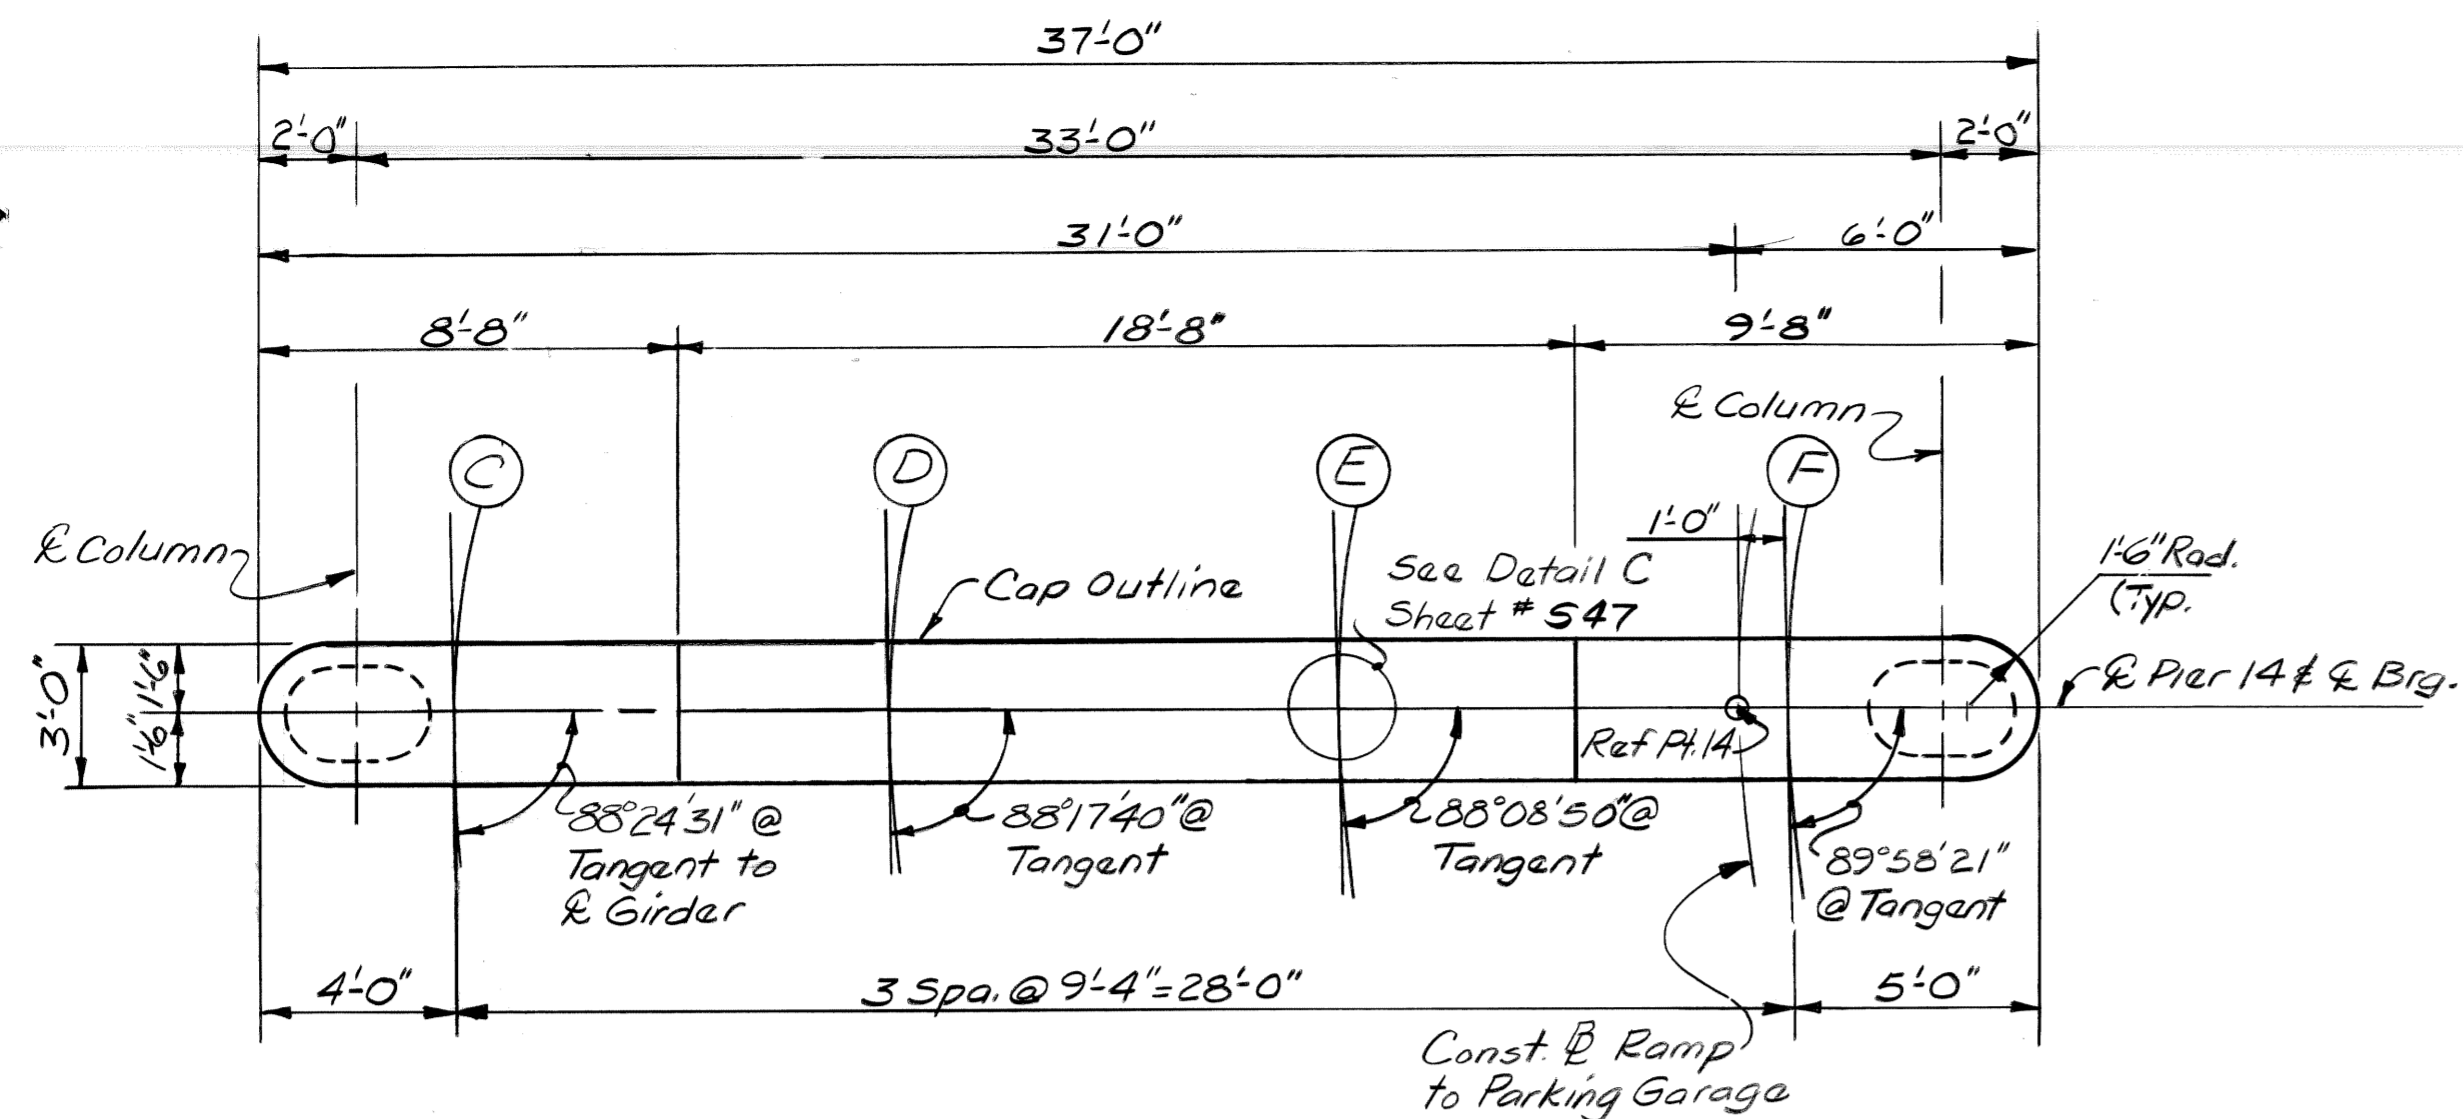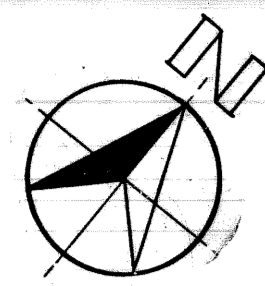


PLAN OF CAP

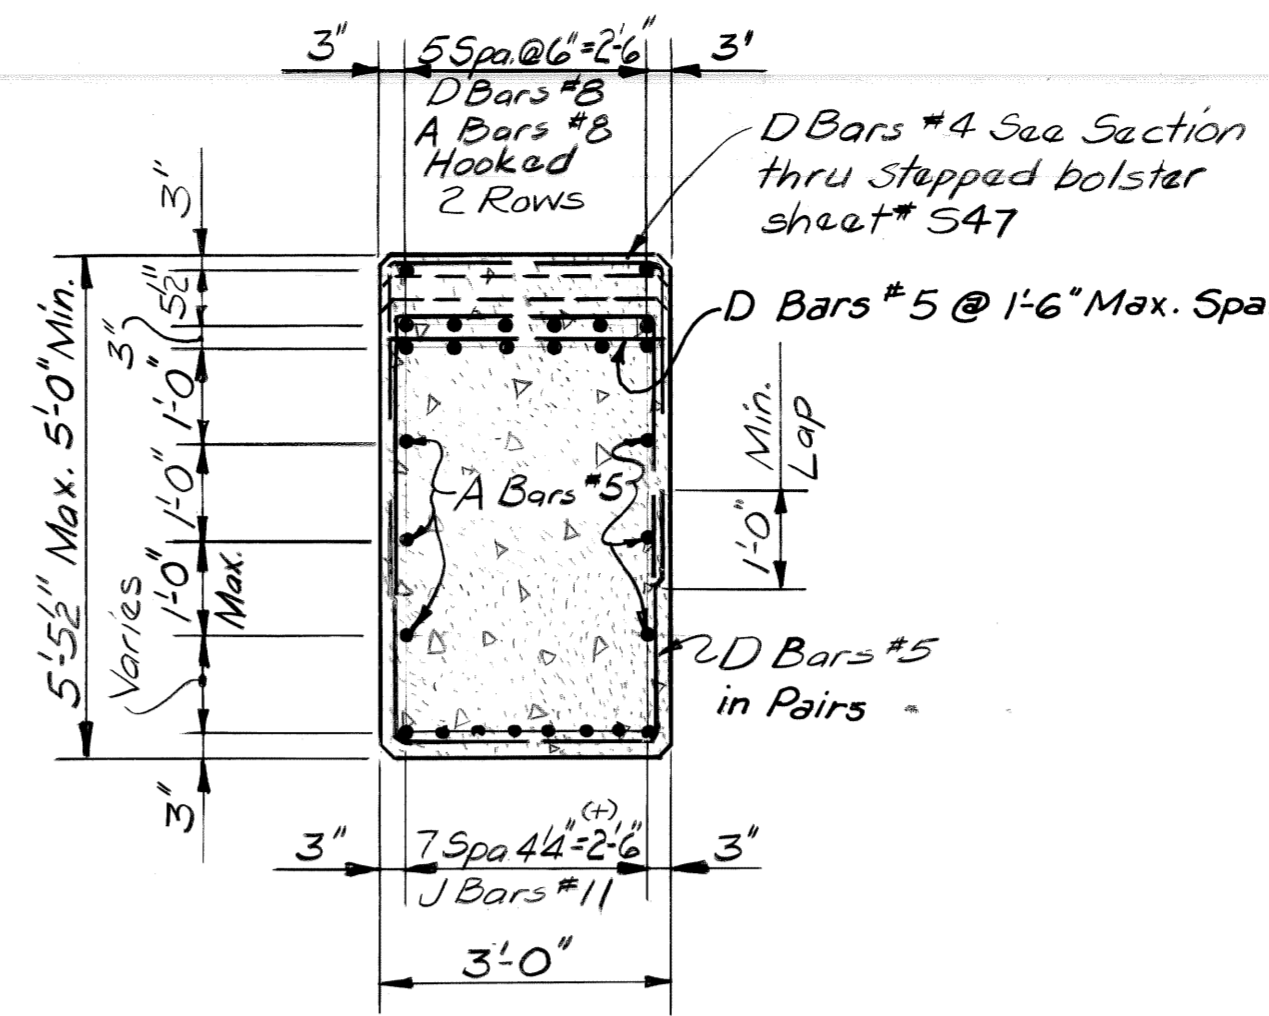



SECTION A-A

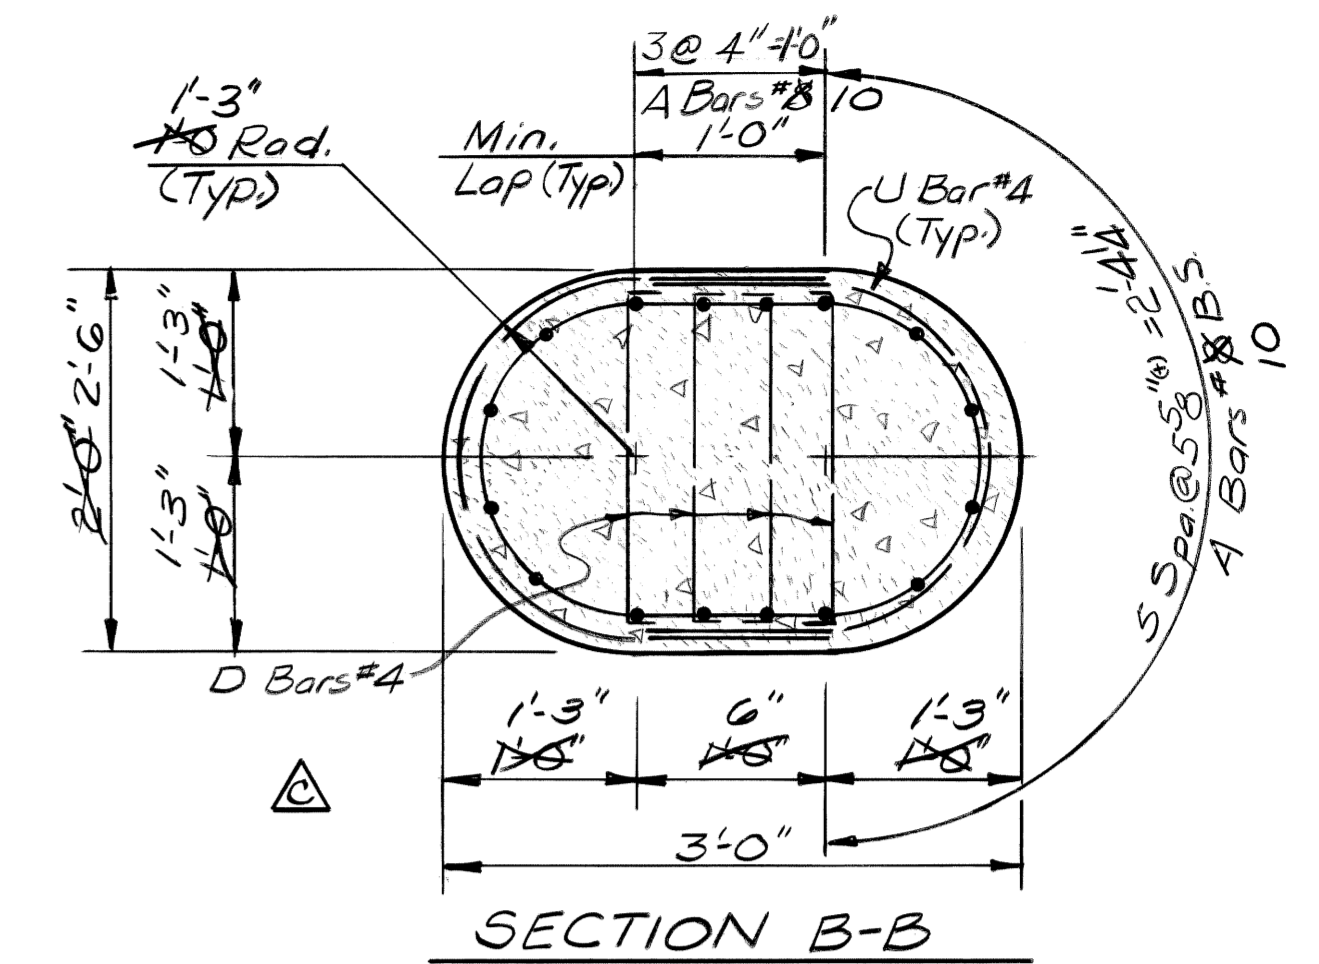


SECTION B-B

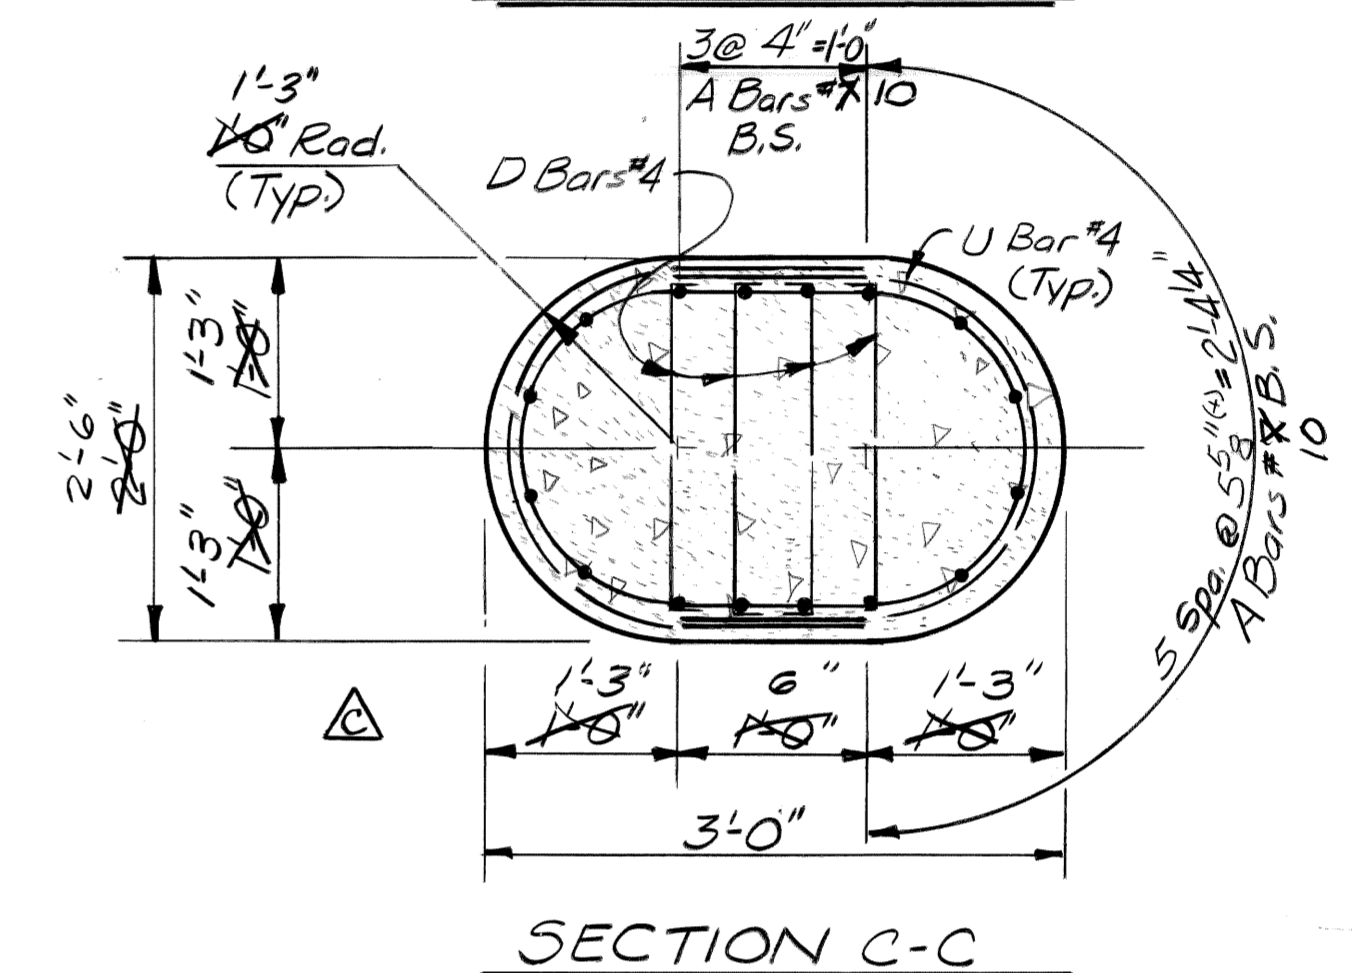


SECTION C-C

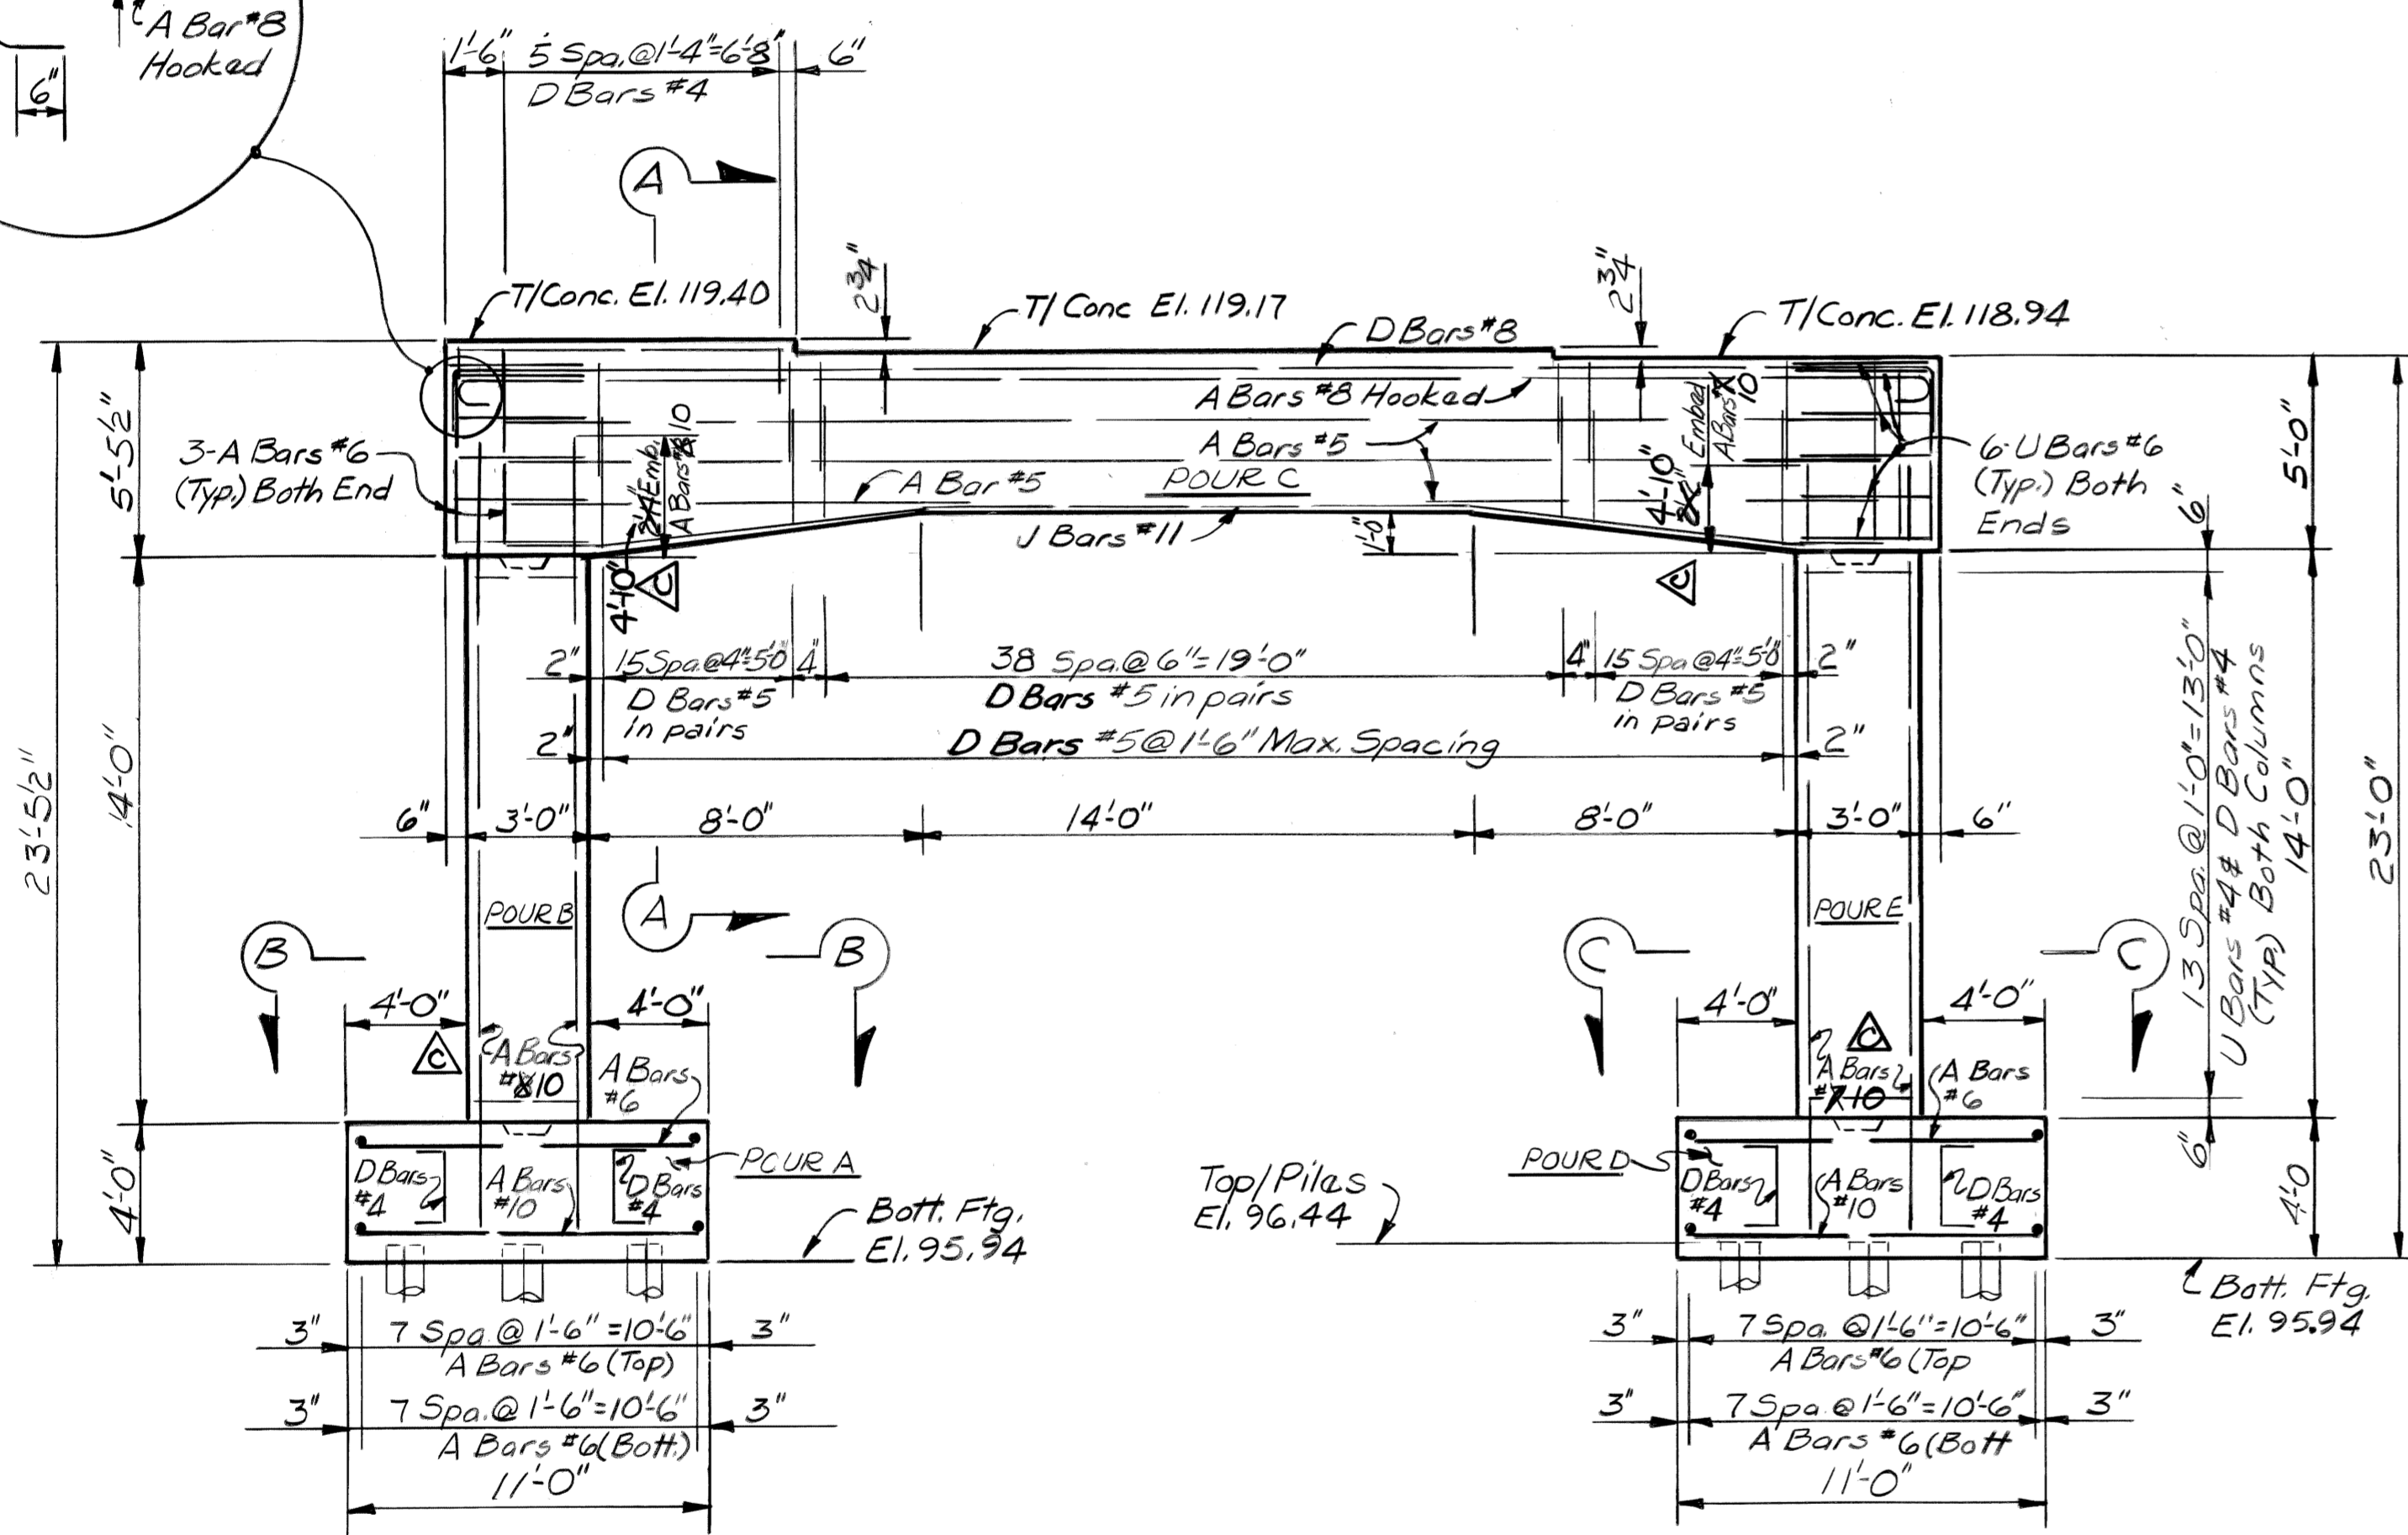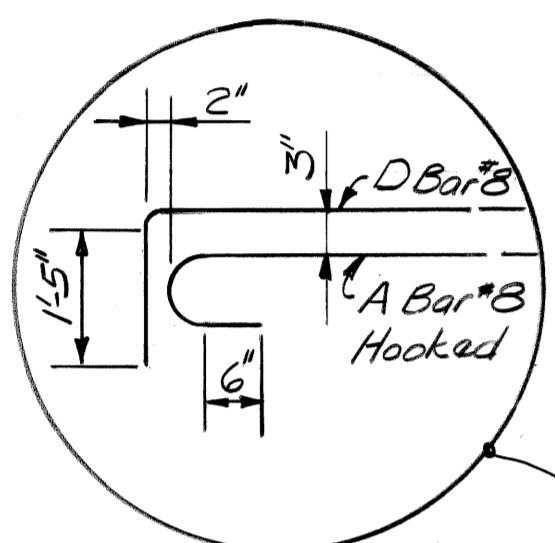


ELEVATION

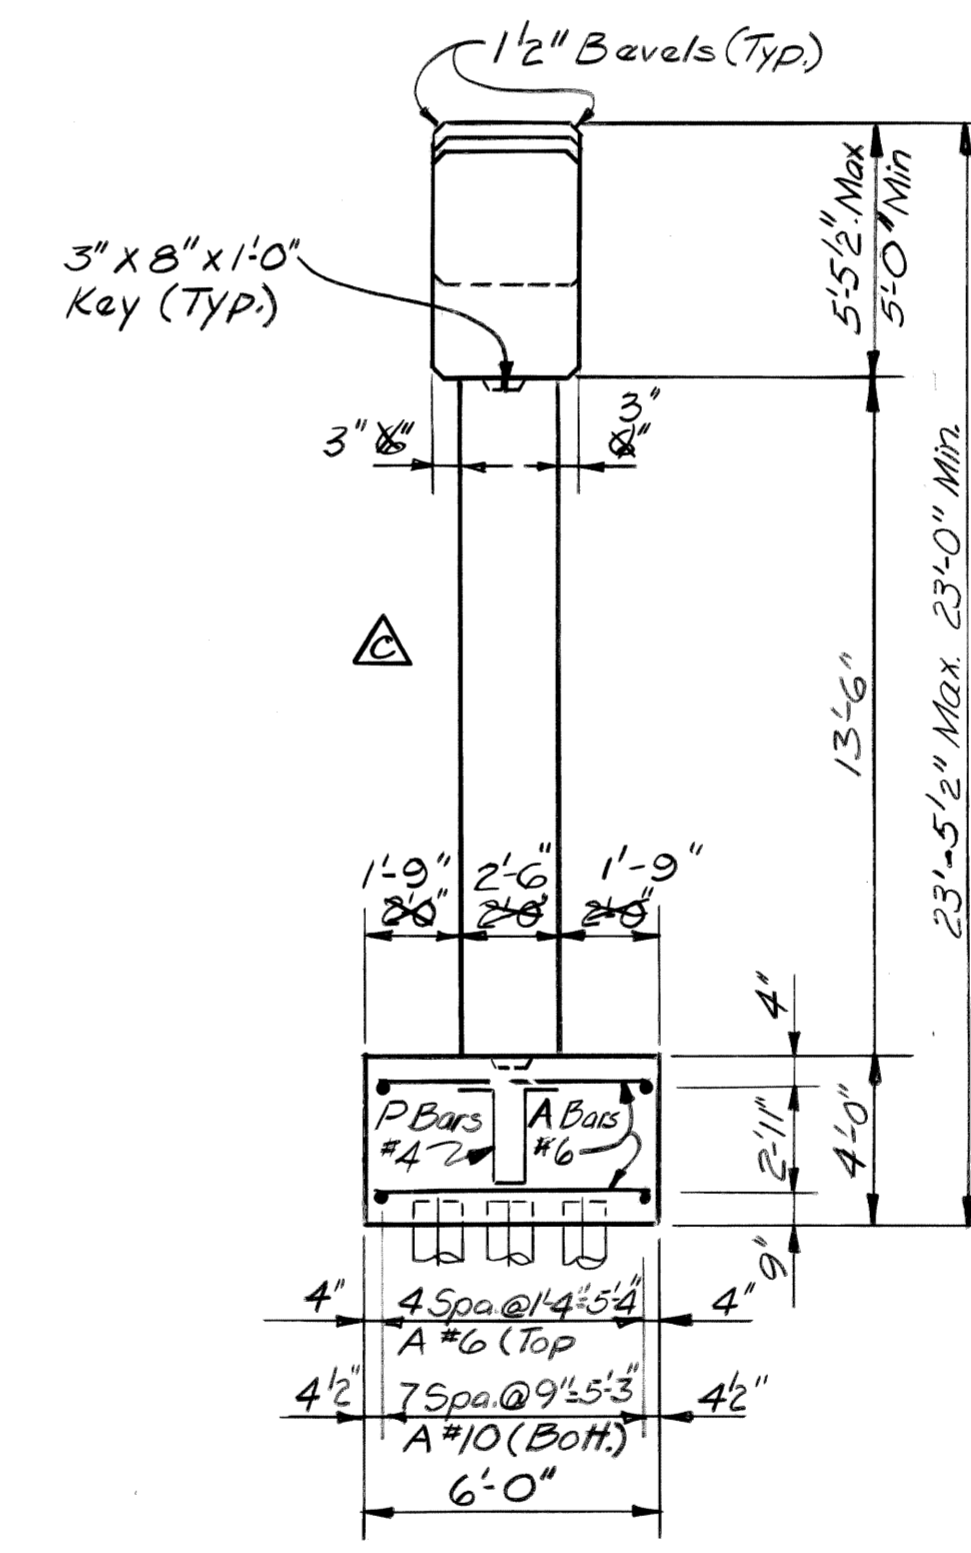

END VIEW

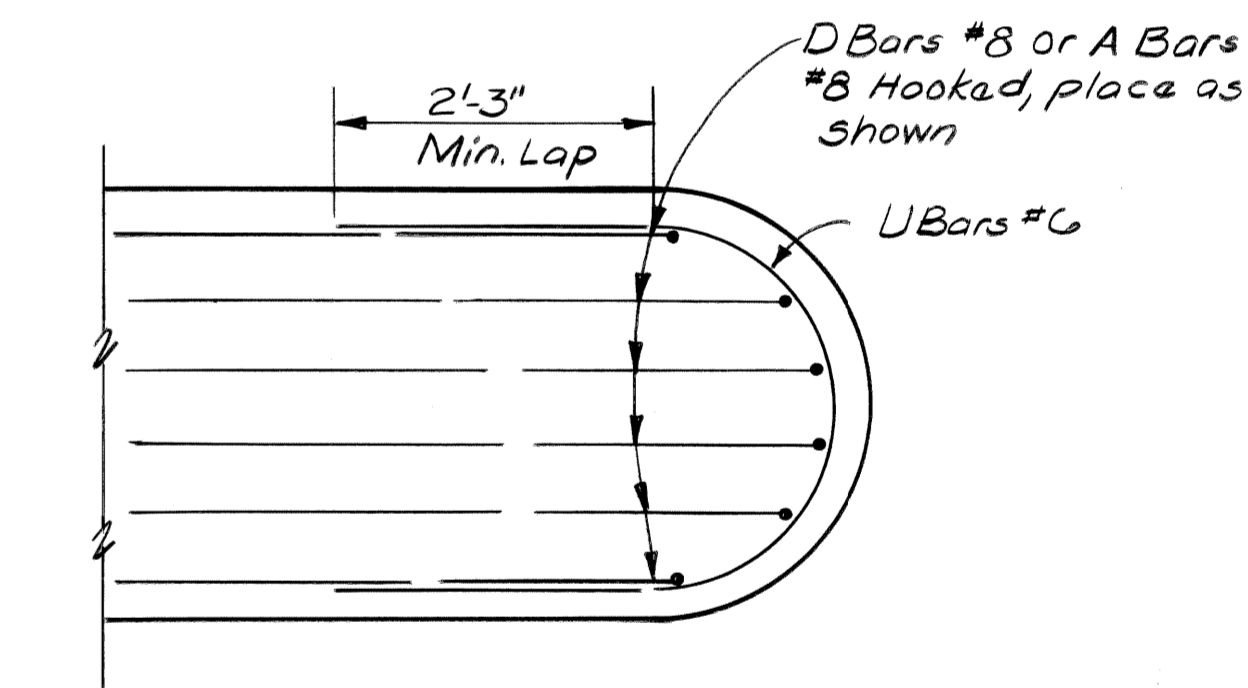

END CAP DETAIL

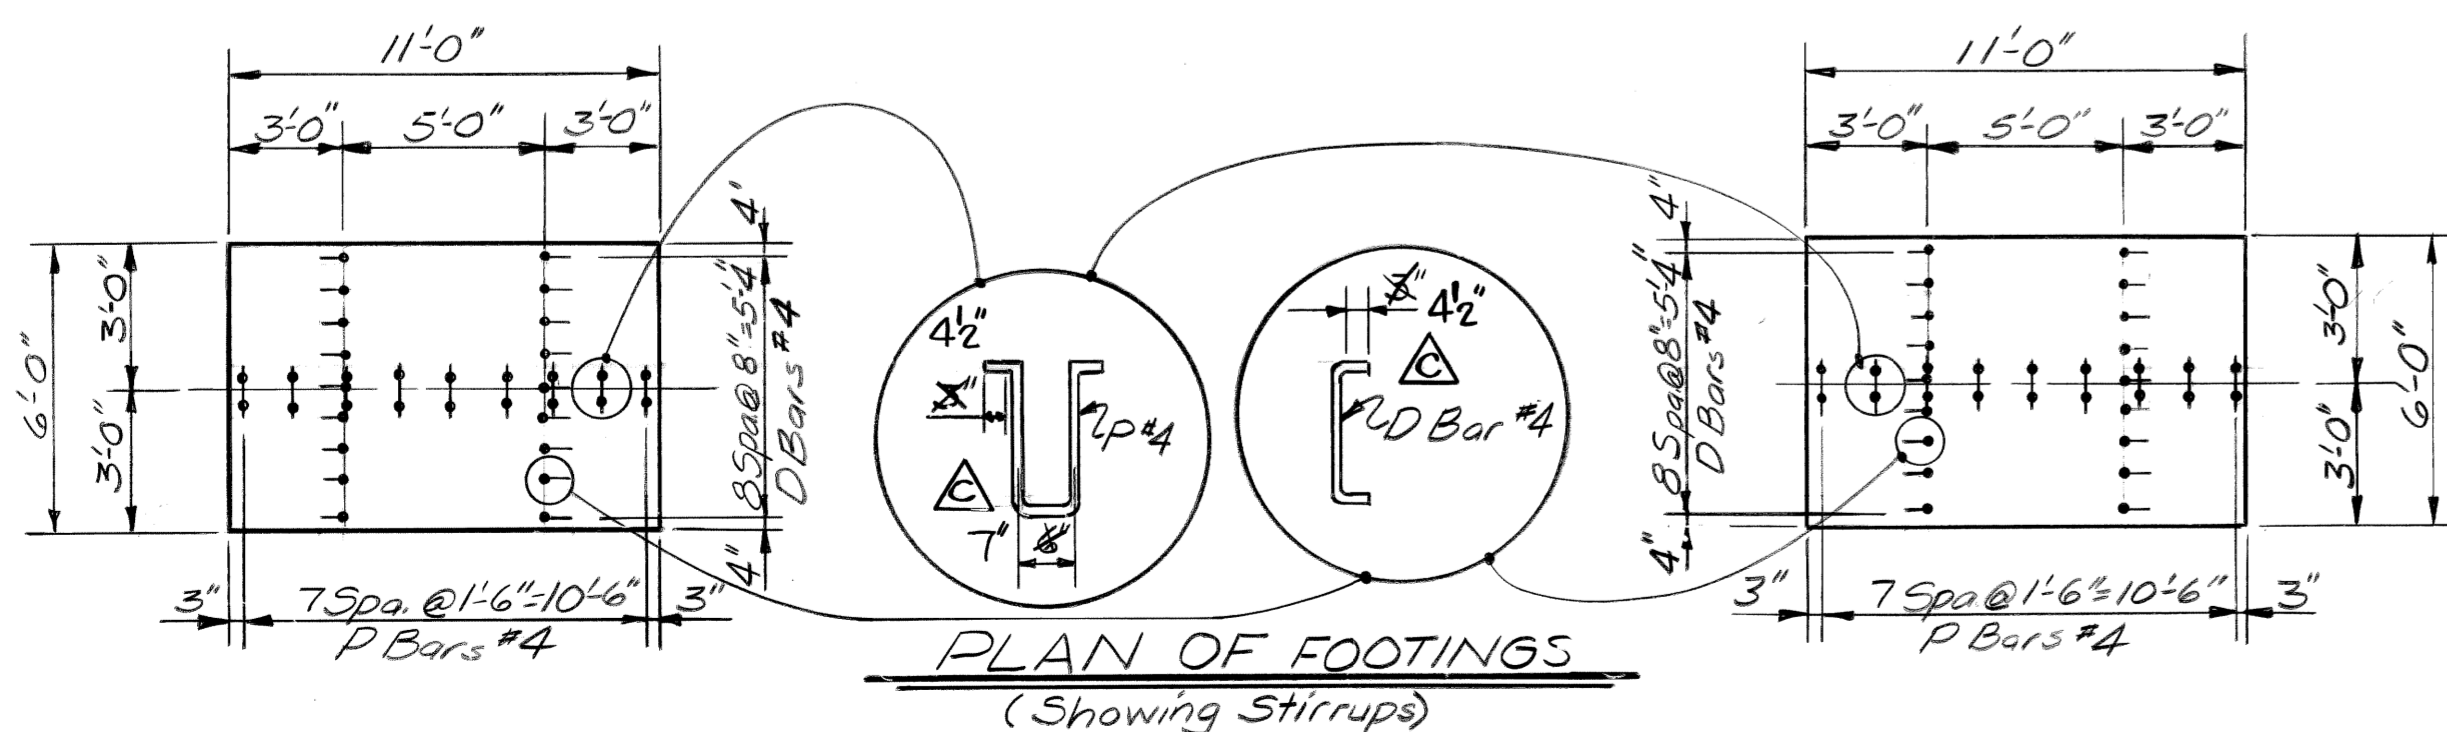

PLAN OF FOOTINGS
(Showing Stirrups)

Work This Sheet With Sheets # 534 thru 545, 547 & 548

DATE: August, 1979

DSGN BY:	RGW, MH
DRN BY:	MH
CK'D BY:	RGW
APP'D BY:	

REVISIONS	△ Revise Dimensions SJP 1-22-1980
-----------	-----------------------------------


CITY OF DETROIT, MICHIGAN




JOHN C. LODGE EXIT RAMP AND JEFFERSON AVENUE-RECONSTRUCTION AT THE JOE LOUIS ARENA.

PIER DETAILS
PIER 14

SCALE: NONE
DRN. NO: S46

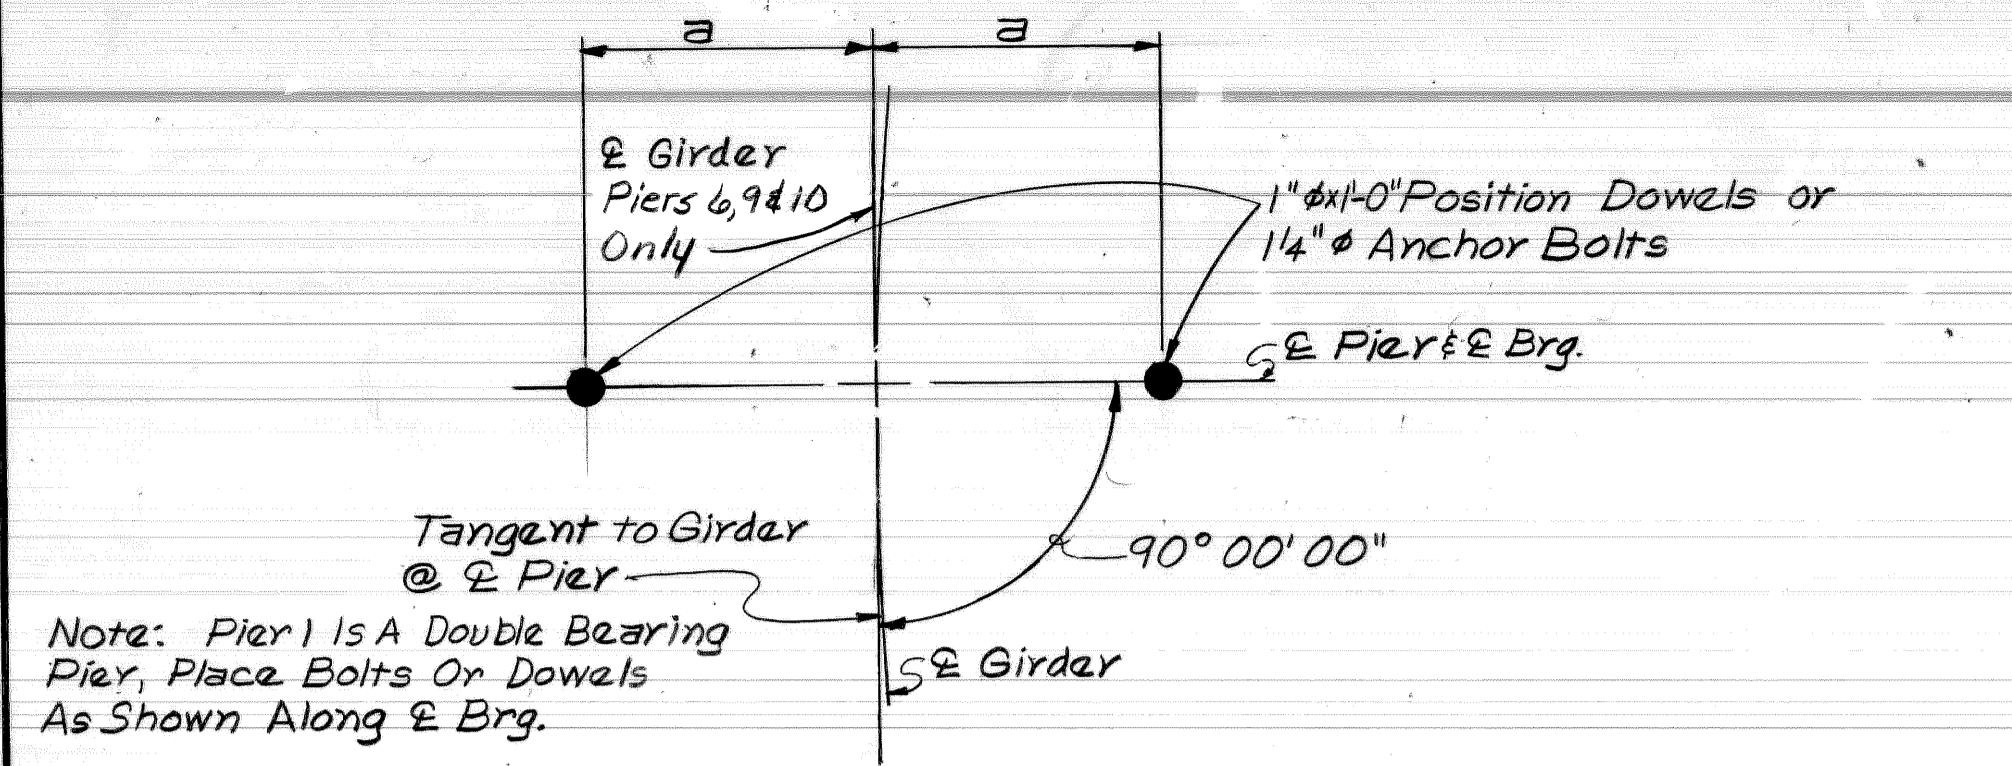


DETAIL B
Piers 1 thru 6-11, 94 10

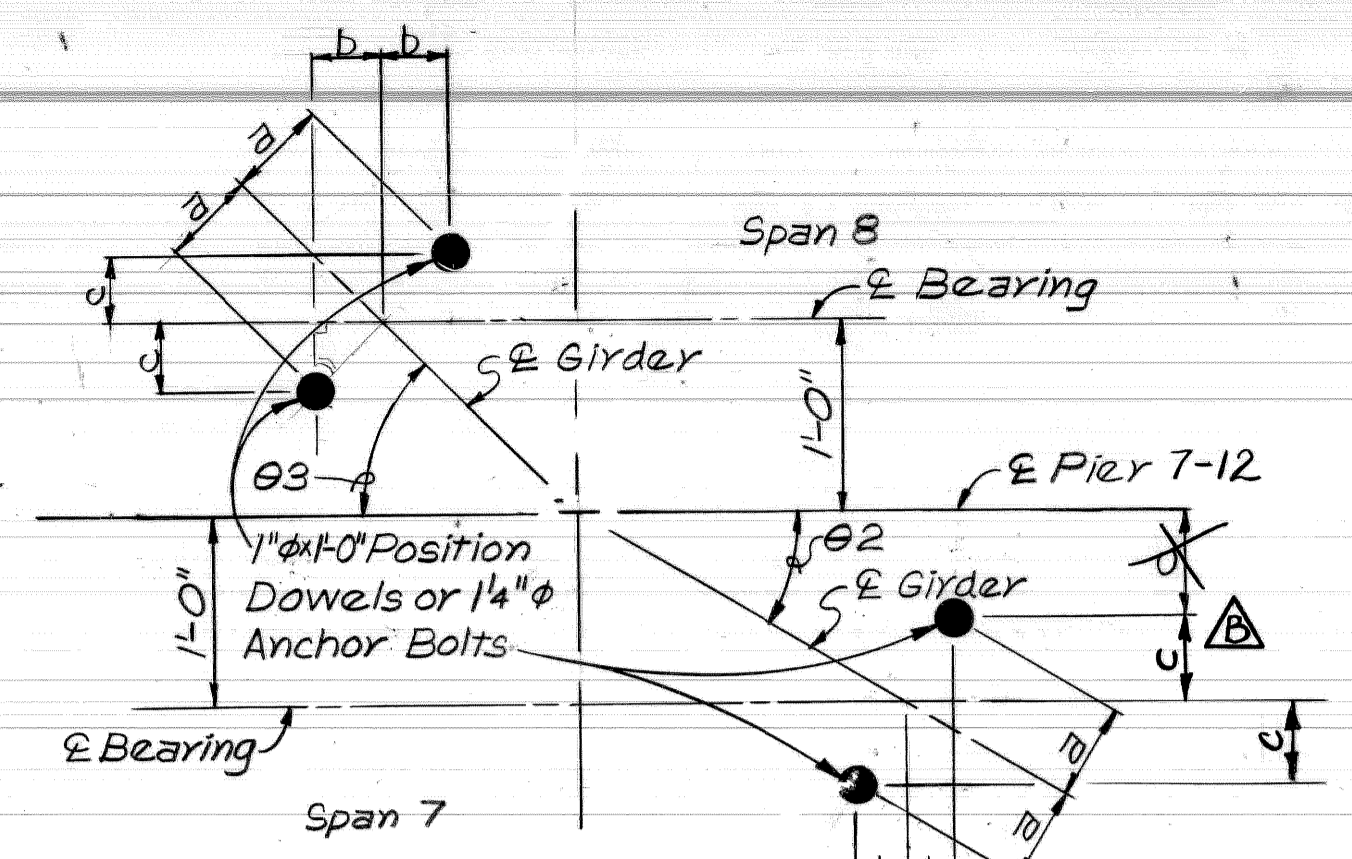


DETAIL D
Pier 7-12

PROJECTION TABLE


Location	Girder	A	B	B-B	C	D	E	F
Pier 1, Span 1	3 1/2"	3 1/2"	N.A.	3 1/2"	3 1/2"	3 1/2"	3 1/2"	7"
Pier 1, Span 2	1"	1"	N.A.	1"	1"	1"	1"	8 3/8"
Pier 2	3 1/2"	3 1/2"	N.A.	3 1/2"	3 1/2"	3 1/2"	3 1/2"	8 7/8"
Pier 3	2 1/2"	2 1/2"	N.A.	2 1/2"	2 1/2"	2 1/2"	2 1/2"	8 1/8"
Pier 4	3 1/2"	3 1/2"	N.A.	3 1/2"	3 1/2"	3 1/2"	3 1/2"	9 3/8"
Pier 5	2 1/2"	2 1/2"	N.A.	2 1/2"	2 1/2"	2 1/2"	2 1/2"	8 1/8"
Pier 6-11	3 1/2"	3 1/2"	N.A.	3 1/2"	3 1/2"	3 1/2"	3 1/2"	9 1/8"
Pier 7-12 Span 7	5 3/4"	1"	N.A.	1"	1"	1"	1"	1"
Pier 7-12 Span 8	4 3/4"	1"	1"	1"	1"	1"	1"	1"
Pier 8, Span 8	6"	3 1/2"	3 1/2"	N.A.	N.A.	N.A.	N.A.	N.A.
Pier 8, Span 9	9 3/4"	3 1/2"	N.A.	3 1/2"	3 1/2"	N.A.	N.A.	N.A.
Pier 9	8 3/8"	3 1/2"	N.A.	3 1/2"	3 1/2"	N.A.	N.A.	N.A.
Pier 10	3 1/2"	3 1/2"	N.A.	3 1/2"	3 1/2"	N.A.	N.A.	N.A.
Pier 13, Span 8	N.A.	N.A.	N.A.	3 1/2"	3 1/2"	3 1/2"	3 1/2"	8 1/4"
Pier 13, Span 12	N.A.	N.A.	N.A.	3 1/2"	3 1/2"	3 1/2"	3 1/2"	8 1/4"
Pier 14	N.A.	N.A.	N.A.	1"	1"	1"	1"	6 3/4"

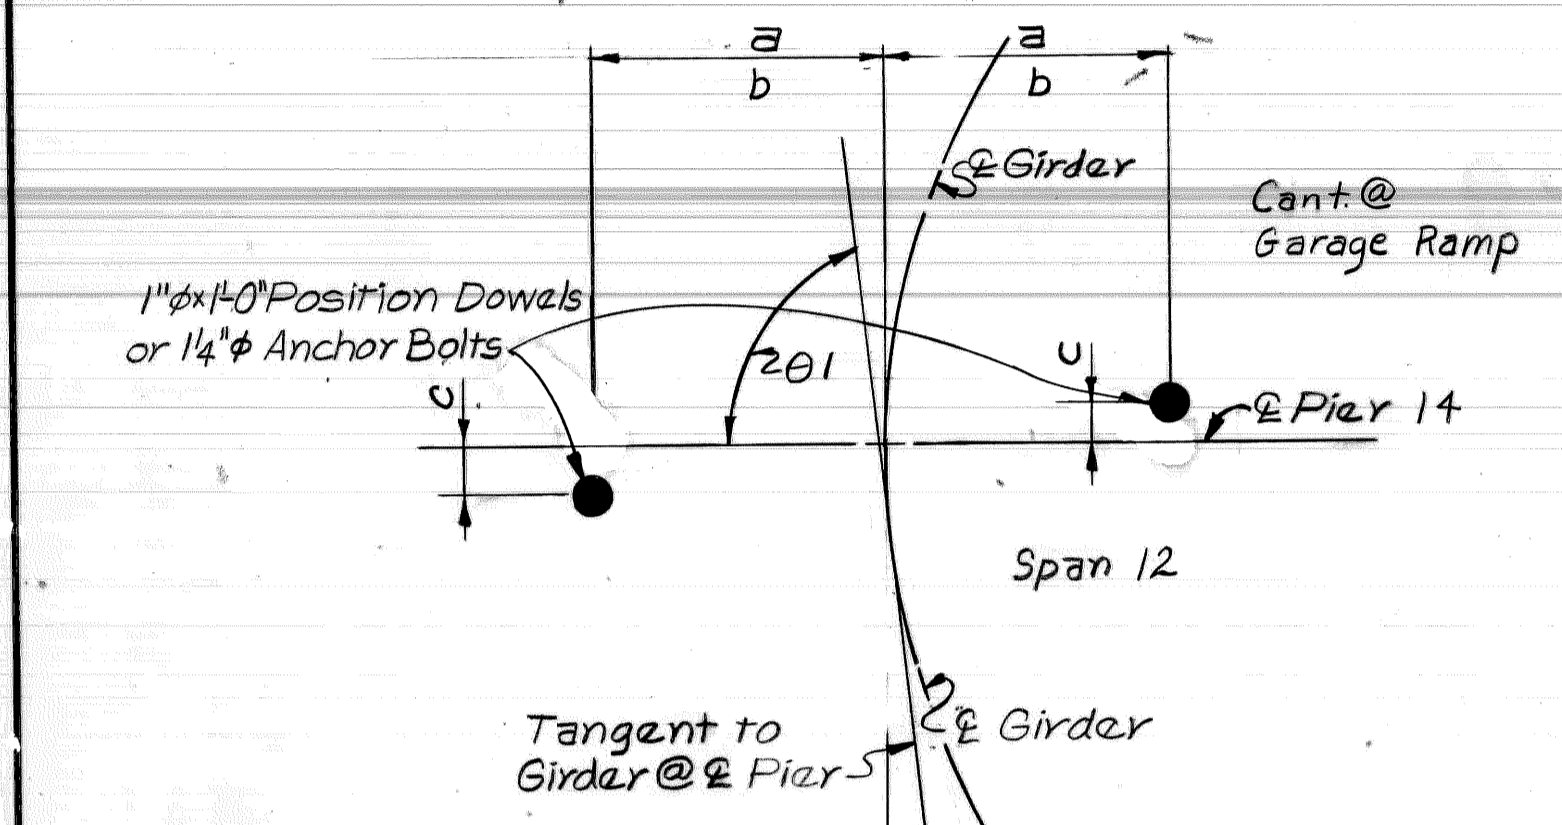

DETAIL C
Pier 14

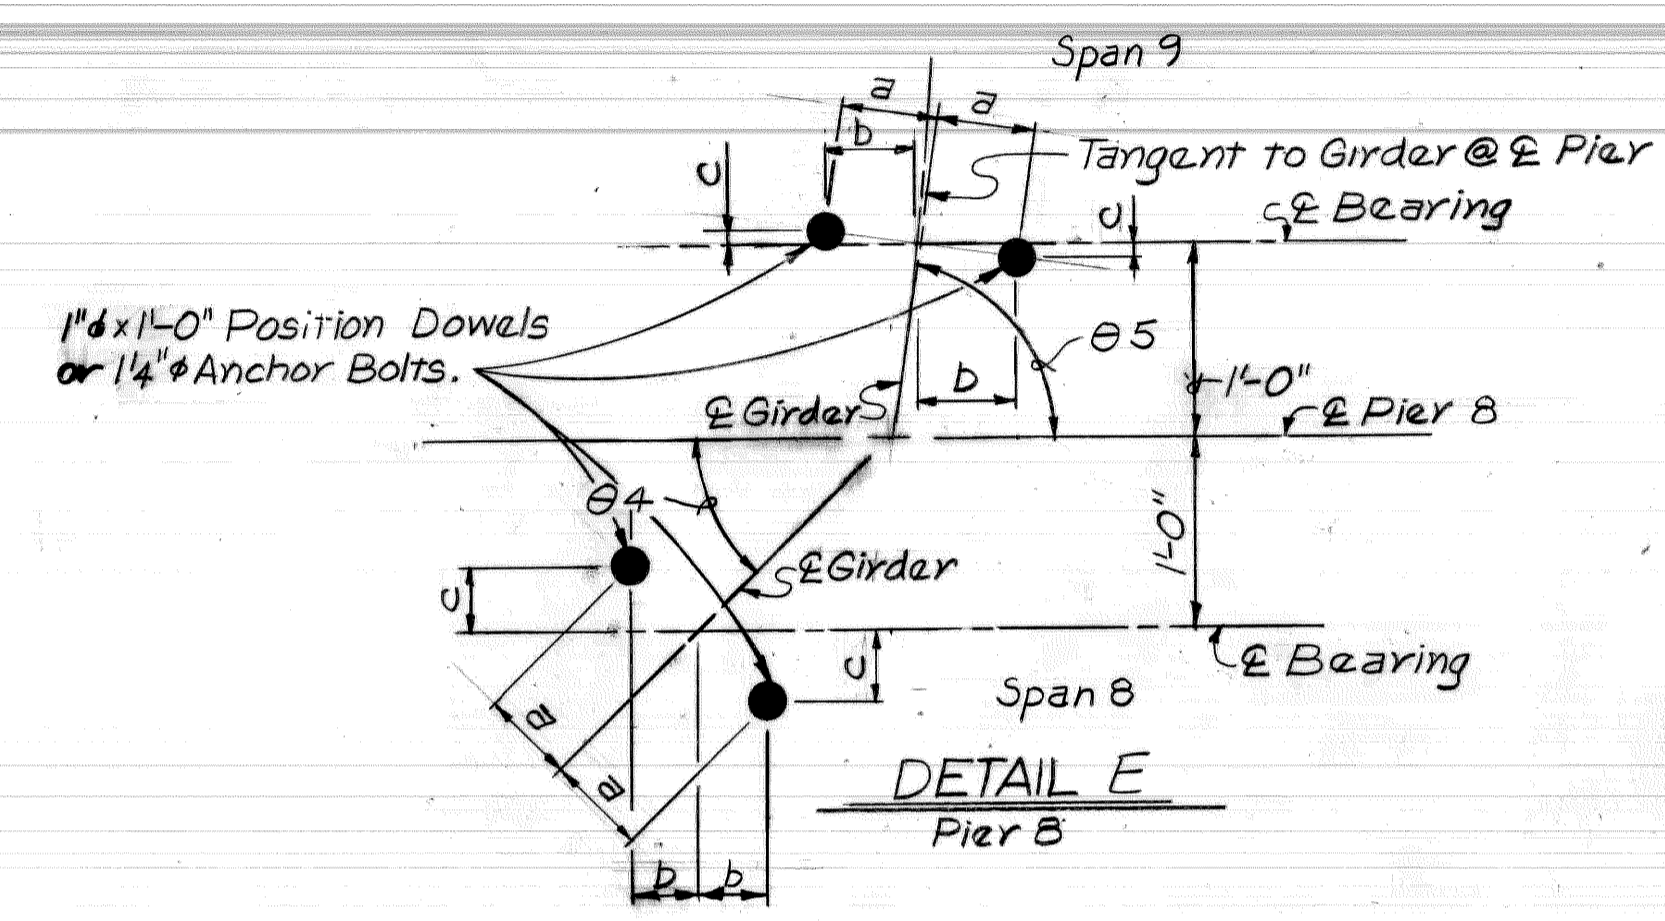

DETAIL E
Pier 8

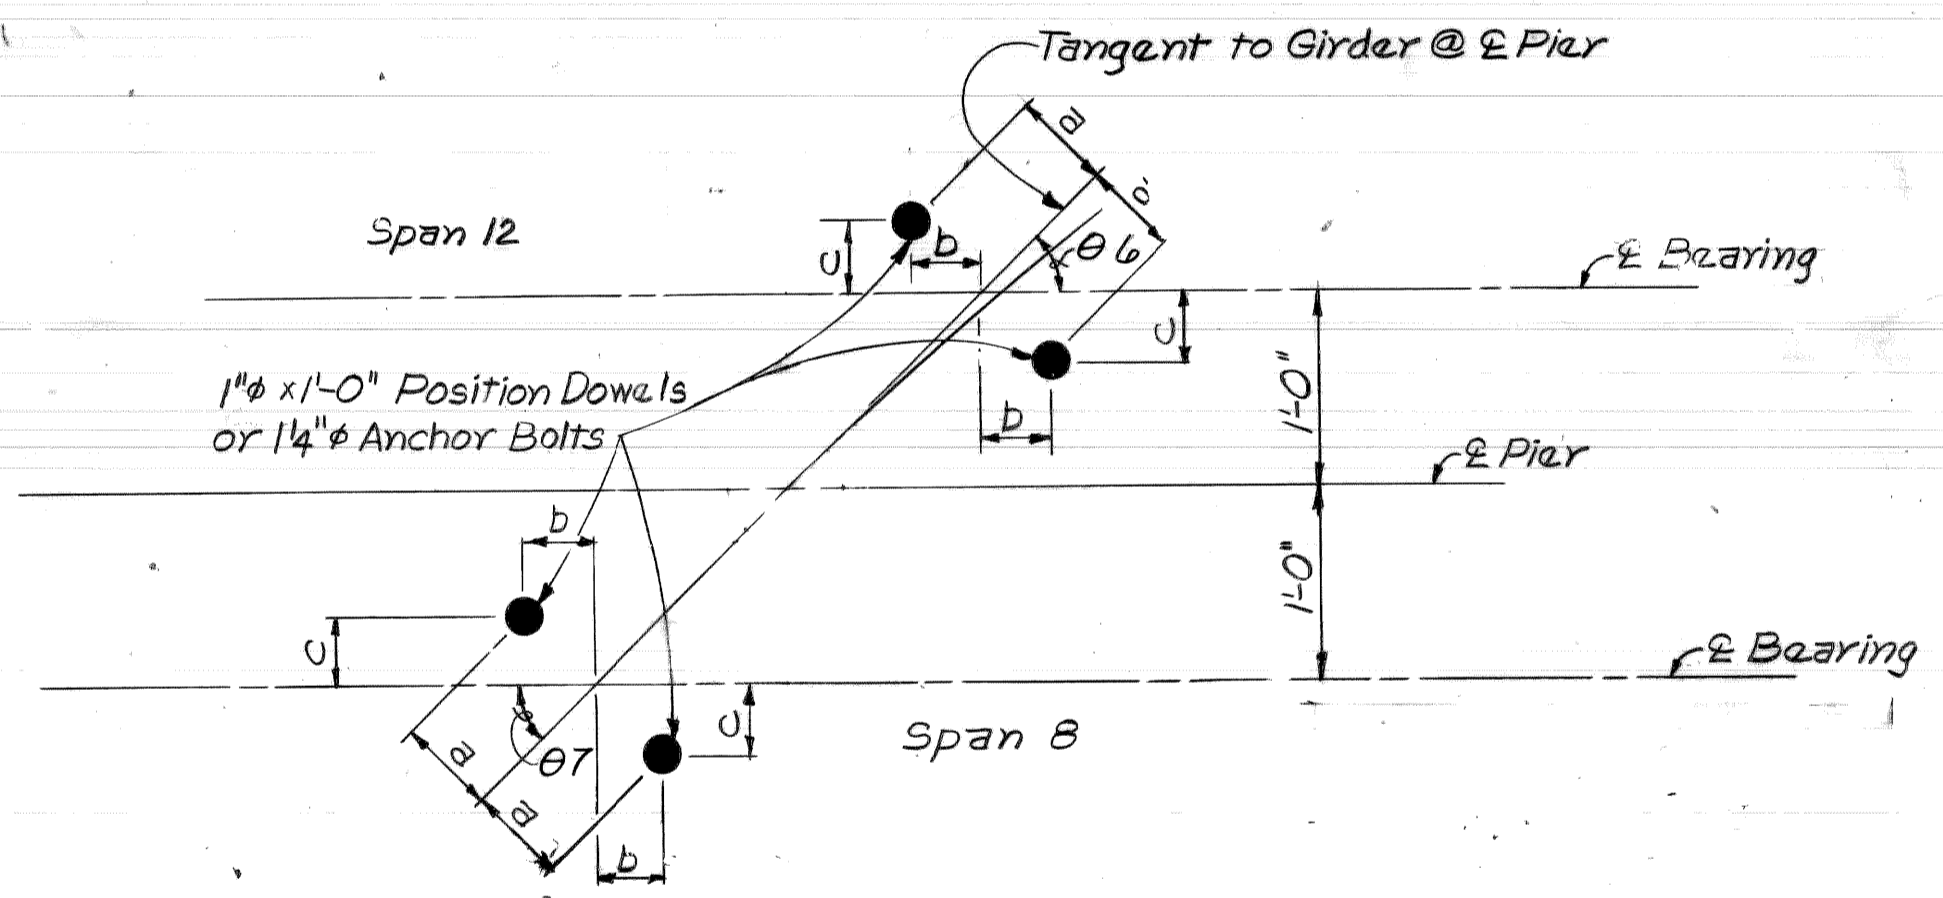


DETAIL F
Pier 13

BEARING LOCATION DIMENSIONS


GIRDER	A	B	C	D	E	F
LOCATION	DIMENSION a					
Pier 1 Span 1	5"	5"	5"	5"	5"	2 3/4"
Pier 1 Span 2	6 1/2"	6 1/2"	6 1/2"	6 1/2"	6 1/2"	2 3/4"
Pier 2	6 1/2"	6 1/2"	6 1/2"	6 1/2"	6 1/2"	2 3/4"
Pier 3	5 1/2"	5 1/2"	5 1/2"	5 1/2"	5 1/2"	2 3/4"
Pier 4	8"	8"	8"	8"	8"	2 3/4"
Pier 5	6"	6"	6"	6"	6"	2 3/4"
Pier 6-11	6 1/2"	6 1/2"	6 1/2"	6 1/2"	6 1/2"	2 3/4"
GIRDER	1 1/2" A	1 1/2" B	B-B	C	D	E
LOCATION	a	b	c	a	b	c
Pier 7-12 Span 7	5 1/2"	4"	3 3/8"	N.A.	5 1/2"	4 1/8"
Pier 7-12 Span 8	2 3/4"	1 1/4"	2 1/8"	2 1/2"	1 7/8"	1 1/4"
Pier 8 Span 8	2 3/4"	2 3/4"	3 1/8"	6 1/2"	6 1/2"	6"
Pier 8 Span 9	2 3/4"	2 3/4"	3 1/8"	4 1/2"	4 1/2"	4 1/2"
GIRDER	A	B	C	D	E	F
LOCATION	DIMENSION a					
Pier 9	2 3/4"	2 3/4"	6 1/2"	6 1/2"	6 1/2"	6 1/2"
Pier 10	6 1/2"	6 1/2"	6 1/2"	6 1/2"	6 1/2"	6 1/2"
GIRDER	C	D	E	F		
LOCATION	a	b	c	a	b	c
Pier 13 Span 8	5"	4"	3 1/8"	5"	3 3/4"	3 1/4"
Pier 13 Span 12	6"	4 3/8"	4 3/8"	6"	4 3/8"	4 3/8"
Pier 14	8 1/2"	8 1/2"	1 1/4"	8 1/2"	8 1/2"	1 1/4"

ANGLE TABLE


ANGLE	GIRDER	theta 1	theta 2	theta 3	theta 4	theta 5	theta 6	theta 7
A	N.A.	45°18'39"	38°27'48"	81°37'40"	82°44'12"	N.A.	N.A.	N.A.
B	N.A.	46°25'12"	35°02'28"	73°28'05"	83°16'14"	N.A.	N.A.	N.A.
B-B	N.A.	N.A.	41°23'31"	67°07'01"	N.A.	N.A.	N.A.	N.A.
C	88°24'54"	47°47'07"	47°47'07"	N.A.	83°43'53"	52°39'38"	44°17'29"	N.A.
D	88°17'22"	48°19'59"	48°19'59"	N.A.	84°07'59"	49°06'25"	44°50'21"	N.A.
E	88°08'31"	49°12'44"	49°12'44"	N.A.	N.A.	46°25'38"	45°43'05"	N.A.
F	87°58'00"	50°17'56"	50°17'56"	N.A.	N.A.	46°25'38"	46°48'17"	N.A.

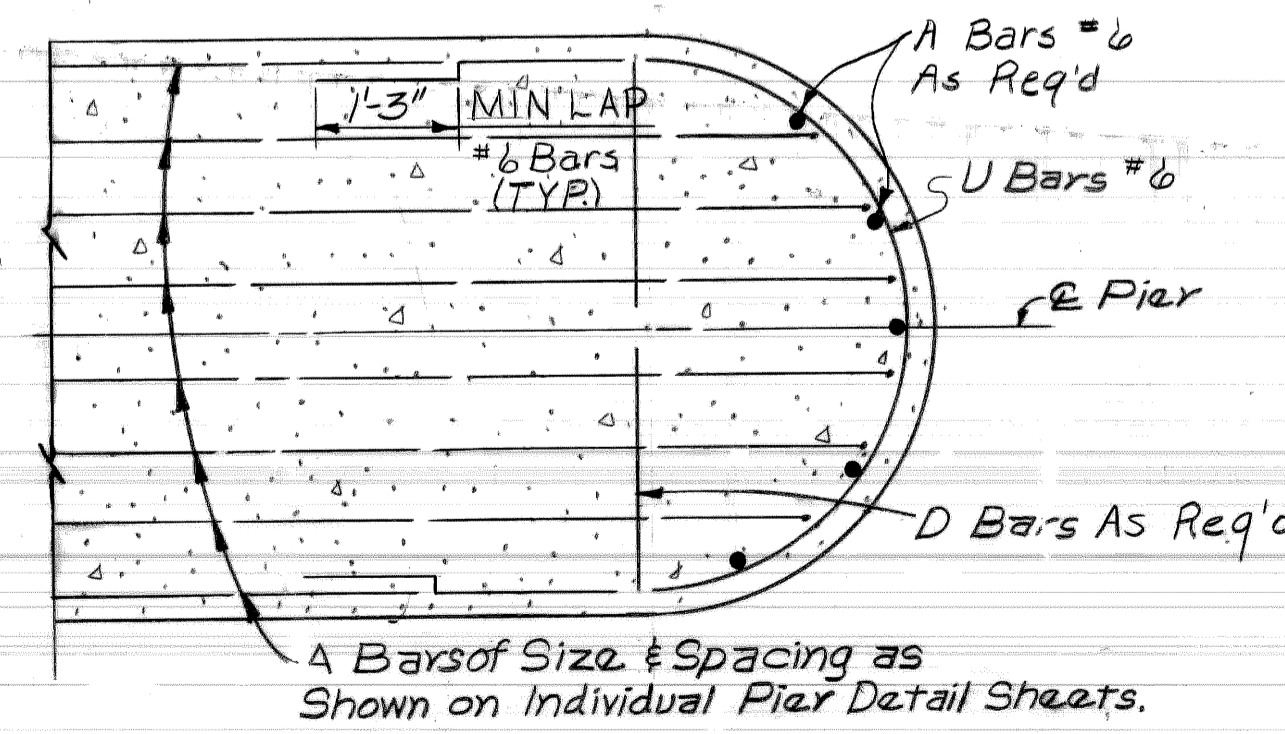


END CAP DETAIL

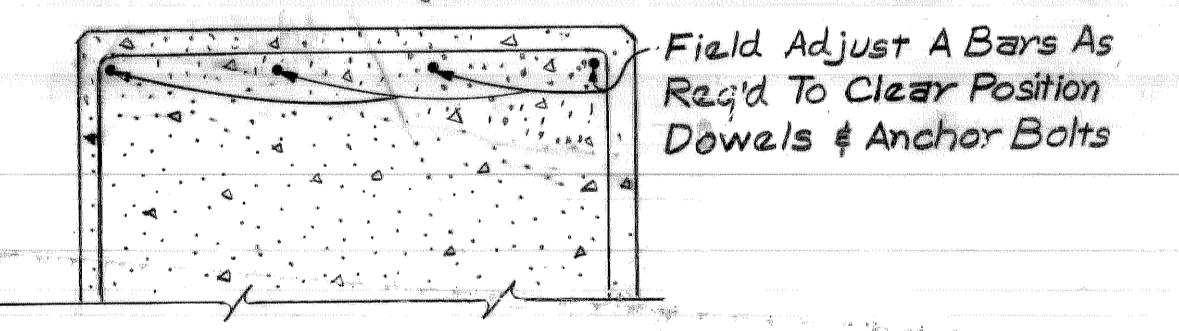

TYPICAL SECTION THRU LEVEL BOLSTER

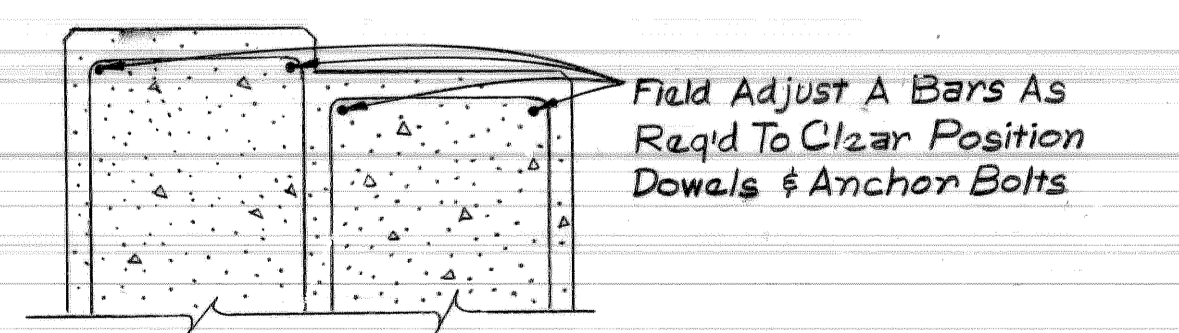

TYPICAL SECTION THRU STEPPED BOLSTER

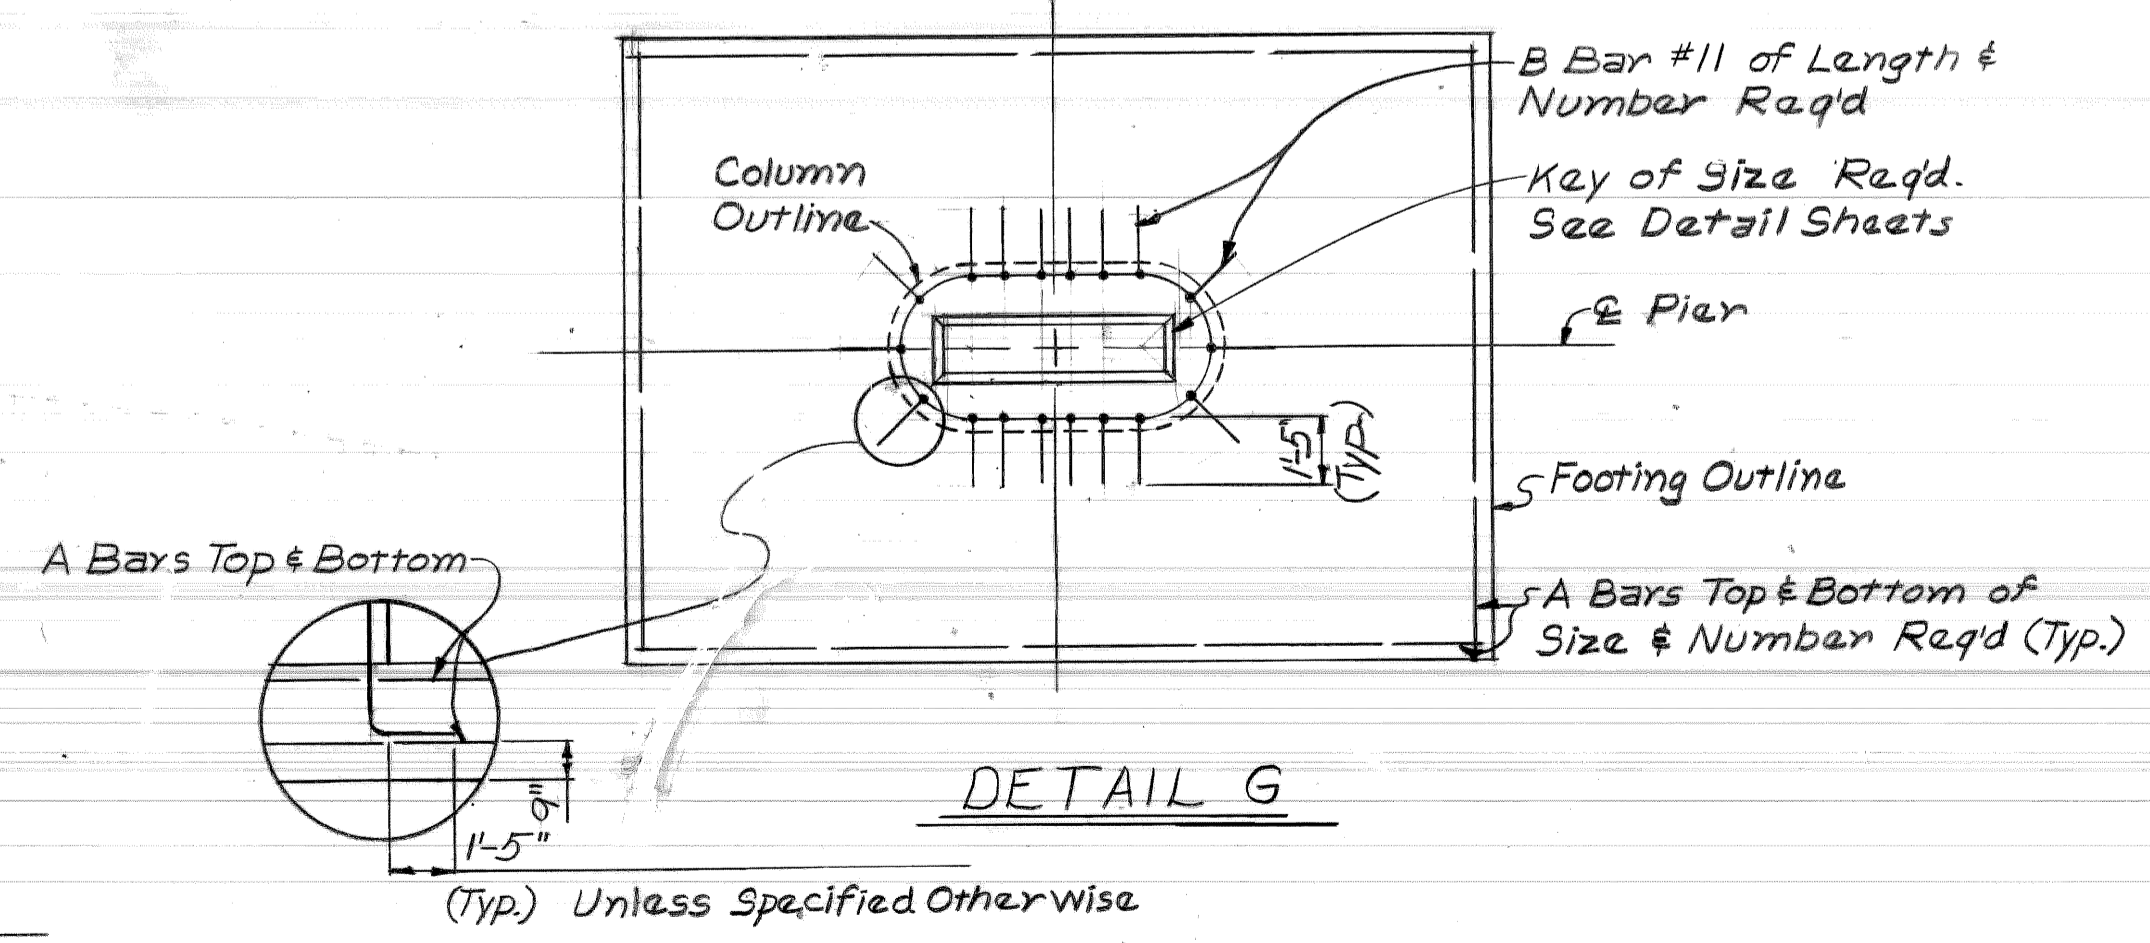

DETAIL G

DSGN BY: MH, HGW
DR'N BY: MH, DE
CK'D BY: RGW
APP'D BY:

REVISIONS
Change Anchor Bolt Projection, change Bearing Location Dimension 01-02-80


CITY OF DETROIT, MICHIGAN

Snell Environmental Group
LANSING INDIANAPOLIS AKRON


Work This Sheet With Sheets# S34 thru S46, S48
JOHN C. LODGE EXIT RAMP AND JEFFERSON AVENUE- RECONSTRUCTION AT THE JOE LOUIS ARENA.

PIER DETAILS
TYPICAL SECTIONS, DETAILS, AND QUANTITIES


DATE: August, 1979
SCALE: NONE
DRN. NO: S47

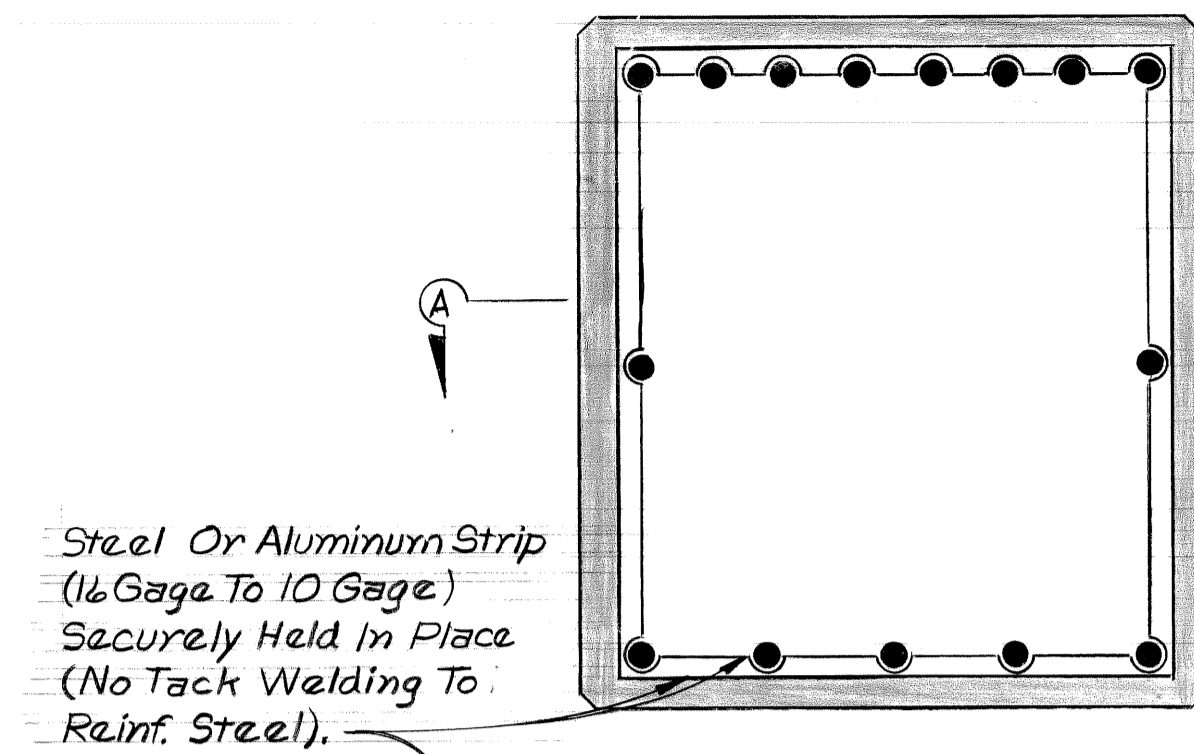

Notes:
Partial Metal Bulkhead May Be Used As Alternate Construction Joint At Contractors Expense.
Care Is To Be Used In Casting Concrete Around Bulkhead To Prevent Dislocation Or Misalignment Of The Bulkhead.

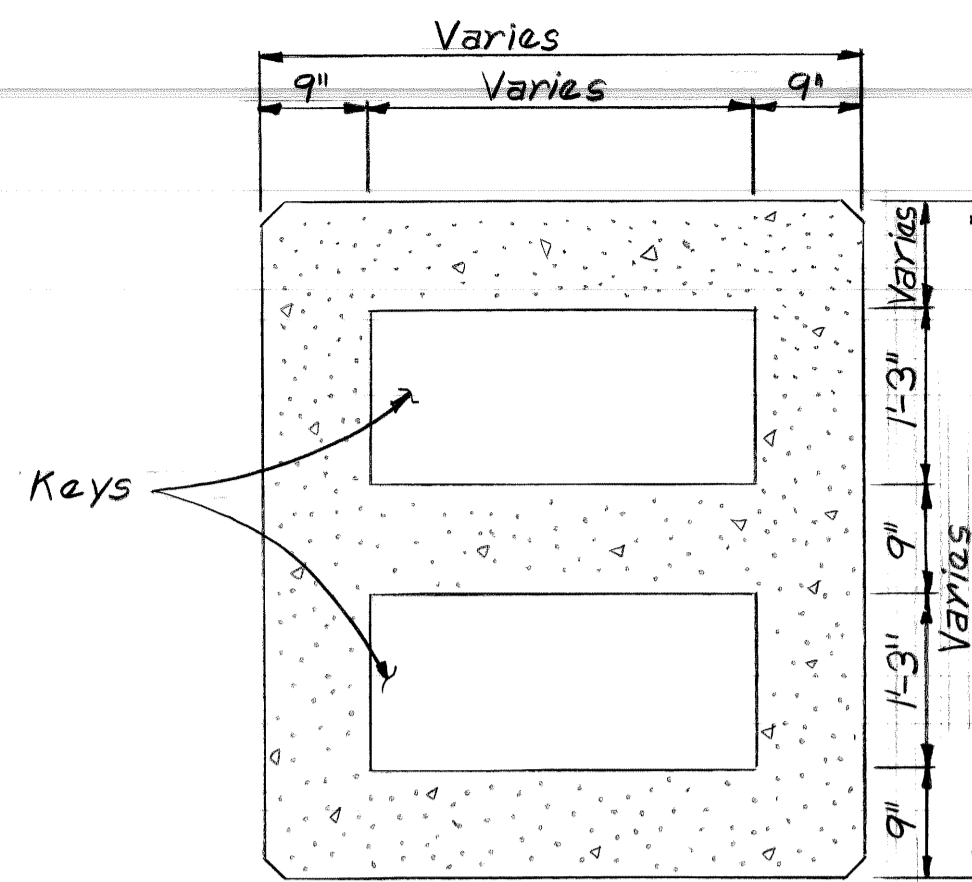


CONSTRUCTION JOINT

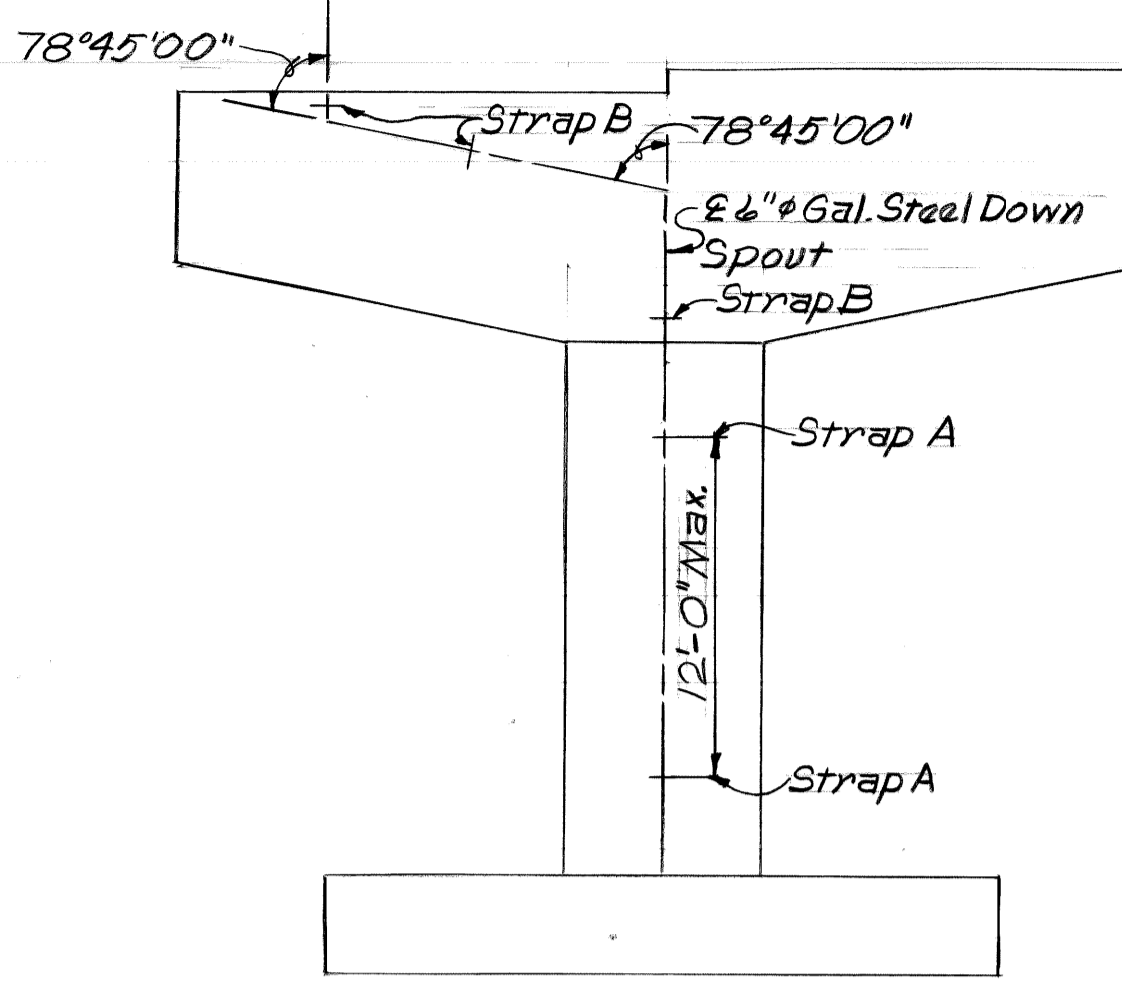


ELEVATION

Strap A or Strap B (Typ) (See Detail this sheet) (Incidental)

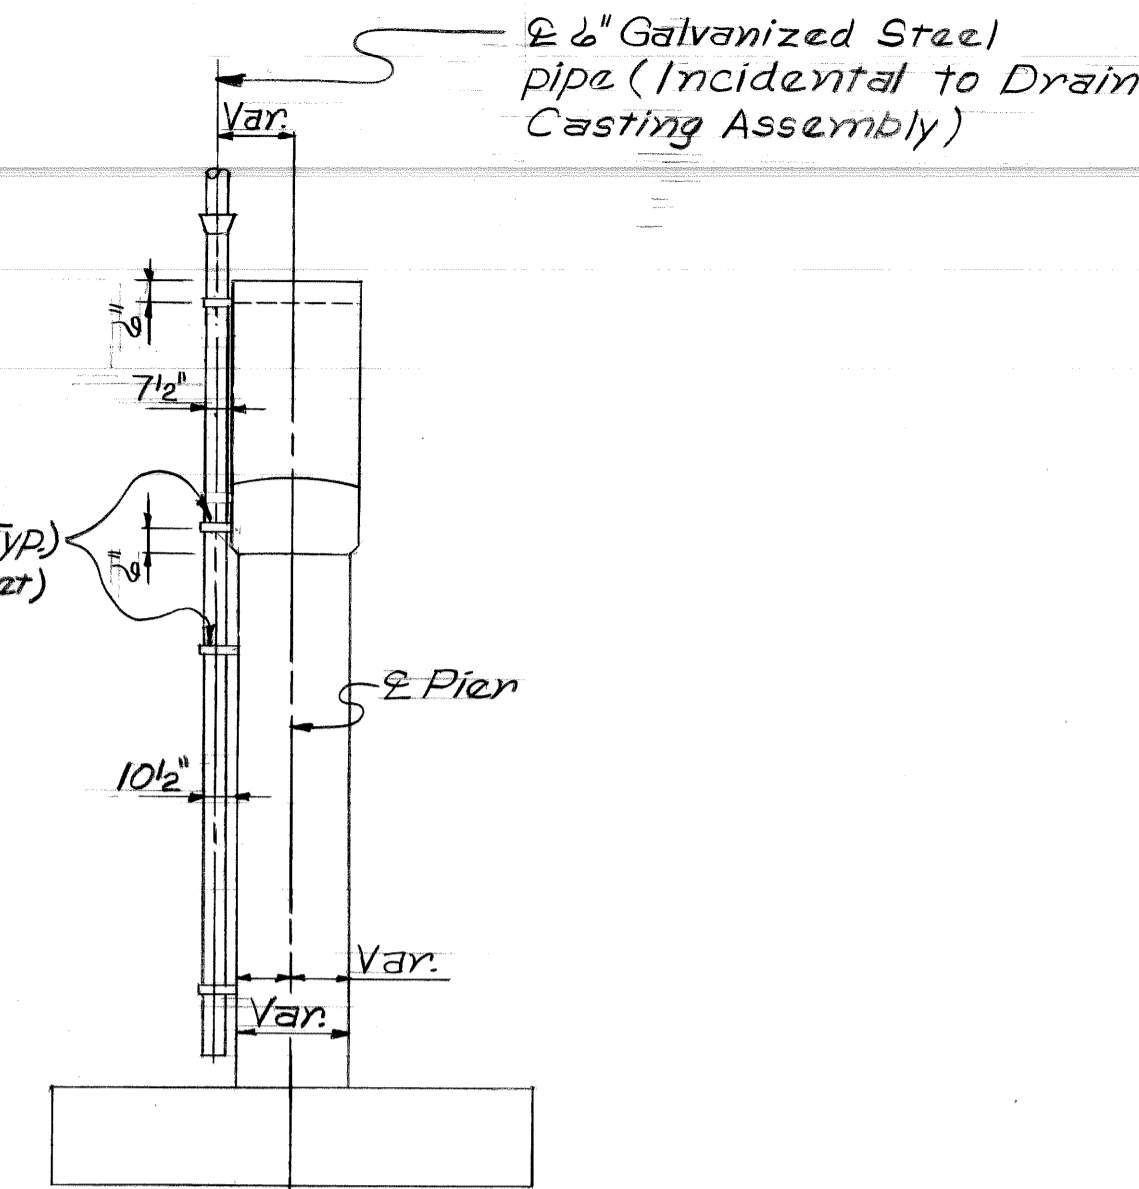


END VIEW

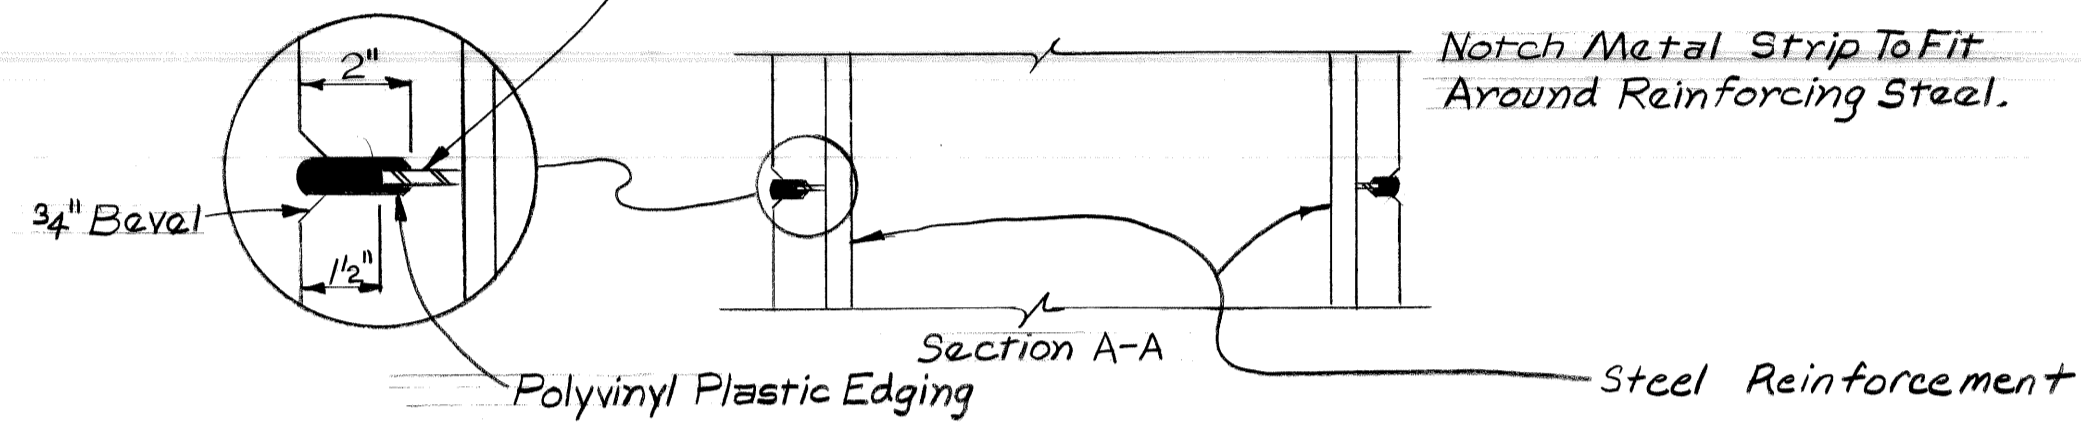


ALTERNATE CONSTRUCTION JOINT

DOWN SPOUT DETAIL

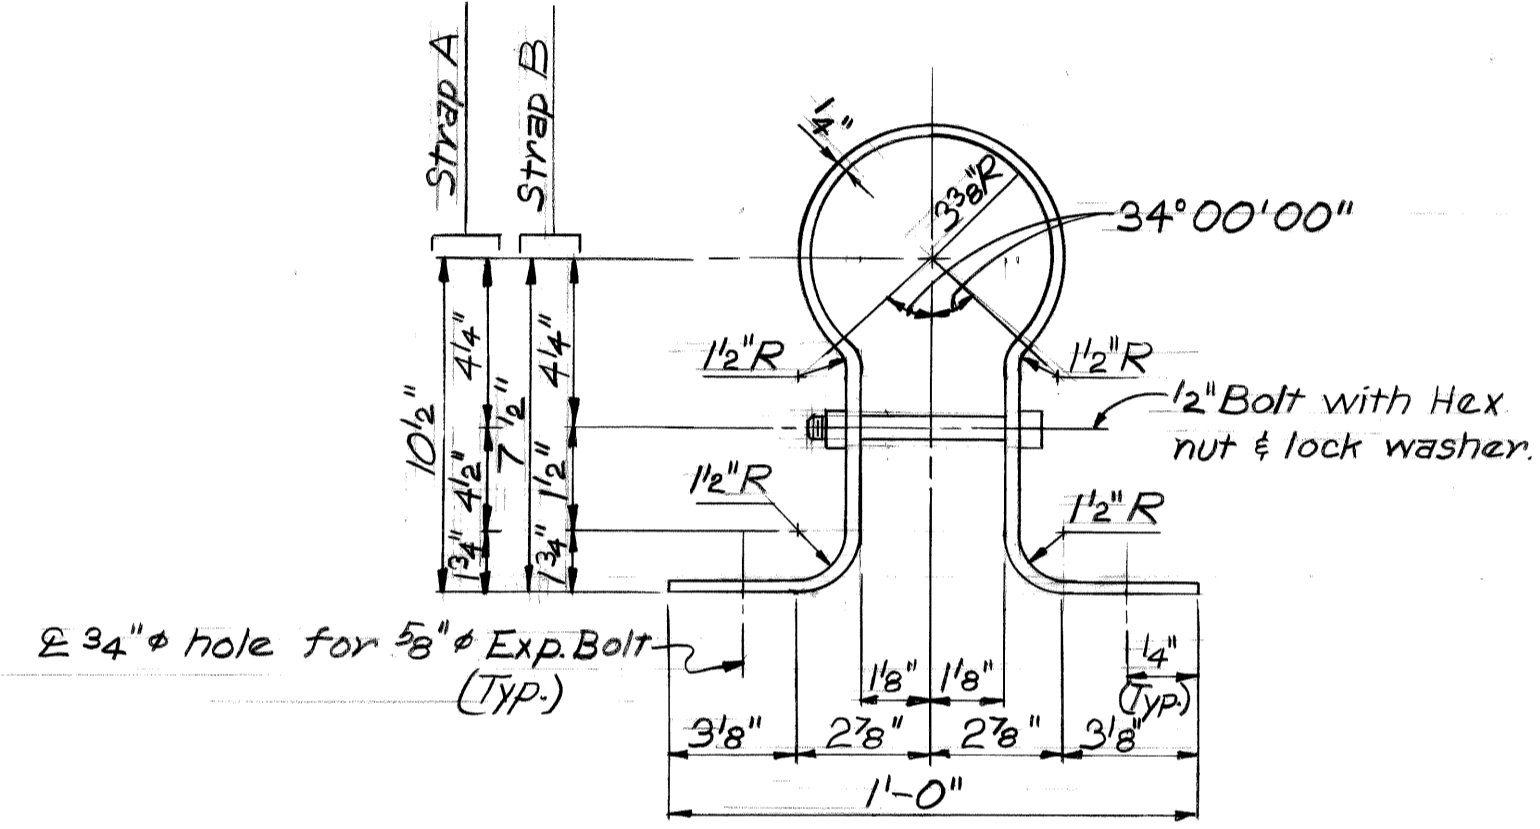

DETAIL-STRAP A & STRAP B

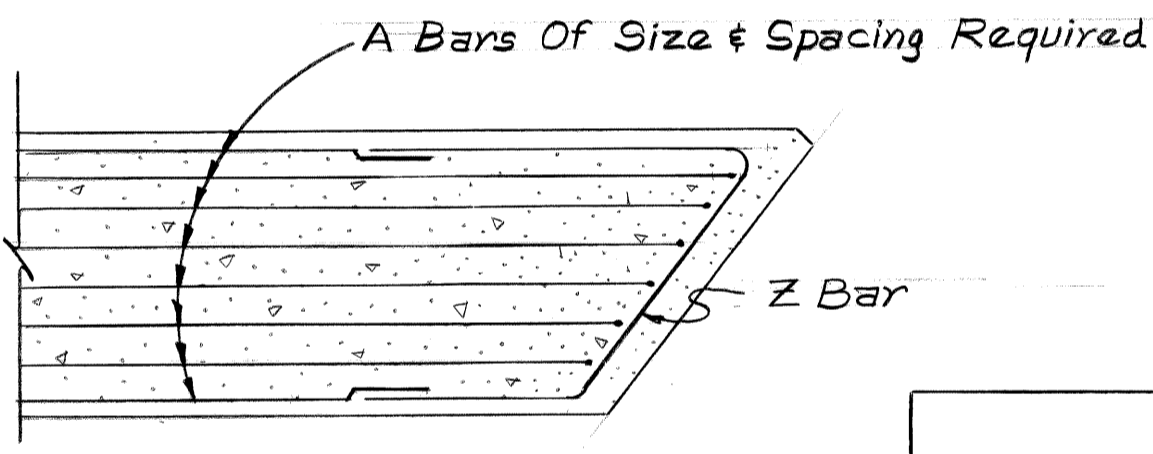

END CAP DETAIL
Pier 8 & Pier 13

MISCELLANEOUS QUANTITIES														
Item	Unit	Amount												Total
		Pier 1	Pier 2	Pier 3	Pier 4	Pier 5	Pier 6-11	Pier 7-12	Pier 8	Pier 9	Pier 10	Pier 11	Pier 12	
Unclassified Foundation Excavation	C.Y.	69	74	47	81	47	81	249	62	56	56	64	43	934
Protective Sealant Coating	S.F.	186	N.A.	N.A.	N.A.	N.A.	N.A.	309	128	N.A.	N.A.	213	N.A.	836
Clear Protective Coating For Substructure Concrete	S.F.	881	1,159	1,193	1,157	1,145	1,172	1,472	671	670	625	922	794	11,861
Low Temperature Protection, Substructure Concrete	C.Y.	97	106	88	112	85	112	267	72	60	58	104	43	1,204

SUBSTRUCTURE CONCRETE QUANTITIES							
Item	Unit	Pour					
		A	B	C	D	E	F
Pier 1	C.Y.	44.0	6.4	46.7	N.A.	N.A.	N.A.
Pier 2	C.Y.	48.0	11.1	46.8	N.A.	N.A.	N.A.
Pier 3	C.Y.	28.0	12.7	47.3	N.A.	N.A.	N.A.
Pier 4	C.Y.	53.3	10.6	47.4	N.A.	N.A.	N.A.
Pier 5	C.Y.	28.0	10.1	47.1	N.A.	N.A.	N.A.
Pier 6-11	C.Y.	53.3	11.1	47.8	N.A.	N.A.	N.A.
Pier 7-12	C.Y.	89.8	9.9	32.3	89.8	9.9	35.2
Pier 8	C.Y.	39.0	8.2	25.1	N.A.	N.A.	N.A.
Pier 9	C.Y.	34.0	5.7	20.3	N.A.	N.A.	N.A.
Pier 10	C.Y.	34.0	3.9	20.2	N.A.	N.A.	N.A.
Pier 13	C.Y.	40.0	9.5	54.0	N.A.	N.A.	N.A.
Pier 14	C.Y.	9.8	2.6	13.4	9.8	2.6	N.A.
Total Substructure Concrete = 1,204 C.Y.							

MISCELLANEOUS QUANTITIES		
Item	Unit	Amount
Steel Reinforcement	lbs.	169,000

NOTES
B.S. denotes Both Sides.
For Bevel and Molding Details, see Standard Sheet R17.
For Drain Casting Details, see Pier Detail Sheets and Standard Sheet DC1.
The tops of Piers 1, 7-12, 8, & 13 shall be given an application of protective sealant coating for concrete after the elastomeric bearings have been placed in final position on the Structure.
Clear protective coating for substructure concrete is to be applied to the complete area of the pier concrete above footings except the tops of Piers 1, 7-12, 8 & 13.
The concrete surface below an elastomeric bearing shall be broom finished and shall be clean and dry at time of installation of the bearing.
Drilling holes for anchor bolts or position dowels will not be permitted.
Adjust the spacing of reinforcing steel as required to permit placing of anchor bolts or position dowels.
For pile quantities, pile layout and notes pertaining to piles, see Pile Detail Sheets.
Pipe to be used for downspouts is to be galvanized steel pipe ASTM A53, Standard Grade.

Work This Sheet With Sheets # 534 thru 547

DATE: August, 1979

DSGN BY: RGW, MHP	
DRN BY: DE	
CK'D BY: RGW	
APP'D BY:	

REVISIONS	
-----------	--






CITY OF DETROIT, MICHIGAN



JOHN C. LODGE EXIT RAMP AND JEFFERSON AVENUE RECONSTRUCTION AT THE JOE LOUIS ARENA.

PIER DETAILS
MISCELLANEOUS SECTIONS AND DETAILS

SCALE: NONE
DRN. NO: S48

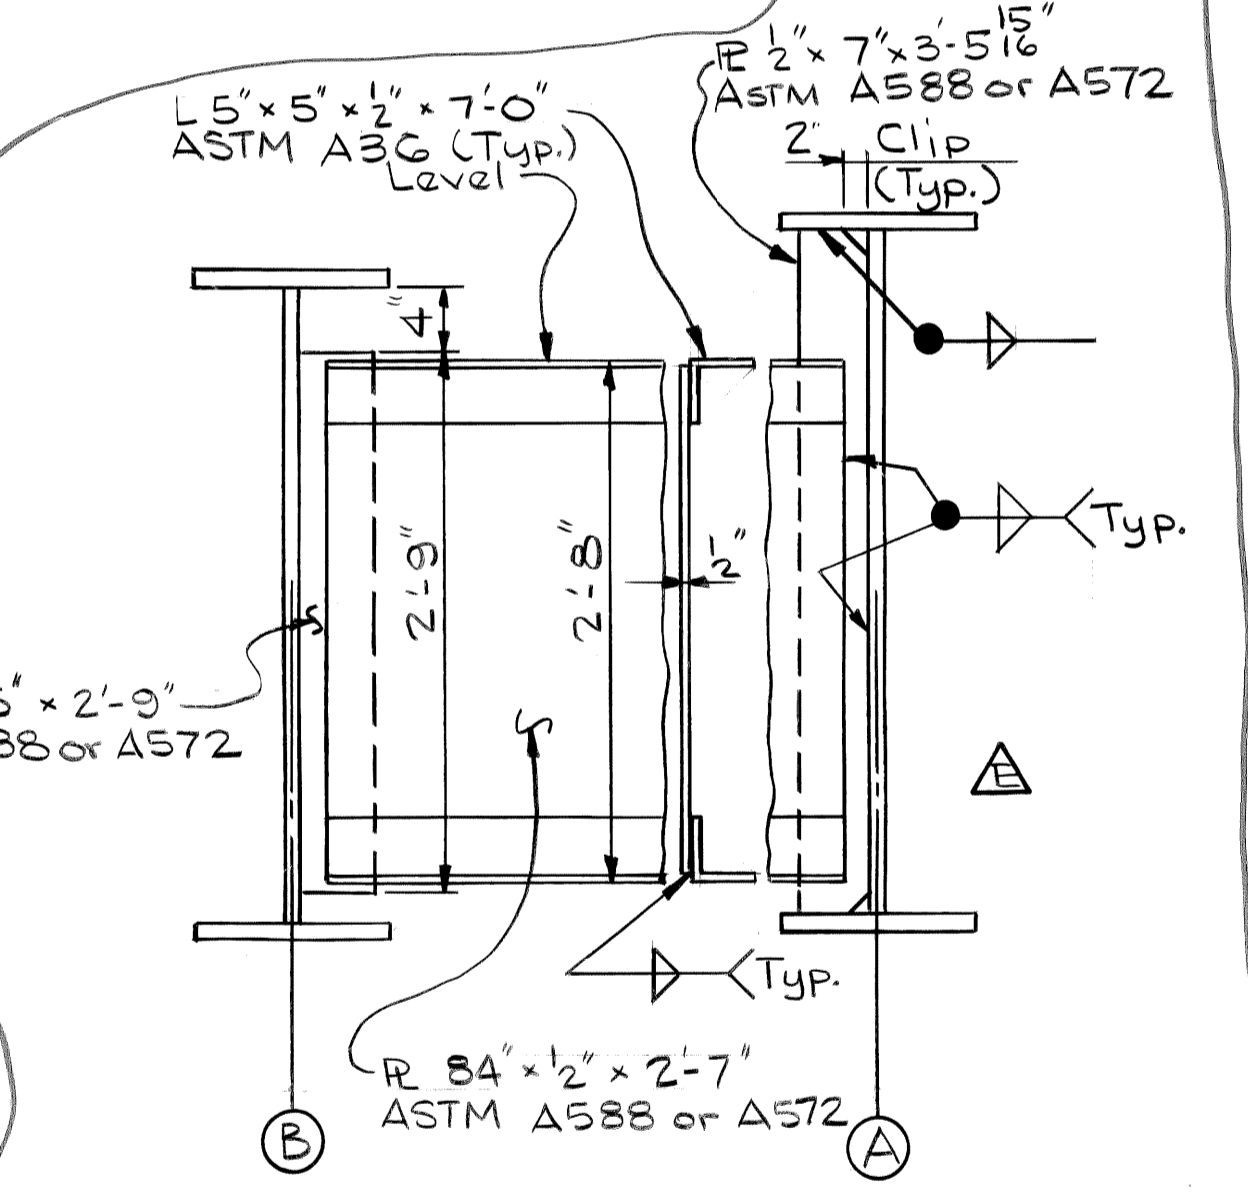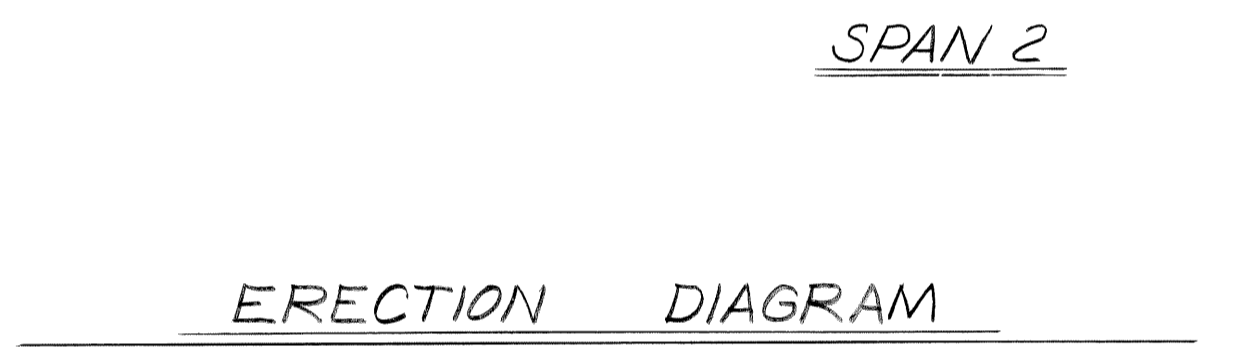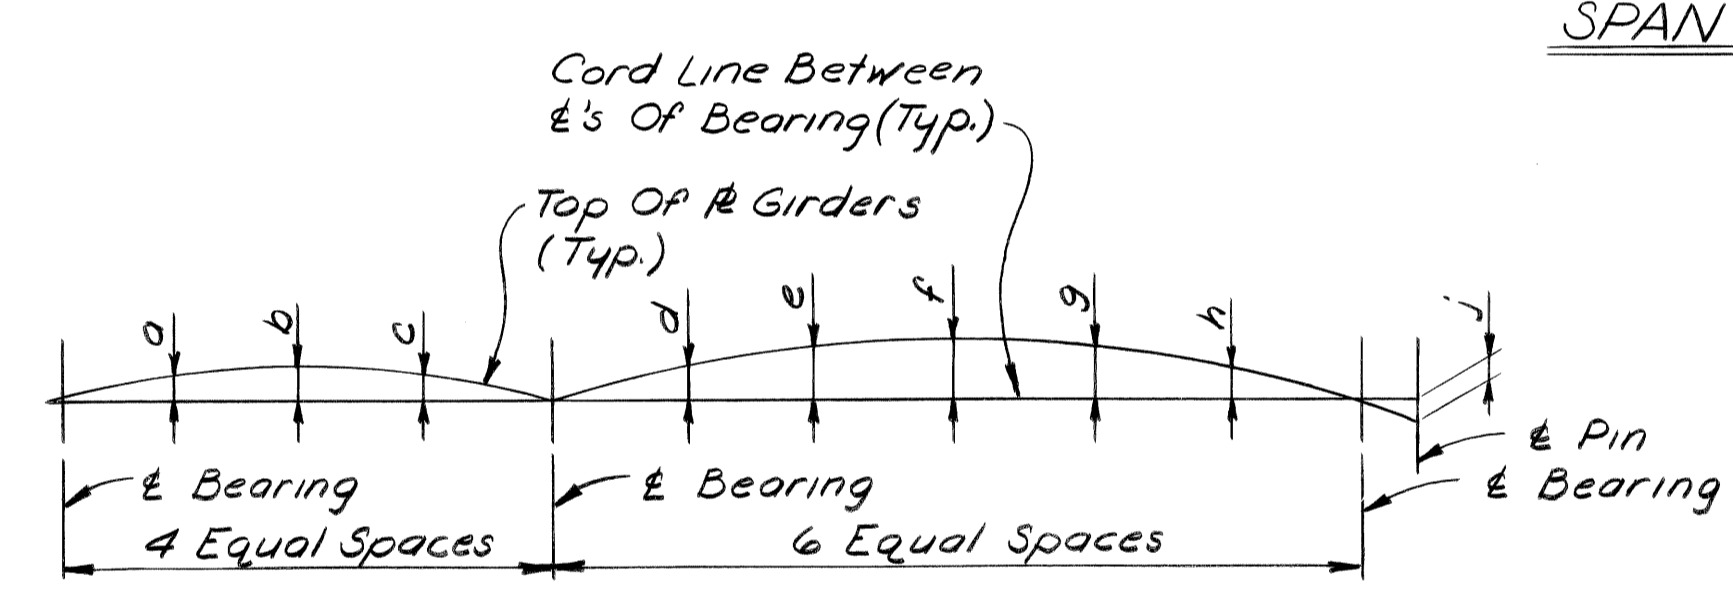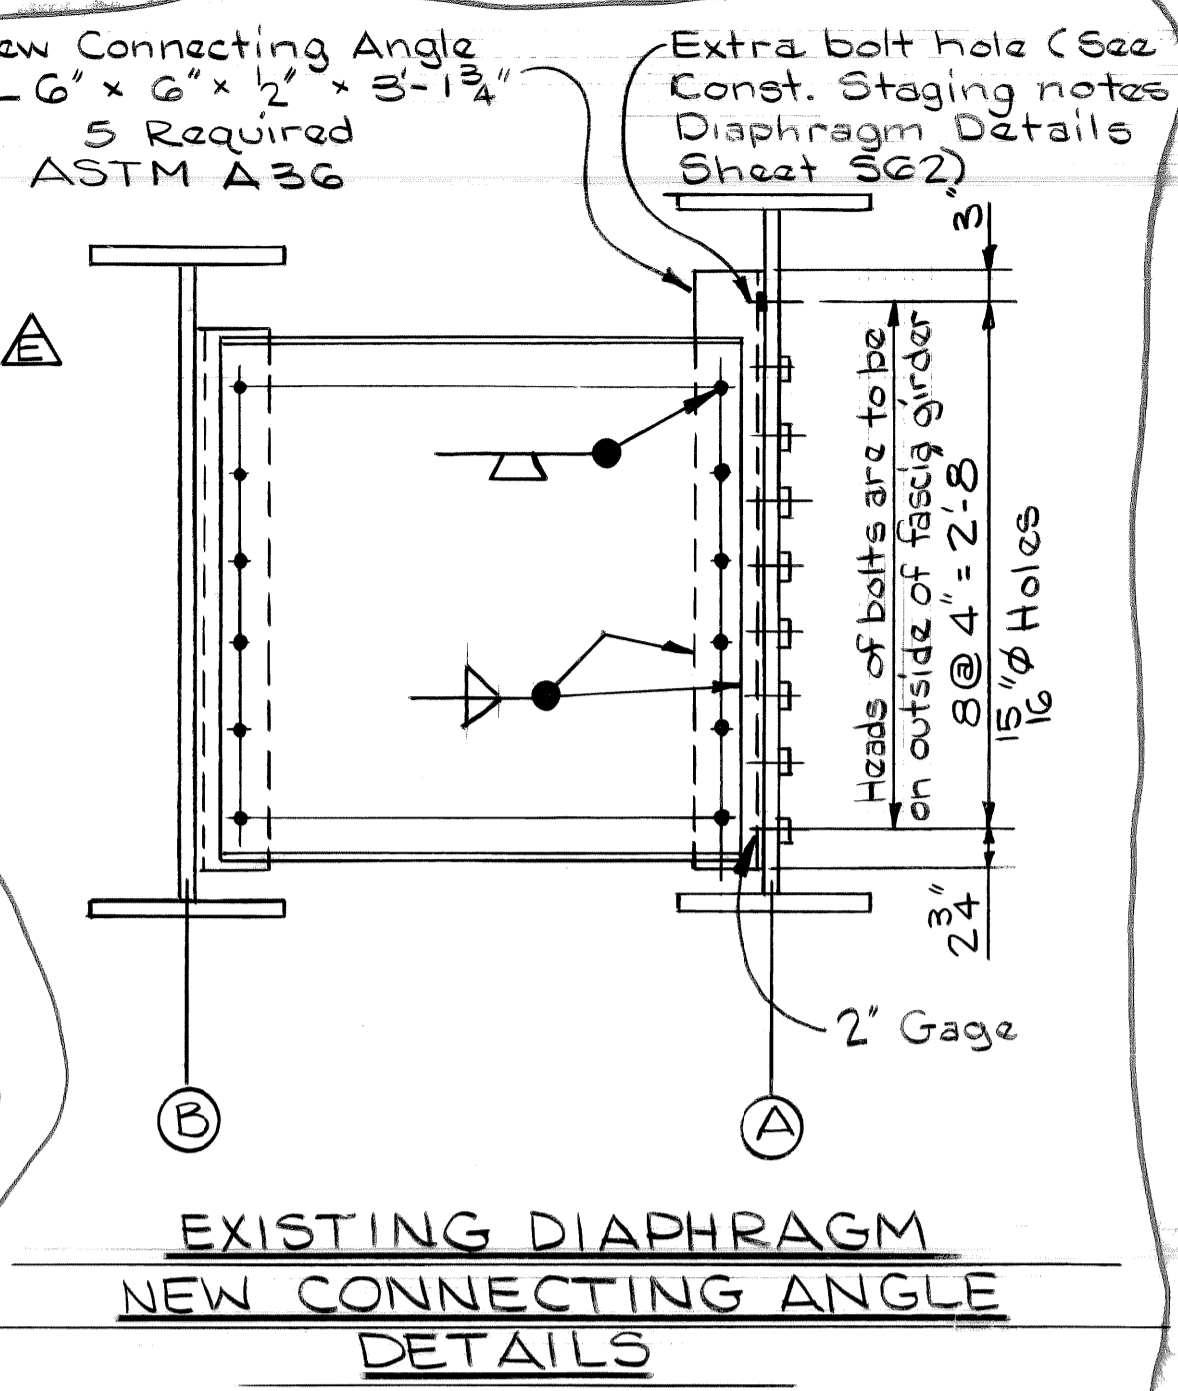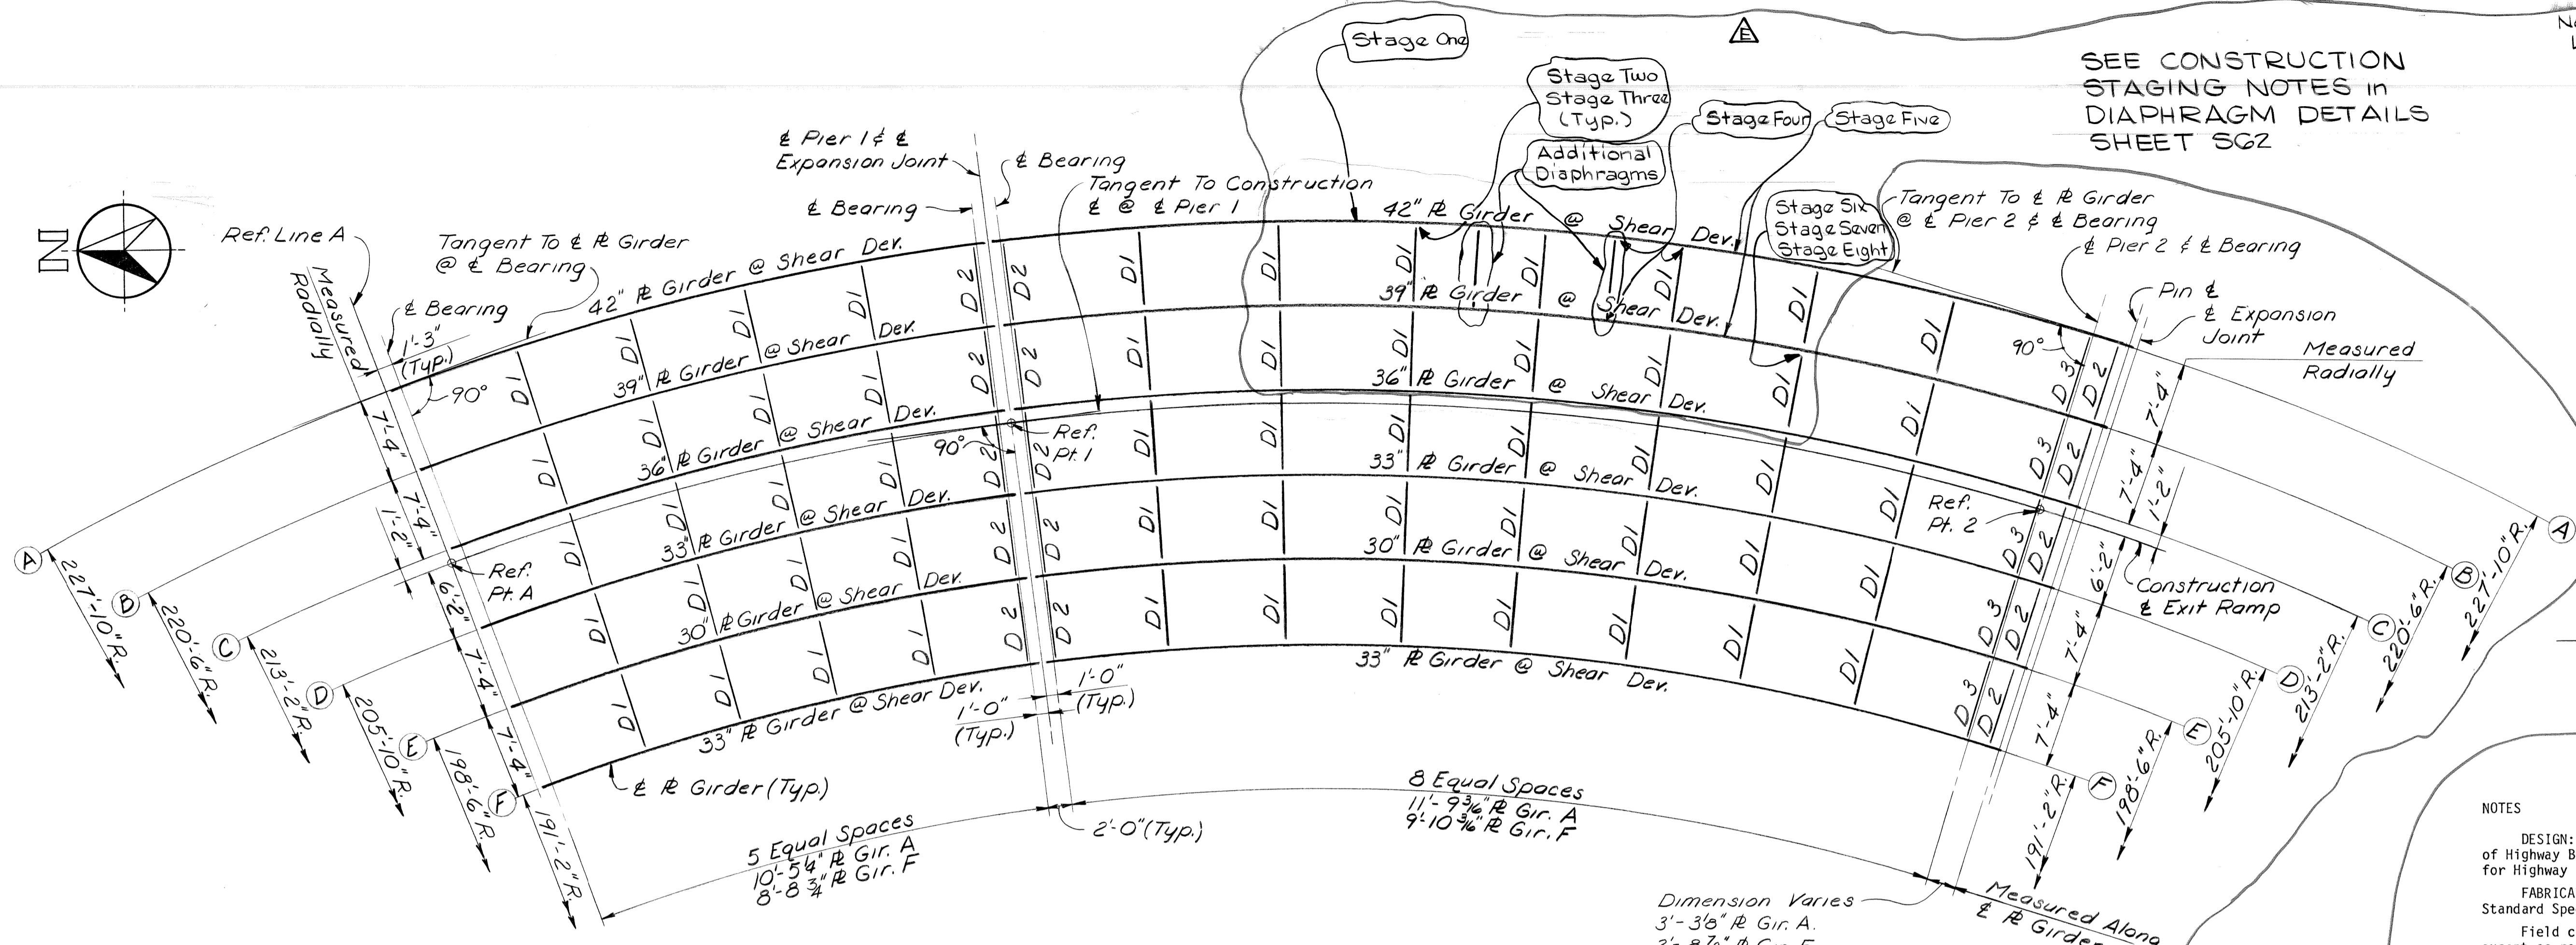

NOTES

DESIGN: Michigan Department of State Highways Specifications for Design of Highway Bridges - 1958 Edition and current AASHTO Standard Specifications for Highway Bridges. HS25 Loading.

FABRICATION: Michigan Department of State Highways and Transportation Standard Specifications for Highway Construction - 1976 Edition.

Field connections shall be bolted with 3/4 inch high-strength bolts except as noted.

The girders are to have a parabolic camber with ordinates as shown on the camber diagrams. Heating is to be used, if necessary, to assure camber permanency within the tolerance specified in the AWS Specifications. The dead load deflection of the girders alone, with all steel erected, is as shown on the camber diagram.

Studs shall be omitted from bolted splice plates.

Structural steel shall be painted. Painting of the structural steel shall be in accordance with the Special Provision for Shop Cleaning, Shop Painting, Field Repair and Top Coating Structural Steel.

Anchor bolt and position dowel lengths shown are minimum. Bolts or dowels longer than those shown may be furnished at no additional cost.

The minimum size of weld is to be 1/4 inch unless otherwise shown on the Plans.

Structural steel shall conform to ASTM A-588 except that steel for galvanized portions of bearings may be ASTM A-36.

Steel for pins shall be ASTM A-588, ASTM A-235 (Class G) or ASTM A-108 having a minimum yield point of 50,000 p.s.i.

The fabricator shall fabricate the girders in Span 1 thru 6 straight and curve to the proper radius by heating. The procedure shall conform to the requirements of the current AASHTO Specifications, except that continuous heating will not be allowed. If the Fabricator elects not to use heating for curving the girders to the proper radius in spans 1 thru 6, then an adjusted Camber Table must be obtained from the Design Office of Snell Environmental Group, Inc., 1120 May Street, Lansing, Michigan 48906.

Elastomer for Elastomeric Bearing Pads shall be nominal 50 durometer hardness for expansion bearings and 70 durometer hardness for fixed bearings. The design of these pads is based on a maximum pressure of 500 p.s.i. D.L. and 800 p.s.i. D.L. + L.L.

The quantity Structural Steel includes:

A-588 Steel 1,170,000 lbs. Total

CAMBER ORDINATES

Girder	Dimension	SPAN 1					SPAN 2				Pin
		a	b	c	d	e	f	g	h	j	
A	Stage 1	1 1/2"	2"	1 1/2"	3 1/2"	5 1/2"	6 1/2"	5 1/2"	3 1/2"	-1/8"	
	Stage 2	1 1/4"	1 1/2"	1 1/2"	3 1/2"	5 1/2"	5 1/2"	5 1/2"	3 1/2"	-1/8"	
B	Stage 1	1 1/2"	2"	1 1/2"	3 1/2"	5 1/2"	6"	5 1/2"	3 1/2"	-1/8"	
	Stage 2	1 1/4"	1 1/2"	1 1/2"	3 1/2"	5 1/2"	5 1/2"	5 1/2"	3 1/2"	-3/8"	
C	Stage 1	1 1/2"	1 3/4"	1 1/2"	3 1/2"	5 1/2"	6 1/4"	5 1/2"	3 1/2"	-1/2"	
	Stage 2	1 1/4"	1 1/2"	1 1/2"	3 1/2"	5 1/2"	5 3/8"	5 1/2"	3 1/2"	-1/8"	
D	Stage 1	1 1/2"	1 3/4"	1 1/2"	3 1/2"	5 1/2"	6"	5 1/2"	3 1/2"	-5/16"	
	Stage 2	1 1/4"	1 1/2"	1 1/2"	3 1/2"	5 1/2"	5 1/2"	5 1/2"	3 1/2"	-1/4"	
E	Stage 1	1 1/2"	1 3/4"	1 1/2"	3 1/2"	5 1/2"	5 3/4"	5 1/2"	3 1/2"	+1/8"	
	Stage 2	1 1/4"	1 1/2"	1 1/2"	3 1/2"	5 1/2"	5 3/8"	5 1/2"	3 1/2"	+3/16"	
F	Stage 1	1 1/2"	1 1/2"	1 1/2"	2 3/4"	4 1/4"	4 1/4"	4 1/4"	2 3/4"	+3/8"	
	Stage 2	1 1/4"	1 1/2"	1 1/2"	2 3/4"	4 1/4"	4 1/4"	4 1/4"	2 3/4"	+1 3/16"	

STRUCTURAL STEEL QUANTITIES		
ITEM	UNIT	AMOUNT
STRUCTURAL STEEL-FURNISHING & FABRICATING (A588 PLATE)	Lbs.	1,170,000
STRUCTURAL STEEL-ERECTED (A588 PLATE)	Lbs.	1,170,000
3/4" Elastomeric Bearing	Sq. Ft.	37
1" Elastomeric Bearing	Sq. Ft.	32
1 1/2" Elastomeric Bearing	Sq. Ft.	5
2" Elastomeric Bearing	Sq. Ft.	12
2 1/4" Elastomeric Bearing	Sq. Ft.	6
3" Elastomeric Bearing	Sq. Ft.	25
3 3/8" Elastomeric Bearing	Sq. Ft.	16
4" Elastomeric Bearing	Sq. Ft.	6
5 1/2" Elastomeric Bearing	Sq. Ft.	6
Shear Developers	Lump	Sum
Field Painting	Tons	S85

Stage 1 - Camber measured with R girder lying on its side. Heating is to be used, if necessary, to assure camber permanency within the tolerance specified in the AWS Specifications.

Stage 2 - R girders erected with diaphragms in place, no other loads applied. Camber includes allowances for: forms, deck concrete, steel reinforcement, V.C., and railings.

2 Required Span 2
2 Required Span 3
(See Span 3 Erection Diagram)

DSGN BY: SJP, RGW	REVISIONS: Add additional diaphragm details SJP/2/2/10
DRN BY: LDM, MH	
CHK'D BY: SJP, RGW	
APP'D BY:	

CITY OF DETROIT, MICHIGAN



Work This Sheet With Sheets# S50 thru S62

JOHN C. LODGE EXIT RAMP AND JEFFERSON AVENUE-RECONSTRUCTION AT THE JOE LOUIS ARENA.



STRUCTURAL STEEL DETAILS
ERECTION DIAGRAM AND CAMBERS
SPANS 1 AND 2

DATE: August, 1979

SCALE: NONE

DRN. NO: S49



SEE ADDITIONAL DIAPHRAGM DETAILS SHEET S49 & CONSTRUCTION STAGING NOTES SHEET S62.

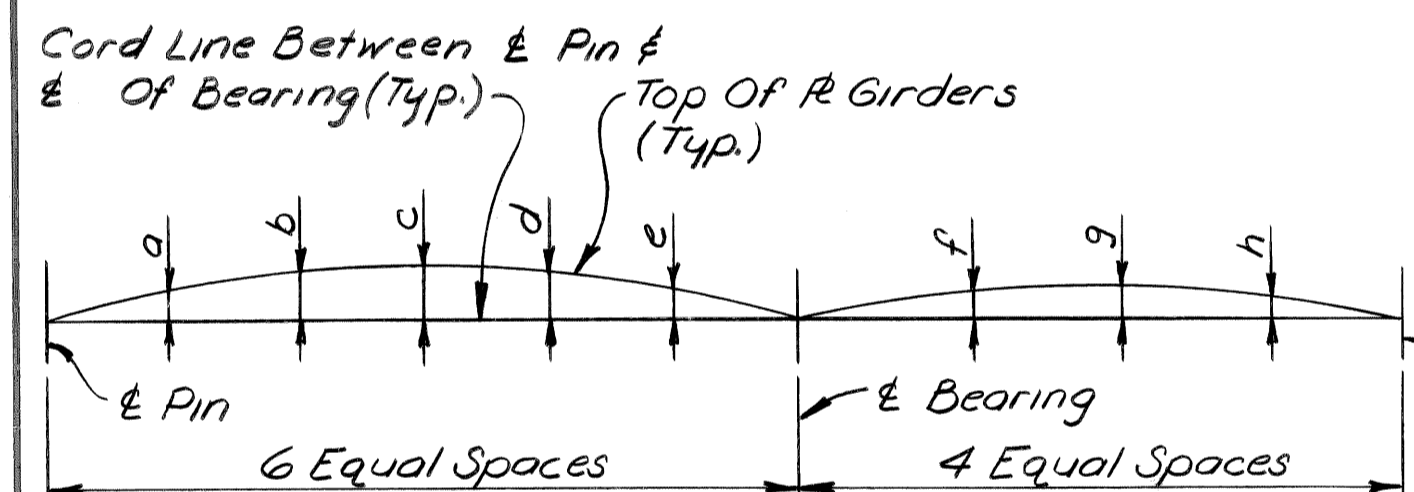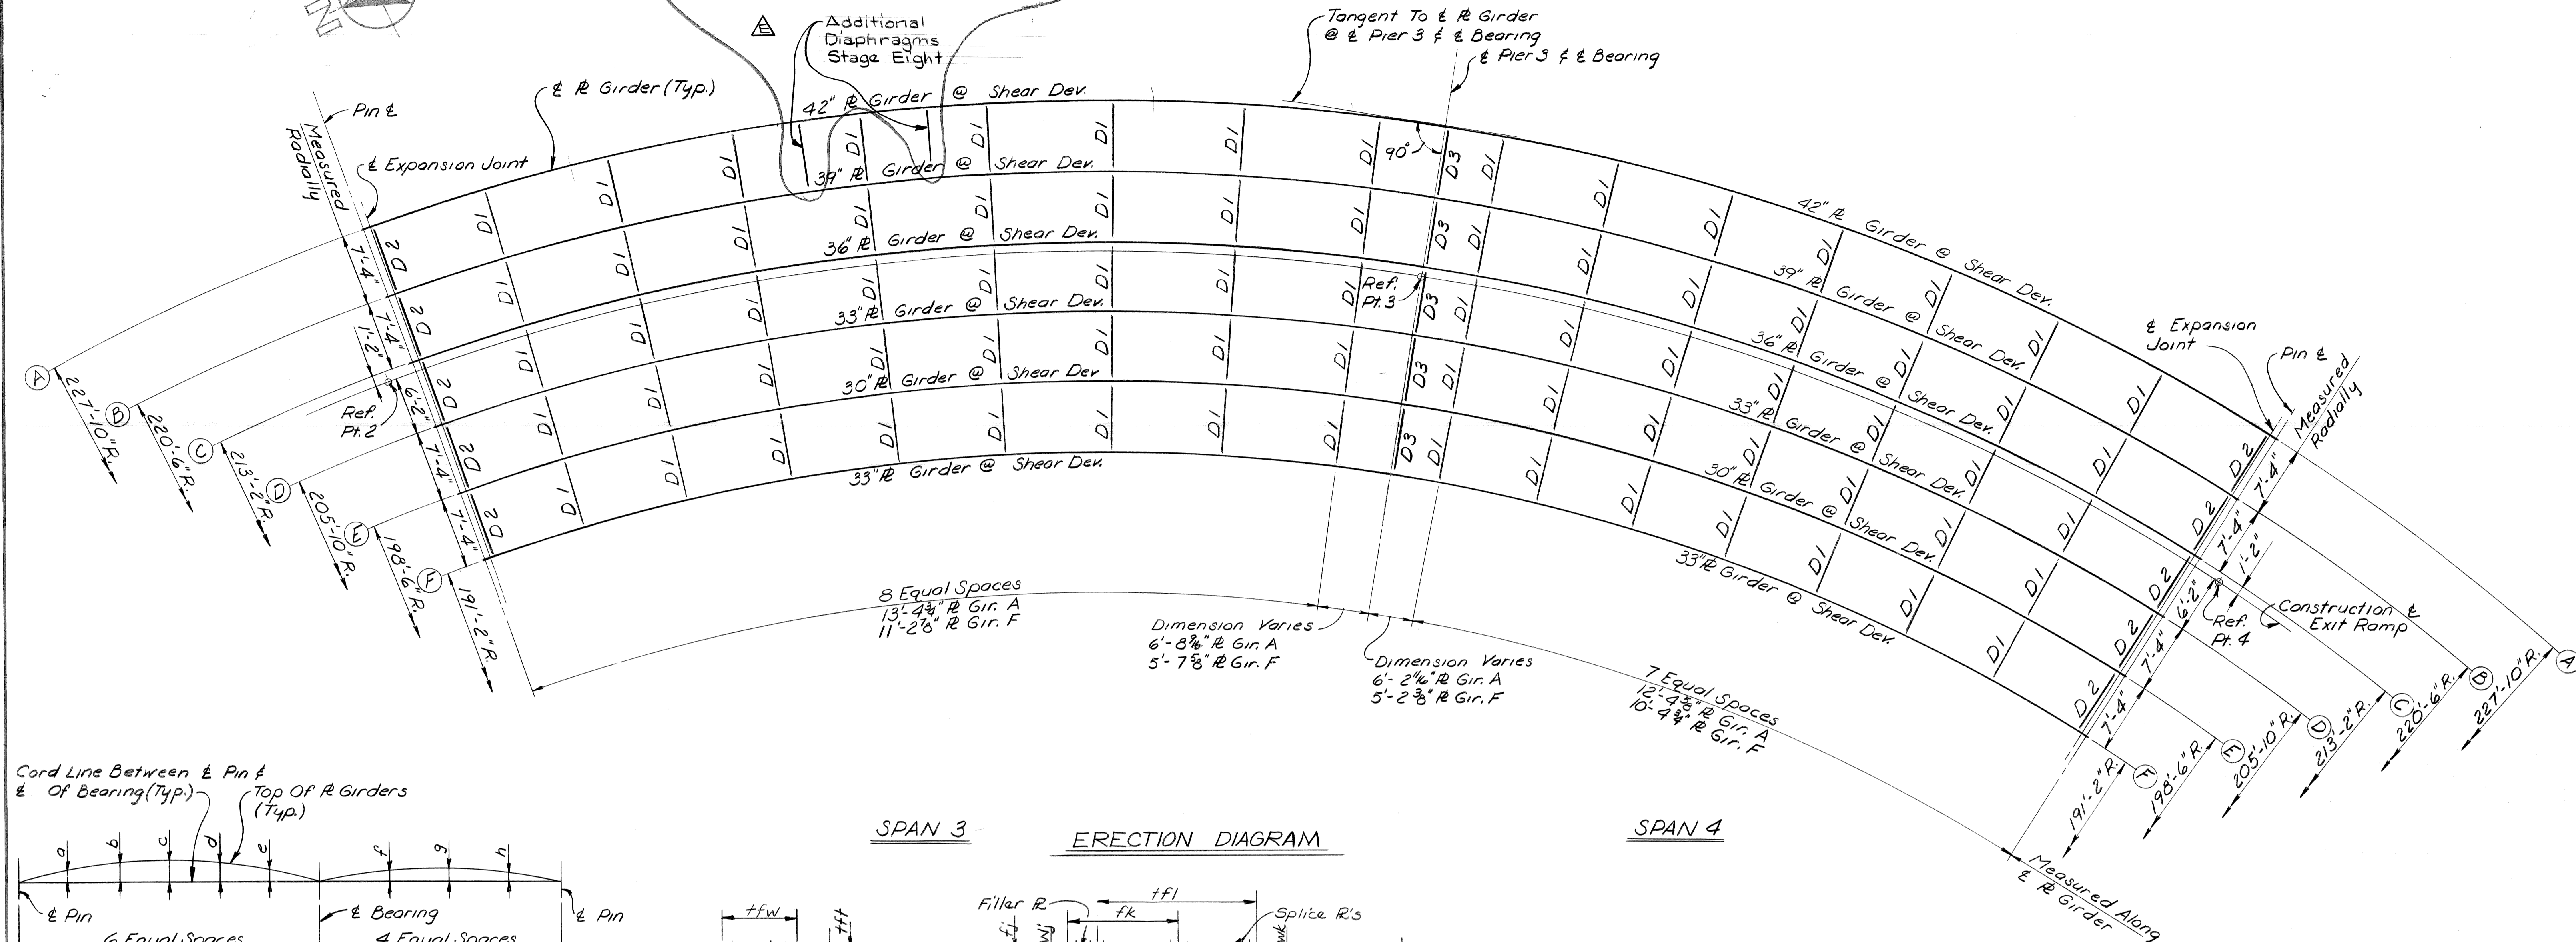

CAMBER DIAGRAM

Stage 1 - Camber measured with R girder lying on its side. Heating is to be used, if necessary, to assure camber permanency within the tolerance specified in the AWS Specifications.
 Stage 2 - R girders erected with diaphragms in place, no other loads applied. Camber includes allowances for: forms, deck concrete, steel reinforcement, V.C., and railings.


Dimension		SPAN 3				SPAN 4			
Girder		a	b	c	d	e	f	g	h
A	Stage 1	3 7/8"	6 3/8"	7 1/4"	6 1/2"	4"	1 5/8"	2 3/4"	2 1/4"
	Stage 2								
B	Stage 1	3 3/4"	6 1/8"	7 1/8"	6 1/4"	4"	1 7/8"	3 1/4"	2 1/2"
	Stage 2								
C	Stage 1	3 7/8"	6 3/8"	7 3/8"	6 1/2"	4 1/8"	1 7/8"	3 1/4"	2 5/8"
	Stage 2								
D	Stage 1	4"	6 1/2"	7 3/8"	6 5/8"	4 1/8"	2"	3 1/4"	2 5/8"
	Stage 2								
E	Stage 1	4"	6 1/2"	7 3/8"	6 5/8"	4 1/8"	2"	3 1/4"	2 5/8"
	Stage 2								
F	Stage 1	3 1/2"	5 3/4"	6 5/8"	5 5/8"	3 3/4"	1 3/4"	2 3/4"	2 1/4"
	Stage 2								

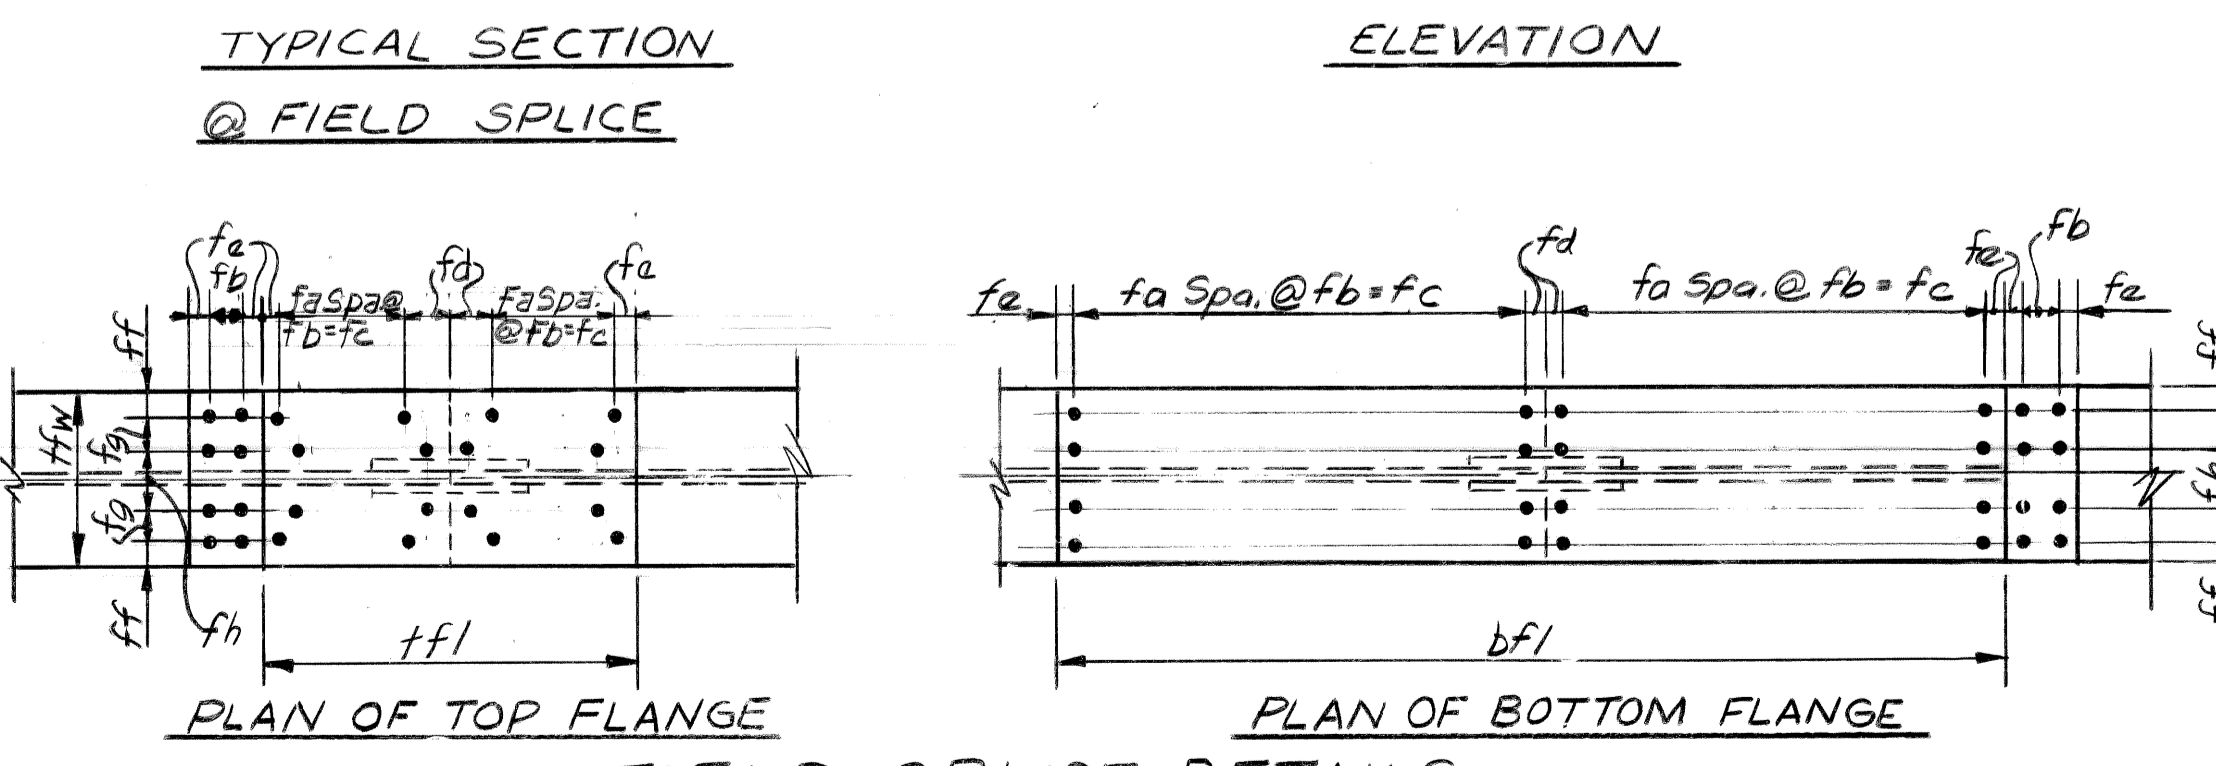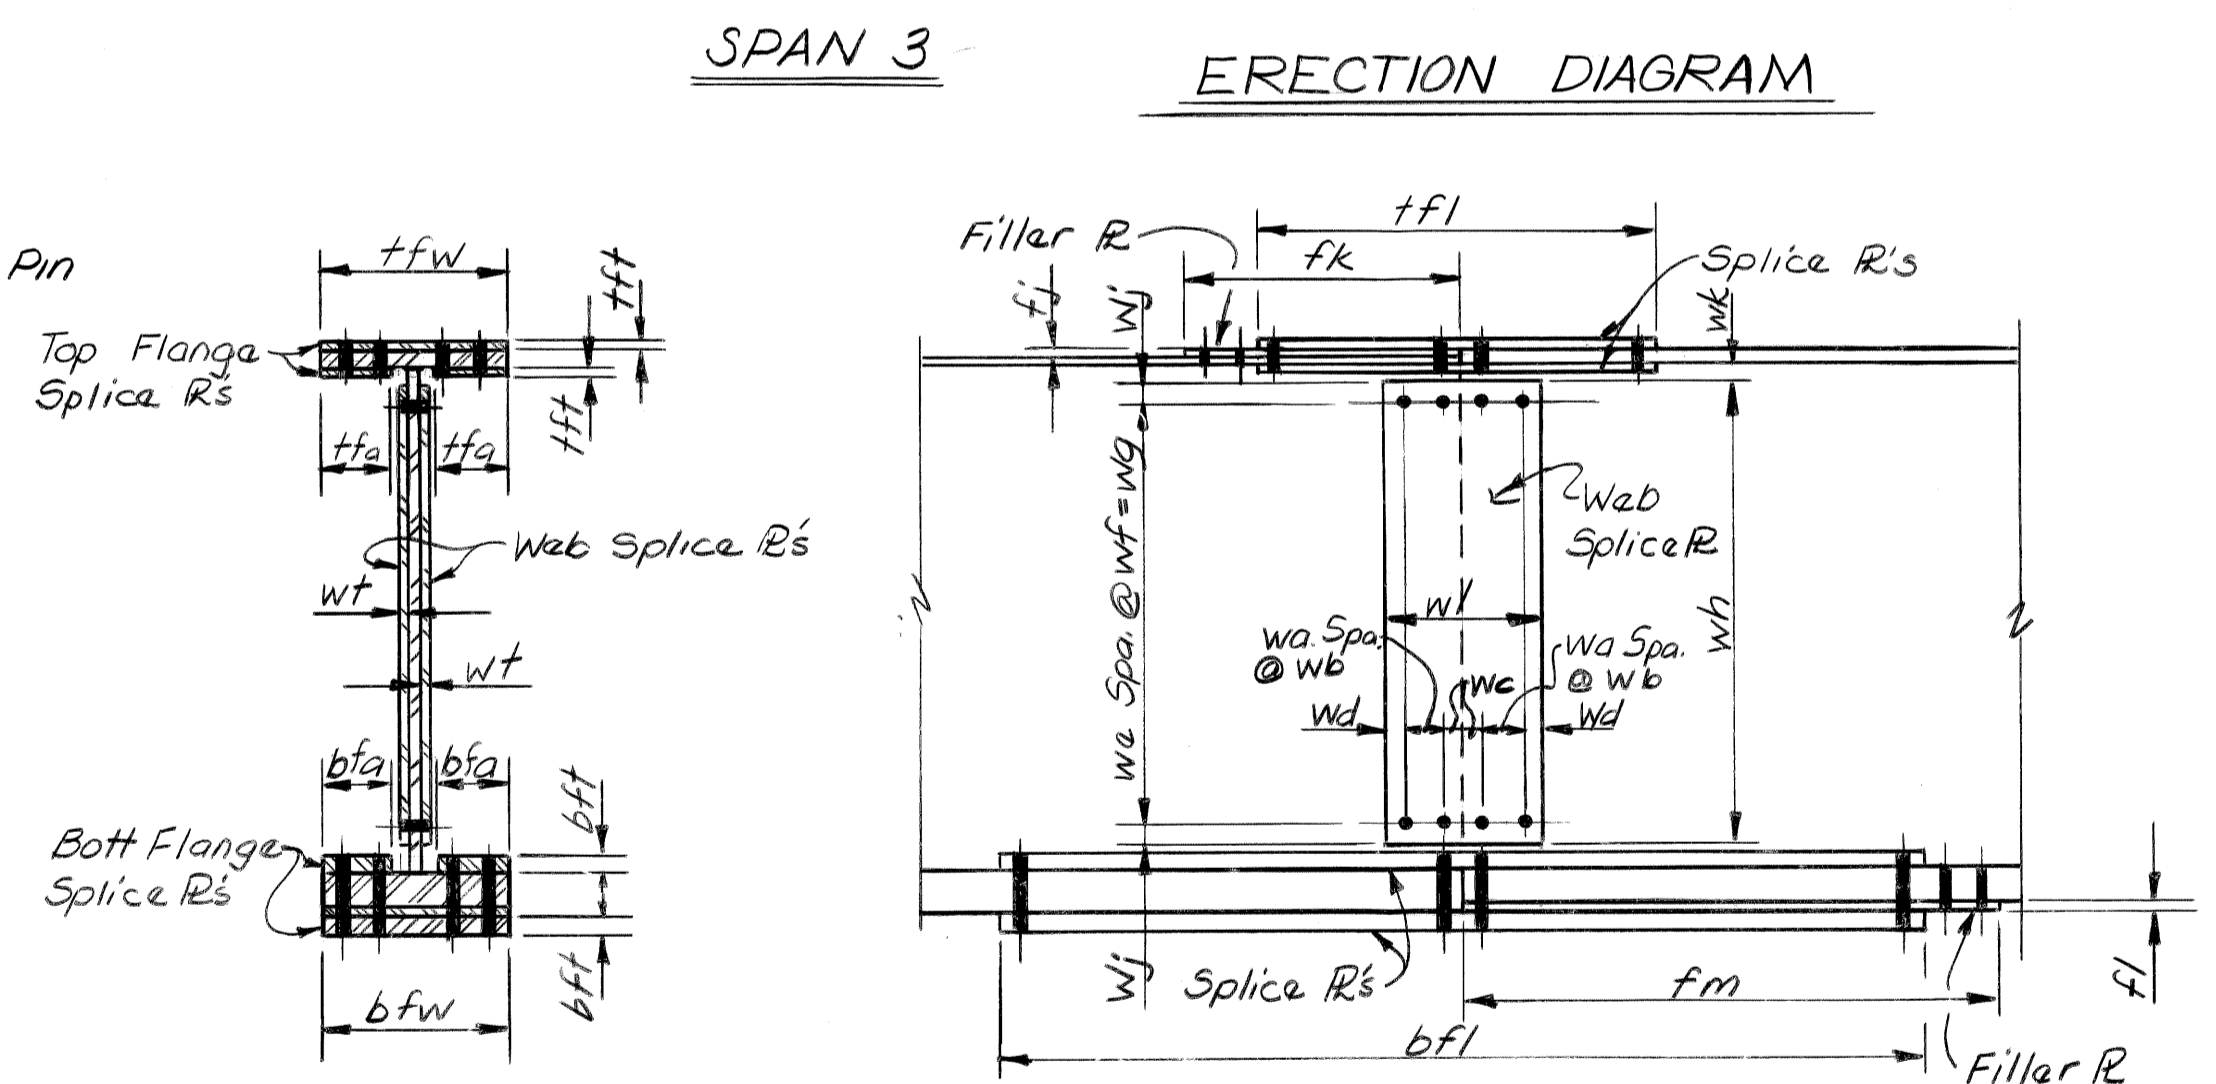

FIELD SPLICE DIMENSIONS							
Dim	Girder	A	B	C	D	E	F
TOP FLANGE	ffa	6 1/2"	5"	5"	5"	5"	5"
	ffl	9 1/4"	7 1/2"	2 1/2"	2 1/2"	2 1/2"	2 1/2"
	ffw	1 1/2"	1 1/2"	1 1/2"	1 1/2"	1 1/2"	1 1/2"
	fff	3 5/8"	3 5/8"	3 5/8"	3 5/8"	3 5/8"	3 5/8"
	fo	5"	5"	5"	5"	5"	5"
	fb	3 1/2"	5"	5"	5"	5"	5"
	fc	1 1/2"	3 1/4"	10"	10"	10"	10"
	fd	3 1/2"	1 3/4"	4 1/4"	1 3/4"	1 3/4"	1 3/4"
	fe	1 1/2"	1 1/4"	1 1/4"	1 1/4"	1 1/4"	1 1/4"
	ff	2 1/4"	2"	2"	2"	2"	2"
	fg	2 3/4"	1 3/4"	1 3/4"	1 3/4"	1 3/4"	1 3/4"
	fh	5"	4 1/2"	4 1/2"	4 1/2"	4 1/2"	4 1/2"
	fk	2 1/2"	4 1/2"	1 1/2"	1 1/2"	1 1/2"	1 1/2"
	fi	1 1/2"	1 1/2"	1 1/2"	1 1/2"	1 1/2"	1 1/2"
WEB	wa@wb	2 @ 3"	2 @ 2 1/2"	2 @ 2 1/2"	2 @ 2 1/2"	1 @ 2 1/2"	1 @ 2 1/2"
	wc	2"	1 3/4"	1 3/4"	1 3/4"	1 3/4"	1 3/4"
	wd	1 1/2"	1 1/4"	1 1/4"	1 1/4"	1 1/4"	1 1/4"
	we	10"	10"	9"	9"	9"	11"
	wf	3 1/2"	3 1/4"	3 1/2"	3 1/4"	3 1/4"	2 1/2"
	wg	2 1/2"	2 1/2"	2 1/2"	2 1/2"	2 1/2"	2 1/2"
	wh	3 1/2"	2 1/2"	2 1/2"	2 1/2"	2 1/2"	2 1/2"
	wj	1 1/2"	1 1/4"	1 1/4"	1 1/4"	1 1/4"	1 1/4"
	wk	2"	2"	2"	2"	2"	2"
	wl	1 1/2"	1 1/4"	1 1/4"	1 1/4"	1 1/4"	1 1/4"
	wt	3 1/2"	3 1/2"	3 1/2"	3 1/2"	3 1/2"	3 1/2"
	wf@	6 1/2"	6 1/2"	6 1/2"	6 1/2"	6 1/2"	6 1/2"
	bf	4 1/2"	5 1/2"	4 1/2"	4 1/2"	4 1/2"	3 1/2"
	bft	1"	1"	1"	1"	1"	1"
bfl	1 1/2"	1 1/2"	1 1/2"	1 1/2"	1 1/2"	1 1/2"	
BOTT FLANGE	fb	3"	2 1/2"	2 1/2"	2 1/2"	2 1/2"	2 1/2"
	fc	2 1/2"	2 1/2"	2 1/2"	2 1/2"	2 1/2"	1 1/2"
	fd	2"	1 3/4"	1 3/4"	1 3/4"	1 3/4"	1 3/4"
	fe	1 1/2"	1 1/4"	1 1/4"	1 1/4"	1 1/4"	1 1/4"
	ff	1 3/4"	1 3/4"	1 3/4"	1 3/4"	1 3/4"	1 1/2"
	fg	3"	3"	3"	3"	3"	2 1/2"
	fh	5 1/2"	5 1/2"	5 1/2"	5 1/2"	5 1/2"	5"
	fi	1 1/2"	1 1/2"	N/A	1 1/2"	1 1/2"	1 1/2"
	fm	2 1/2"	2 1/2"	N/A	2 1/2"	2 1/2"	2 1/2"
	Bolt Size	7/8"	3/4"	3/4"	3/4"	3/4"	3/4"

Work This Sheet With Sheets# S49, S50 & S52 thru S62

DATE: August, 1979

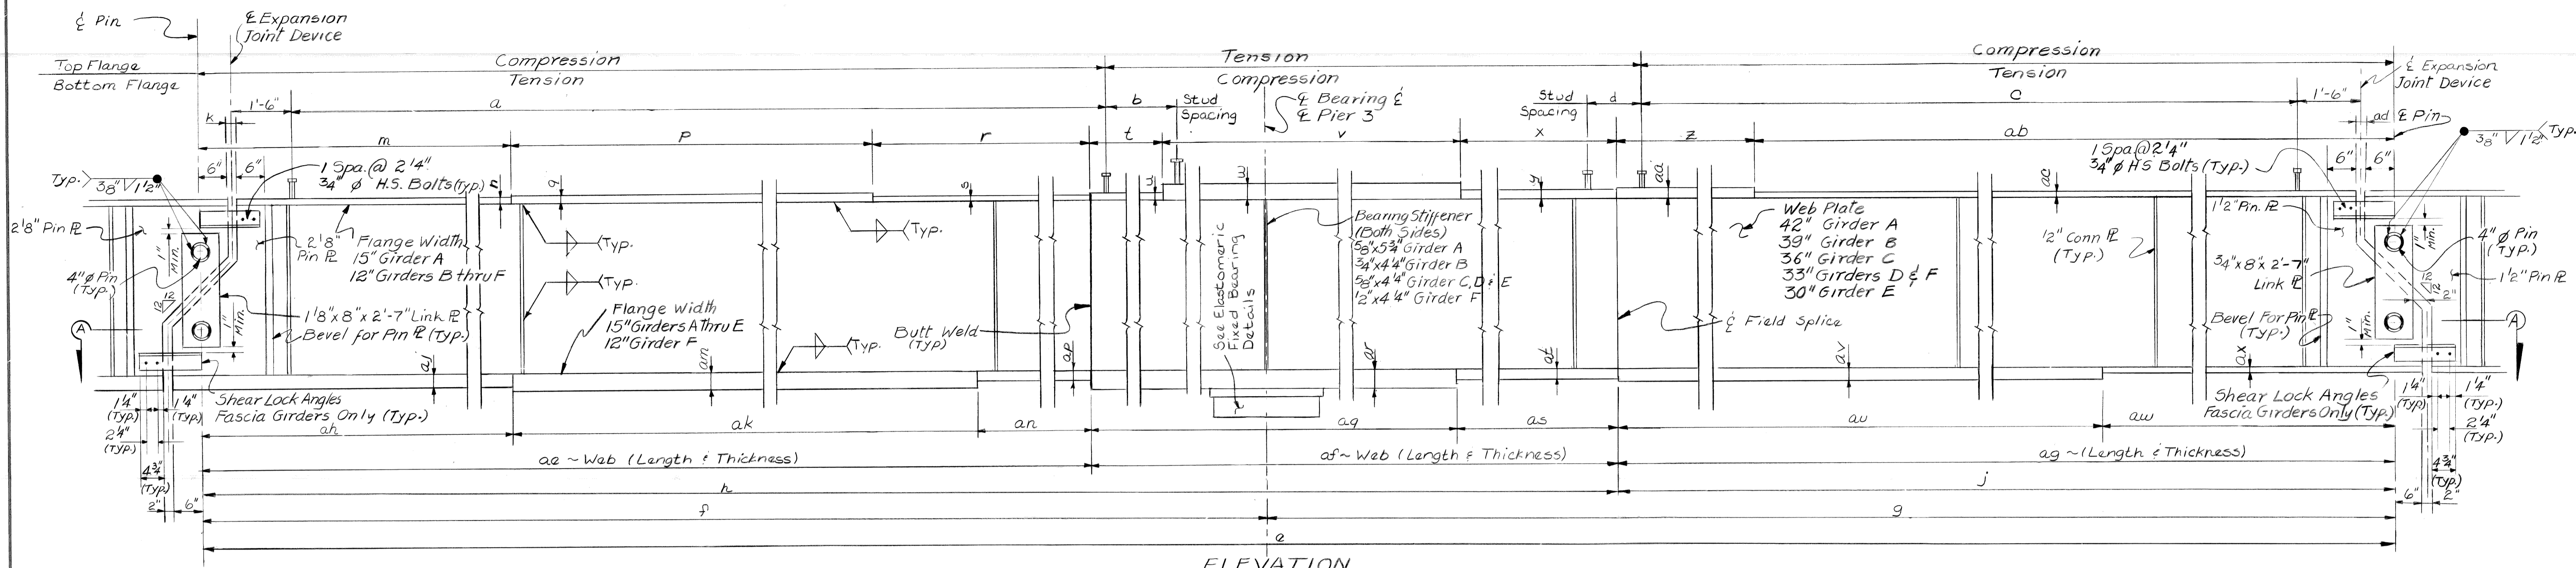


ELEVATION

Dimensions are measured along respective Girder E's

SPAN 3

SPAN 4

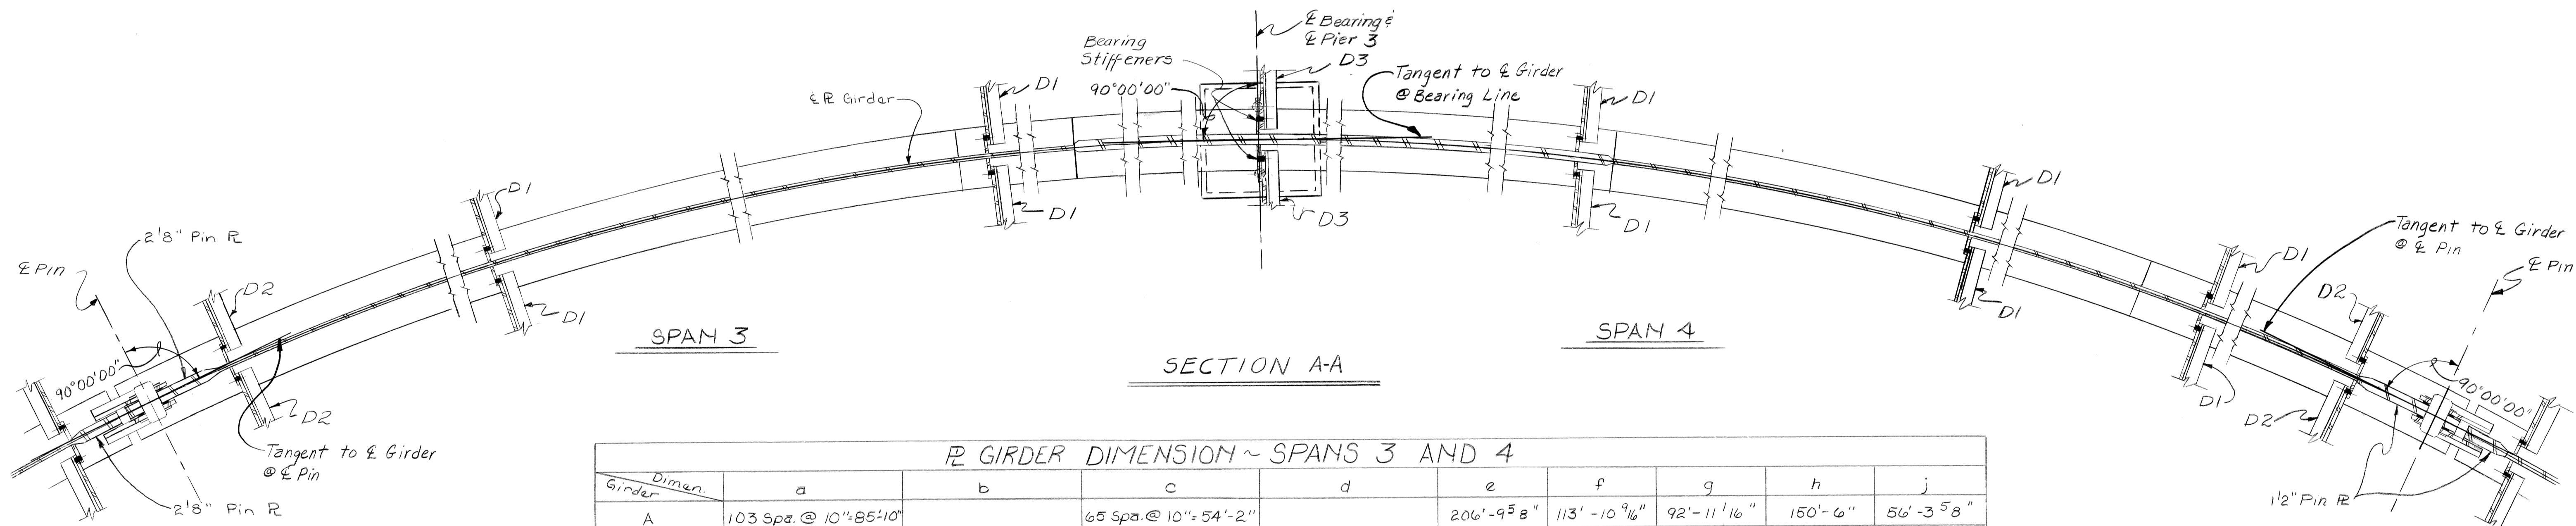

SECTION A-A

R GIRDER DIMENSION ~ SPANS 3 AND 4

Girder	Dimen.	a	b	c	d	e	f	g	h	j
A		103 Spa. @ 10" = 85'-10"		65 Spa. @ 10" = 54'-2"		206'-9 5/8"	113'-10 9/16"	92'-11 1/16"	150'-0"	56'-3 5/8"
B		99 Spa. @ 10" = 82'-6"		64 Spa. @ 10" = 53'-4"		200'-1 3/4"	110'-2 9/16"	89'-11 3/16"	145'-6"	54'-7 3/4"
C		95 Spa. @ 10" = 79'-2"	5 Spa. @ 6" = 2'-6"	69 Spa. @ 9" = 51'-9"	5 Spa. @ 6" = 2'-6"	193'-5 13/16"	106'-6 9/16"	86'-11 1/4"	140'-2"	53'-3 1/4"
D		100 Spa. @ 9" = 75'-0"		68 Spa. @ 9" = 51'-0"		186'-9 15/16"	102'-10 9/16"	83'-11 3/8"	134'-0"	52'-9 5/16"
E		95 Spa. @ 9" = 71'-3"		76 Spa. @ 8" = 50'-8"		180'-2 1/8"	99'-2 5/8"	80'-11 1/2"	123'-0"	57'-2 1/8"
F		92 Spa. @ 9" = 69'-0"		69 Spa. @ 9" = 51'-9"		173'-6 1/4"	95'-6 5/8"	77'-11 5/8"	118'-5"	55'-1 1/4"


N/A : Denotes Not Applicable

R GIRDER DIMENSIONS ~ SPANS 3 AND 4 (CONTINUED)

Dimen. Girder	k	m	n	p	q	r	s	t	u	v	w	x	y	z	aa	ab	ac	ad	ae	af	ag	ah	aj	ak	am	an	ap	aq	ar	as	at	au	av	aw	ax
A	6 1/2"	21'-9 1/2"	1"	44'-0"	1 1/2"	21'-9"	1"	11'-9"	1 3/8"	30'-3"	2 3/4"	20'-11 1/2"	1 1/2"	6'-9"	1 5/8"	49'-6 5/8"	1"	6 1/2"	87'-6 1/2" x 12"	62'-11 1/2" x 9 1/16"	56'-3 5/8" x 12"	19'-4 1/2" x 2 1/8"	53'-3"	3 3/8"	14'-11"	2 1/4"	45'-1"	3 3/8"	17'-10 1/2"	2 1/8"	52'-0"	2 1/4"	24'-3 5/8"	1 3/8"	
B	5 7/8"	83'-9 9/16"	1 3/4"					11'-7"	1 3/4"	29'-11"	3 5/8"	20'-2 7/16"	1 7/8"	5'-6"	2"	49'-1 3/4"	1 1/4"	5 7/8"	83'-9 9/16" x 12"	61'-8 7/16" x 12"	54'-7 3/4" x 7 1/16"	18'-5 9/16" x 1 7/8"	65'-4"	3"			42'-11"	3 1/8"	18'-9 7/16"	2 1/8"	33'-2"	2 3/8"	21'-5 3/4"	1 1/2"	
C	5 5/8"	80'-1 9/16"	1 3/8"	N/A	N/A	N/A	N/A	11'-4"	1 5/8"	29'-4"	3 1/4"	19'-4 7/16"	1 3/4"			53'-3 13/16"	5 8"	5 5/8"	80'-1 9/16" x 12"	60'-0 7/16" x 12"	53'-3 13/16" x 7 1/16"	16'-11 9/16" x 1 5/8"	63'-2"	2 3/4"	N/A	N/A	41'-10"	3"	18'-2 7/16"	2"	36'-0"	2"	17'-3 15/16"	1 1/4"	
D	4 1/16"	76'-7 9/16"	1 1/8"					12'-0"	1 5/8"	27'-6"	3 1/4"	17'-10 7/16"	1 3/4"			52'-9 15/16"	1 2"	4 1/16"	76'-7 9/16" x 12"	57'-4 7/16" x 12"	52'-9 15/16" x 7 1/16"	16'-8 9/16" x 1 1/2"	59'-11"	2 3/8"	N/A	N/A	39'-7"	3"	17'-9 7/16"	2"	37'-6"	1 7/8"	15'-3 15/16"	1 1/8"	
E	4 1/8"	72'-10 3/8"	7 8"					11'-11 13/16"	1 5/8"	38'-1 3/8"	3 1/4"					57'-2 1/8"	1 2"	4 1/8"	72'-10 3/8" x 12"	50'-1 3/16" x 7 1/16"	57'-2 1/8" x 3 8"	16'-1 13/16" x 1 3/8"	56'-9"	2 1/4"			50'-1 3/16"	3"		N/A	N/A	42'-6"	1 7/8"	14'-8 1/8"	1 1/8"
F	3 1/2"	70'-3 9/16"	1 1/2"					15'-7 1/16"	1 1/4"	32'-6 3/8"	2 3/8"					55'-1 1/4"	1 2"	3 1/2"	70'-3 9/16" x 12"	48'-1 7/16" x 12"	55'-1 1/4" x 7 1/16"	70'-3 9/16" x 2 1/8"	N/A	N/A			48'-1 7/16"	3"		N/A	N/A	N/A	N/A	55'-1 1/4"	1 3/4"


Work This Sheet With Sheets # S40 thru S51 & S53 thru S62

DATE: August, 1979

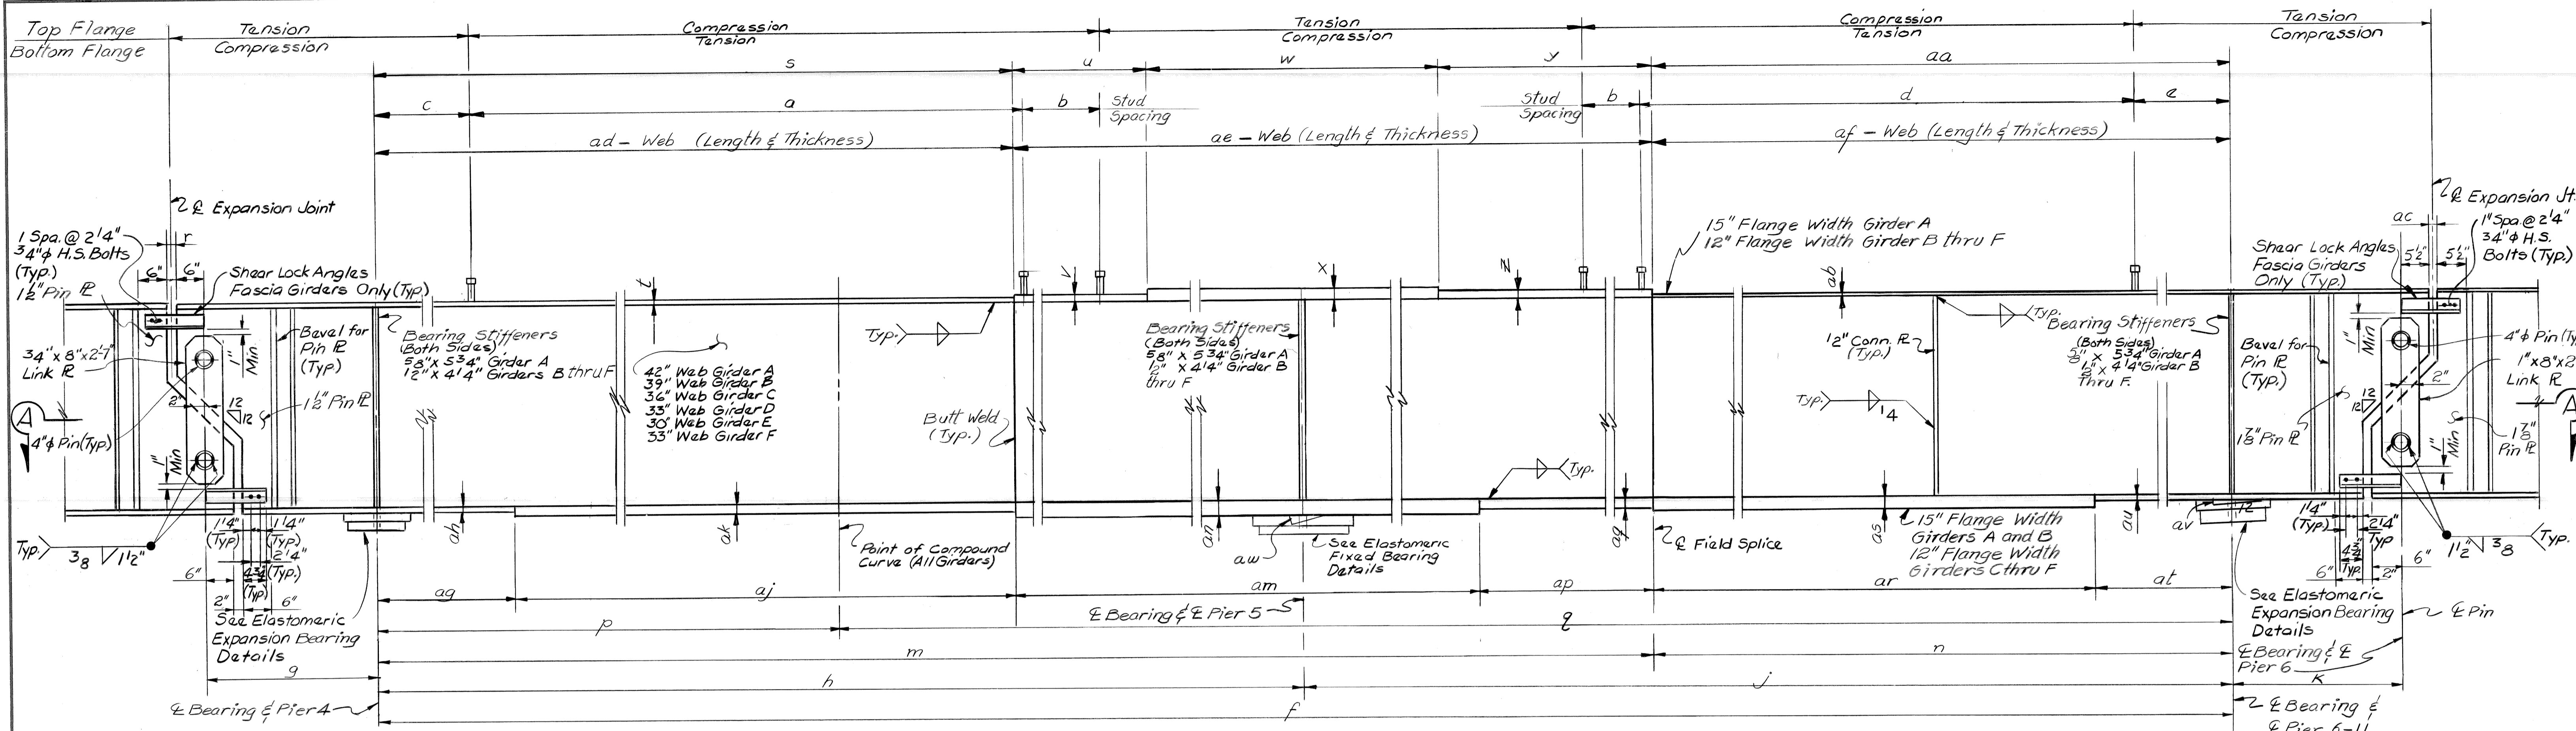

ELEVATION
Dimensions are measured along respective girder R's

NOTE: Girder ends are to be vertical in final position

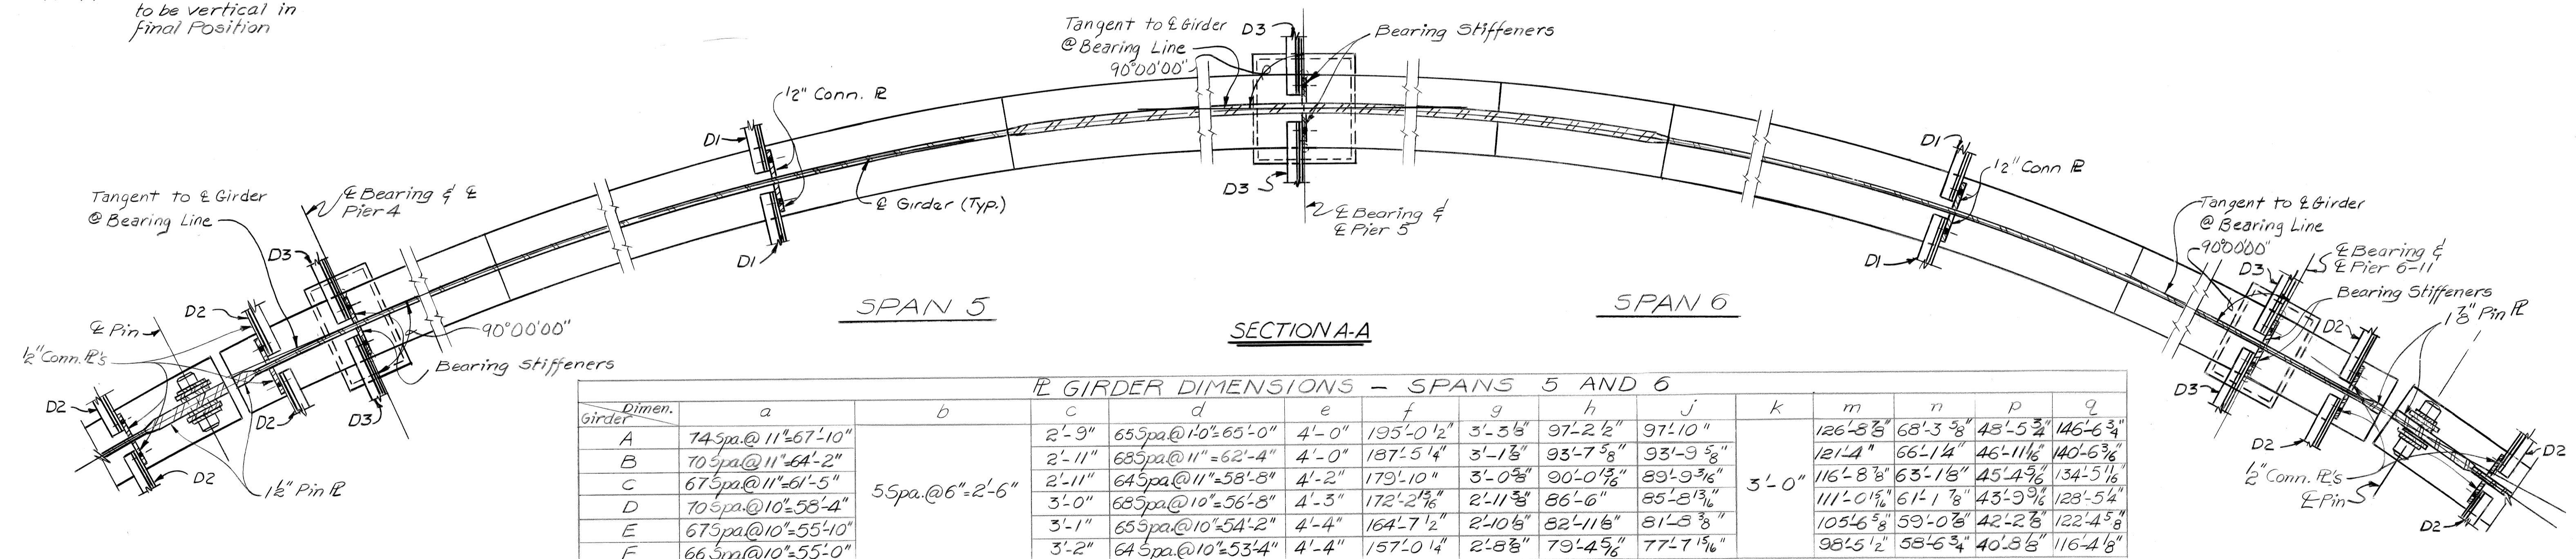

SECTION A-A

W GIRDER DIMENSIONS - SPANS 5 AND 6

Dimen. Girder	a	b	c	d	e	f	g	h	j	k	m	n	p	q
A	74 Spa @ 11" = 67'-10"	5 Spa @ 6" = 2'-6"	2'-9"	65 Spa @ 10" = 65'-0"	4'-0"	195'-0 1/2"	3'-3 3/8"	97'-2 1/2"	97'-10"	3'-0"	126'-8 3/8"	68'-3 5/8"	48'-5 3/4"	146'-6 3/4"
B	70 Spa @ 11" = 64'-2"		2'-11"	68 Spa @ 11" = 62'-4"	4'-0"	187'-5 1/4"	3'-1 1/8"	93'-7 5/8"	93'-9 5/8"		121'-4"	66'-1 1/4"	46'-11 1/2"	140'-6 3/8"
C	67 Spa @ 11" = 61'-5"		2'-11"	64 Spa @ 11" = 58'-8"	4'-2"	179'-10"	3'-0 3/8"	90'-0 1/2"	89'-9 3/8"		116'-8 8/8"	63'-1 1/8"	45'-4 3/8"	134'-5 1/8"
D	70 Spa @ 10" = 58'-4"		3'-0"	68 Spa @ 10" = 56'-8"	4'-3"	172'-2 1/2"	2'-11 3/8"	86'-6"	85'-8 13/16"		111'-0 1/2"	61'-1 7/8"	43'-9 9/16"	128'-5 4/8"
E	67 Spa @ 10" = 55'-10"		3'-1"	65 Spa @ 10" = 54'-2"	4'-4"	164'-7 1/2"	2'-10 8/8"	82'-11 6/8"	81'-8 3/8"		105'-6 5/8"	59'-0 3/8"	42'-2 3/8"	122'-4 5/8"
F	66 Spa @ 10" = 55'-0"		3'-2"	64 Spa @ 10" = 53'-4"	4'-4"	157'-0 1/4"	2'-8 8/8"	79'-4 5/8"	77'-7 15/16"		98'-5 1/2"	58'-6 3/4"	40'-8 8/8"	116'-4 8/8"

W GIRDER DIMENSIONS - SPANS 5 AND 6 (CONTINUED)

Dimen. Girder	r	s	t	u	v	w	x	y	z	aa	ab	ac	ad	ae	af	ag	ah	aj	ak	am	an	ap	aq	ar	as	at	au	av	aw
A	6 1/2"	70'-1 1/2"	3 1/4"	11'-8"	1 1/8"	32'-5"	2 1/4"	12'-6 3/8"	1 1/8"	68'-3 5/8"	3 1/4"		70'-1 1/2" x 1/2"	56'-7 3/8" x 1/2"	68'-3 5/8" x 1/2"	16'-9 1/2"	1 3/8"	53'-4"	2 1/4"	46'-11"	2 3/8"	9'-5 3/8"	1 1/2"	50'-10"	2 3/8"	17'-5 5/8"	1 3/8"	3 1/8"	0"
B	5 3/8"	67'-1 1/2"	7/8"	11'-1"	1 3/8"	31'-8"	2 3/4"	11'-5 1/2"	1 3/8"	66'-1 1/4"	3 1/4"		67'-1 1/2" x 1/2"	54'-2 1/2" x 1/2"	66'-1 1/4" x 1/2"	16'-3 1/2"	1 3/8"	50'-10"	2 1/4"	54'-2 1/2"	2 3/8"			50'-0"	2 1/4"	16'-1 1/4"	1 3/8"	3 1/8"	0"
C	5 5/8"	63'-10 3/4"	3 1/4"			36'-7"	2 3/8"	16'-3 1/8"	1 3/8"	63'-1 1/8"	3 1/4"		63'-10 3/4" x 7/16"	52'-10 1/8" x 1/2"	63'-1 1/8" x 7/16"	15'-1 3/4"	1 5/8"	48'-9"	2 3/8"	52'-10 1/8"	3 3/8"			48'-4"	2 1/2"	14'-9 3/8"	1 1/2"	1 1/8"	0"
D	4 1/16"	61'-3 1/2"	3 1/8"	N/A	N/A	49'-9"	2 1/2"			61'-2 3/8"	5 3/8"		61'-3 1/2" x 7/16"	49'-9" x 1/2"	61'-1 7/8" x 7/16"	61'-3 1/2"	2 3/8"	N/A	N/A	49'-9"	3 1/4"	N/A	N/A	45'-5"	2 3/8"	15'-8 7/8"	1 1/2"	0"	0"
E	4 1/8"	58'-11 1/8"	1 1/2"			46'-7 1/2"	2 3/8"	N/A	N/A	59'-0 1/8"	1 1/2"		58'-11 1/8" x 7/16"	46'-7 1/2" x 7/16"	59'-0 1/8" x 7/16"	13'-1 1/8"	1 3/8"	45'-10"	2 3/8"	46'-7 1/2"	3 5/8"			45'-6"	2 3/8"	13'-6 3/8"	1 3/8"	1 1/8"	0"
F	3 1/2"	57'-11 1/4"	1 1/2"			40'-6 1/4"	1 3/4"			58'-6 3/4"	1 1/2"		57'-11 1/4" x 7/16"	40'-6 1/4" x 7/16"	58'-6 3/4" x 7/16"	57'-11 1/4"	1 3/8"	N/A	N/A	40'-6 1/4"	2 3/8"			N/A	N/A	58'-6 3/4"	1 1/8"	0"	0"

Work This Sheet With Sheets # S49 thru S53 & S55 thru S62

DATE: August, 1979

DSGN BY: SJPRGW
DRN BY: MH
CK'D BY: SJP, Rgw
APP'D BY:

REVISIONS


CITY OF DETROIT, MICHIGAN

Snell Environmental Group
LANSING INDIANAPOLIS AKRON


JOHN C. LODGE EXIT RAMP AND JEFFERSON AVENUE-RECONSTRUCTION AT THE JOE LOUIS ARENA.

STRUCTURAL STEEL DETAILS
W GIRDER DETAILS SPANS 5 AND 6


SCALE: NONE
DRN. NO: S54

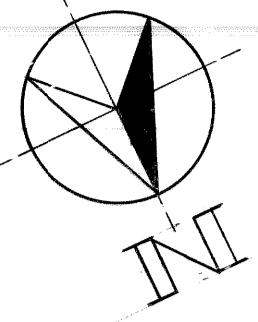

Angle/Girder	θ1	θ2	θ3	θ4
A	90°00'00"	45°18'39"	38°27'48"	81°37'40"
B	88°53'27"	46°25'12"	35°02'28"	73°28'05"
B-B	N.U.	N.U.	41°23'31"	67°07'01"
C	87°31'32"	47°47'07"	47°47'07"	44°17'29"
D	86°58'40"	48°19'59"	48°19'59"	44°50'21"
E	86°05'55"	49°12'44"	49°12'44"	45°43'05"
F	85°00'43"	50°17'56"	50°17'56"	46°48'17"

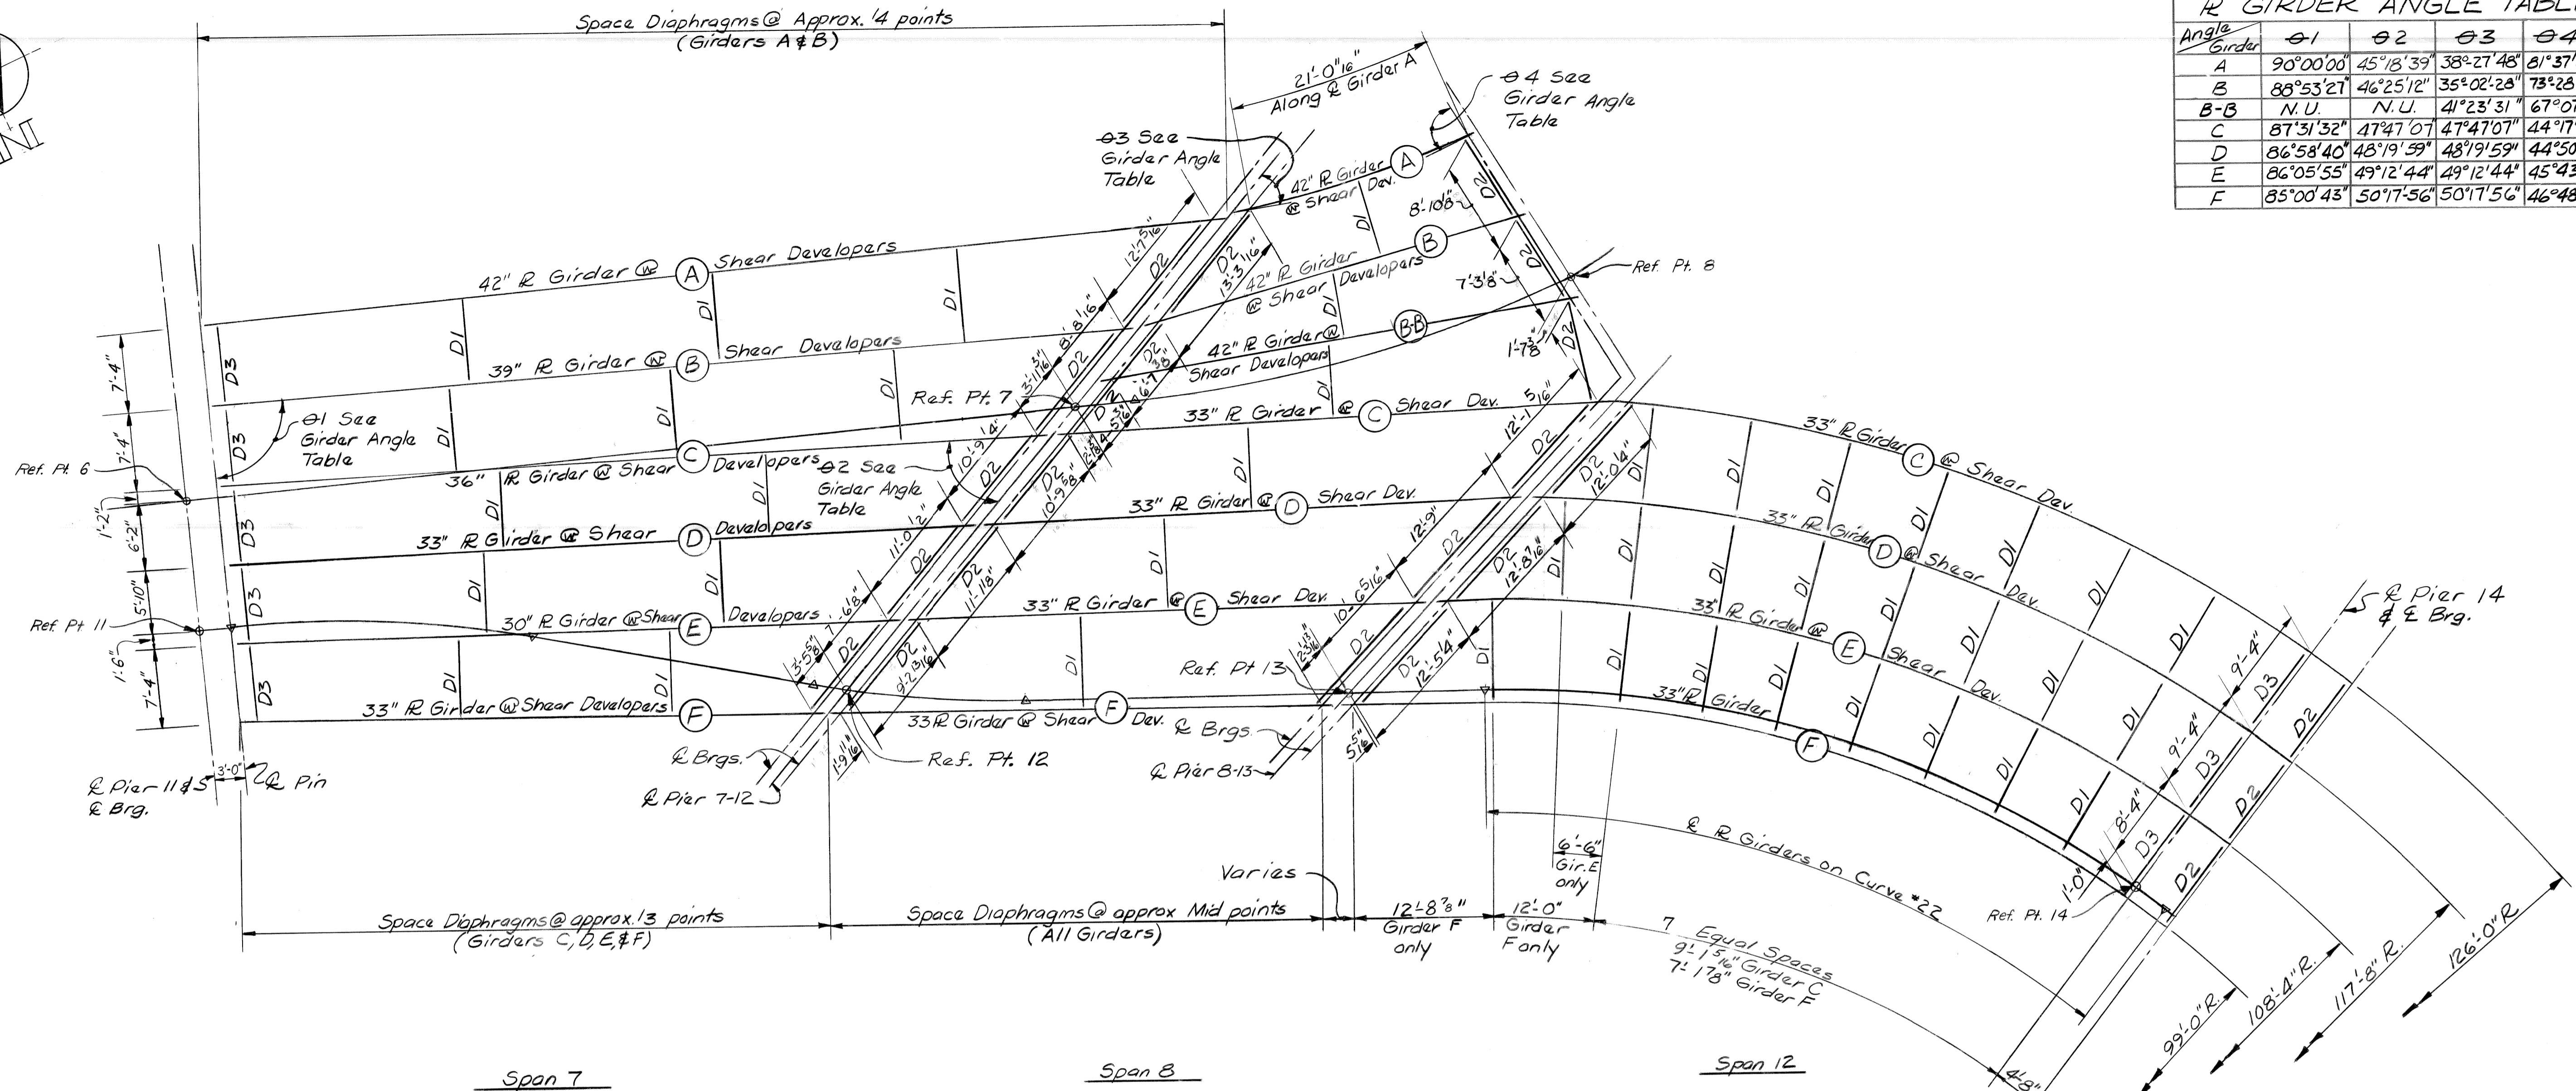

ERECTOR DIAGRAM

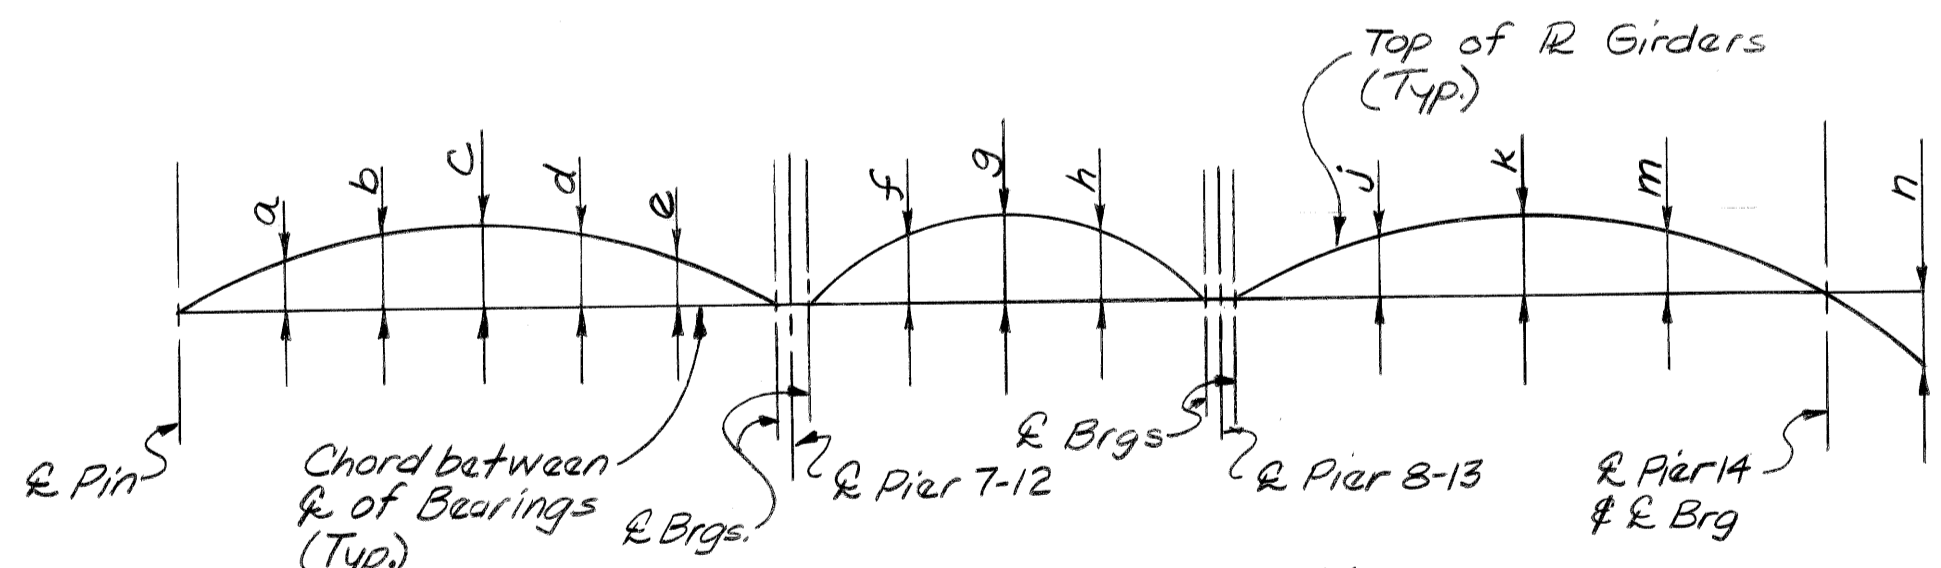

CAMBER DIAGRAM

Stage 1 - Camber is measured with R Girder lying on its side. Heating is to be used, if necessary, to assure camber permanency within the tolerance specified in the A.W.S. Specifications.

Stage 2 - R Girders erected with diaphragms in place, no other loads applied. Camber includes allowances for forms, deck concrete, steel reinforcement, V.C. and railings

Girder	Dimension	Span 7			Span 8			Span 12			Pin		
		a	b	c	d	e	f	g	h	j		k	m
A	Stage 1	2 4"	3 9/16"	4"	3 3/8"	2 4"	0	0	0	Not Used			
	Stage 2				3 3/8"								
B	Stage 1	2 1/8"	3 5/8"	3 3/4"	3 5/8"	2 1/8"	3/16"	4"	3/16"				
	Stage 2				3 3/8"			4"	3/16"				
B-B	Stage 1	Not Used				3/16"	4"	3/16"					
	Stage 2						3/16"						
C	Stage 1	1 1/8"	2 1/8"	3"	2 1/8"	1 1/8"	3/8"	1 1/8"	3/8"	2 3/8"	3 4"	2 3/8"	4"
	Stage 2				2 7/16"			1 1/8"	15/16"			2 1/16"	3/16"
D	Stage 1	1 3/8"	2 4"	2 1/2"	2 4"	1 3/8"	9/16"	3/4"	9/16"	2 4"	3"	2 4"	1 1/2"
	Stage 2				2 3/8"			1 1/8"	1 1/8"			2 1/8"	3/16"
E	Stage 1	1 1/8"	1 3/4"	2"	1 3/4"	1 1/8"	9/16"	3/4"	9/16"	1 4"	1 3/4"	1 4"	1 1/2"
	Stage 2				1 3/4"			1 1/8"	1 1/8"			1 1/2"	7/16"
F	Stage 1	1 1/8"	1 1/8"	1 1/4"	1 1/8"	1 1/8"	9/16"	3/4"	9/16"	-1 1/8"	-1 1/2"	-1 1/8"	-4"
	Stage 2				1 1/8"			1 1/8"	1 1/8"			-1 1/2"	-4"


Work This Sheet With Sheets # 543 thru 554 & 556 thru 562

DATE: August, 1979

DSGN BY: SJR, RGW
 DR'N BY: LDM, MH
 CK'D BY: SJP, RGW
 APP'D BY:

REVISIONS


CITY OF DETROIT, MICHIGAN

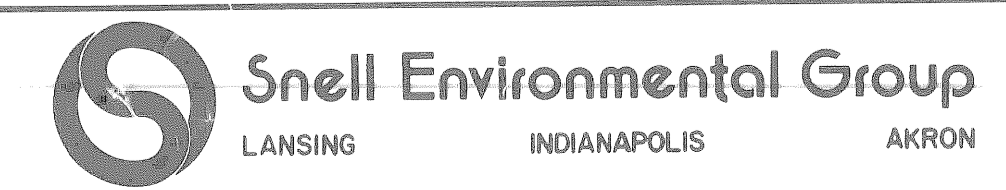

JOHN C. LODGE EXIT RAMP AND JEFFERSON AVENUE- RECONSTRUCTION AT THE JOE LOUIS ARENA.


STRUCTURAL STEEL DETAILS
 ERECTOR DIAGRAM AND CAMBERS
 SPANS 7, 8, AND 12

SCALE: NONE
 DRN. NO: S55

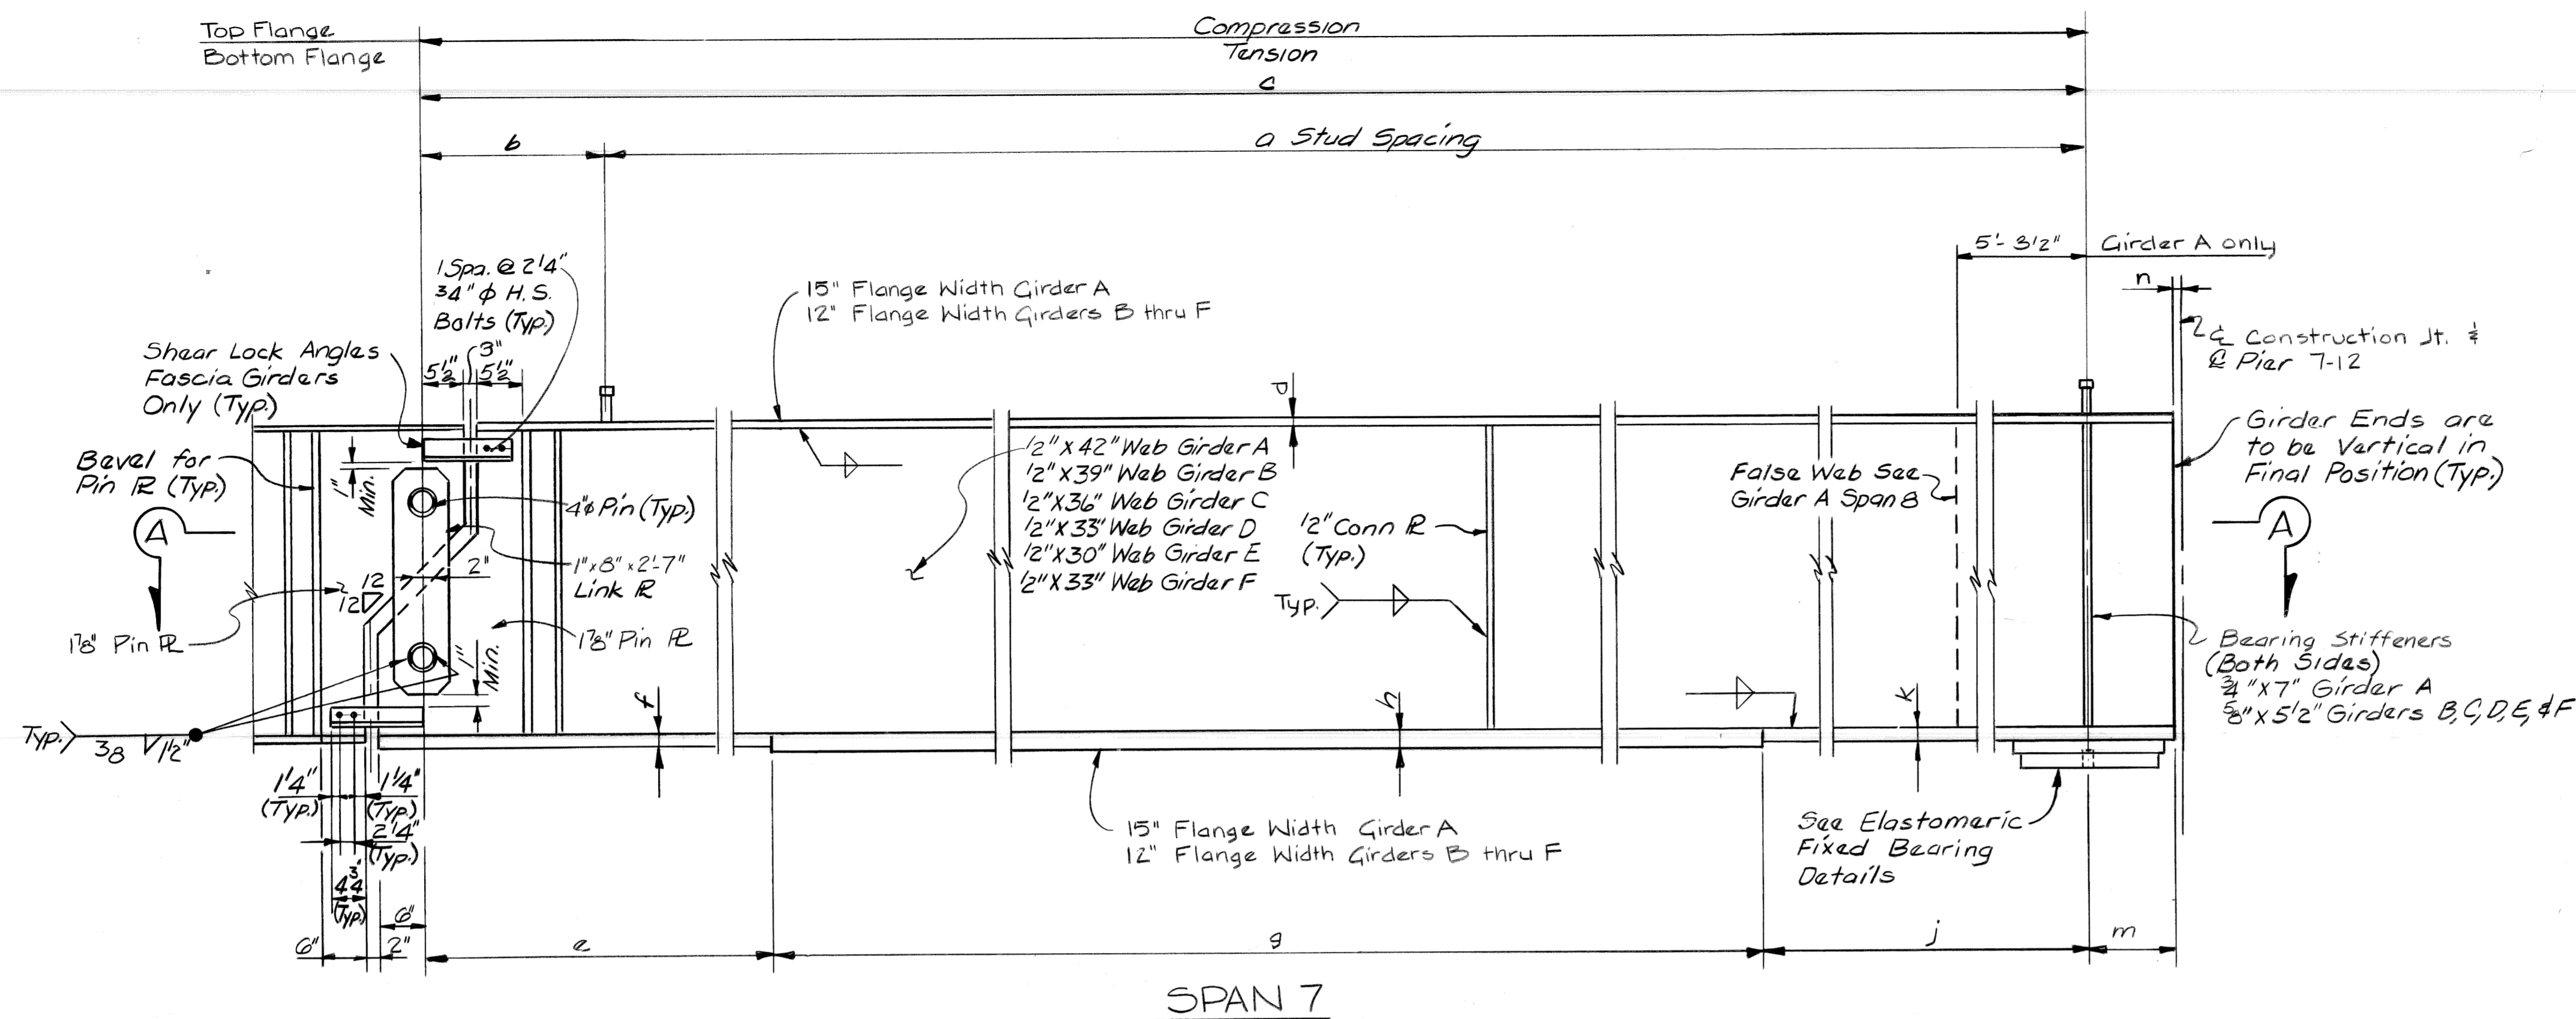


ELEVATION

Dimensions are measured along respective Girder &s

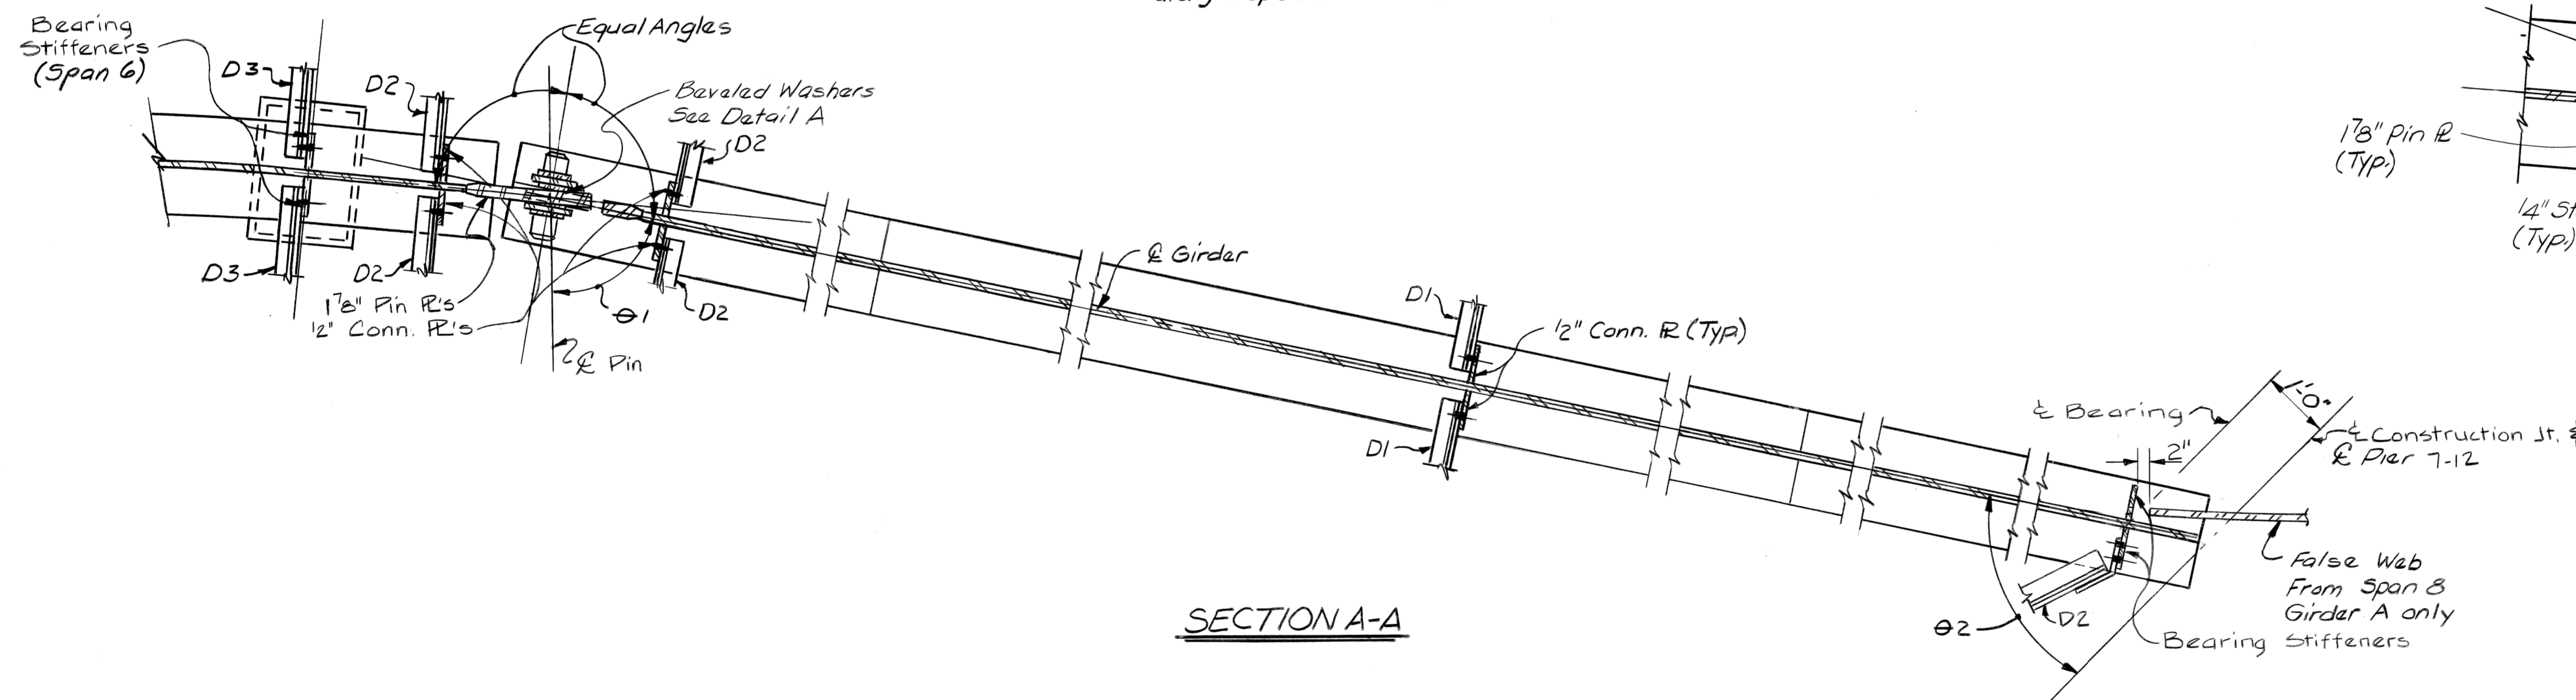

SECTION A-A

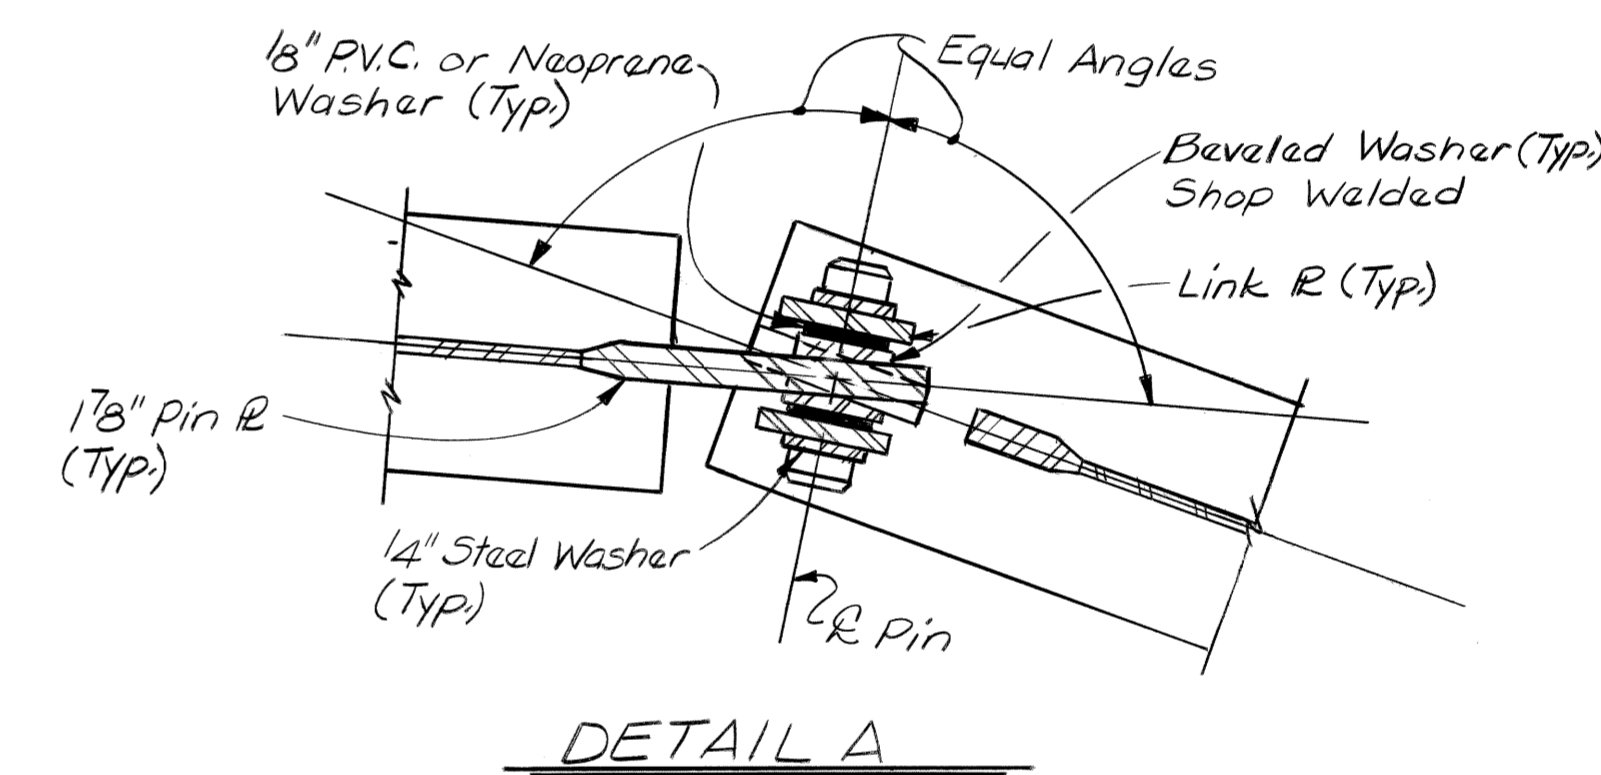

DETAIL A

R GIRDER DIMENSIONS ~ SPAN 7														
Dimen. Girder	a	b	c	d	e	f	g	h	j	k	ø1	ø2	m	n
A	100 Spa. @ 11" = 91'-8"	1'-5 7/8"	93'-1 7/16"	78"	18'-5 3/8"	1'8"	56'-2"	2'8"	18'-6"	1'8"	90°00'00"	45°18'39"	1'-3 1/2"	17'6"
B	99 Spa. @ 10" = 82'-0"	1'-9 1/4"	84'-3 1/4"	34"	16'-2 1/4"	1'4"	51'-10"	2'3 3/8"	16'-3"	1'4"	88°53'27"	48°23'12"	1'-3 3/16"	1'3"
C	99 Spa. @ 9" = 74'-3"	1'-2 9/16"	73'-5 9/16"	58"	13'-10 9/16"	1"	47'-8"	2"	13'-11"	1"	87°31'32"	47°47'07"	1'-27"	1'3 3/8"
D	89 Spa. @ 9" = 66'-9"	1'-1 1/8"	67'-10 5/8"	58"	N/A	N/A	67'-10 5/8"	1'3 1/4"	N/A	N/A	86°58'40"	48°19'59"	1'-2'3 1/4"	1'5 1/8"
E	88 Spa. @ 8" = 58'-8"	1'-6 5/8"	60'-2 5/8"	58"	N/A	N/A	60'-2 5/8"	1'2"	N/A	N/A	86°05'55"	48°12'44"	1'-2'2"	1'5 1/8"
F	77 Spa. @ 8" = 51'-4"	1'-2'3 3/8"	52'-6'3 3/8"	12"	N/A	N/A	52'-6'3 3/8"	1"	N/A	N/A	85°00'43"	50°17'56"	1'-2'5 1/8"	1'5 1/8"

NOTE: N/A denotes Not Applicable

Work This Sheet With Sheets # S49 thru S55 & S57 thru S62

DATE: August, 1979

DSGN BY:	SJP, RGW
DRN BY:	MH
CK'D BY:	SJP, RGW
APP'D BY:	

REVISIONS	

CITY OF DETROIT, MICHIGAN



JOHN C. LODGE EXIT RAMP AND JEFFERSON AVENUE - RECONSTRUCTION AT THE JOE LOUIS ARENA.

STRUCTURAL STEEL DETAILS
R GIRDER DETAILS SPAN 7


SCALE: NONE

DRN. NO: S56

R GIRDER DIMENSIONS ~ SPAN 8

Dimen. Girder	a	b	c	d	e	1	2	3	4	f	g	h	j	k	m
A	41 Spa. @ 6" = 20'-6"	6 1/2"	21'-0 1/16"	5 1/2"	5 1/2"	45°18'39"	35°27'48"	81°37'40"	N/A	1 5/8"	1'-5 1/16"	10 1/8"	2 1/8"	3 1/8"	3 1/8"
B	45 Spa. @ 9" = 33'-9"	7 1/2"	34'-4 1/2"	1 1/2"	1 1/2"	46°25'12"	35°02'28"	73°28'05"	N/A	1 3/4"	1'-7 3/16"	10 5/16"	2 3/16"	1 1/8"	1 1/8"
B-B	46 Spa. @ 11" = 42'-2"	4 15/16"	42'-0 5/16"	1 1/2"	1 1/2"	N/A	41°23'31"	67°07'01"	N/A	1 1/2"	1'-4 5/8"	10 3/4"	2 1/4"	1 1/8"	0"
C	64 Spa. @ 9" = 48'-0"	10 1/8"	48'-10 1/16"	3 1/4"	1 1/2"	47°47'07"	47°47'07"	N/A	44°17'29"	1 3/8"	1'-2 7/8"	1'-3 1/2"	1 1/16"	0"	0"
D	70 Spa. @ 8" = 46'-8"	9 3/8"	47'-5 3/16"	7 1/8"	1 1/2"	48°19'59"	48°19'59"	N/A	44°50'21"	1 5/16"	1'-2 3/4"	1'-3 5/16"	1 1/16"	0"	0"
E	68 Spa. @ 8" = 45'-4"	5 1/4"	45'-9 1/4"	3 1/4"	1 1/2"	49°12'44"	49°12'44"	N/A	45°43'05"	1 5/16"	1'-2 1/2"	1'-3 1/8"	1 5/8"	0"	0"
F	65 Spa. @ 8" = 43'-4"	8 5/16"	44'-0 5/16"	3 1/4"	1 1/2"	50°17'56"	50°17'56"	N/A	46°48'17"	1 5/16"	1'-2 5/16"	1'-2 13/16"	1 5/8"	0"	0"


NOTE: N/A denotes Not Applicable

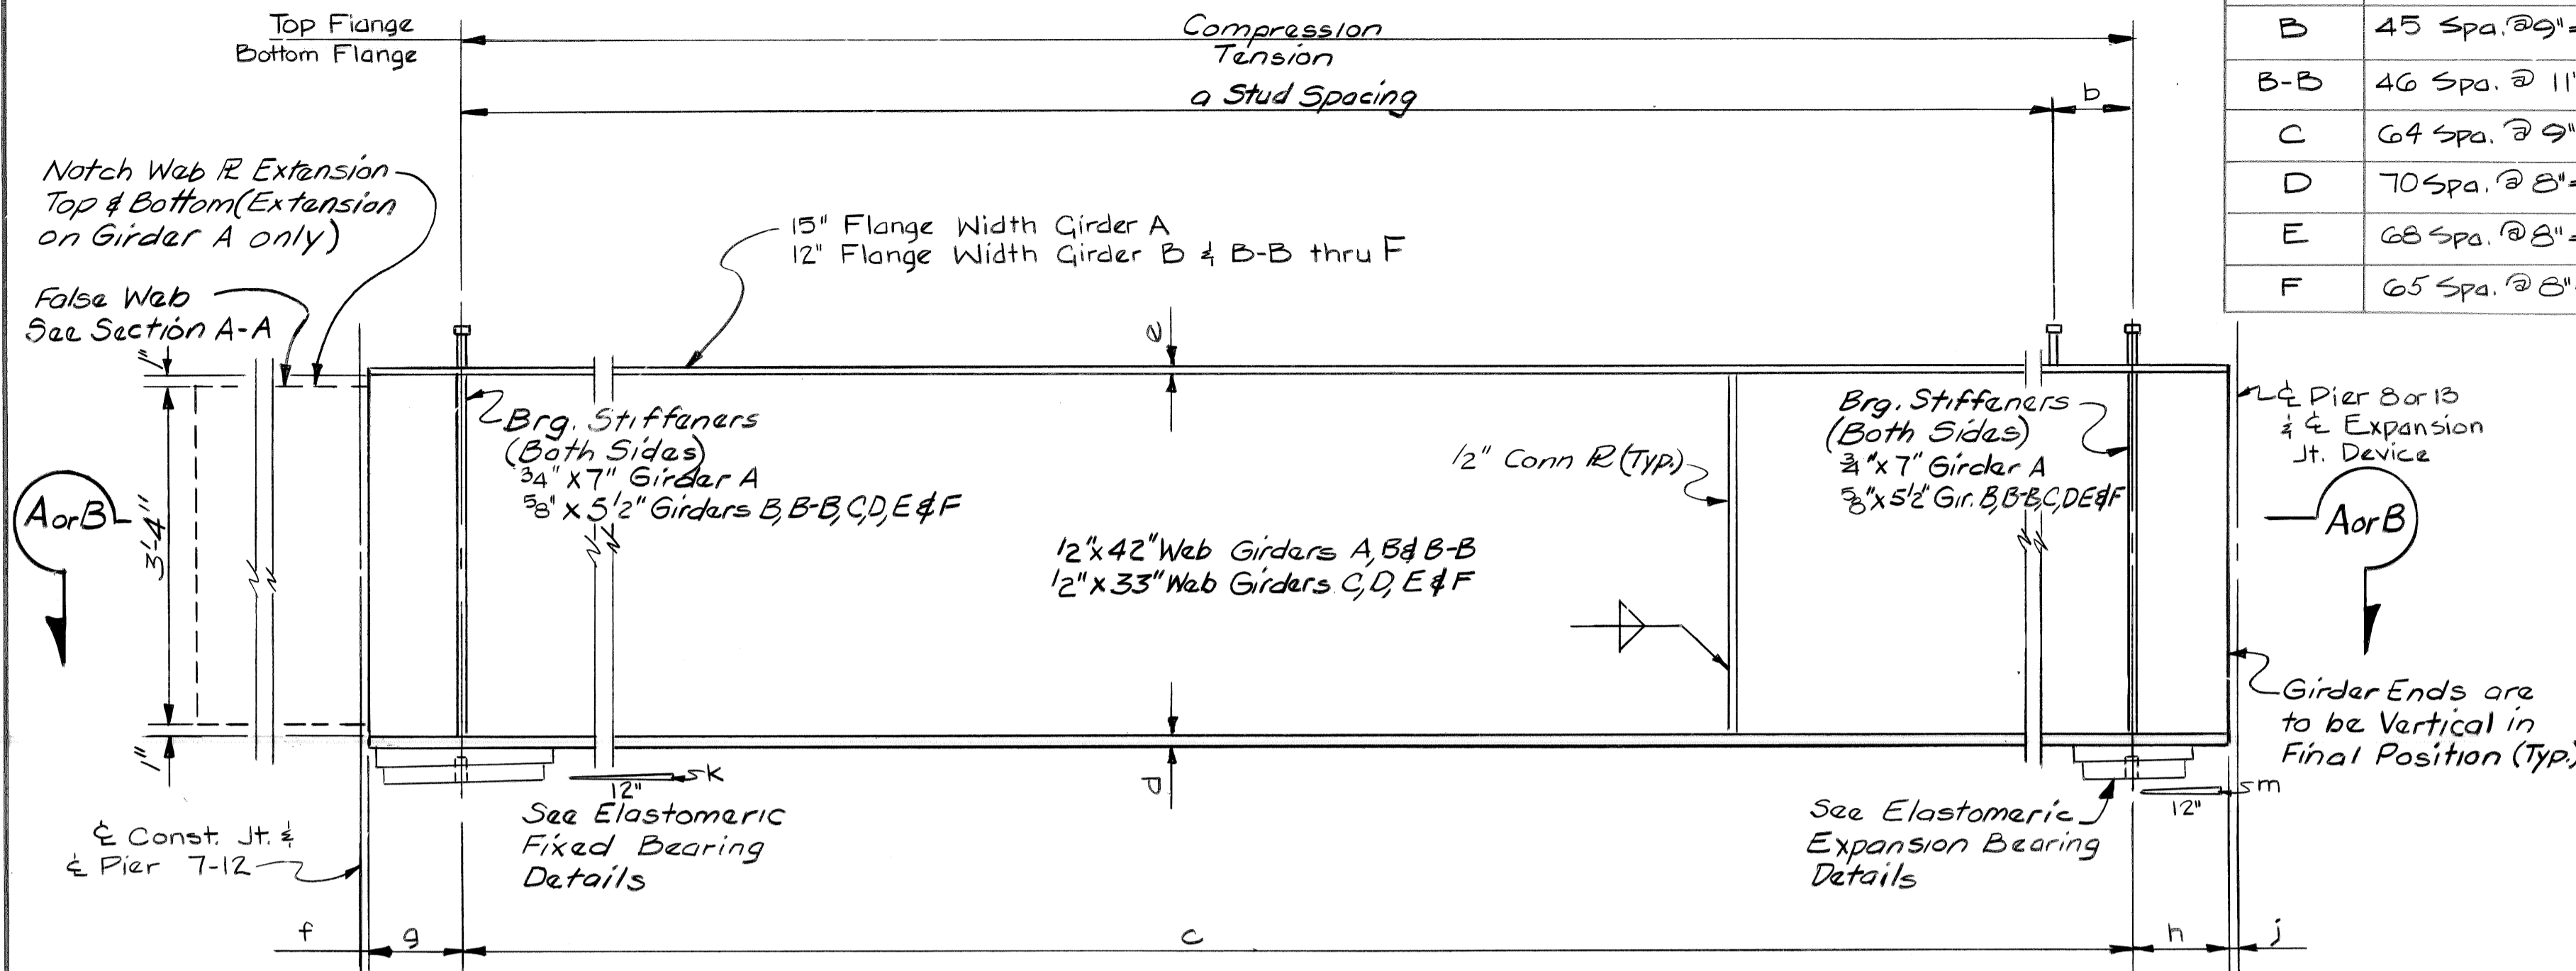

SPAN 8


ELEVATION

Dimensions are measured along respective girder R's

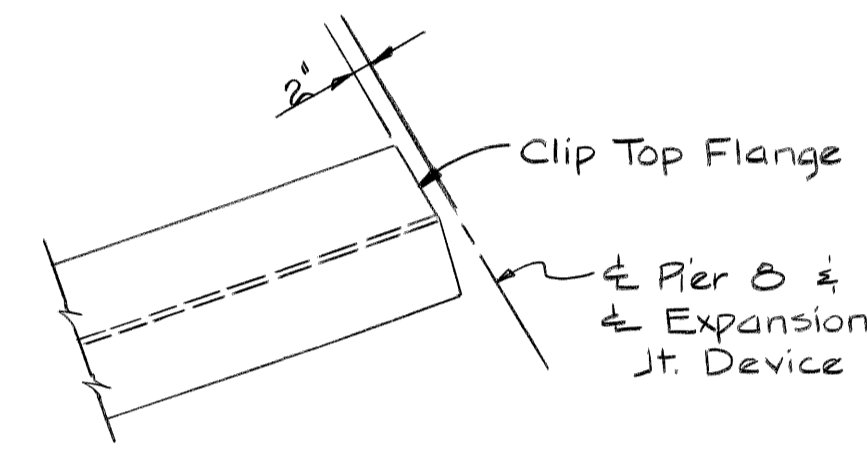


PARTIAL PLAN OF TOP FLANGE


(Girders A, B & B-B)

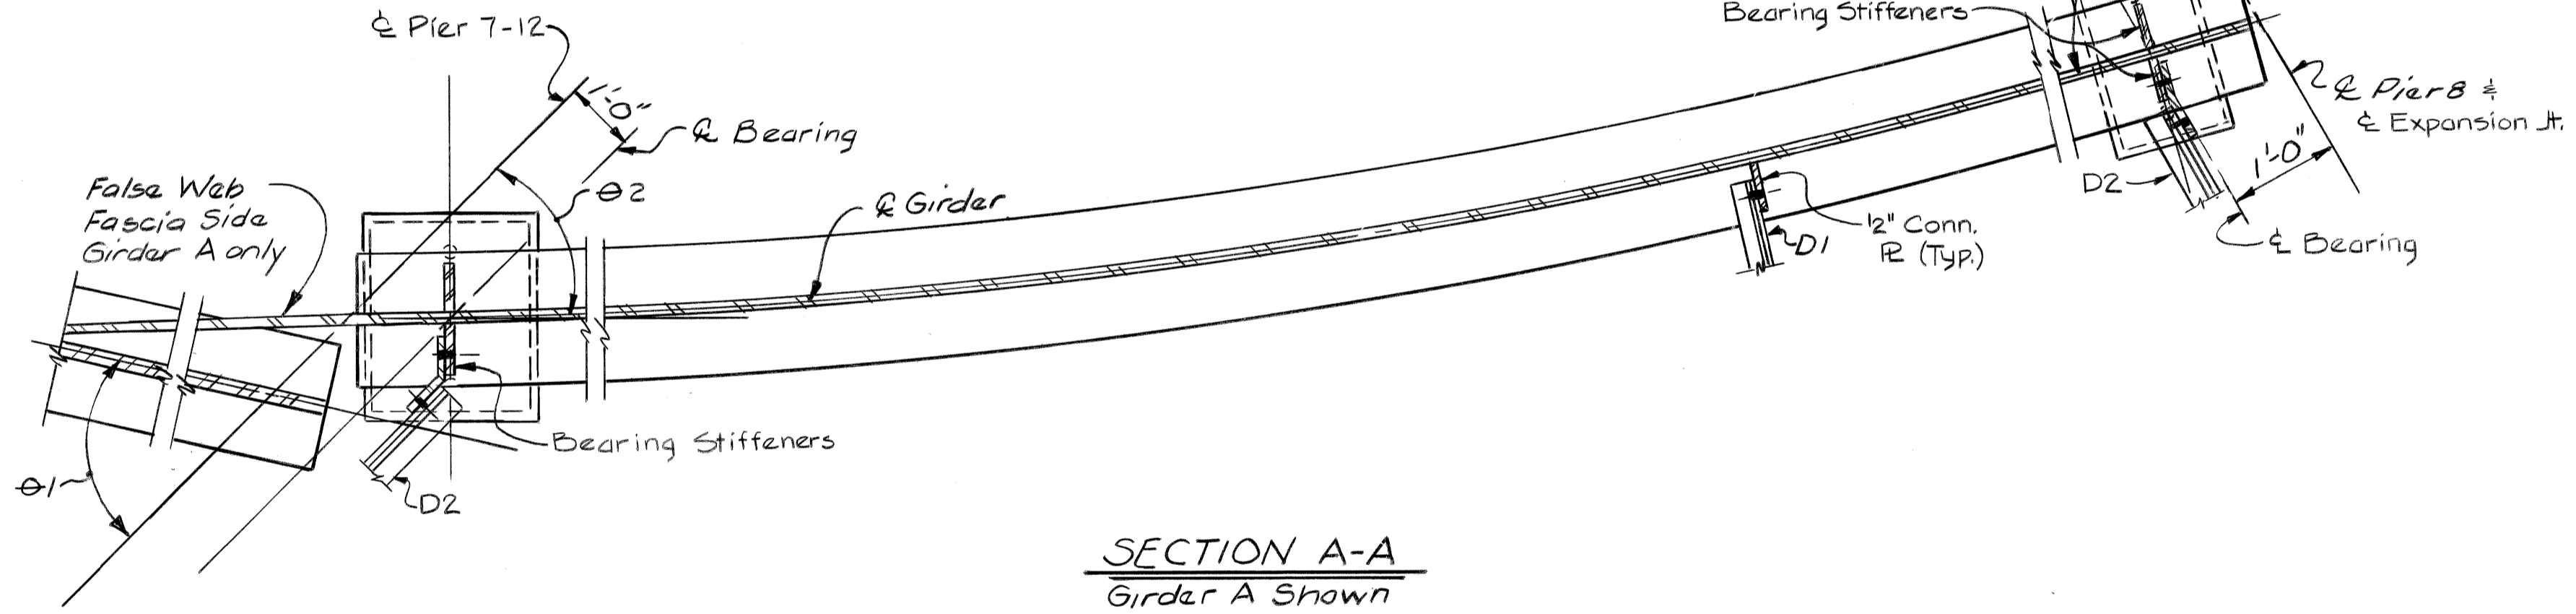

SECTION A-A
Girder A Shown

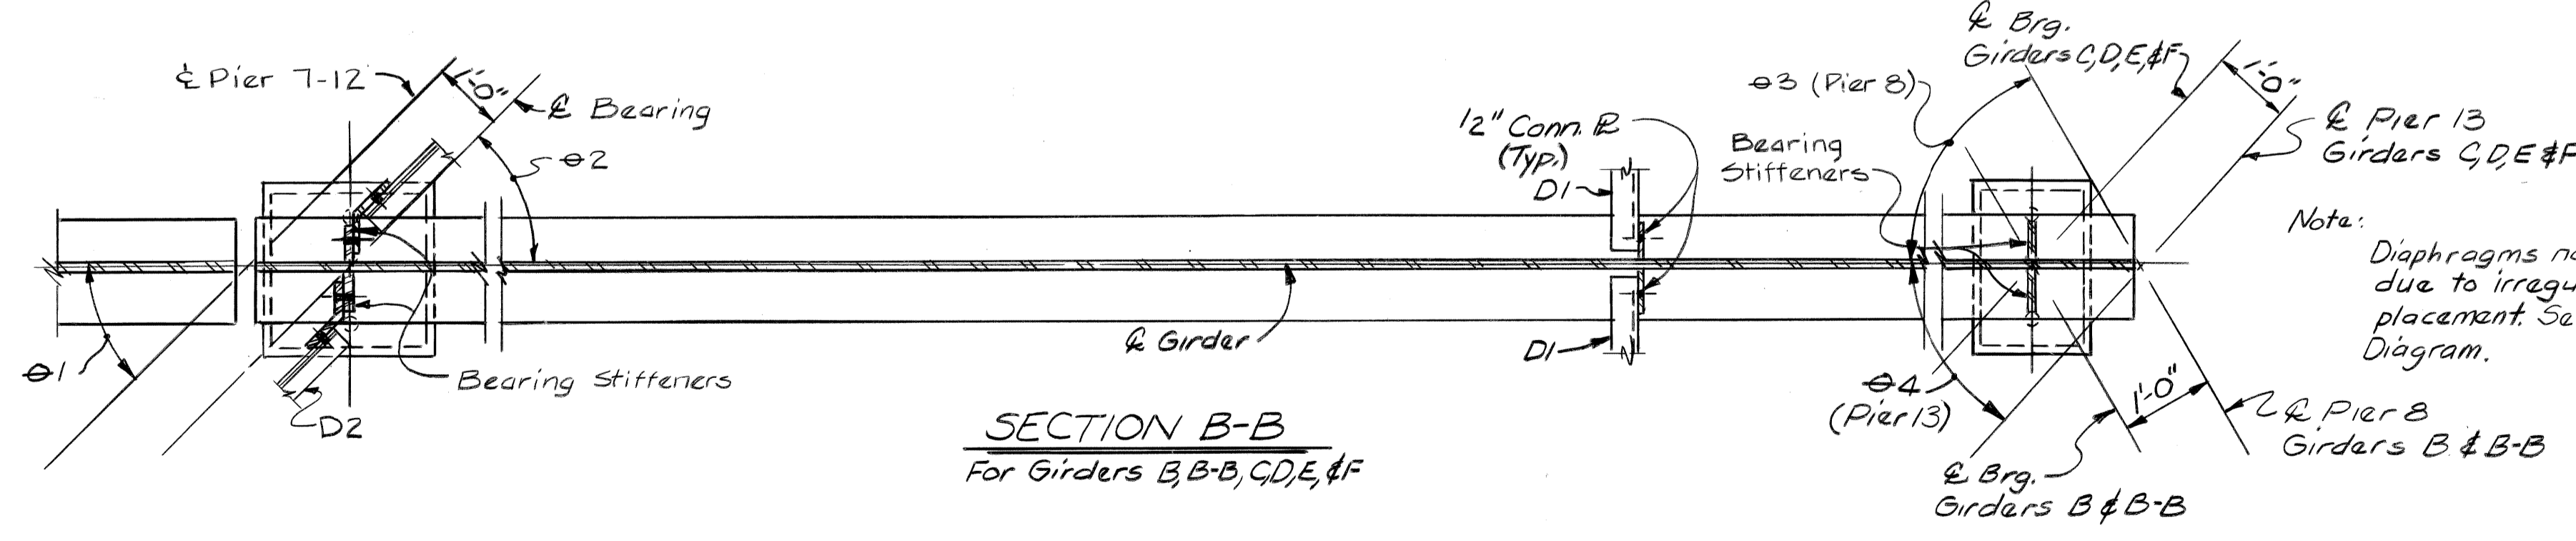

SECTION B-B
For Girders B, B-B, C, D, E, & F

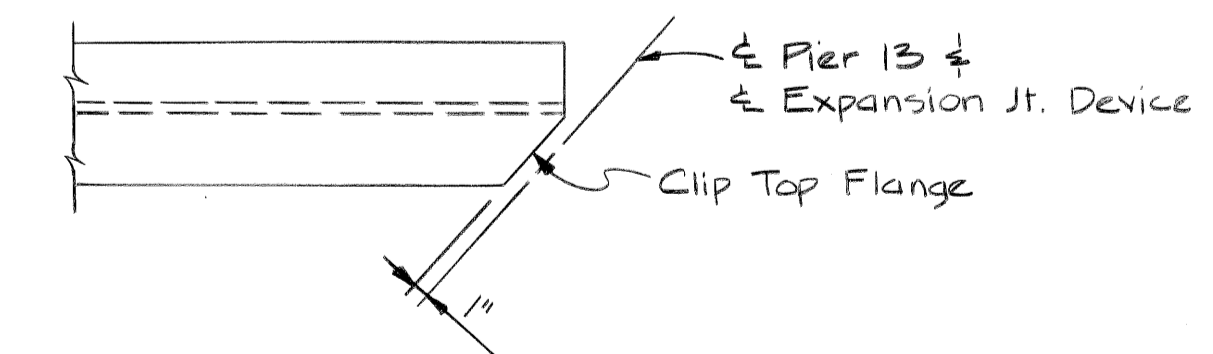

PARTIAL PLAN OF TOP FLANGE

(Girders C, D, E & F)

Note: Diaphragms not shown due to irregular placement. See Erection Diagram.

Work This Sheet With Sheets # S49 thru S56 & S58 thru S62

DATE: August, 1979

DSGN BY:	SJRRGW
DRN BY:	MH
CK'D BY:	SJP, RGW
APP'D BY:	

REVISIONS	


CITY OF DETROIT, MICHIGAN




JOHN C. LODGE EXIT RAMP AND JEFFERSON AVENUE-RECONSTRUCTION AT THE JOE LOUIS ARENA.

STRUCTURAL STEEL DETAILS
R GIRDER DETAILS SPAN 8

SCALE: NONE
DRN. NO: S57

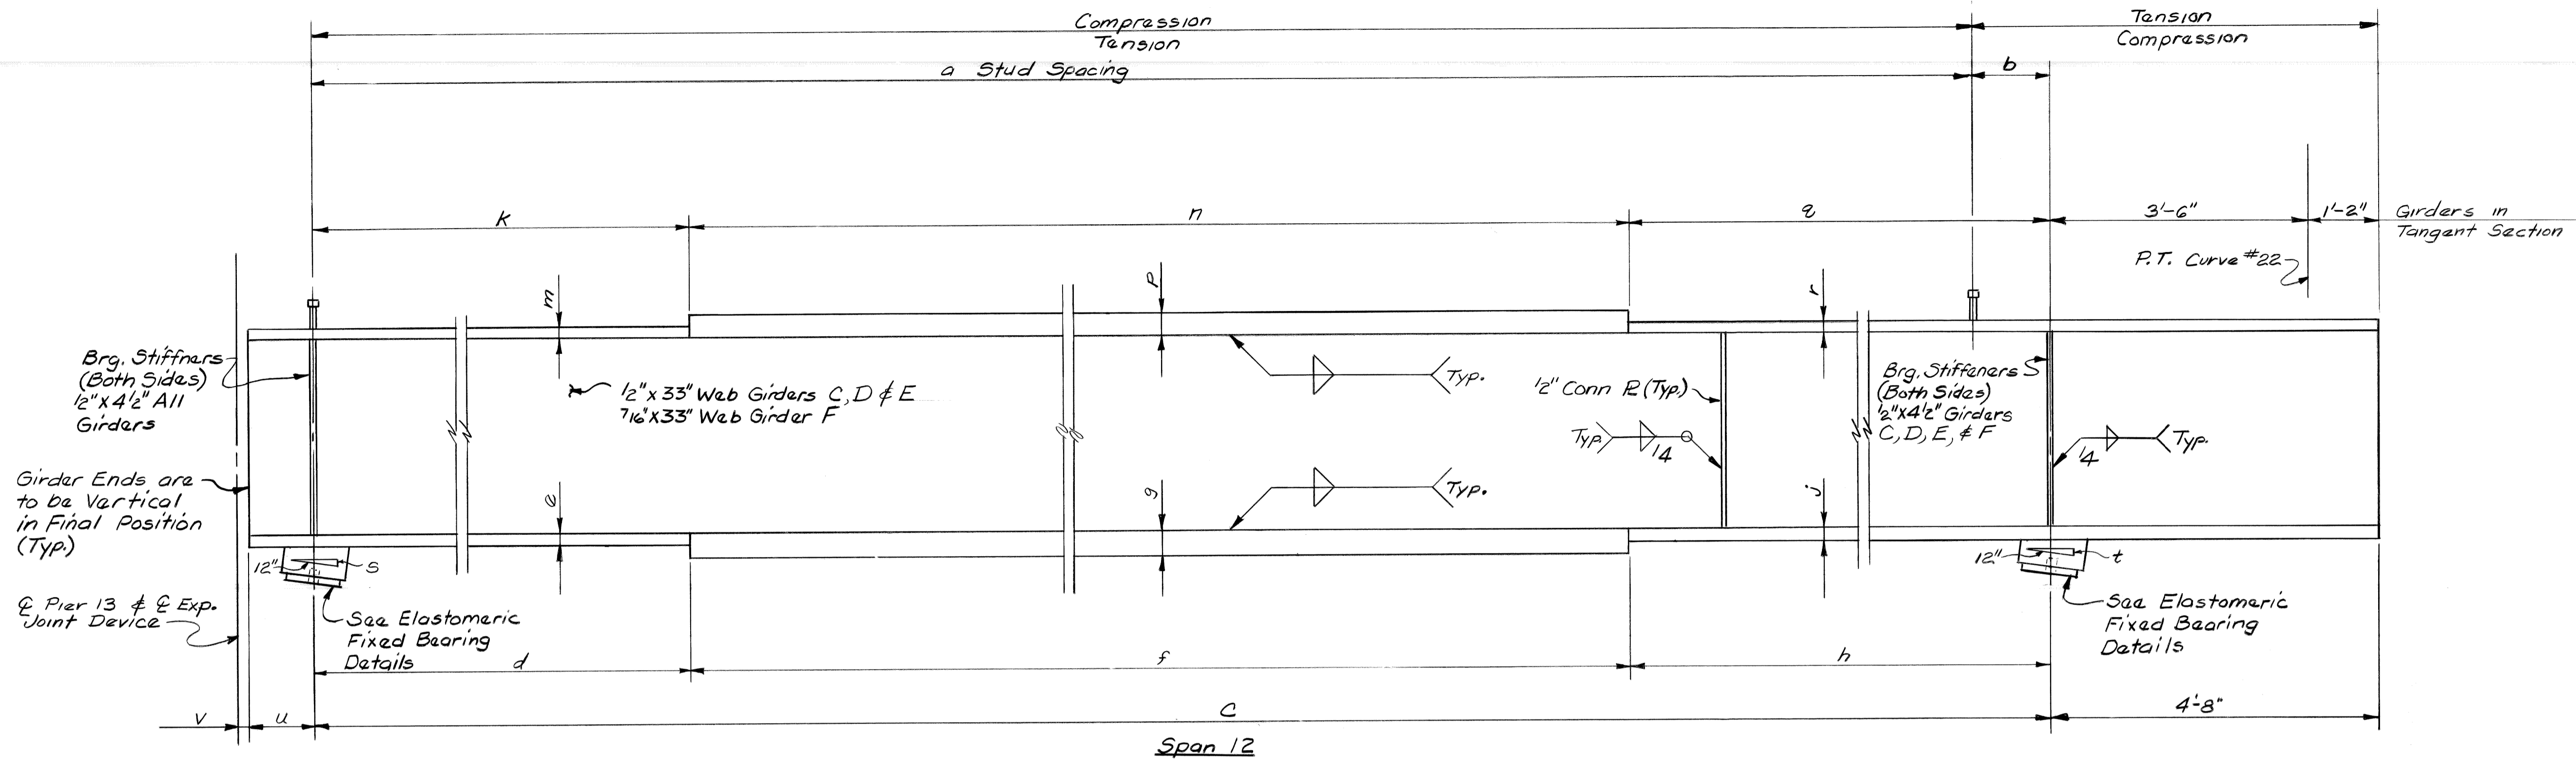

ELEVATION
Dimensions are Measured along respective Girder R's

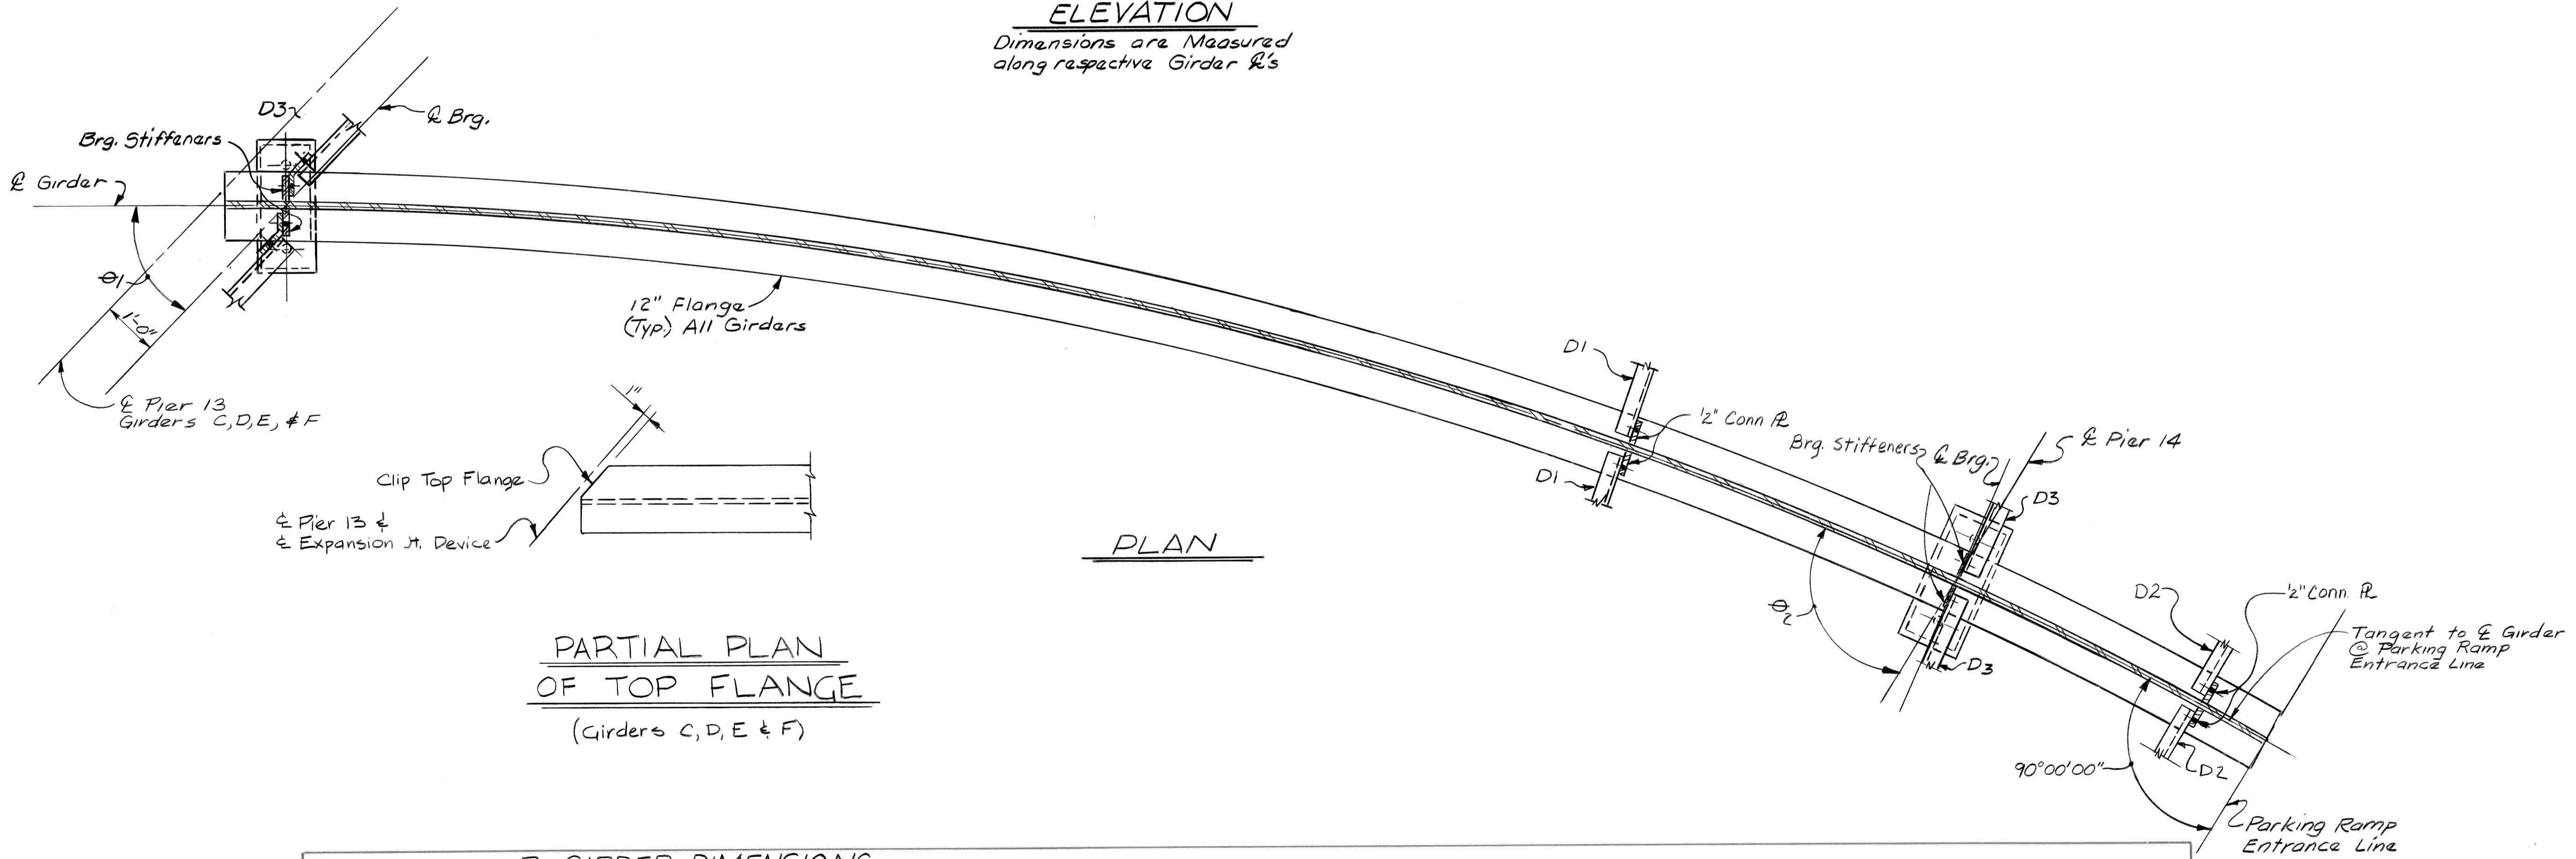

PARTIAL PLAN OF TOP FLANGE
(Girders C, D, E & F)

Girder Dim.	a	b	c	d	e	φ ₁	φ ₂	f	g	h	j	k	m	n	P	q	r	s	t	u	v
C	115 Spa @ 7" = 67'-1"	6 3/8"	67'-7 3/8"	13'-1 3/8"	1 7/8"	52°39'38"	88°25'11"	41'-5"	3 1/8"	13'-1"	1 3/8"	N/A	N/A	67'-7 3/8"	1 3/8"	N/A	N/A	3/16"	1/8"	1'-0 3/8"	2 1/2"
D	119 Spa @ 7" = 69'-5"	3 3/16"	69'-8 3/16"	13'-0 3/8"	1 3/8"	49°06'25"	88°17'40"	43'-8"	3 1/8"	13'-0"	1 3/8"	N/A	N/A	69'-8 3/16"	1 3/8"	N/A	N/A	5/16"	3/8"	1'-1"	2 3/8"
E	114 Spa @ 6" = 72'-0"	2 3/8"	72'-2 3/8"	12'-11 3/8"	1 3/4"	46°25'38"	88°08'50"	46'-2"	3"	13'-1"	1 3/4"	N/A	N/A	72'-2 3/8"	1 3/8"	N/A	N/A	1/4"	1/2"	1'-1 1/8"	3"
F	N/A	N/A	74'-10"	12'-10"	2"	46°25'38"	87°58'21"	49'-3"	3 1/4"	12'-9"	2"	17'-2"	1 3/8"	39'-4"	2 3/8"	18'-4"	1 3/8"	3/16"	5/16"	1'-1 3/16"	3"

NOTE: N/A denotes Not Applicable

Work This Sheet With Sheets # S49 thru S57 & S59 thru S62

DATE: August, 1979

DSGN BY: SJPRGW
DR'N BY: MH
CK'D BY: SJP, Rgw
APP'D BY:

REVISIONS

CITY OF DETROIT, MICHIGAN



Snell Environmental Group
LANSING INDIANAPOLIS AKRON

JOHN C. LODGE EXIT RAMP AND JEFFERSON AVENUE-
RECONSTRUCTION AT THE JOE LOUIS ARENA.

STRUCTURAL STEEL DETAILS
R GIRDER DETAILS SPAN 12

SCALE: NONE

DRN. NO. S58

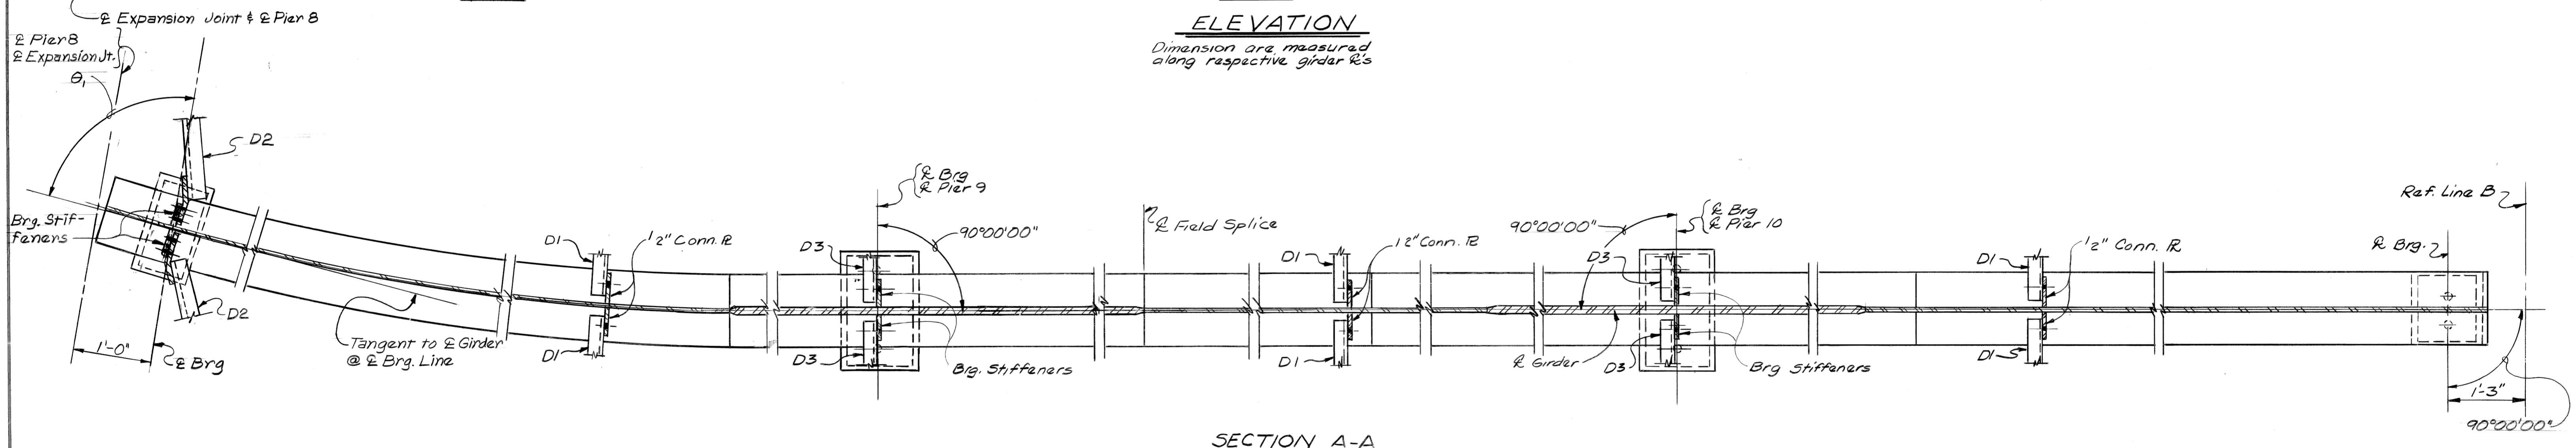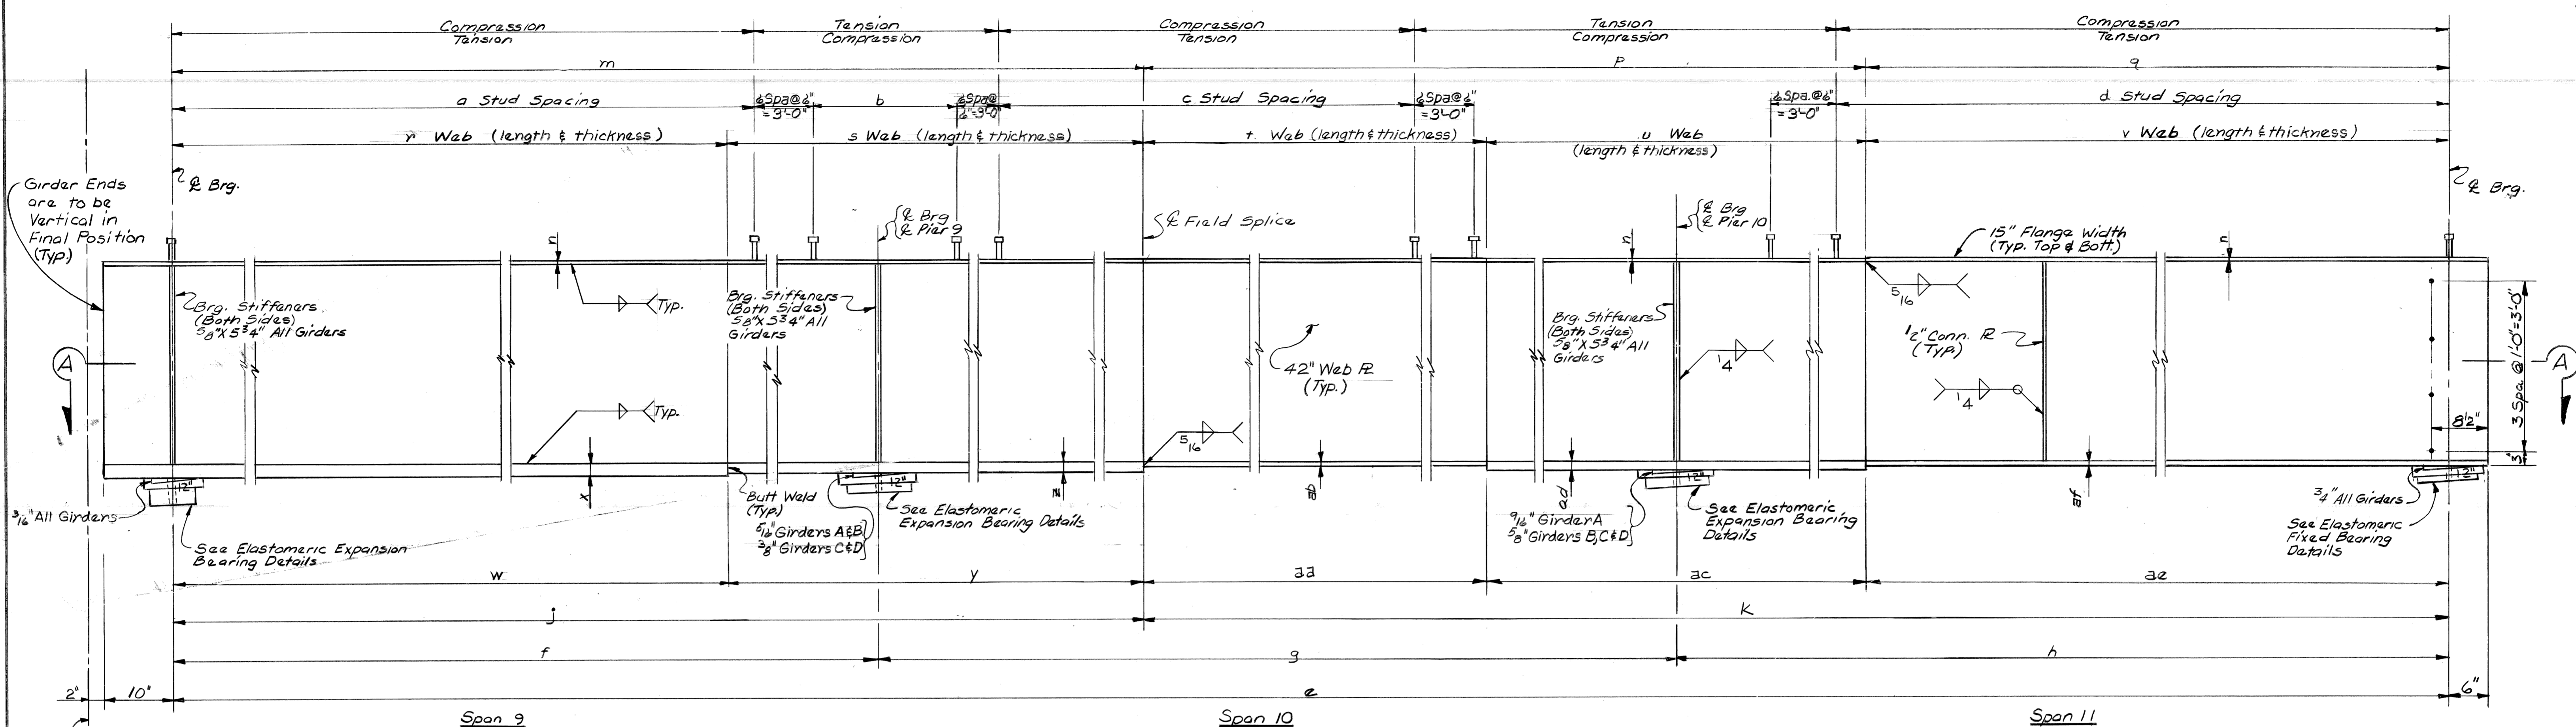

R GIRDER DIMENSIONS ~ SPANS 9, 10 & 11


Dimen. Girder	a	b	c	d	e	f	g	h	j	k
A	64 Spa @ 7" = 37'-4"	17'-8"	65 Spa @ 6" = 32'-6"	57 Spa @ 10" = 47'-0"	170'-3 1/2"	49'-3 1/2"			61'-5"	108'-10 1/2"
B	60 Spa @ 8" = 40'-0"	18'-6 1/2"	53 Spa @ 7" = 30'-11"		172'-5 5/8"	51'-5 5/8"	60'-2"	60'-2"	64'-7"	107'-10 5/8"
C	64 Spa @ 8" = 42'-8"	19'-6"	50 Spa @ 7" = 29'-2"	58 Spa @ 10" = 48'-4"	174'-7 7/8"	53'-7 7/8"			68'-2"	106'-5 1/8"
D	67 Spa @ 8" = 44'-8"	21'-1"	55 Spa @ 6" = 27'-6"		176'-8 3/8"	55'-8 3/8"			70'-11"	105'-9 3/8"

R GIRDER DIMENSIONS ~ SPANS 9, 10 & 11 CONTINUED


Dimen. Girder	m	n	p	q	r	s	t	u	v	w	x	y	z	aa	ab	ac	ad	ae	af	θ ₁
A	61'-5"		61'-7 1/2"	47'-3"	37'-0" x 7 1/2"	24'-5" x 1 1/2"	33'-2 1/2" x 3/8"	28'-5" x 1 1/2"	47'-3" x 7 1/2"	37'-0"	3/8"	24'-5"	7/8"	33'-2 1/2"		28'-5"		47'-3"		82° 44' 12"
B	64'-7"		60'-4 5/8"	47'-6"	39'-9" x 7 1/2"	24'-10" x 1 1/2"	32'-5 5/8" x 3/8"	28'-2" x 1 1/2"	47'-6" x 7 1/2"	39'-9"	7/8"	24'-10"	3/4"	32'-2 7/8"	5/8"	28'-2"		47'-6"		83° 16' 14"
C	68'-2"		58'-8 5/8"	47'-9"	42'-3" x 7 1/2"	25'-11" x 1 1/2"	30'-10 5/8" x 3/8"	27'-10" x 1 1/2"	47'-9" x 7 1/2"	42'-3"	1"	25'-11"	3/4"	30'-10 5/8"	5/8"	27'-10"		47'-9"		83° 43' 53"
D	70'-11"		57'-8 3/8"	48'-1"	44'-7" x 1 1/2"	26'-4" x 1 1/2"	30'-0 7/8" x 3/8"	27'-8" x 1 1/2"	48'-1" x 7 1/2"	44'-7"	1 1/8"	26'-4"	7/8"	30'-0 7/8"		27'-8"		48'-1"		84° 07' 59"

Work This Sheet With Sheets # S49 thru S59, S61 & S62


DATE: August, 1979

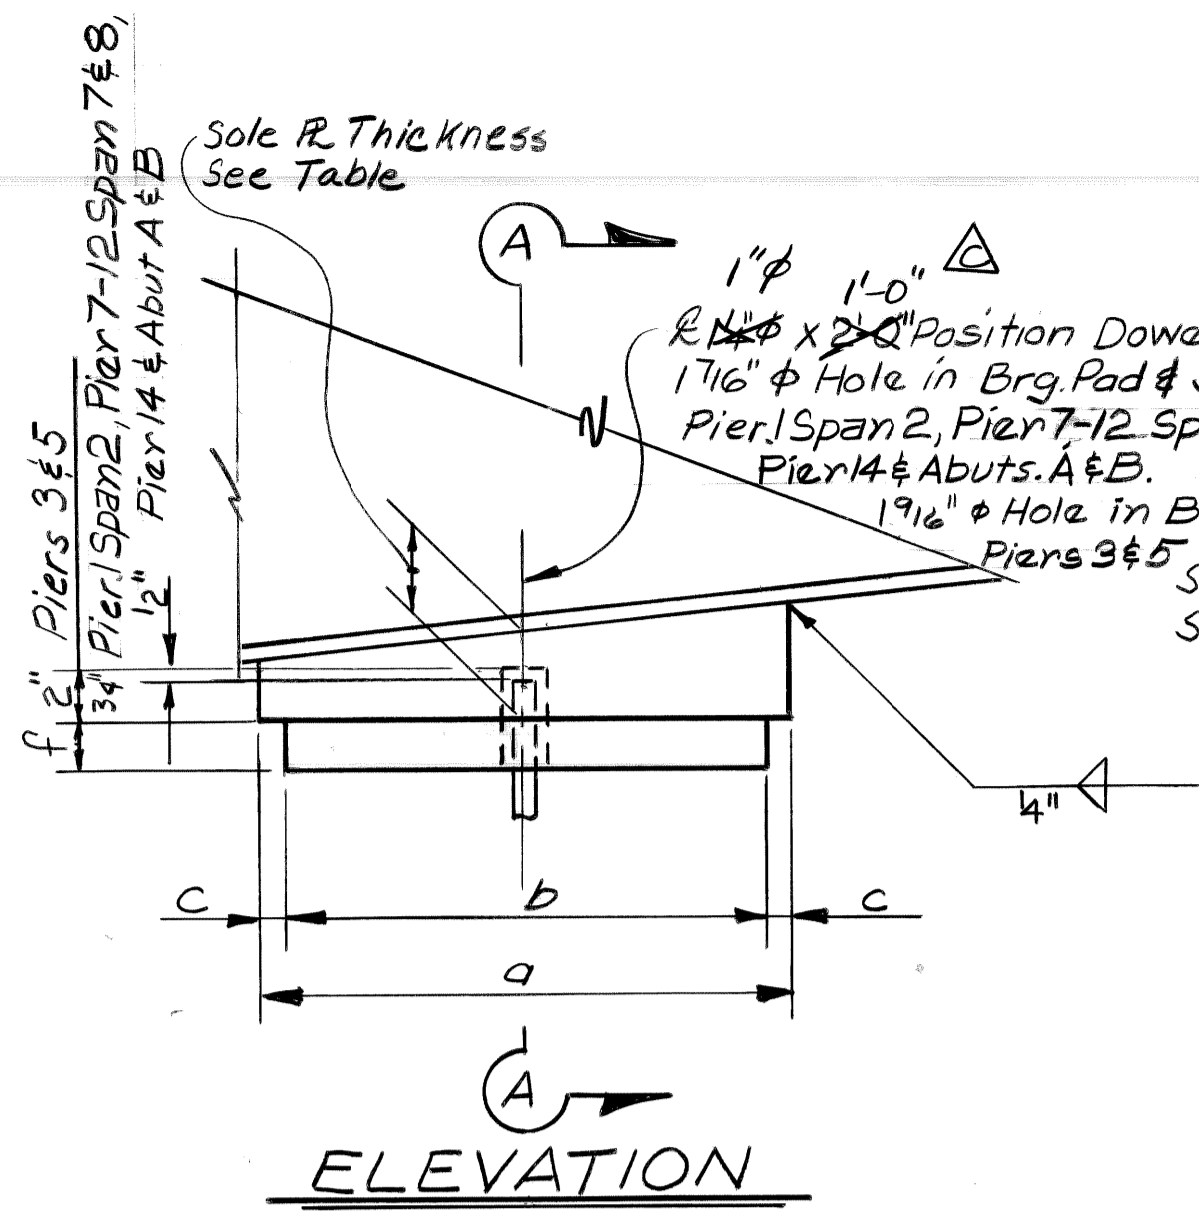


ELEVATION A

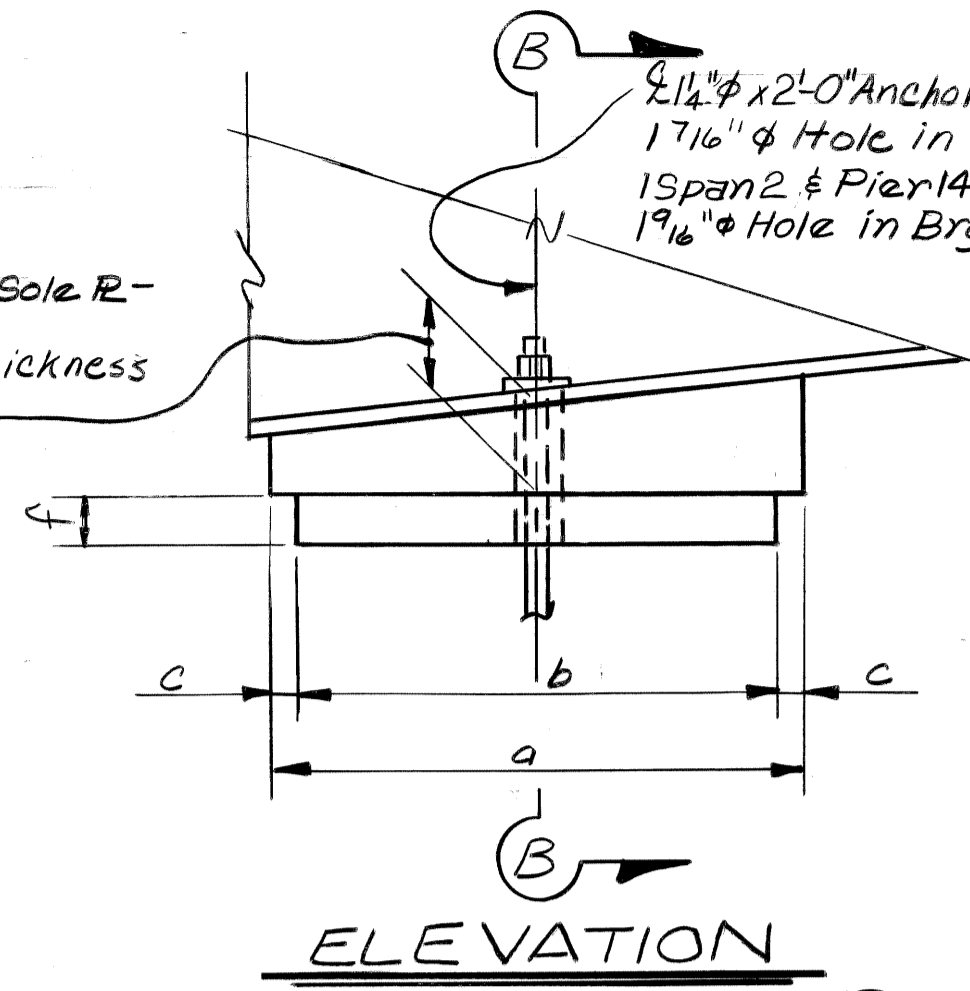


ELEVATION B

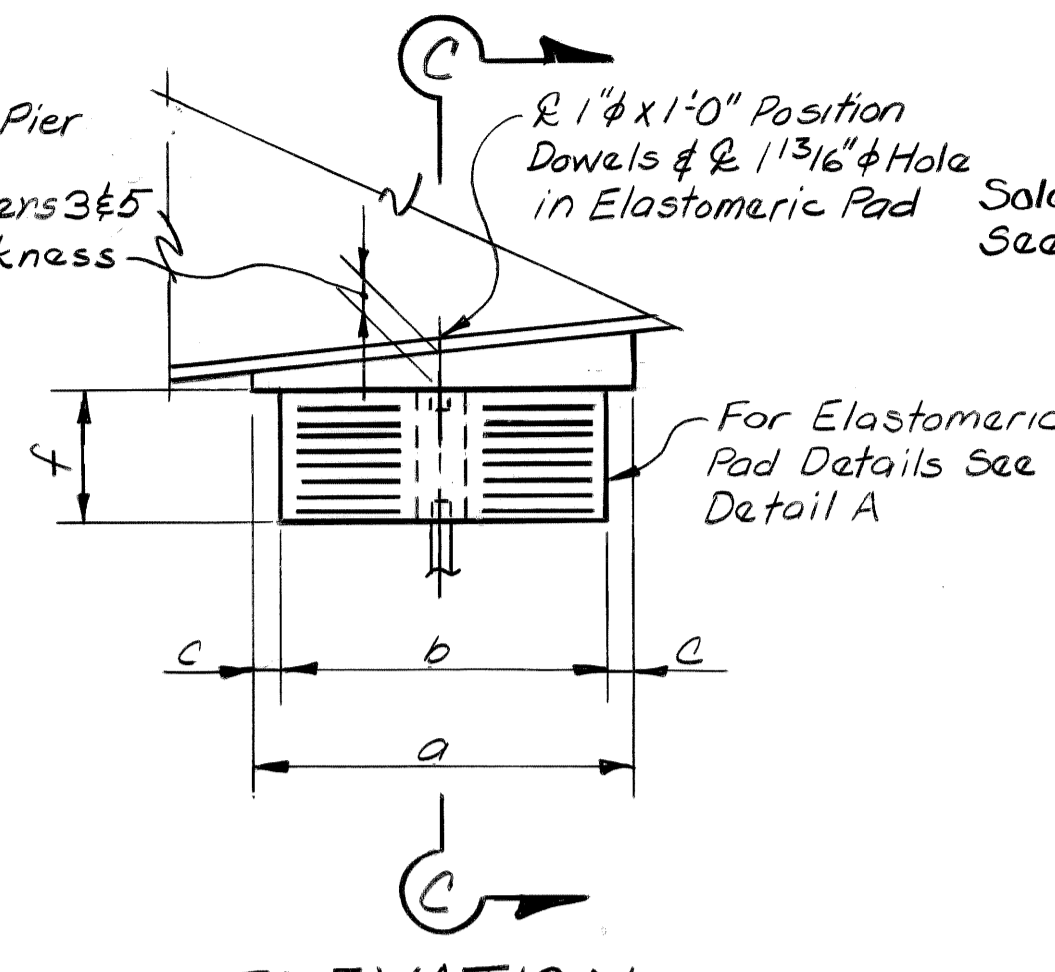

ELEVATION C

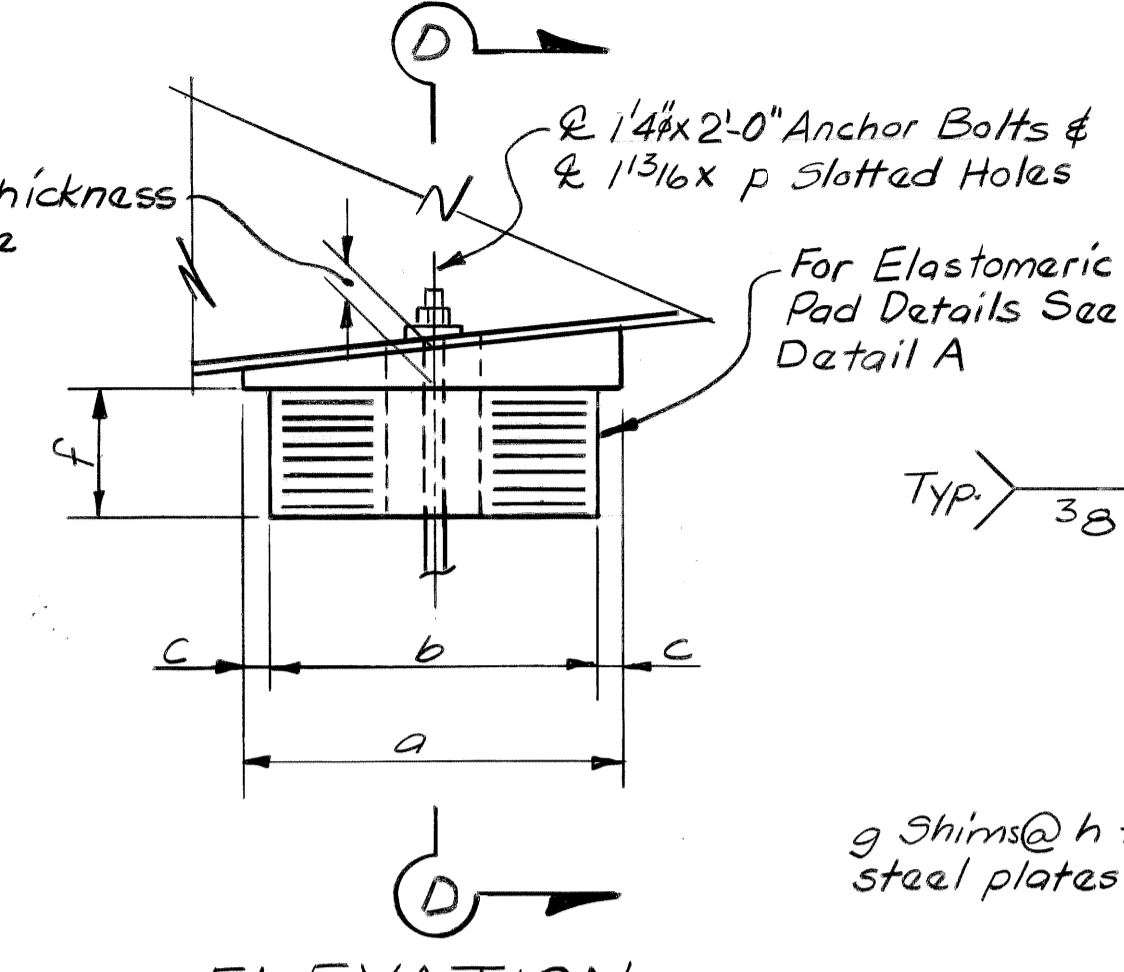


ELEVATION D

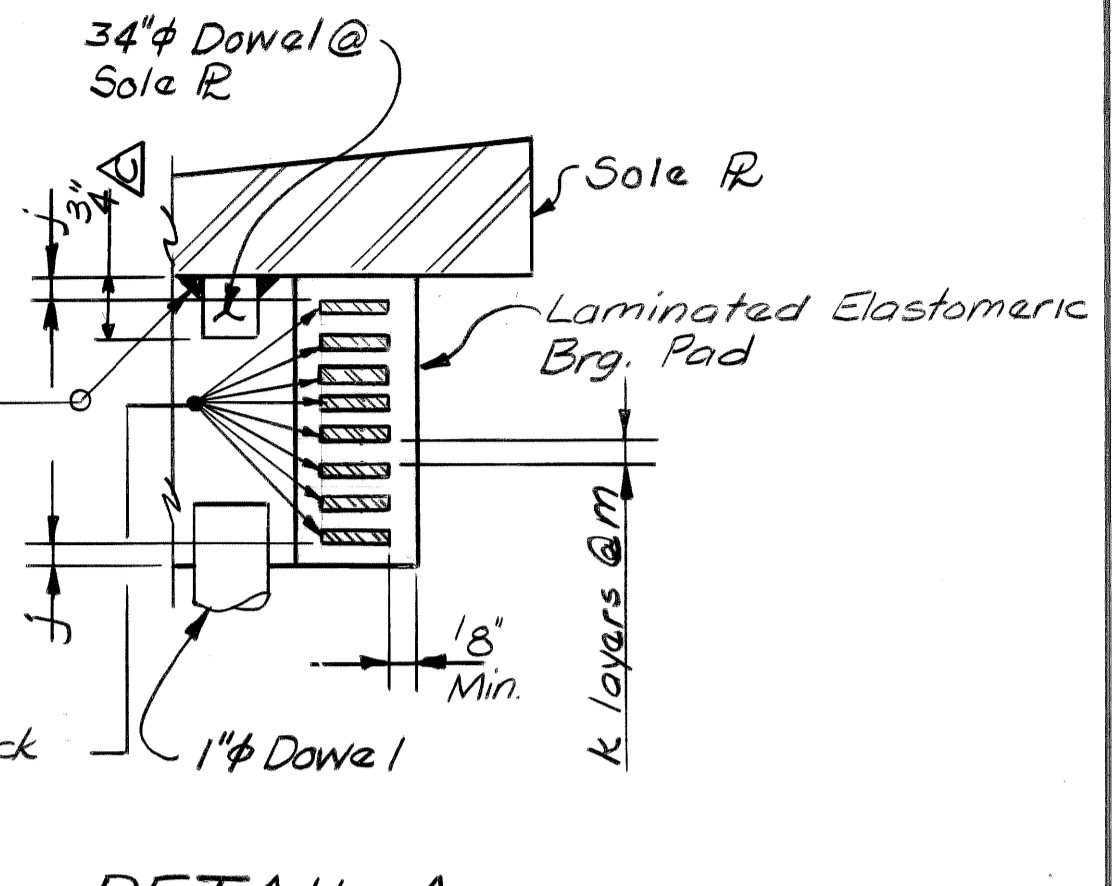


DETAIL A

Showing Bolts Through Sole R & Brg. Pad (Typical Girder F - Pier 1 Span 2, Piers 3, 5 & 14, Girder A Pier 7-12 Span 7 & 8)


Showing Bolts Through Sole R & Brg. Pad (Typical Girder F - Pier 1 Span 1, Piers 2, 4, 6 & 13 Span 8 & 12, Pier 8 Span 8 & 9 & Pier 9)

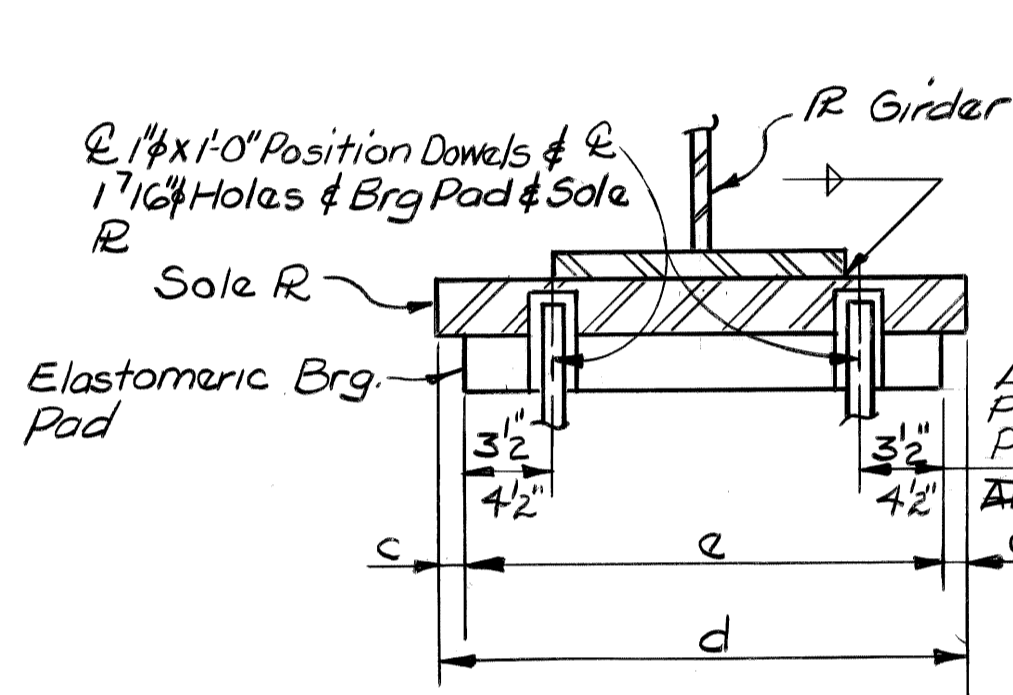


SECTION A-A

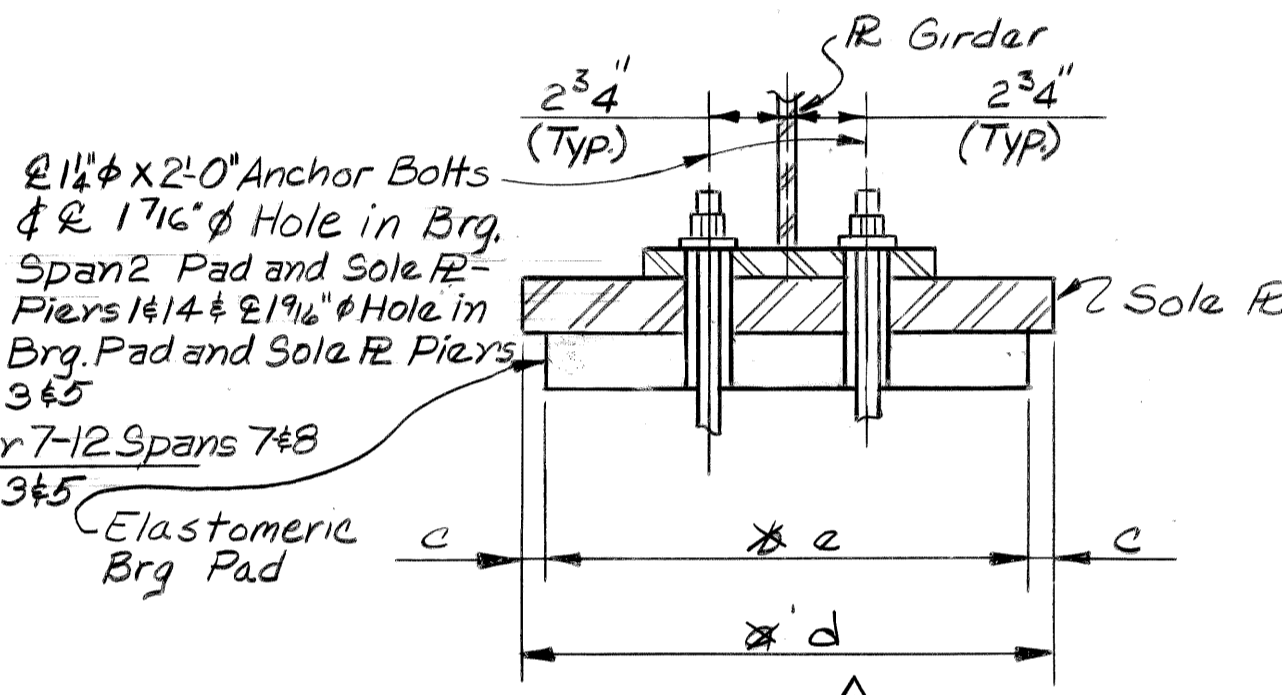

SECTION B-B

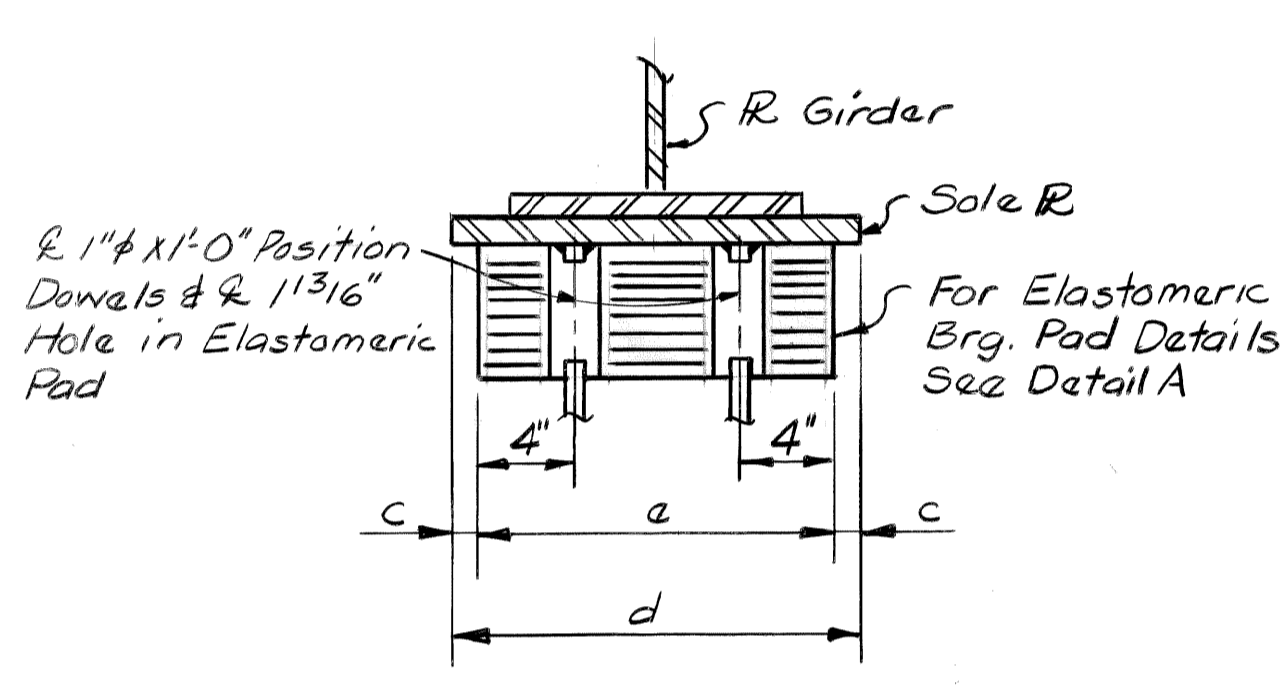


SECTION C-C

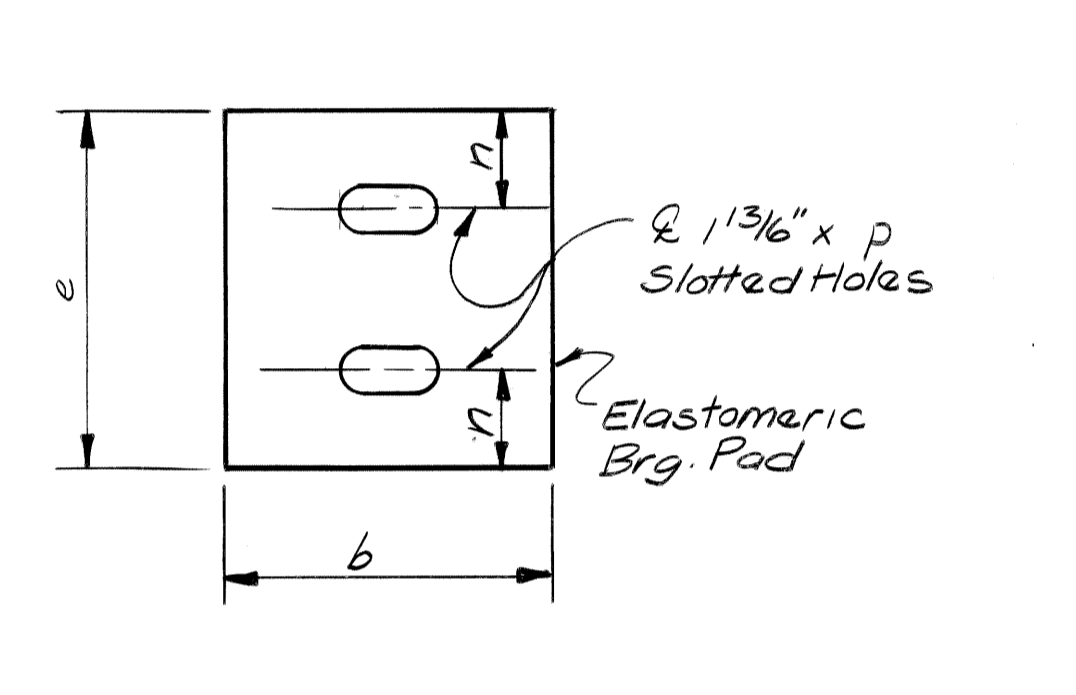

BEARING PAD PLAN


Showing Slotted Holes, Girder & Sole R removed

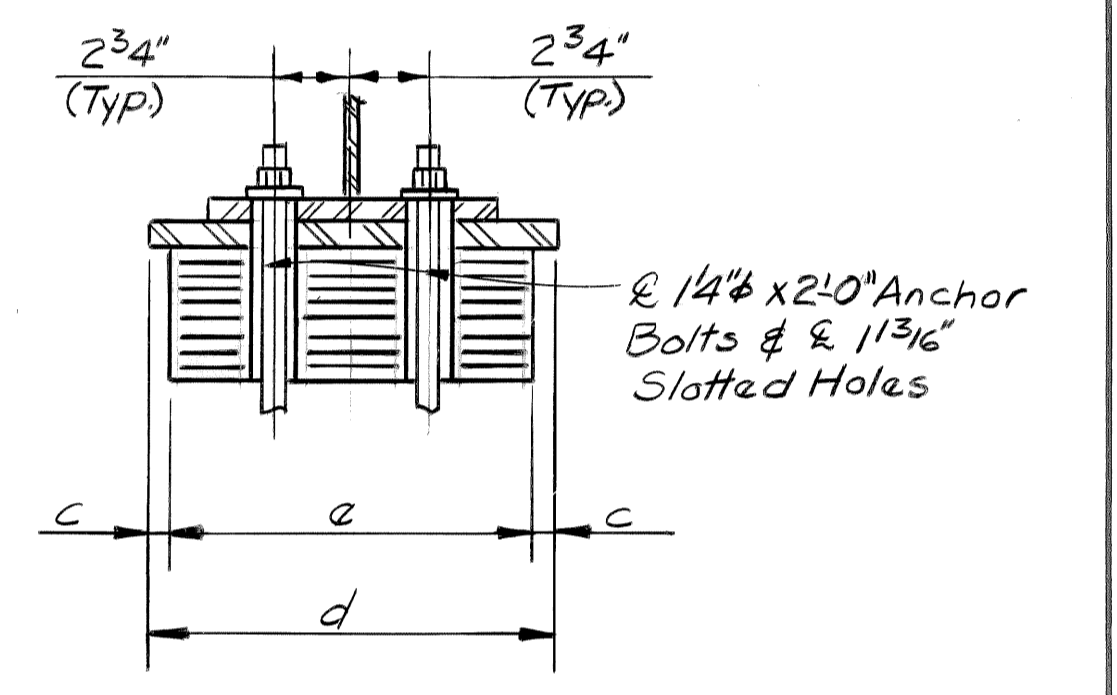

SECTION D-D

FIXED BEARING DETAILS


EXPANSION BEARING DETAILS

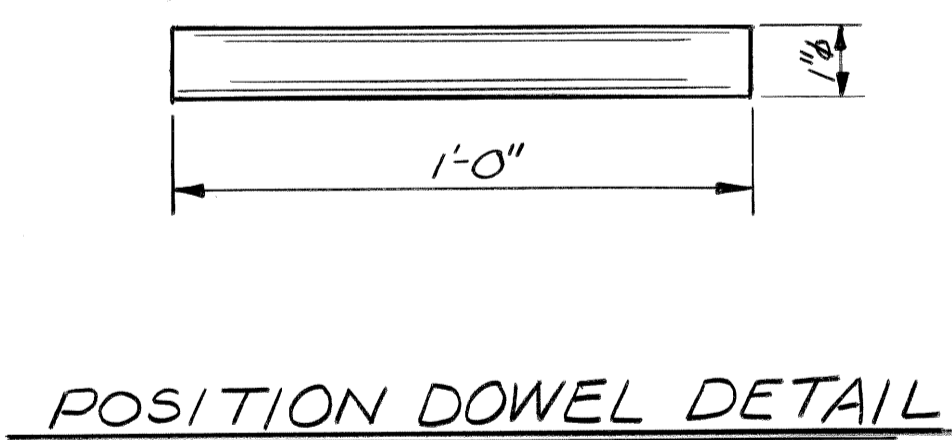

POSITION DOWEL DETAIL

FIXED BEARING DIMENSIONS						
Dimension Location	a	b	c	d	e	f
Abut A	11"	10"	12"	12 1/2"	1'-0"	34"
Pier 1, Span 2	11"	10"	12"	12 9/16"	12 9/16"	34"
Pier 3	1'-10"	1'-8"	1"	1'-10"	1'-8"	1"
Pier 5	1'-8"	1'-6"	1"	1'-11"	1'-9"	1"
Pier 7, Span 7	11"	10"	12"	12 7/16"	12 7/16"	34"
Pier 7, Span 8	11"	10"	12"	12 4/16"	12 4/16"	34"
Abut B	10"	9"	12"	12 4/16"	12 3/16"	34"
Pier 14	11"	10"	12"	2'-1"	2'-0"	34"

* Note: Dim C in Section A-A = 2"

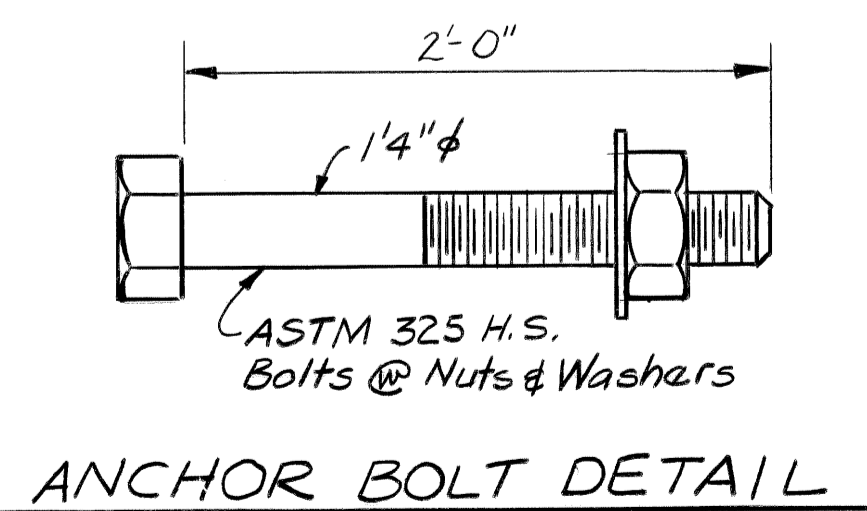

ANCHOR BOLT DETAIL

EXPANSION BEARING DIMENSIONS													
Dimension Location	a	b	c	d	e	f	g	h	j	k	m	p	
Pier 1, Span 1	9"	7"	1"	12 8/16"	12 6/16"	15 8/16"	3	3 3/2"	11 3/2"	2	11 3/2"	6 1/4"	2"
Pier 2	14 8/16"	14 6/16"	1"	12 11/16"	12 9/16"	3 5/8"	4	3 1/6"	12"	3	5 8/16"	7 3/4"	3"
Pier 4	14 2/16"	14 0/16"	1"	2 4/16"	2 0/16"	3"	4	18"	12"	3	12"	9 1/4"	3"
Pier 6-11	12 5/16"	12 3/16"	1"	12 11/16"	12 9/16"	3"	4	18"	12"	3	12"	7 3/4"	3"
Pier 8, Span 8	7"	5"	1"	12 11/16"	12 9/16"	2"	5	3 3/2"	14"	4	14"	7 3/4"	2"
Pier 8, Span 9	14 3/2"	14 1/2"	1"	14 7/16"	14 5/16"	5 1/2"	8	18"	12"	7	12"	5 3/4"	5"
Pier 9	14 1/16"	14"	1"	12 11/16"	12 9/16"	4"	6	18"	3 8/16"	5	12"	7 3/4"	4"
Pier 10	14 1/2"	14 1/2"	1"	12 11/16"	12 9/16"	2"	3	18"	3 8/16"	2	7 1/6"	7 3/4"	2"
Pier 13, Span 8	9"	7"	1"	12 8/16"	12 6/16"	2"	5	3 3/2"	14"	4	14"	6 1/4"	2"
Pier 13, Span 12	1'-0"	10"	1"	12 10/16"	12 8/16"	2 1/4"	3	18"	7 1/6"	2	12"	7 1/4"	2"

SOLE PLATE THICKNESS TABLE							
Girder Location	A	B	B-B	C	D	E	F
Abut A	2 3/4"	2"	N.U.	1 1/2"	1"	1"	1 1/2"
Pier 1, Span 1	3"	2 1/2"	do	2"	1 1/2"	1 1/2"	2"
Pier 1, Span 2	1 1/4"	2 3/4"	do	2 1/2"	1 3/4"	1 1/4"	2 3/4"
Pier 2	2 1/4"	1 3/4"	do	1 3/4"	1 1/4"	1 1/2"	1 1/2"
Pier 3	2 1/2"	2 3/4"	do	2 1/2"	2 1/2"	2 1/2"	2 1/2"
Pier 4	2"	2 3/4"	do	2"	2"	2"	2"
Pier 5	2 1/2"	2 1/2"	do	2 3/4"	2 1/2"	2 3/4"	2 1/2"
Pier 6-11	1 3/4"	2 1/2"	do	1 3/4"	2 1/2"	2"	1 3/4"
Pier 7, Span 7	1 1/4"	1"	do	1"	2 1/4"	1"	1 1/4"
Pier 7, Span 8	1"	1"	2 1/4"	1"	2 1/2"	1 3/4"	1"
Pier 8, Span 8	1"	1"	1"	N.U.	N.U.	N.U.	N.U.
Pier 8, Span 9	1"	1"	N.U.	1"	1"	N.U.	N.U.
Pier 9	1"	2 1/4"	N.U.	1"	1"	do	do
Pier 10	1"	2 1/4"	do	1"	1"	do	do
Pier 13, Span 8	N.U.	N.U.	do	1"	1"	2 3/4"	1"
Pier 13, Span 12	do	do	do	1 1/2"	1 1/2"	1 1/2"	1 1/2"
Abut B	1"	2 1/2"	do	1"	1"	N.U.	N.U.
Pier 14	N.U.	N.U.	do	1 1/2"	2 1/2"	1 1/2"	1 1/2"

Note: N.U. denotes Not Used.

NOTES:

For sole plate bevels, see individual girder elevations.
Steel sole plates, anchor bolts and position dowels are included in the quantity "Structural Steel".
Holes in bearings shall be centered on anchor bolts or dowels.

Work This Sheet With Sheets # S49 thru S60 & S62

DATE: August, 1979

DSGN BY: SJP, RGW	REVISIONS:
DRN BY: MH	
CHK'D BY: SJP, RGW	
APP'D BY:	

Revise Dimensions SJP 1-22-1980

CITY OF DETROIT, MICHIGAN




JOHN C. LODGE EXIT RAMP AND JEFFERSON AVENUE RECONSTRUCTION AT THE JOE LOUIS ARENA.


STRUCTURAL STEEL DETAILS BEARING DETAILS

SCALE: NONE


DRN. NO: S61

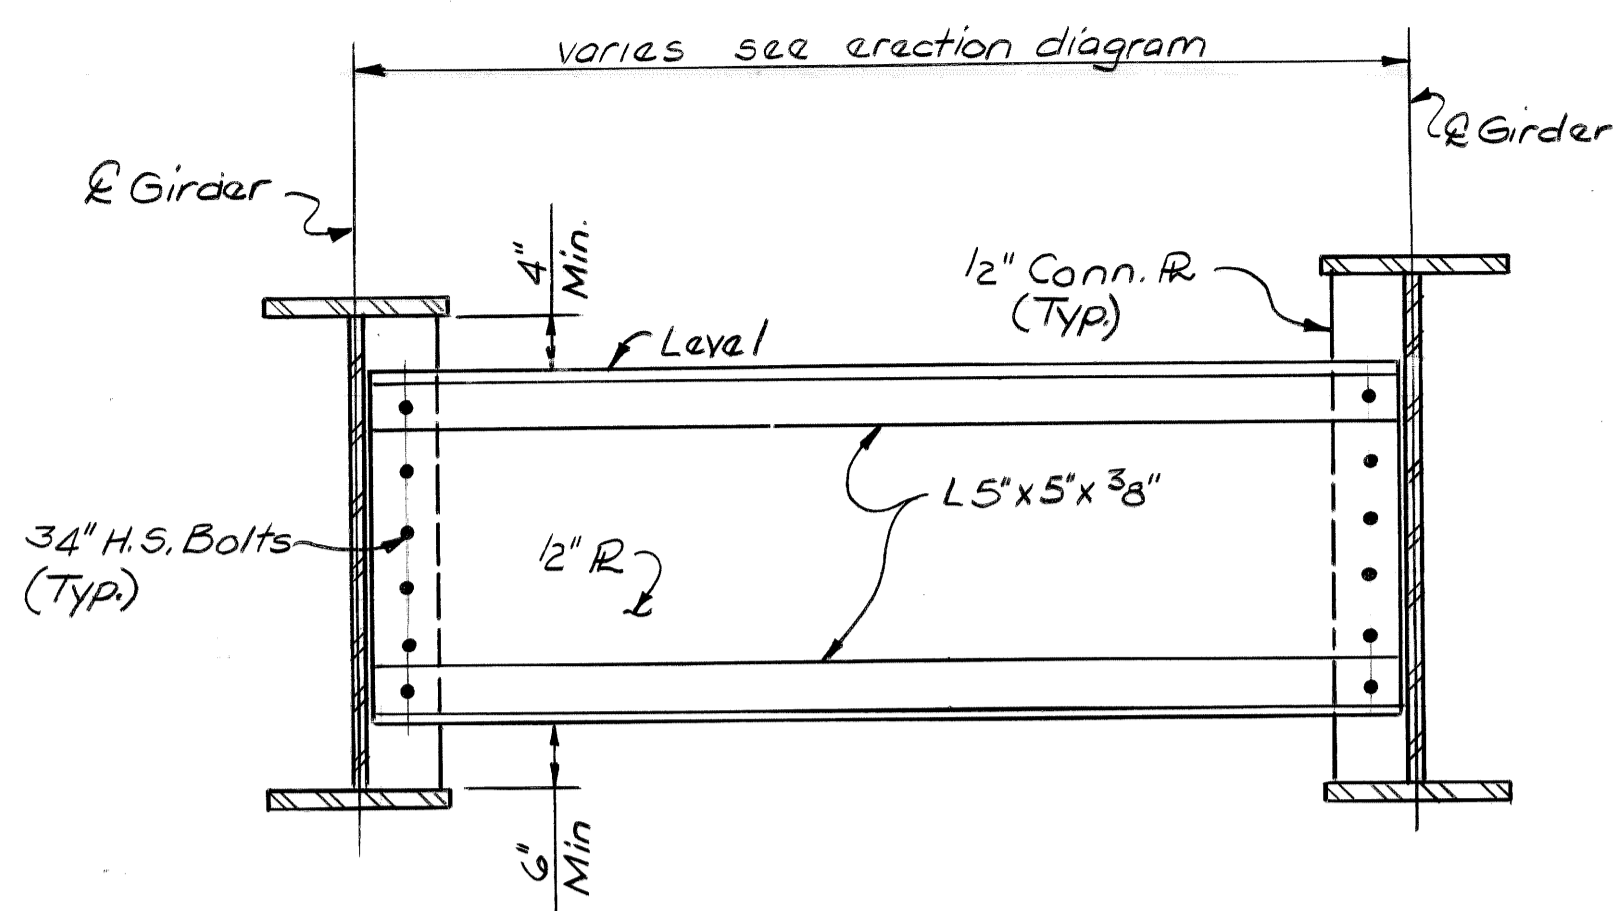


DIAPHRAGM D1

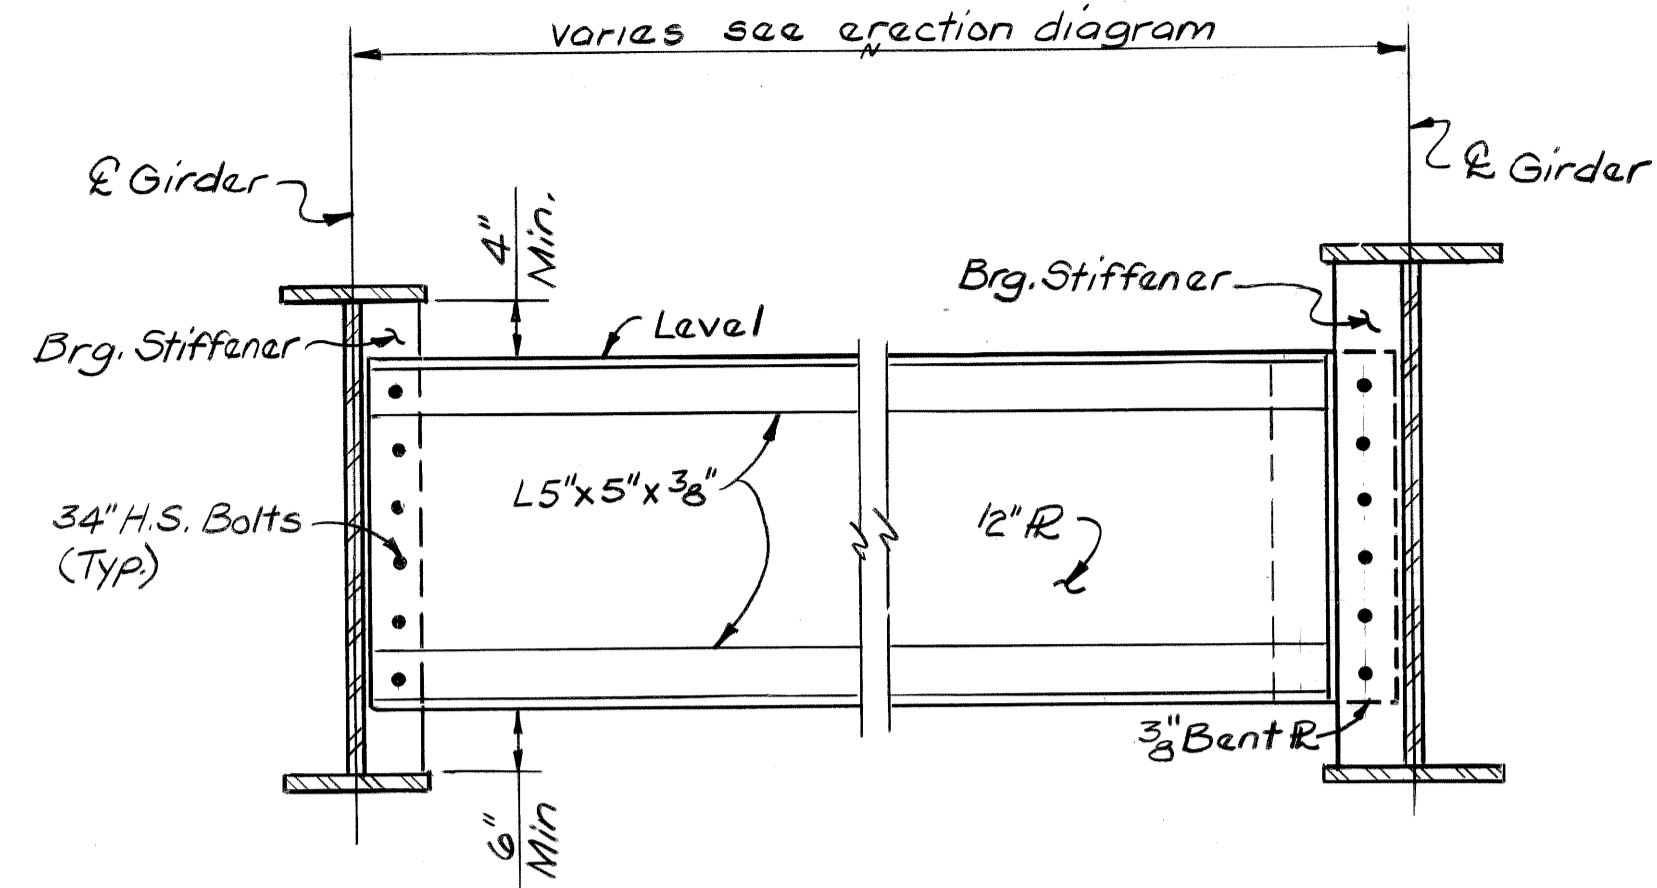


DIAPHRAGM D3

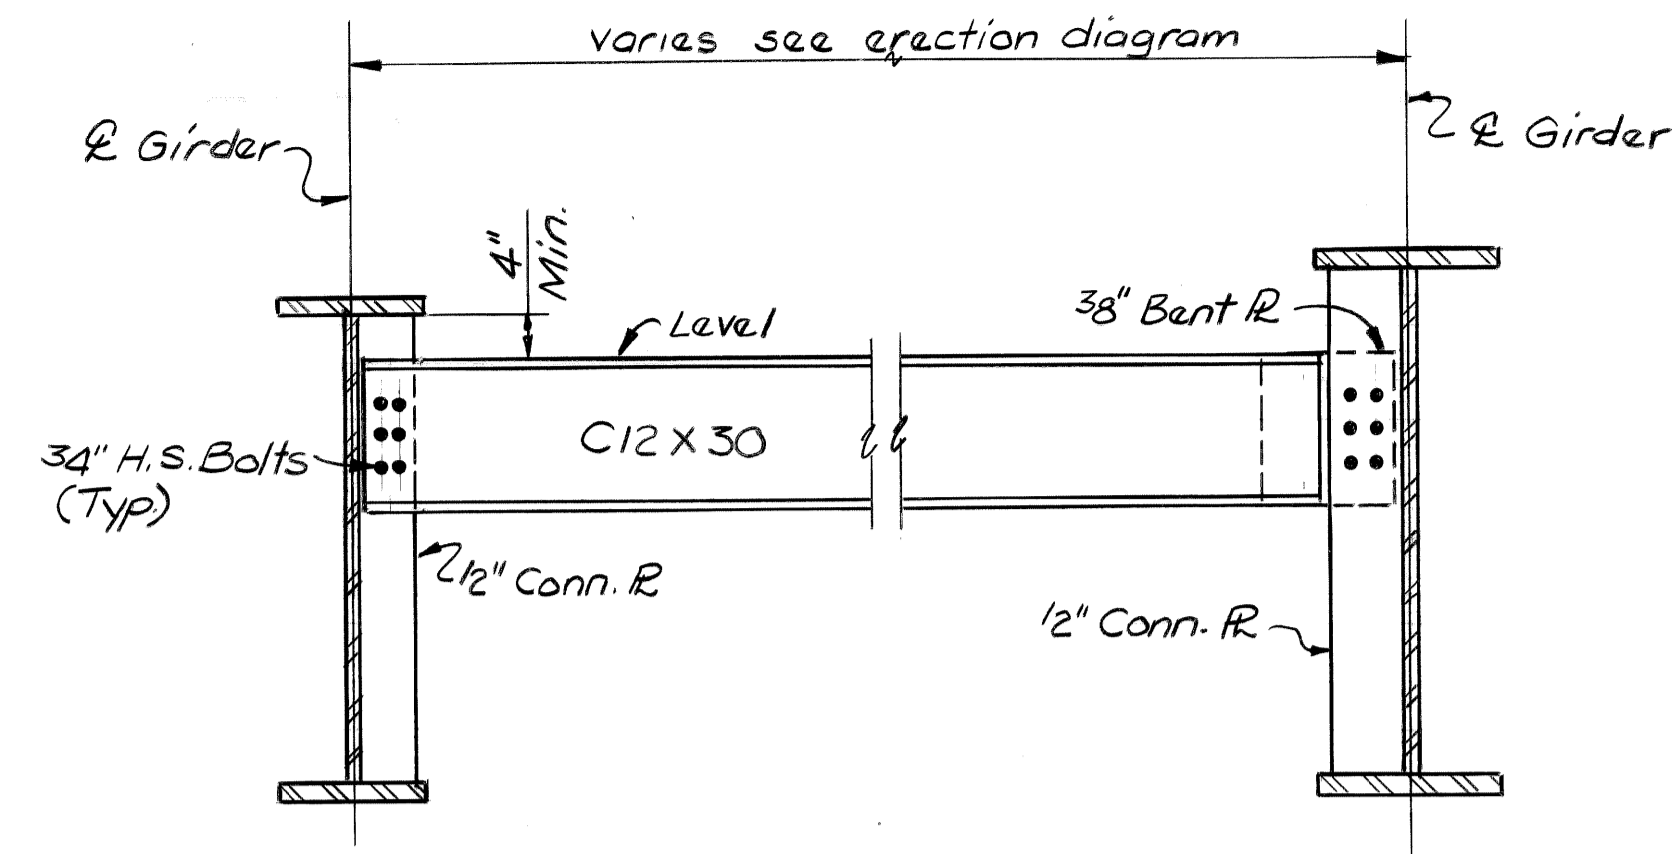


DIAPHRAGM D2

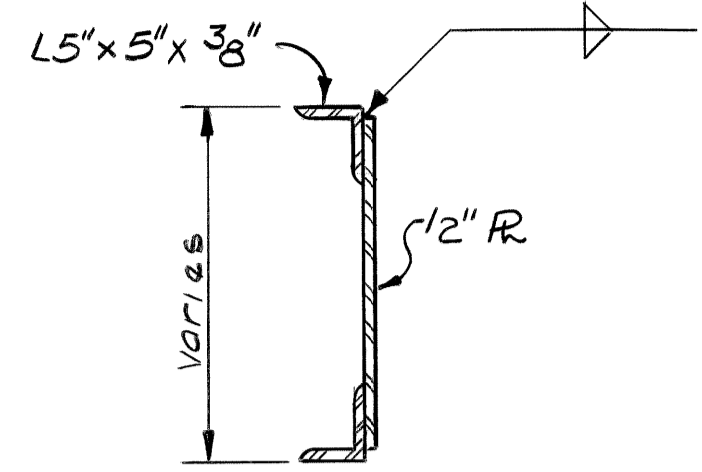


SECTION THRU DIAPHRAGM D1 or D3

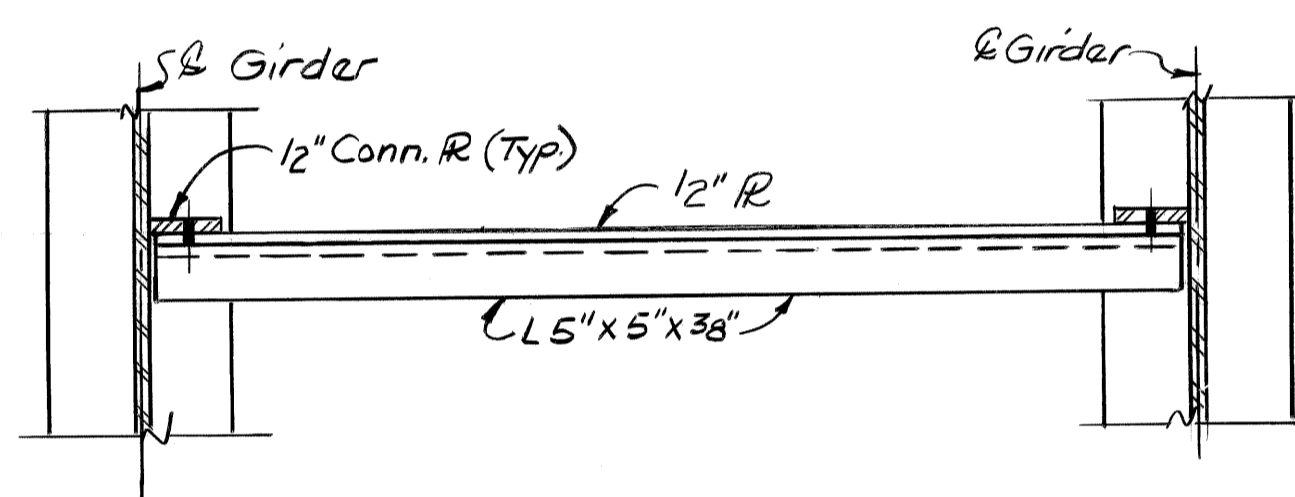


PLAN of D1

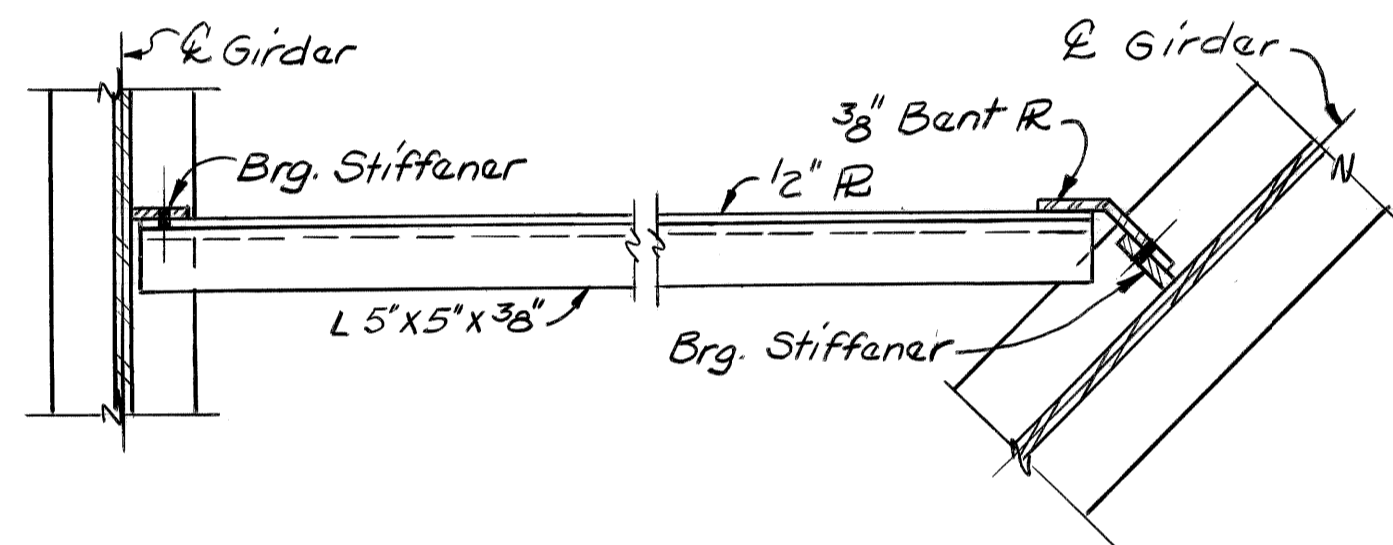


PLAN of D3

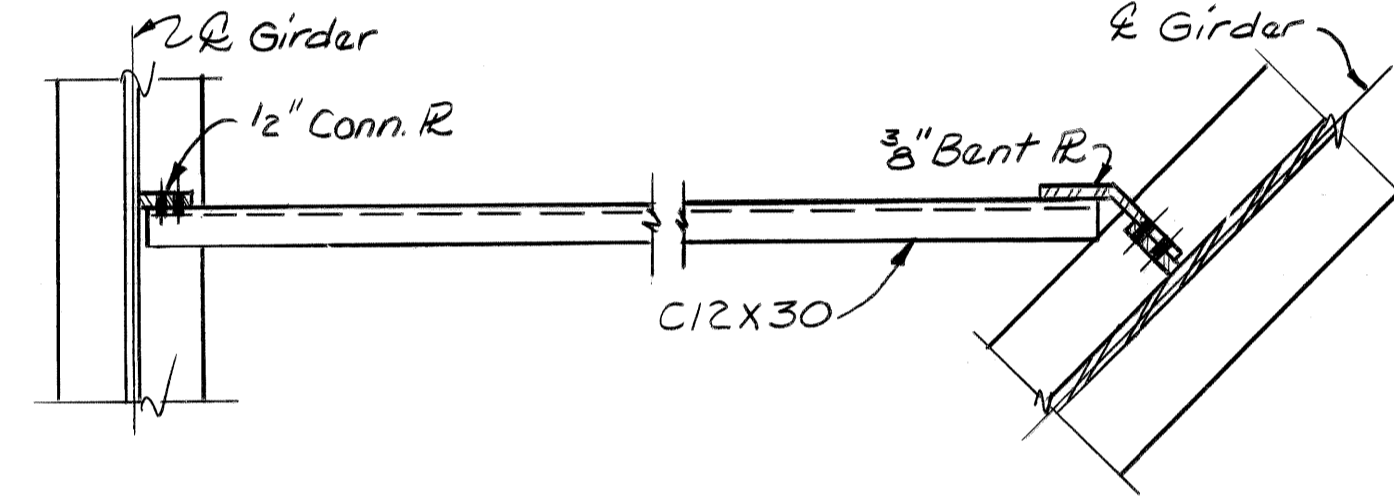


PLAN of D2

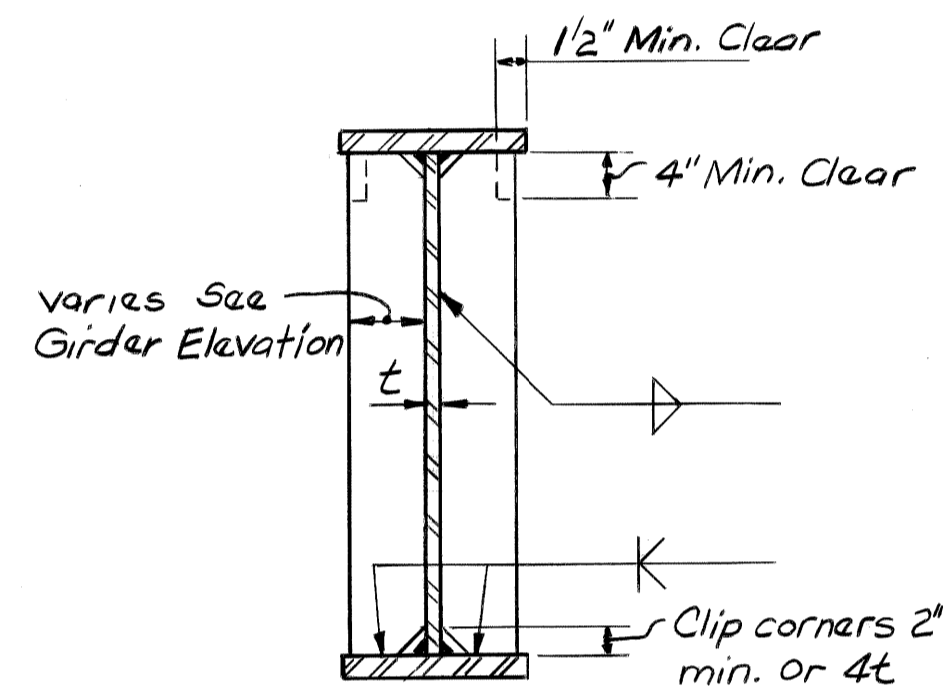


BEARING STIFFENER DETAIL

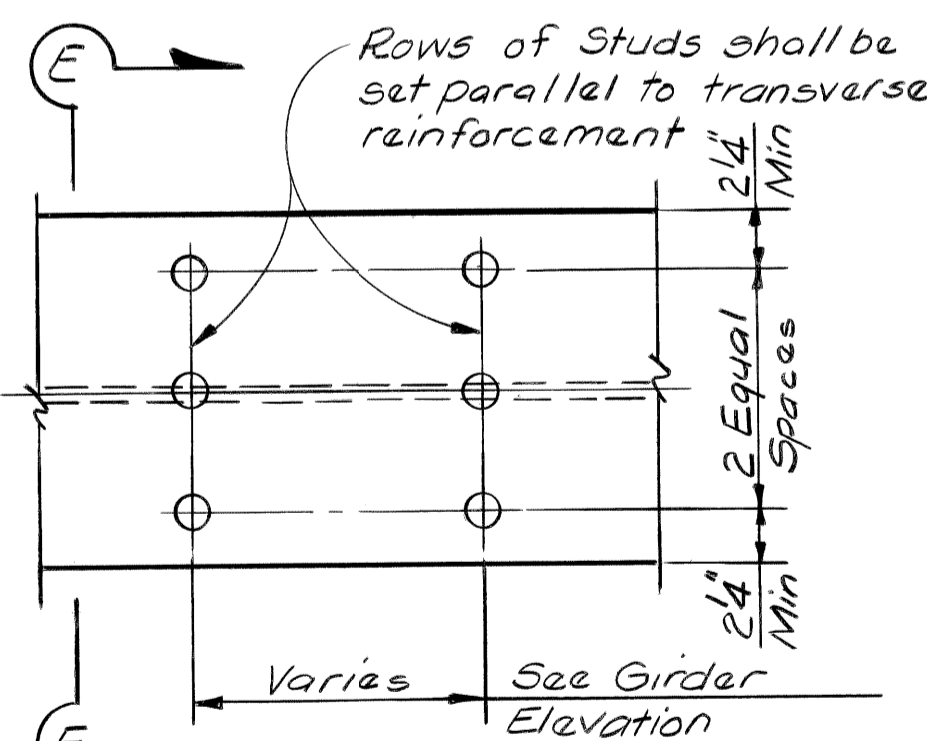

PLAN

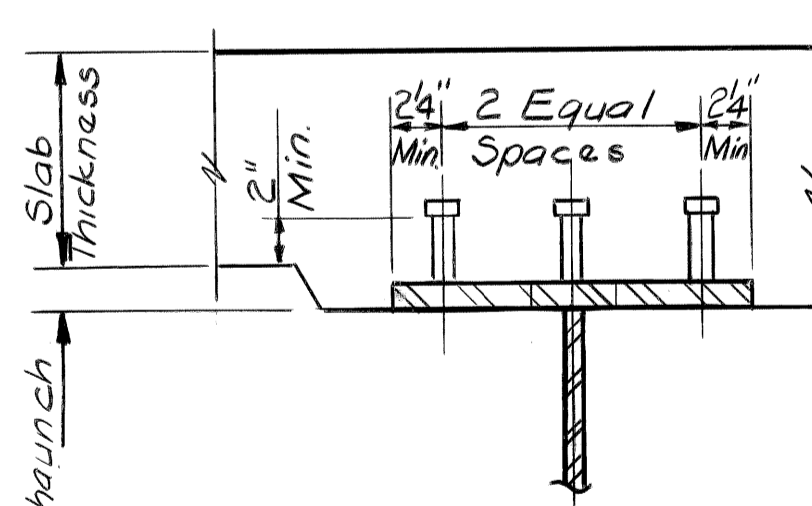


SECTION E-E

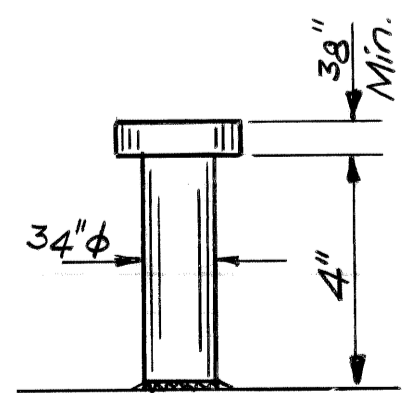


DETAIL OF STUD

STUD SHEAR DEVELOPER DETAILS

NOTES:
Furnishing of studs and welding of studs to girder flanges is included in the bid item "Shear Developers."

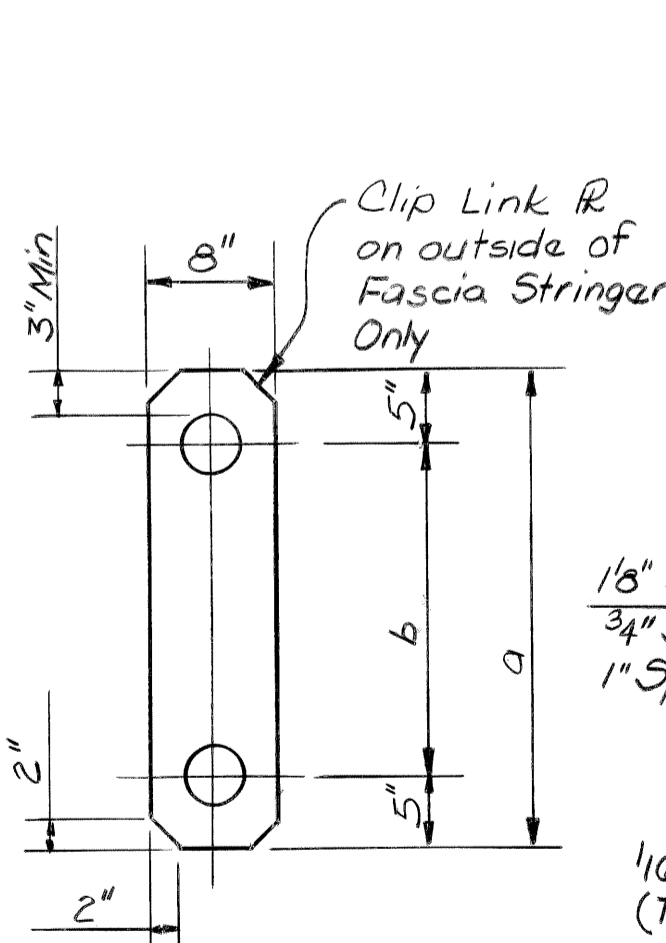

LINK R DETAIL

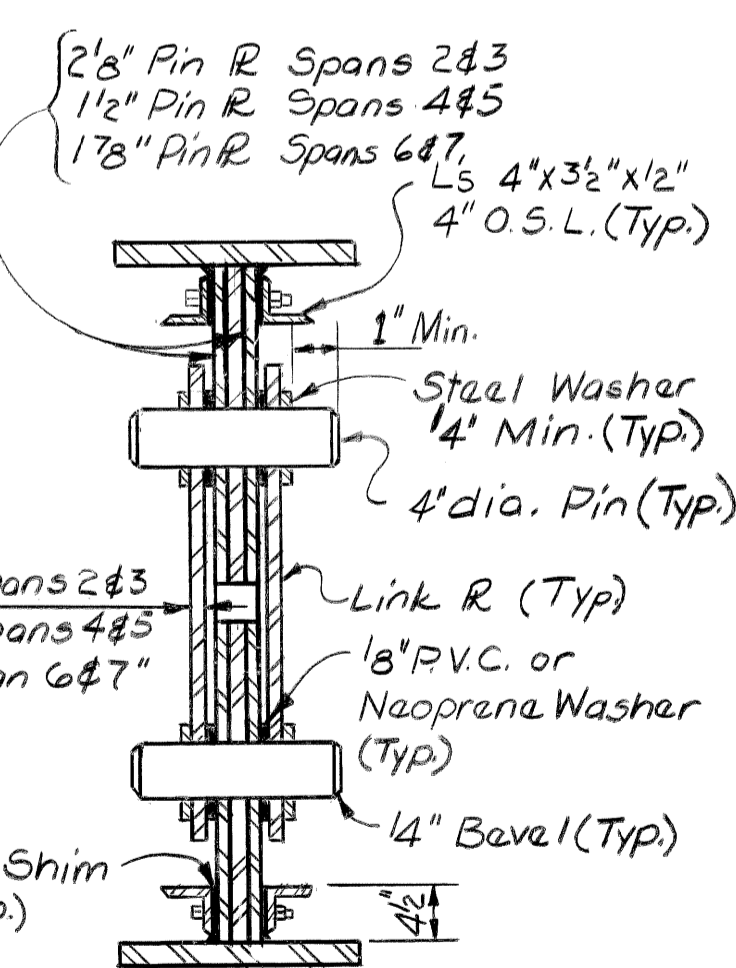

SECTION AT PIN

LINK PLATE DIMENSIONS					
Girder Depth Dimension	42"	39"	36"	33"	30"
a	31"	28"	25"	22"	19"
b	21"	18"	15"	12"	9"

SEE SPAN 2 OR SPAN 3 ERECTION DIAGRAM

CONSTRUCTION STAGING
(For Additional Diaphragms in Span 2 & Span 3)

Span 2 Construction

Stage One: Shore the compression (top) flange of Girder A at 1/4 points between centerline bearing to centerline bearing to resist a minimum of 1-1/4 Tons each.

Stage Two: Remove the bolts on existing 5 interior diaphragms (See Span 2 Erection Diagram), Girder A only and remove connection angle.

Stage Three: Replace connection angle with new L6" x 6" x 1/2" (See Existing Diaphragm Details). Ream holes and bolt new connection angle to Girder A, replacing 3/4" ϕ bolts with 7/8" ϕ H.S. bolts. Extra bolt hole in new connection angle is to be above top of bent plate. Drill new hole in web and align with extra bolt hole in new connection angle and place 7/8" ϕ bolt.

Stage Four: Weld existing bent plates to new connecting angles. Position additional diaphragms (See Span 2 Erection Diagram) and weld new connection plate to the girders.

Stage Five: Remove Girder A shoring. Shore the compression (top) flange of Girder B at 1/4 points between centerline bearing to centerline bearing to resist 1-1/4 Tons each.

Stage Six: Remove the bolts on existing 5 interior diaphragms (See Span 2 Erection Diagram), that are fastening the bent plate to the connecting angle.

Stage Seven: Ream holes through bent plate and connecting angle and replace 3/4" ϕ bolts. If a significant movement occurs, that makes reaming the holes impractical, the reconstruction shall be accomplished by plug welding utilizing the existing bolt holes and fillet welding bent plate to connecting angle. The use of the latter procedure is to be determined in the field by the Engineer.

Stage Eight: Remove Girder B shoring.

Span 3 Construction

Stage Nine: Position additional diaphragms between Girder A and Girder B (See Span 3 Erection Diagram) and weld connecting plates to the girders.

Work This Sheet With Sheets# S49 thru S61

DATE: August, 1979

DSGN BY: SJP, RGW
DRN BY: MH
CK'D BY: SJP, RGW
APP'D BY:

REVISIONS
Add Construction Staging Notes SJP/EJ/2/80


CITY OF DETROIT, MICHIGAN

Snell Environmental Group
LANSING INDIANAPOLIS AKRON


JOHN C. LODGE EXIT RAMP AND JEFFERSON AVENUE-
RECONSTRUCTION AT THE JOE LOUIS ARENA.

STRUCTURAL STEEL DETAILS
DIAPHRAGM AND MISCELLANEOUS DETAILS


SCALE: NONE
DRN. NO: S62

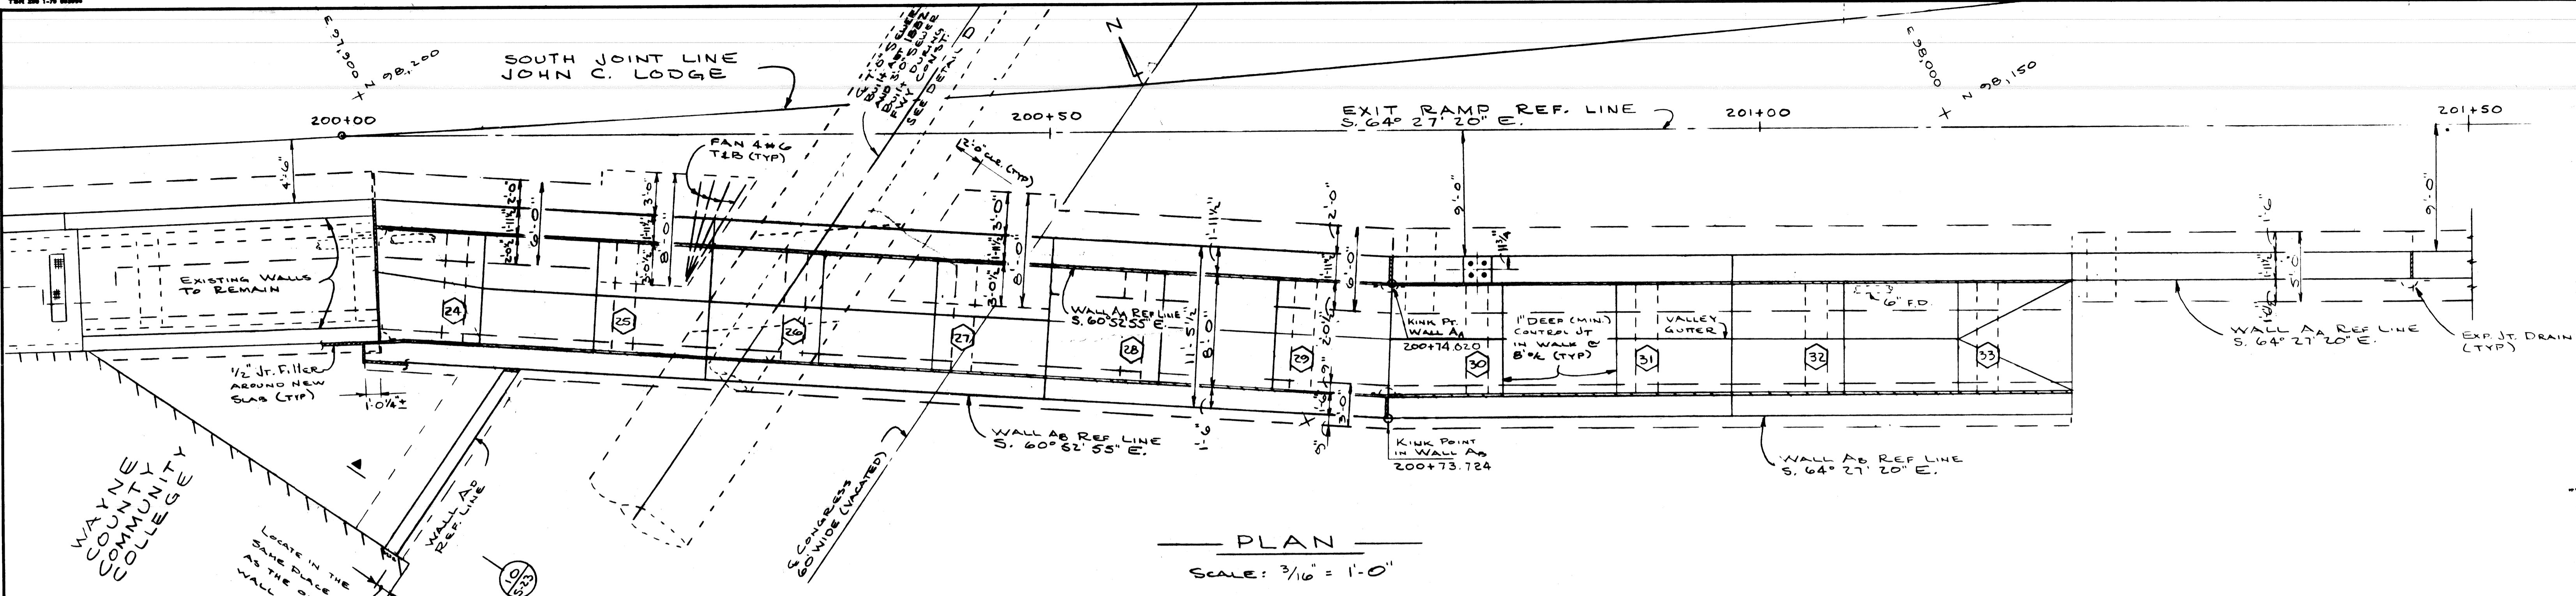



PLAN
SCALE: 3/16" = 1'-0"

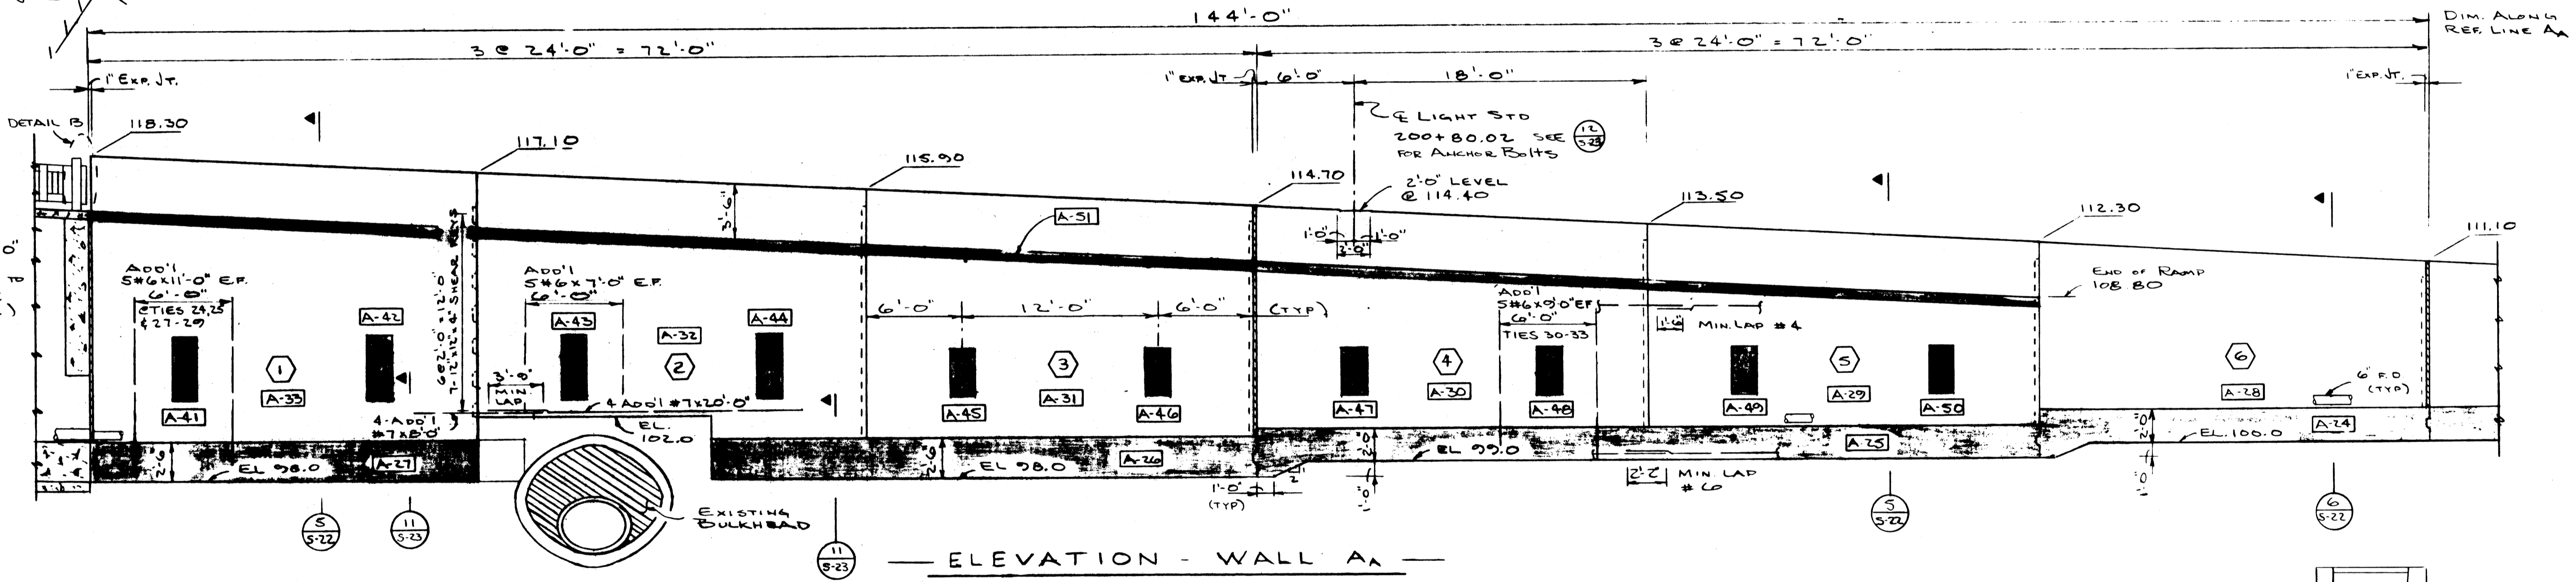


ELEVATION - WALL A
SCALE: 3/16" = 1'-0"

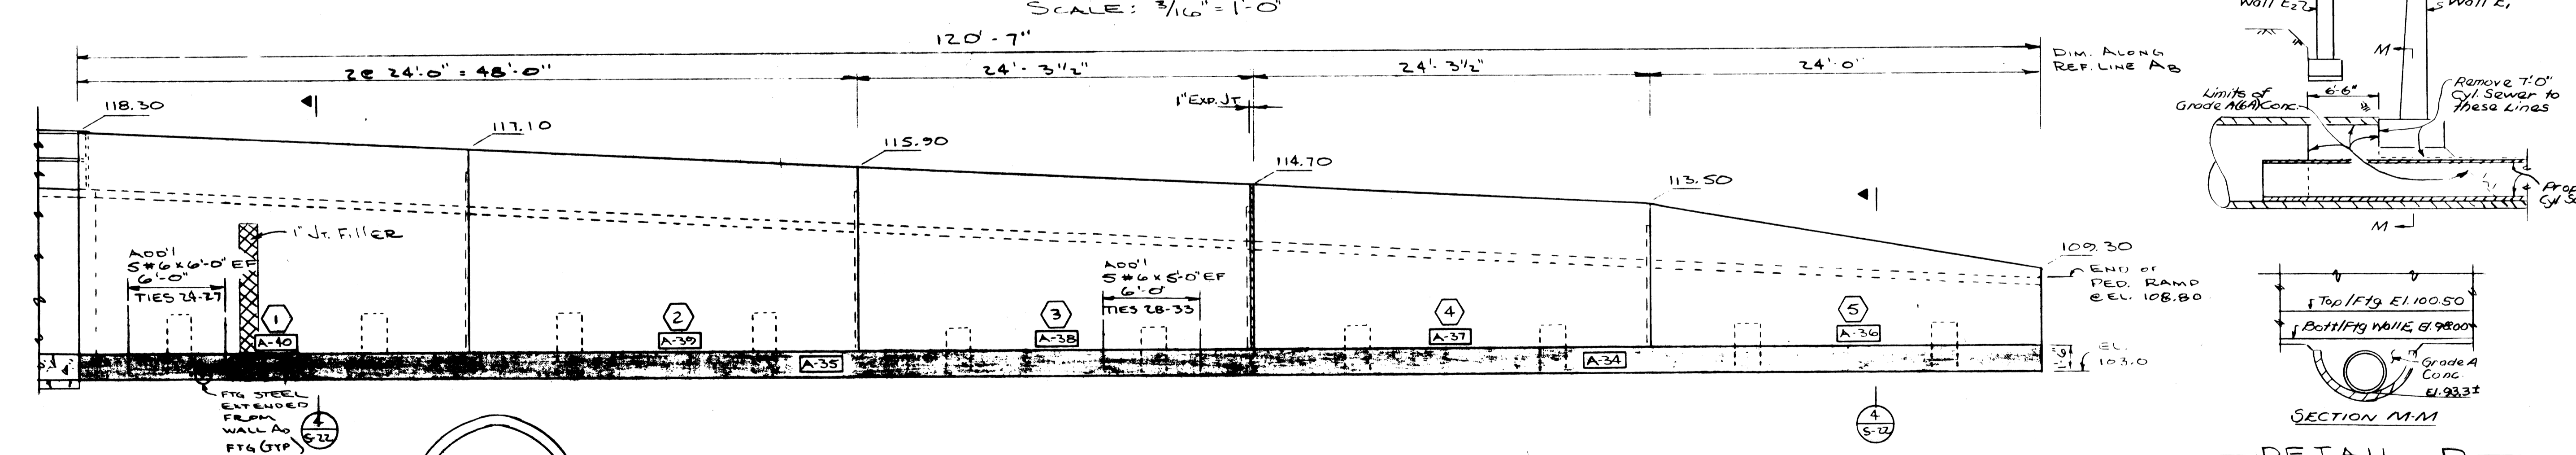


ELEVATION - WALL B
SCALE: 3/16" = 1'-0"

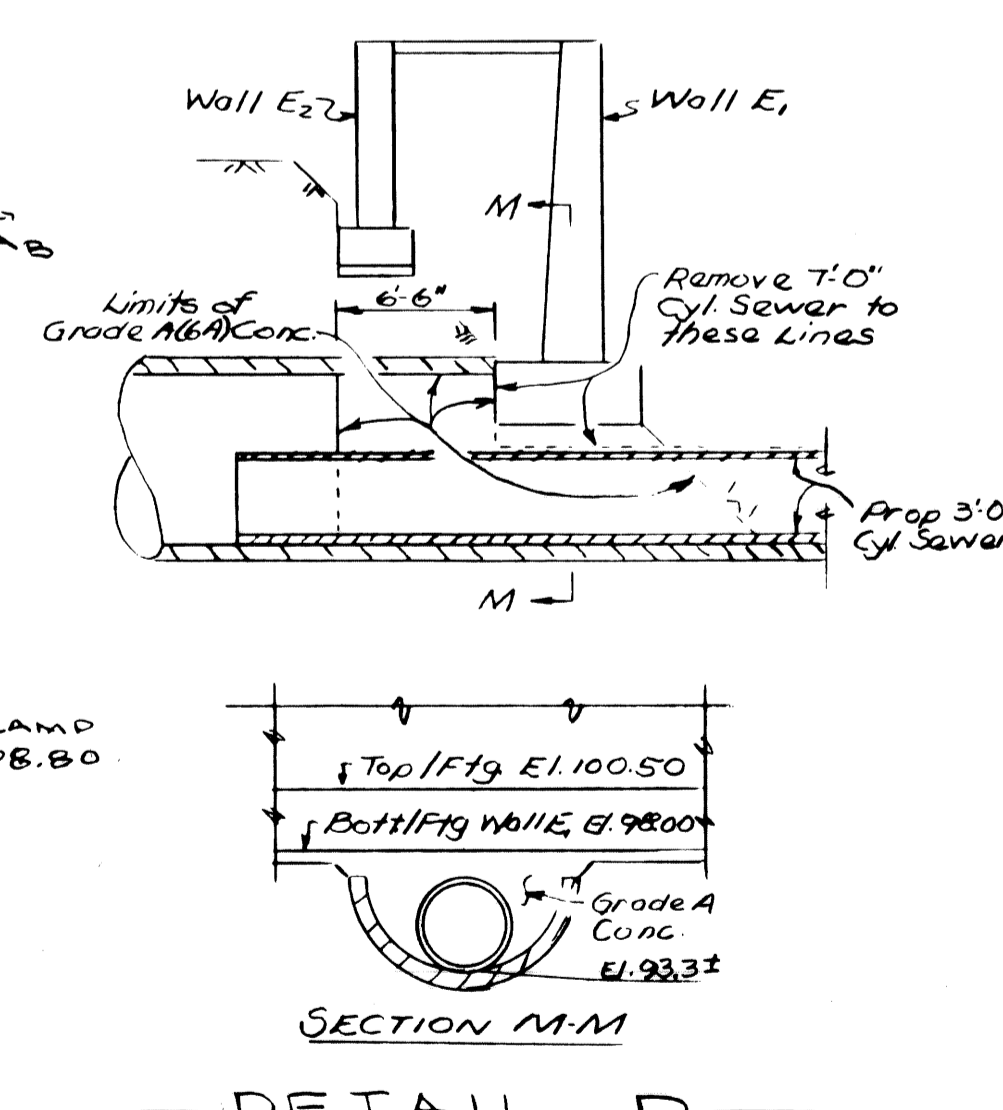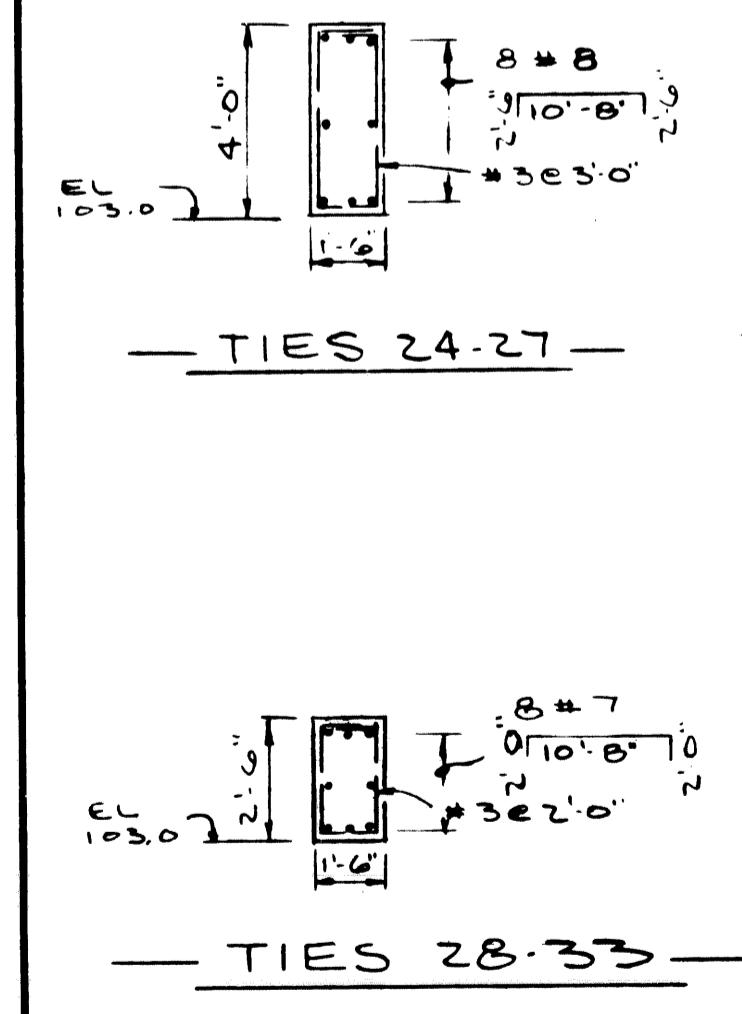


REVISIONS LOCATED BY COORDINATES ON SHEET		DESIGNED BY <i>R. Kahan</i>	APPROVED:	CITY OF DETROIT CITY ENGINEERING DIVISION - EPMD	JOHN C. LODGE EXIT RAMP AND JEFFERSON AVE RECONSTRUCTION AT THE JOE LOUIS ARENA RAMP - WALL A & B DETAILS	SHEET ___ OF ___ SHEETS CONTRACT NO. 16563 A DRWG. NO. S-21 DATE AUG 1979
DRAWN BY <i>R. Kahan</i>	TRACED BY	CHECKED BY <i>M. J. ...</i>	COORD. DESCRIPTION DRN CK'D AP'D DATE	CITY OF DETROIT CITY ENGINEERING DIVISION - EPMD	JOHN C. LODGE EXIT RAMP AND JEFFERSON AVE RECONSTRUCTION AT THE JOE LOUIS ARENA RAMP - WALL A & B DETAILS	SHEET ___ OF ___ SHEETS CONTRACT NO. 16563 A DRWG. NO. S-21 DATE AUG 1979

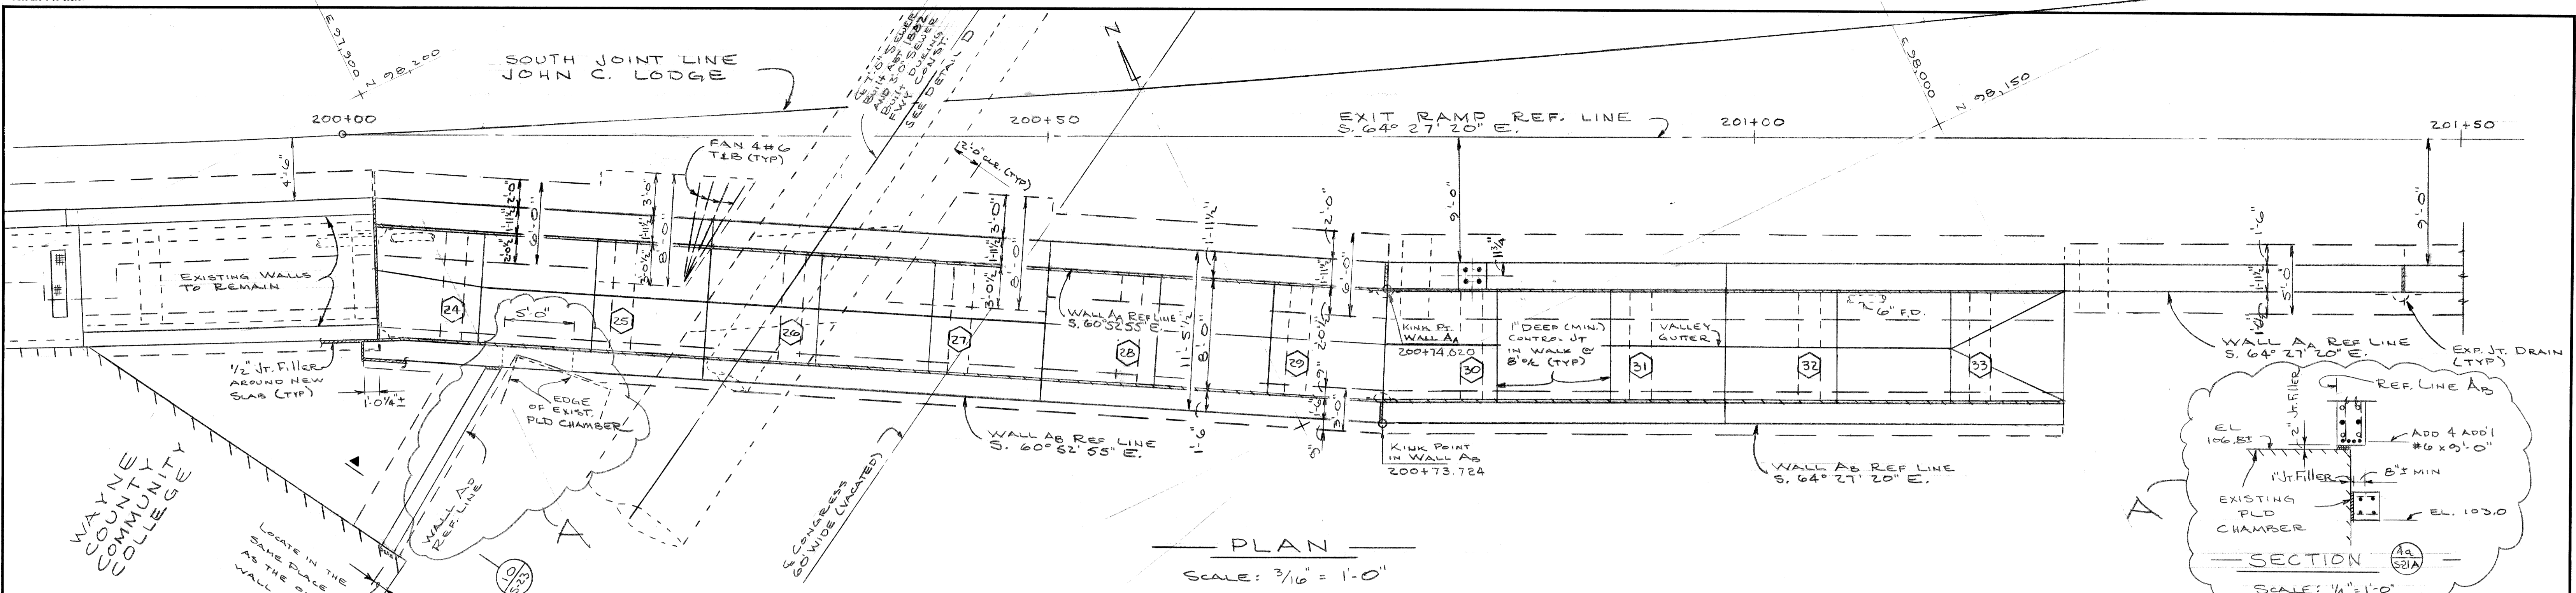


PLAN
SCALE: 3/16" = 1'-0"

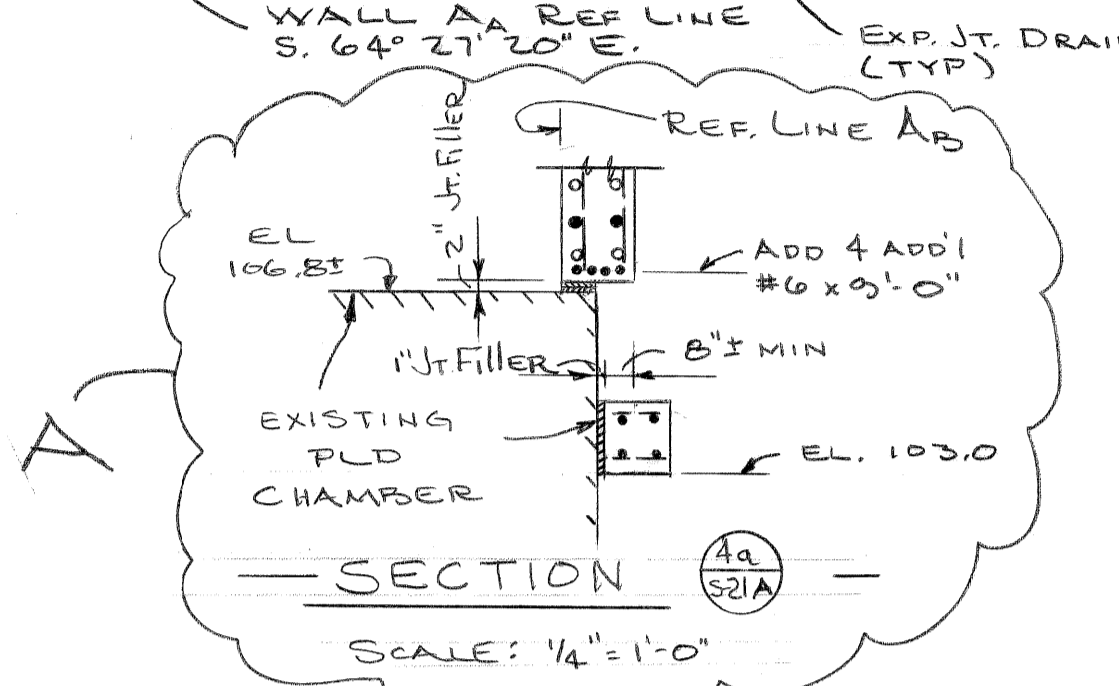


SECTION
SCALE: 1/4" = 1'-0"

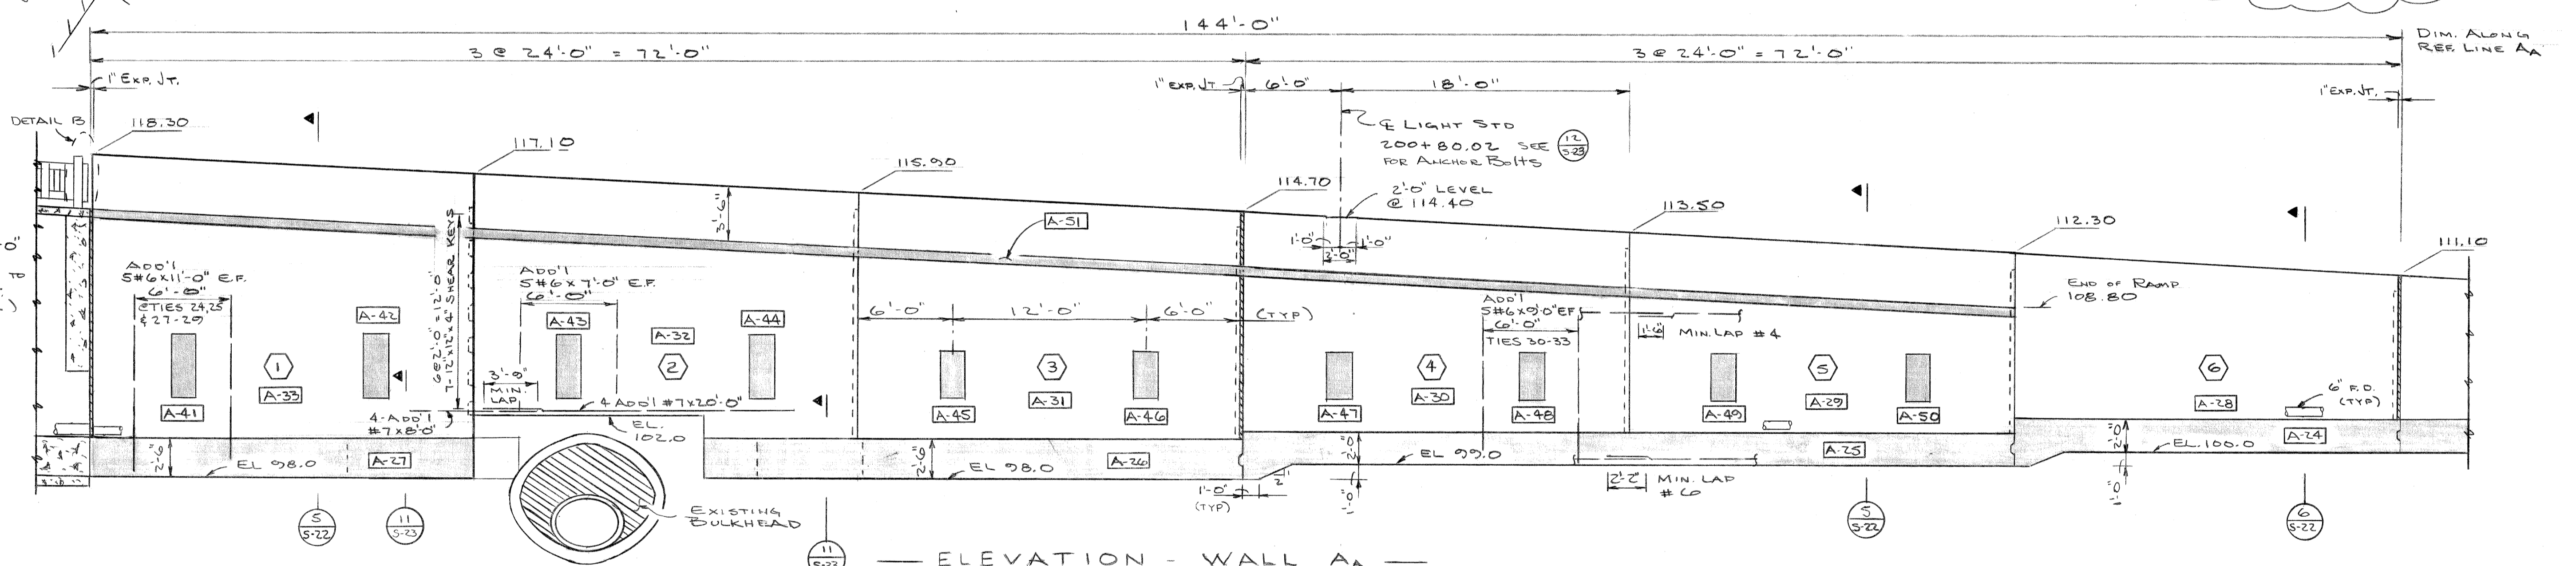


ELEVATION - WALL A
SCALE: 3/16" = 1'-0"

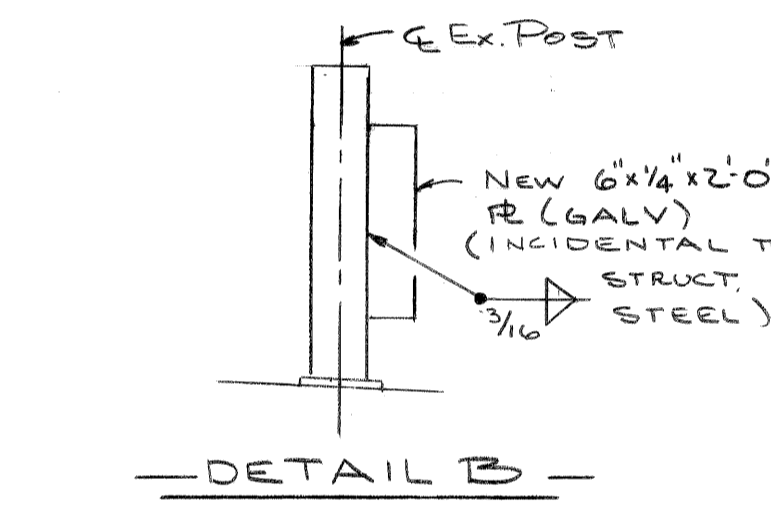


DETAIL B

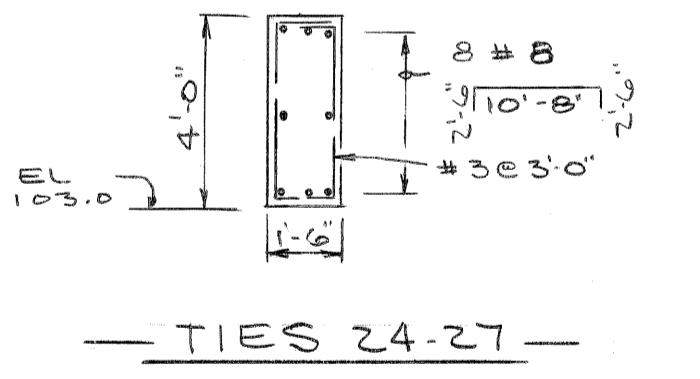


TIES 24-27

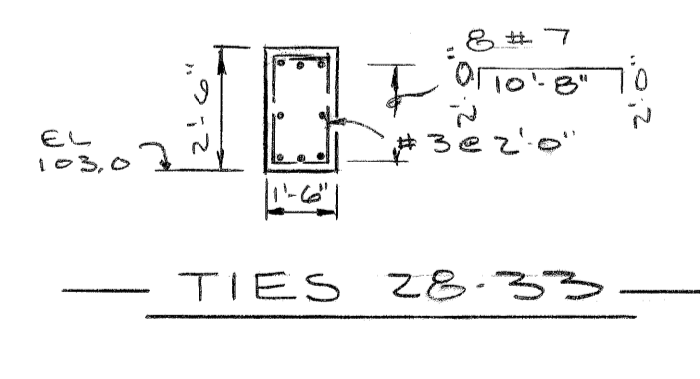


TIES 28-33

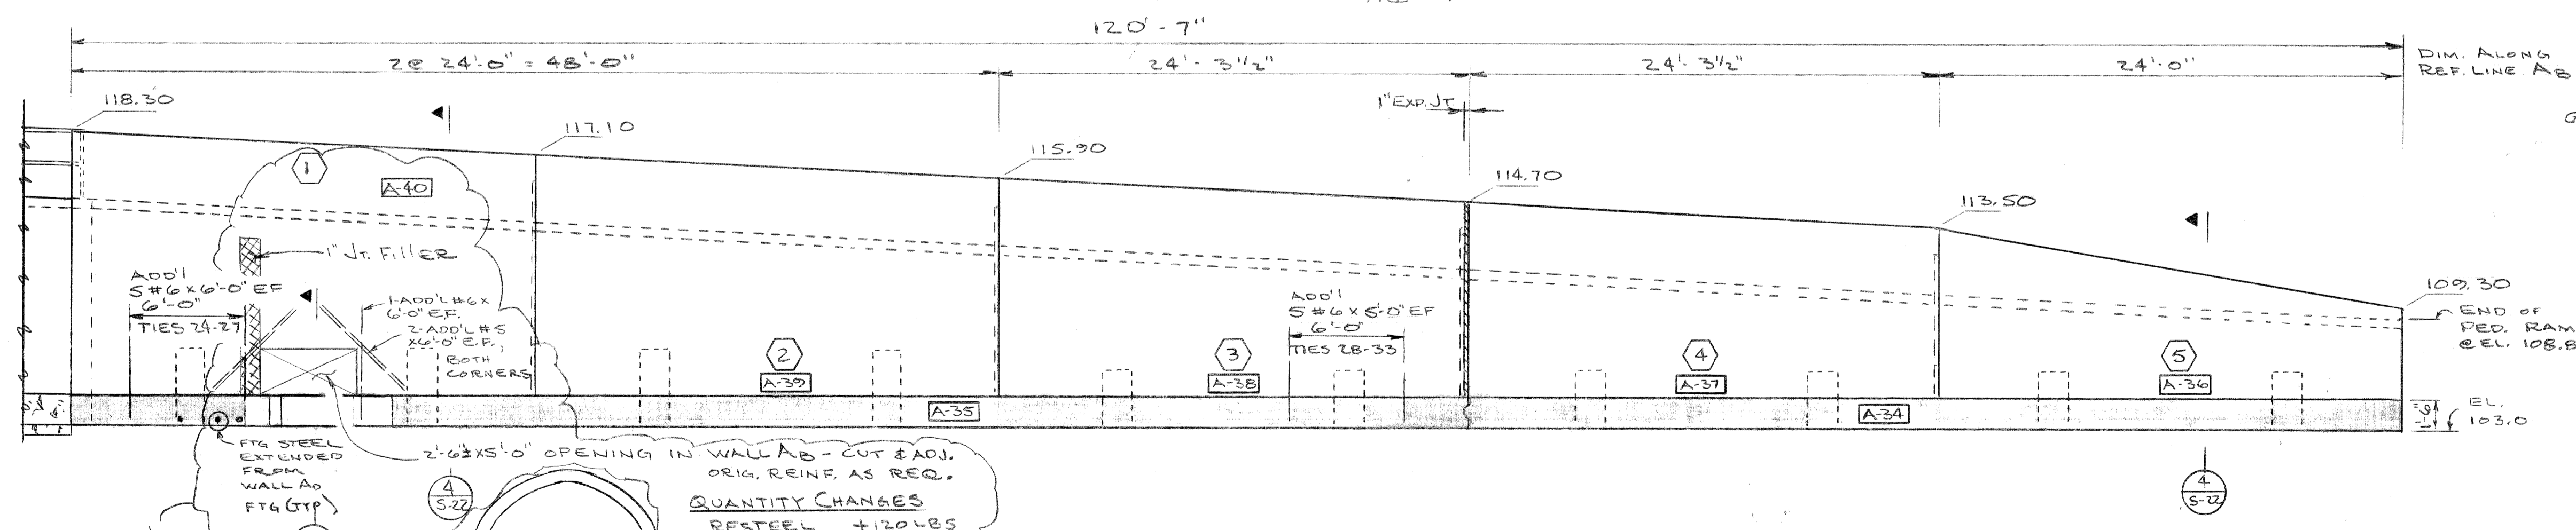

ELEVATION - WALL AB
SCALE: 3/16" = 1'-0"

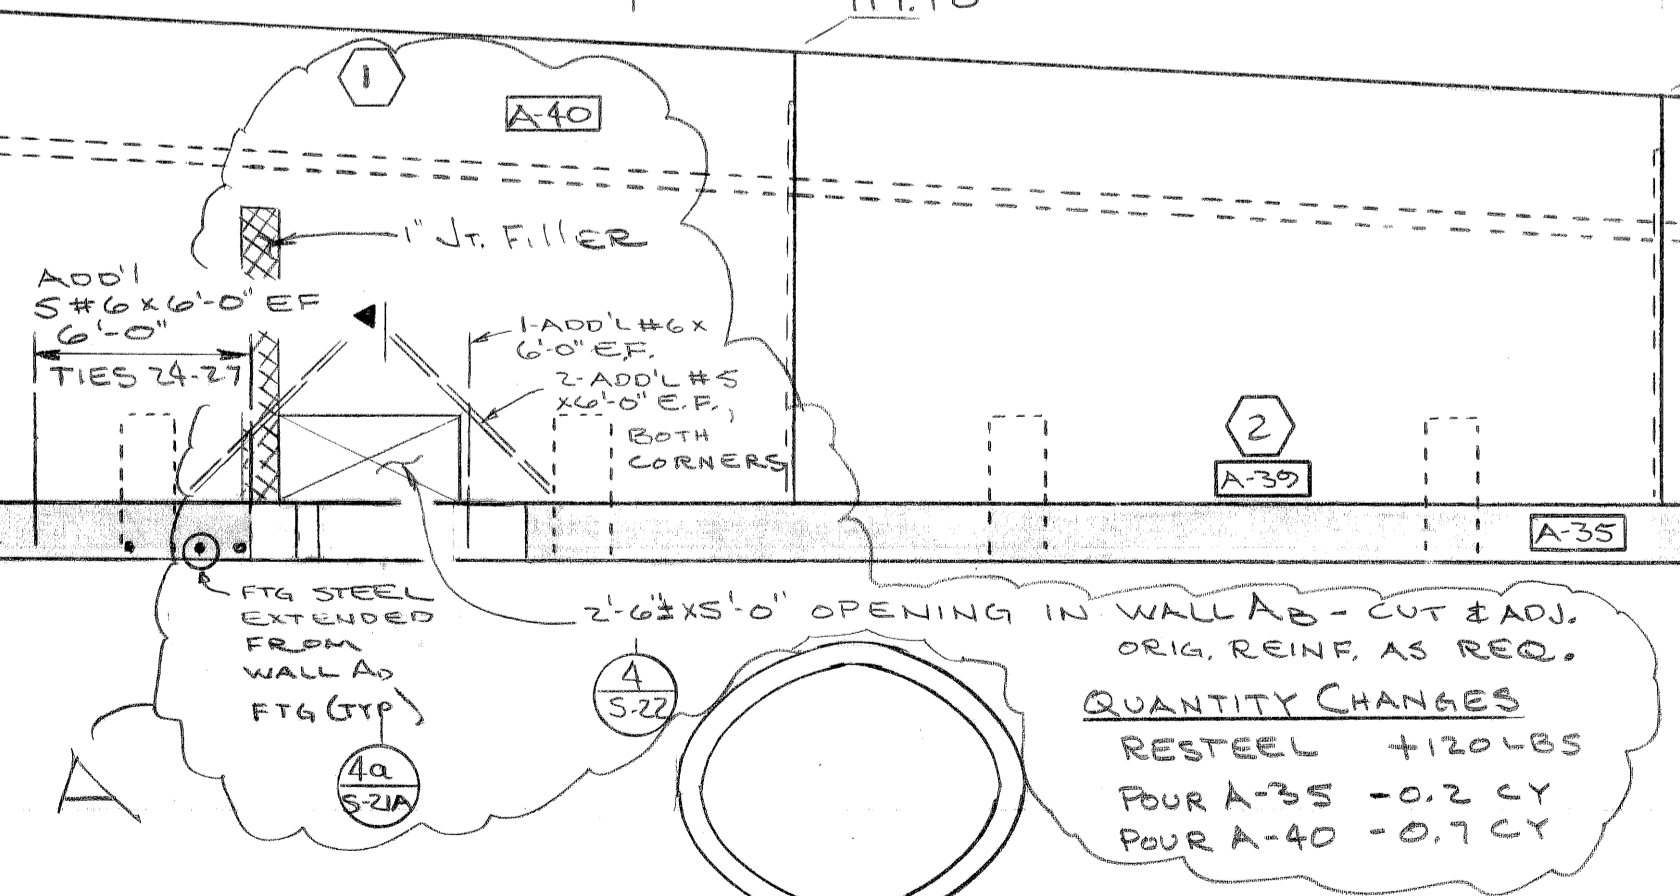


2'-6" x 5'-0" OPENING IN WALL AB - CUT & ADJ. ORIG. REINF. AS REQ. QUANTITY CHANGES RESTEEL +120 LBS FOUR A-35 -0.2 CY FOUR A-40 -0.7 CY

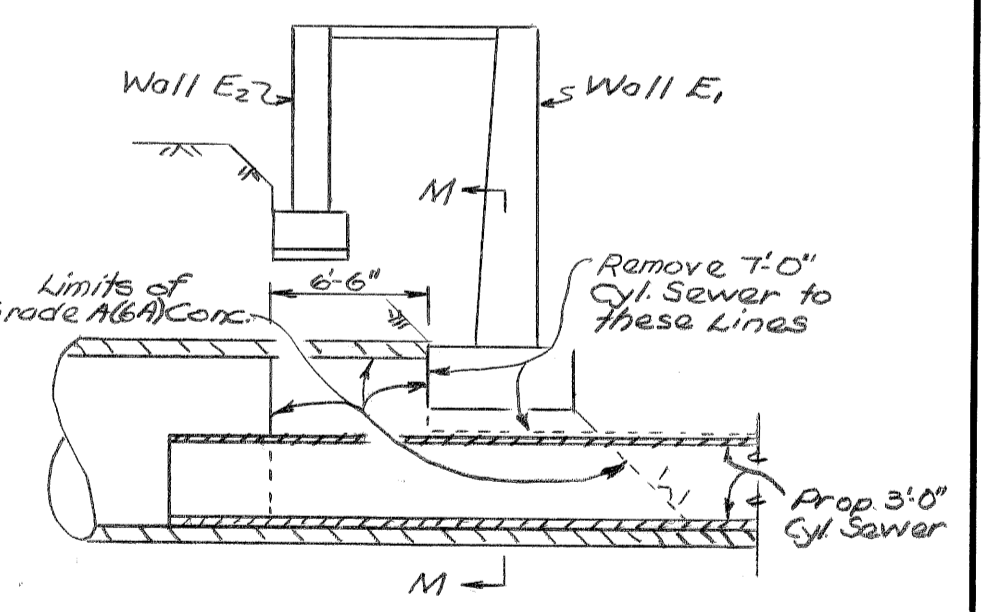


DETAIL D

SCALE: 1/8" = 1'-0" (FROM ORIG. FWY. DRWGS.)

REFERENCE DRAWINGS DESIGNED BY: <i>R. K. ...</i> DRAWN BY: <i>R. K. ...</i> TRACED BY: CHECKED BY: <i>M. J. ...</i>		APPROVED: CITY OF DETROIT CITY ENGINEERING DIVISION - EPMD	JOHN C. LODGE EXIT RAMP AND JEFFERSON AVE RECONSTRUCTION AT THE JOE LOUIS ARENA RAMP - WALL A & AB DETAILS	SHEET _____ OF _____ SHEETS CONTRACT NO. 16563A DRWG. NO. S-21A DATE AUG 1979
REVISIONS LOCATED BY COORDINATES ON SHEET 1 2		3 4 5 6 7 8 9 10 11		

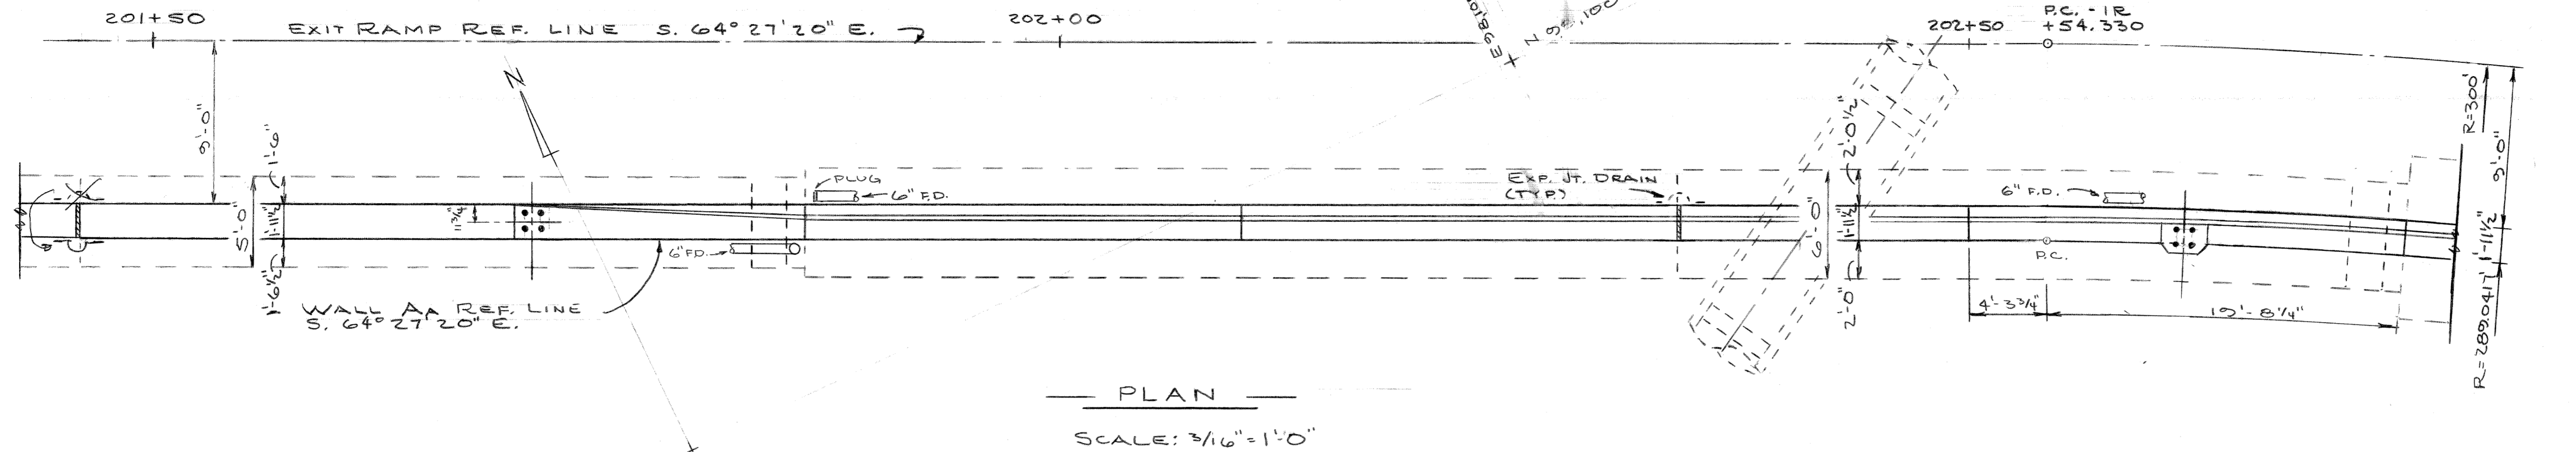


PLAN
SCALE: 3/16" = 1'-0"

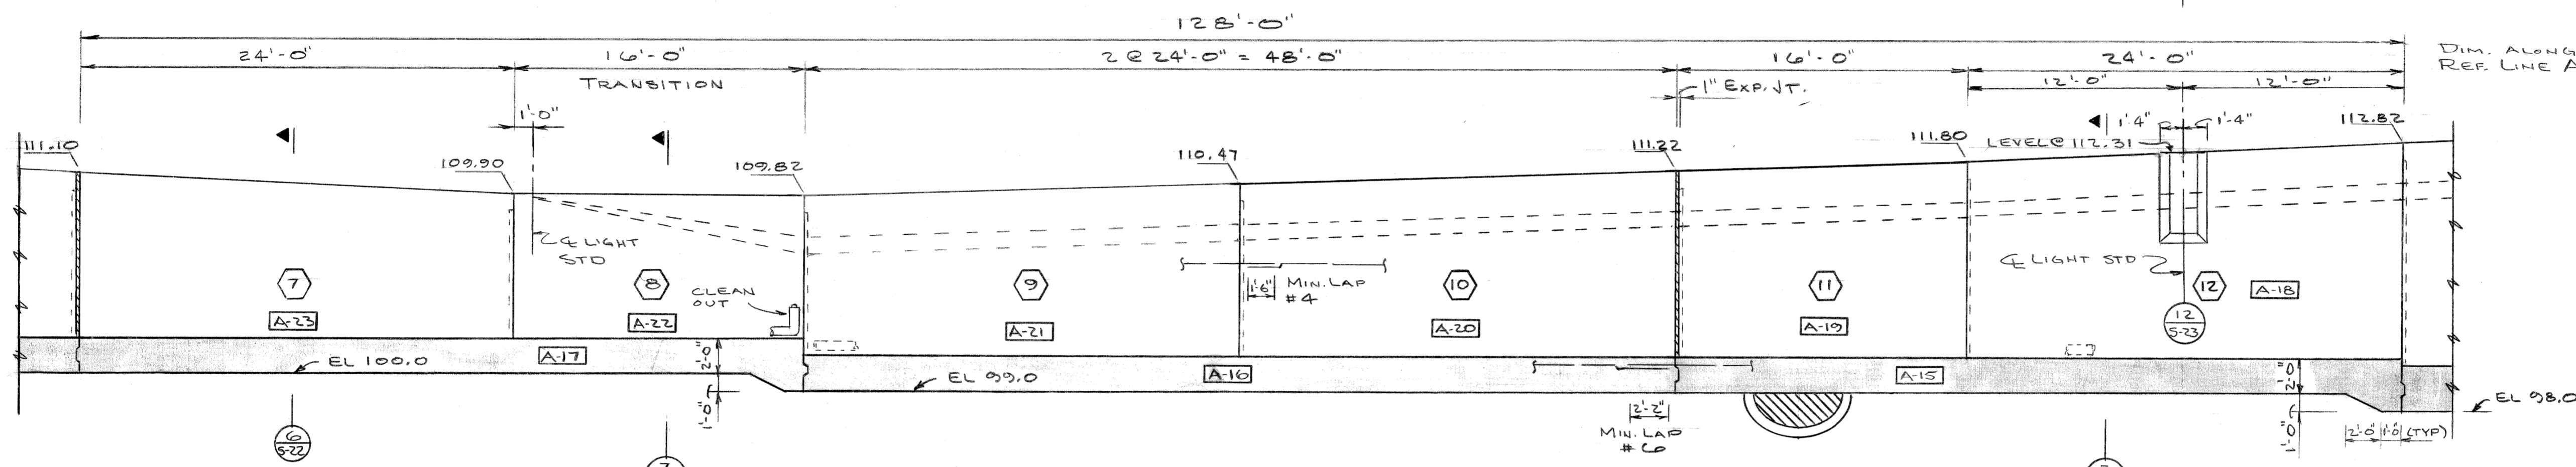


ELEVATION
SCALE: 3/16" = 1'-0"


ADDITIONAL REINFORCEMENT (ALL SPACING @ 18")				
WALL	a	b	c	d
A _A 1-3	#6x7'-0"	-	-	-
A _A 4-12	-	-	-	-
A _A 13-14	#6x5'-0"	-	-	-
A _A 15-16	#6x7'-0"	-	-	#6x4'-0"
A _A 17	#7x9'-0"	#7x6'-0"	#6x6'-0"	#6x5'-0"
A _B 1-5	-	-	-	-
A _C 1	-	-	-	-
A _C 2	#6x7'-0"	-	-	#6x4'-0"
A _C 3	#7x9'-0"	#7x6'-0"	#6x6'-0"	#6x5'-0"

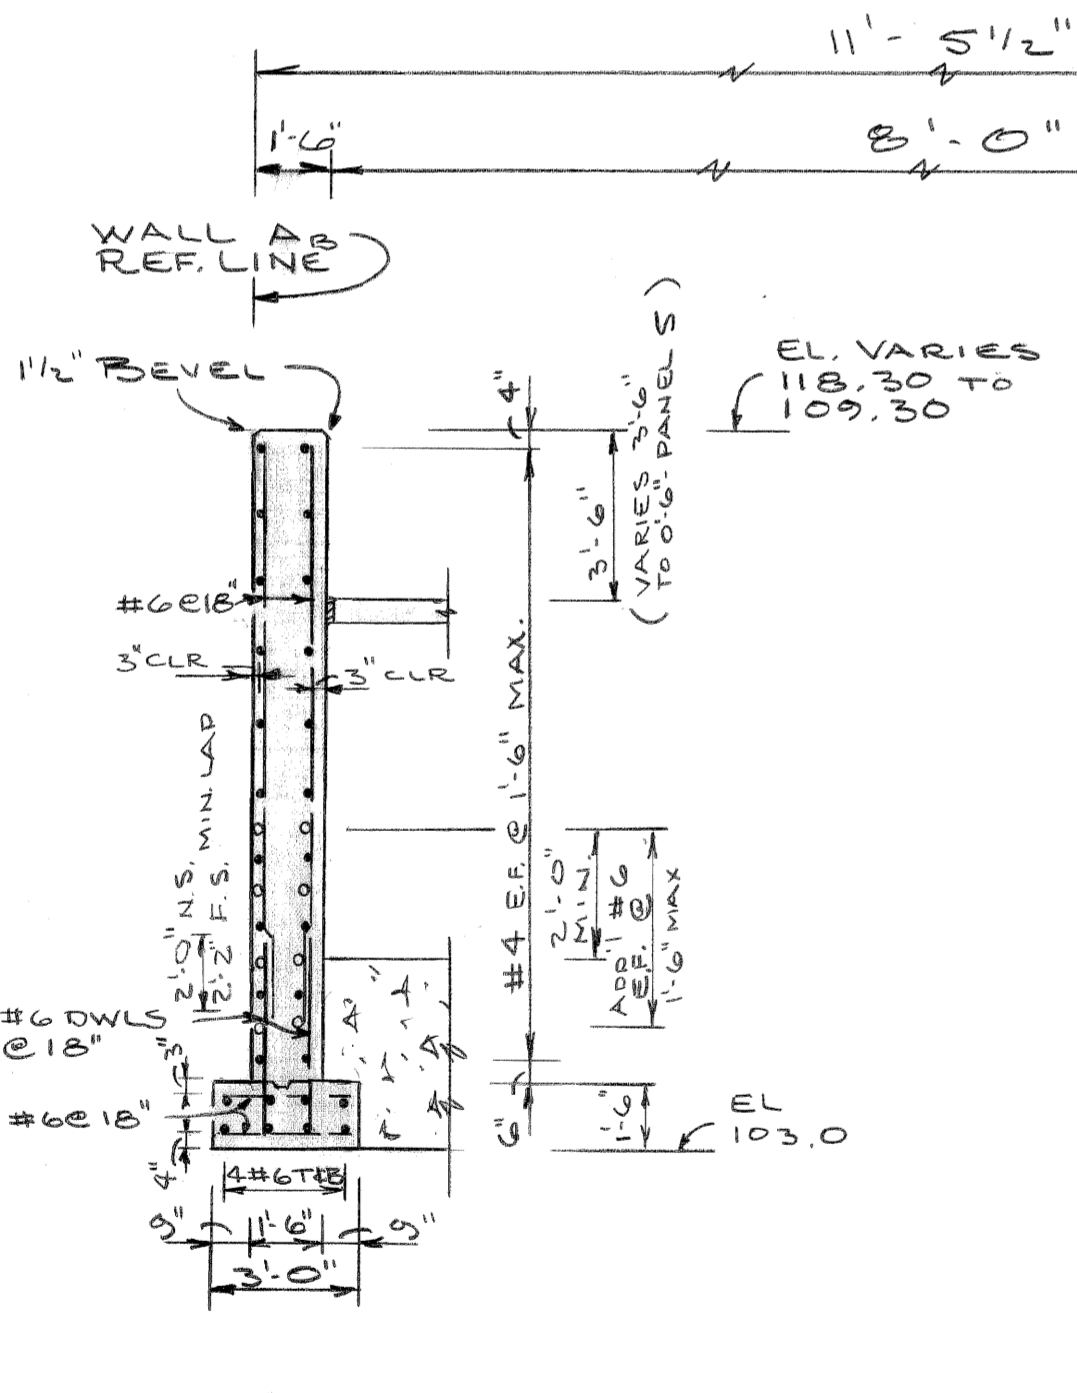


SECTION 4
SCALE: 1/4" = 1'-0"

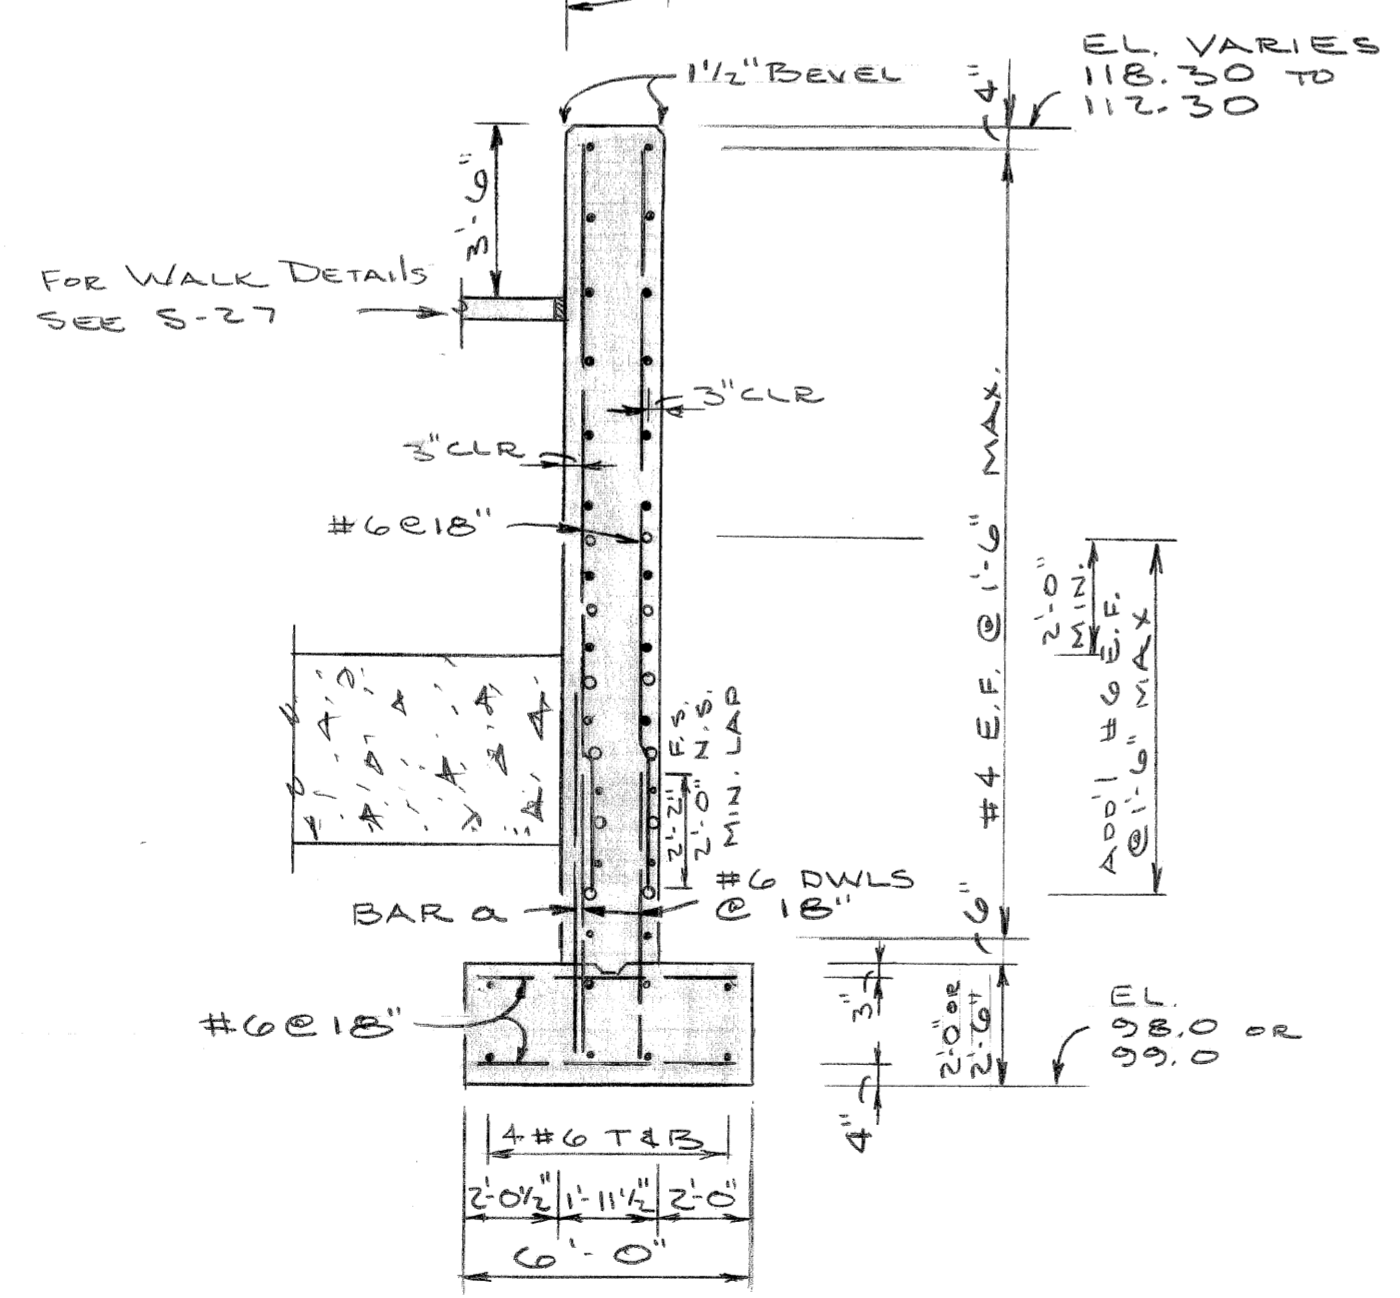

SECTION 5
SCALE: 1/4" = 1'-0"

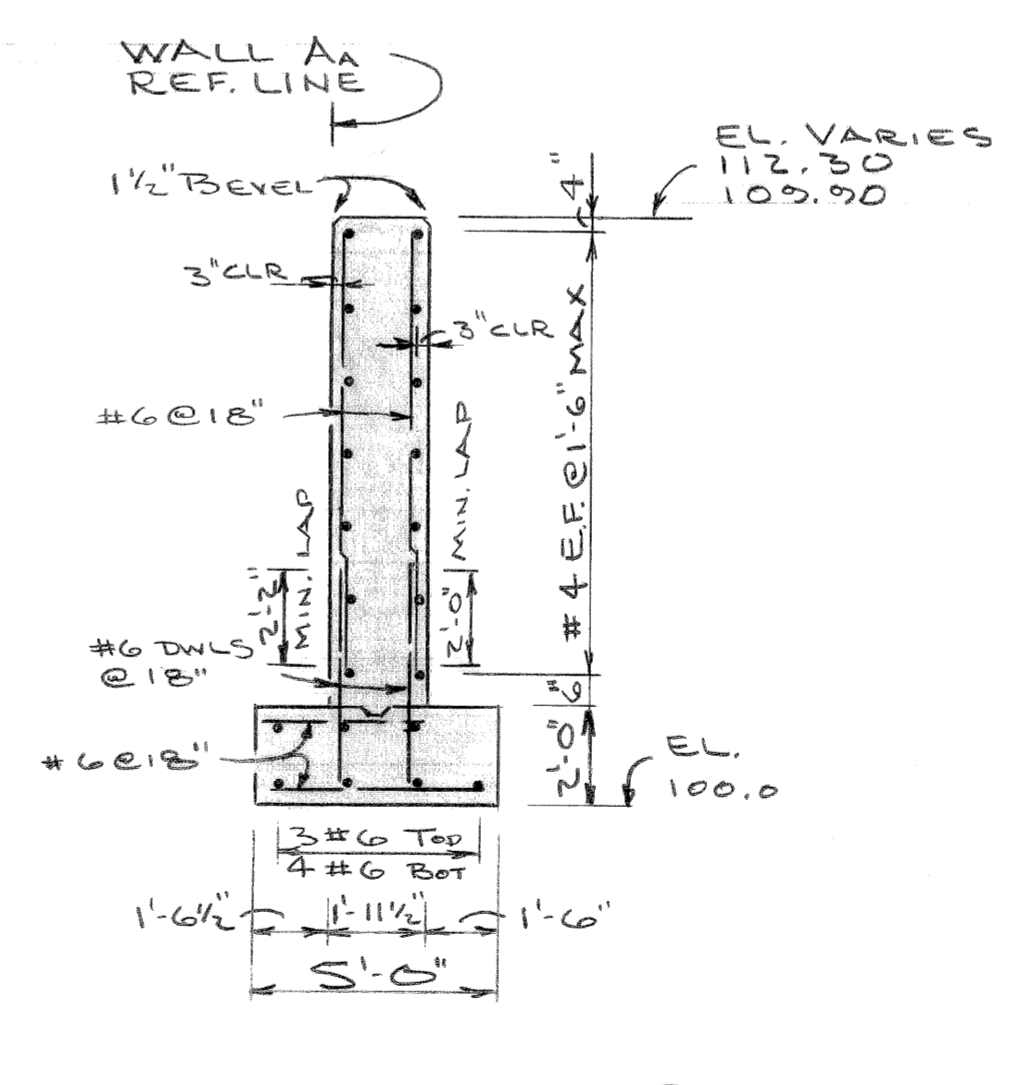


SECTION 6
SCALE: 1/4" = 1'-0"

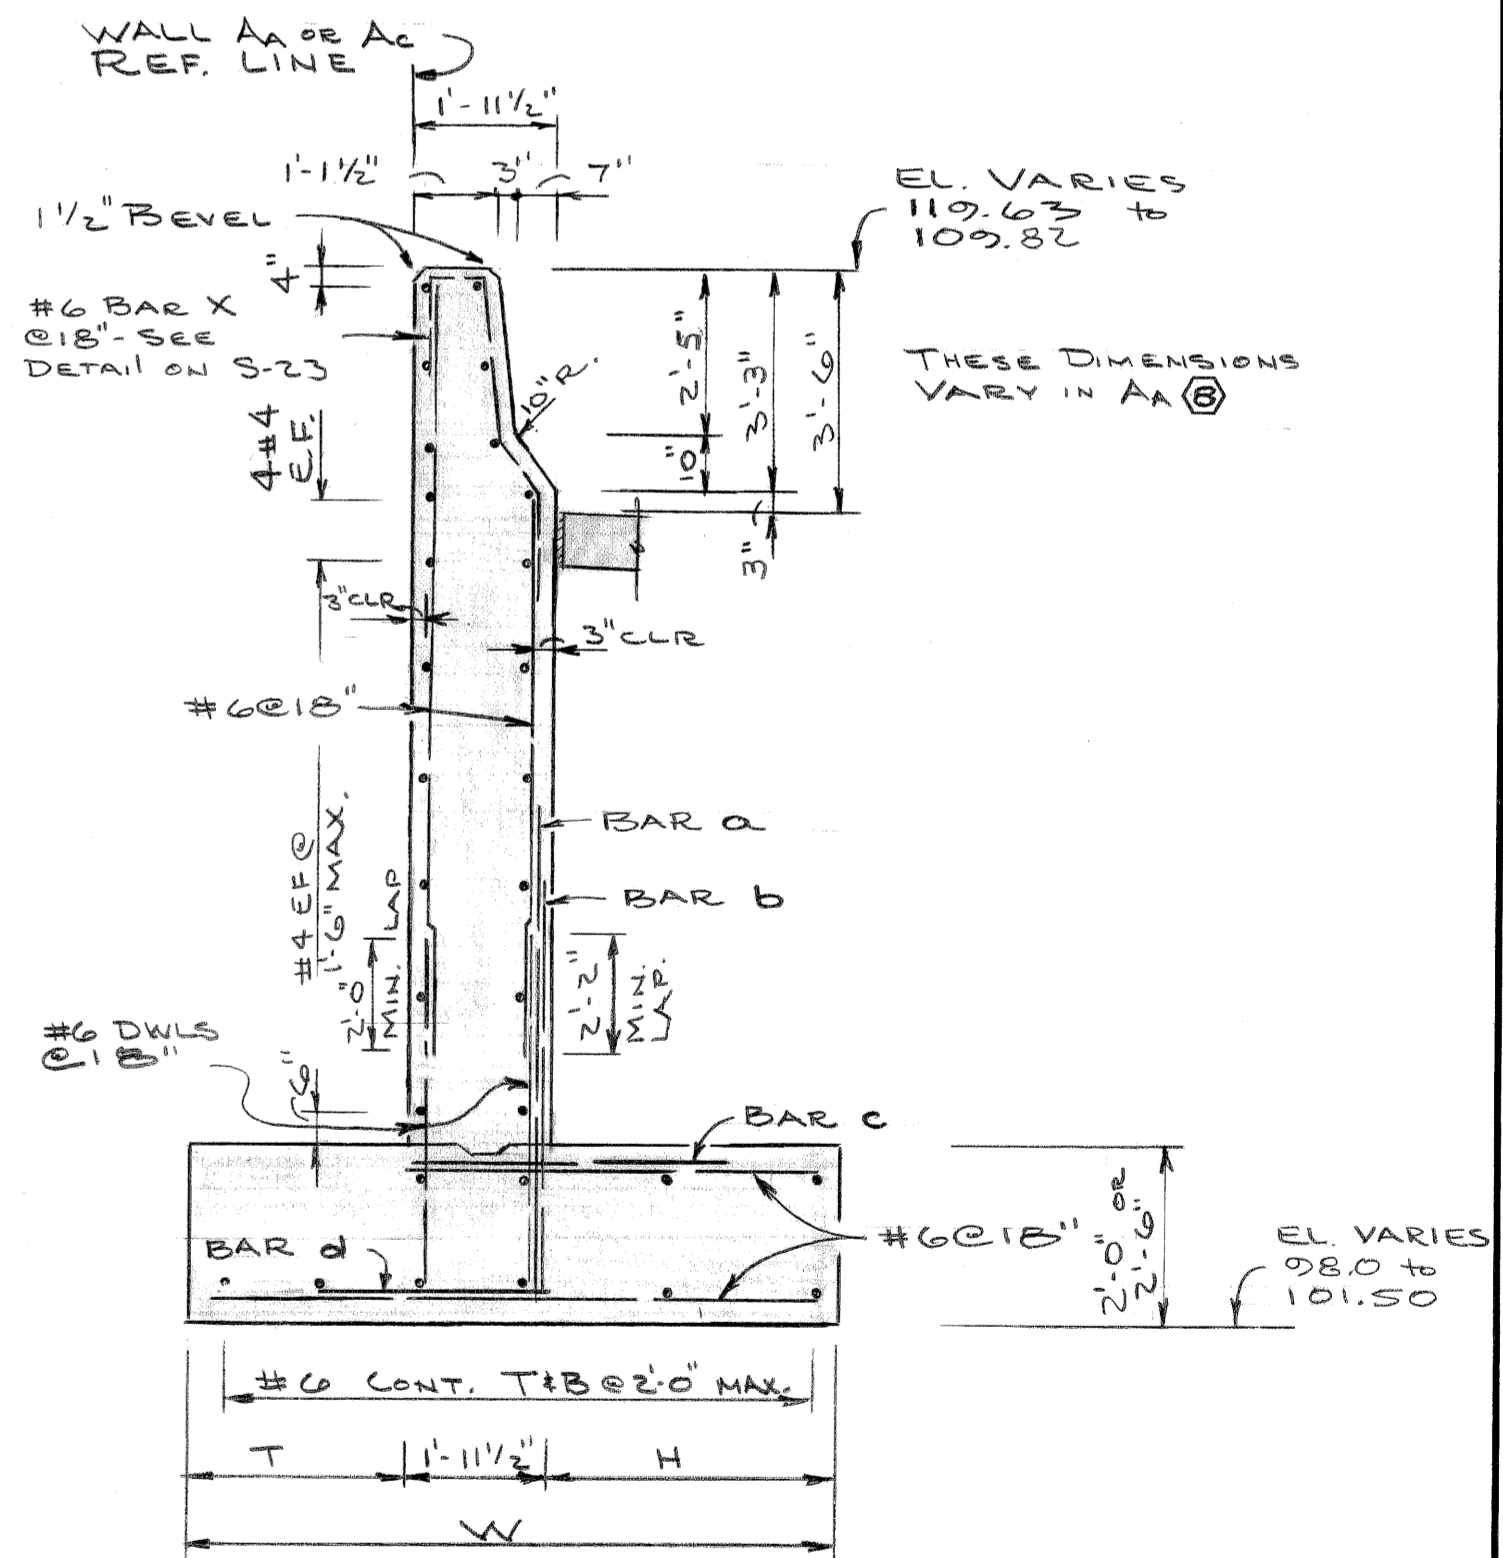


SECTION 7
SCALE: 3/8" = 1'-0"


REVISIONS LOCATED BY COORDINATES ON SHEET 1 2		REFERENCE DRAWINGS DESIGNED BY: <i>R. Kahan</i> DRAWN BY: <i>R. Kahan</i> TRACED BY: <i>-</i> CHECKED BY: <i>J. J. J.</i>	APPROVED: STRUCTURAL ENGINEER CITY OF DETROIT CITY ENGINEERING DIVISION - EPMD JOHN C. LODGE EXIT RAMP AND JEFFERSON AVE RECONSTRUCTION AT THE JOE LOUIS ARENA RAMP - WALL A A DETAILS	SHEET <u> </u> OF <u> </u> SHEETS CONTRACT NO. 16563A DRWG. NO. S-22 DATE AUG 1979
---	--	---	---	---

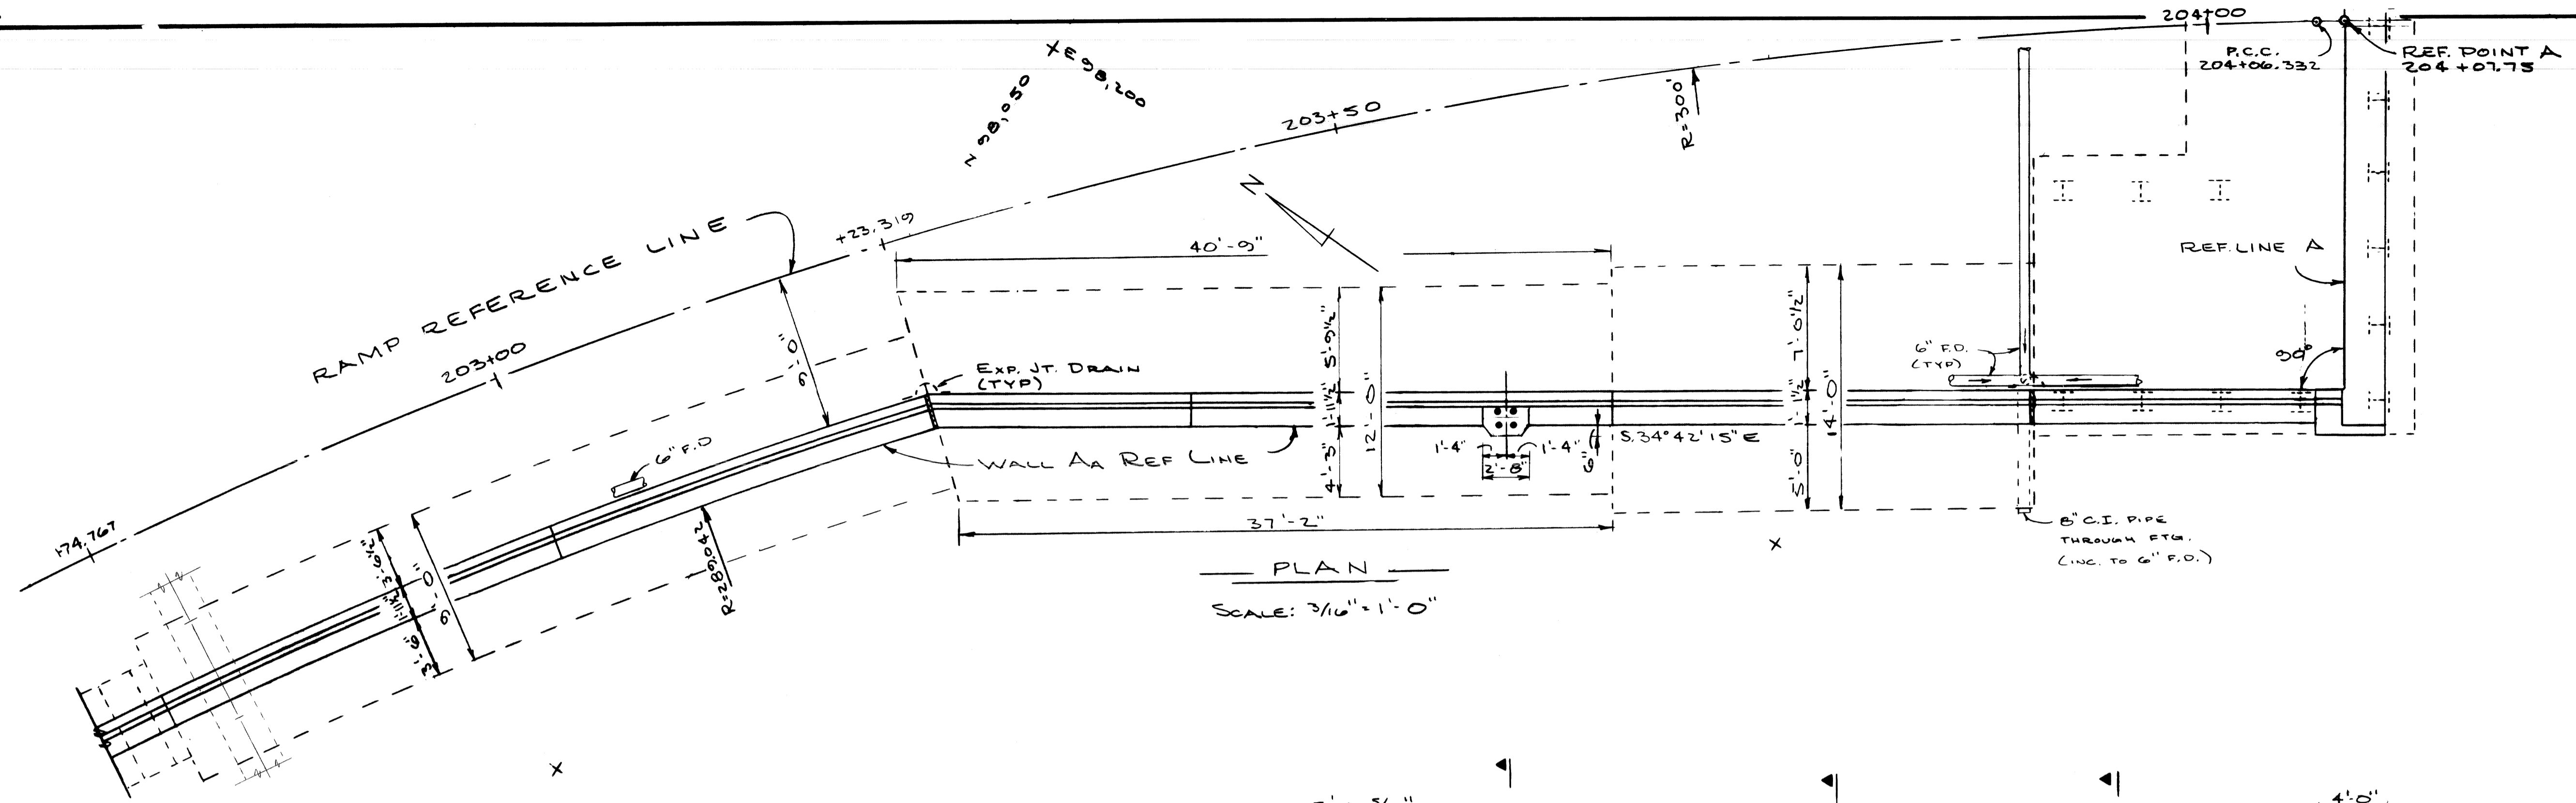


PLAN
SCALE: 3/16" = 1'-0"

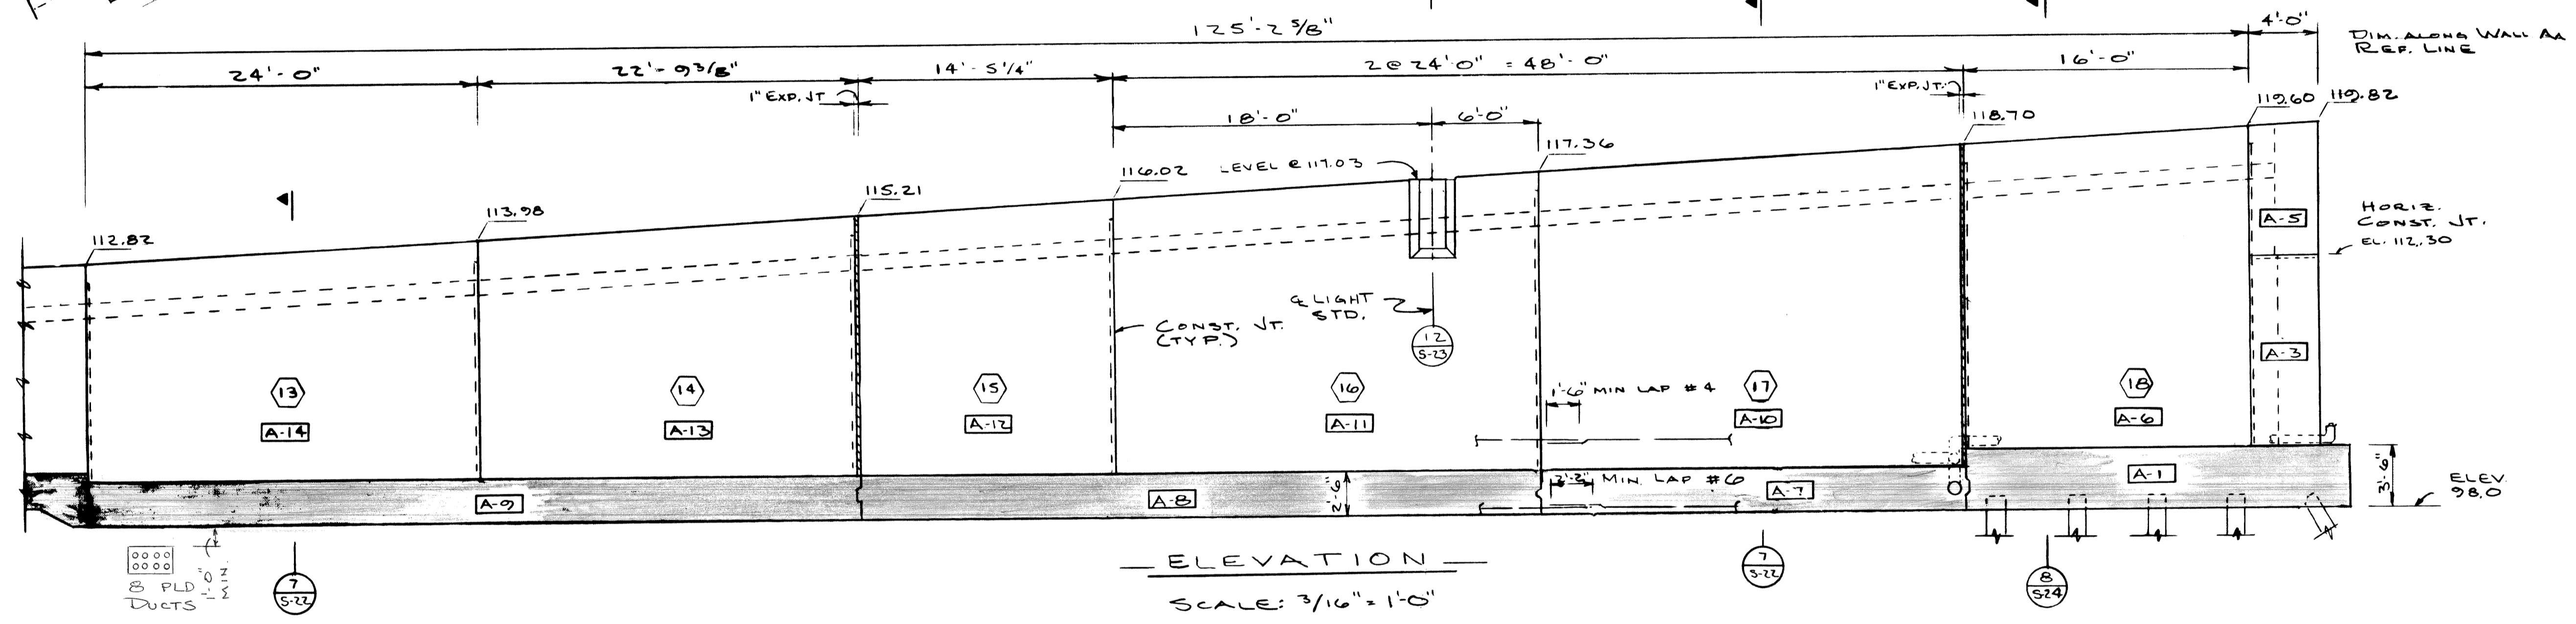


ELEVATION
SCALE: 3/16" = 1'-0"

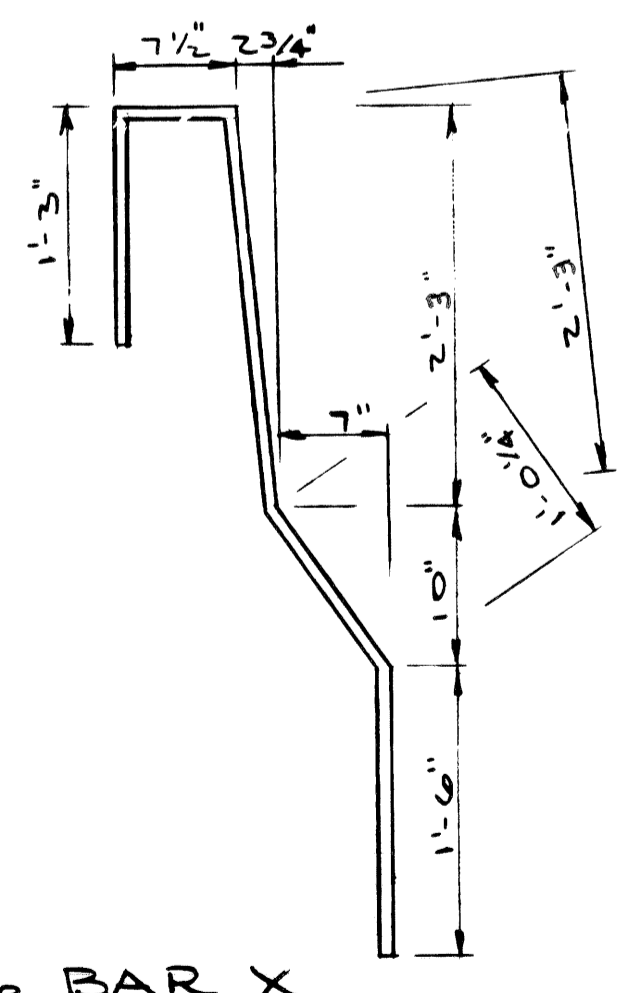


#6 BAR X
DETAIL

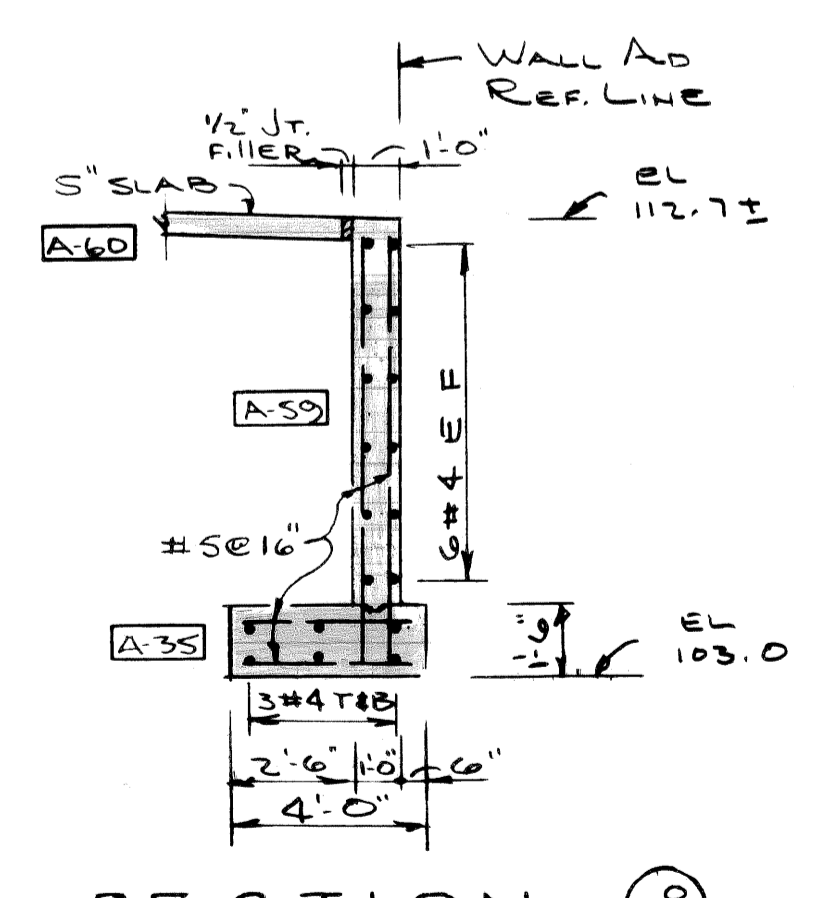


SECTION 10
SCALE: 1/4" = 1'-0"

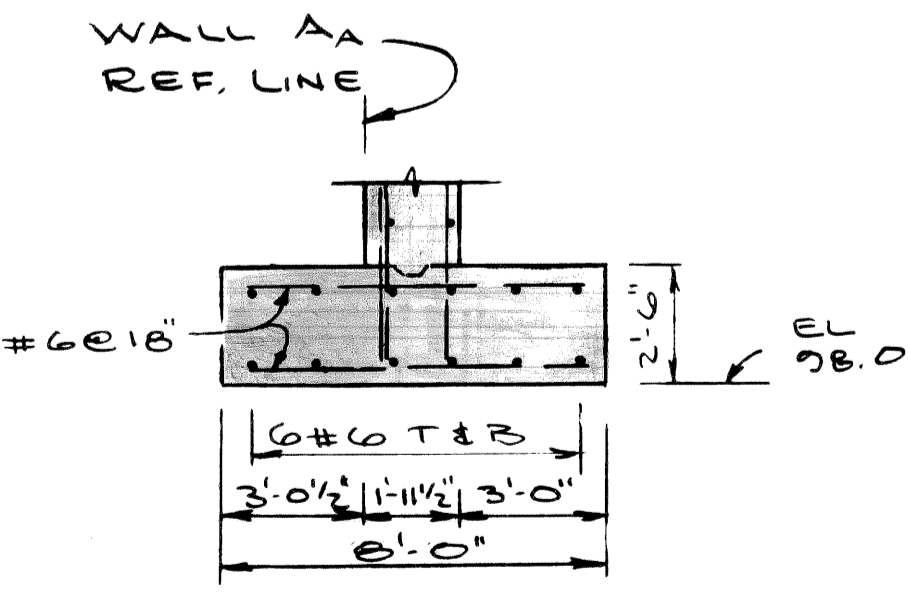

SECTION 11
SCALE: 1/4" = 1'-0"

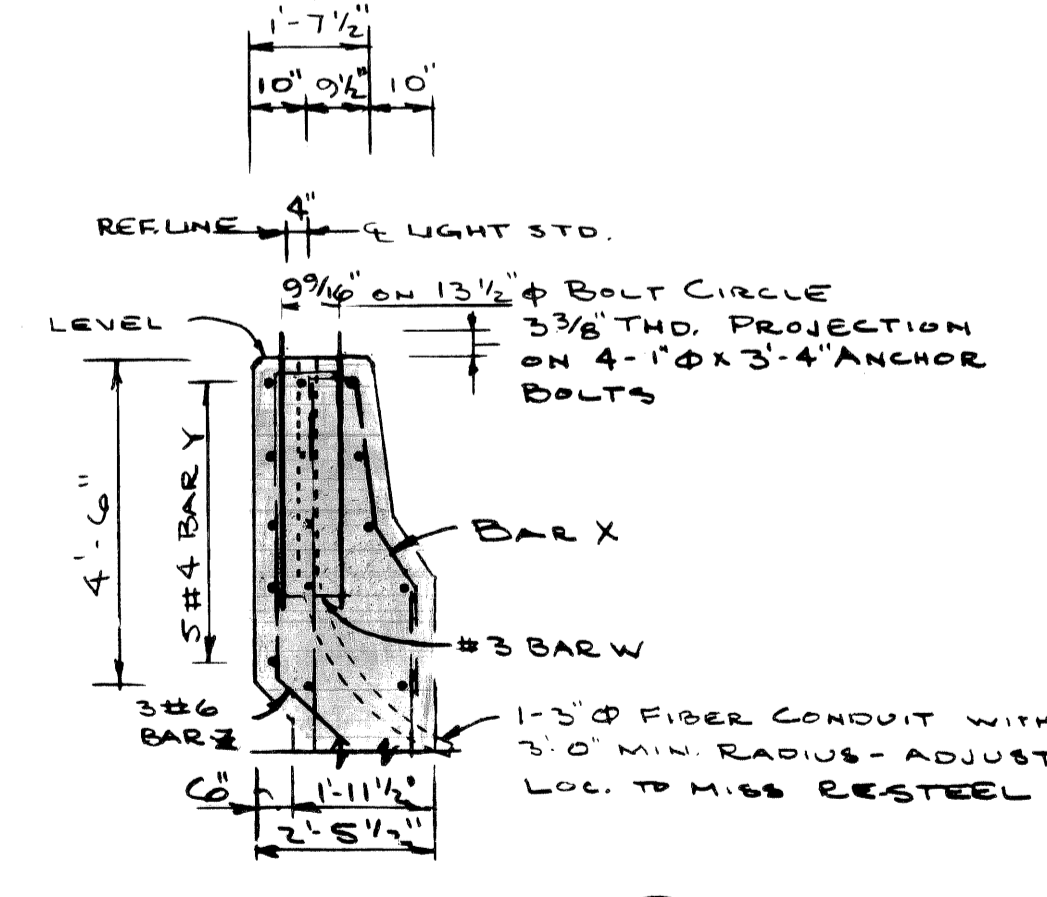





SECTION 12
SCALE: 3/8" = 1'-0"

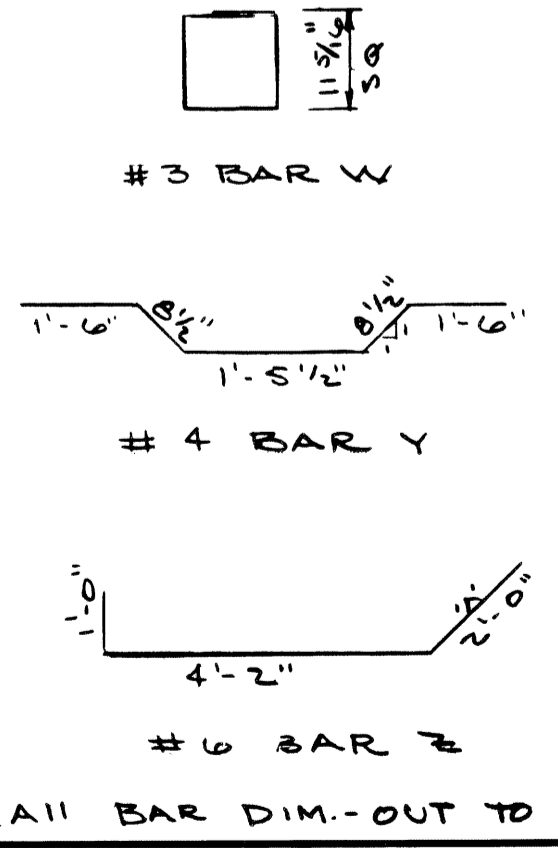

(ALL BAR DIM.-OUT TO OUT)

DESIGNED BY <i>R. Kahan</i> DRAWN BY <i>R. Kahan</i> TRACED BY CHECKED BY <i>J. M. Smith</i>		APPROVED: STRUCTURAL ENGINEER	CITY OF DETROIT CITY ENGINEERING DIVISION - EPMD	JOHN C LODGE EXIT RAMP AND JEFFERSON AVE. RECONSTRUCTION AT THE JOE LOUIS ARENA RAMP - WALL AA DETAILS	SHEET ___ OF ___ SHEETS CONTRACT NO. 16563A DRAWING NO. S-23 DATE AUG 1979
---	--	----------------------------------	---	---	---

REVISIONS LOCATED BY COORDINATES ON SHEET

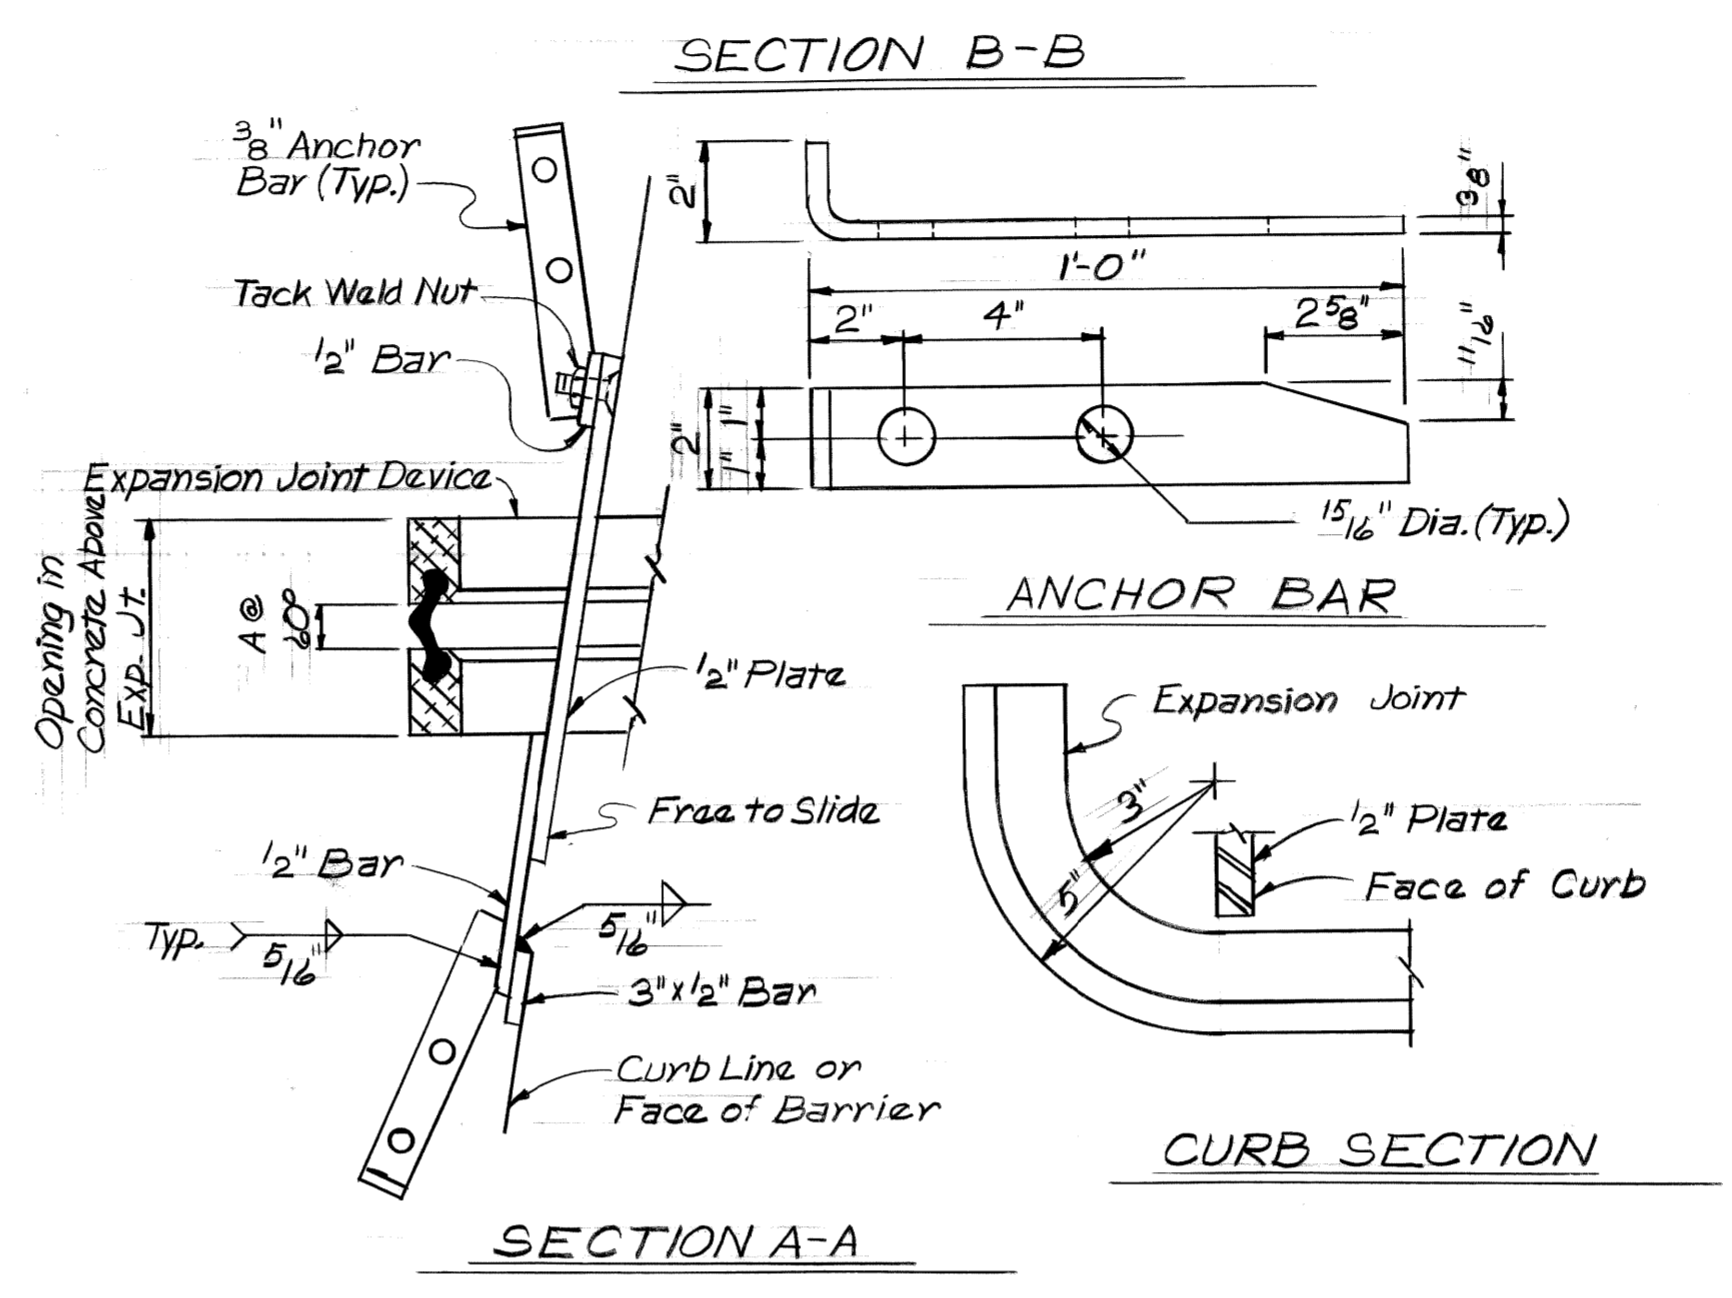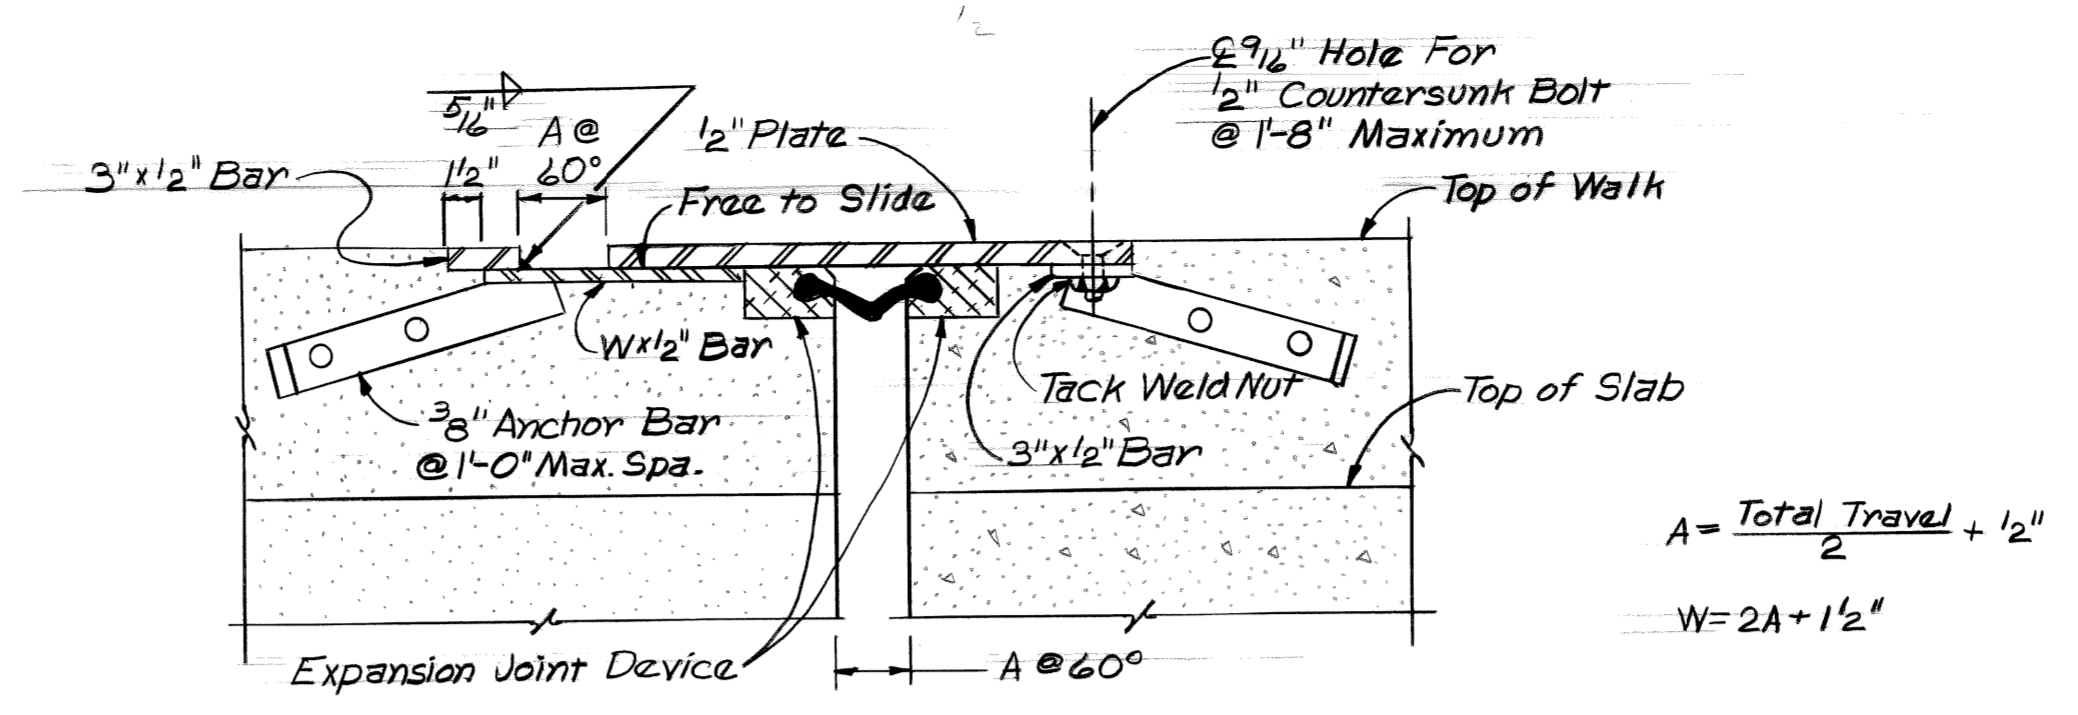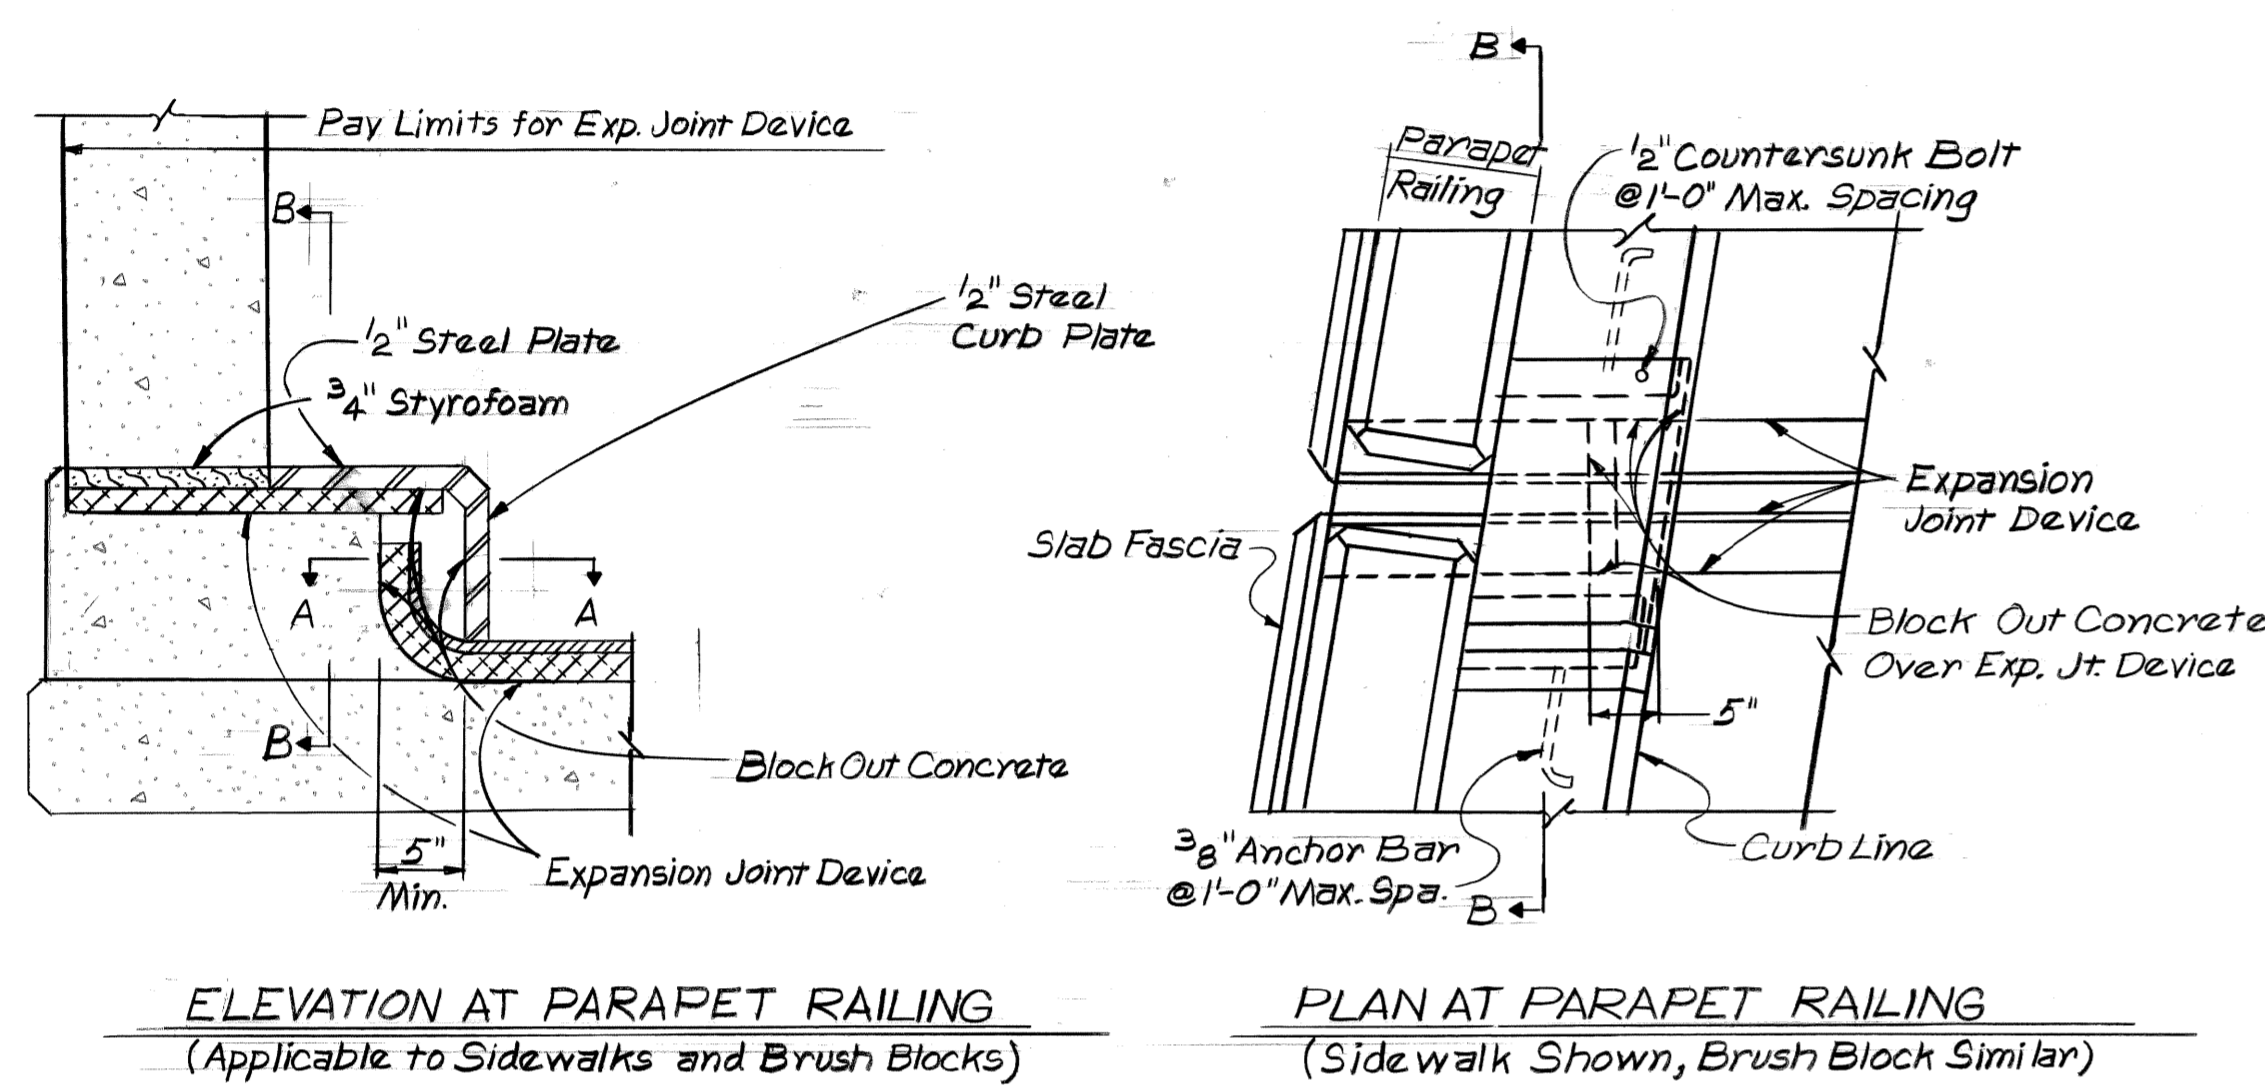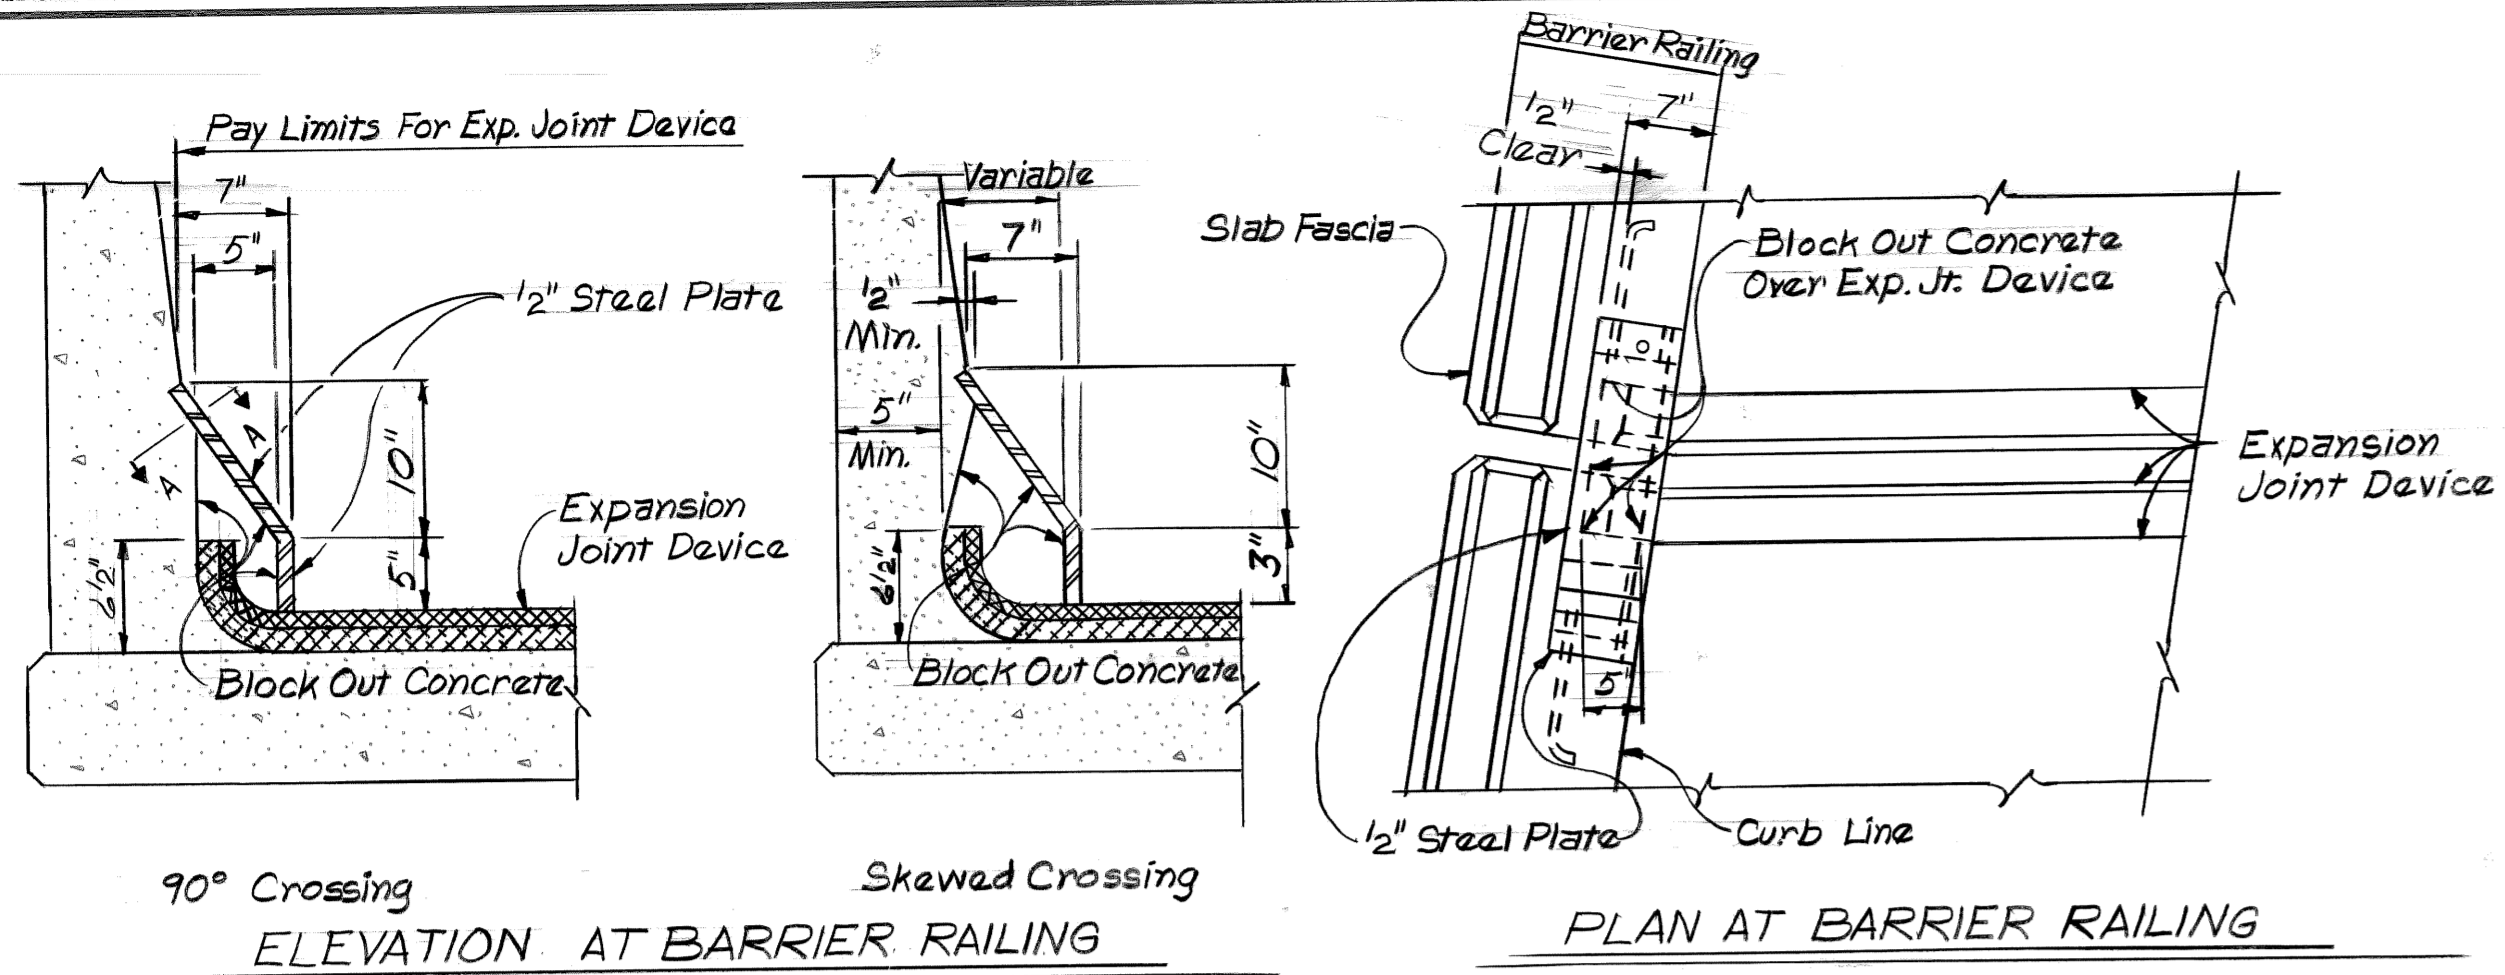

NOTES:

JOINT TYPES

THE EXPANSION JOINT DEVICE SHALL BE OF A TYPE THAT INCLUDES A CONTINUOUS NEOPRENE SEAL ACROSS THE DECK. UNLESS OTHERWISE NOTED ON THE PLANS, THE CONTRACTOR HAS THE OPTION OF USING ANY OF THE DEVICES LISTED BELOW:

DEVICE	MANUFACTURER
ACME STRIP SEAL	ACME HIGHWAY PRODUCTS
ALU - STRIP	WATSON BOWMAN, INC.
ONFLEX	STRUCTURAL ACCESSORIES, INC.
PRO - SPAN	FEL - PRO INC.
UNIDAM	ROYSTON LABORATORIES, INC.
WABO - MAURER STRIP SEAL	WATSON BOWMAN, INC.
FEL-SPAN C.S.	FEL-PRO INC.

SEE SHOP DRAWINGS

THE MODEL OF THE JOINT TYPE SELECTED SHALL BE SUITABLE TO ACCOMMODATE THE TOTAL MOVEMENT NOTED ON THE PLANS. COMPLETE WORKING DRAWINGS OF ALL DETAILS OF FABRICATION OF THE EXPANSION JOINT DEVICE SHALL BE SUBMITTED FOR REVIEW IN ACCORDANCE WITH STANDARD SPECIFICATION 1.05.02.

FABRICATION AND INSTALLATION

THE EXPANSION JOINT SHALL BE BENT IN THE SHOP TO CONFORM TO THE CONTOUR OF THE ROADWAY SLAB. IT SHALL BE INSTALLED IN ACCORDANCE WITH MANUFACTURER'S RECOMMENDATIONS SUBJECT TO NOTES HEREIN AND THE APPROVAL OF THE ENGINEER.

WHERE THE DEVICE IS TO BE INSTALLED ON CAST CONCRETE, THE SURFACE LAITANCE SHALL BE REMOVED BY SANDBLASTING AND ANY VOIDS FILLED WITH EPOXY MORTAR PRIOR TO BEDDING. WHERE THE SEALING GLAND IS LOCKED INTO A METAL EXTRUSION, A LUBRICANT-ADHESIVE CONFORMING TO STANDARD SPECIFICATION 8.16.04 - D-2 SHALL BE REQUIRED BETWEEN THE SEAL AND METAL EXTRUSION.

A SEALANT SHALL BE USED BETWEEN THE SEAT AND THE ANCHORED PORTION OF THE SEALING GLAND, AND ALSO BETWEEN THE SEAT AND HOLD DOWN DEVICE. THE SEALANT SHALL CONFORM TO FEDERAL SPECIFICATION MMHG-650B GRADE B. TT-S-00230C TYPE 11, OR SHALL BE AN APPROVED EQUAL.

THE VOID FORMED BETWEEN THE VERTICAL EDGE OF THE HOLD DOWN DEVICE AND THE BLOCK OUT SHALL BE FILLED WITH A SEALANT IF LESS THAN 1/2 INCH IN WIDTH OR WITH AN EPOXY MORTAR IF GREATER THAN 1/2 INCH. THE SEALANT SHALL CONFORM TO FEDERAL SPECIFICATION TT-S-00230C TYPE 11 OR SHALL BE AN APPROVED FLEXIBLE EPOXY.

ALL BOLT CAVITIES IN THE HOLD DOWN DEVICES SHALL BE FILLED WITH AN EPOXY MORTAR IF THE CAVITIES ARE CONTINUOUS OR WITH AN APPROVED FLEXIBLE EPOXY IF THEY ARE NOT CONTINUOUS.

THE AREA OF THE HOLD DOWN DEVICE AND SEALING GLAND WHICH WILL BE IN CONTACT WITH A SEALANT SHALL BE CLEANED WITH TOLUENE OR OTHER APPROVED SOLVENT.

ALL SURFACES IN CONTACT WITH THE EPOXY MORTAR SHALL BE LIGHTLY SANDBLASTED AND PRIMED WITH THE BINDER PRIOR TO PLACING THE MORTAR.

THE EPOXY MORTAR SHALL CONFORM TO STANDARD SPECIFICATION 4.50.20. THE PRO-SPAN DEVICE MUST INCORPORATE A CAST-IN-PLACE METAL SEAT.

DETAILS AT CURBS OR BARRIERS

THE DETAILS ON THIS SHEET SHOW AN APPROVED MEANS OF TERMINATING THE EXPANSION JOINT DEVICE AT CURBS OR BARRIERS. VARIATIONS OR ALTERNATIVE SCHEMES WILL BE CONSIDERED AND MAY BE USED IF APPROVED BY THE ENGINEER.

MATERIALS


THE COST OF ALL MATERIALS AND LABOR REQUIRED FOR PROPER INSTALLATION OF THE EXPANSION JOINT AND THE TERMINAL ASSEMBLIES AT THE CURBS, SIDEWALKS, OR BARRIERS IS INCLUDED IN THE PAYMENT FOR THE EXPANSION JOINT DEVICE.

MISCELLANEOUS	QUANTITY	
Item	Unit	Amount
Expansion Joint Device 2" Min. Travel	Lineal Feet	71
Expansion Joint Device 3" Min. Travel	Lineal Feet	191

DATE: August, 1979

DSGN BY:	
DR'N BY:	
CK'D BY:	
APP'D BY:	


CITY OF DETROIT, MICHIGAN

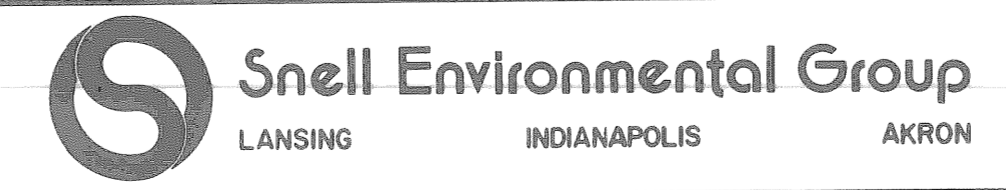

JOHN C. LODGE EXIT RAMP AND JEFFERSON AVENUE-RECONSTRUCTION AT THE JOE LOUIS ARENA.

EXPANSION JOINT DETAIL
FEL-PRO TYPE

SCALE: NONE
DRN. NO: S63

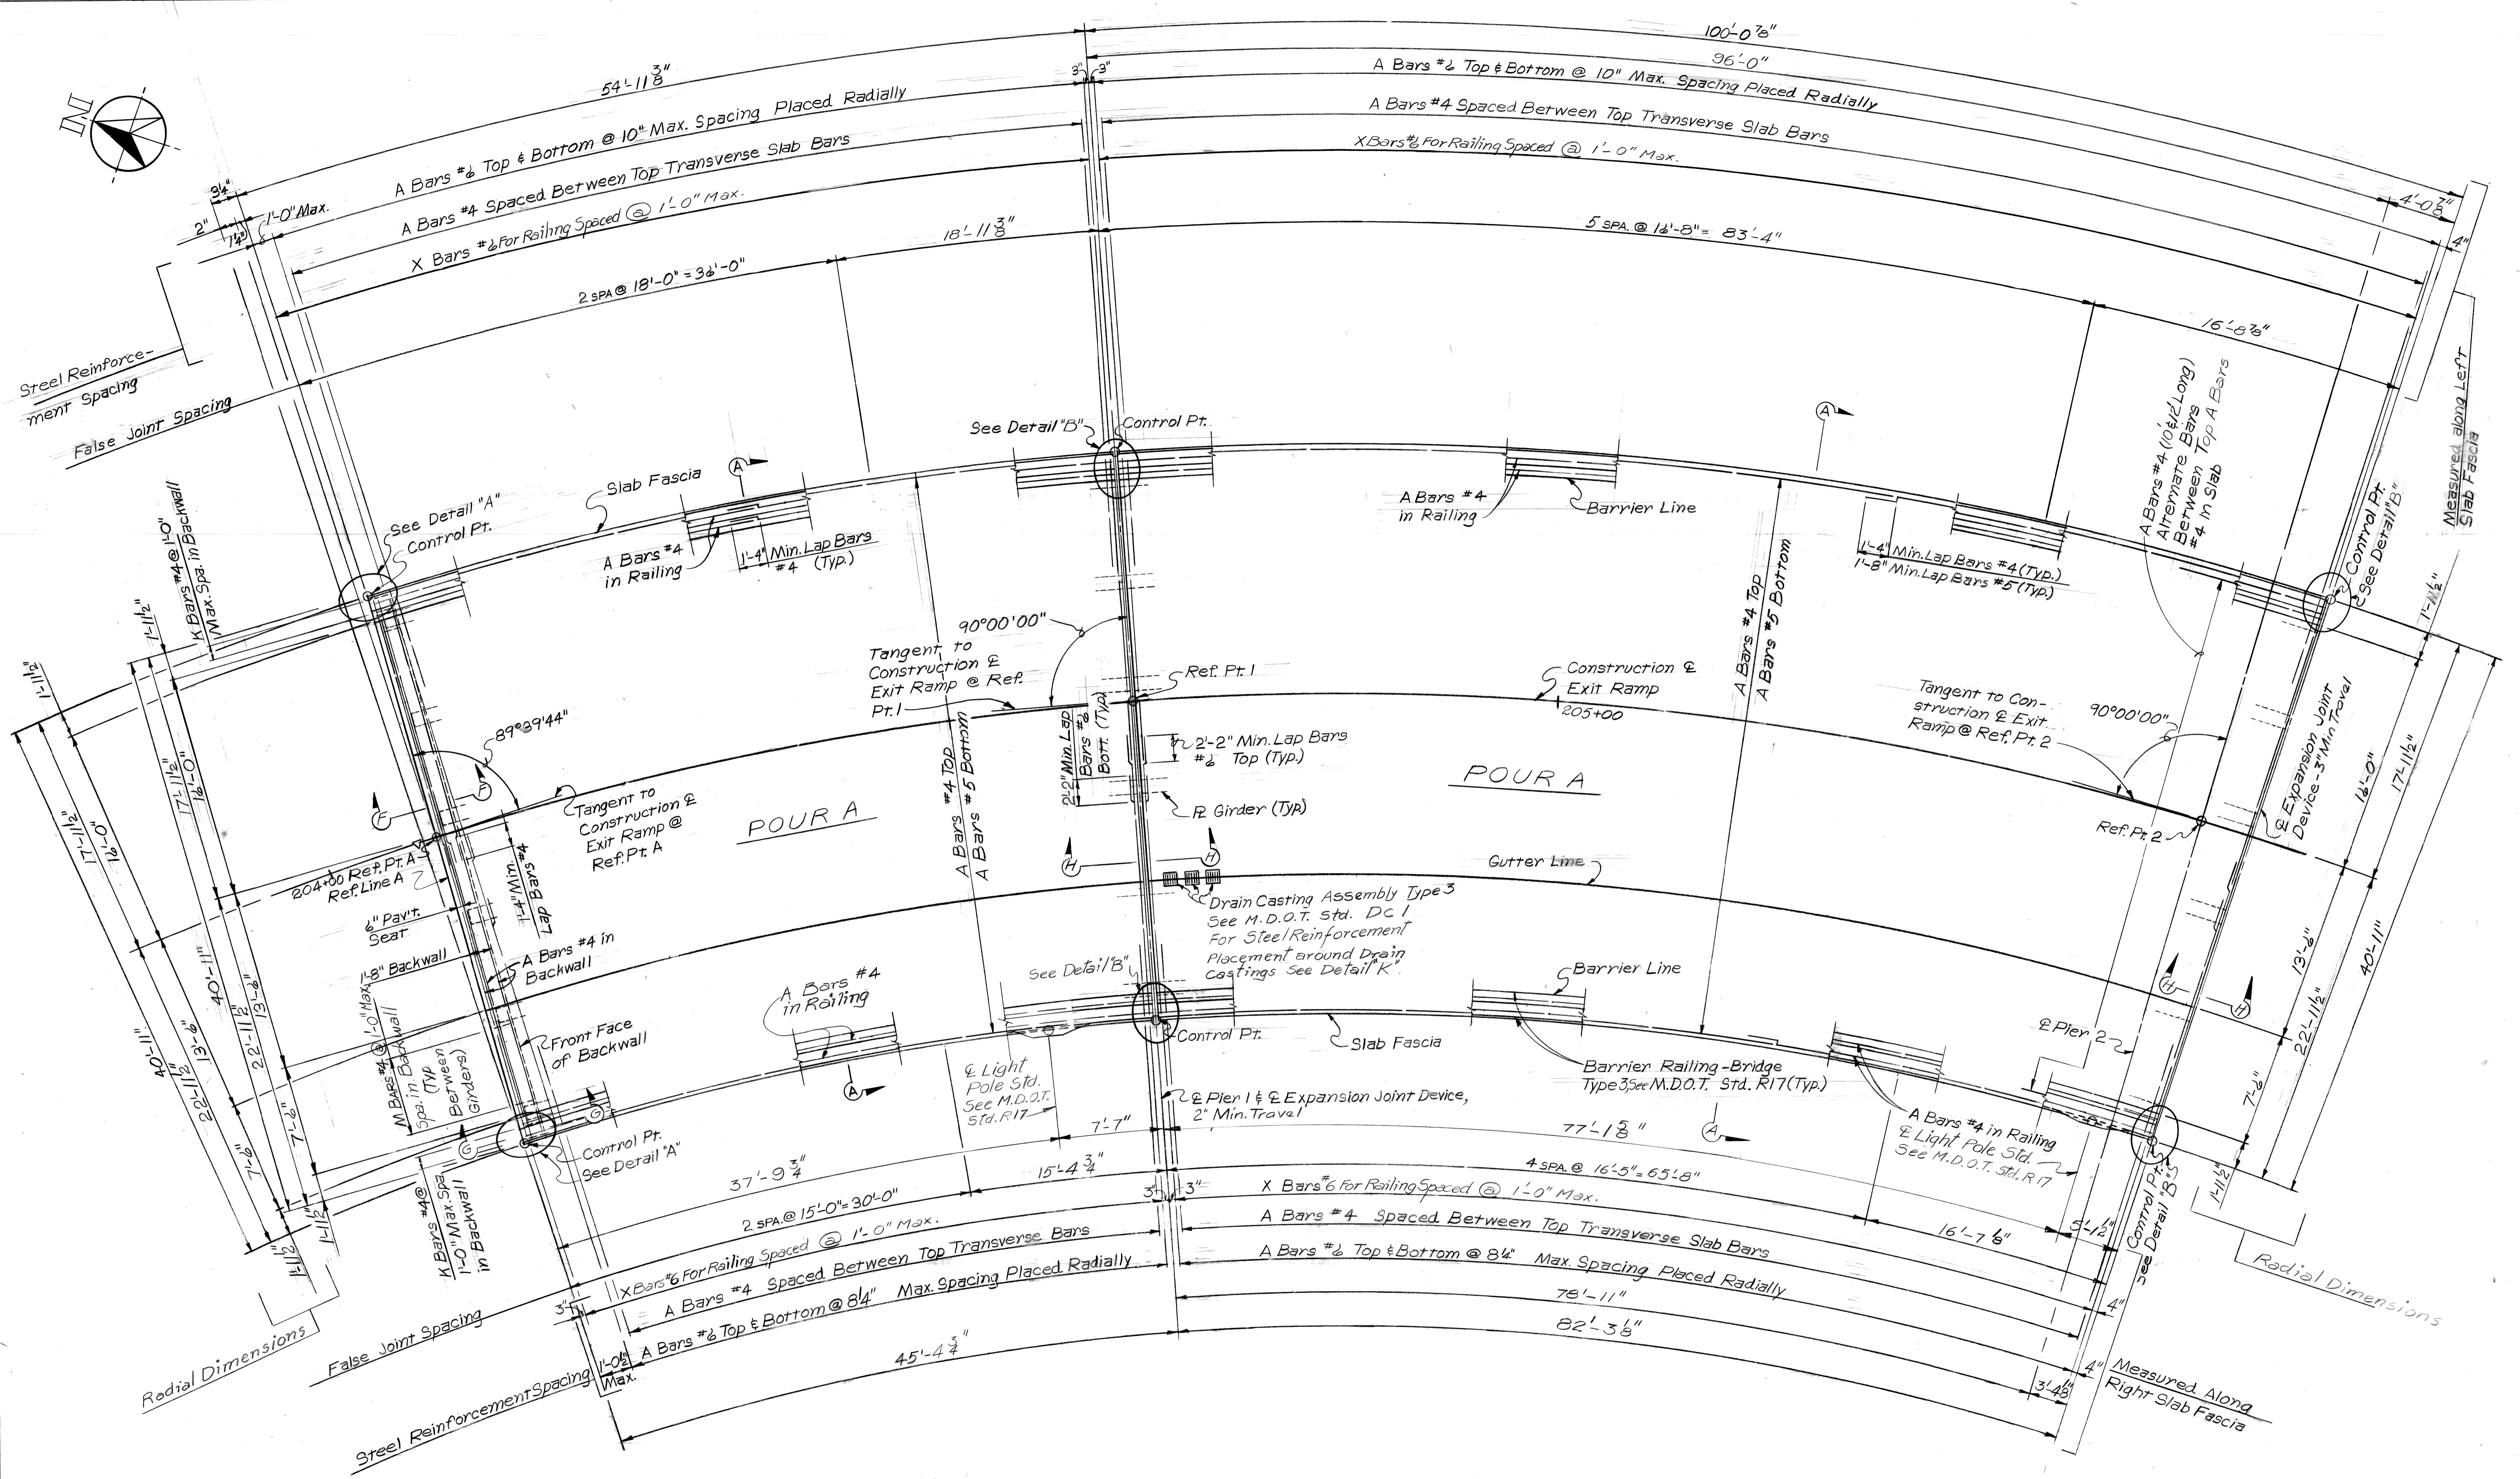

PLAN OF SLAB

Work This Sheet With Sheets # 565 thru 582

DATE: August, 1979

DSGN BY: SJRRGW	REVISIONS:
DRN BY: DE	
CK'D BY: SJR, RGW	
APP'D BY:	

CITY OF DETROIT, MICHIGAN





JOHN C. LODGE EXIT RAMP AND JEFFERSON AVENUE RECONSTRUCTION AT THE JOE LOUIS ARENA.

SUPERSTRUCTURE DETAILS
PLAN OF SLAB - SPANS 1 AND 2

SCALE: NONE

DRN. NO: S64

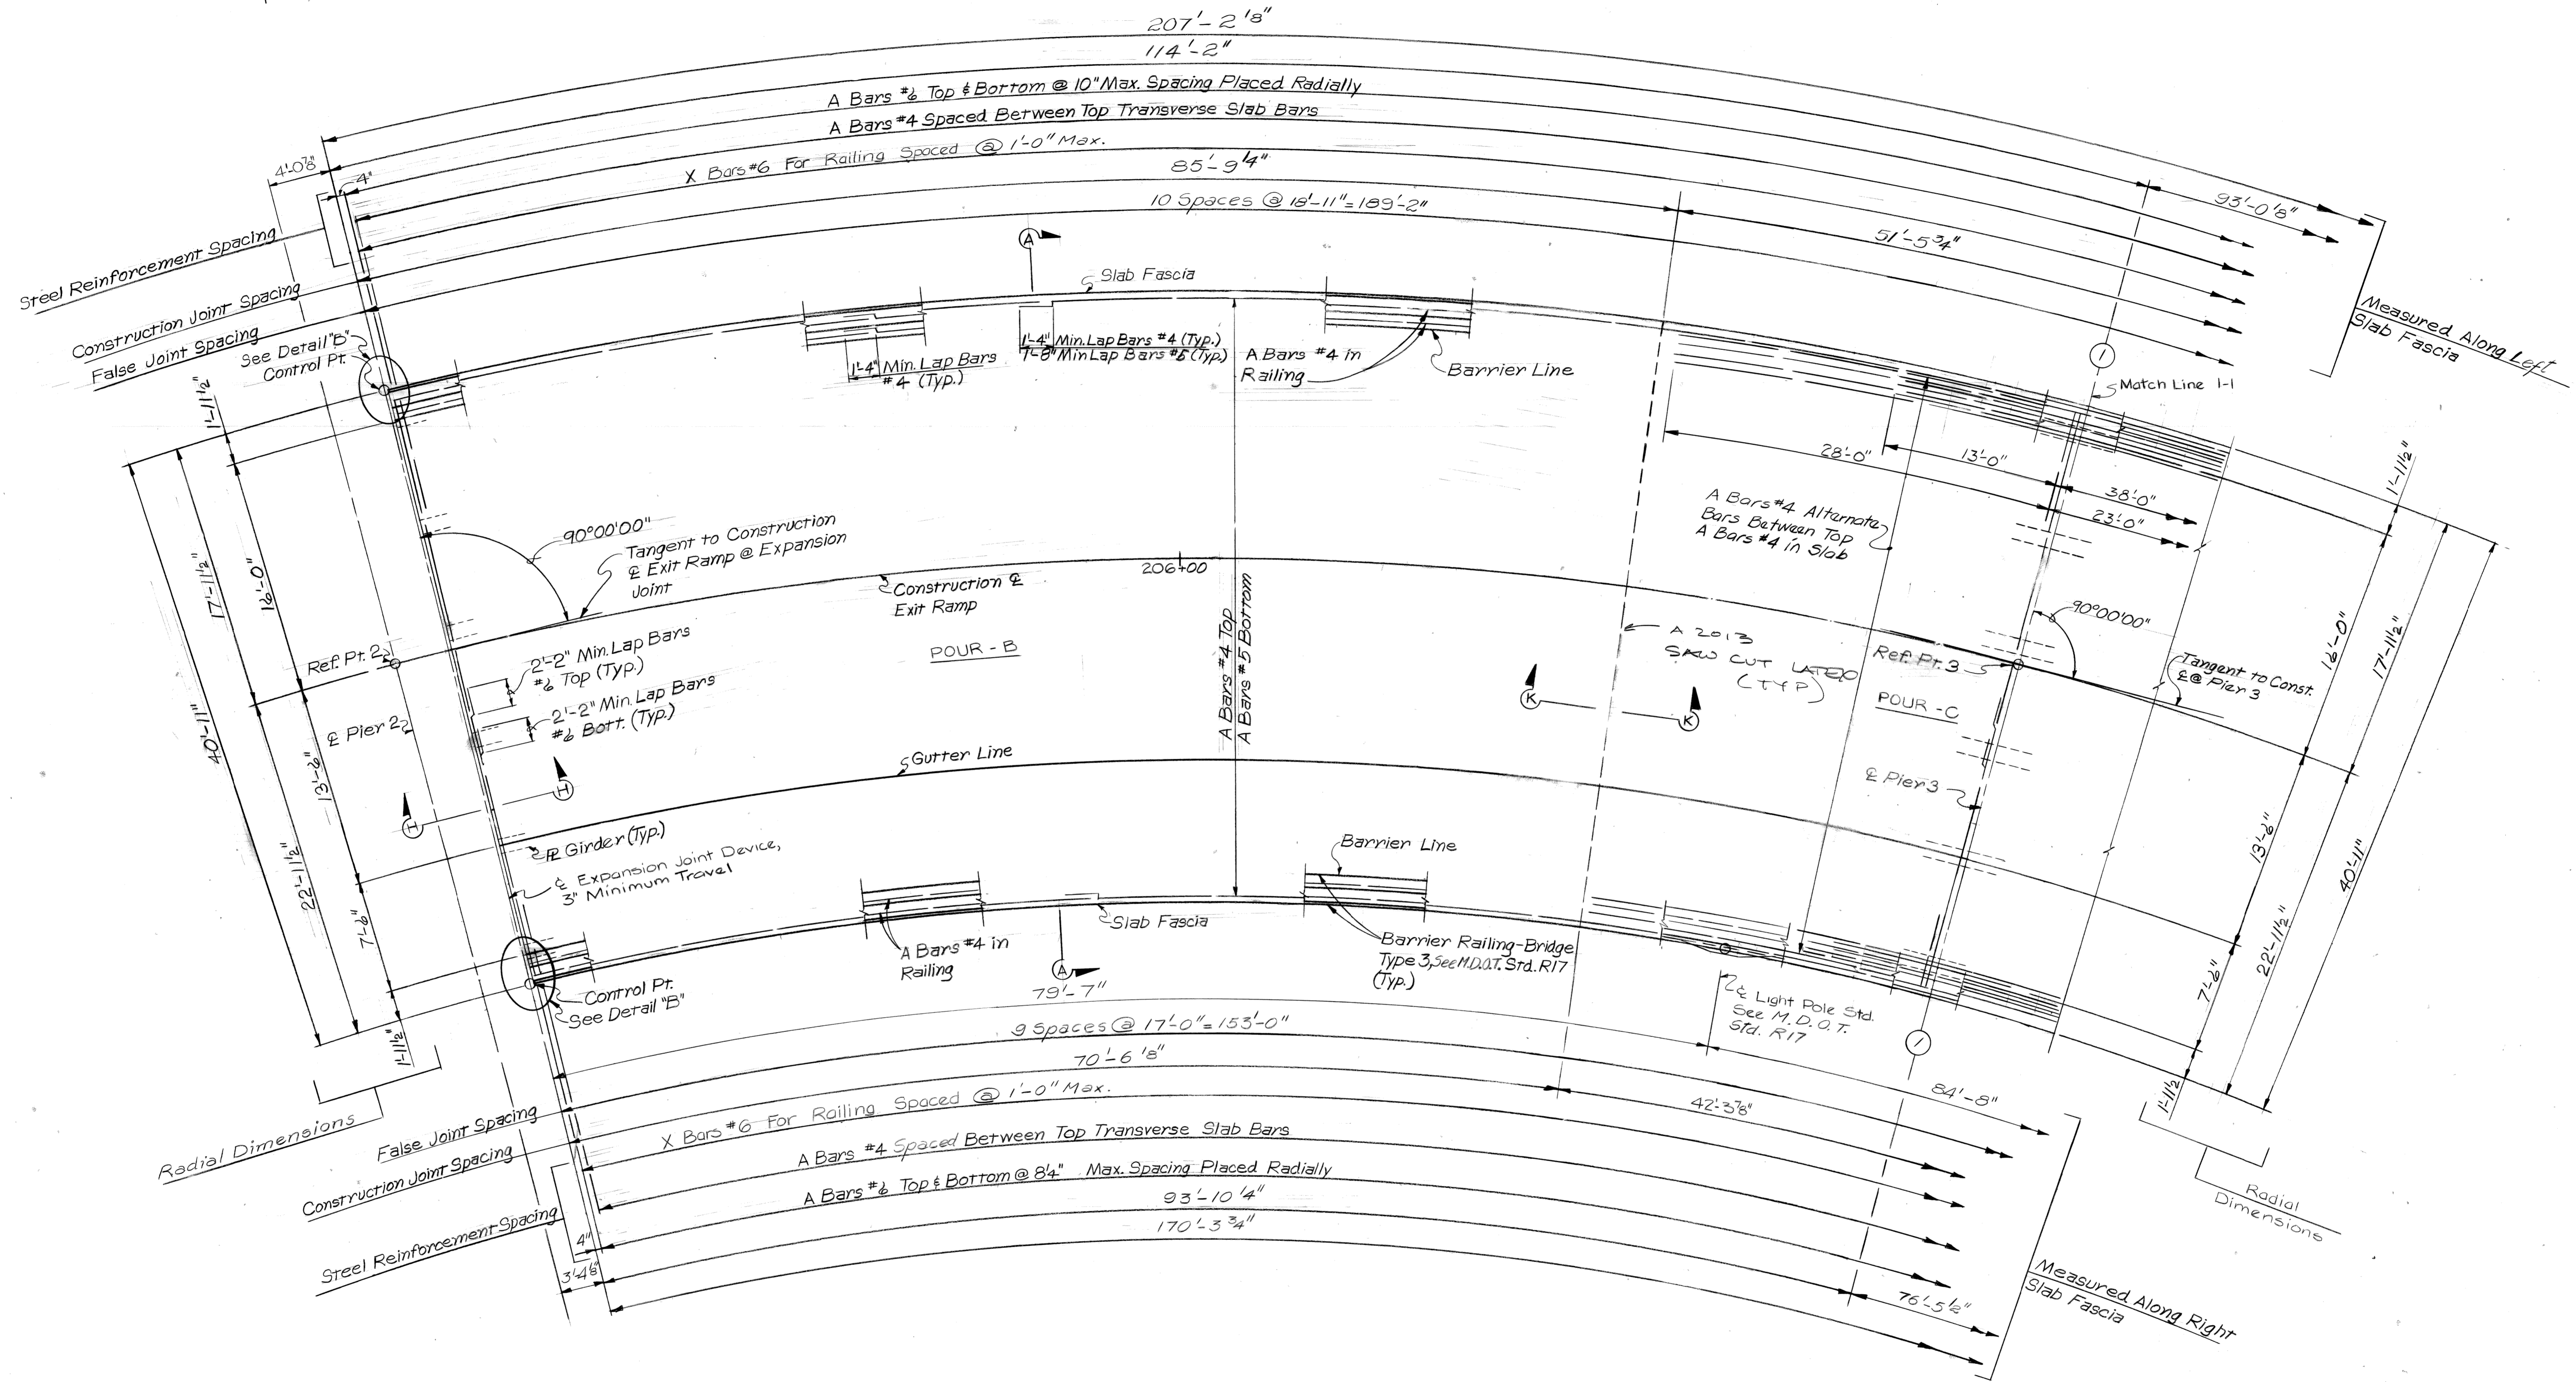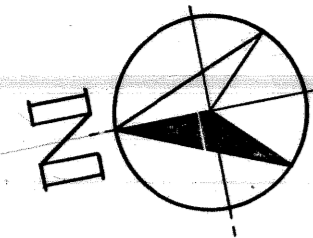

SPAN 3
PLAN OF SLAB

Work This Sheet With Sheets# S64 & S66 thro S82

DATE: August, 1979

DSGN BY: SJPRGW	REVISIONS
DRN BY: DE	
CK'D BY: SJP, RGW	
APP'D BY:	

CITY OF DETROIT, MICHIGAN





JOHN C. LODGE EXIT RAMP AND JEFFERSON AVENUE RECONSTRUCTION AT THE JOE LOUIS ARENA.

SUPERSTRUCTURE DETAILS
PLAN OF SLAB - SPAN 3

SCALE: NONE

DRN. NO: S65

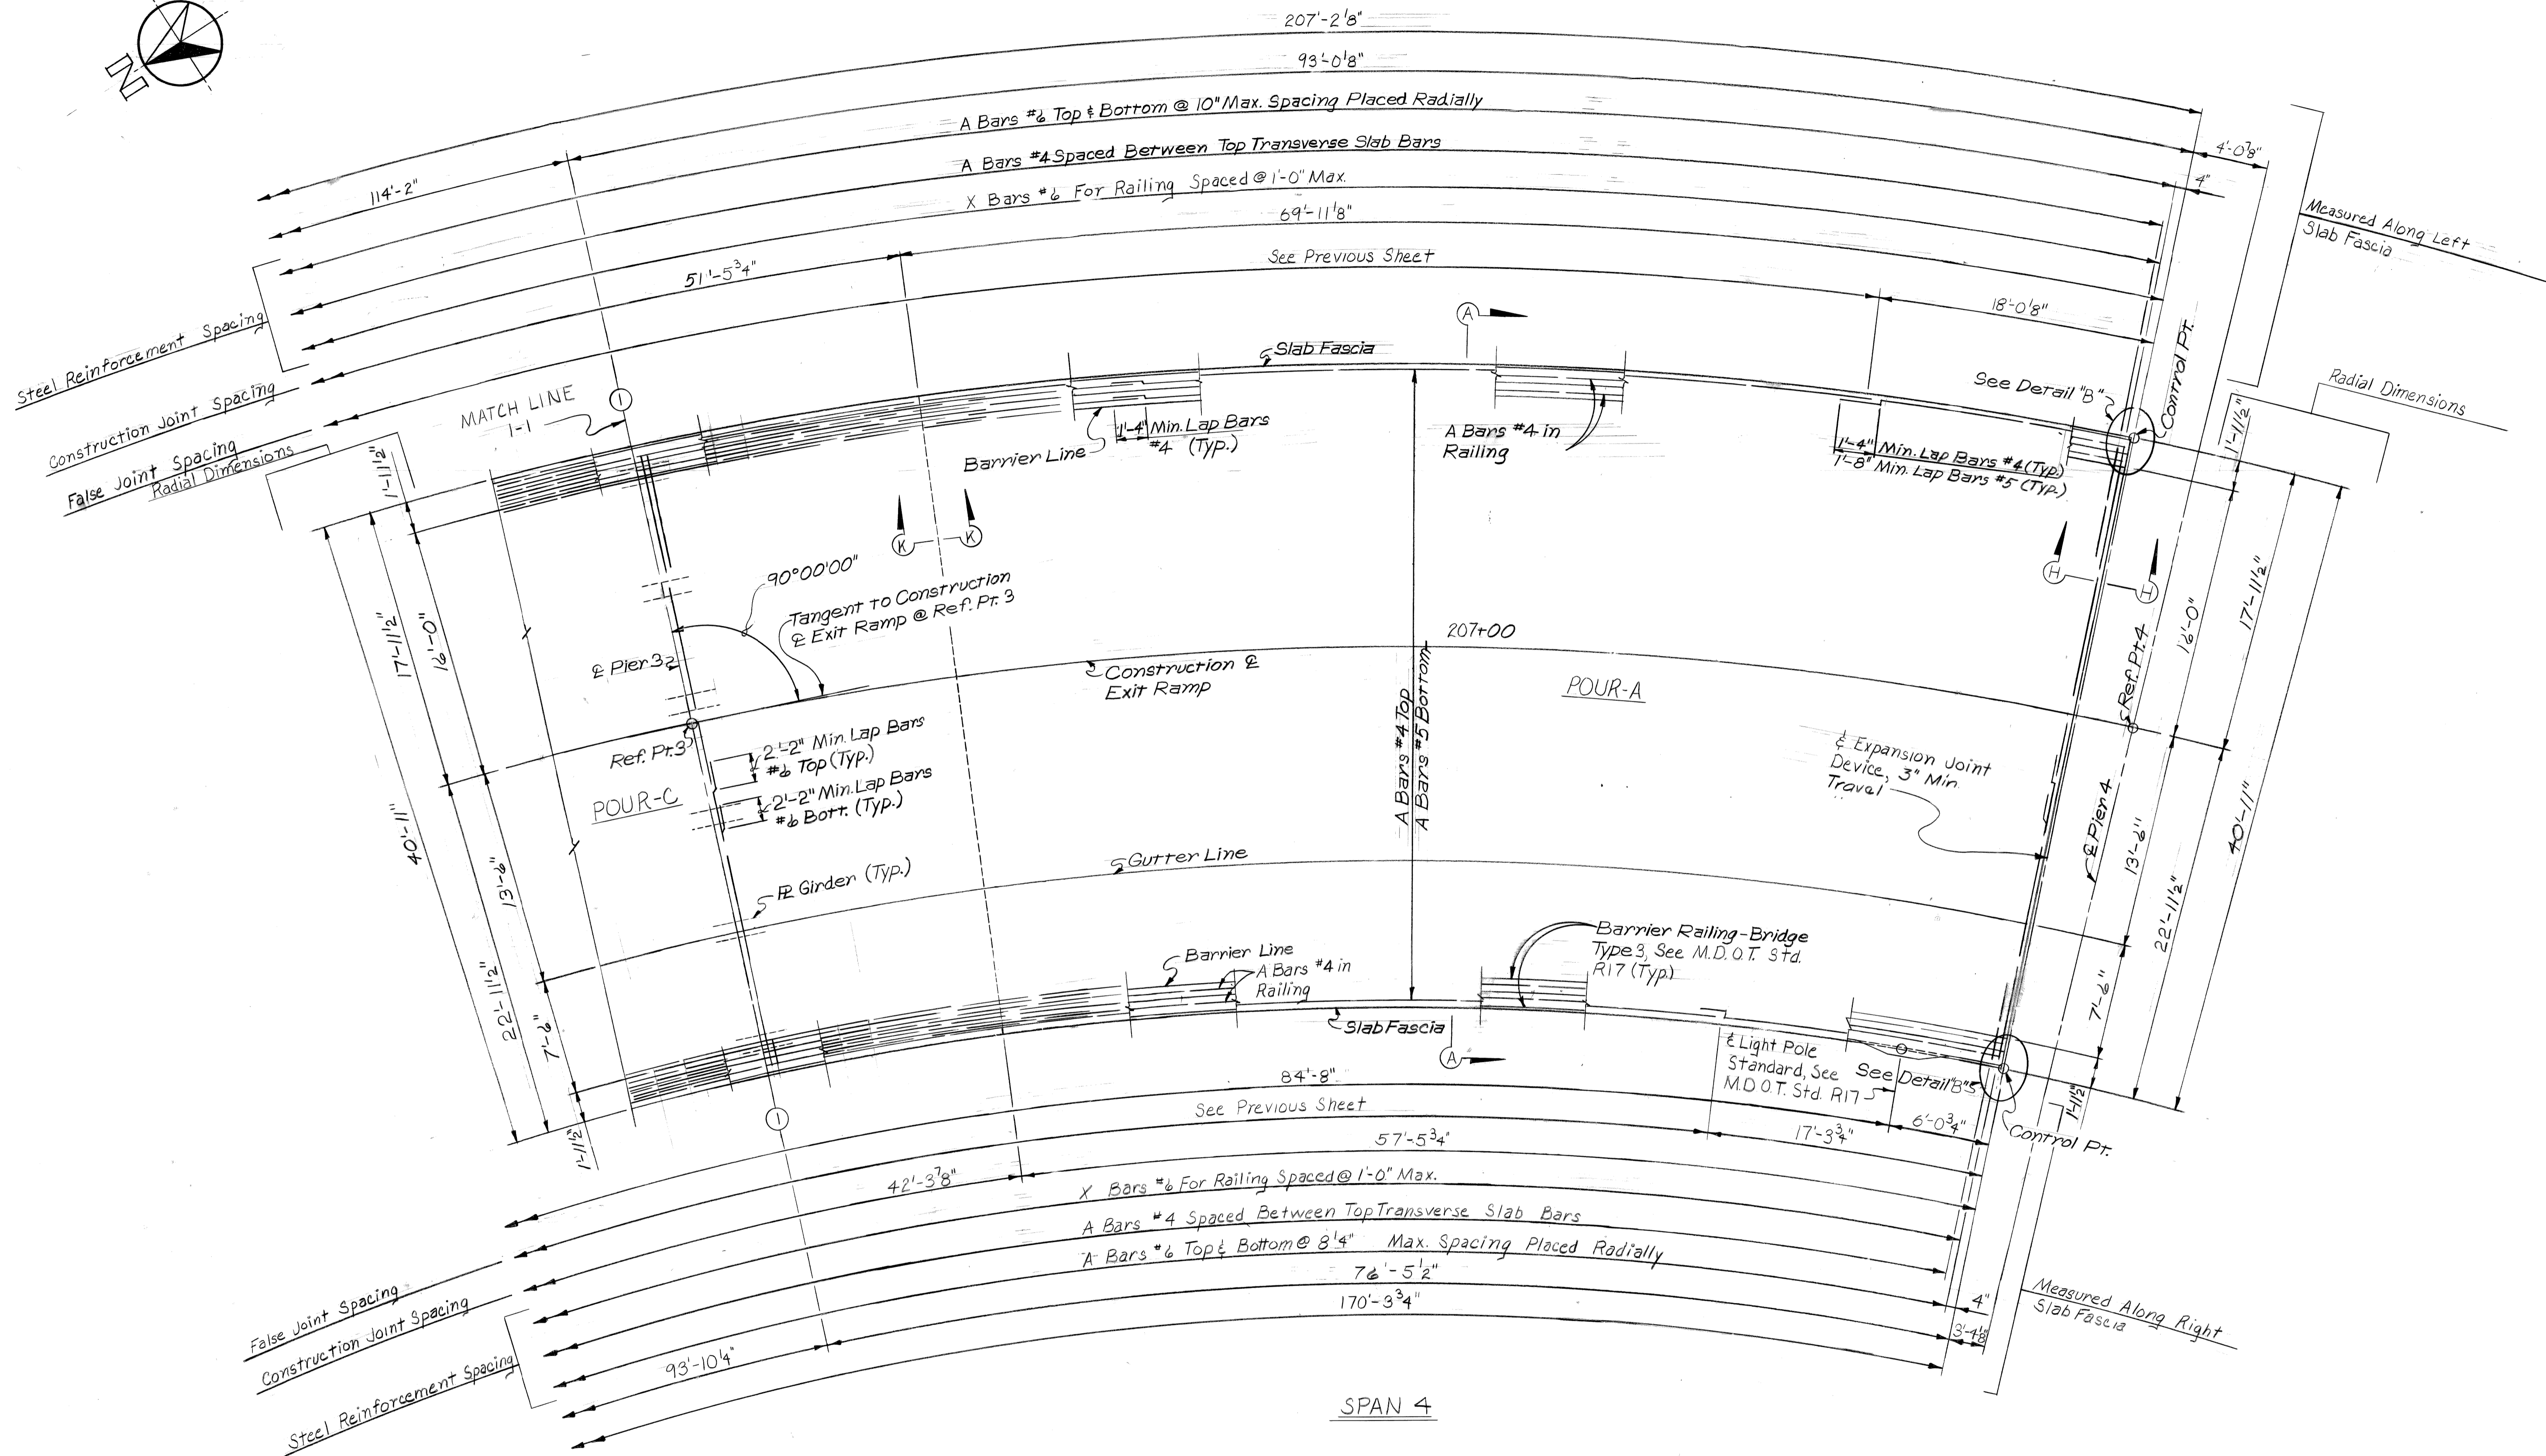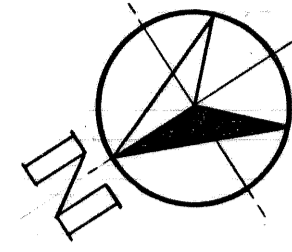

PLAN OF SLAB

Work This Sheet With Sheets # S64, S65 & S67 thru S82

DATE: August, 1979

DSGN BY:	SJRRGW	REVISIONS	
DRN BY:	DE		
CHK'D BY:	SJP, RGW		
APP'D BY:			

CITY OF DETROIT, MICHIGAN





JOHN C. LODGE EXIT RAMP AND JEFFERSON AVENUE
RECONSTRUCTION AT THE JOE LOUIS ARENA

SUPERSTRUCTURE DETAILS
PLAN OF SLAB - SPAN 4

SCALE: NONE

DRN. NO: S66

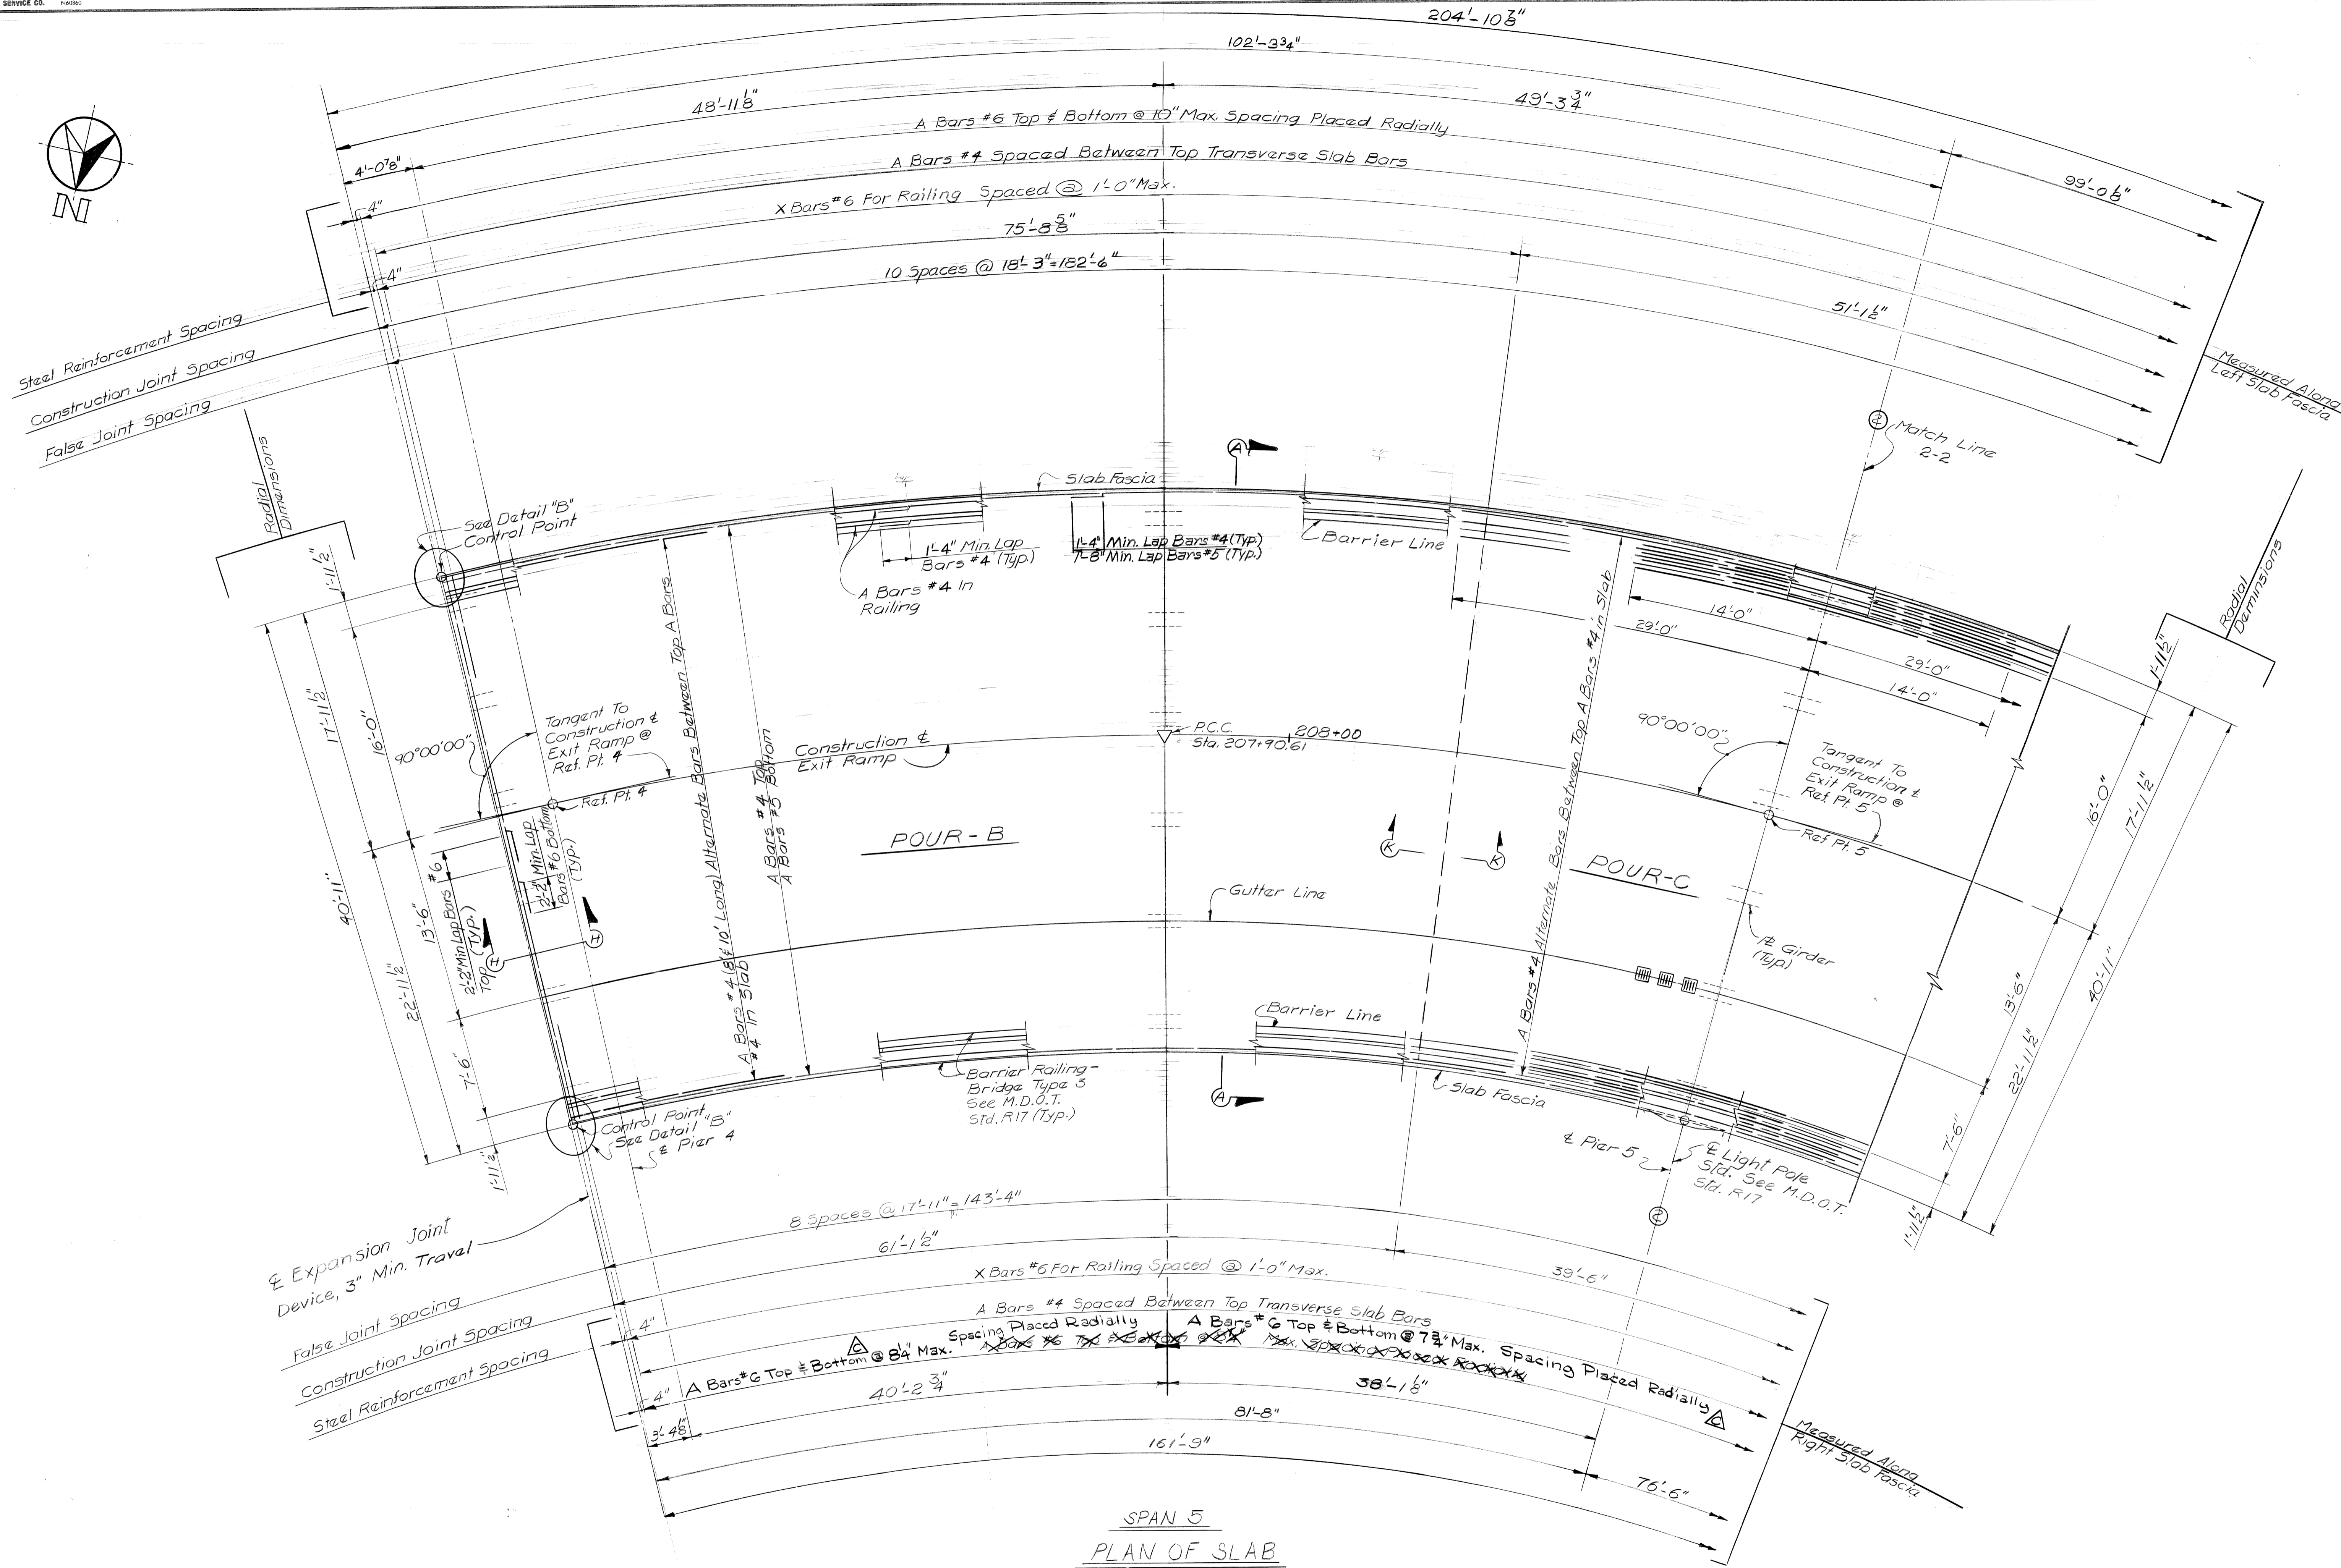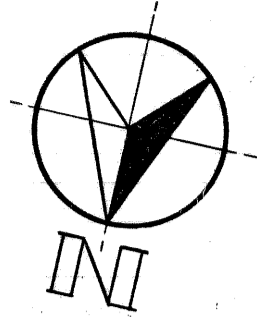

SPAN 5
PLAN OF SLAB


Work This Sheet With Sheets# S64 thru S66 & S68 thru S82

DATE: August, 1979

DSGN BY:	SJP, RGW
DR'N BY:	RD
CK'D BY:	SJP, RGW
APP'D BY:	

REVISIONS	△ Revise Dimensions SJP 1-22-1980
-----------	-----------------------------------


CITY OF DETROIT, MICHIGAN

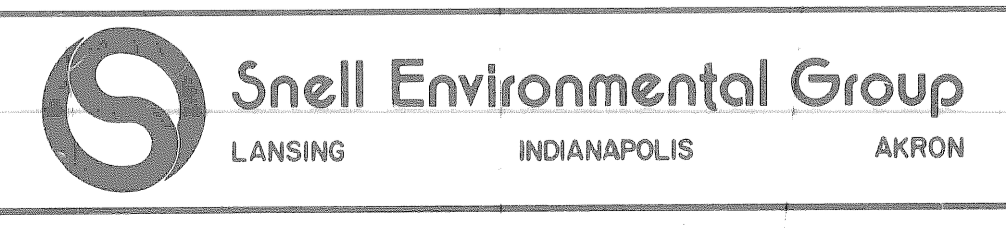

JOHN C. LODGE EXIT RAMP AND JEFFERSON AVENUE RECONSTRUCTION AT THE JOE LOUIS ARENA

SUPERSTRUCTURE DETAILS
PLAN OF SLAB - SPAN 5

SCALE: NONE
DRN. NO: S67

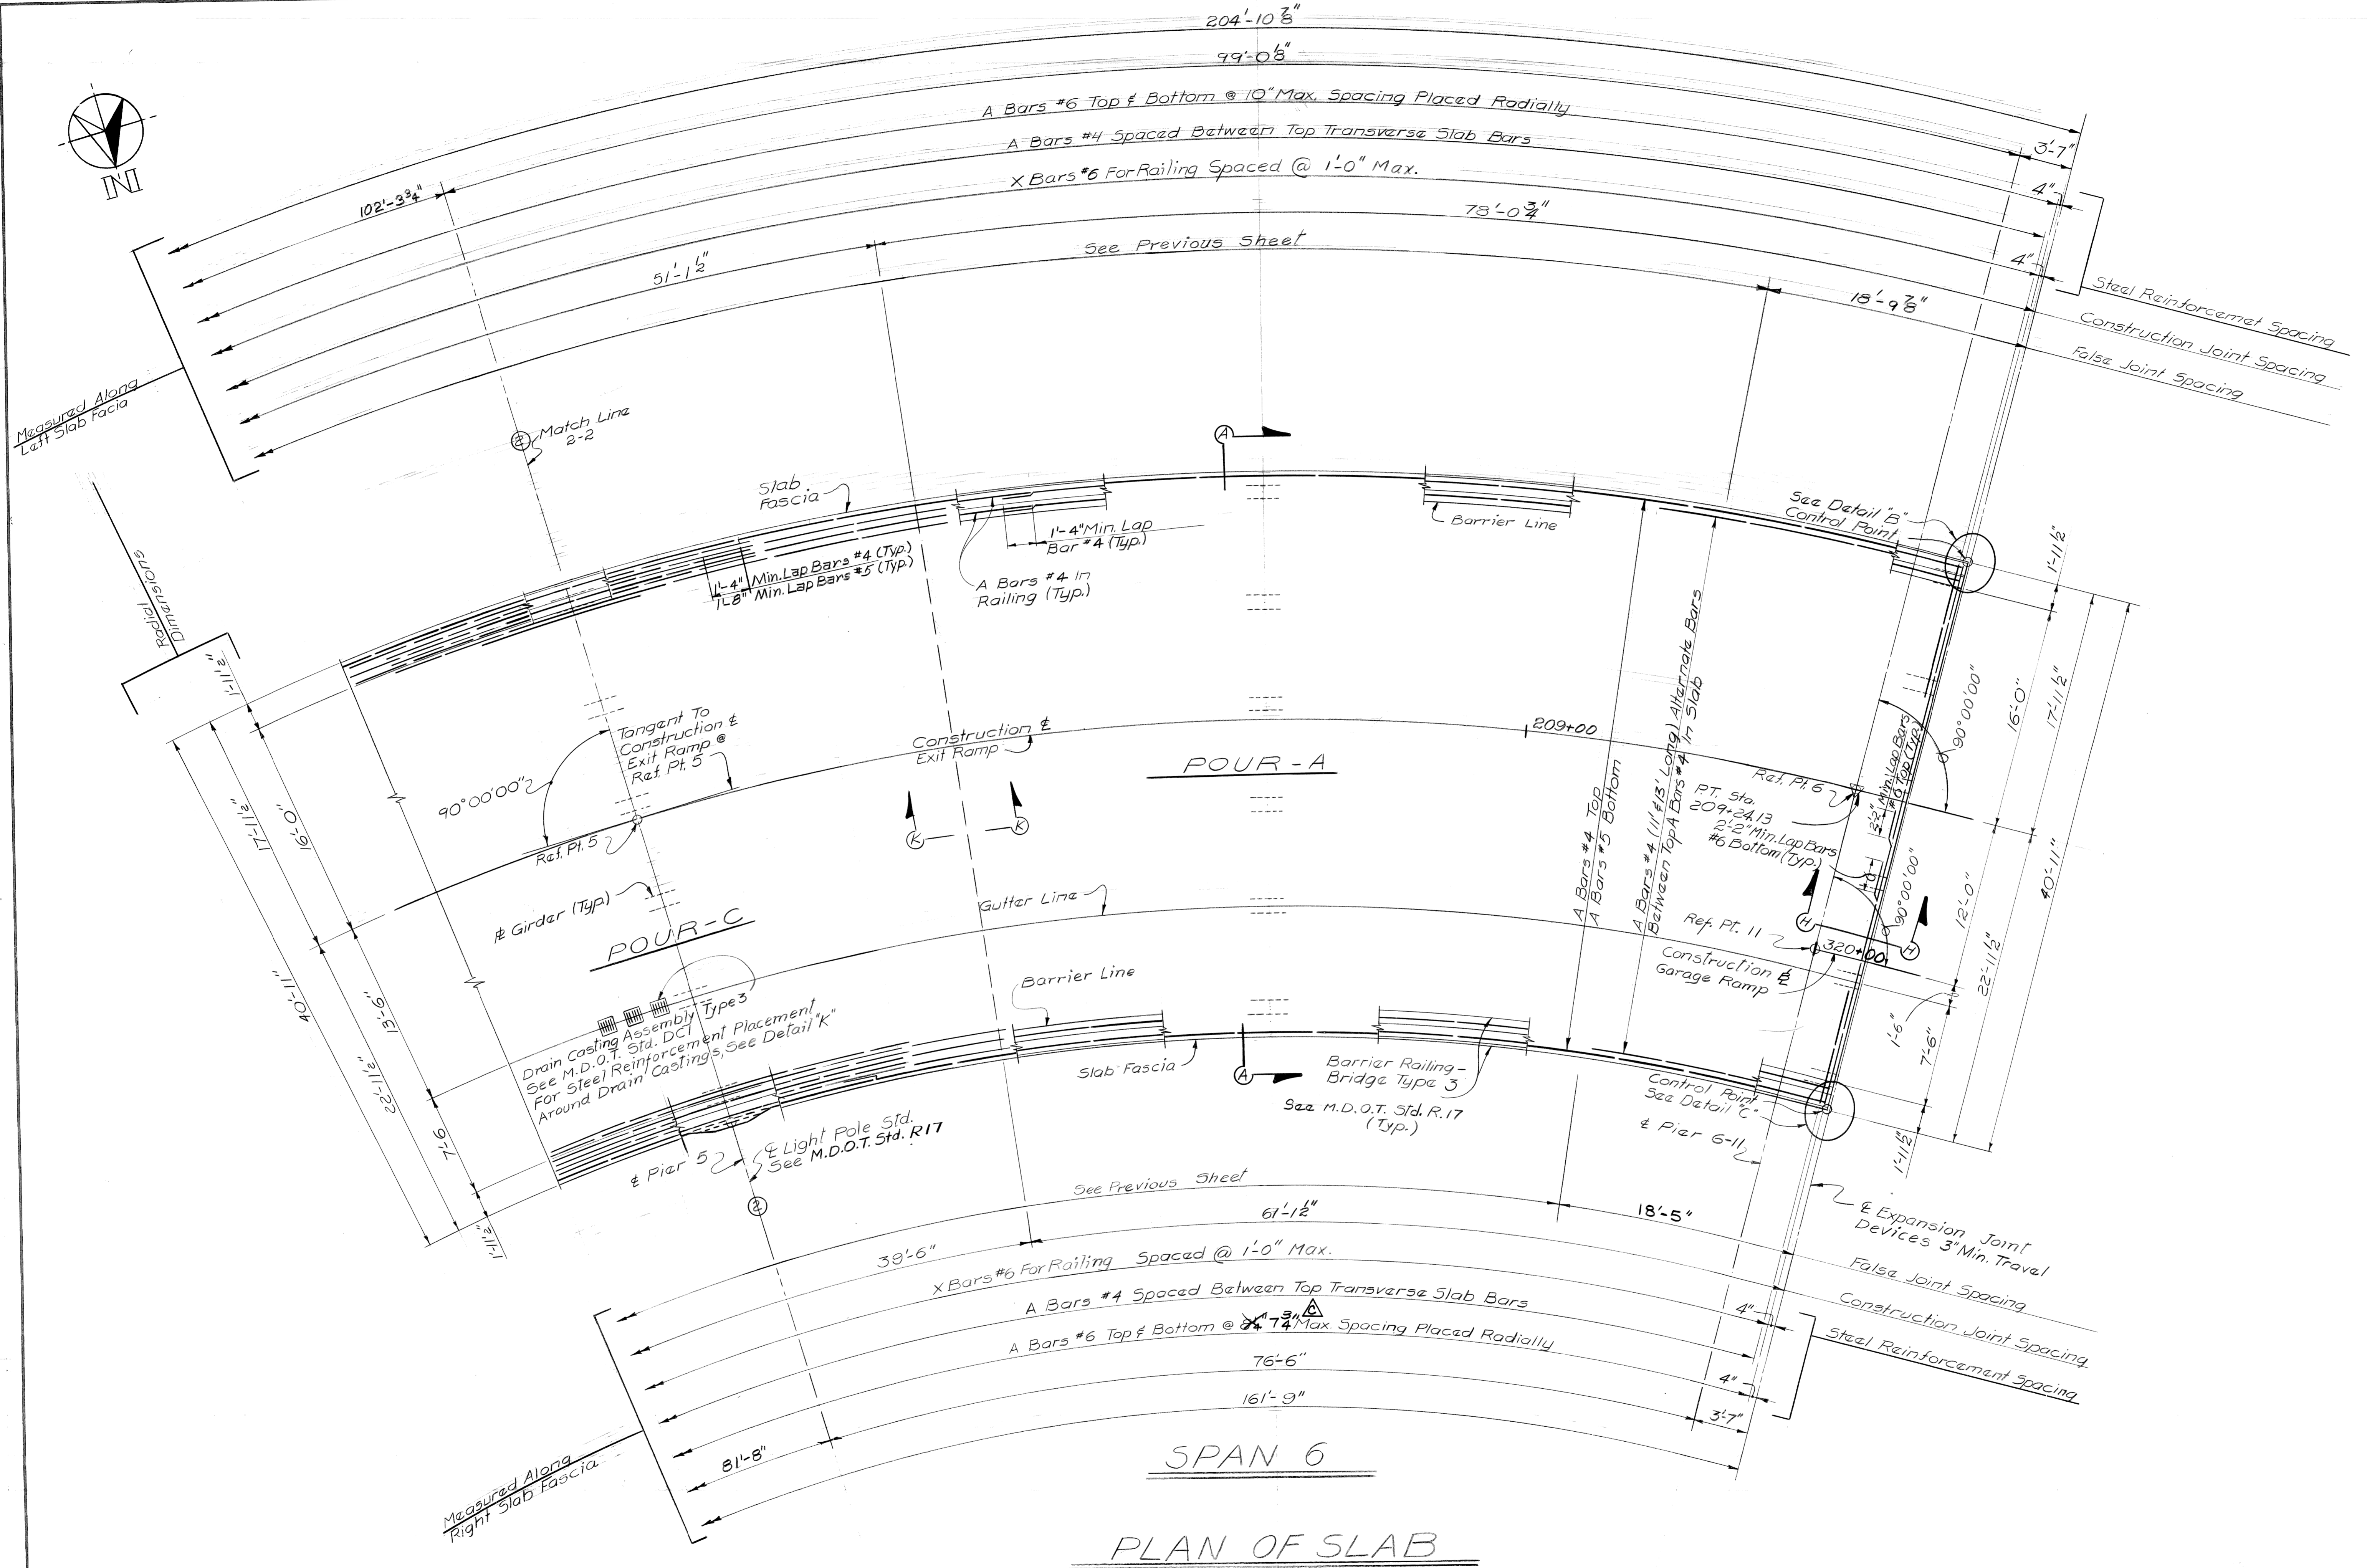

PLAN OF SLAB

Work This Sheet With Sheets # S64 thru S67 & S69 thru S82 DATE: August 1979

DSGN BY: SJR, RW	REVISIONS
DRN BY: RD	
CK'D BY: SJP, RW	
APP'D BY:	

△ Revise Dimension SJP 1-22-1980



CITY OF DETROIT, MICHIGAN



JOHN C. LODGE EXIT RAMP AND JEFFERSON AVENUE- RECONSTRUCTION AT THE JOE LOUIS ARENA.

SUPERSTRUCTURE DETAILS
 PLAN OF SLAB - SPAN 6


SCALE: NONE
 DRN. NO: S68

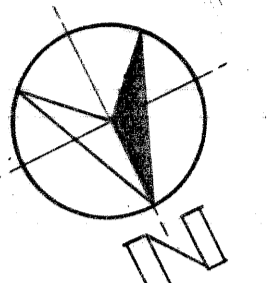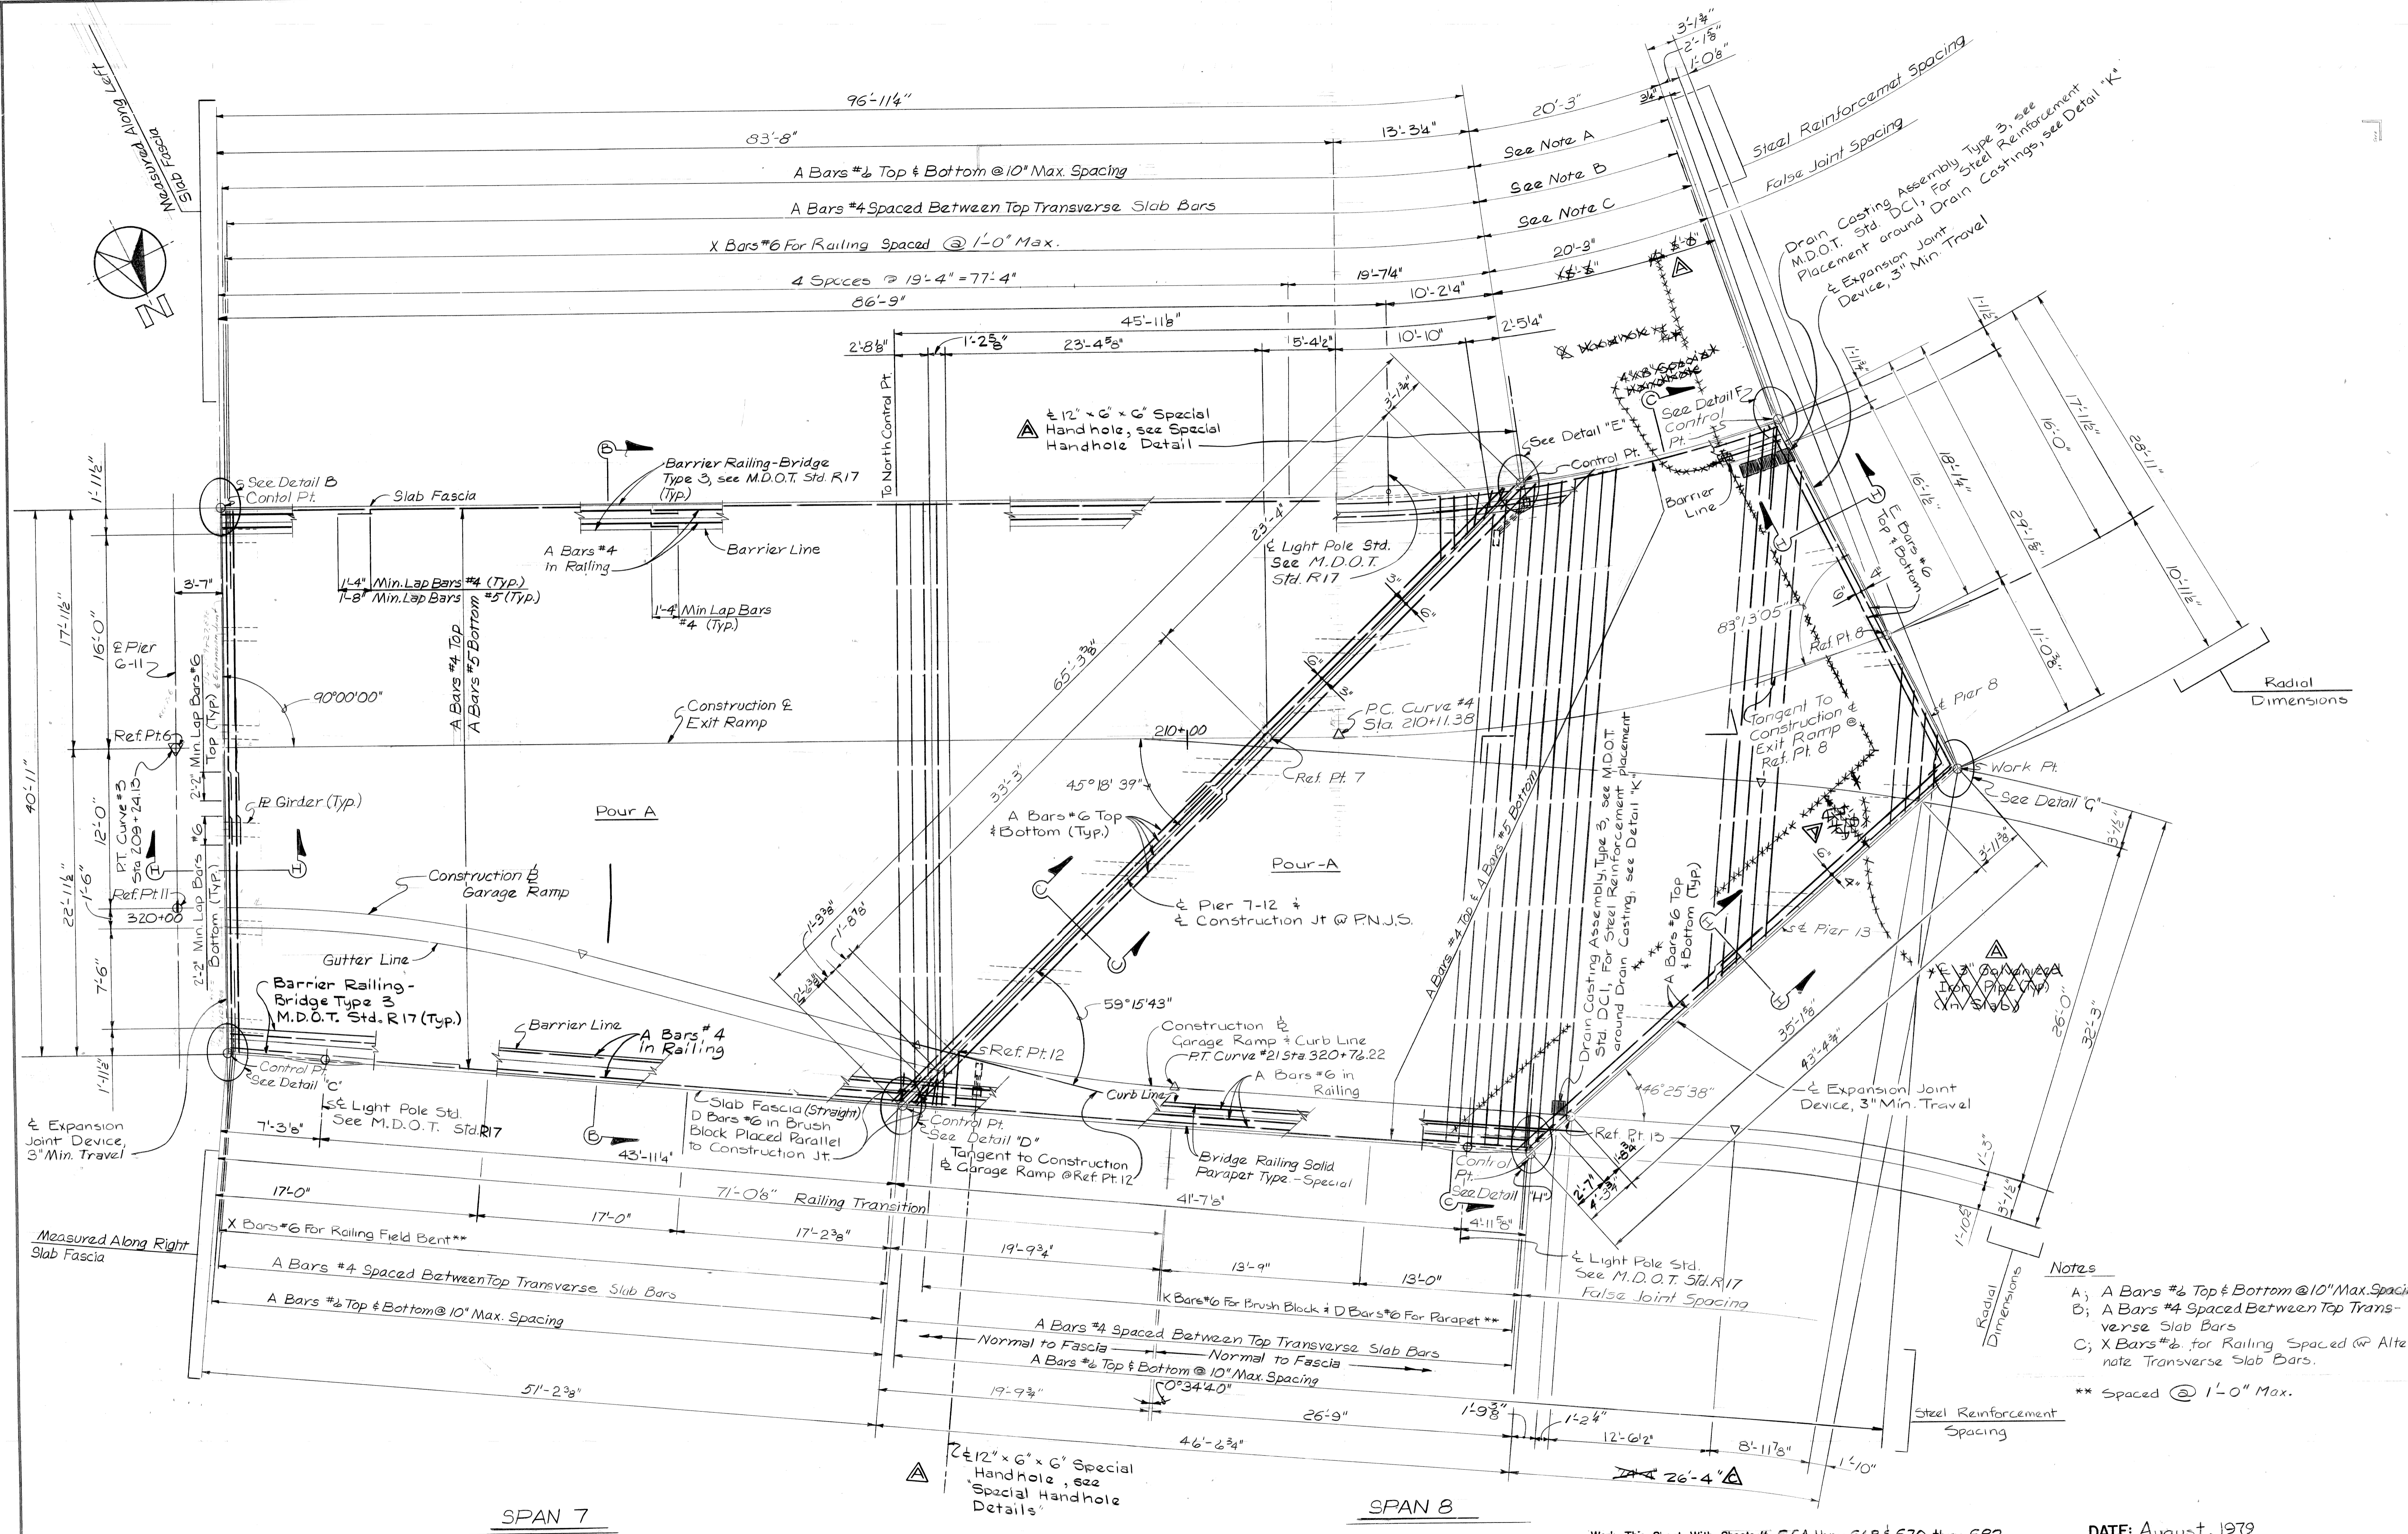

- Notes**
- A; A Bars #6 Top & Bottom @ 10" Max. Spacing
 - B; A Bars #4 Spaced Between Top Transverse Slab Bars
 - C; X Bars #6 for Railing Spaced @ Alternate Transverse Slab Bars.
 - ** Spaced @ 1'-0" Max.

DSGN BY: SJPRGW	Remove 3" Gal. Iron Pipe & Reposition Special Hand Holes / ESP 11-14-1979
DRN BY: DE	Revise Dimension ESP 1-7-1980
CK'D BY: SJPRGW	
APP'D BY:	

CITY OF DETROIT, MICHIGAN

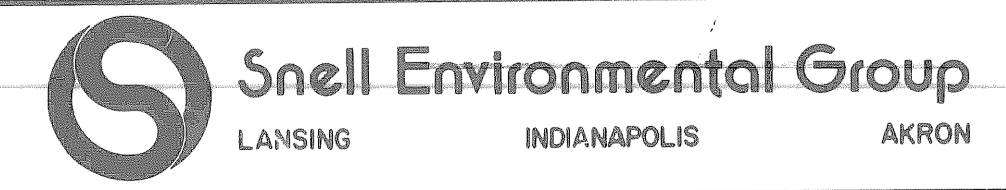



JOHN C. LODGE EXIT RAMP AND JEFFERSON AVENUE-7 RECONSTRUCTION AT THE JOE LOUIS ARENA

SUPERSTRUCTURE DETAILS PLAN OF SLAB - SPANS 7 AND 8

SCALE: NONE
DRN. NO: S69

Work This Sheet With Sheets # S64 thru S68 & S70 thru S82

DATE: August, 1979

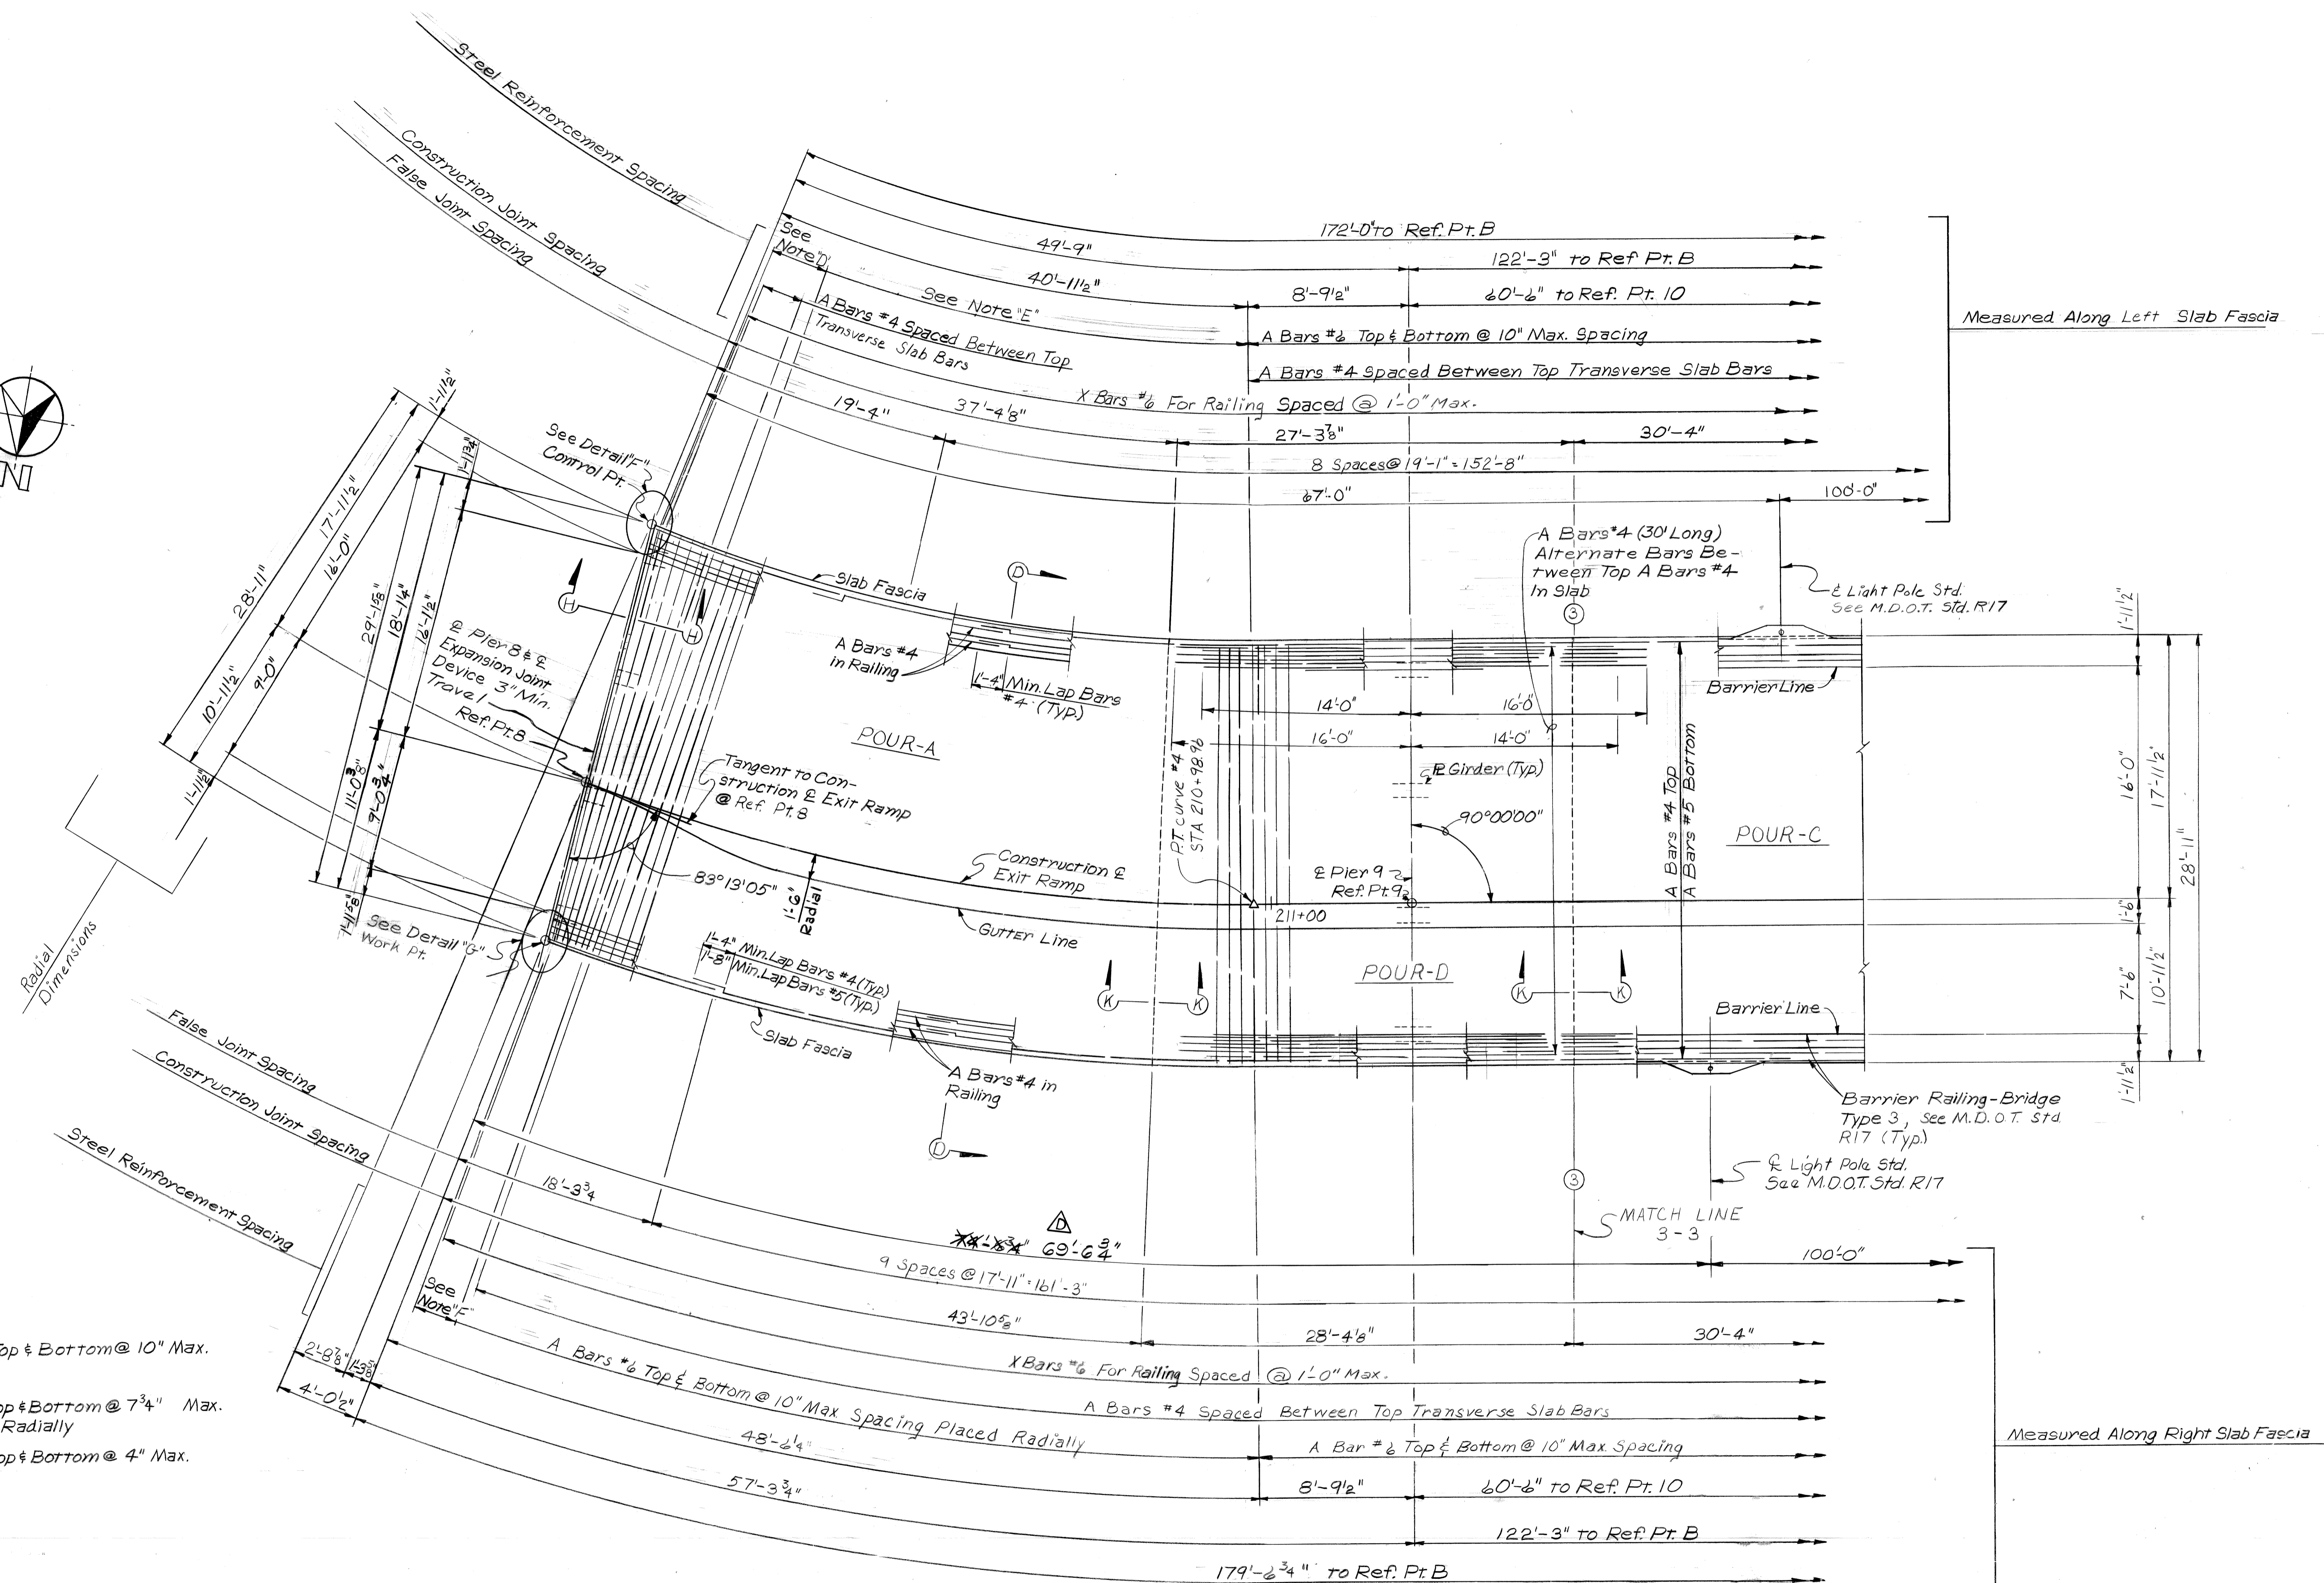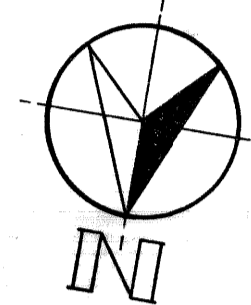

- Notes:
- D: A Bars #6 Top & Bottom @ 10" Max. Spacing Fanned
 - E: A Bars #6 Top & Bottom @ 7 3/4" Max. Spacing Placed Radially
 - F: A Bars #6 Top & Bottom @ 4" Max. Spacing Fanned

SPAN 9

PLAN OF SLAB

SPAN 10
(Partial)

Work This Sheet With Sheets # S64 thru S69 & S71 thru S82 DATE: August, 1979

DSGN BY:	SJPRGW
DRN BY:	DE
CHK'D BY:	SJP, RGW
APP'D BY:	

REVISIONS	Change Dimension SJP 3-21-80


CITY OF DETROIT, MICHIGAN



JOHN C. LODGE EXIT RAMP AND JEFFERSON AVENUE RECONSTRUCTION AT THE JOE LOUIS ARENA

SUPERSTRUCTURE DETAILS
PLAN OF SLAB - SPANS 9 AND 10 (PARTIAL)

SCALE: NONE
DRN. NO: S70

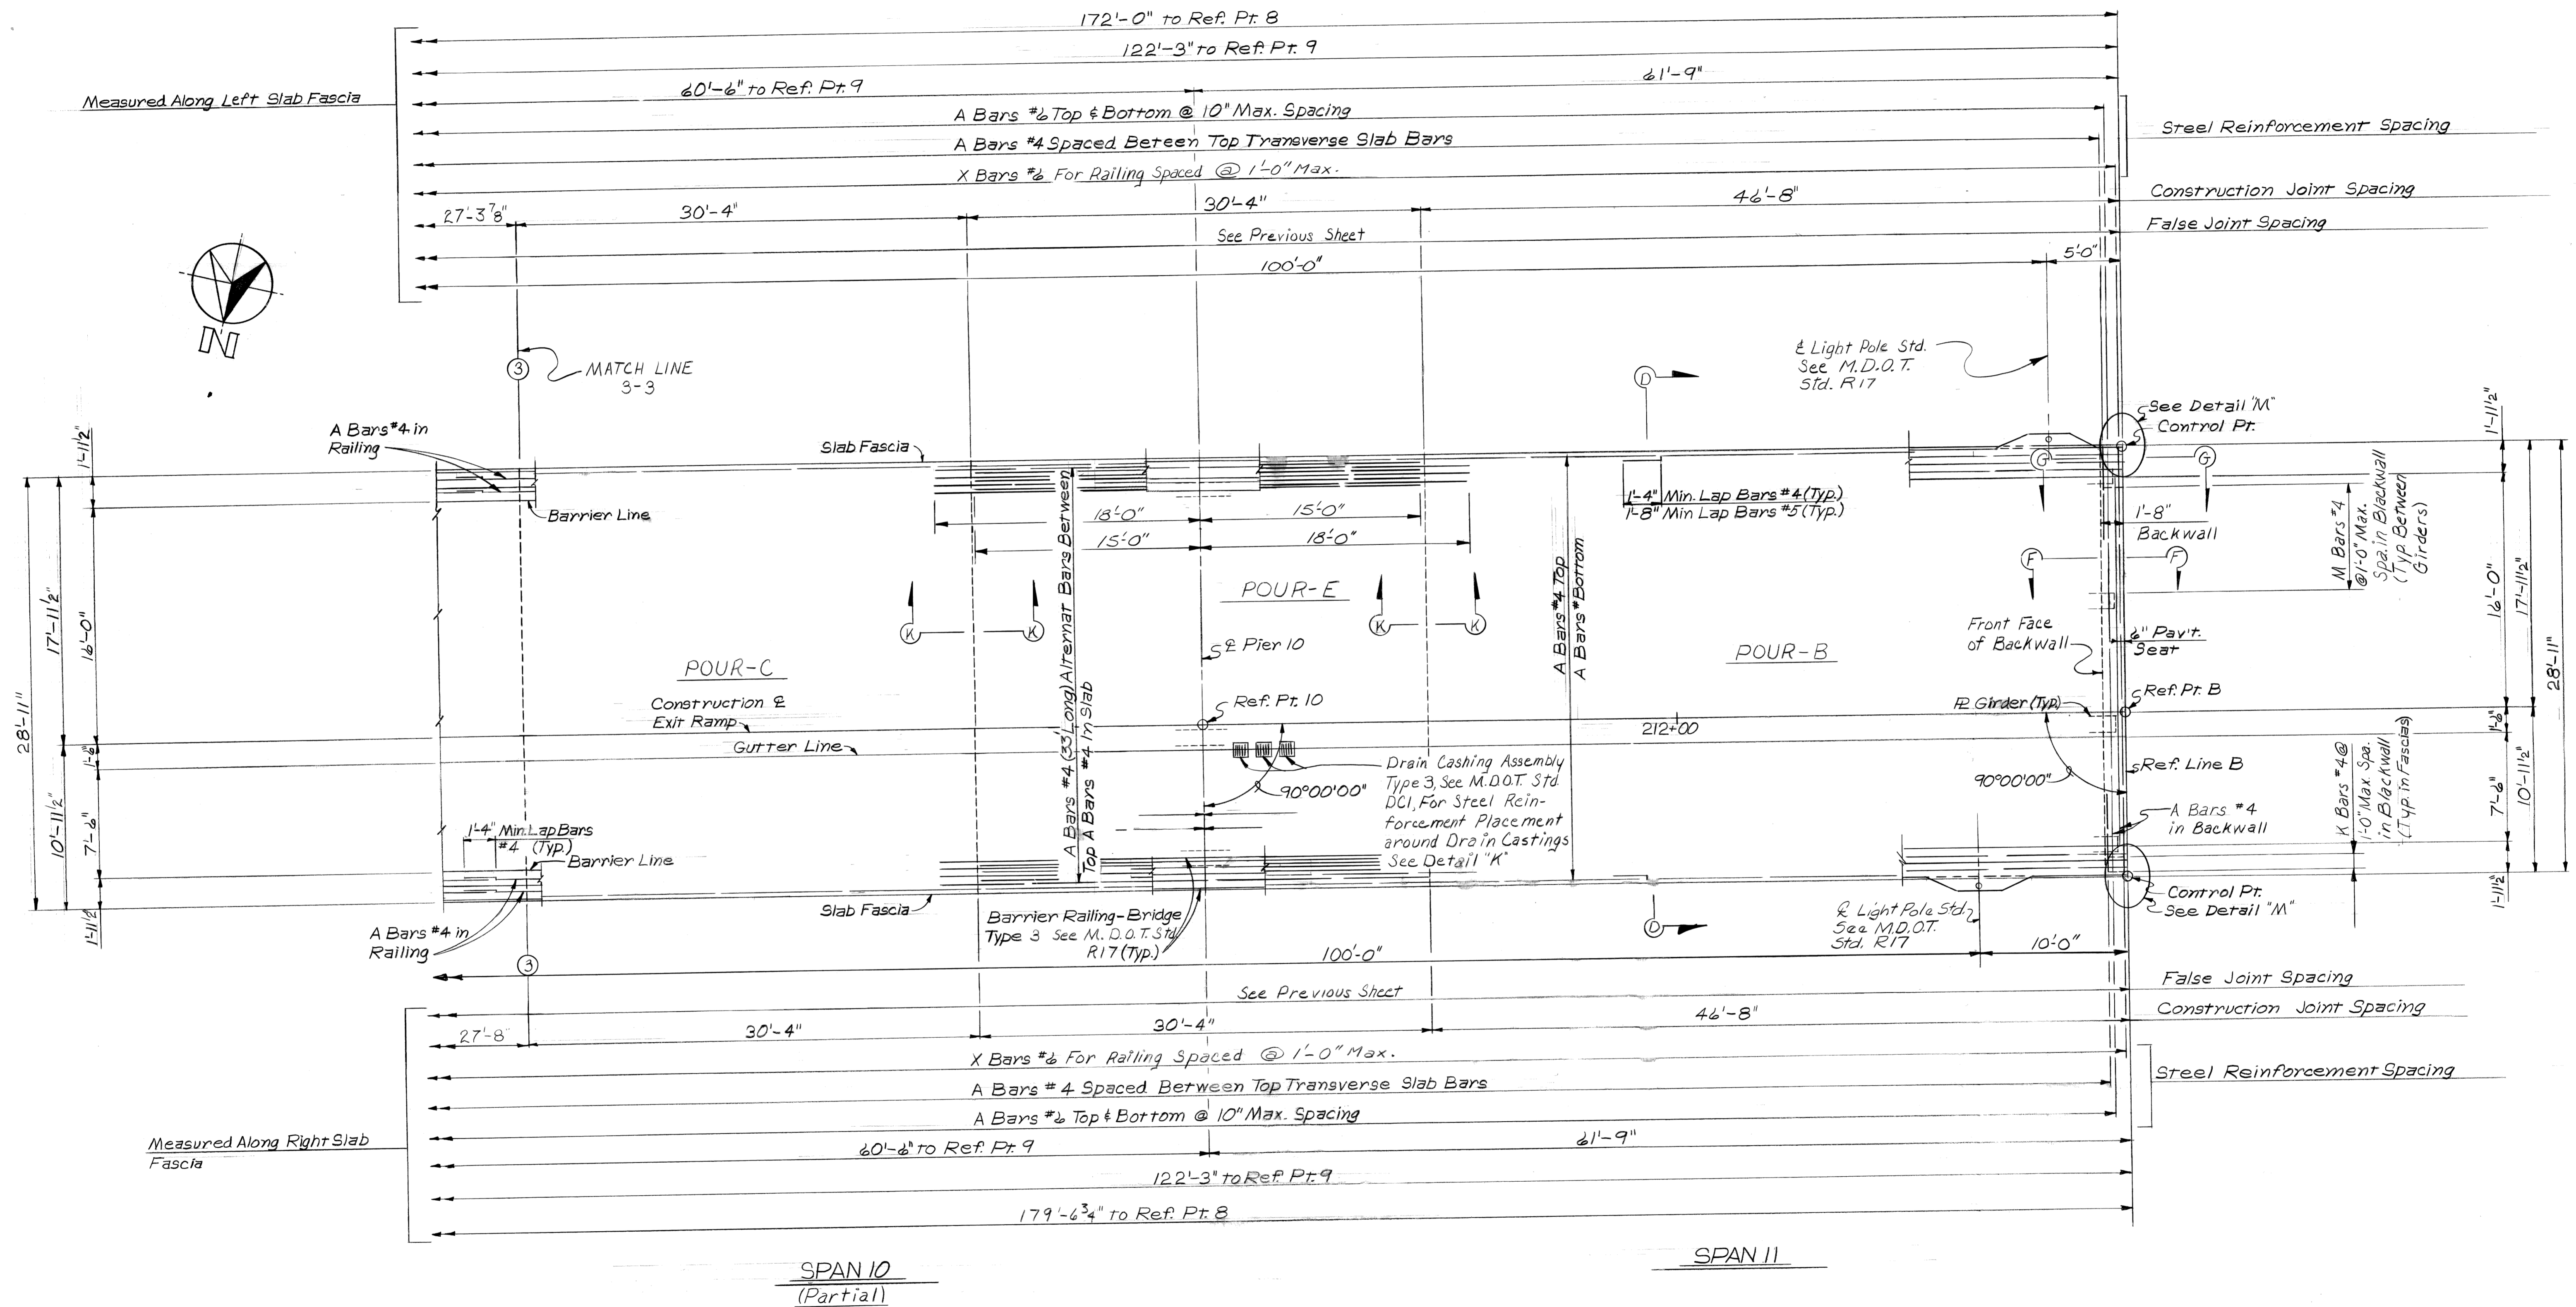

PLAN OF SLAB

Work This Sheet With Sheets # S64 thru S70 & S72 thru S82

DATE: August, 1979

DSGN BY:	SJP, RGW
DRN BY:	DE
CHK'D BY:	SJP, RGW
APP'D BY:	

REVISIONS	






CITY OF DETROIT, MICHIGAN



















JOHN C. LODGE EXIT RAMP AND JEFFERSON AVENUE RECONSTRUCTION AT THE JOE LOUIS ARENA.

SUPERSTRUCTURE DETAILS
PLAN OF SLAB - SPANS 10(PARTIAL) AND 11



SCALE: NONE
DRN. NO: S71

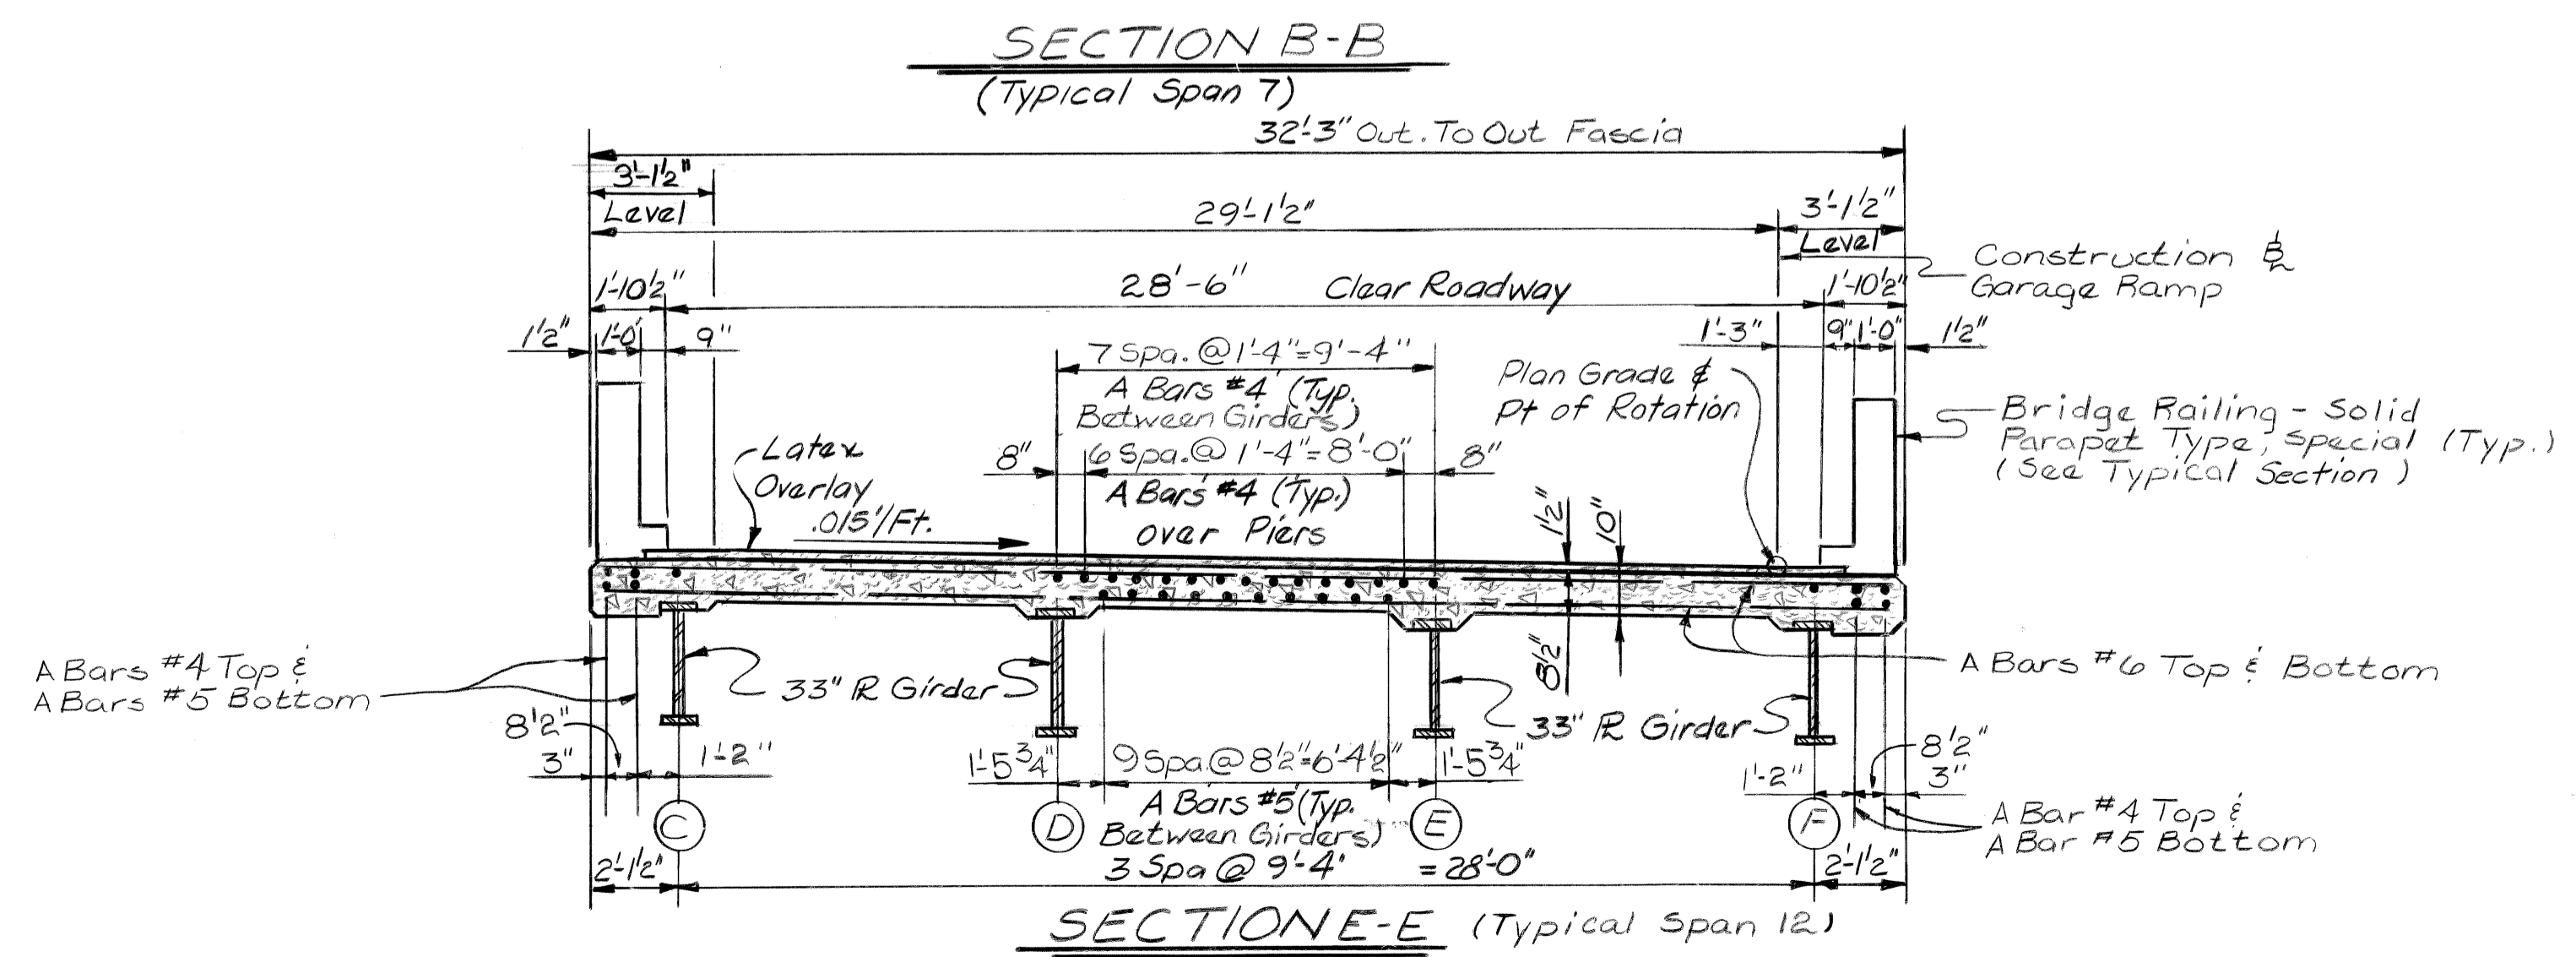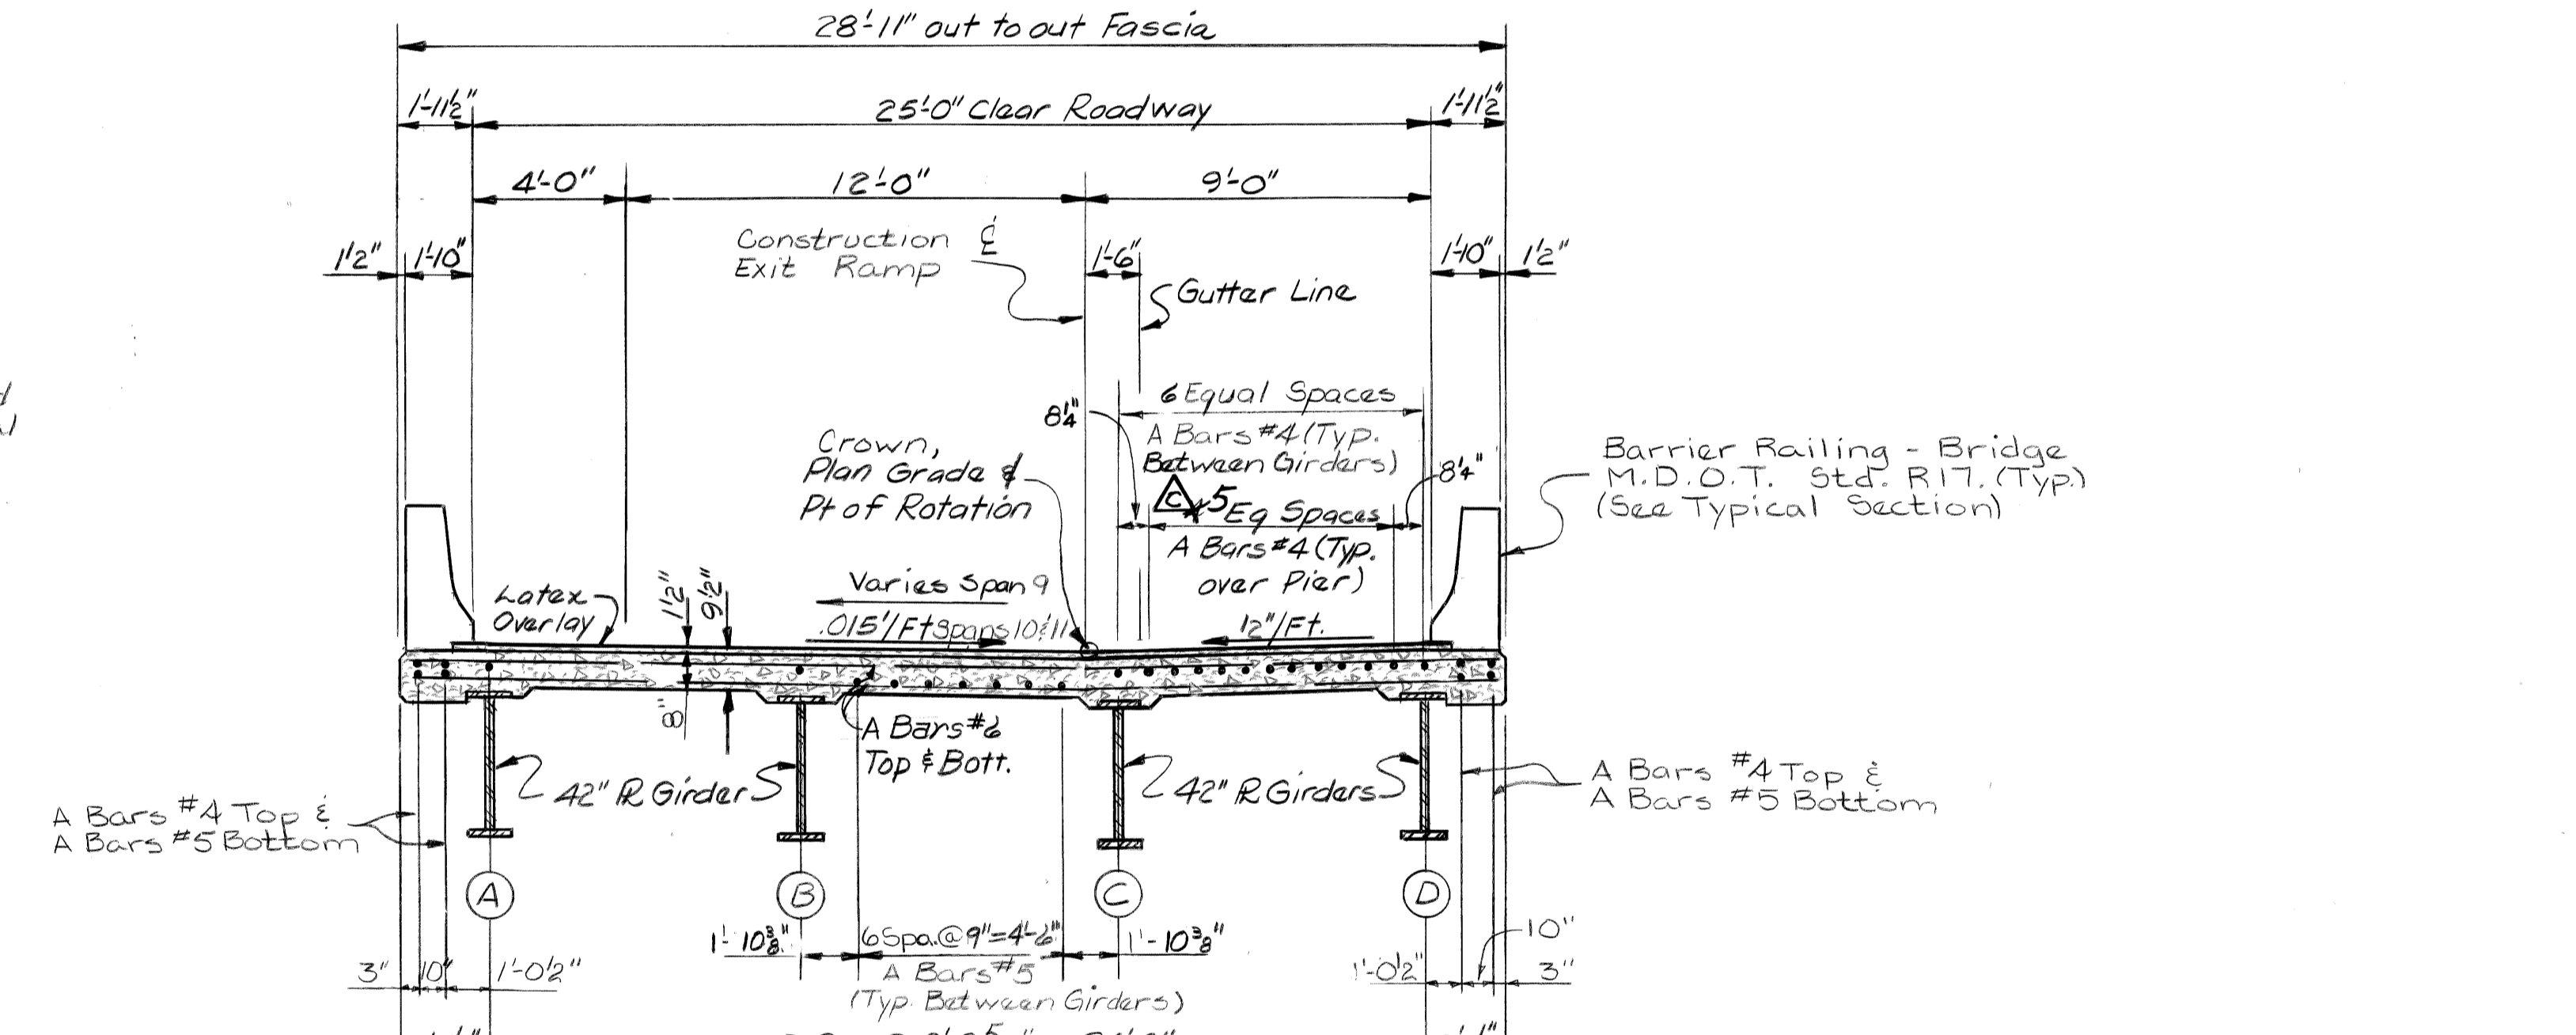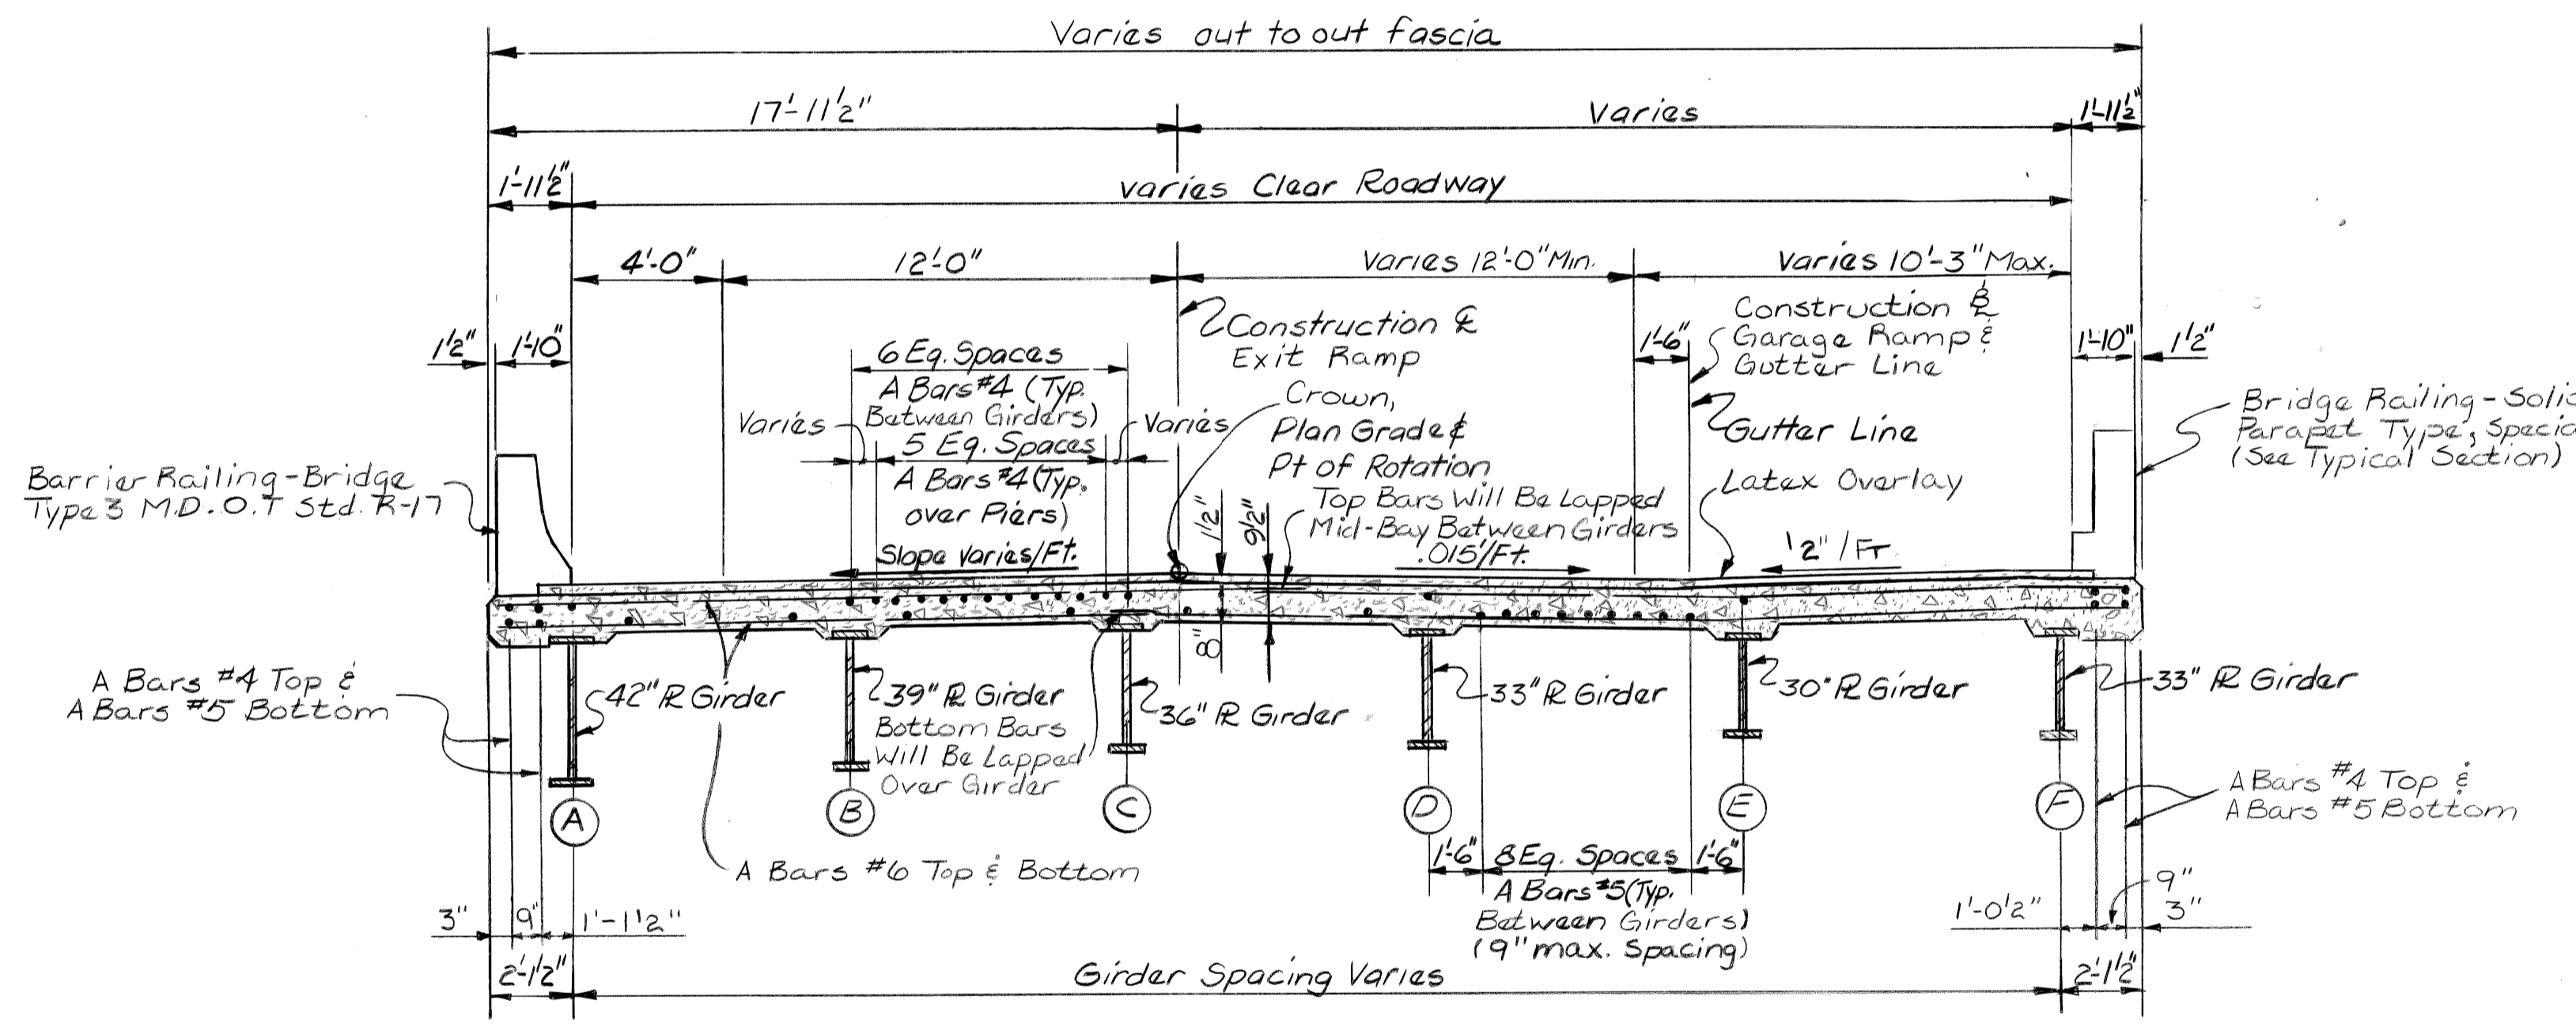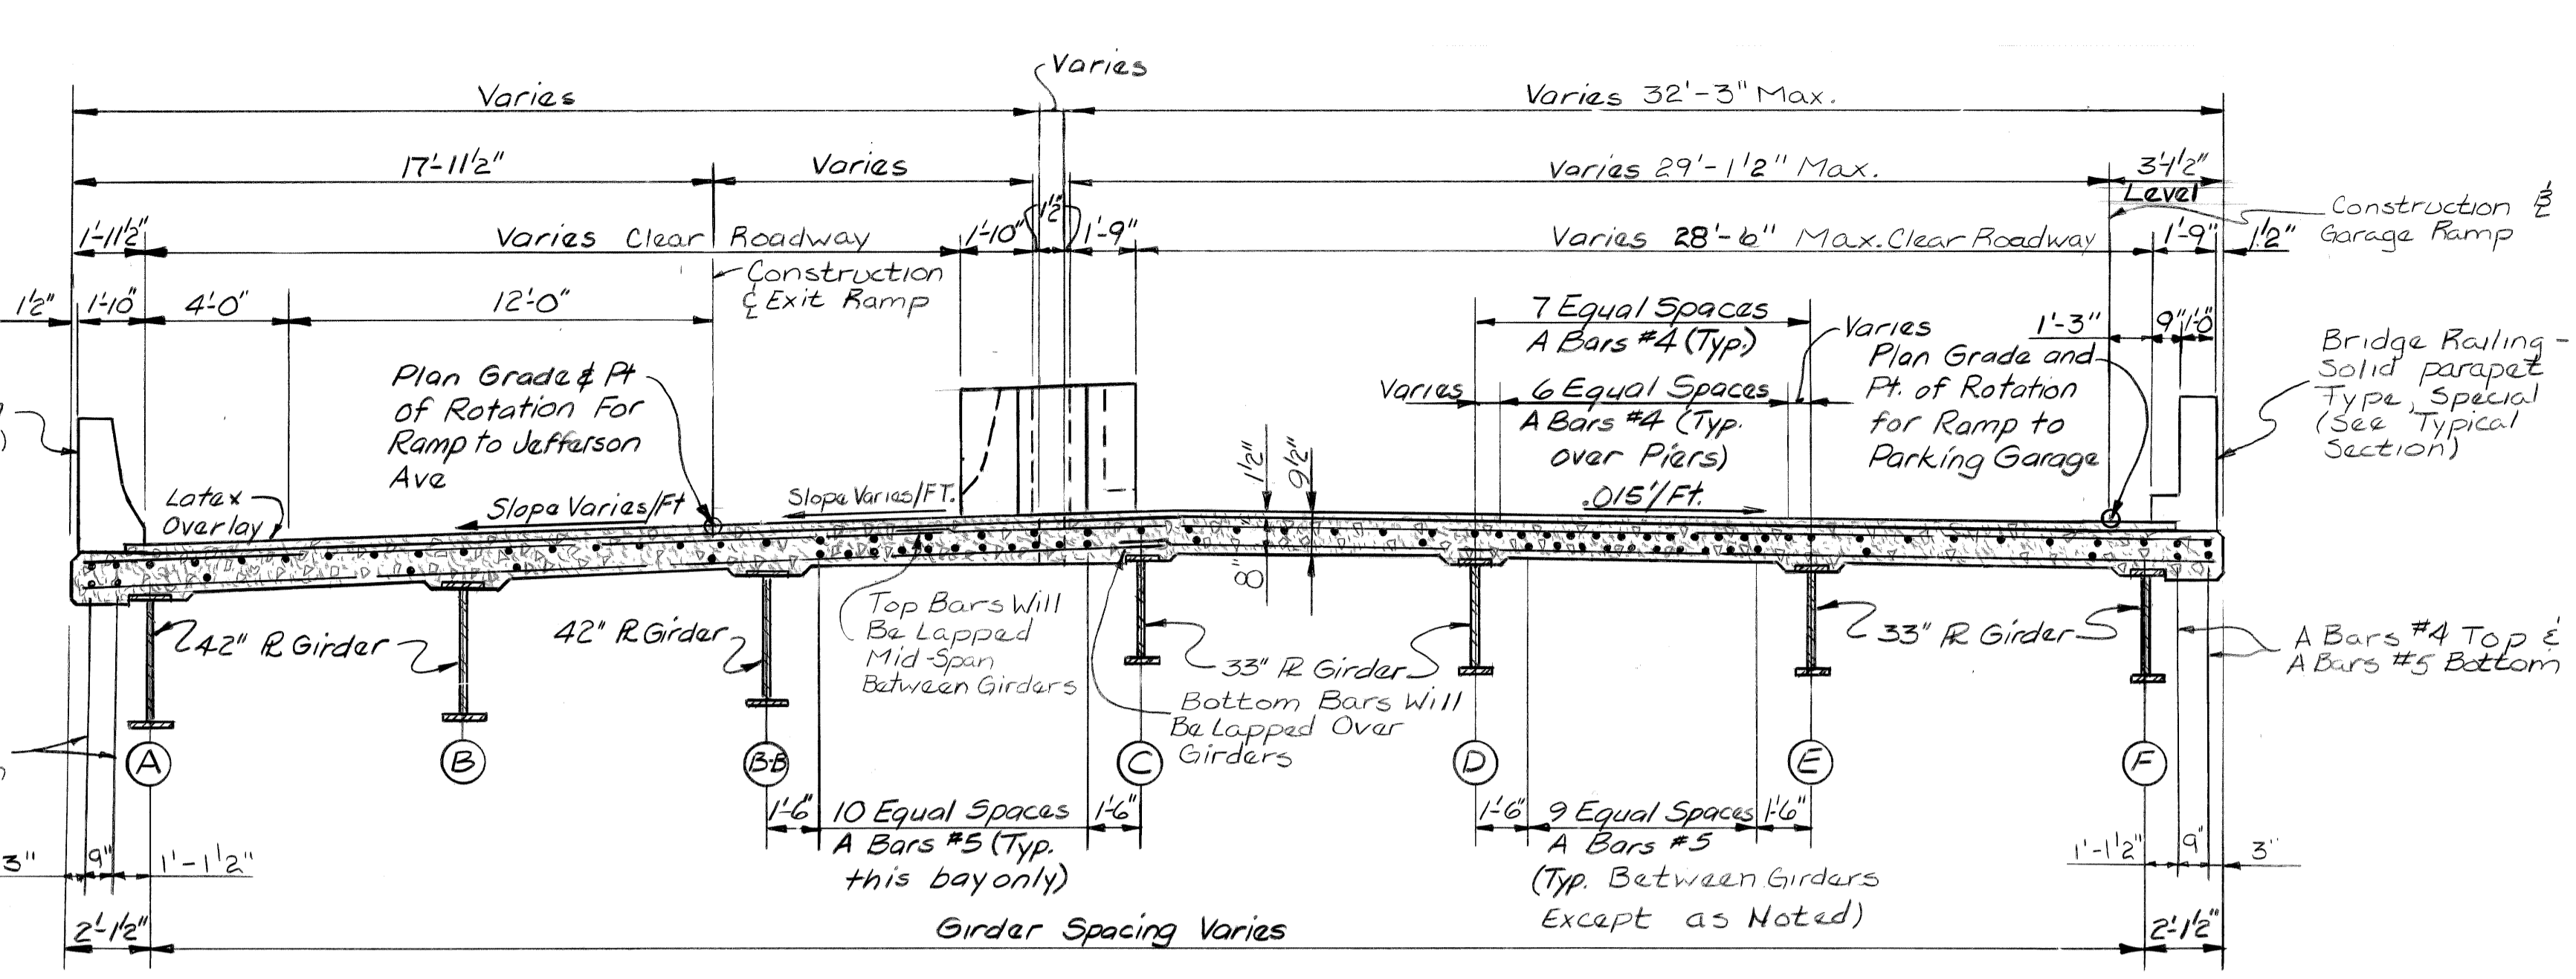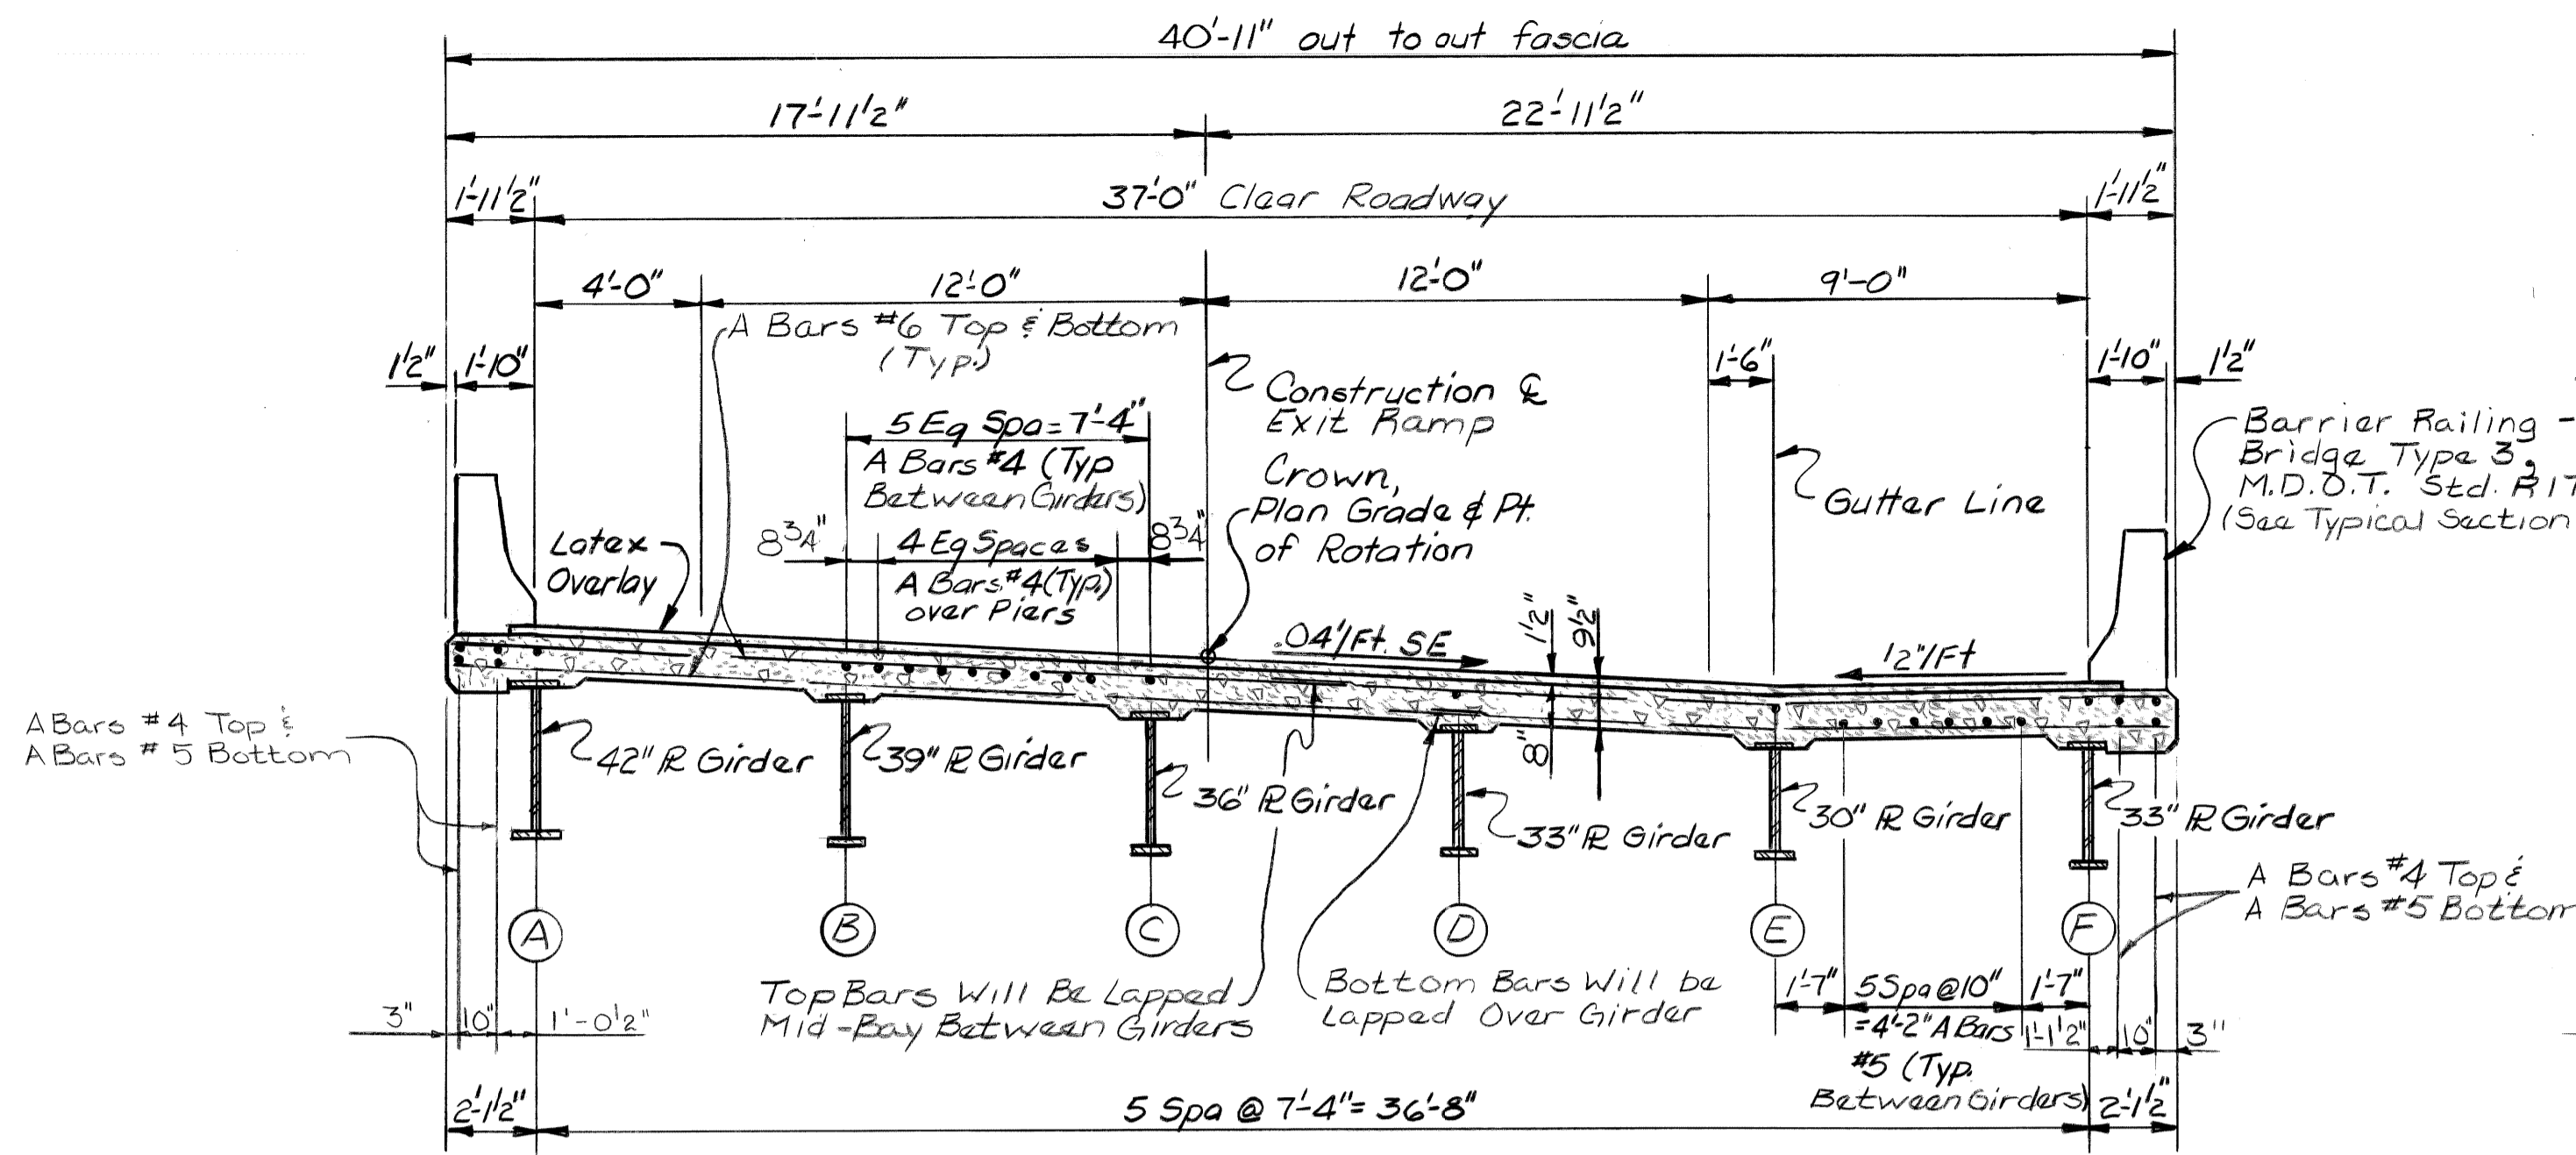

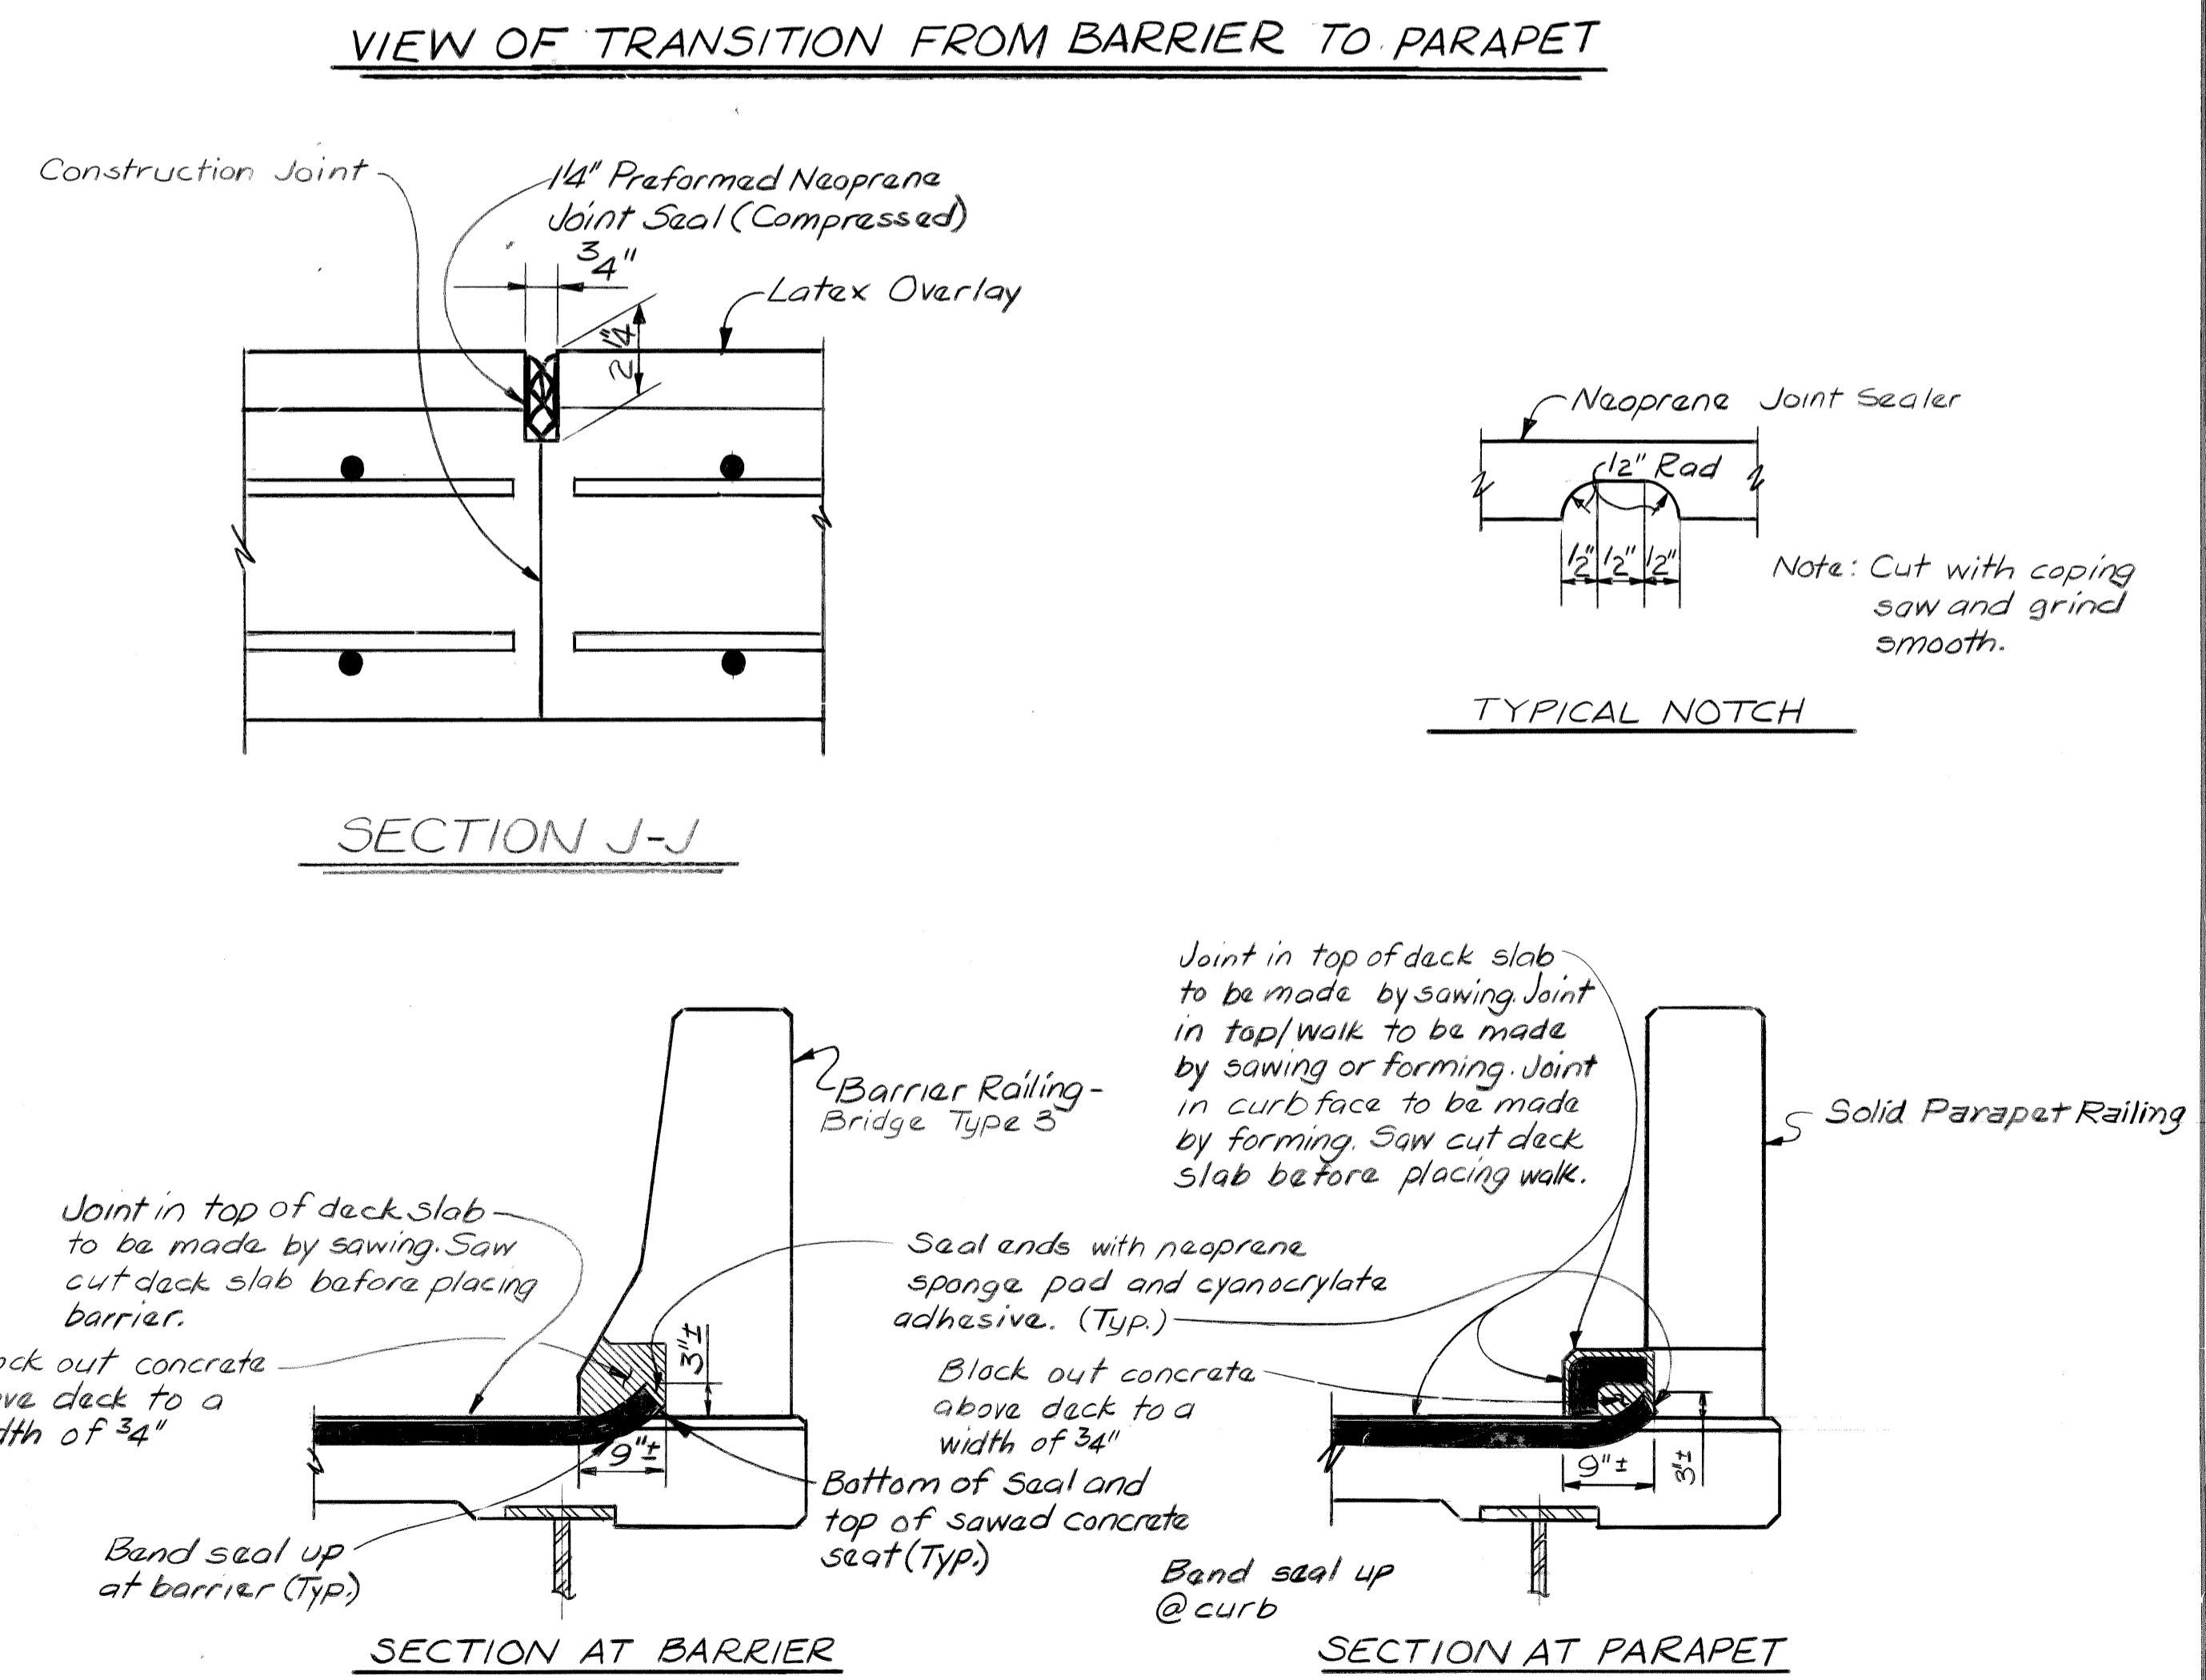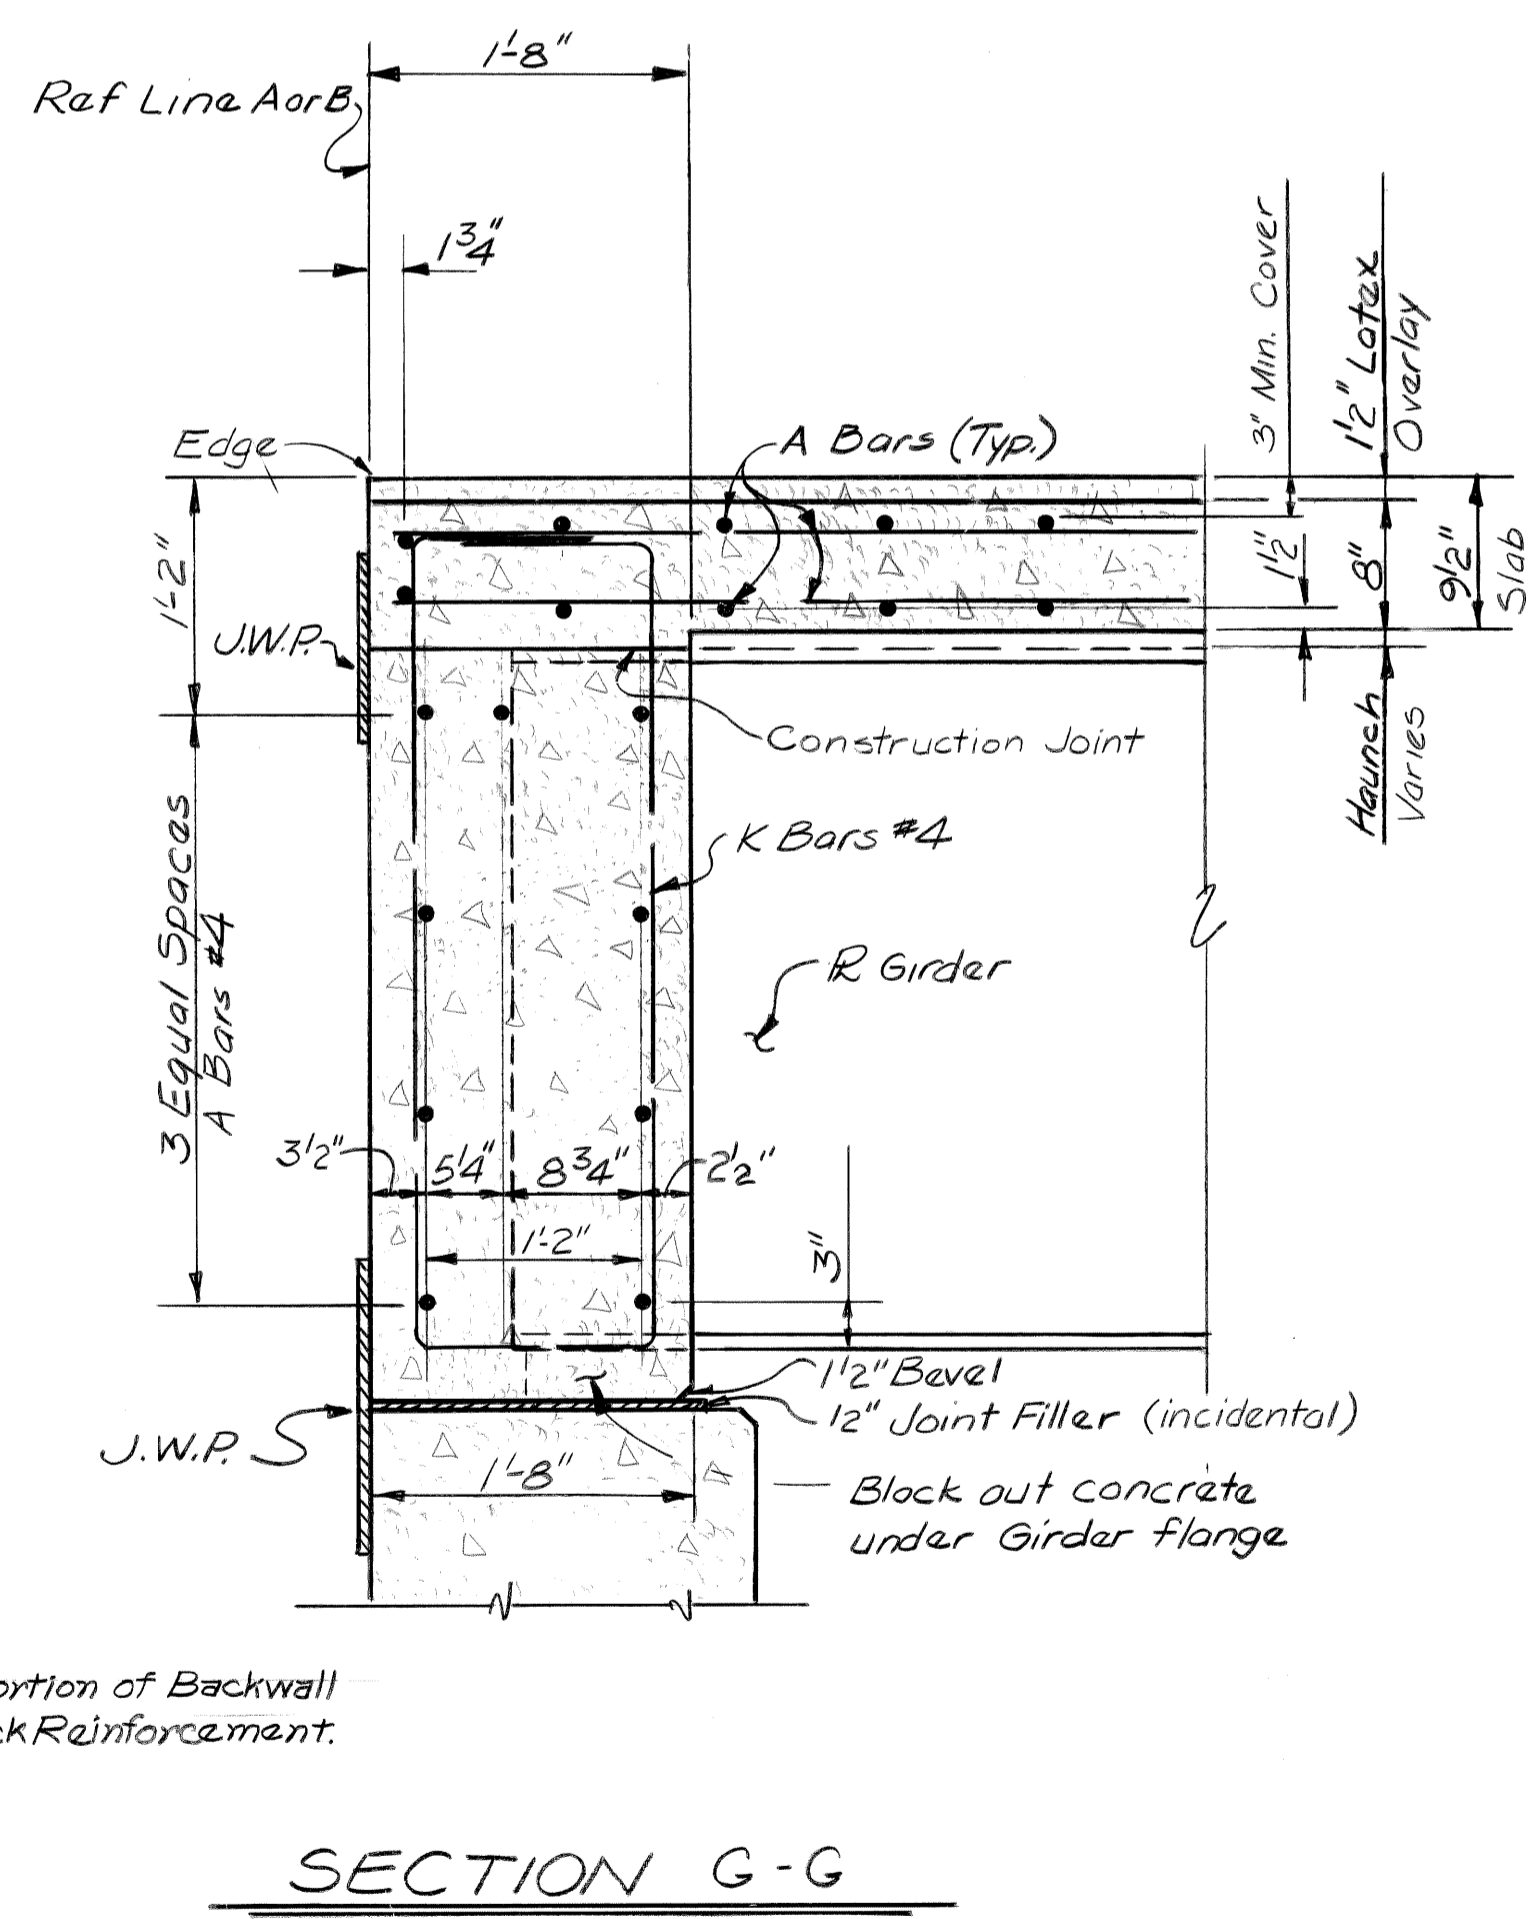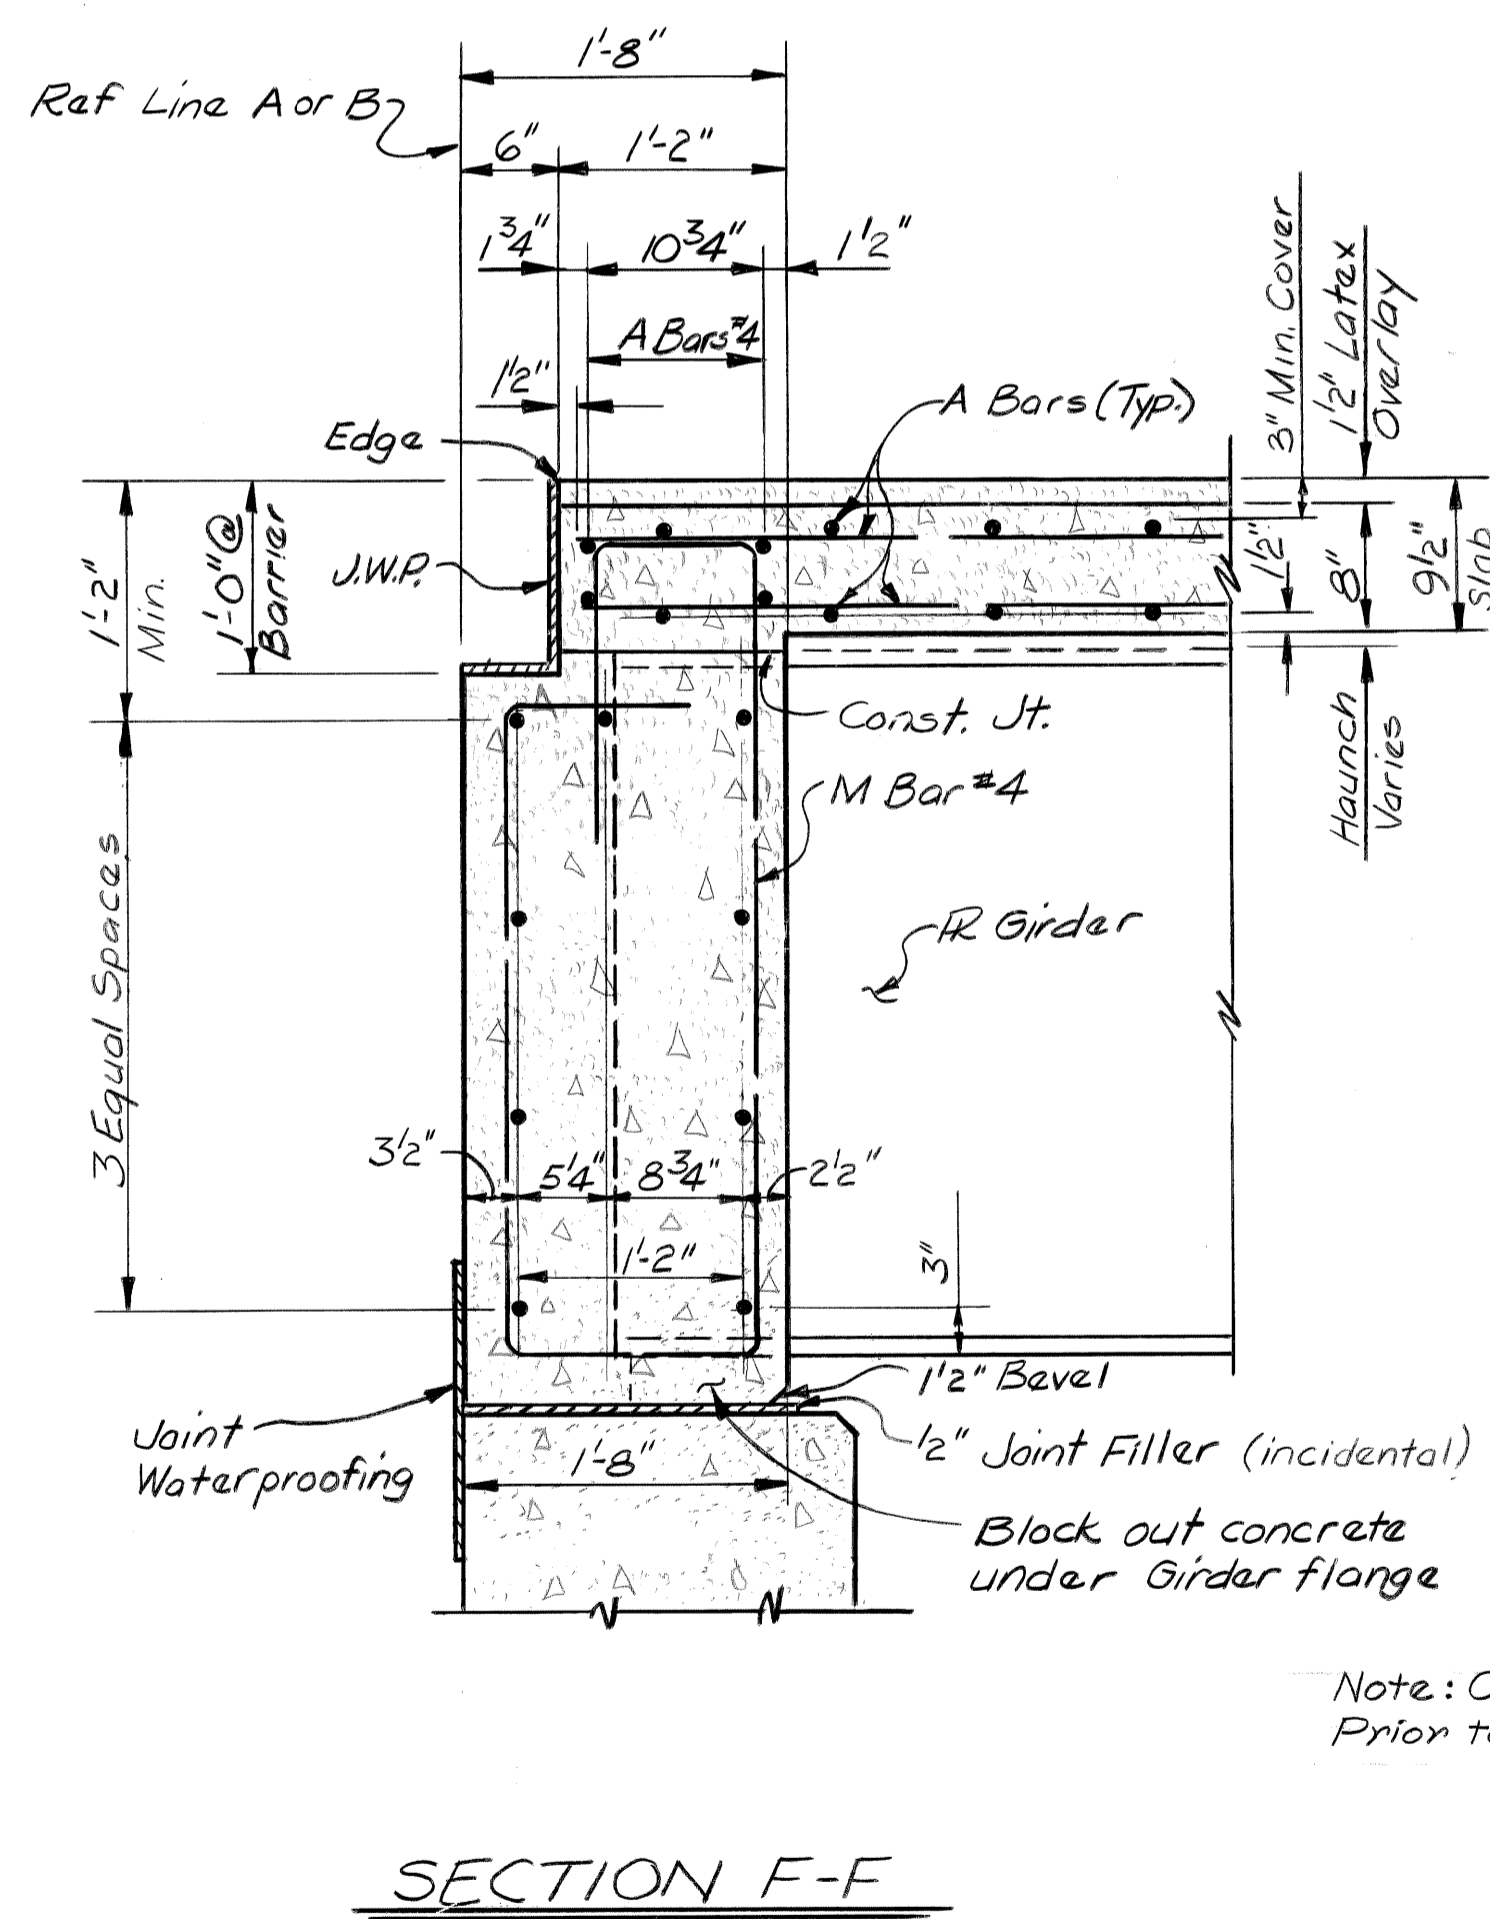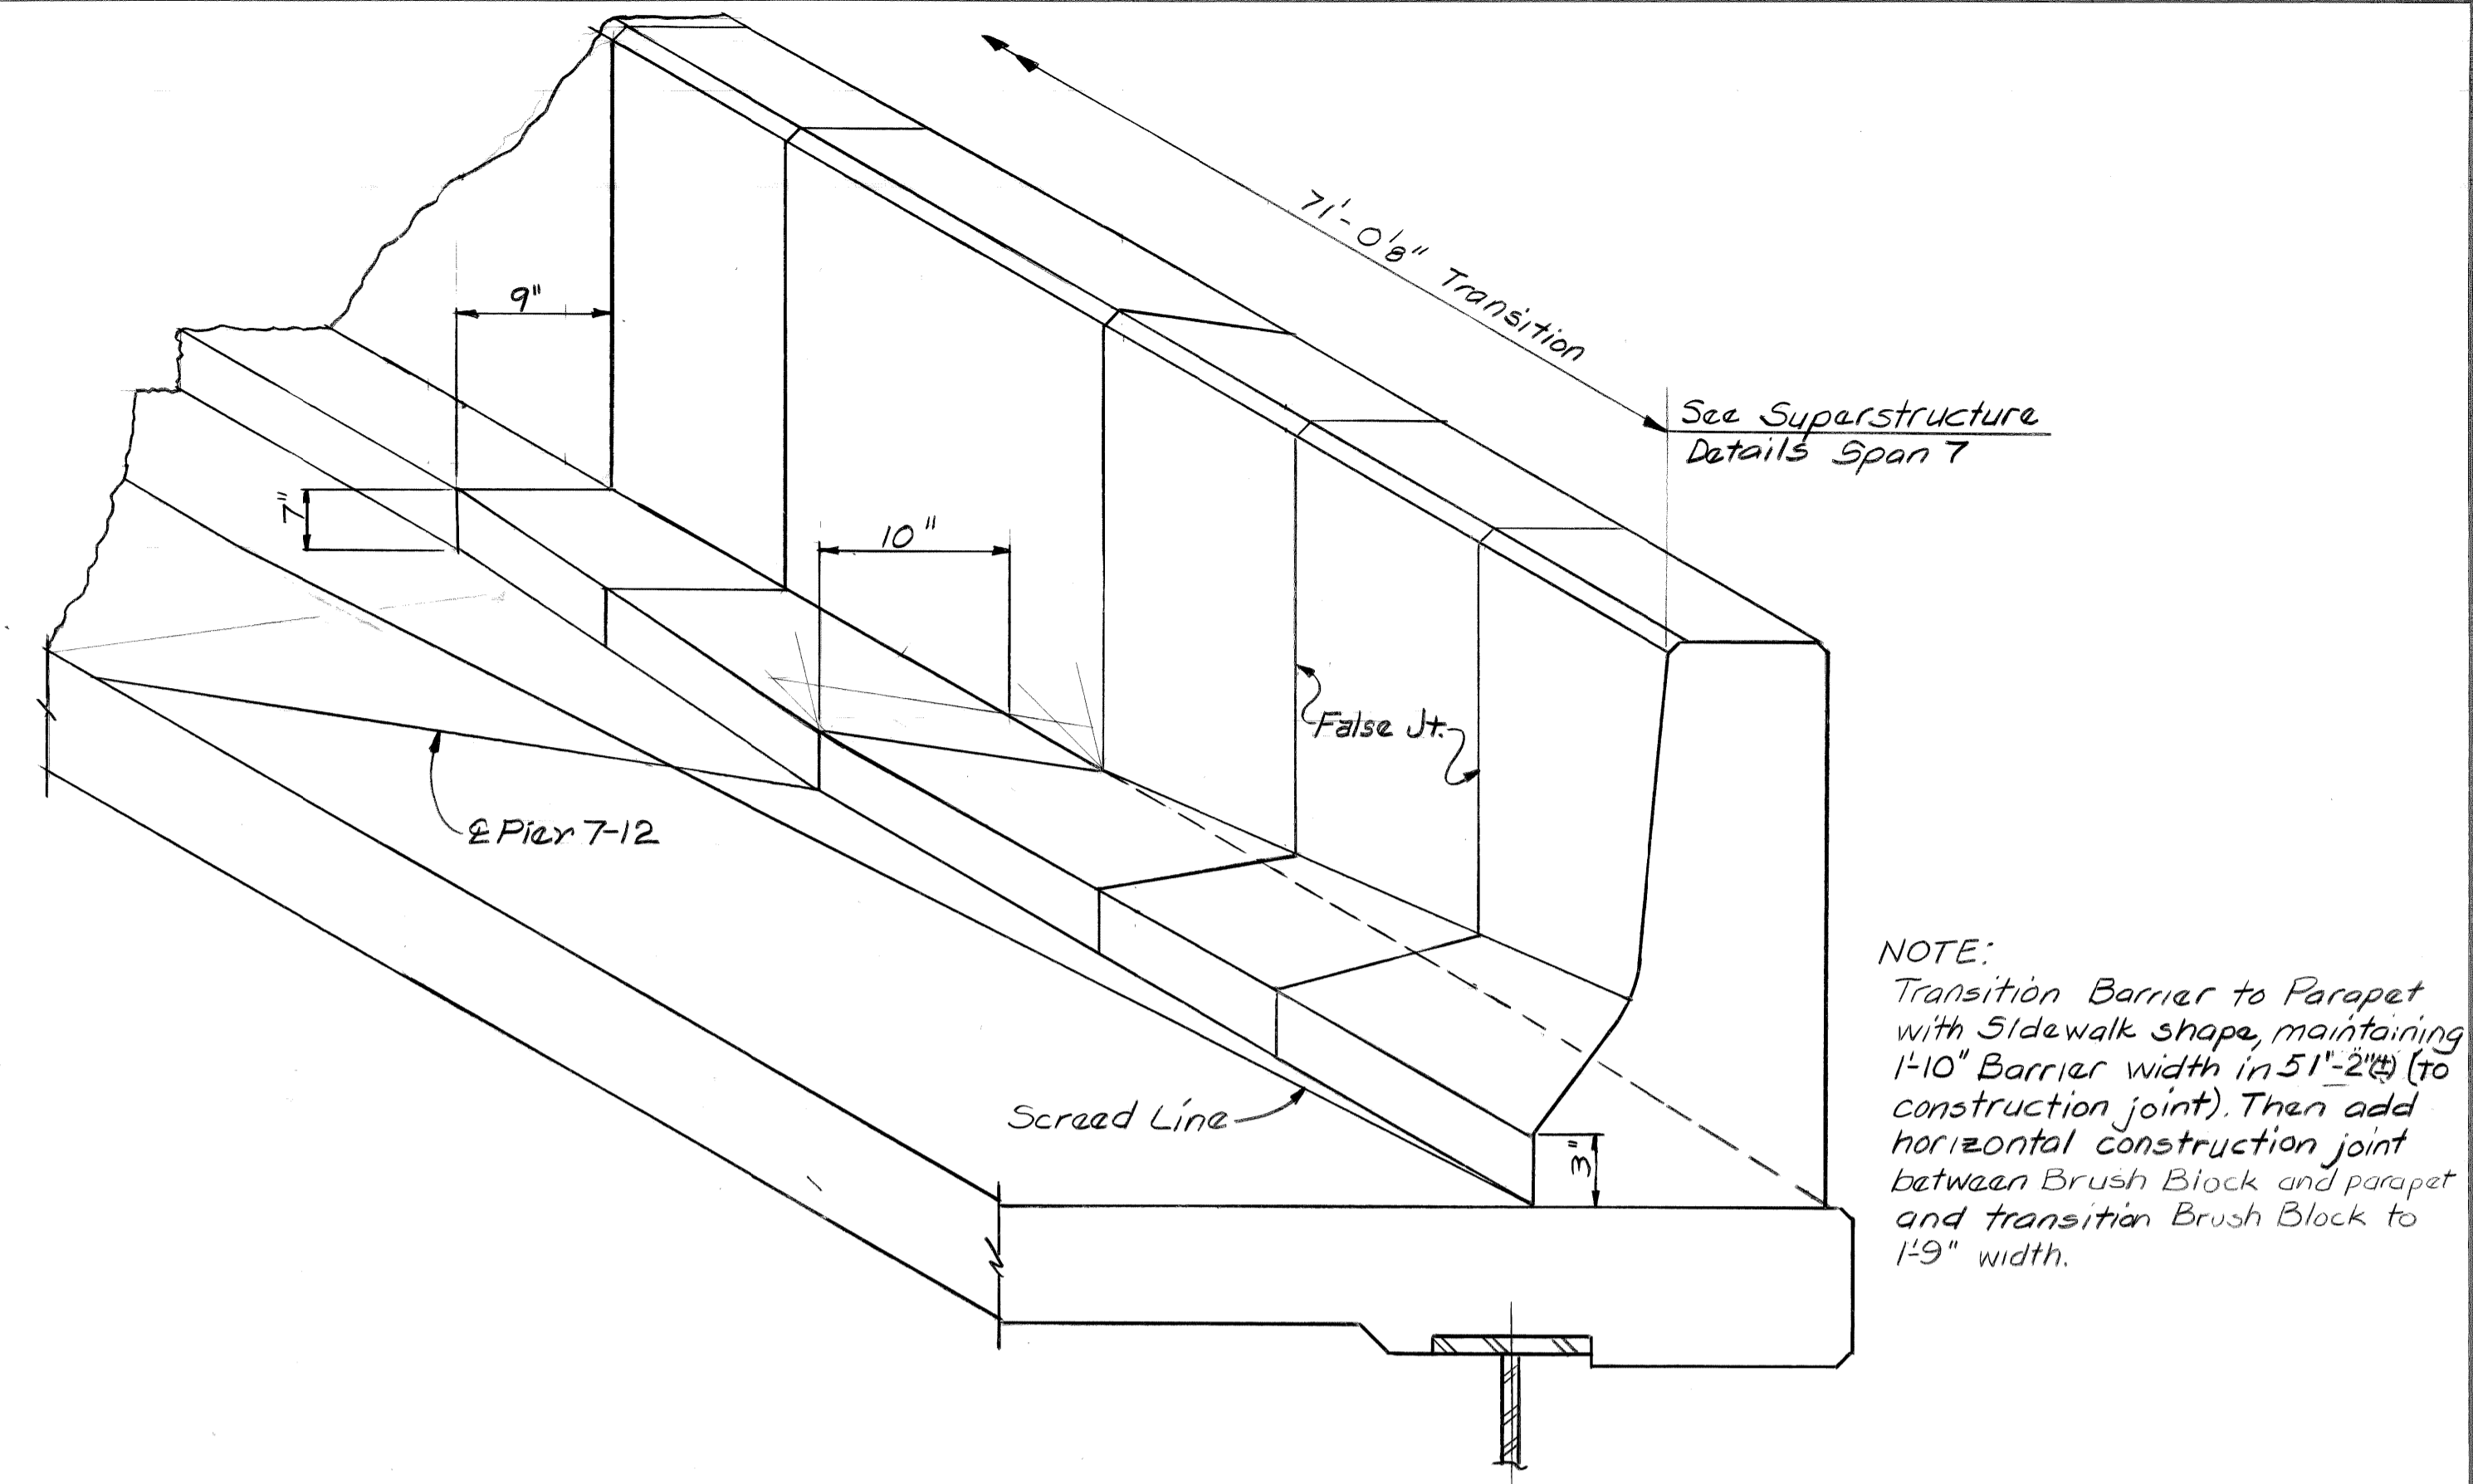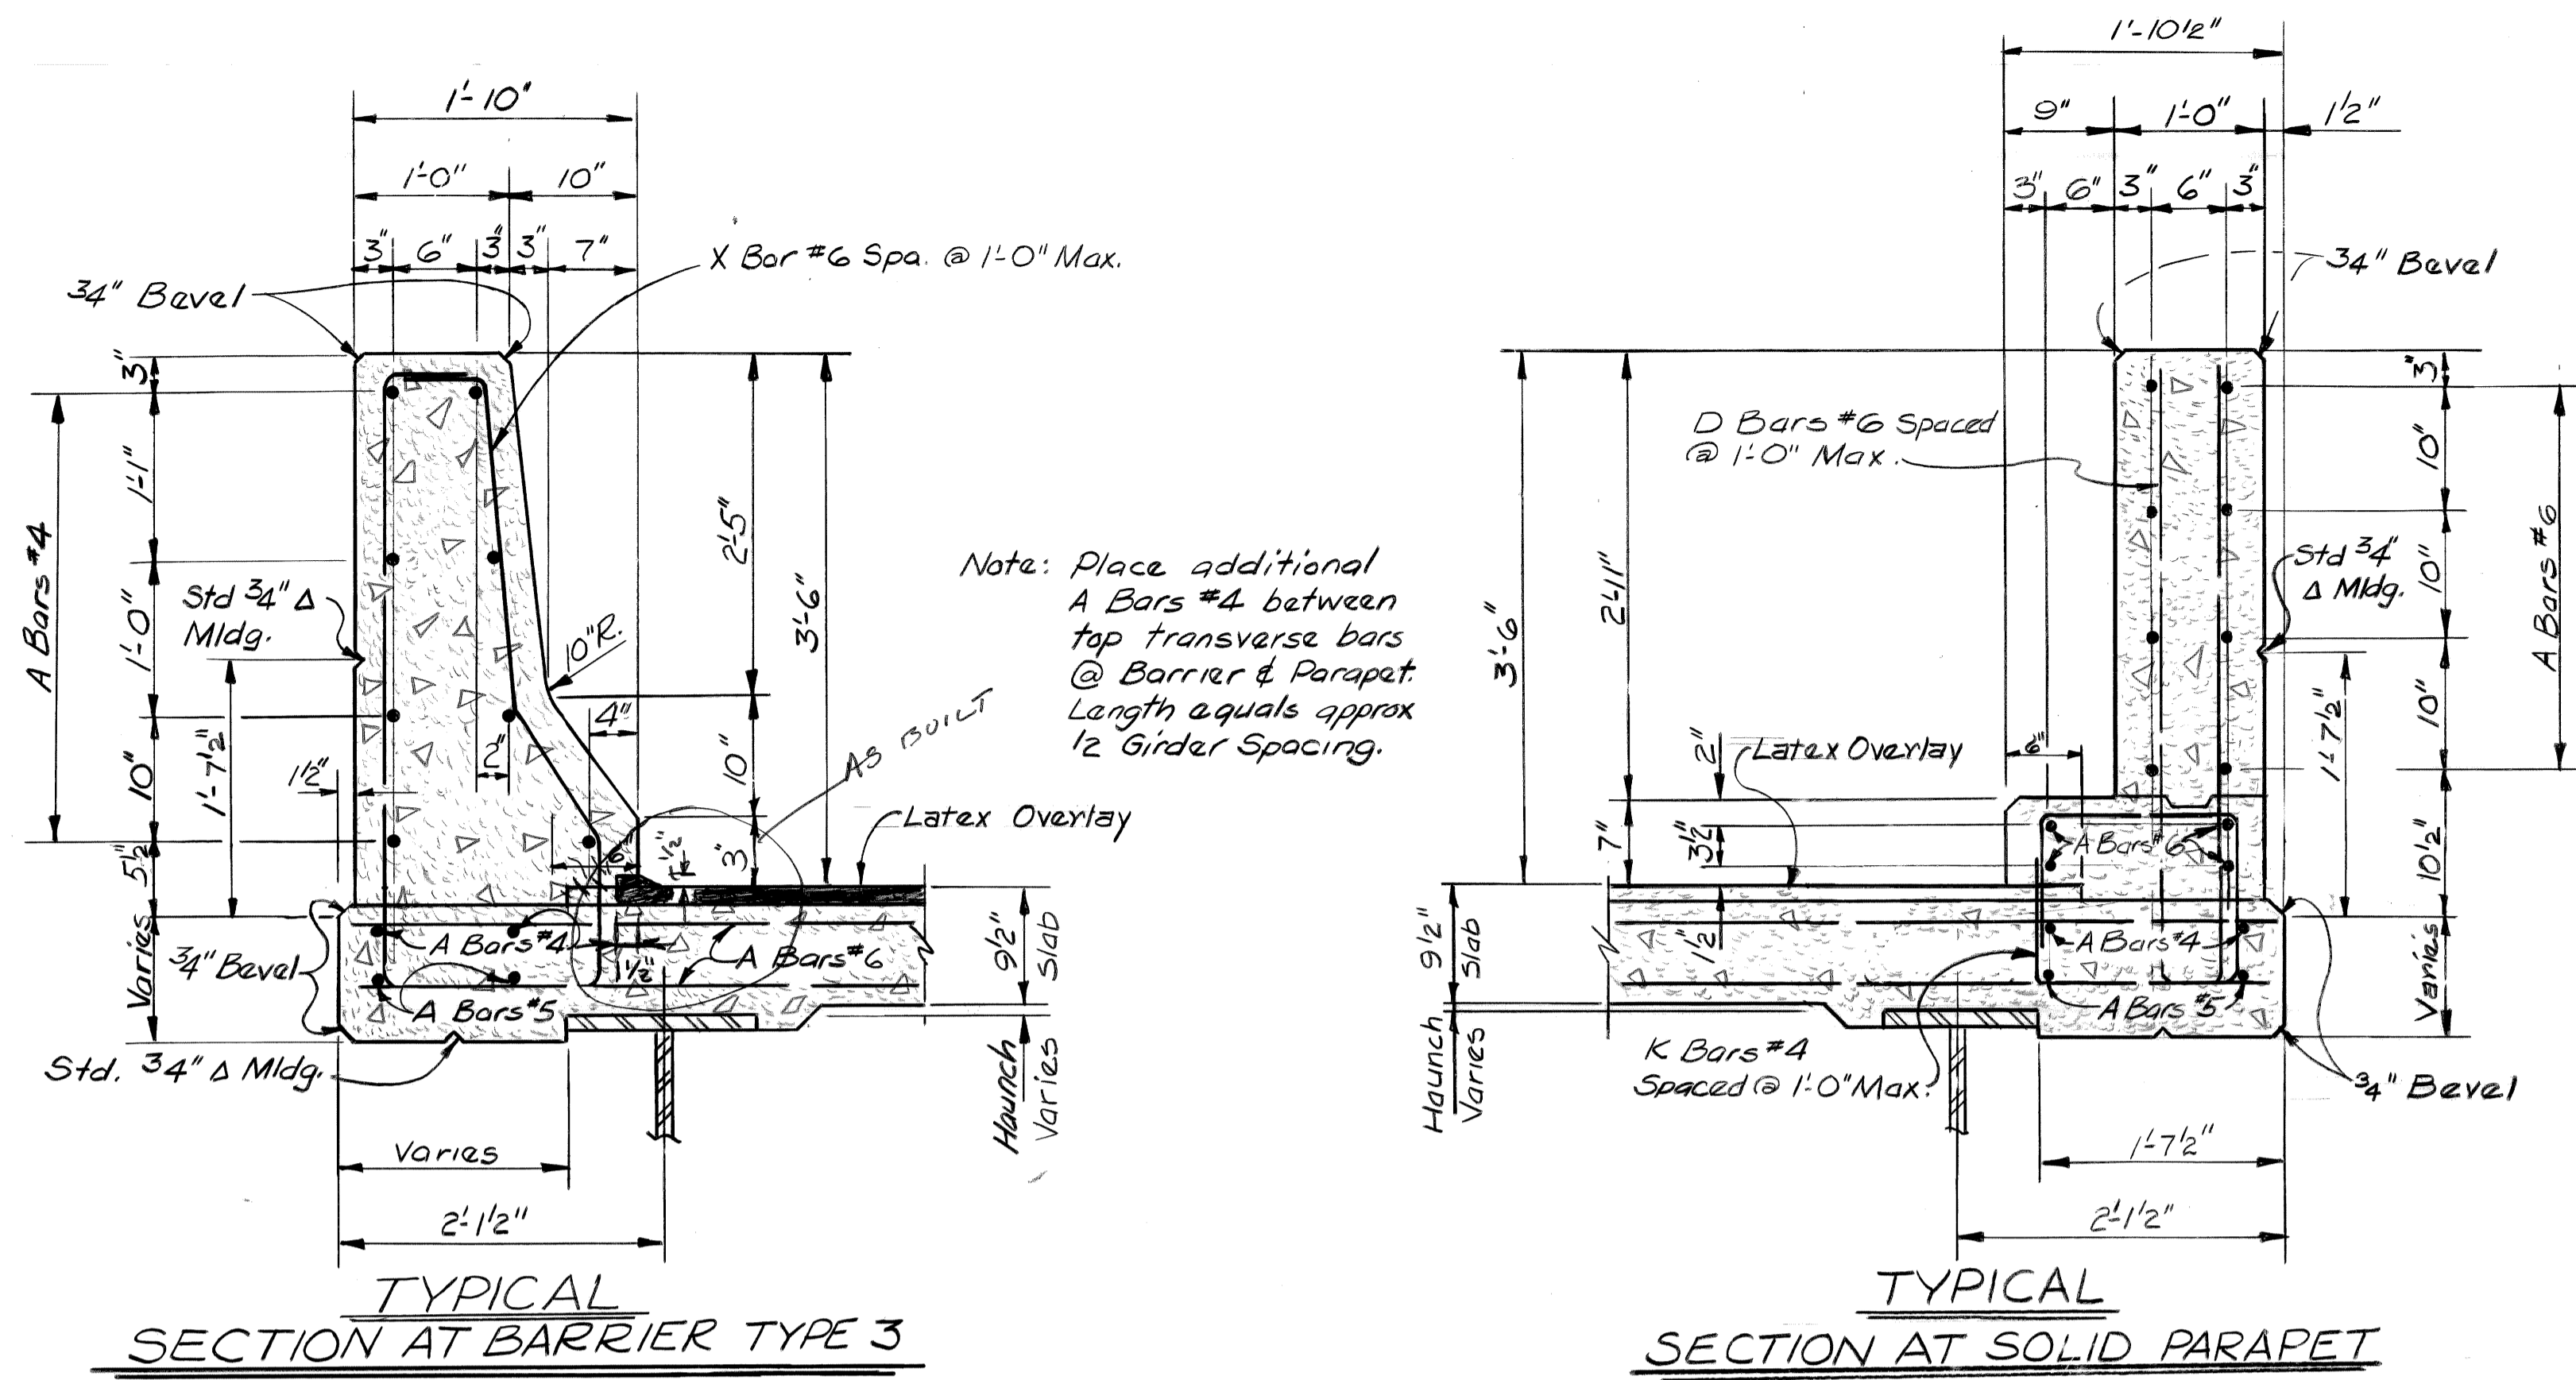

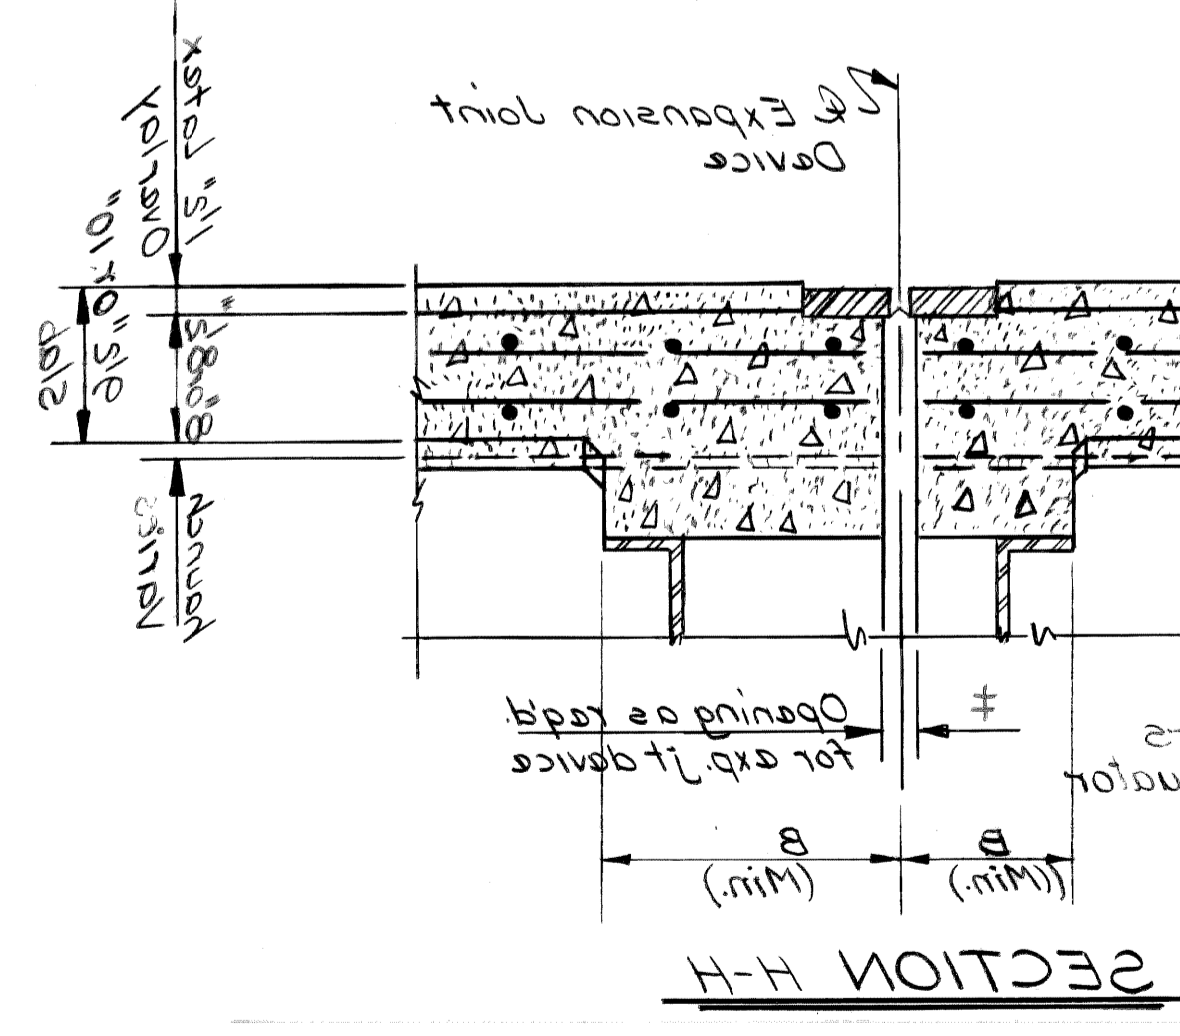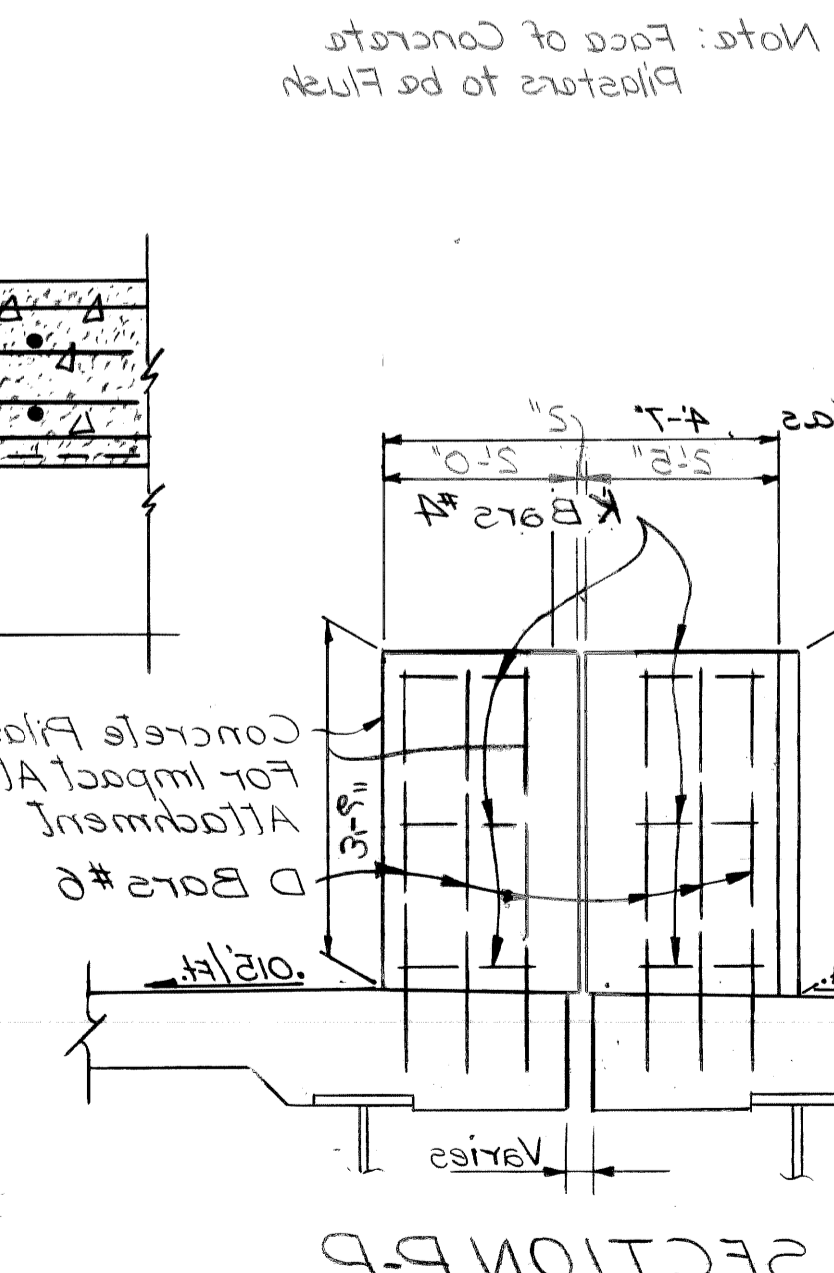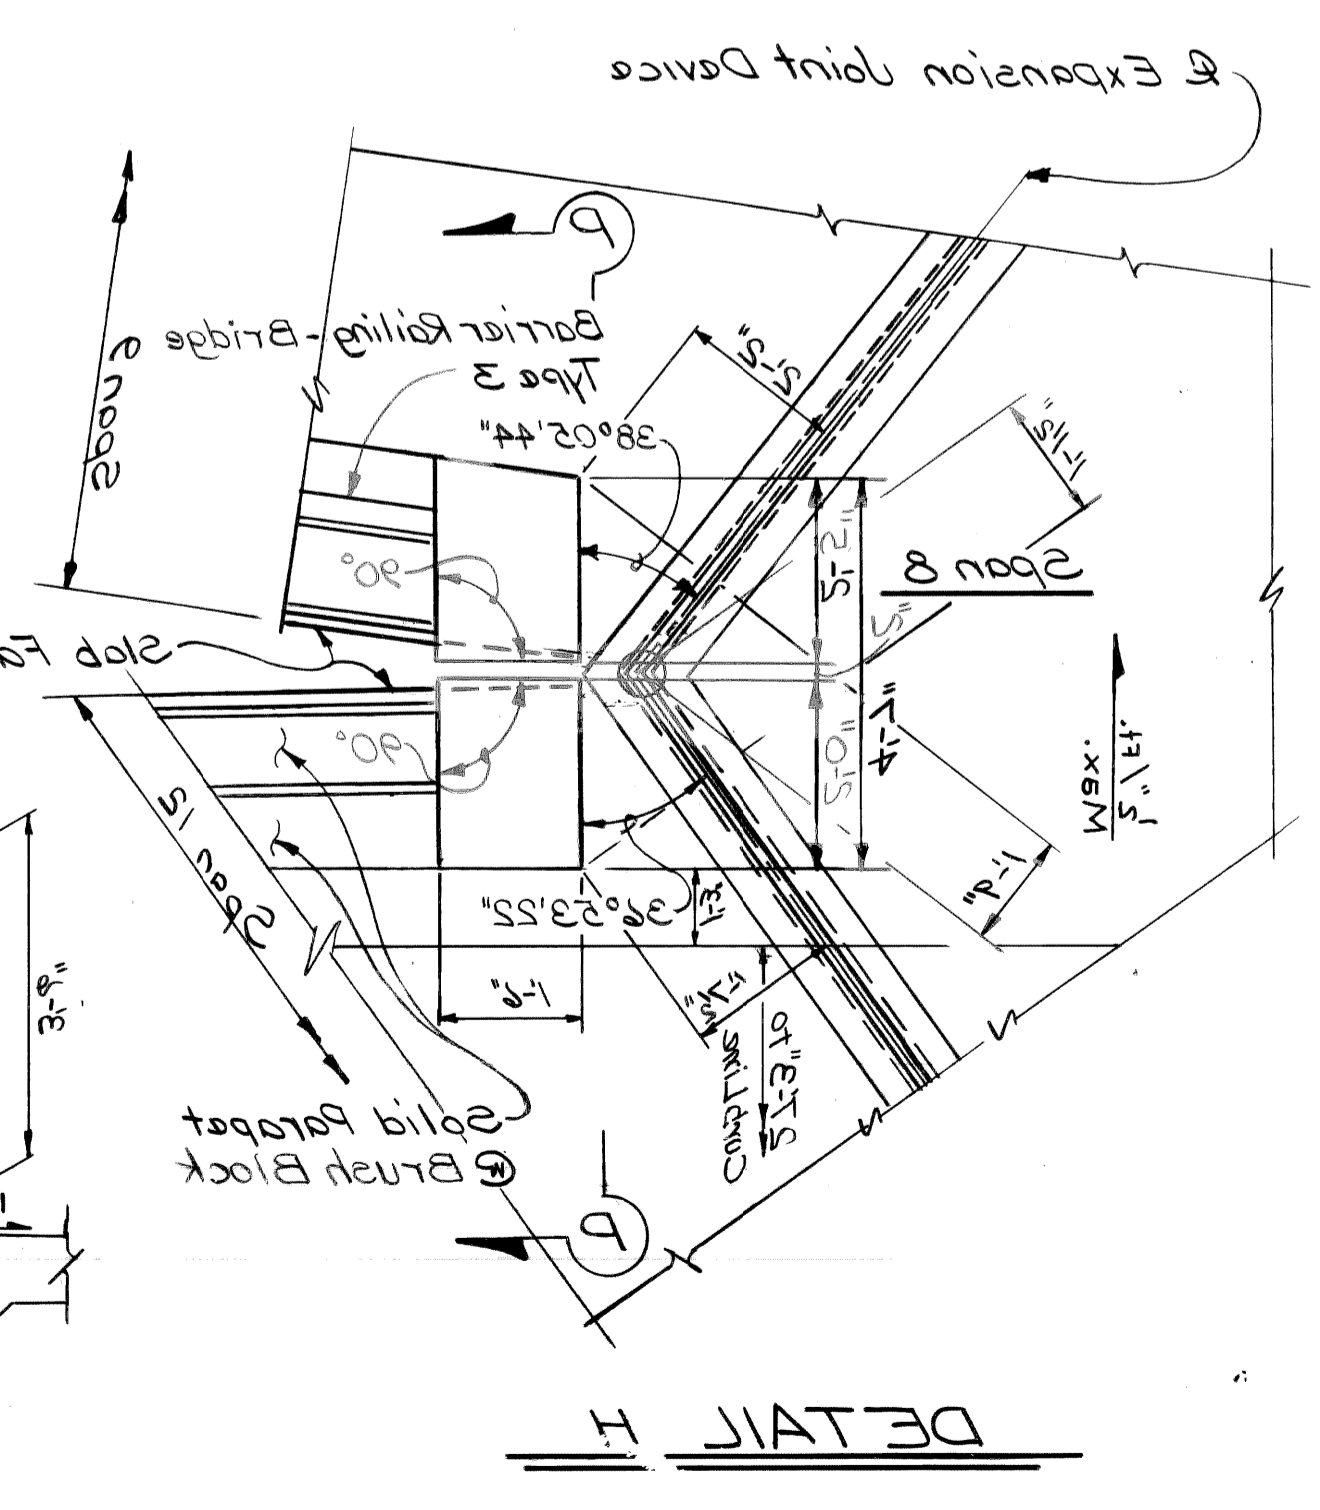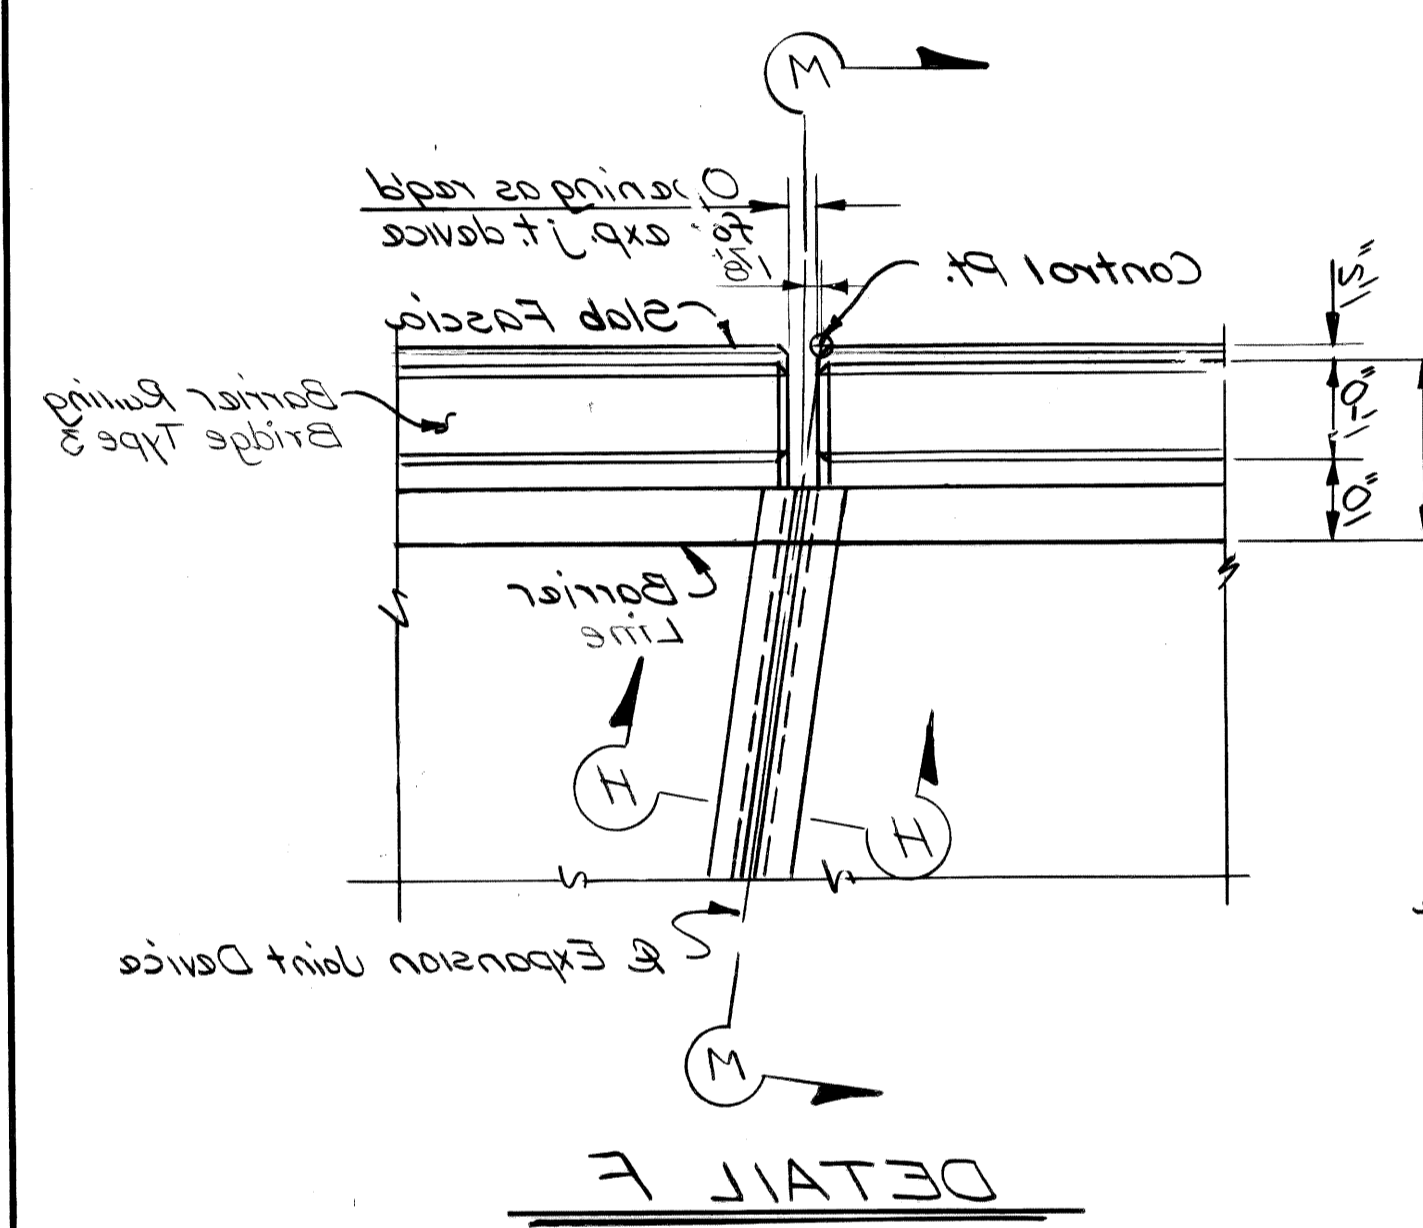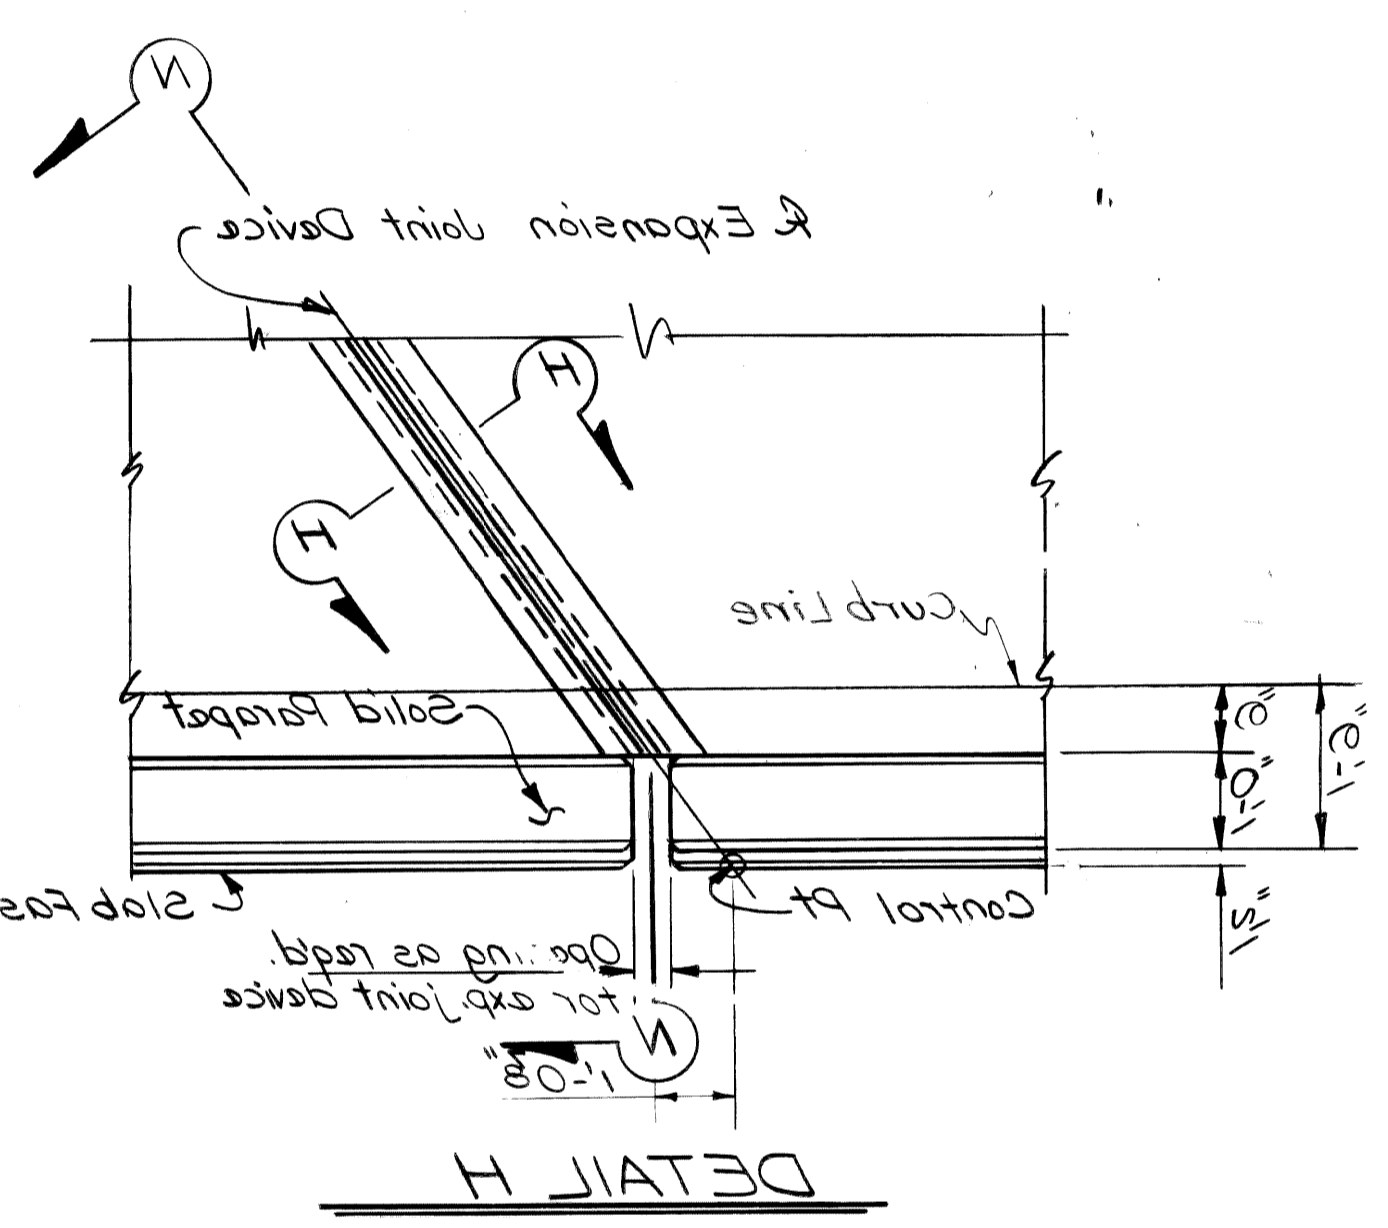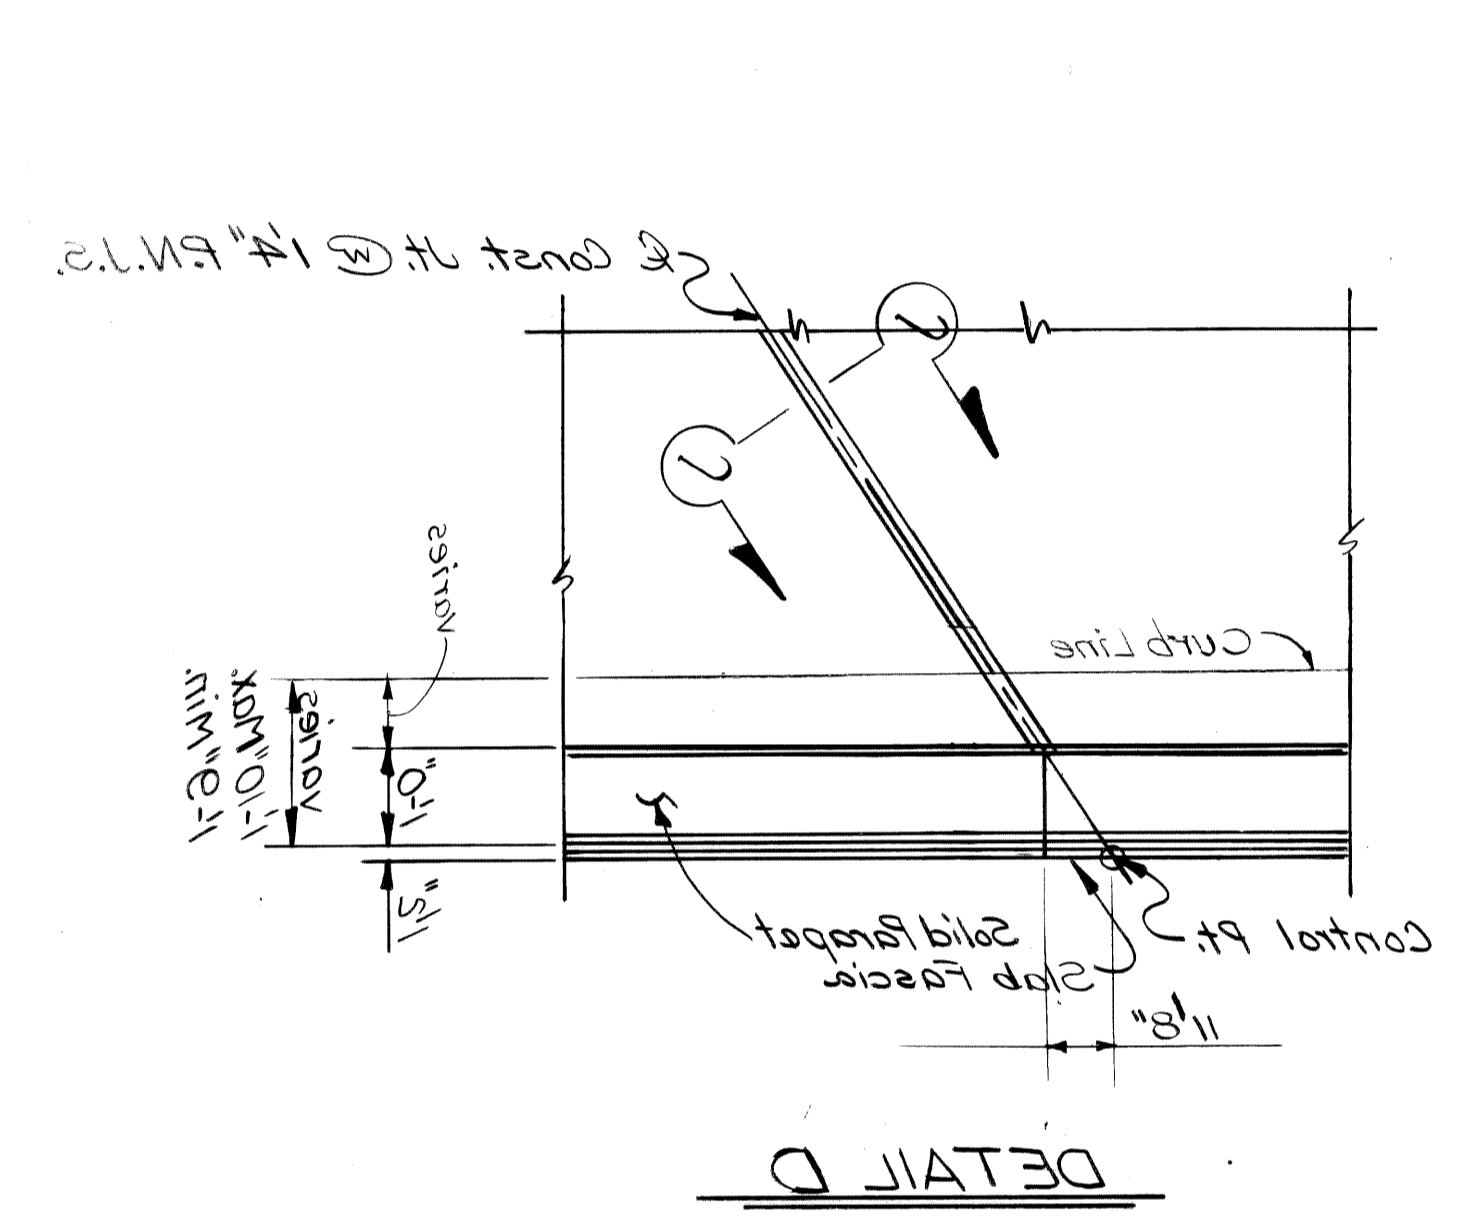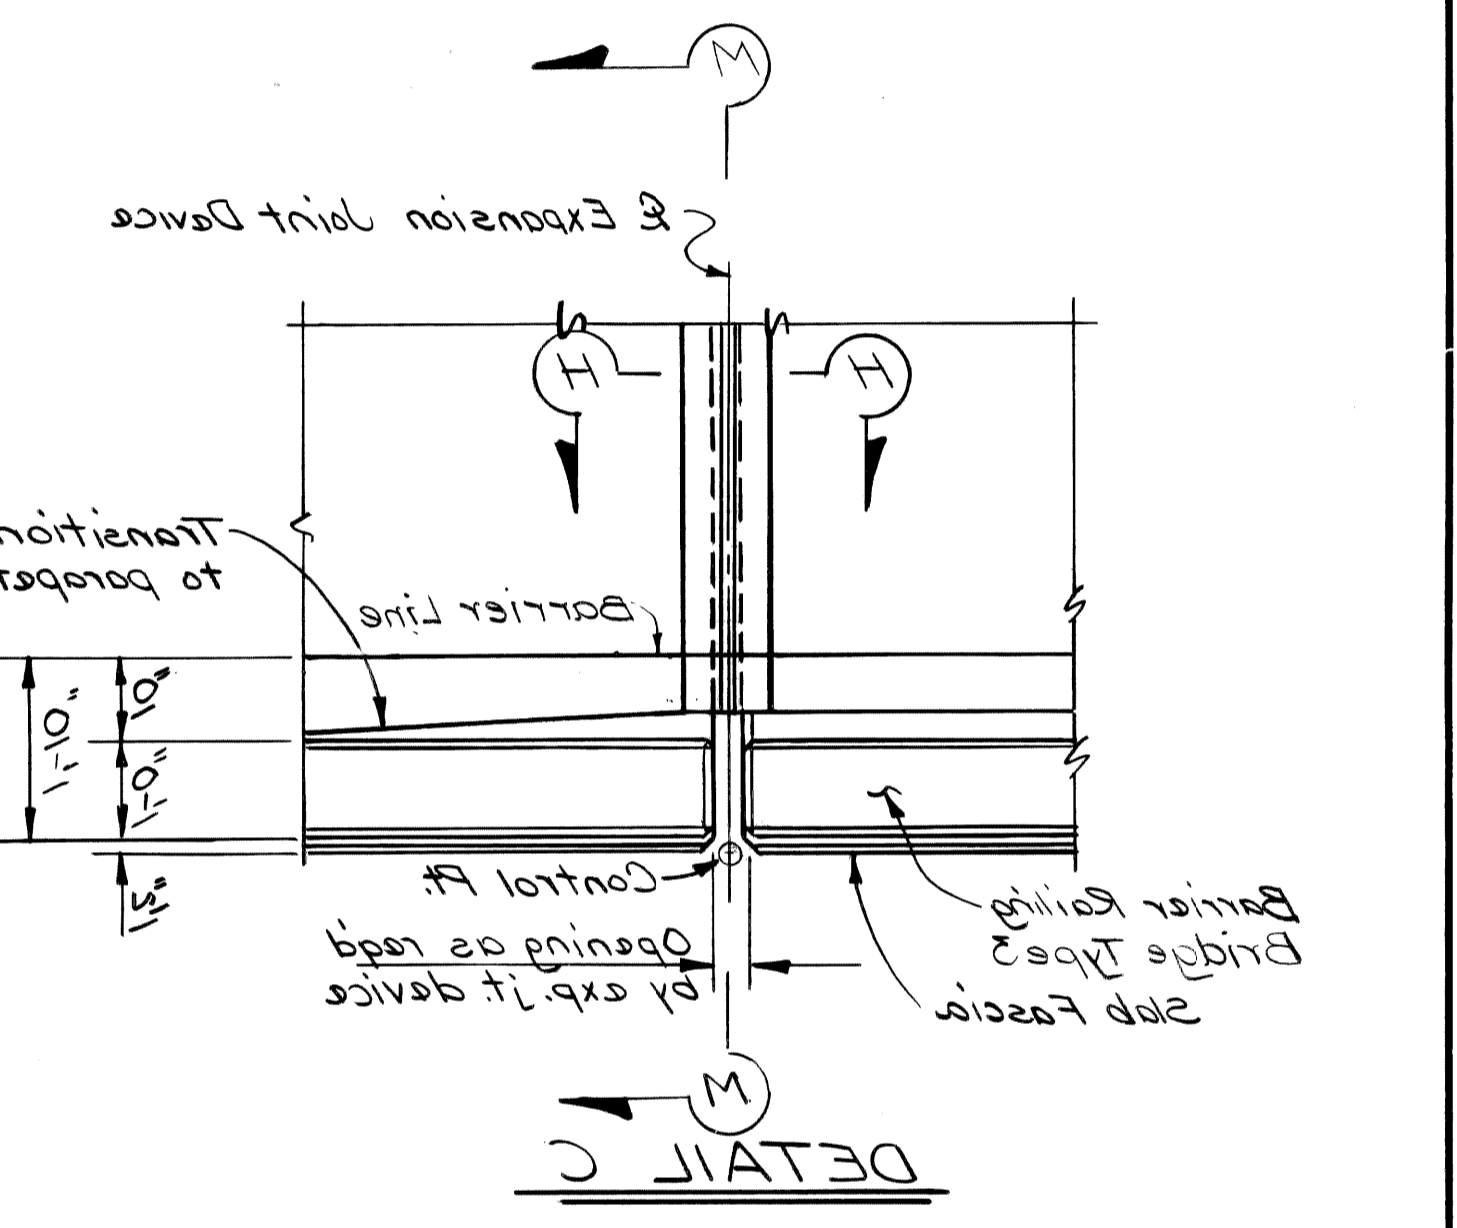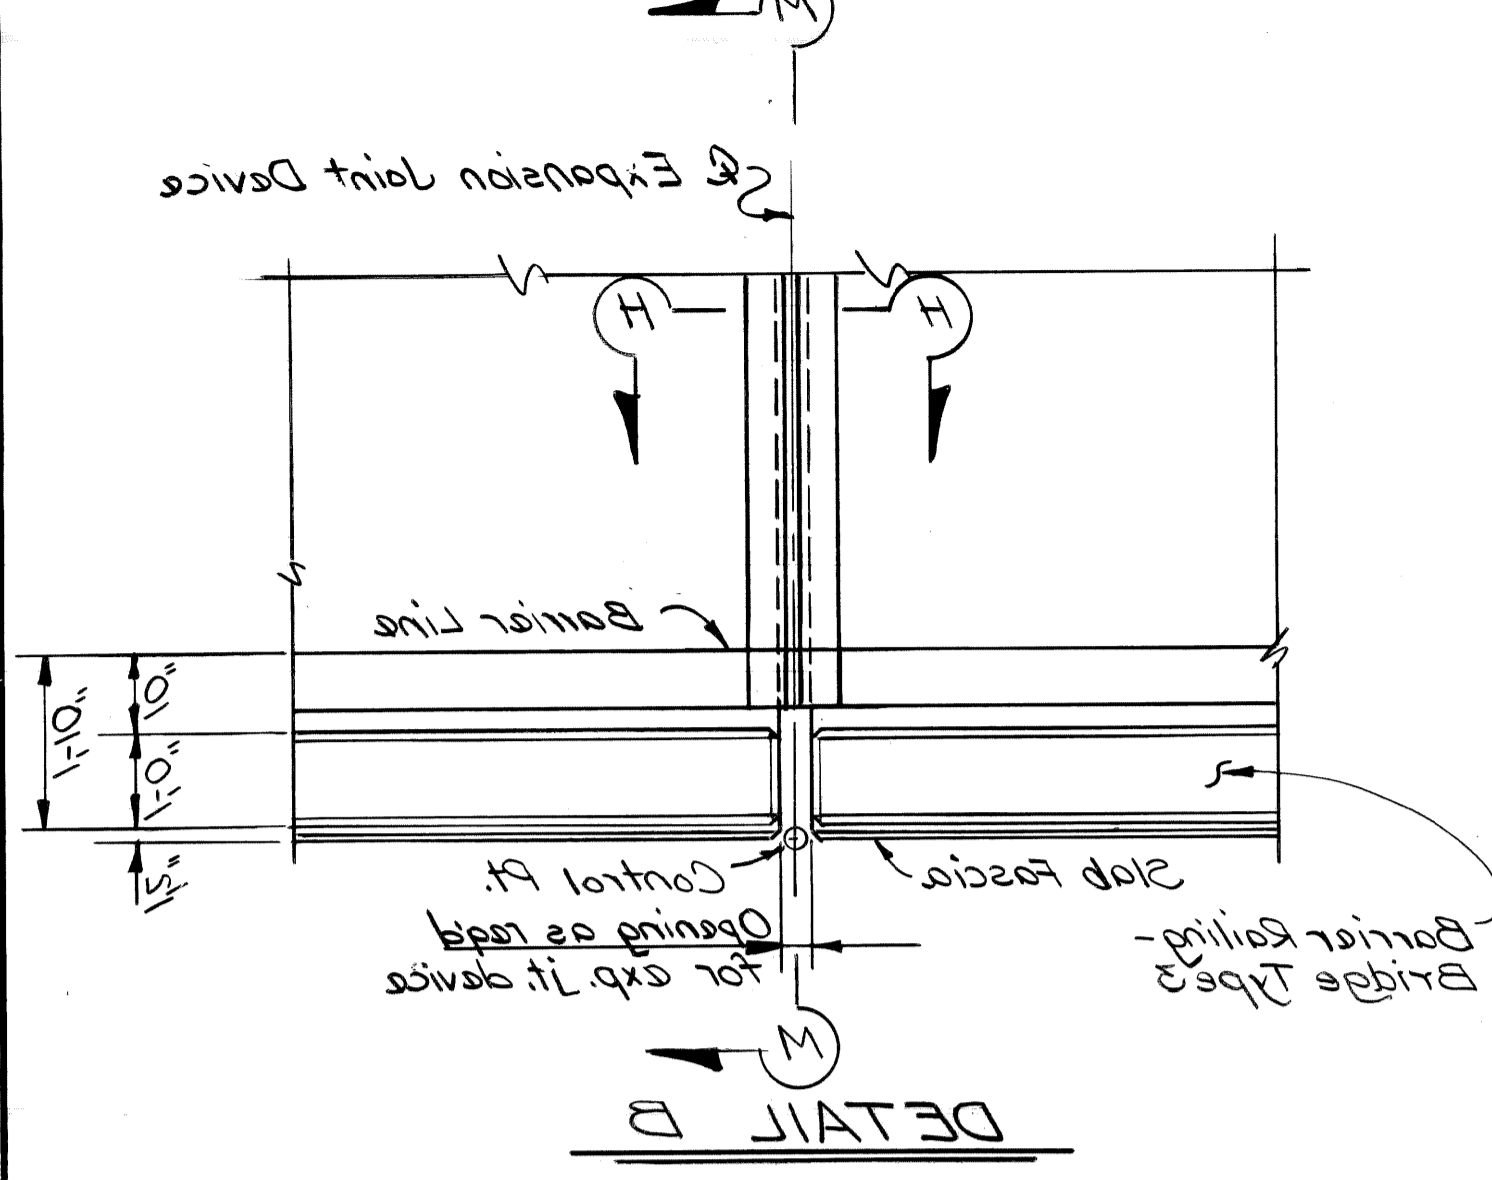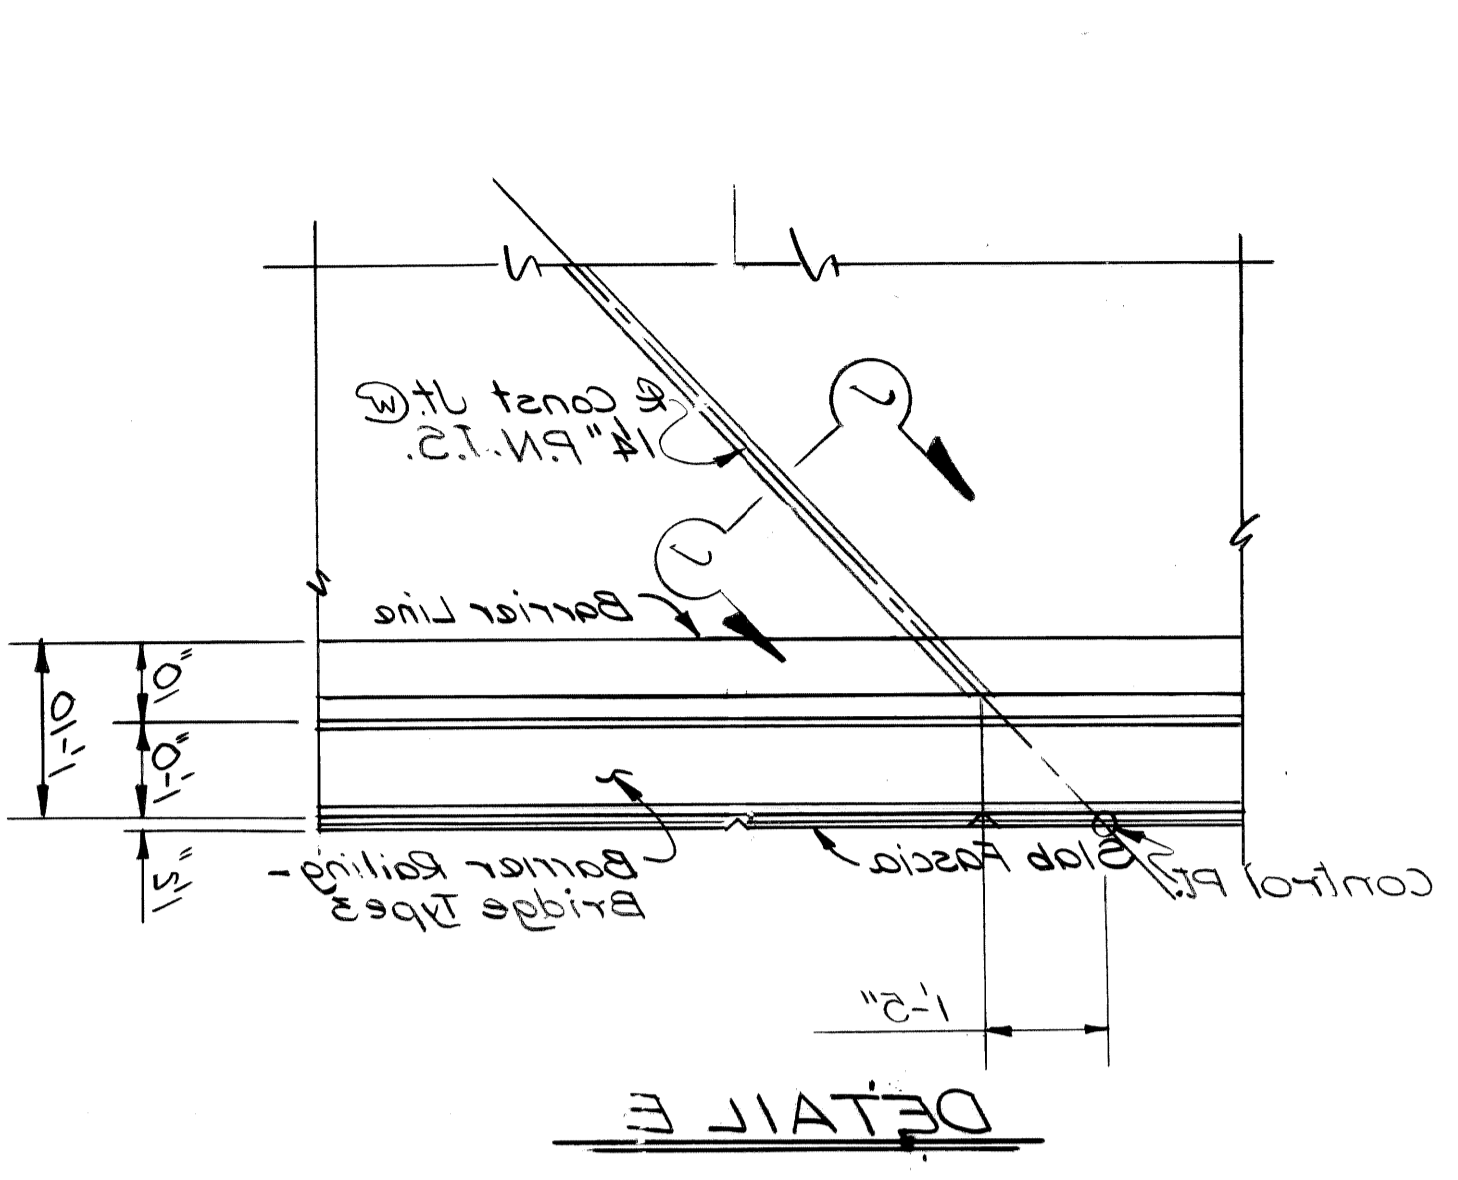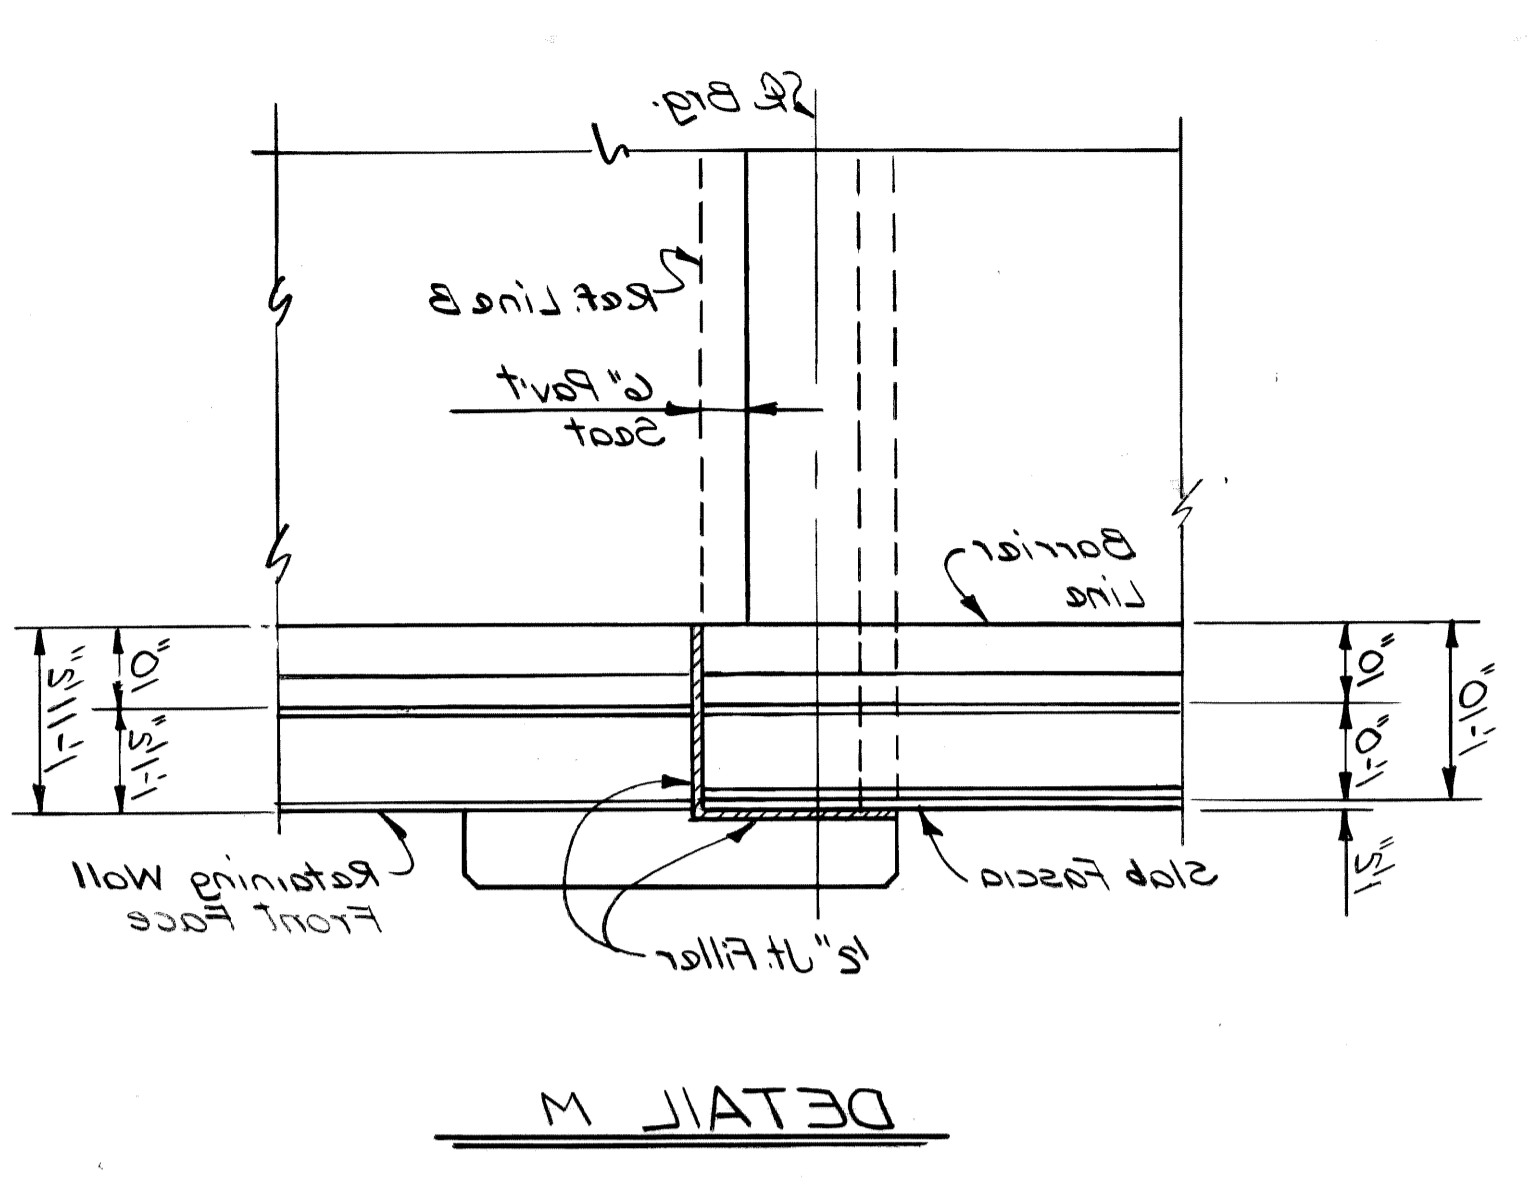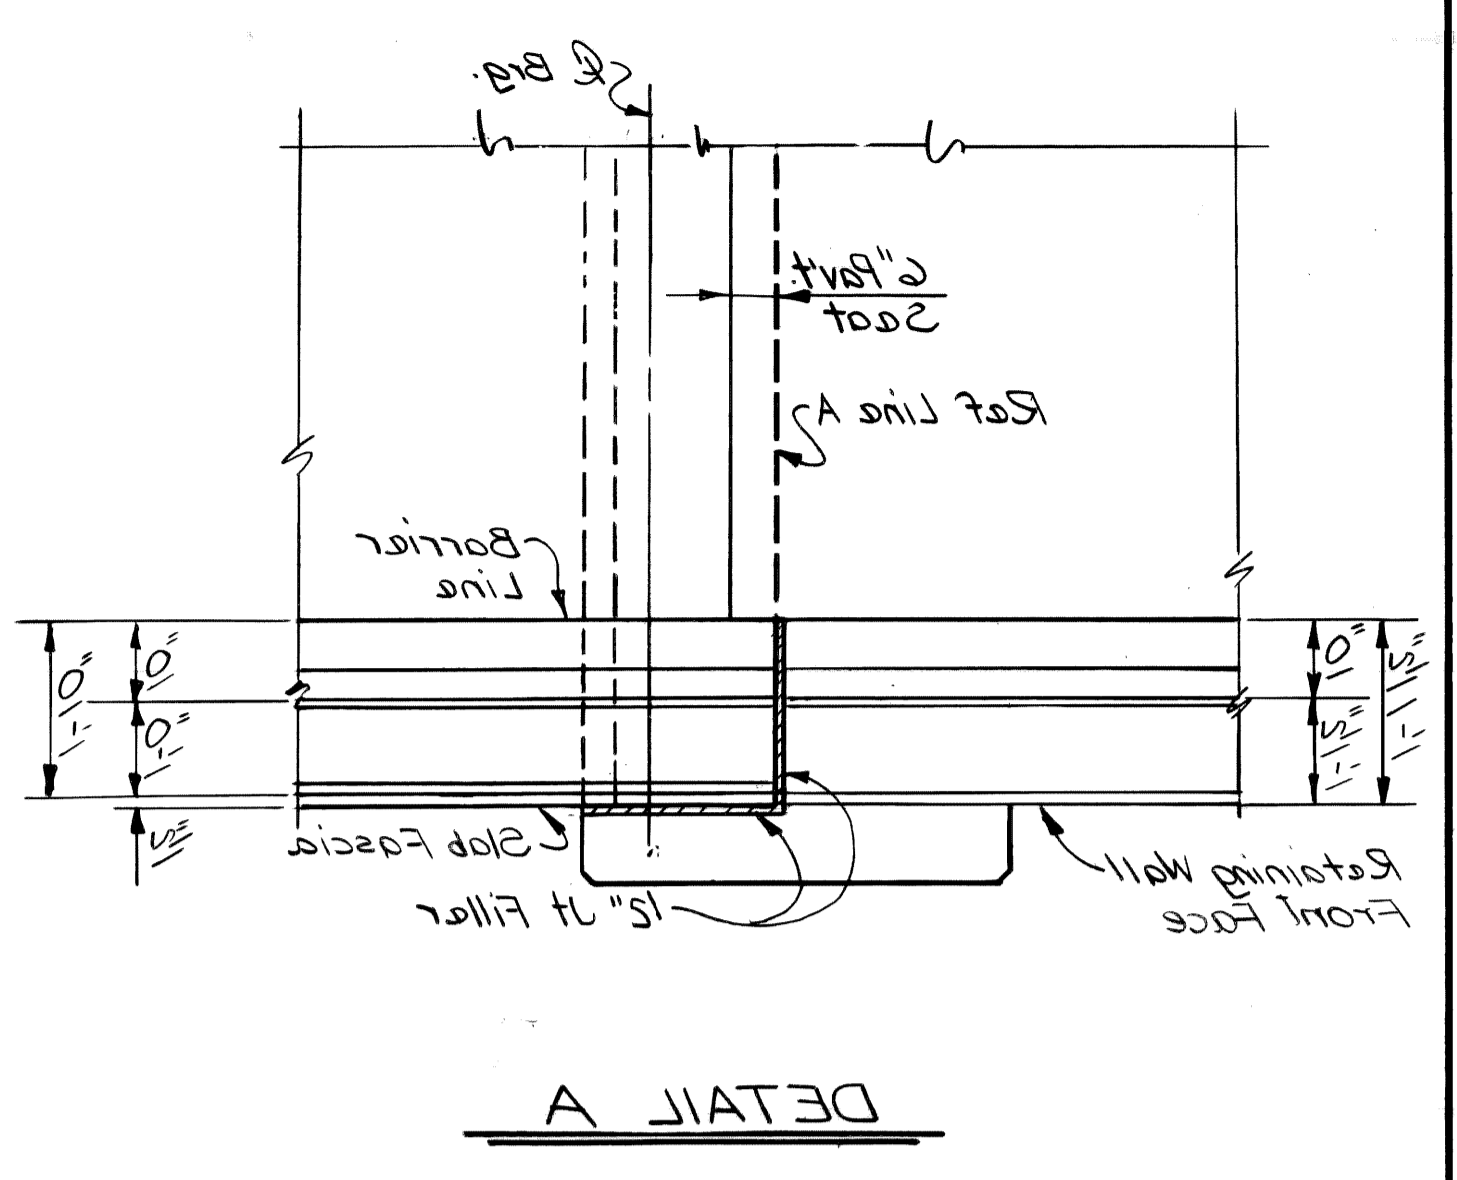


* Note: For dimensions see Structural Steel Details and Exp. Jt. Device Detail Sheet.

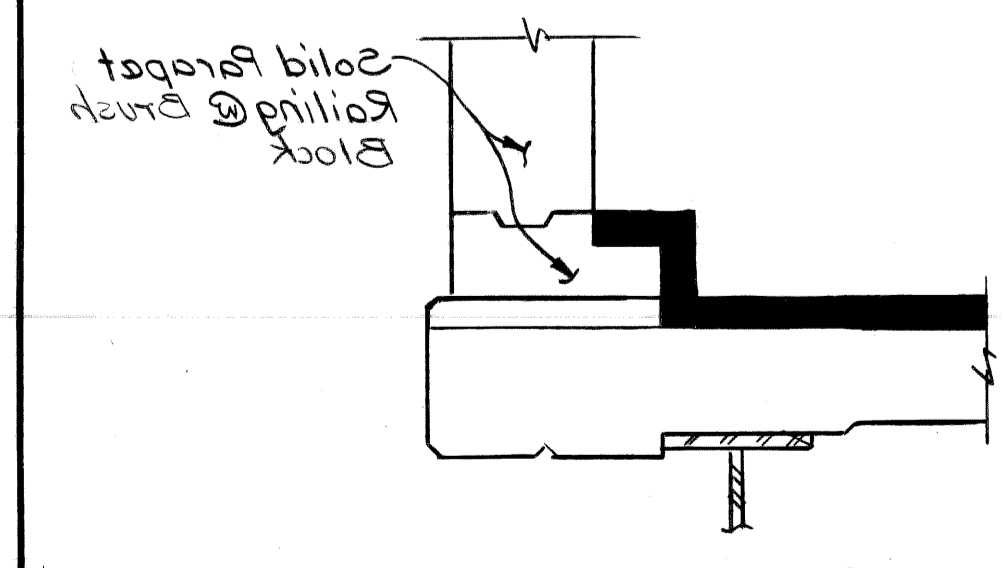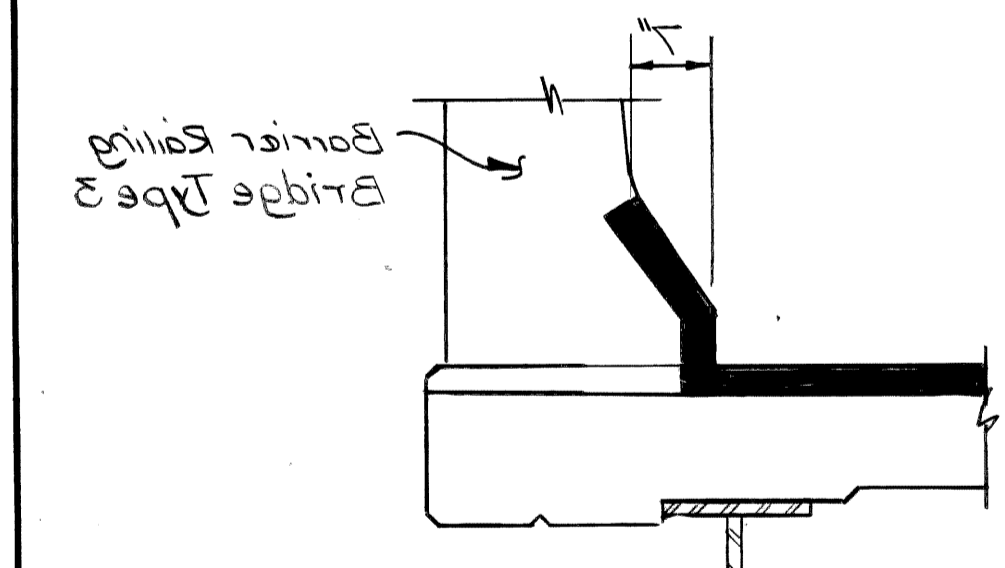


APR. BY:	DR. BY:	DESIGN BY:	DATE: August 1979	SHEET NO. 274 WORK THIS SHEET WITH SHEETS # 273 AND 275 SUPERSTRUCTURE DETAILS RECONSTRUCTION AT THE JOE LOUIS ARENA JOHN C. LODGE EXIT RAMP AND JEFFERSON AVENUE-	Shell Environmental Group LANSING INDIANAPOLIS AKRON	CITY OF DETROIT, MICHIGAN	
REV. BY:	REV. BY:	REV. BY:	SCALE: NONE			DRN. NO: 272	

SUPERSTRUCTURE LATEX-MODIFIED SURFACING MIXTURE QUANTITIES									
Location	Span 1	Span 2	Span 3 & 4	Span 5 & 6	Span 7	Span 8	Span 9, 10 & 11	Span 12	Total
Cubic Yards	8.8	16.1	33.5	32.2	14.2	10.2	21.2	34.8	147

The actual quantity of Latex Modified Surfacing Mixture concrete placed on the deck was _____ cubic yards. This information is to be filled in by the Engineer when submitting as Constructed Plans.

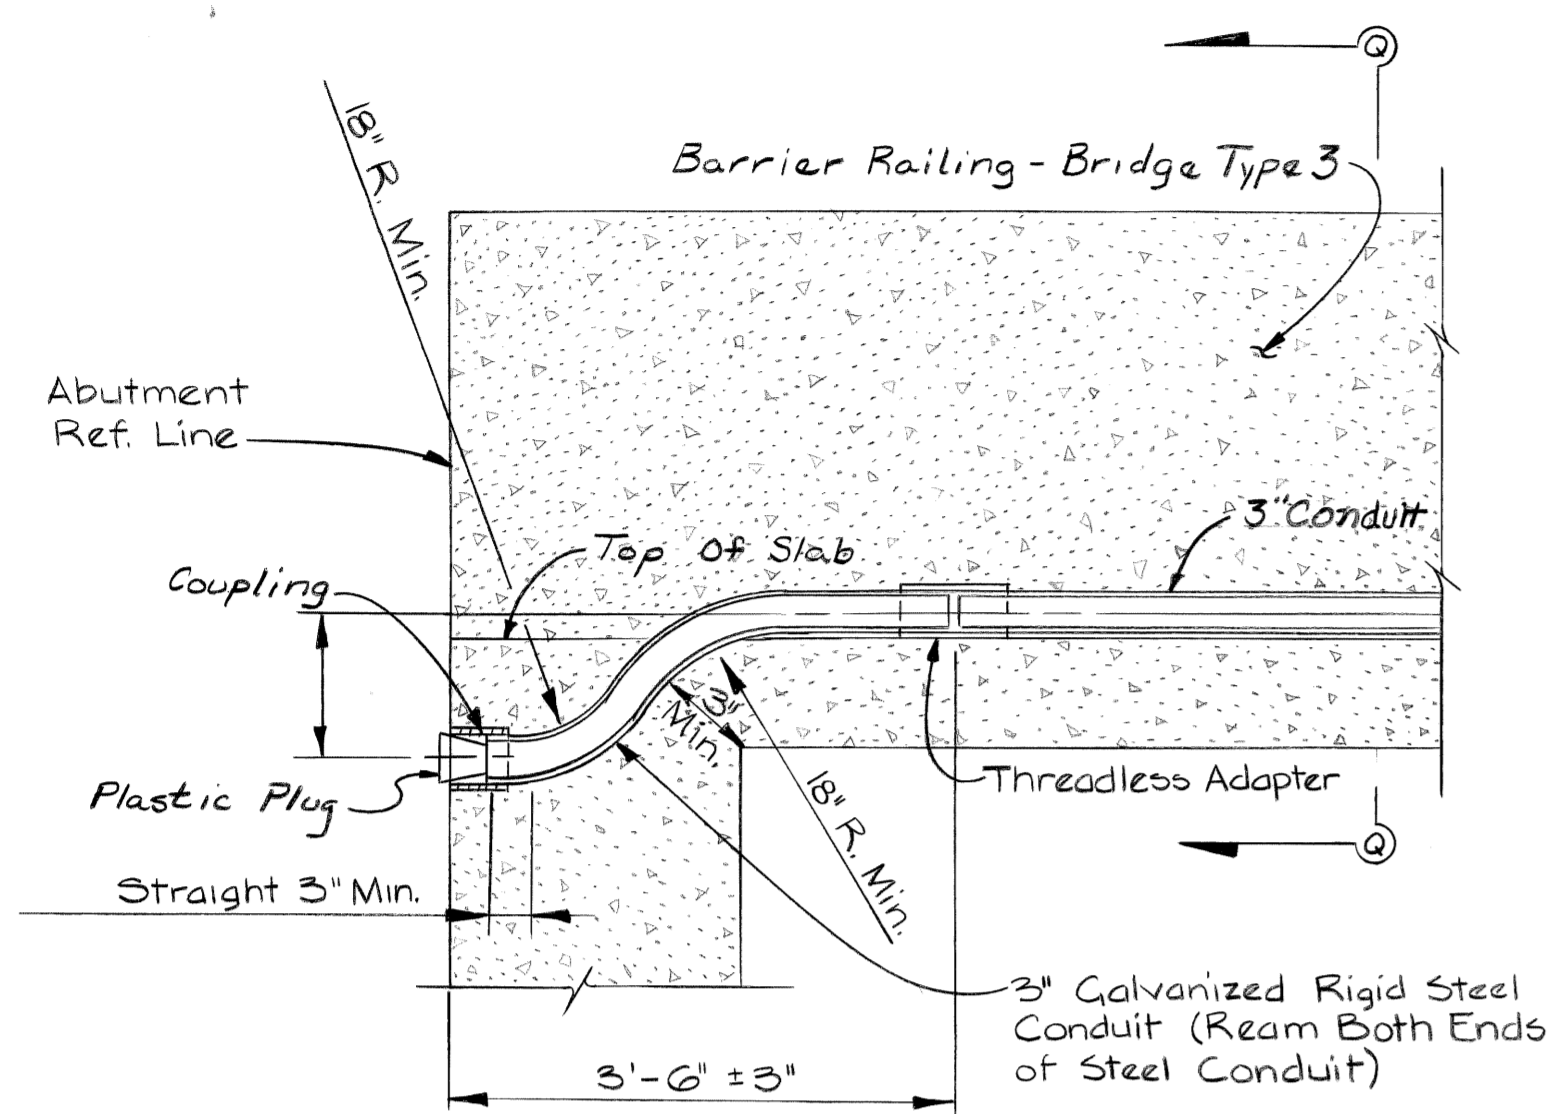


SECTION @ BACKWALL

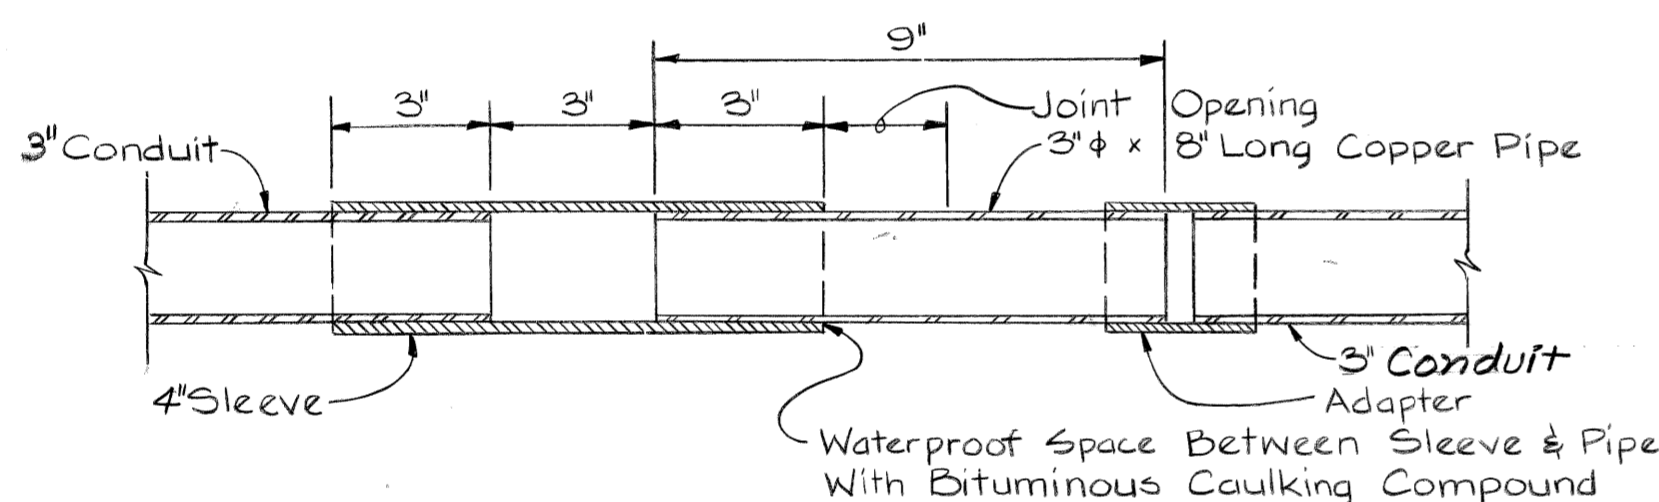


EXPANSION JOINT DETAIL

NOTE: For Details of Barrier Railing Light Standard, see M.D.O.T. Std. R17.

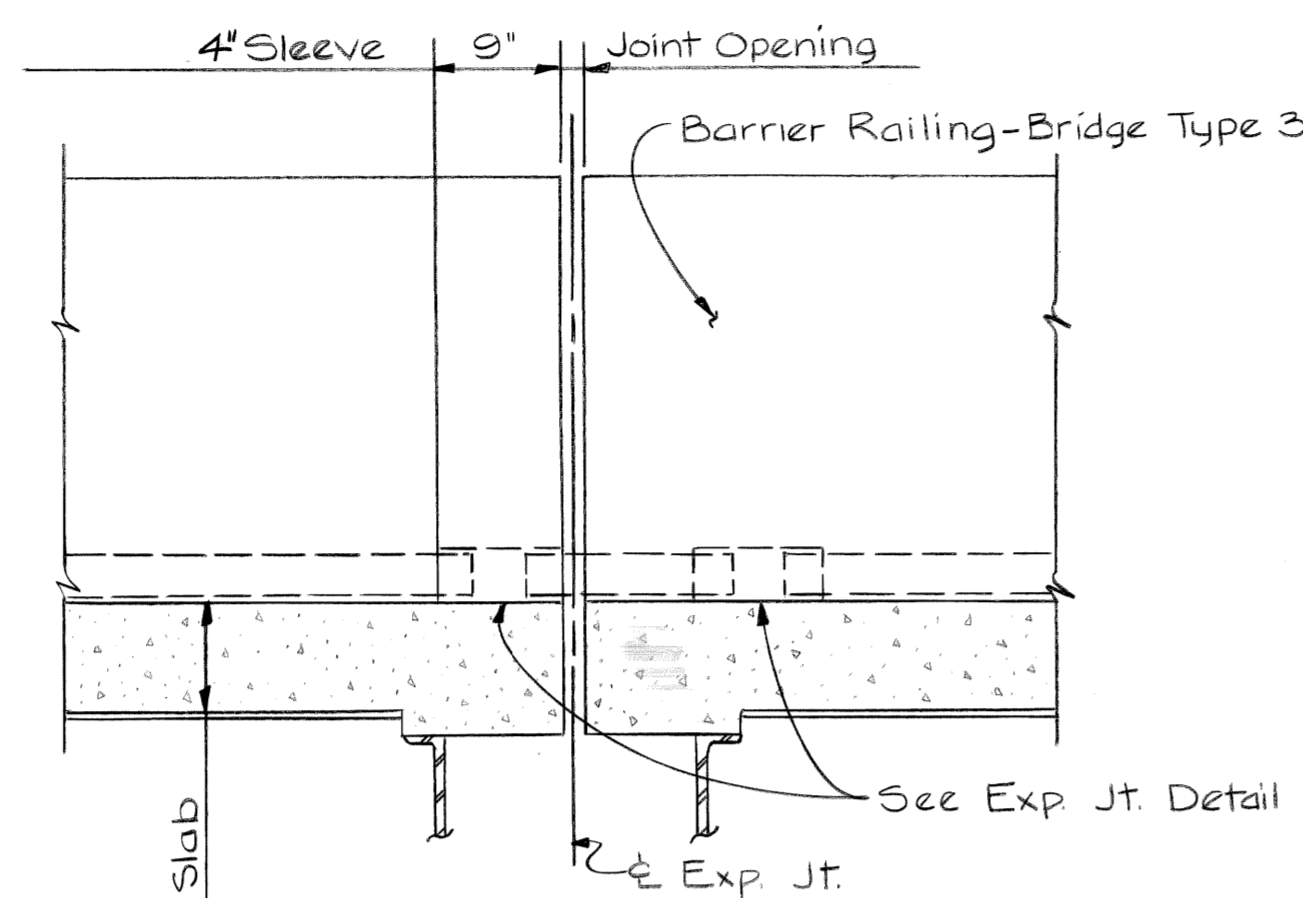


SECTION @ TRANSVERSE EXP. JT.

Sleeves, Copper Pipe, Adapters, Couplings, Galvanized Steel Conduit, Bushings, Plugs And Waterproofing Are Incidental to 3" Conduit.

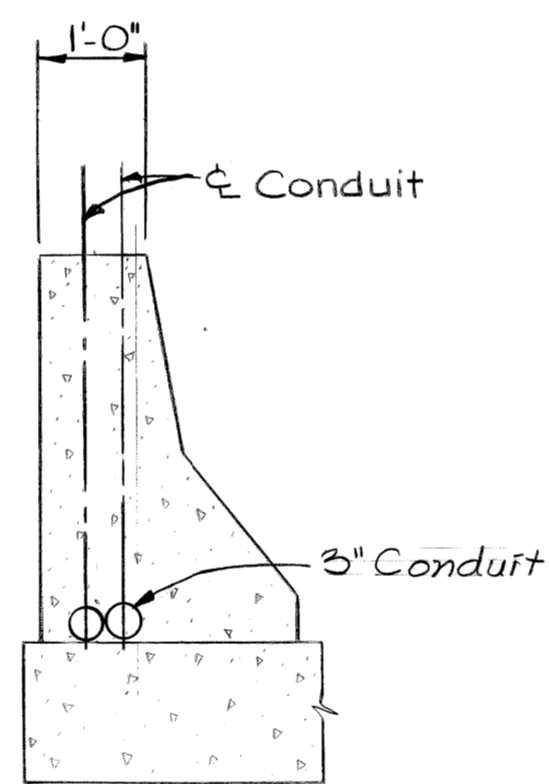

SECTION Q-Q

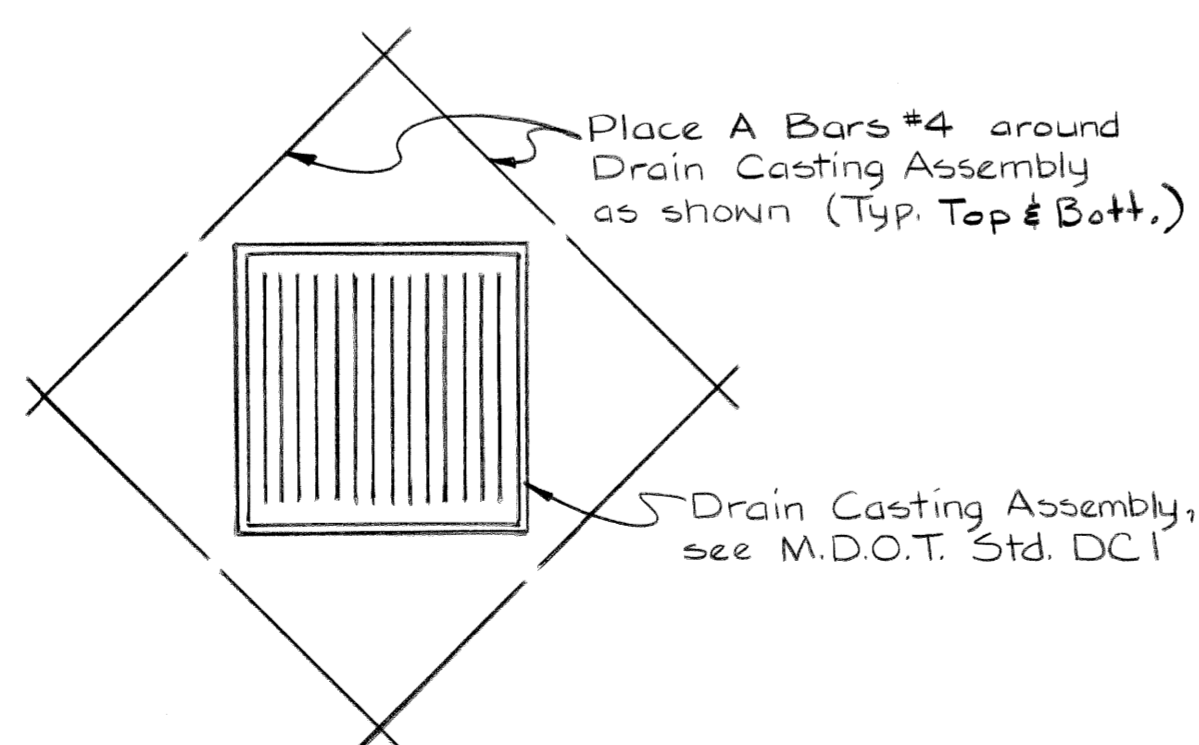


TYPICAL DETAIL "K"

SUPERSTRUCTURE CONCRETE QUANTITIES									
Location	Pour	Span 1	Span 2	Spans 3 & 4	Spans 5 & 6	Span 7	Span 8	Spans 9, 10 & 11	Span 12
A		62.5	99.7	70.5	75.7	84.2	59.3	31.3	65.9
B				85.2	74.4			42.7	
C				53.2	50.8			23.3	
D		N/A		N/A	N/A	N/A	N/A	20.9	N/A
E								23.3	
Sub-Totals		162.2	208.9	200.9	200.9	84.2	59.3	141.5	65.9
Grand Total									923 Cu.Yds.

N/A Denotes Not Applicable


MISCELLANEOUS QUANTITIES		
item	unit	amount
Forming, Finishing, & Curing of Superstructure Concrete	Lump Sum	Lump Sum
Joint Waterproofing	Sq. Ft.	227
Constructing Bridge Deck Surface	Sq. Yds.	3516
Barrier Railing - Bridge Type 3	Lin. Ft.	1495
Bridge Railing, Solid Parapet Type-Special	Lin. Ft.	179
Drain Casting Assembly-Type 3	Each	5
1/4" Preformed Neoprene Joint Sealer	Lin. Ft.	60
3" Conduit	Lin. Ft.	1725
Light Standard Anchor Assembly - Placed	Each	13
3" Galvanized Iron Pipe	Lin. Ft.	74
Low Temperature Protection - Superstructure	Cu. Yds.	1970
Superstructure Steel Reinforcement	Lbs.	162,000
Superstructure Epoxy Coated Steel Reinforcement	Lbs.	89,000

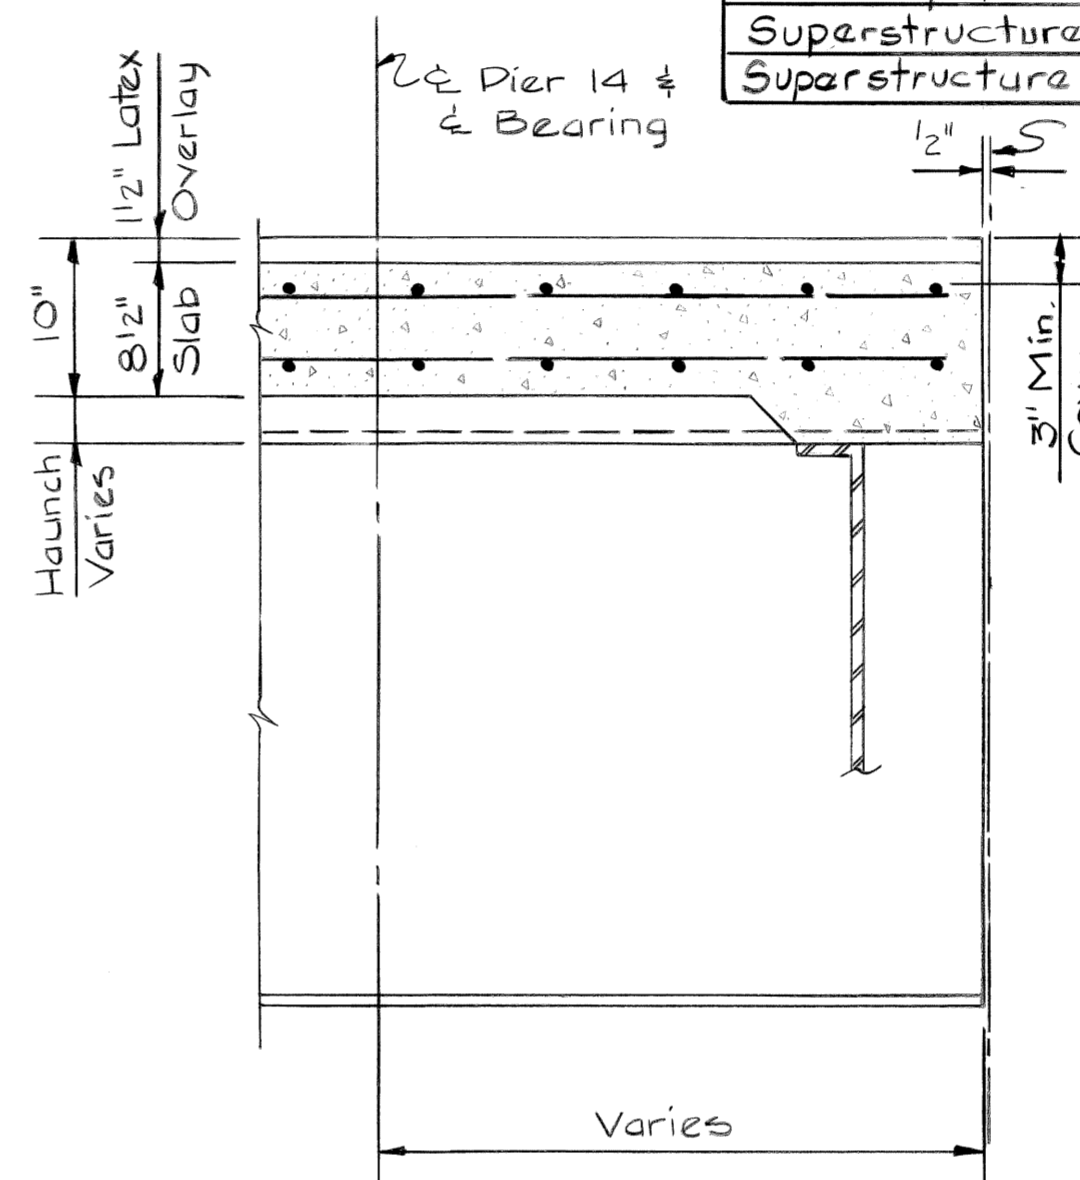

SECTION M-M



NOTES

- J.W.P. denotes Joint Waterproofing.
- For details of bevels, moldings, and bridge railings, see Standard Sheet R17. For details of drain castings see Standard Sheet DC1.
- Edge denotes edging with an approved tool.
- Exposed construction joints and false joints in barrier railing are to be grooved with an approved tool.
- Barrier Railing pours shall not be cast until slab concrete has attained at least 50% of its strength as determined by Table 7.01-4 of the Standard Specifications.
- Screeds affected by loads in other spans are to be set to the elevations shown before casting any concrete. Concrete in the suspended spans is to be cast before the concrete in the anchor spans.
- Alphabetical designation of pours in continuous spans 3 and 4, 5 and 6, 9, 10, and 11, is to be used as a pour sequence.
- Screed elevations are based on the condition that no slab concrete has been cast and that formwork, steel reinforcement and shear developers are in place.
- Bottom of slab elevations are at right angles to the girder centerline and are based on the condition that all structural steel has been erected, but no other loads applied. These elevations include allowances for deflections due to forms, steel reinforcement, deck concrete and railings.
- The Contractor is to provide a sawed joint 1/2 inch deep by 1/8 inch wide (min.) in the top of slab over and parallel to the centerline of piers. The joint is to be sawed before casting of barrier railings and prior to placing Latex Overlay. The joint is to be filled with Hot-Poured Joint Sealant. The Hot-Poured Joint Sealant is to be poured in such a manner that the adjacent concrete deck surface is kept clean so as not to interfere with the bonding of the Latex Overlay to the concrete deck surface.
- Transverse strike-off finishing machine is to be used in placing deck concrete and Latex Overlay.
- For name plate mounting details, see Standard Sheet R17. For location of name plate, see General Plan of Structure, Bridge Plan and Elevations Sheet S9.
- Barrier Railing is to be concrete barrier railing-bridge type 3. See Railing Standard R17.

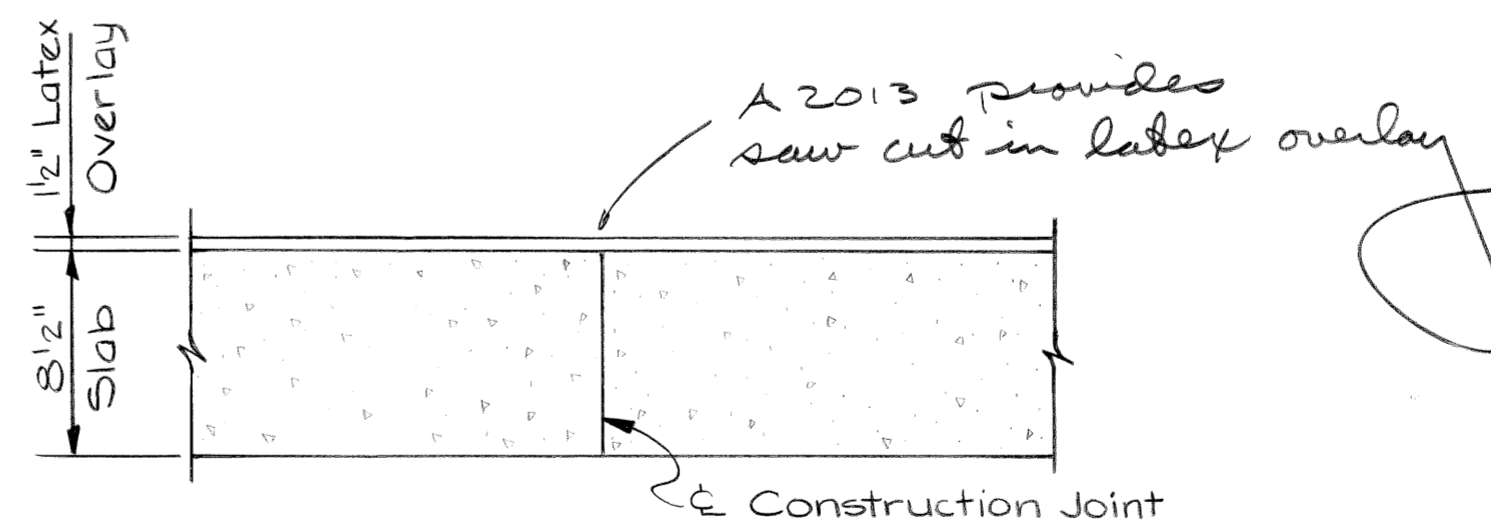


SECTION K-K


- Linseed oil compound shall not be applied to the top surface of the bridge deck.
- The top mat of Steel Reinforcement for the deck is to be Epoxy Coated.
- Pipe to be used for downspouts is to be galvanized pipe ASTM A53, Standard Grade.
- Expansion Joint Device is to be Type and Size as manufactured by the Manufacturing Company. It shall be bent in the shop to conform with the top of roadway slab.

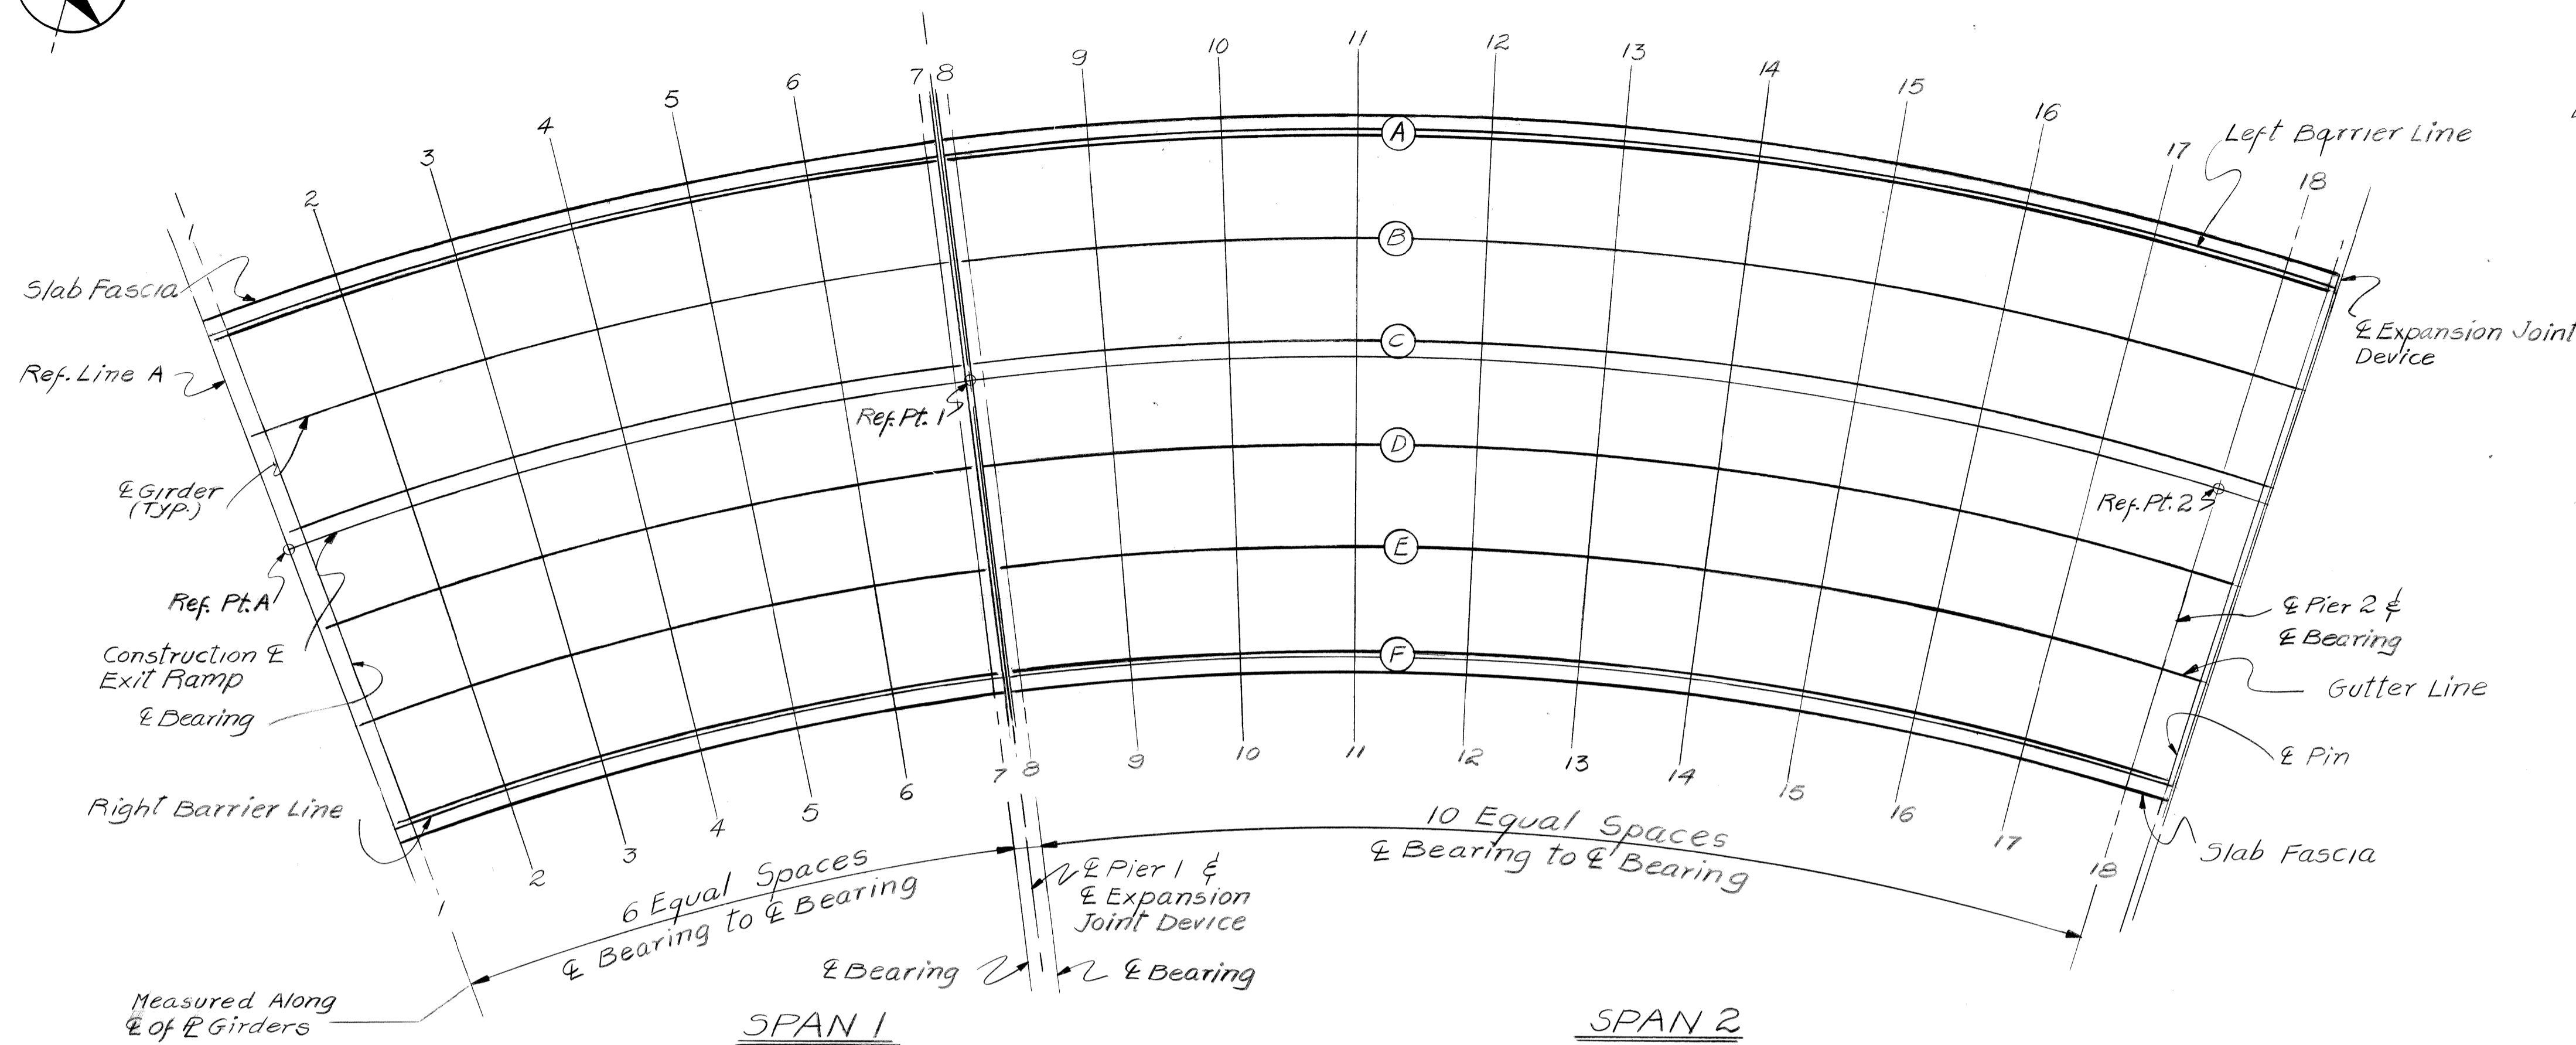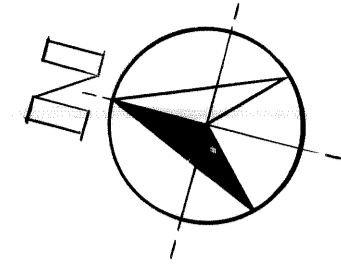

PLAN OF SLAB FOR SCREED & BOTTOM OF SLAB ELEVATIONS

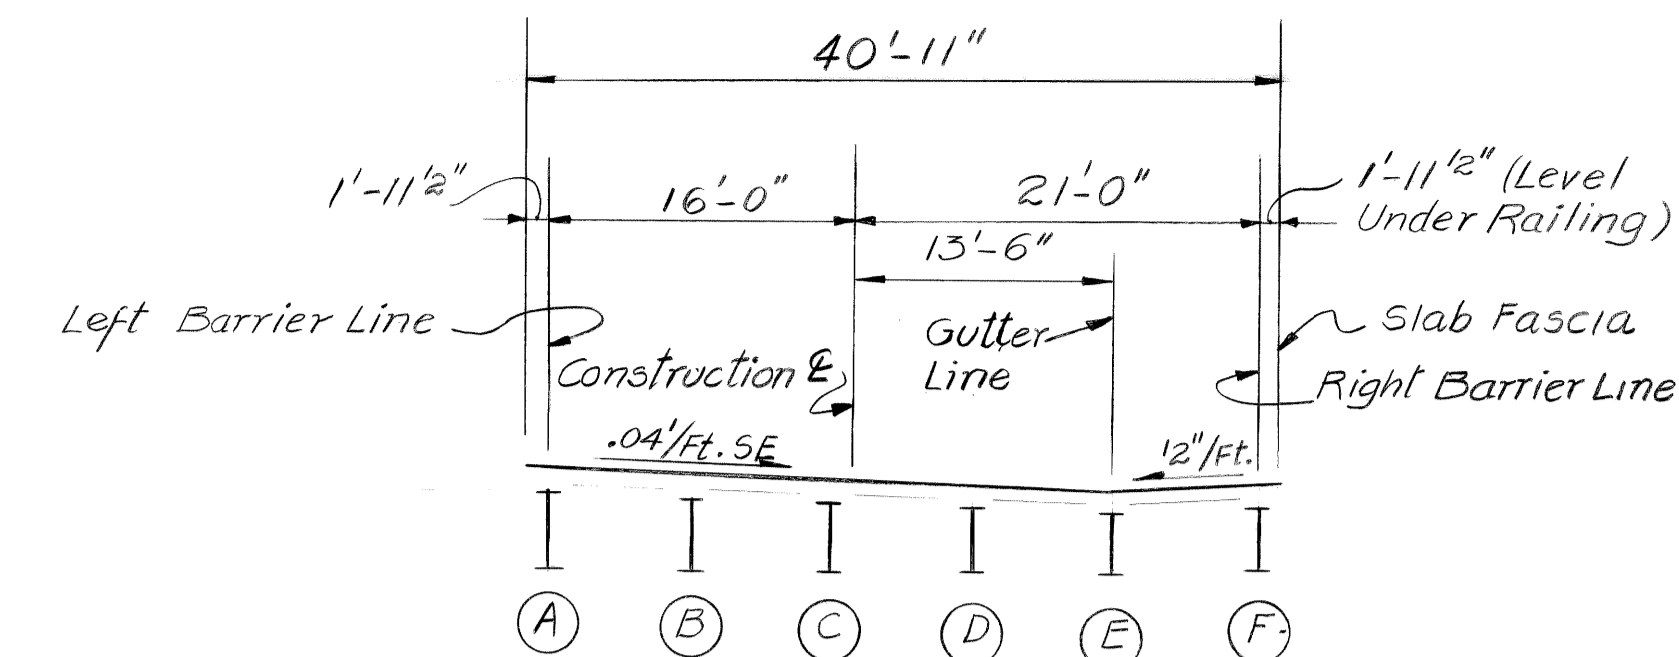

SCREED TEMPLATE

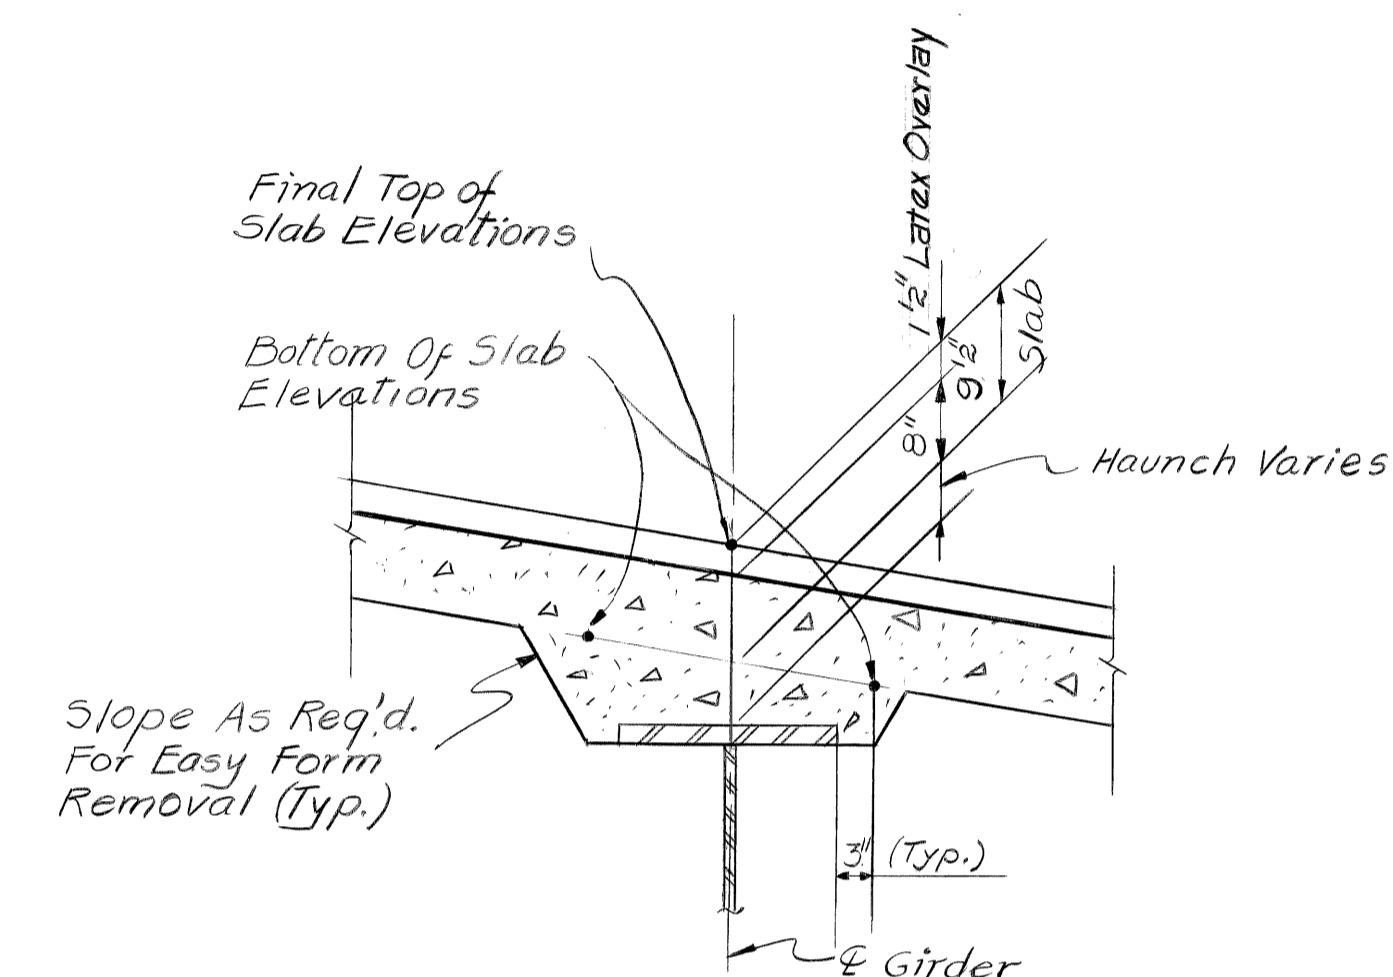


TYPICAL SECTION AT GIRDER

Line		1-1	2-2	3-3	4-4	5-5	6-6	7-7	8-8	9-9	10-10	11-11	12-12	13-13	14-14	15-15	16-16	17-17	18-18
Girder A	Right	116.29	116.77	117.23	117.65	118.04	118.39	118.72	118.80	119.27	119.72	120.13	120.50	120.83	121.12	121.37	121.58	121.76	121.92
Girder B	Left	116.06	116.55	117.00	117.43	117.81	118.16	118.49	118.57	119.04	119.49	119.89	120.26	120.59	120.88	121.13	121.35	121.53	121.69
Girder B	Right	116.00	116.49	116.94	117.37	117.75	118.10	118.43	118.51	118.98	119.43	119.83	120.20	120.53	120.82	121.07	121.29	121.47	121.63
Girder C	Left	115.77	116.25	116.71	117.13	117.51	117.87	118.19	118.28	118.75	119.19	119.60	119.97	120.30	120.59	120.84	121.05	121.24	121.40
Girder C	Right	115.71	116.19	116.65	117.07	117.45	117.81	118.13	118.22	118.69	119.13	119.54	119.91	120.24	120.53	120.78	120.99	121.18	121.34
Girder D	Left	115.47	115.95	116.41	116.83	117.22	117.57	117.90	117.99	118.46	118.89	119.30	119.67	120.00	120.28	120.54	120.75	120.94	121.10
Girder D	Right	115.41	115.89	116.35	116.77	117.16	117.51	117.84	117.93	118.40	118.83	119.24	119.61	119.94	120.22	120.48	120.69	120.88	121.04
Girder E	Left	115.18	115.66	116.11	116.54	116.92	117.27	117.60	117.70	118.16	118.59	118.99	119.36	119.69	119.98	120.23	120.45	120.64	120.81
Girder E	Right	115.18	115.66	116.12	116.54	116.92	117.28	117.60	117.70	118.16	118.59	118.99	119.36	119.69	119.98	120.23	120.45	120.64	120.81
Girder F	Left	115.42	115.90	116.35	116.76	117.15	117.51	117.85	117.95	118.39	118.81	119.20	119.56	119.89	120.18	120.44	120.67	120.87	121.05

Girder		A	B	C	D	E	F
Stage 2	b	1 1/8"	1 5/8"	1 1/2"	1 1/4"	1 1/2"	1 1/2"
	f	5 1/2"	5 3/4"	5 5/8"	5 1/2"	5 1/2"	4 1/2"
	J	1"	3/8"	7/16"	3/16"	3/16"	-3/4"
Stage 3	b	1 7/8"	1 7/8"	1 5/8"	1 5/8"	1 3/8"	1 3/8"
	f	5 3/4"	5"	5 5/16"	5 1/8"	4 1/2"	4 3/16"
	J	1"	3/8"	7/16"	3/16"	-3/16"	-3/4"
Stage 4	b	1 7/8"	1 3/8"	1 1/2"	1 1/2"	1 1/8"	1 1/8"
	f	3"	2 7/8"	3 3/16"	2 3/4"	2 7/8"	2 1/2"
	J	0"	1/4"	3/16"	3/16"	-1/4"	-3/4"

Screed Line	1-1	2-2	3-3	4-4	5-5	6-6	7-7	8-8	9-9	10-10	11-11	12-12	13-13	14-14	15-15	16-16	17-17	18-18
Left Barrier Line	117.00	117.48	117.94	118.36	118.74	119.10	119.43	119.51	119.97	120.41	120.82	121.18	121.51	121.80	122.06	122.27	122.46	122.63
Gutter Line	115.82	116.29	116.75	117.17	117.55	117.91	118.24	118.34	118.79	119.21	119.57	120.00	120.30	120.59	120.85	121.07	121.27	121.45
Right Barrier Line	116.13	116.60	117.05	117.46	117.85	118.21	118.55	118.65	119.09	119.50	119.89	120.25	120.57	120.87	121.13	121.36	121.57	121.76

Line	1-1	2-2	3-3	4-4	5-5	6-6	7-7	8-8	9-9	10-10	11-11	12-12	13-13	14-14	15-15	16-16	17-17	18-18
Girder A	117.11	117.55	117.98	118.39	118.79	119.17	119.54	119.63	120.02	120.38	120.73	121.07	121.39	121.69	121.97	122.25	122.50	122.75
Girder B	116.82	117.26	117.69	118.10	118.49	118.88	119.25	119.34	119.72	120.09	120.44	120.76	121.09	121.39	121.68	121.95	122.21	122.45
Girder C	116.53	116.97	117.39	117.80	118.20	118.58	118.95	119.04	119.43	119.80	120.15	120.48	120.80	121.10	121.39	121.66	121.92	122.16
Girder D	116.23	116.67	117.10	117.51	117.90	118.29	118.66	118.75	119.14	119.51	119.86	120.19	120.51	120.81	121.09	121.37	121.62	121.87
Girder E	115.94	116.38	116.80	117.21	117.61	117.99	118.36	118.46	118.85	119.21	119.56	119.90	120.21	120.52	120.80	121.07	121.33	121.57
Girder F	116.25	116.68	117.11	117.52	117.91	118.30	118.67	118.77	119.15	119.52	119.87	120.20	120.52	120.82	121.11	121.38	121.64	121.88

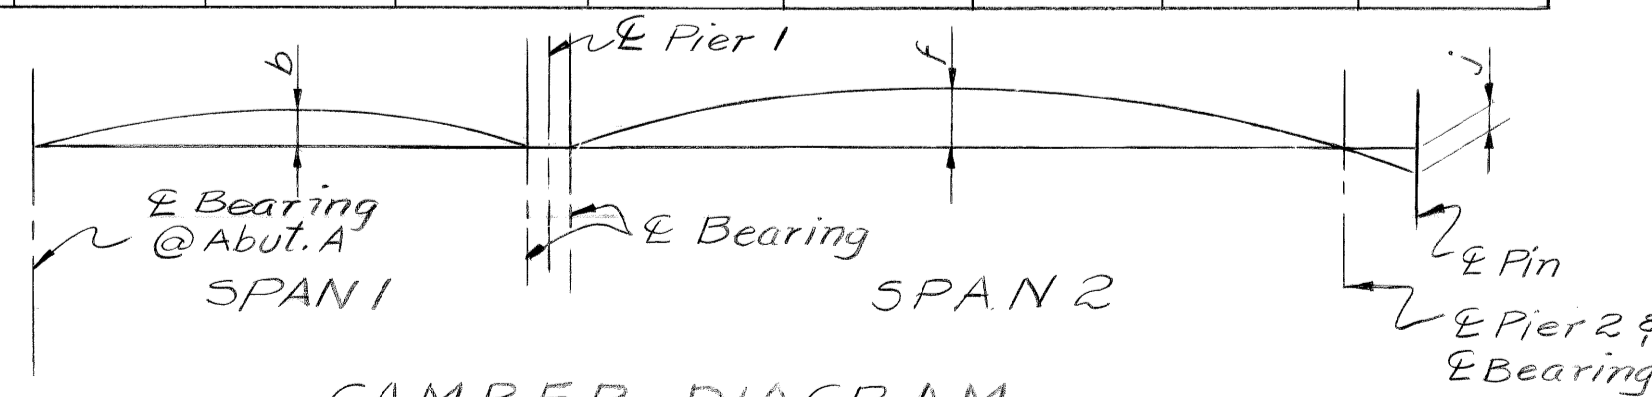


CAMBER DIAGRAM

- Stage 2 - R girders erected with diaphragms in place, no other loads applied. Camber ordinates includes allowances for: forms, deck concrete steel reinforcement, vertical curve and railings.
- Stage 3 - Forms, shear developers and steel reinforcement in place, all spans complete. Camber ordinates includes allowance for Deck concrete, vertical curve and railings.
- Stage 4 - Deck concrete and railing cast, all spans complete. Camber ordinates includes allowance for vertical curve.

Work This Sheet With Sheets # S64 thru S76 & S78 thru S82

DATE: August, 1979

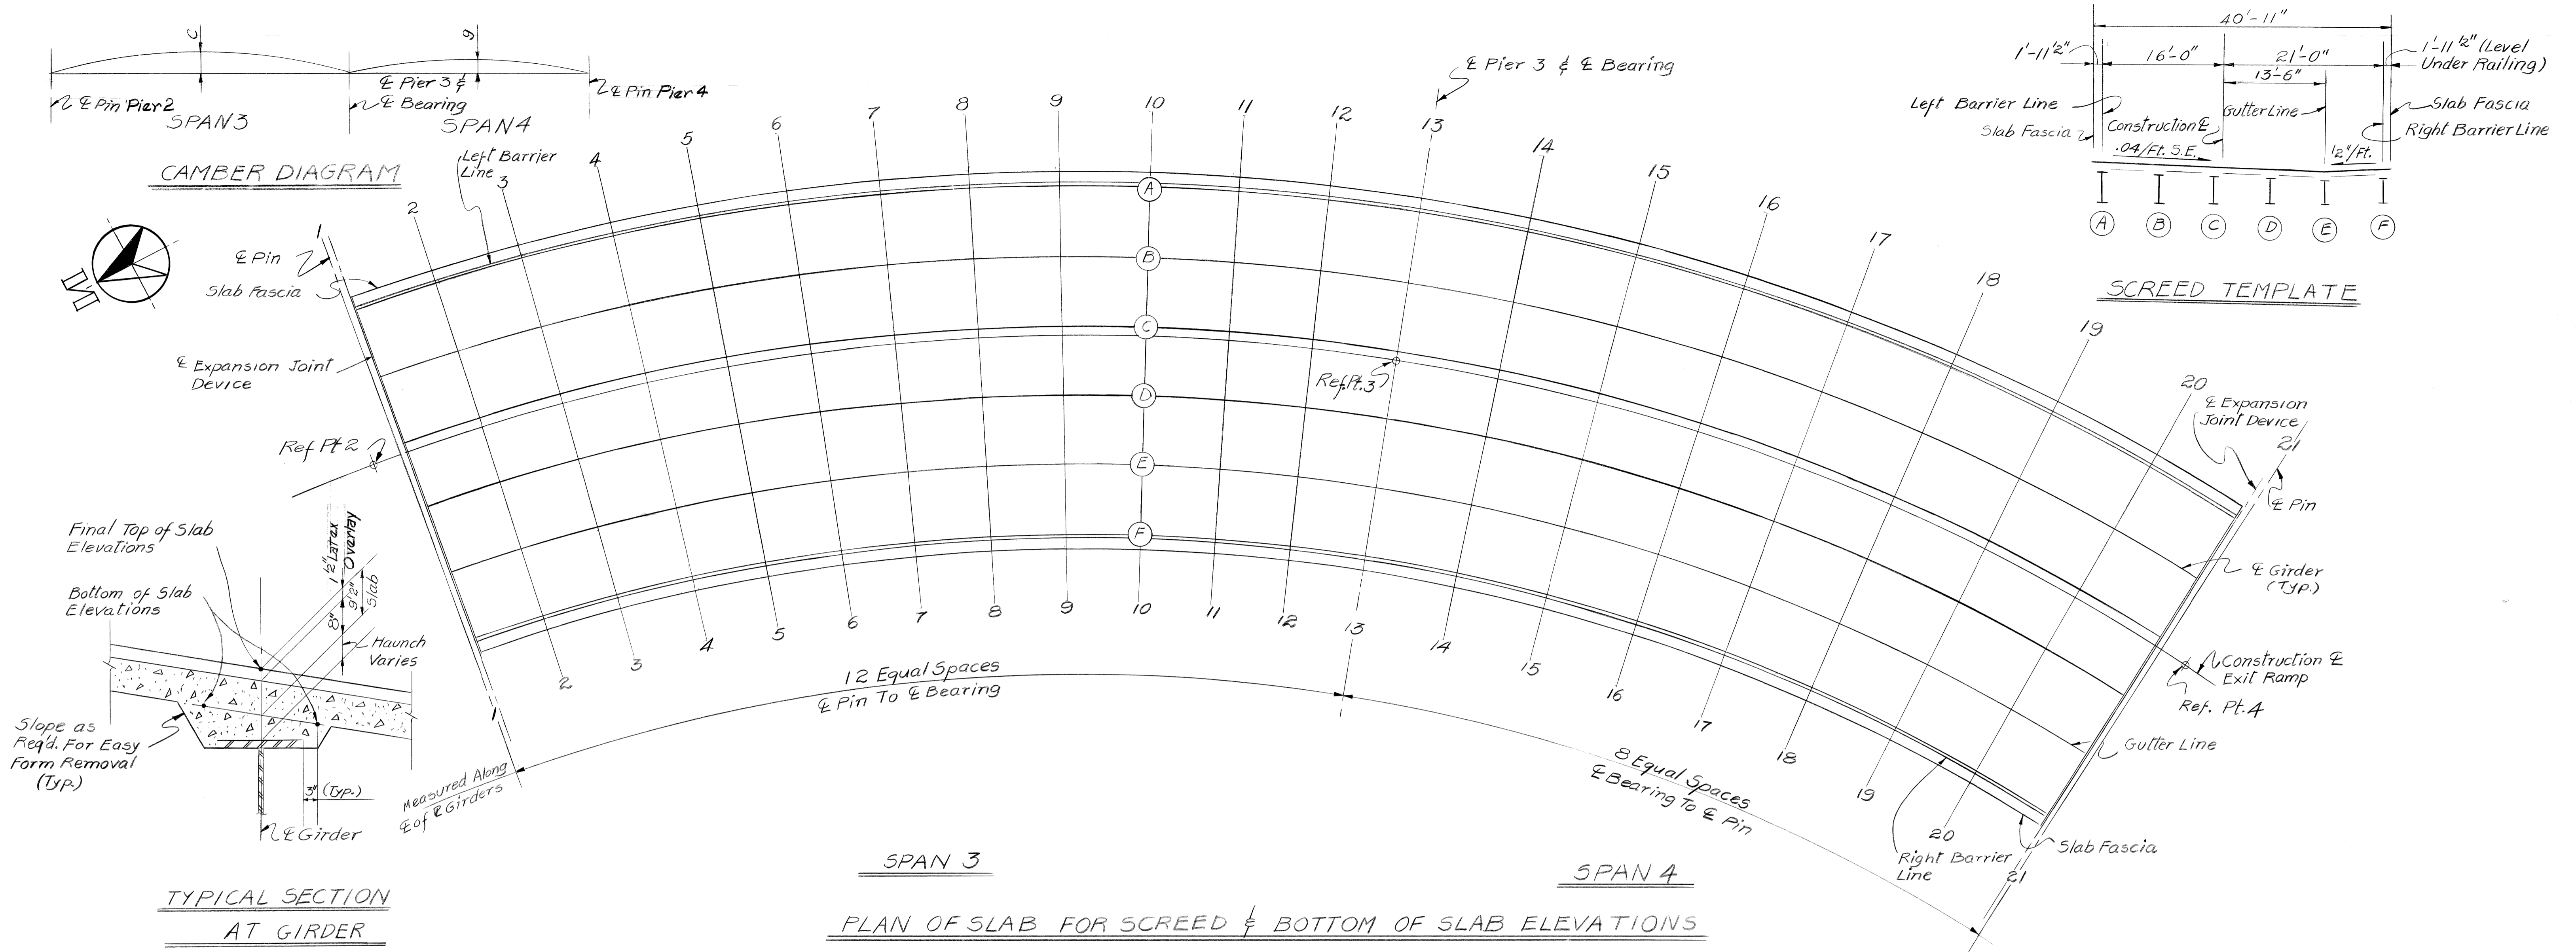

BOTTOM OF SLAB ELEVATIONS

Line	1-1	2-2	3-3	4-4	5-5	6-6	7-7	8-8	9-9	10-10	11-11	12-12	13-13	14-14	15-15	16-16	17-17	18-18	19-19	20-20	21-21
Girder A Right	122.00	122.30	122.58	122.82	123.04	123.23	123.39	123.50	123.58	123.63	123.64	123.63	123.59	123.62	123.64	123.65	123.63	123.57	123.50	123.41	123.31
Girder B Left	121.78	122.07	122.34	122.59	122.80	122.99	123.14	123.26	123.34	123.39	123.40	123.40	123.36	123.39	123.42	123.42	123.40	123.34	123.27	123.18	123.09
Girder B Right	121.72	122.01	122.28	122.53	122.74	122.93	123.08	123.20	123.28	123.33	123.34	123.34	123.30	123.33	123.36	123.36	123.34	123.28	123.21	123.12	123.03
Girder C Left	121.49	121.77	122.04	122.28	122.50	122.68	122.85	122.95	123.03	123.08	123.10	123.10	123.10	123.13	123.15	123.15	123.13	123.08	123.00	122.90	122.79
Girder C Right	121.43	121.71	121.98	122.22	122.44	122.62	122.77	122.89	122.97	123.02	123.04	123.04	123.01	123.04	123.07	123.09	123.07	123.02	122.94	122.84	122.73
Girder D Left	121.20	121.48	121.75	121.99	122.20	122.39	122.54	122.65	122.74	122.79	122.81	122.80	122.78	122.81	122.84	122.86	122.84	122.79	122.71	122.61	122.50
Girder D Right	121.14	121.42	121.69	121.93	122.14	122.33	122.48	122.59	122.68	122.73	122.75	122.74	122.72	122.75	122.78	122.80	122.78	122.73	122.65	122.55	122.44
Girder E Left	120.91	121.20	121.46	121.71	121.92	122.11	122.26	122.38	122.46	122.51	122.52	122.52	122.48	122.52	122.56	122.57	122.55	122.50	122.42	122.32	122.21
Girder E Right	120.91	121.20	121.47	121.71	121.93	122.11	122.26	122.38	122.46	122.51	122.53	122.52	122.49	122.52	122.56	122.57	122.56	122.50	122.42	122.32	122.21
Girder F Left	121.15	121.43	121.69	121.93	122.14	122.32	122.47	122.58	122.67	122.72	122.75	122.75	122.73	122.77	122.79	122.80	122.77	122.72	122.64	122.55	122.45

CAMBER ORDINATES

Girder Dim.	Camber Ordinate					
	A	B	C	D	E	F
Stage 2	6 1/2"	6 1/2"	6 3/8"	5 3/8"	6 15/16"	6 3/8"
Stage 3	2 13/16"	3"	3 3/16"	3 3/8"	3 1/8"	2 5/8"
Stage 4	6 3/16"	6 7/16"	6 1/2"	6 9/16"	6 11/16"	6 1/5"
Stage 5	2 3/4"	3"	3 1/8"	3 1/16"	3 1/16"	2 9/16"
Stage 6	4 7/16"	4 9/16"	5"	5 1/16"	5 1/4"	4 15/16"
Stage 7	2 3/16"	2 5/8"	2 3/4"	2 1/8"	2 1/16"	1 9/16"

SCREED ELEVATIONS

Screed Line	1-1	2-2	3-3	4-4	5-5	6-6	7-7	8-8	9-9	10-10	11-11	12-12	13-13	14-14	15-15	16-16	17-17	18-18	19-19	20-20	21-21
Left Barrier Line	122.71	123.01	123.28	123.53	123.75	123.93	124.09	124.20	124.28	124.33	124.34	124.33	124.30	124.33	124.35	124.35	124.33	124.28	124.20	124.12	124.02
Gutter Line	121.54	121.83	122.10	122.34	122.56	122.74	122.89	123.01	123.09	123.14	123.16	123.15	123.12	123.16	123.19	123.20	123.18	123.13	123.05	122.95	122.85
Right Barrier Line	121.86	122.14	122.39	122.63	122.83	123.01	123.16	123.28	123.37	123.42	123.45	123.45	123.43	123.47	123.50	123.50	123.47	123.41	123.34	123.25	123.16

FINAL TOP OF SLAB ELEVATIONS

Line	1-1	2-2	3-3	4-4	5-5	6-6	7-7	8-8	9-9	10-10	11-11	12-12	13-13	14-14	15-15	16-16	17-17	18-18	19-19	20-20	21-21
Girder A	122.82	123.05	123.25	123.44	123.62	123.77	123.91	124.03	124.14	124.24	124.31	124.37	124.42	124.45	124.46	124.44	124.40	124.34	124.28	124.21	124.15
Girder B	122.53	122.75	122.96	123.15	123.32	123.48	123.62	123.74	123.85	123.94	124.02	124.08	124.13	124.16	124.17	124.15	124.11	124.05	123.98	123.92	123.85
Girder C	122.24	122.46	122.67	122.86	123.03	123.19	123.33	123.45	123.56	123.65	123.73	123.79	123.83	123.87	123.87	123.86	123.82	123.76	123.69	123.63	123.56
Girder D	121.95	122.17	122.38	122.57	122.74	122.89	123.03	123.16	123.26	123.36	123.43	123.49	123.54	123.57	123.58	123.56	123.52	123.46	123.40	123.33	123.27
Girder E	121.66	121.88	122.09	122.28	122.45	122.60	122.74	122.86	122.97	123.06	123.14	123.20	123.25	123.28	123.29	123.27	123.23	123.17	123.11	123.04	122.98
Girder F	121.97	122.19	122.40	122.58	122.75	122.91	123.05	123.17	123.28	123.37	123.45	123.51	123.55	123.58	123.59	123.58	123.54	123.48	123.41	123.35	123.28




Stage 2 - Girders erected with diaphragms in place, no other loads applied. Camber ordinates includes allowances for: forms, deck concrete steel reinforcement, vertical curves and railings.

Stage 3 - Forms, shear developers and steel reinforcement in place, all spans complete. Camber ordinates includes allowance for Deck Concrete, Vertical Curve and railings.


Stage 4 - Deck concrete and railing cast, all spans complete. Camber ordinates includes allowance for vertical curve.

Work This Sheet With Sheets # S64 thru S77 & S79 thru S82


DATE: August, 1979

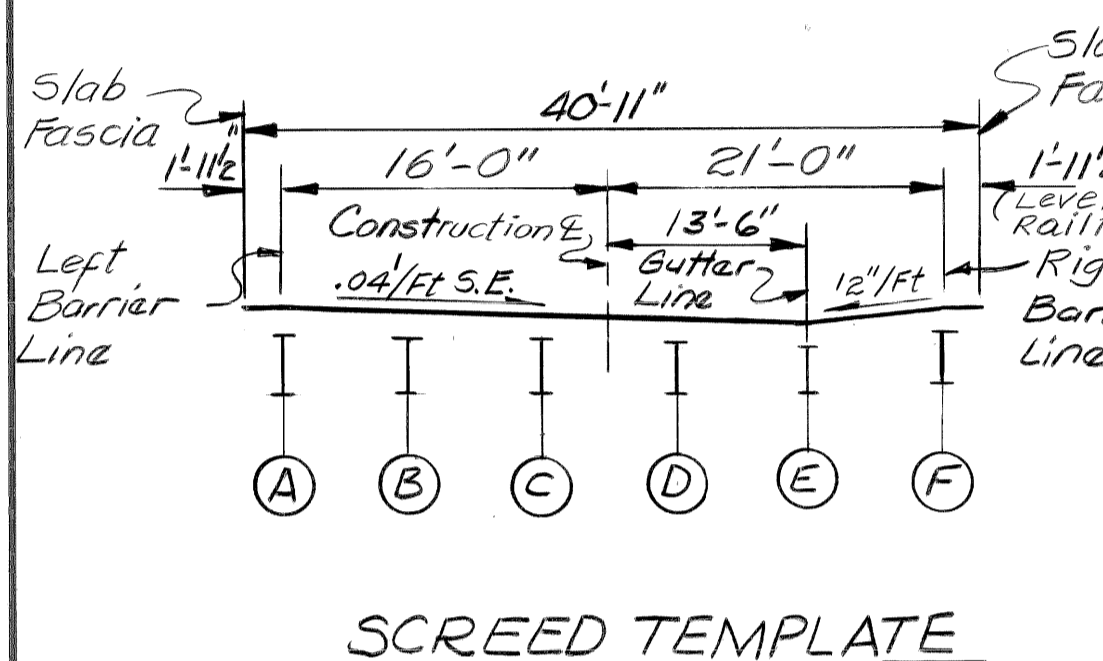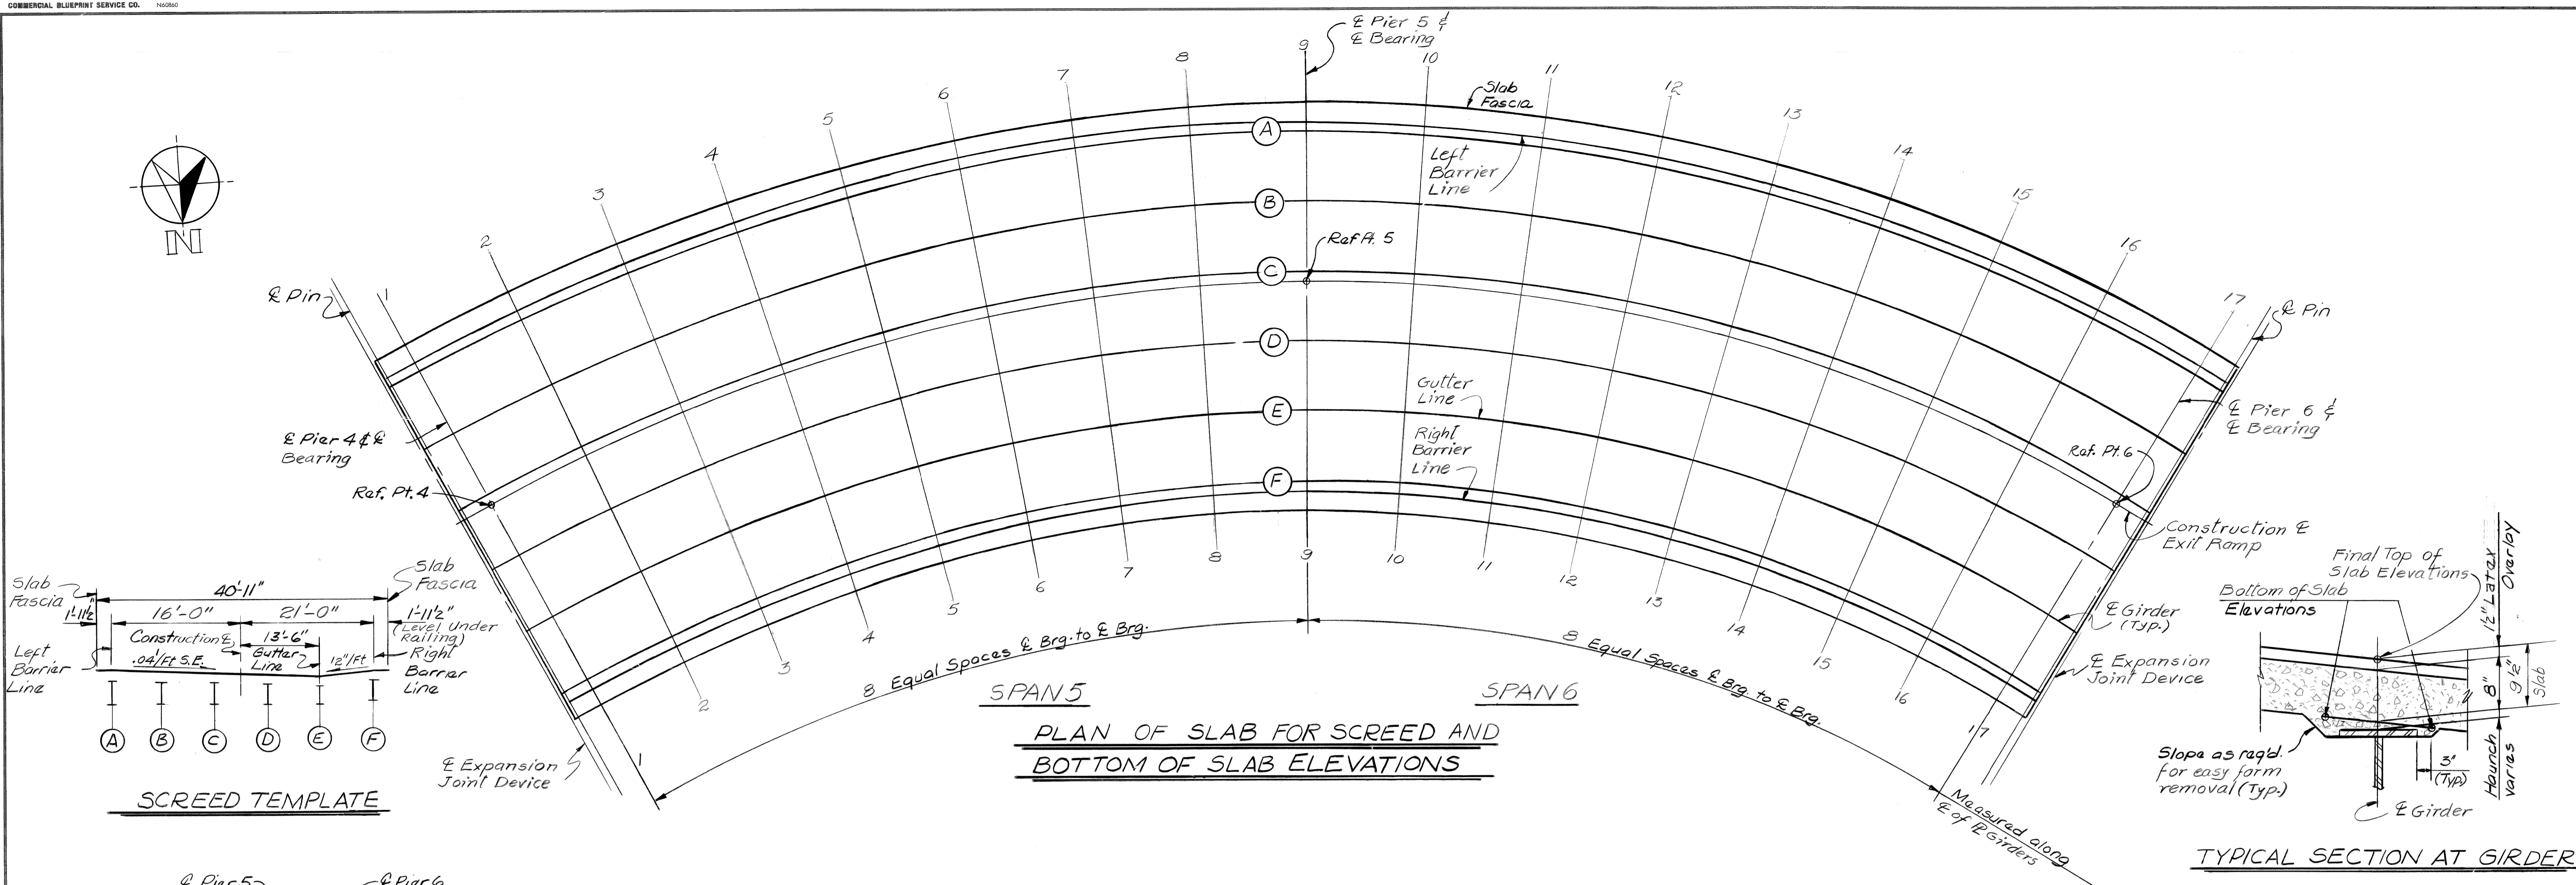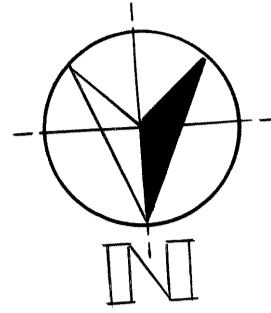

PLAN OF SLAB FOR SCREED AND BOTTOM OF SLAB ELEVATIONS

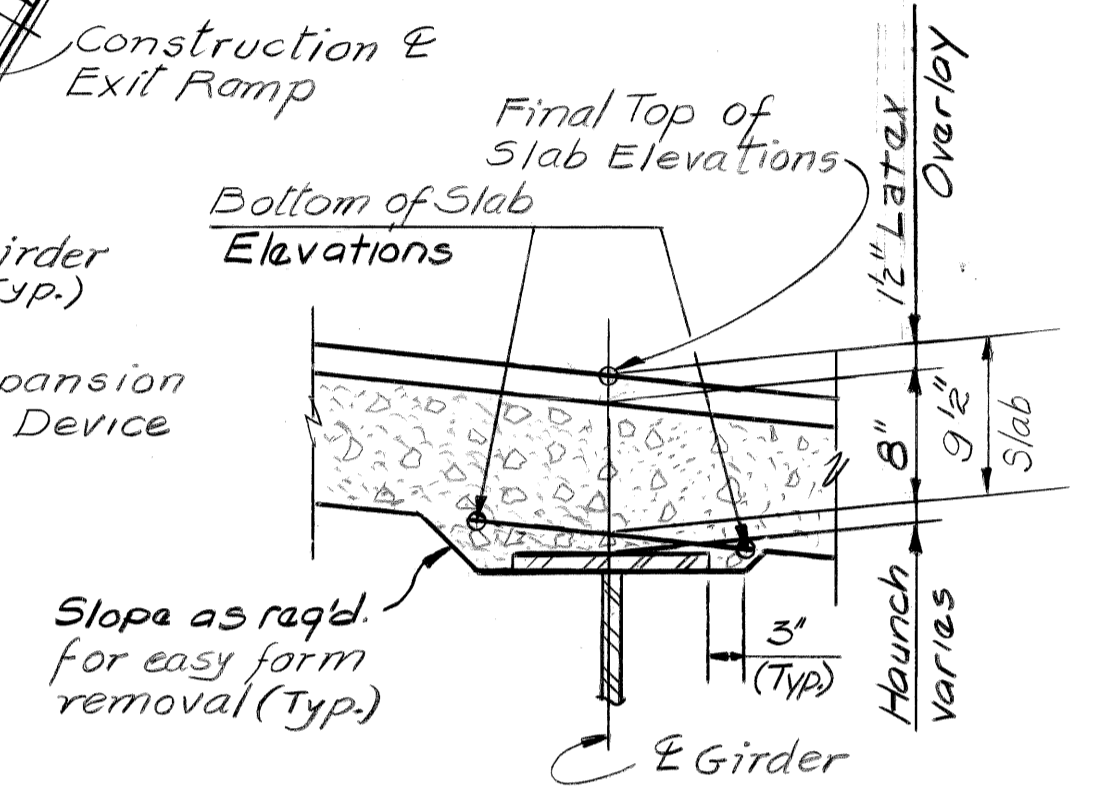

TYPICAL SECTION AT GIRDER

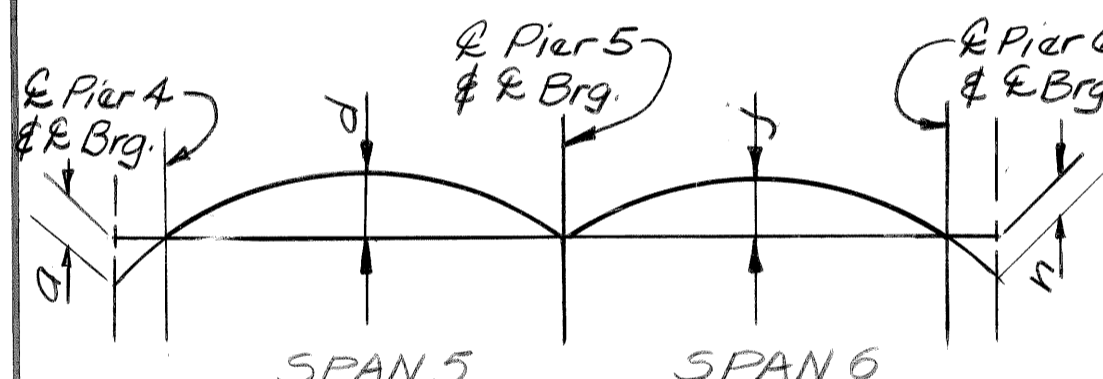

CAMBER DIAGRAM

Stage 2: R Girder erected with diaphragms in place, no other loads applied. Camber ordinates include allowance for forms, deck concrete, steel reinforcement sidewalks, railings, vertical curve and railings.

Stage 3: Forms, shear developers and steel reinforcement in place, all spans complete. Camber ordinates include allowance for deck concrete, vertical curve and railings.



Stage 4: Deck concrete, and railings cast, all spans complete. Camber ordinates include allowance for vertical curve.

Line	1-1	2-2	3-3	4-4	5-5	6-6	7-7	8-8	9-9	10-10	11-11	12-12	13-13	14-14	15-15	16-16	17-17
Girder A Right	123.20	123.28	123.24	123.19	123.12	123.03	122.93	122.84	122.77	122.72	122.68	122.65	122.61	122.54	122.38	122.19	122.00
Girder B Left	123.07	123.04	123.01	122.95	122.88	122.79	122.70	122.61	122.54	122.49	122.45	122.42	122.38	122.31	122.18	121.98	121.86
Girder B Right	123.01	122.98	122.95	122.89	122.82	122.73	122.64	122.55	122.48	122.43	122.39	122.36	122.32	122.25	122.13	121.98	121.82
Girder C Left	122.78	122.75	122.71	122.65	122.58	122.50	122.41	122.32	122.25	122.19	122.16	122.13	122.09	122.02	121.92	121.81	121.68
Girder C Right	122.72	122.69	122.65	122.59	122.52	122.44	122.35	122.26	122.19	122.13	122.10	122.07	122.03	121.96	121.87	121.76	121.64
Girder D Left	122.49	122.45	122.41	122.36	122.29	122.20	122.12	122.03	121.95	121.90	121.86	121.83	121.78	121.72	121.66	121.59	121.50
Girder D Right	122.43	122.39	122.35	122.30	122.23	122.14	122.06	121.97	121.89	121.84	121.80	121.77	121.72	121.66	121.61	121.54	121.47
Girder E Left	122.19	122.16	122.12	122.07	122.00	121.91	121.82	121.74	121.66	121.60	121.56	121.53	121.48	121.42	121.40	121.37	121.32
Girder E Right	122.20	122.16	122.12	122.07	122.00	121.91	121.82	121.74	121.66	121.61	121.57	121.53	121.48	121.43	121.41	121.38	121.34
Girder F Left	122.44	122.40	122.35	122.30	122.23	122.15	122.06	121.98	121.90	121.84	121.79	121.75	121.69	121.63	121.62	121.60	121.58

Line	1-1	2-2	3-3	4-4	5-5	6-6	7-7	8-8	9-9	10-10	11-11	12-12	13-13	14-14	15-15	16-16	17-17
Scraed Line	124.01	123.98	123.94	123.89	123.81	123.73	123.64	123.55	123.48	123.42	123.39	123.35	123.31	123.23	123.07	122.88	122.69
Left Barrier Line	124.01	123.98	123.94	123.89	123.81	123.73	123.64	123.55	123.48	123.42	123.39	123.35	123.31	123.23	123.07	122.88	122.69
Gutter Line	122.83	122.79	122.75	122.69	122.62	122.54	122.46	122.37	122.29	122.24	122.20	122.16	122.11	122.05	122.04	122.01	121.97
Right Barrier Line	123.15	123.10	123.05	122.99	122.93	122.85	122.77	122.68	122.61	122.55	122.49	122.44	122.39	122.33	122.32	122.31	122.29

Line	1-1	2-2	3-3	4-4	5-5	6-6	7-7	8-8	9-9	10-10	11-11	12-12	13-13	14-14	15-15	16-16	17-17
Girder A E	124.13	124.06	123.99	123.93	123.86	123.80	123.73	123.66	123.59	123.53	123.46	123.39	123.33	123.25	123.11	122.96	122.81
Girder B E	123.84	123.77	123.70	123.63	123.57	123.50	123.44	123.37	123.30	123.23	123.16	123.10	123.03	122.96	122.85	122.74	122.63
Girder C E	123.54	123.47	123.41	123.34	123.28	123.21	123.14	123.08	123.01	122.94	122.87	122.81	122.74	122.67	122.60	122.53	122.45
Girder D E	123.25	123.18	123.11	123.05	122.98	122.92	122.85	122.78	122.71	122.65	122.58	122.51	122.45	122.38	122.35	122.31	122.28
Girder E E	122.96	122.89	122.82	122.75	122.69	122.62	122.56	122.49	122.42	122.35	122.28	122.22	122.15	122.10	122.10	122.10	122.10
Girder F E	123.26	123.19	123.13	123.06	122.99	122.93	122.86	122.79	122.73	122.66	122.59	122.52	122.46	122.40	122.40	122.40	122.40

Dim	A	B	C	D	E	F
Stage 2						
a	3/16"	-5/16"	-7/16"	-5/16"	3/16"	1/8"
d	1 1/16"	1 1/8"	1 3/16"	1 3/16"	1 3/16"	5/8"
j	3/2"	3"	2"	1 1/16"	5/16"	-1/8"
n	7/8"	-1/8"	1/4"	3/16"	1/8"	0"
Stage 3						
a	1/8"	-3/16"	-7/16"	-5/16"	3/16"	1/8"
d	1 1/4"	1 3/16"	1 3/8"	1 1/8"	1 3/16"	1 1/2"
j	3 3/8"	2 3/8"	1 7/8"	1 3/16"	3/16"	-3/16"
n	7/16"	-1/8"	1/4"	3/16"	0"	0"
Stage 4						
a	1/16"	-7/16"	-1/2"	-7/16"	1/16"	0"
d	7/16"	3/16"	3/4"	7/16"	1/16"	1/16"
j	2 1/8"	1 3/8"	1 1/16"	1 3/8"	-3/4"	-1 3/16"
n	1/4"	-5/16"	1/8"	0"	-1/8"	-1/8"

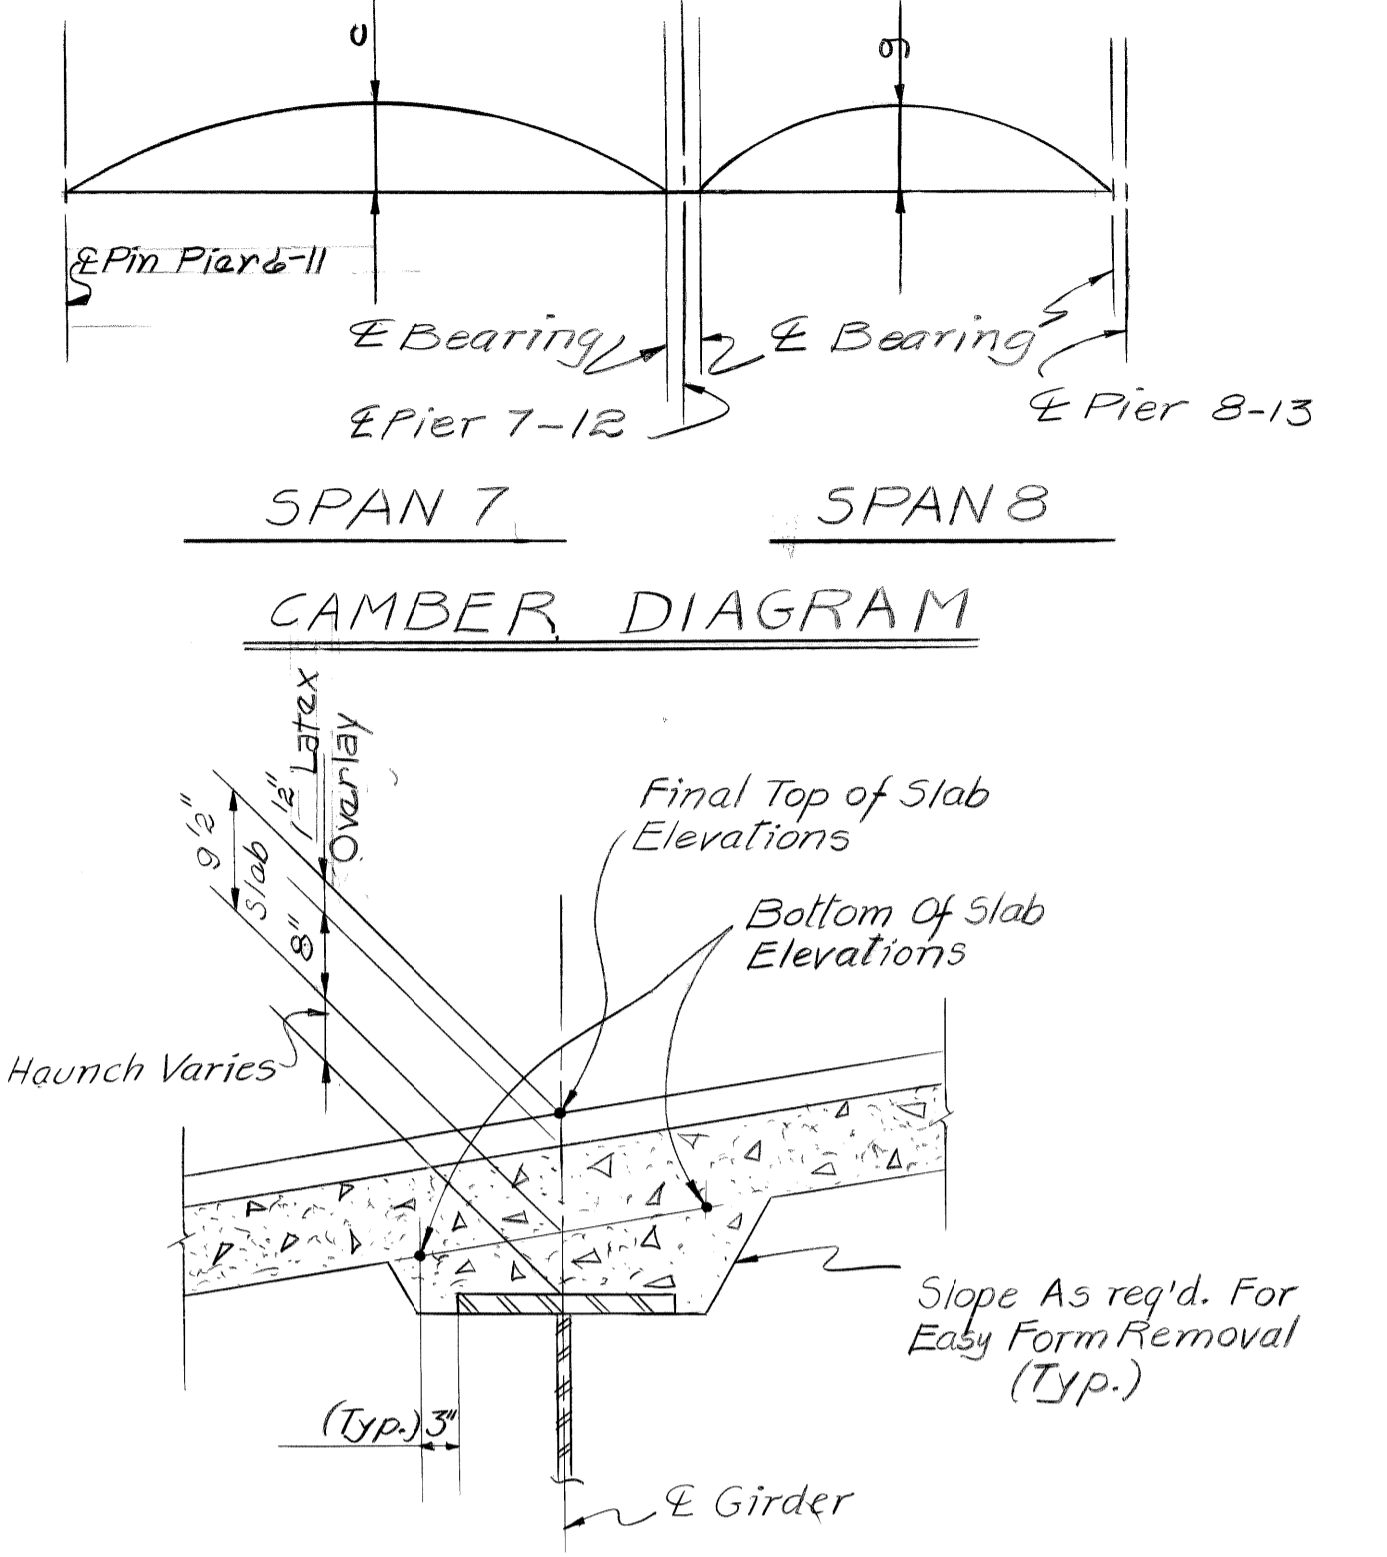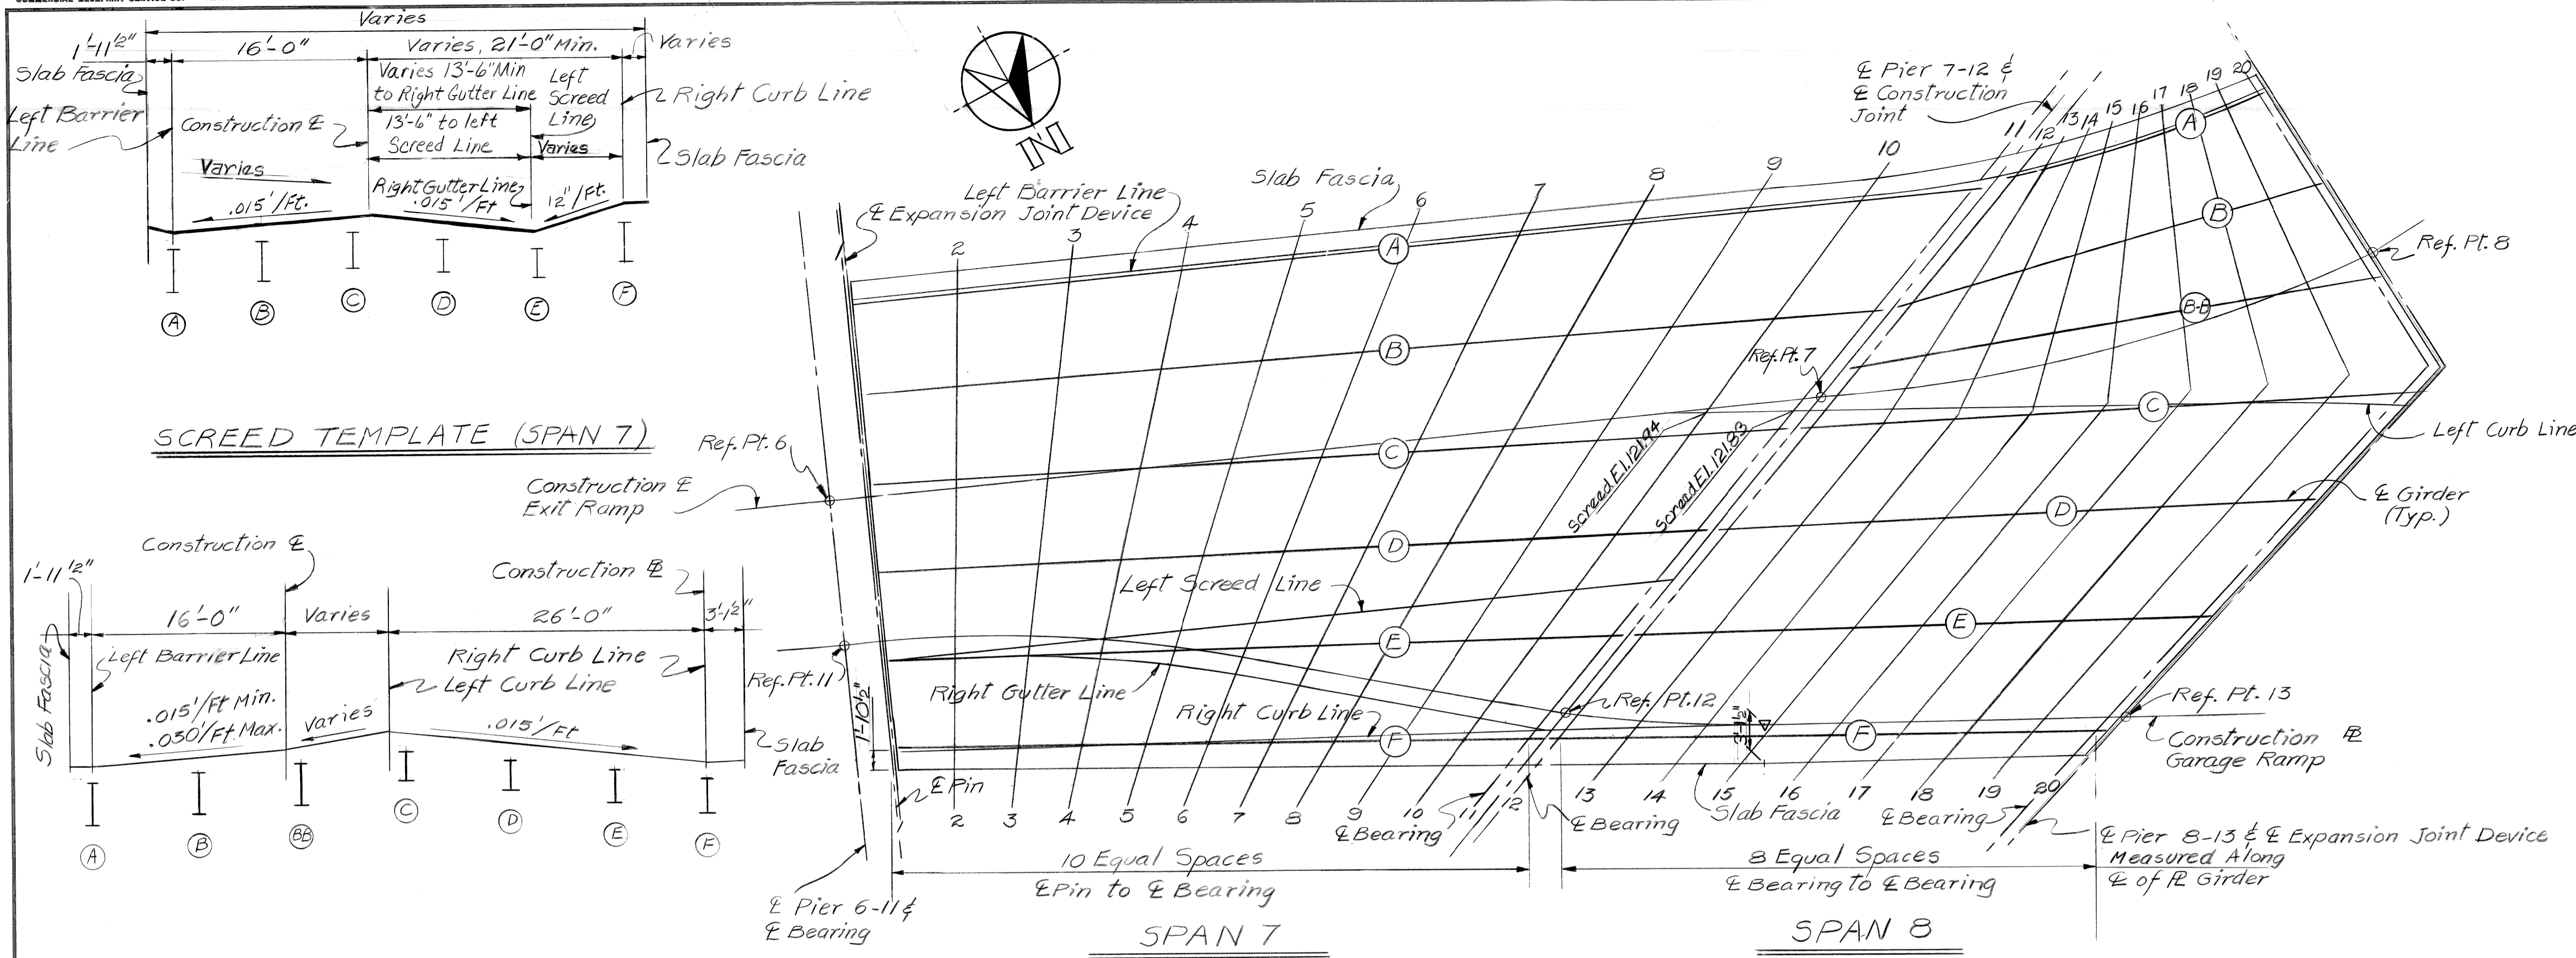

PLAN OF SLAB FOR SCREED AND BOTTOM OF SLAB ELEVATIONS

TYPICAL SECTION AT GIRDER

BOTTOM OF SLAB ELEVATIONS																					
Line	1-1	2-2	3-3	4-4	5-5	6-6	7-7	8-8	9-9	10-10	11-11	12-12	13-13	14-14	15-15	16-16	17-17	18-18	19-19	20-20	
Girder A Right	121.96	121.93	121.89	121.85	121.75	121.64	121.51	121.35	121.17	120.98	120.76	120.70	120.66	120.63	120.58	120.54	120.49	120.44	120.40	120.36	
Girder A Left	121.83	121.82	121.81	121.78	121.73	121.66	121.56	121.44	121.31	121.16	121.00	120.96	120.91	120.86	120.81	120.76	120.71	120.65	120.60	120.56	
Girder B Right	121.79	121.79	121.78	121.76	121.72	121.65	121.56	121.45	121.32	121.17	121.02	120.99	120.94	120.89	120.85	120.80	120.75	120.70	120.65	120.60	
Girder B Left	NOT APPLICABLE											121.10	121.06	121.03	121.00	120.98	120.95	120.92	120.90	120.88	
Girder C Left	121.66	121.67	121.68	121.67	121.65	121.61	121.56	121.45	121.35	121.26	121.14	121.17	121.19	121.22	121.27	121.30	121.33	121.36	121.39	121.42	
Girder C Right	121.63	121.64	121.66	121.65	121.63	121.59	121.53	121.45	121.35	121.24	121.12	121.15	121.16	121.20	121.25	121.28	121.30	121.32	121.35	121.38	
Girder D Left	121.49	121.52	121.54	121.54	121.52	121.48	121.43	121.36	121.27	121.18	121.07	121.06	121.07	121.09	121.11	121.12	121.14	121.15	121.16	121.17	
Girder D Right	121.46	121.49	121.51	121.52	121.50	121.46	121.40	121.33	121.25	121.15	121.05	121.04	121.05	121.07	121.09	121.10	121.12	121.14	121.15	121.16	
Girder E Left	121.34	121.37	121.38	121.41	121.38	121.34	121.29	121.23	121.16	121.08	121.00	120.98	120.96	120.97	120.97	120.97	120.97	120.97	120.97	120.90	
Girder E Right	121.35	121.40	121.43	121.42	121.38	121.34	121.29	121.23	121.15	121.07	120.98	120.96	120.94	120.95	120.95	120.94	120.94	120.94	120.94	120.88	
Girder F Left	121.59	121.63	121.64	121.64	121.60	121.52	121.42	121.31	121.19	121.07	120.95	120.91	120.89	120.87	120.85	120.84	120.83	120.81	120.78	120.75	

CAMBER ORDINATES								
Stage	Dim.	A	B	BB	C	D	E	F
Stage 2	c	3 3/8"	3 3/8"	N.A.	2 9/16"	2 3/8"	1 3/4"	1 1/8"
	g	0"	1/4"	3/16"	15/16"	1 1/8"	1 1/8"	1 1/8"
Stage 3	c	2 7/8"	2 3/4"	N.A.	2 1/16"	1 7/8"	1 1/2"	1"
	g	0"	3/16"	3/16"	15/16"	1 1/8"	1 1/8"	1 1/8"
Stage 4	c	0"	1/8"	N.A.	-1/8"	1/8"	1/8"	1/8"
	g	0"	1/8"	-1/8"	1/8"	-1/8"	-1/8"	1/8"

Note: Grades are very flat in this area and difficult to get positive drainage



SCREED ELEVATIONS																					
SPAN 7											SPAN 8										
Screed Line	1-1	2-2	3-3	4-4	5-5	6-6	7-7	8-8	9-9	10-10	11-11	Screed Line	12-12	13-13	14-14	15-15	16-16	17-17	18-18	19-19	20-20
Left Barrier Line	122.65	122.60	122.55	122.48	122.39	122.27	122.14	121.98	121.81	121.61	121.40	Left Barrier Line	121.35	121.31	121.27	121.23	121.18	121.13	121.08	121.04	121.00
Construction E	122.29	122.30	122.31	122.30	122.28	122.25	122.19	122.12	122.05	121.93	121.82	Construction E	121.81	121.78	121.75	121.73	121.69	121.65	121.60	121.53	121.45
Left Screed Line	121.98	122.02	122.05	122.07	122.05	122.02	121.97	121.92	121.85	121.78	121.70	Left Curb Line	121.85	121.86	121.87	121.87	121.86	121.84	121.82	121.80	121.78
Right Gutter Line	121.98	122.02	122.05	122.06	122.04	121.99	121.93	121.86	121.78	121.69	121.59	Right Curb Line	121.57	121.55	121.53	121.51	121.50	121.49	121.47	121.44	121.41
Right Curb Line	122.29	122.32	122.33	122.33	122.28	122.19	122.09	121.98	121.86	121.74	121.61										

TOP OF SLAB FINAL ELEVATIONS																					
Line	1-1	2-2	3-3	4-4	5-5	6-6	7-7	8-8	9-9	10-10	11-11	12-12	13-13	14-14	15-15	16-16	17-17	18-18	19-19	20-20	
Girder A E	122.77	122.65	122.53	122.40	122.28	122.16	122.04	121.91	121.79	121.67	121.54	121.48	121.43	121.40	121.35	121.31	121.26	121.20	121.17	121.13	
Girder B E	122.60	122.52	122.43	122.35	122.27	122.18	122.11	122.03	121.95	121.87	121.80	121.76	121.71	121.66	121.61	121.56	121.51	121.46	121.41	121.37	
Girder B-B E	NOT APPLICABLE											121.88	121.83	121.79	121.76	121.73	121.70	121.67	121.65	121.64	
Girder C E	122.43	122.38	122.33	122.27	122.22	122.17	122.12	122.07	122.02	121.97	121.92	121.95	121.94	121.93	121.92	121.92	121.93	121.96	122.05	122.11	
Girder D E	122.27	122.24	122.21	122.18	122.13	122.08	122.04	121.99	121.95	121.91	121.85	121.84	121.83	121.82	121.81	121.80	121.80	121.80	121.84	121.91	
Girder E E	122.10	122.10	122.09	122.07	122.04	121.99	121.95	121.91	121.87	121.83	121.78	121.76	121.72	121.71	121.70	121.69	121.68	121.67	121.66	121.68	
Girder F E	122.40	122.41	122.41	122.39	122.33	122.24	122.14	122.04	121.94	121.84	121.74	121.71	121.67	121.62	121.59	121.58	121.57	121.56	121.55	121.54	

Stage 2 - IR girders erected with diaphragms in place, no other loads applied. Camber ordinates includes allowances for: forms, deck concrete steel reinforcement, vertical curves and railings

Stage 3 - Forms, shear developers and steel reinforcement in place, all spans complete. Camber ordinate includes allowance for Deck Concrete, Vertical Curve and railings

Stage 4 - Deck concrete and railing cast, all spans complete. Camber ordinates includes allowance for Vertical Curve.

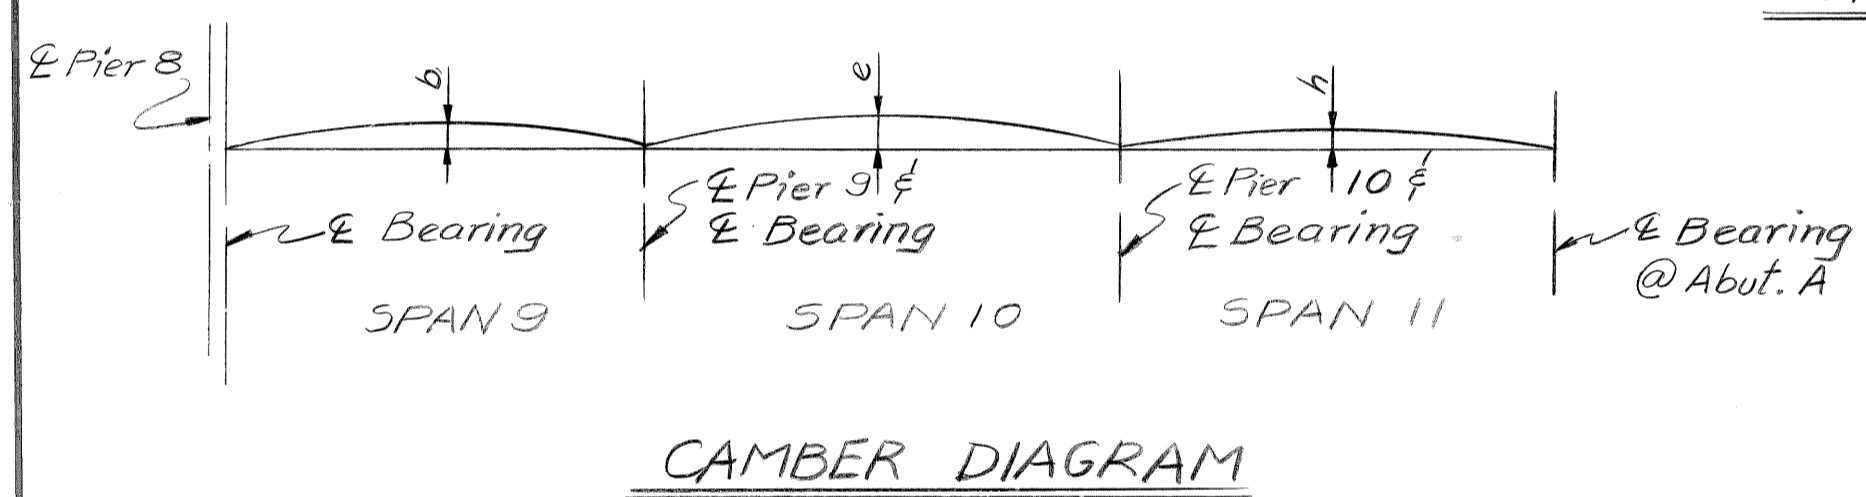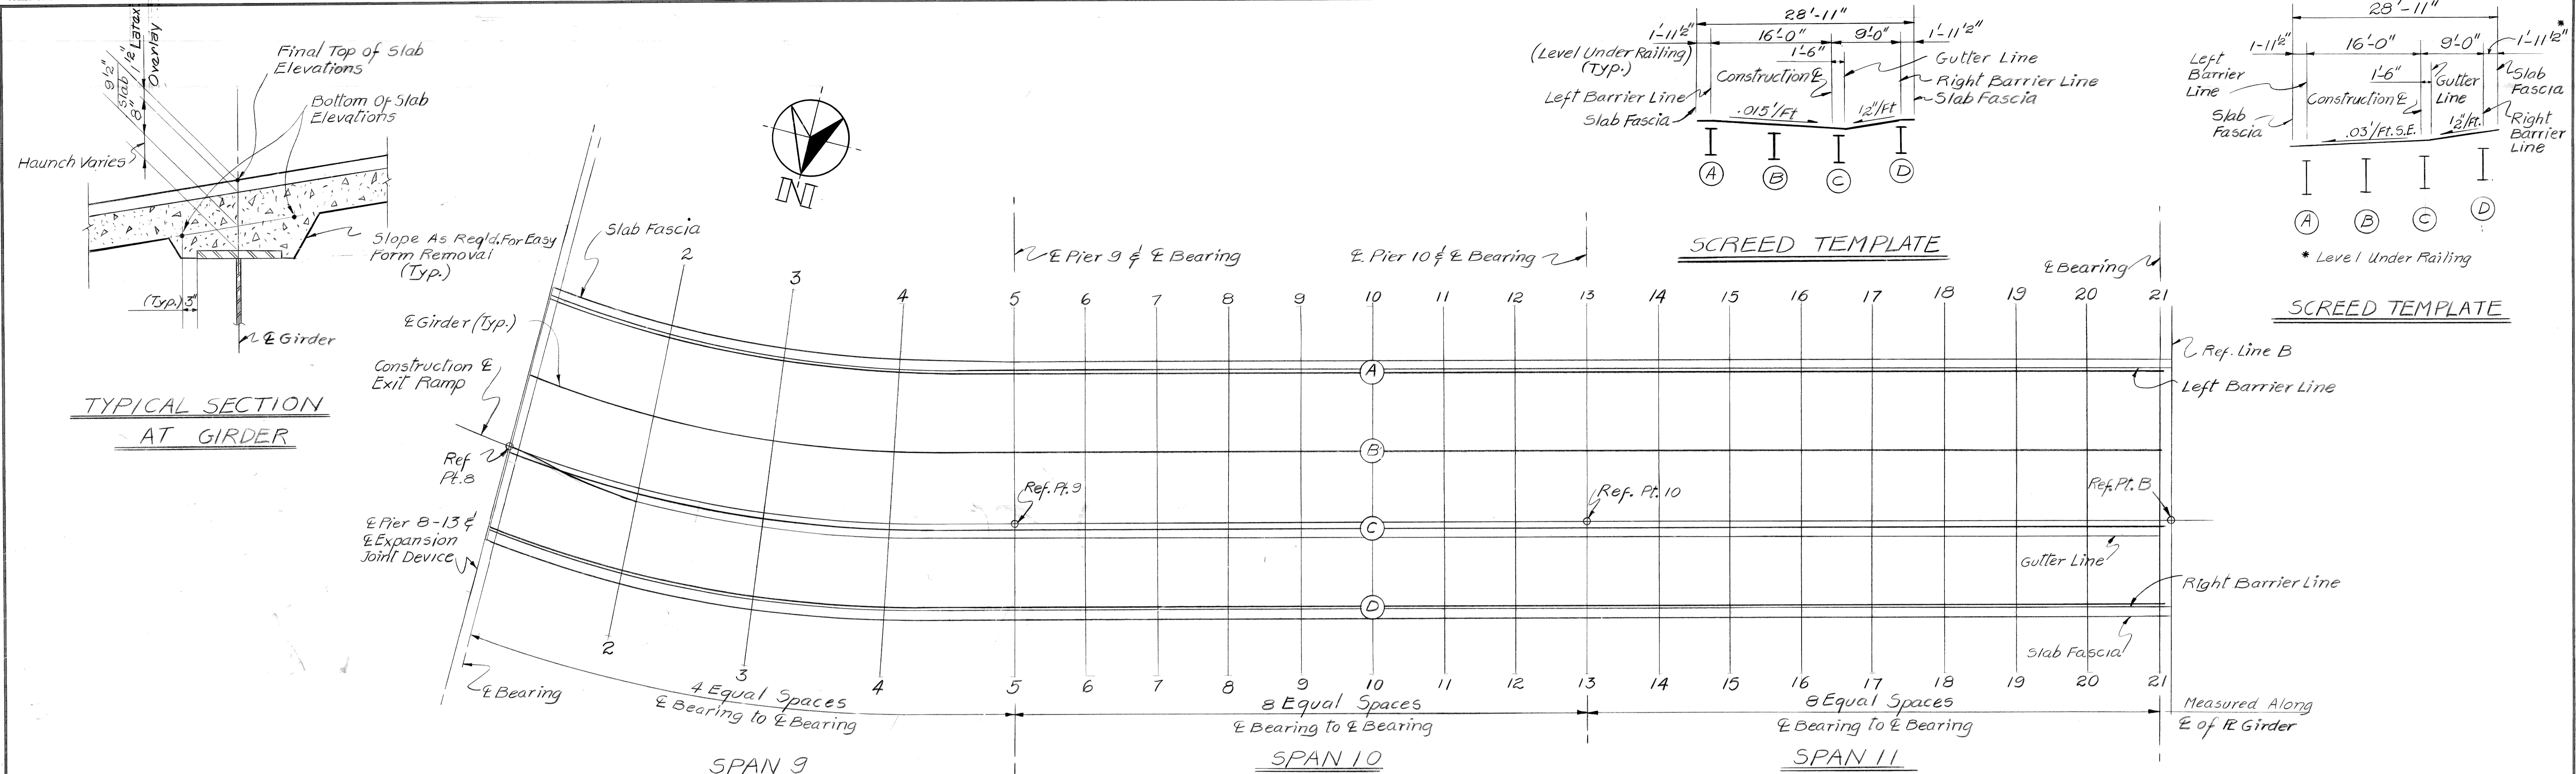

PLAN OF SLAB FOR SCREED & BOTTOM OF SLAB ELEVATIONS

CAMBER DIAGRAM

BOTTOM OF SLAB ELEVATIONS

Line	1-1	2-2	3-3	4-4	5-5	6-6	7-7	8-8	9-9	10-10	11-11	12-12	13-13	14-14	15-15	16-16	17-17	18-18	19-19	20-20	21-21
Girder A Right	120.33	120.12	119.92	119.65	119.35	119.15	118.93	118.69	118.43	118.15	117.84	117.52	117.17	116.77	116.35	115.92	115.47	115.02	114.56	114.09	113.62
Girder B Left	120.51	120.30	120.07	119.77	119.42	119.19	118.96	118.70	118.42	118.11	117.78	117.44	117.07	116.67	116.25	115.82	115.37	114.92	114.46	113.99	113.52
Girder B Right	120.56	120.35	120.11	119.80	119.44	119.21	118.96	118.70	118.41	118.10	117.77	117.42	117.04	116.64	116.23	115.79	115.34	114.89	114.43	113.96	113.49
Girder C Left	120.74	120.54	120.27	119.92	119.51	119.26	118.99	118.70	118.39	118.06	117.71	117.35	116.95	116.55	116.13	115.70	115.25	114.79	114.33	113.87	113.40
Girder C Right	120.87	120.59	120.31	119.95	119.53	119.27	119.00	118.70	118.39	118.05	117.69	117.31	116.92	116.52	116.10	115.67	115.22	114.77	114.31	113.84	113.37
Girder D Left	121.12	120.85	120.58	120.23	119.80	119.54	119.26	118.97	118.66	118.32	117.96	117.58	117.19	116.79	116.37	115.94	115.49	115.04	114.58	114.11	113.64

CAMBER ORDINATES

Girder Dim.	A B C D			
	b	1"	1 1/4"	1 1/2"
e	2"	2 1/4"	2"	2"
h	15/16"	15/16"	15/16"	15/16"
b	15/16"	1 3/16"	1 1/16"	1 5/8"
e	2"	2 1/4"	2"	2"
h	7/8"	7/8"	7/8"	7/8"
b	7/8"	1 1/8"	1 1/2"	1 3/8"
e	1 7/8"	2 1/8"	1 7/8"	1 7/8"
h	1 1/2"	1 1/2"	1 1/2"	1 1/2"

SCREED ELEVATIONS

Screed Line	1-1	2-2	3-3	4-4	5-5	6-6	7-7	8-8	9-9	10-10	11-11	12-12	13-13	14-14	15-15	16-16	17-17	18-18	19-19	20-20	21-21
Left Barrier Line	120.97	120.75	120.56	120.30	120.00	119.80	119.59	119.35	119.10	118.82	118.52	118.20	117.85	117.45	117.03	116.60	116.15	115.70	115.23	114.77	114.30
Gutter Line	121.50	121.25	120.97	120.62	120.19	119.94	119.66	119.37	119.05	118.72	118.36	117.98	117.59	117.19	116.77	116.33	115.88	115.43	114.97	114.50	114.04
Right Barrier Line	121.93	121.56	121.28	120.94	120.51	120.25	119.97	119.68	119.37	119.03	118.67	118.29	117.90	117.50	117.08	116.64	116.20	115.74	115.28	114.82	114.35

FINAL TOP OF SLAB ELEVATIONS





Line	1-1	2-2	3-3	4-4	5-5	6-6	7-7	8-8	9-9	10-10	11-11	12-12	13-13	14-14	15-15	16-16	17-17	18-18	19-19	20-20	21-21
Girder A E	121.10	120.88	120.68	120.42	120.13	119.93	119.71	119.47	119.21	118.94	118.64	118.33	117.97	117.56	117.14	116.69	116.24	115.78	115.33	114.88	114.42
Girder B E	121.33	121.11	120.87	120.57	120.22	119.99	119.74	119.48	119.19	118.89	118.56	118.22	117.85	117.44	117.01	116.57	116.11	115.66	115.21	114.75	114.30
Girder C E	121.59	121.34	121.06	120.72	120.31	120.05	119.78	119.49	119.17	118.84	118.49	118.12	117.73	117.32	116.89	116.44	115.99	115.54	115.08	114.63	114.18
Girder D E	121.94	121.66	121.38	121.04	120.63	120.37	120.09	119.79	119.48	119.14	118.78	118.41	118.02	117.61	117.18	116.74	116.28	115.83	115.38	114.92	114.47

Stage 2 - E girders erected with diaphragms in place, no other loads applied. Camber ordinates includes allowances for: forms, deck concrete steel reinforcement, Vertical Curves and railings

Stage 3 - Forms, shear developers and steel reinforcement in place, all spans complete. Camber ordinates includes allowance for Deck concrete, Vertical Curve and railings.

Stage 4 - Deck concrete and railing cast, all spans complete. Camber ordinates includes allowance for Vertical Curve.

Work This Sheet With Sheets # S64 thru S80 & S82

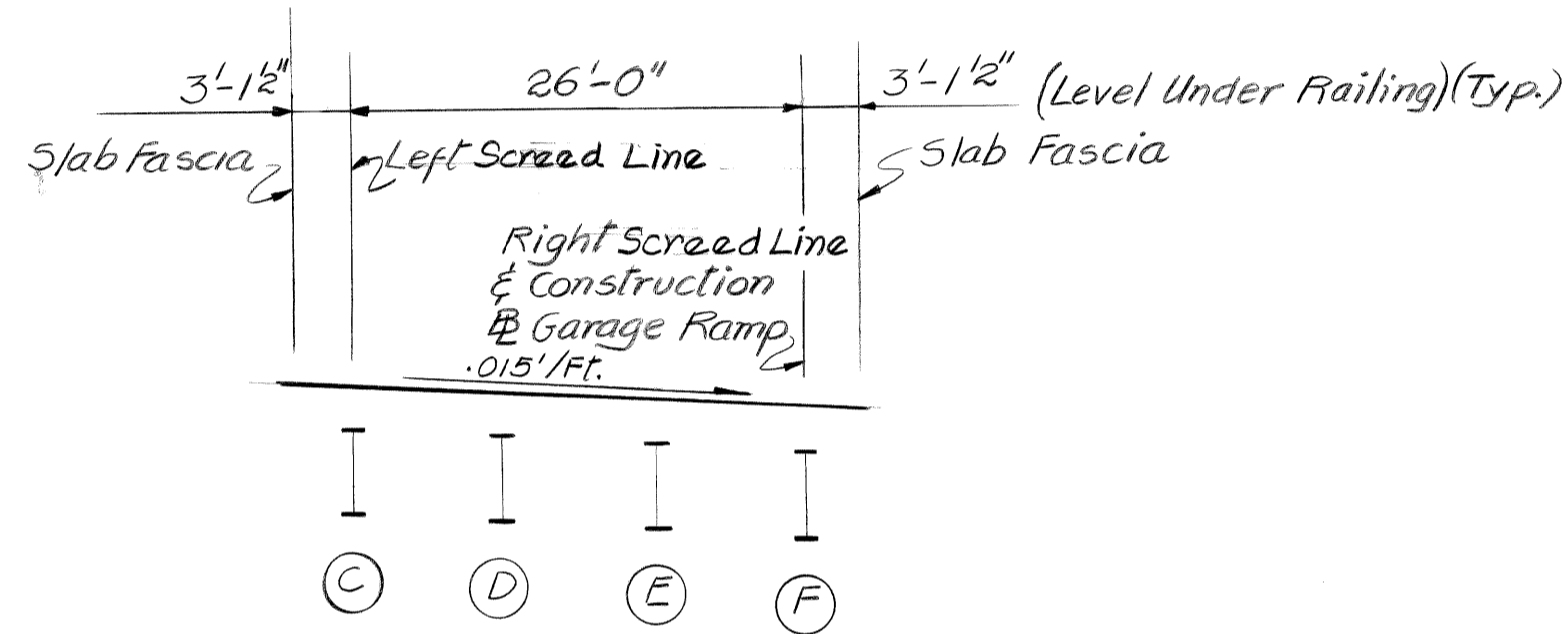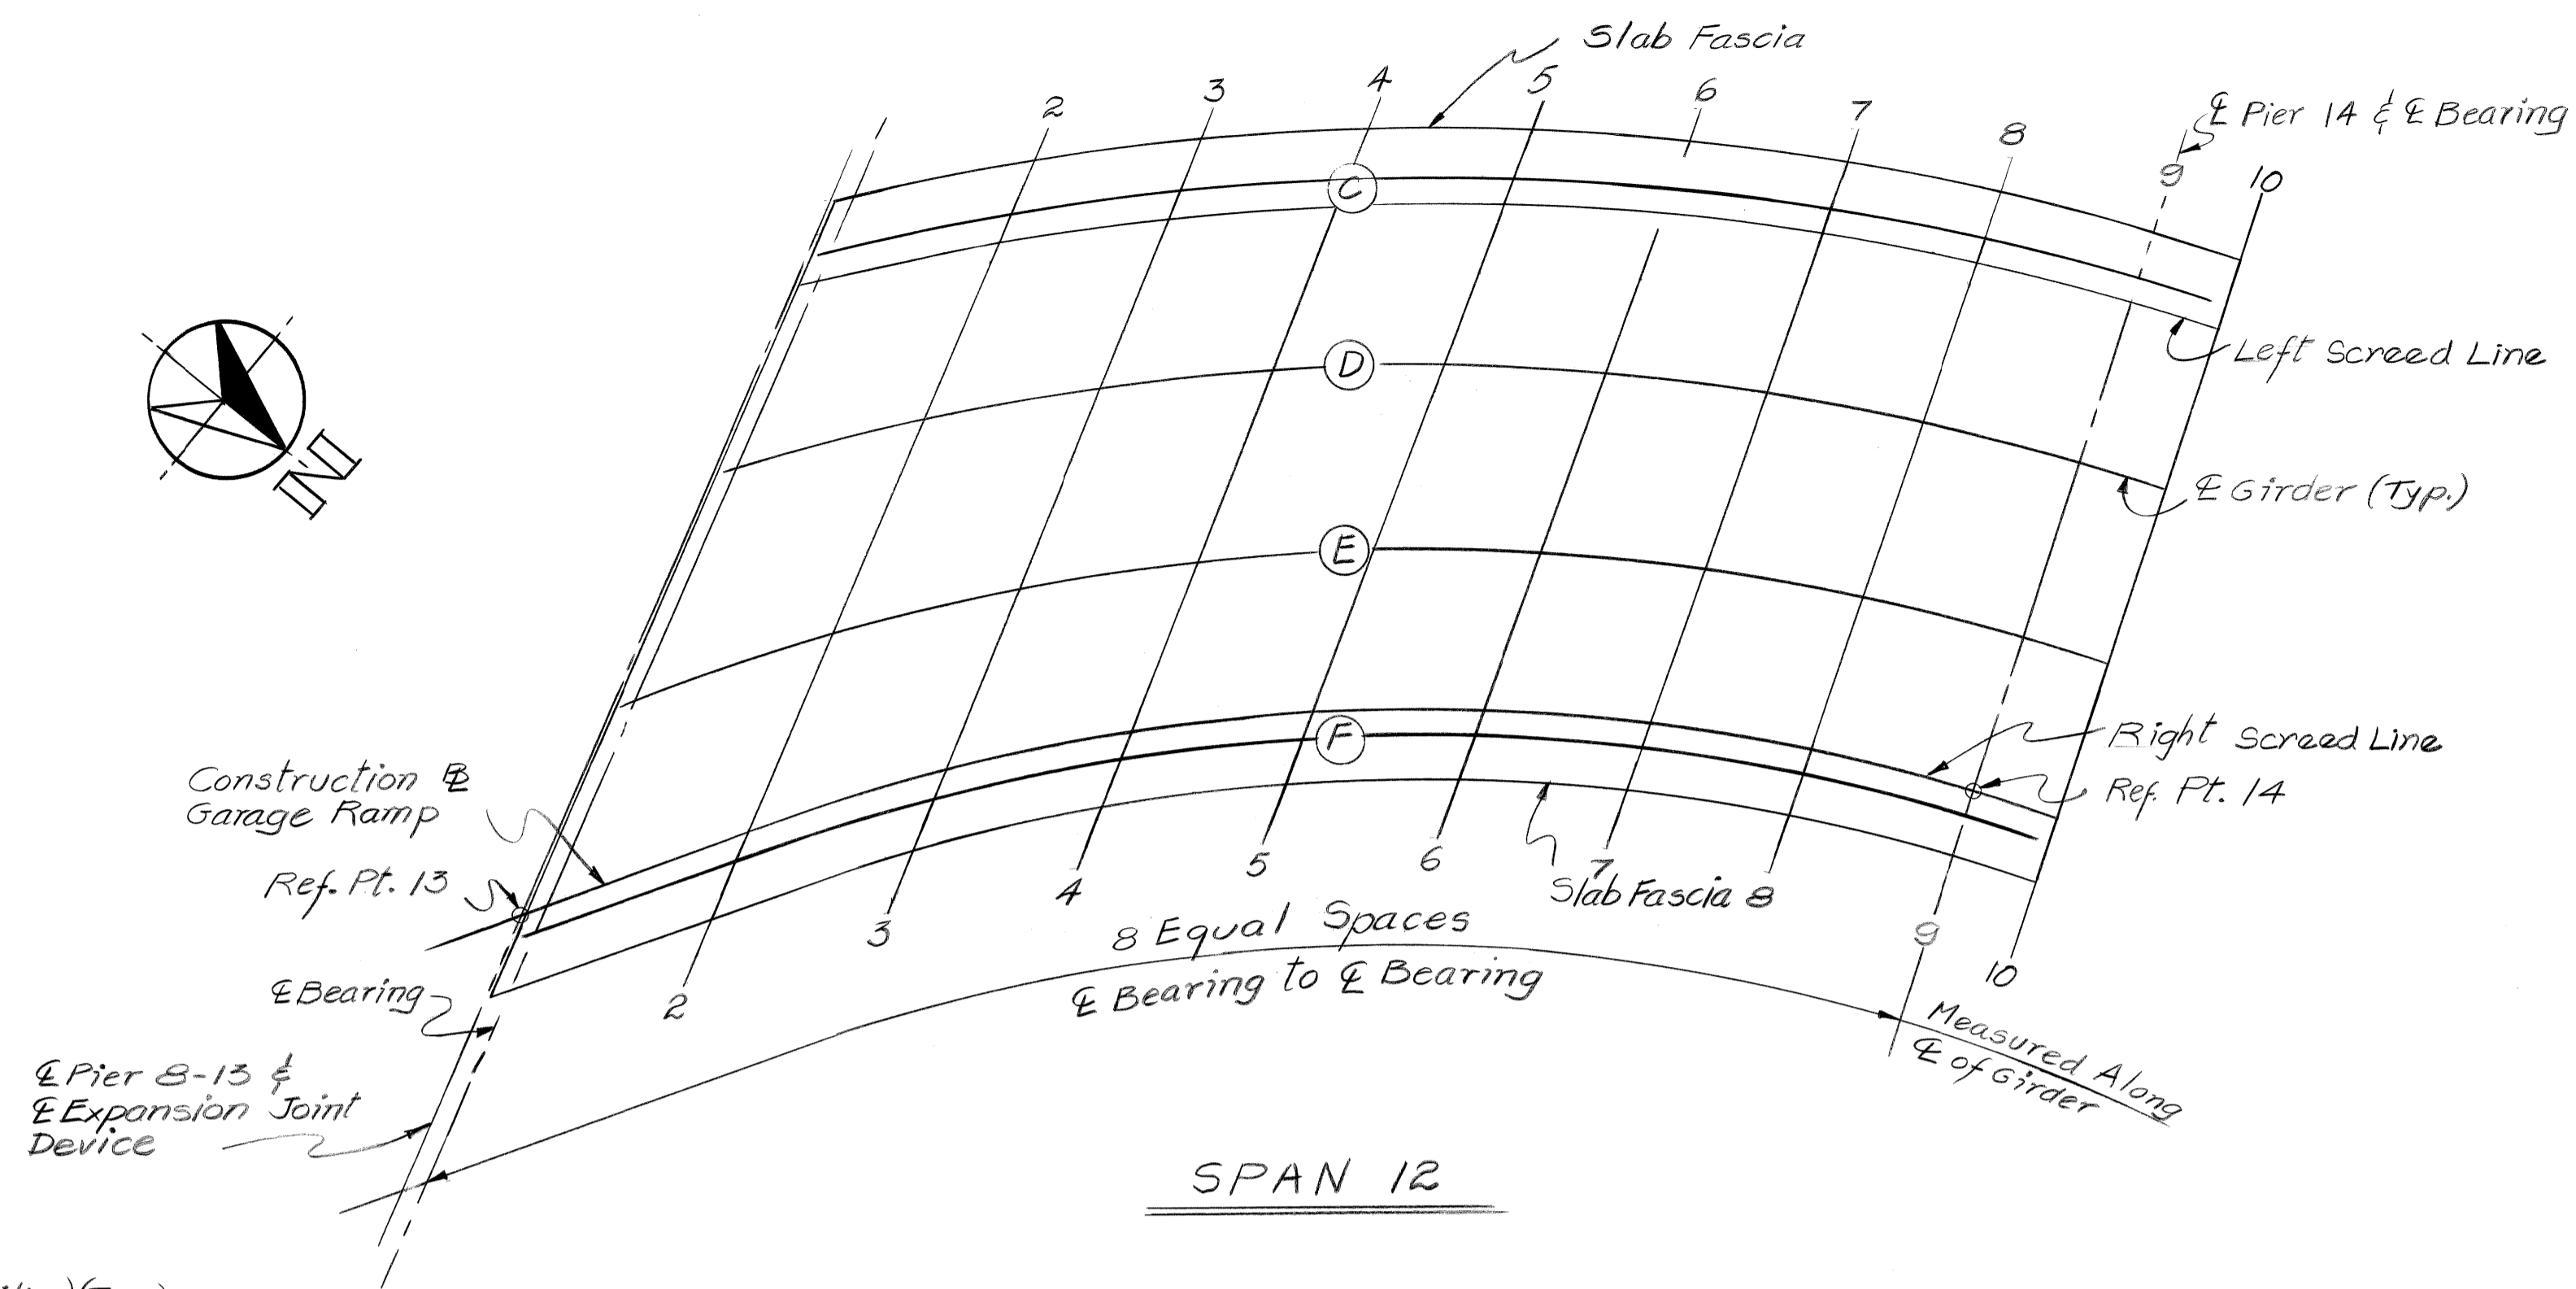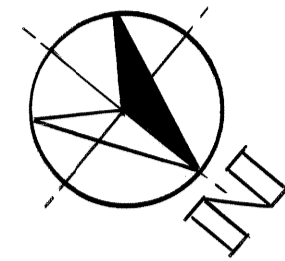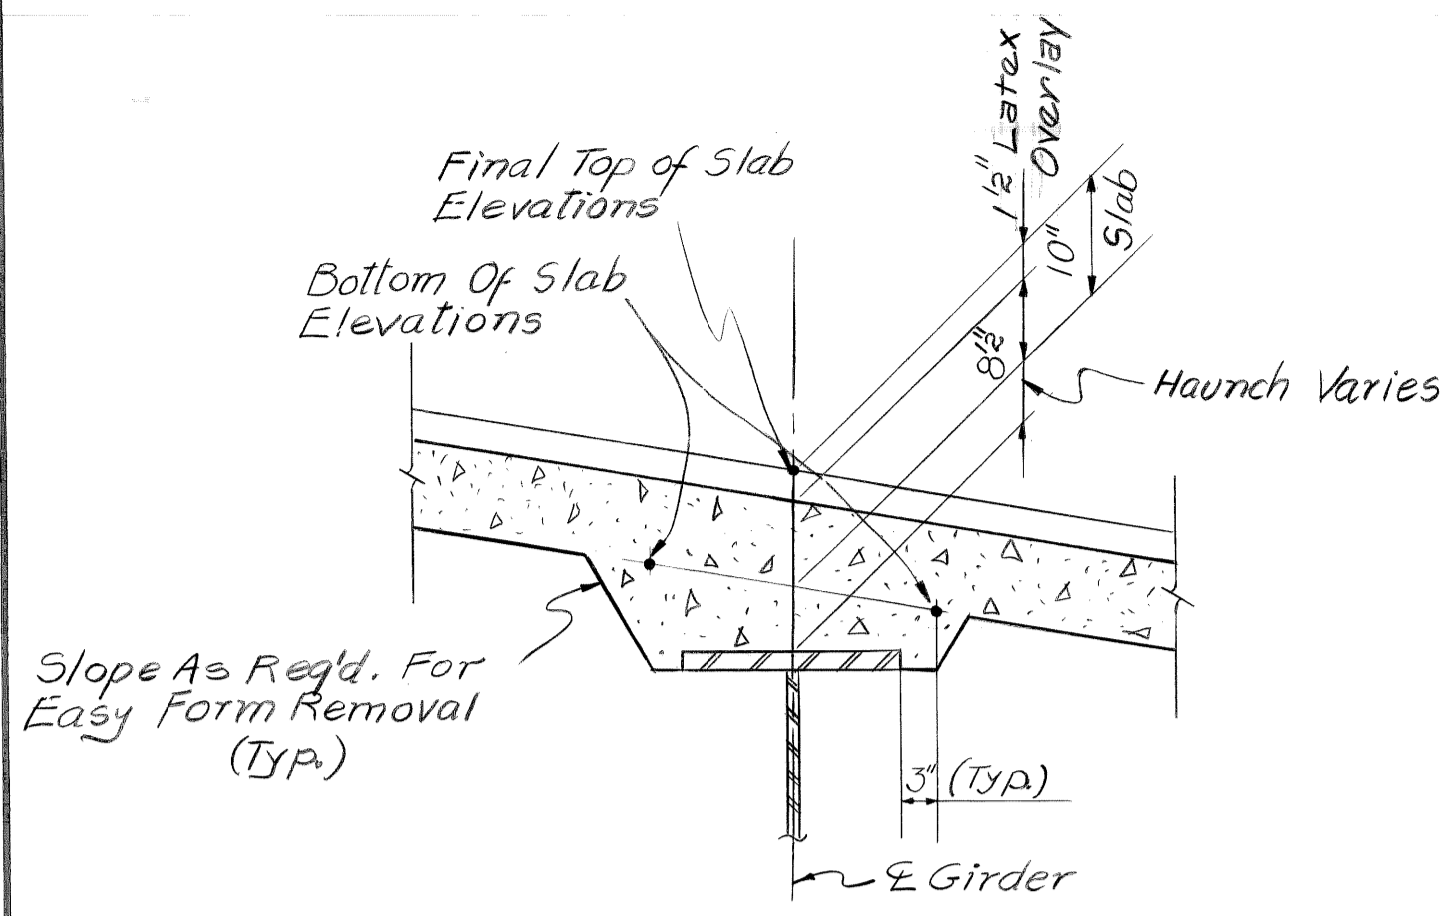


BOTTOM OF SLAB ELEVATIONS

Line	1-1	2-2	3-3	4-4	5-5	6-6	7-7	8-8	9-9	10-10
Girder C Right	121.35	121.57	121.82	122.08	122.28	122.46	122.58	122.67	122.72	122.77
Girder D Left	121.12	121.31	121.55	121.83	122.08	122.28	122.43	122.54	122.60	122.64
Girder D Right	121.10	121.29	121.53	121.80	122.05	122.25	122.41	122.51	122.58	122.62
Girder E Left	120.88	121.03	121.24	121.51	121.80	122.05	122.23	122.37	122.46	122.47
Girder E Right	120.86	121.01	121.22	121.48	121.78	122.02	122.21	122.35	122.44	122.45
Girder F Left	120.70	120.75	120.88	121.10	121.40	121.71	121.96	122.17	122.32	122.36

CAMBER ORDINATES

Stage	Dim.	Girder			
		C	D	E	F
Stage 2	b	2 1/8"	2 1/8"	1 1/2"	-1 1/2"
	d	3/16"	3/16"	7/16"	-4"
Stage 3	b	2 3/4"	2 1/2"	1 5/8"	-1 1/2"
	d	3/16"	1/8"	3/8"	-4"
Stage 4	b	1 5/8"	1 3/8"	4"	-1 1/8"
	d	-3/16"	-1/4"	-1/8"	-1 1/8"

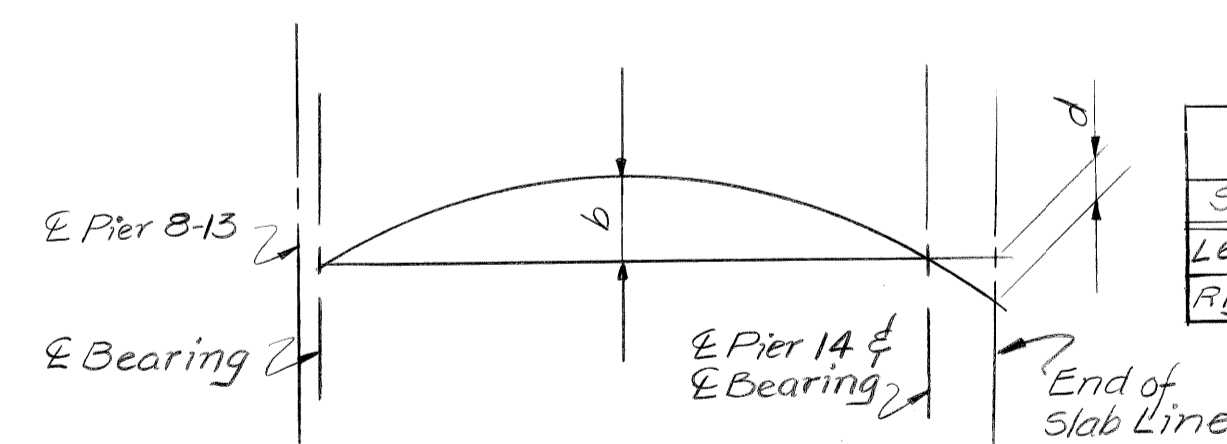

SCREED ELEVATIONS

Screed Line	1-1	2-2	3-3	4-4	5-5	6-6	7-7	8-8	9-9	10-10
Left Barrier Line	122.05	122.26	122.50	122.76	122.97	123.14	123.28	123.37	123.43	123.48
Right Barrier Line	121.41	121.47	121.61	121.83	122.12	122.43	122.68	122.88	123.05	123.07

FINAL TOP OF SLAB ELEVATIONS

Line	1-1	2-2	3-3	4-4	5-5	6-6	7-7	8-8	9-9	10-10
Girder C E	122.19	122.36	122.57	122.80	123.01	123.18	123.33	123.46	123.55	123.63
Girder D E	121.94	122.09	122.29	122.55	122.79	123.00	123.17	123.31	123.42	123.50
Girder E E	121.70	121.82	121.99	122.23	122.52	122.77	122.98	123.15	123.28	123.34
Girder F E	121.54	121.58	121.71	121.93	122.23	122.54	122.79	123.00	123.15	123.20

Stage 2 - IR girders erected with diaphragms in place, no other loads applied. Camber ordinates includes allowances for: forms, deck concrete, steel reinforcement, Vertical Curve and railings.

Stage 3 - Forms, shear developers and steel reinforcement in place, all spans complete. Camber ordinates includes allowance for Deck Concrete, Vertical Curve and railings.

Stage 4 - Deck concrete and railing cast all spans complete. Camber ordinates includes allowance for Vertical Curve.

Work This Sheet With Sheets # S64 thru S81

DATE: August, 1979

DSGN BY:	SJP, RGW
DRN BY:	JB
CK'D BY:	SJP, RGW
APP'D BY:	

REVISIONS	


CITY OF DETROIT




JOHN C. LODGE EXIT RAMP AND JEFFERSON AVENUE-
RECONSTRUCTION AT THE JOE LOUIS ARENA

SUPER STRUCTURE DETAILS
BOTTOM OF SLAB, SCREED, TOP OF SLAB FINAL
ELEVATIONS AND CAMBERS
SPAN 12


SCALE: NONE
DRN. NO: S82

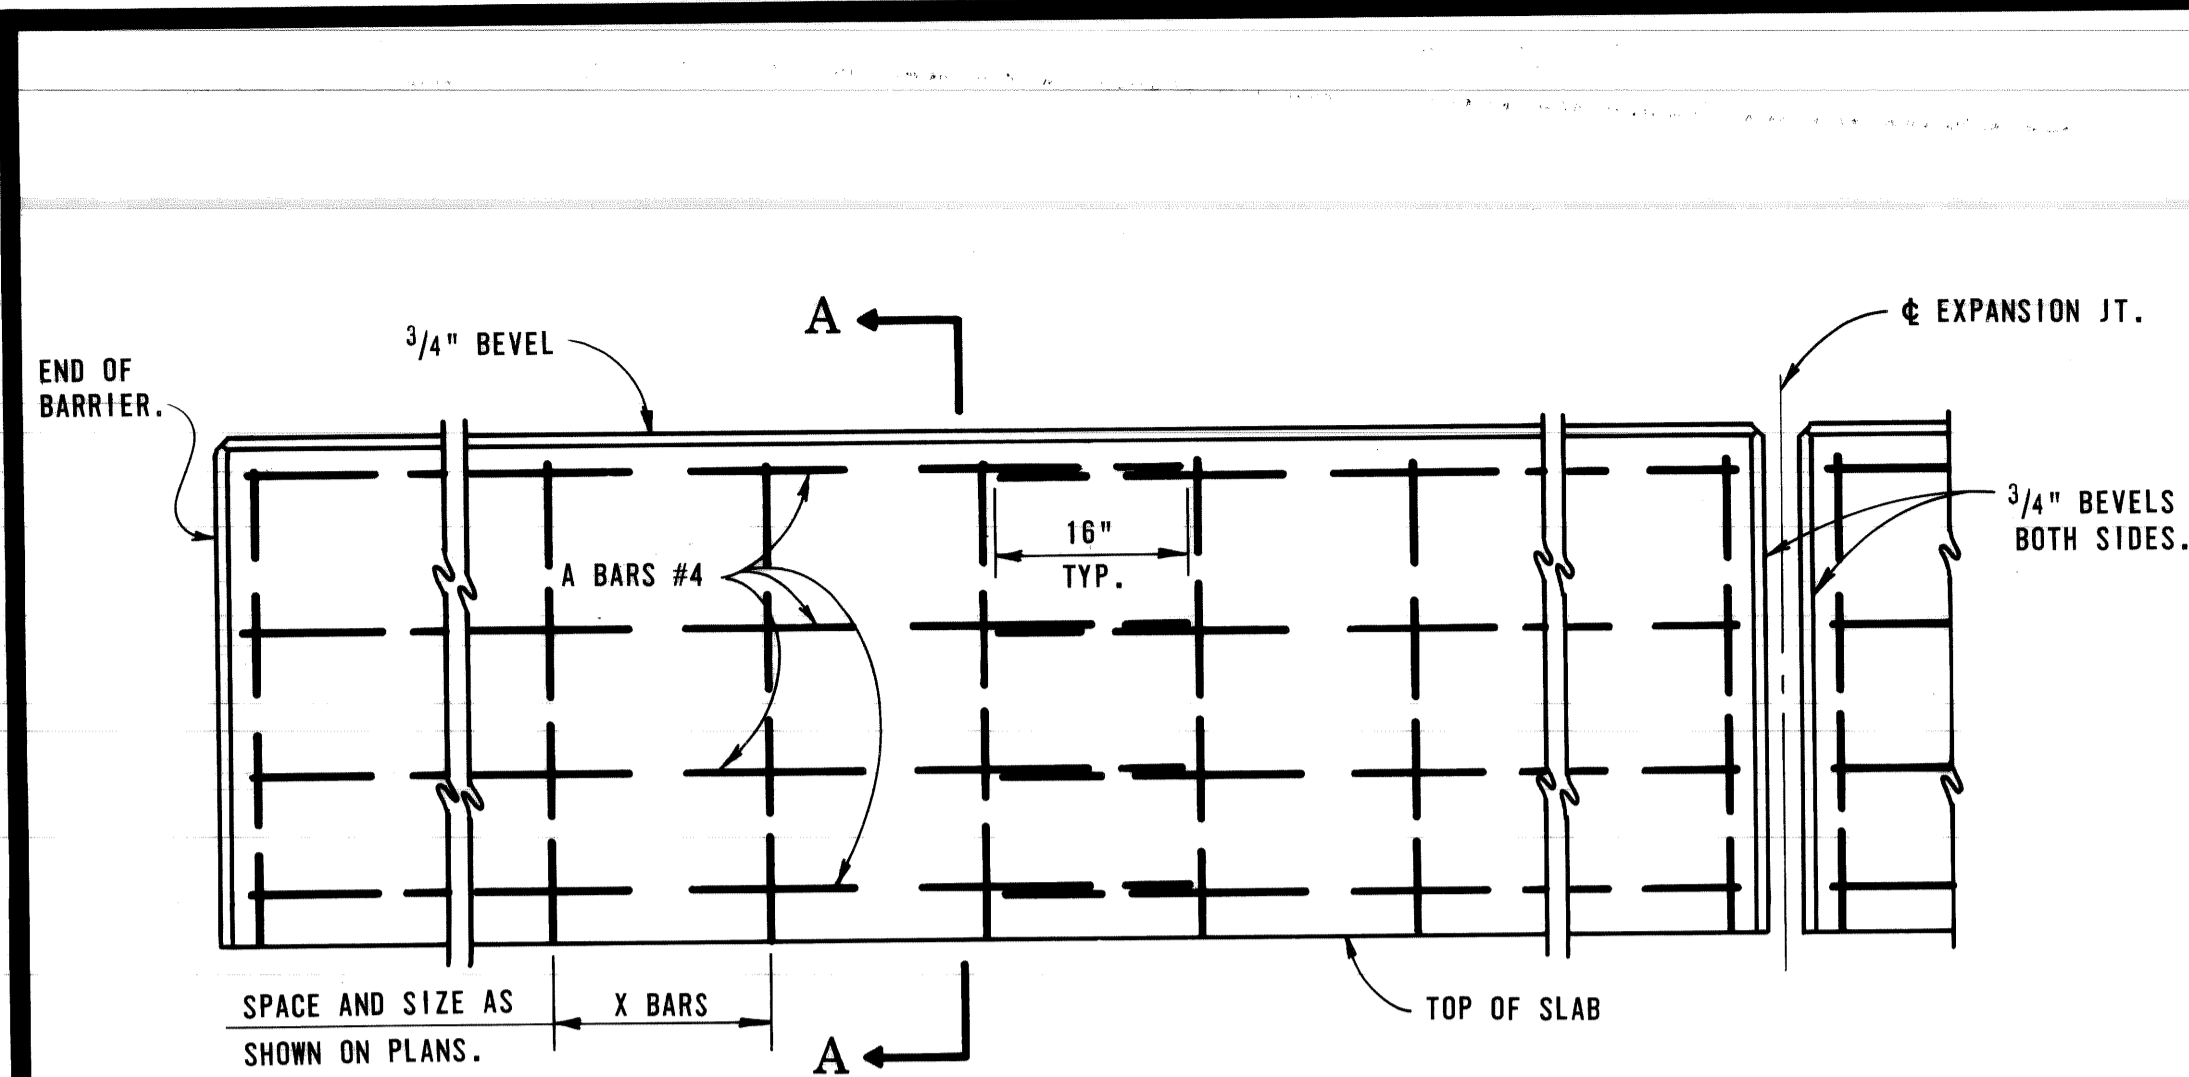


CONCRETE BARRIER - BRIDGE
OUTSIDE ELEVATION

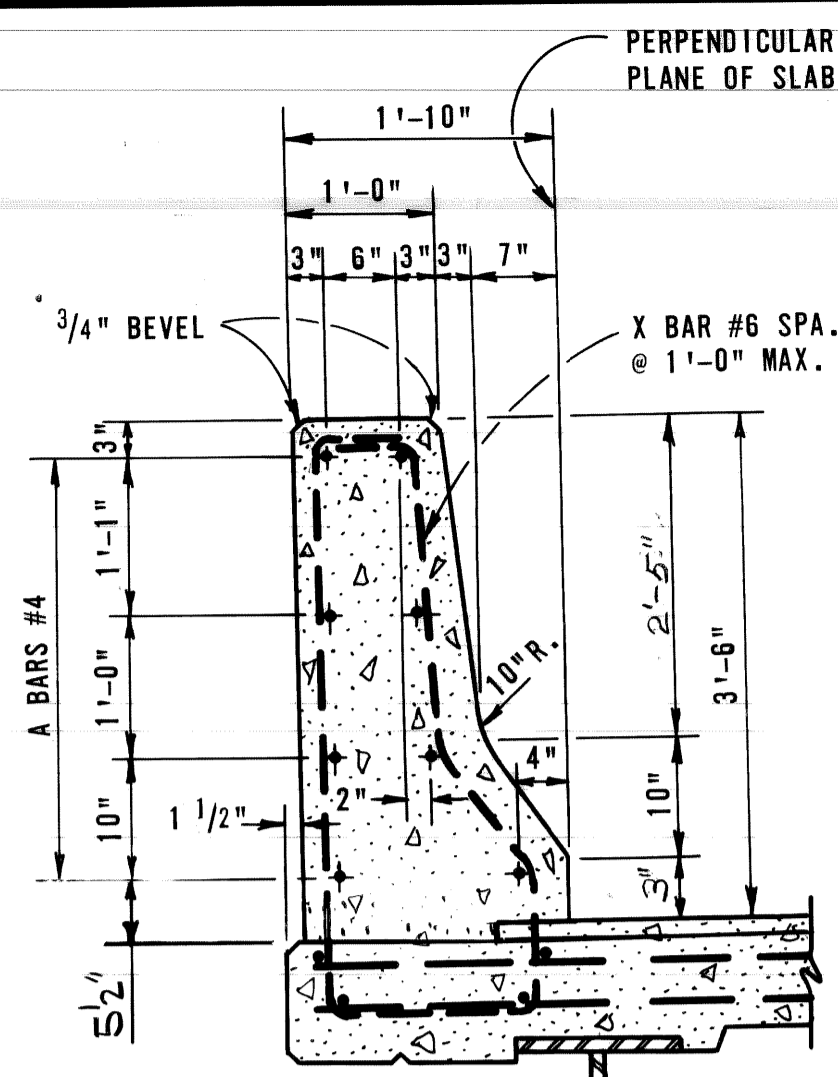

SECTION A - A

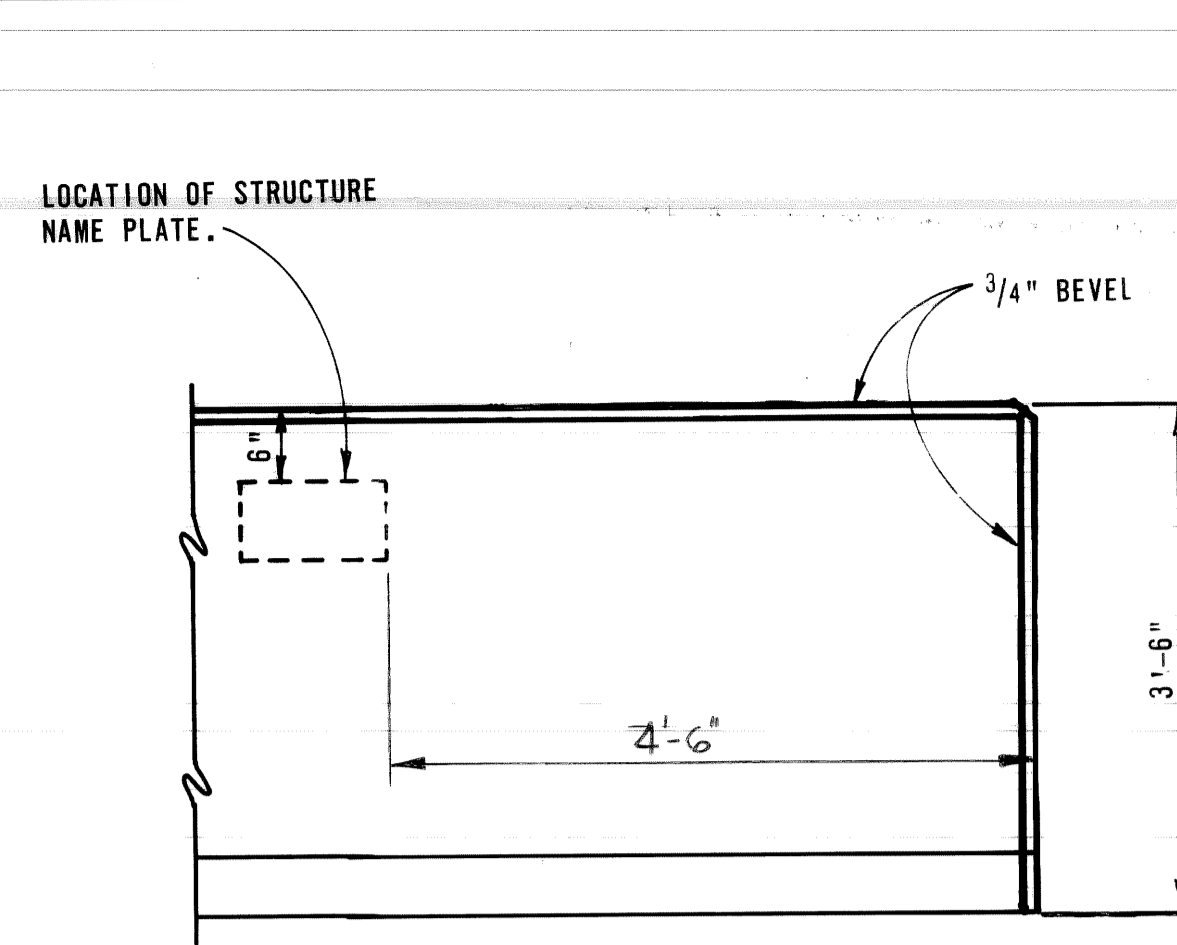


LOCATION OF
GUARD RAIL ANCHORAGE

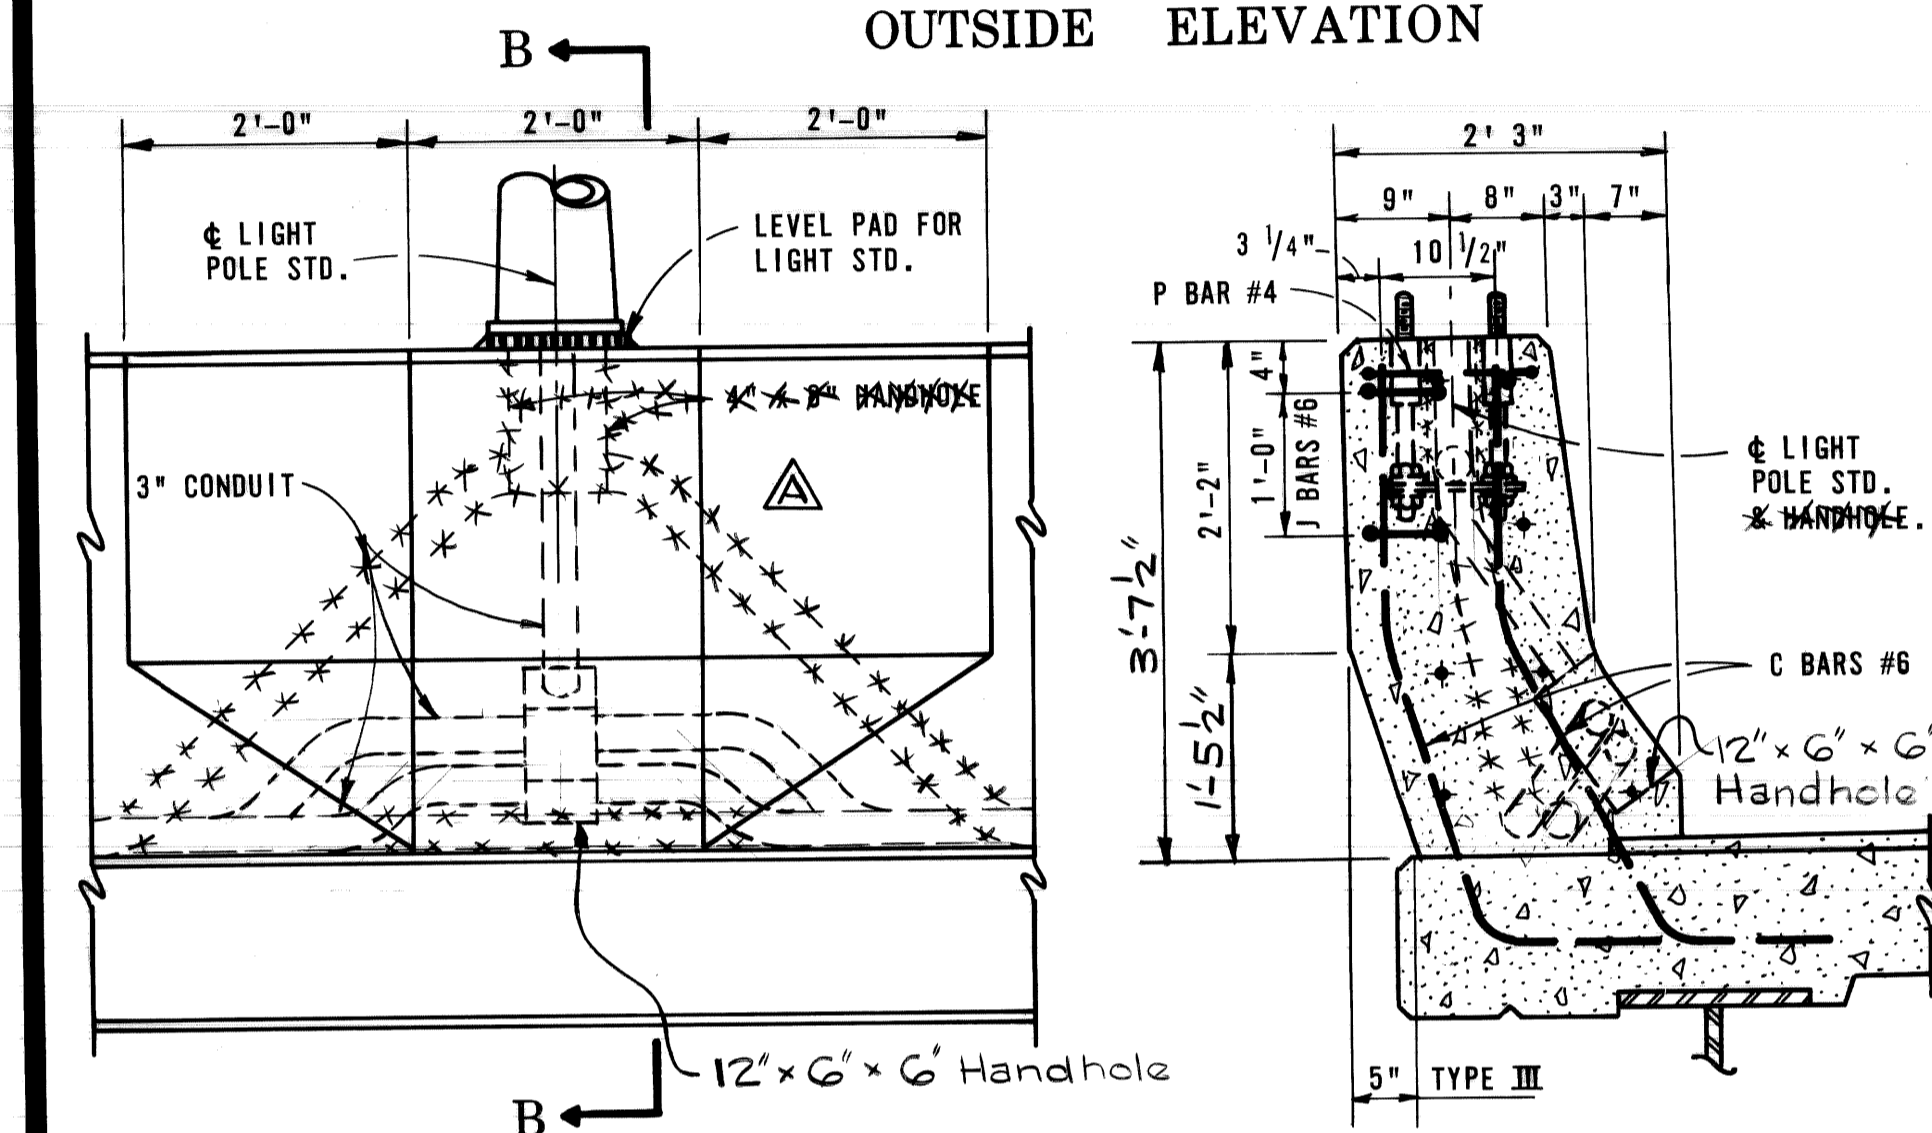


LIGHT STANDARD
ELEVATION VIEW

SECTION B - B

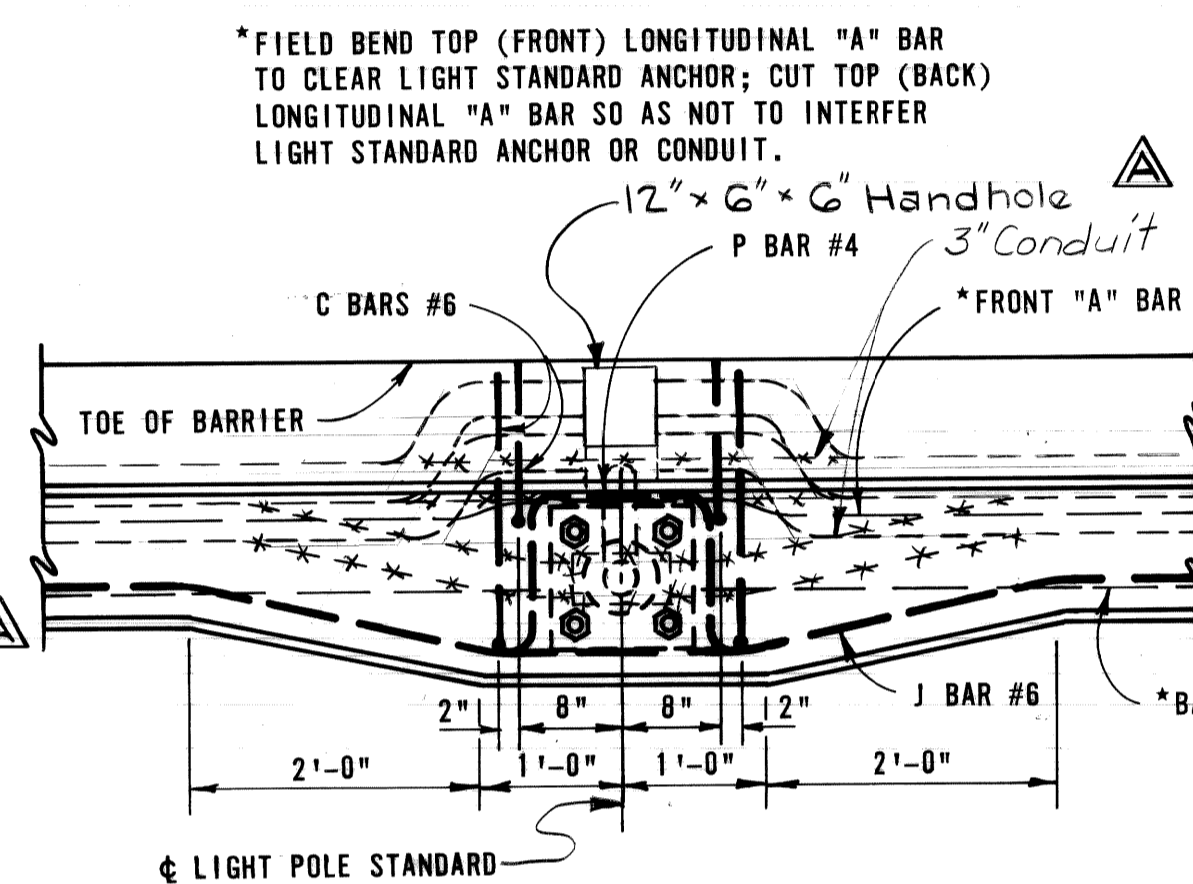

LIGHT STANDARD
PLAN VIEW

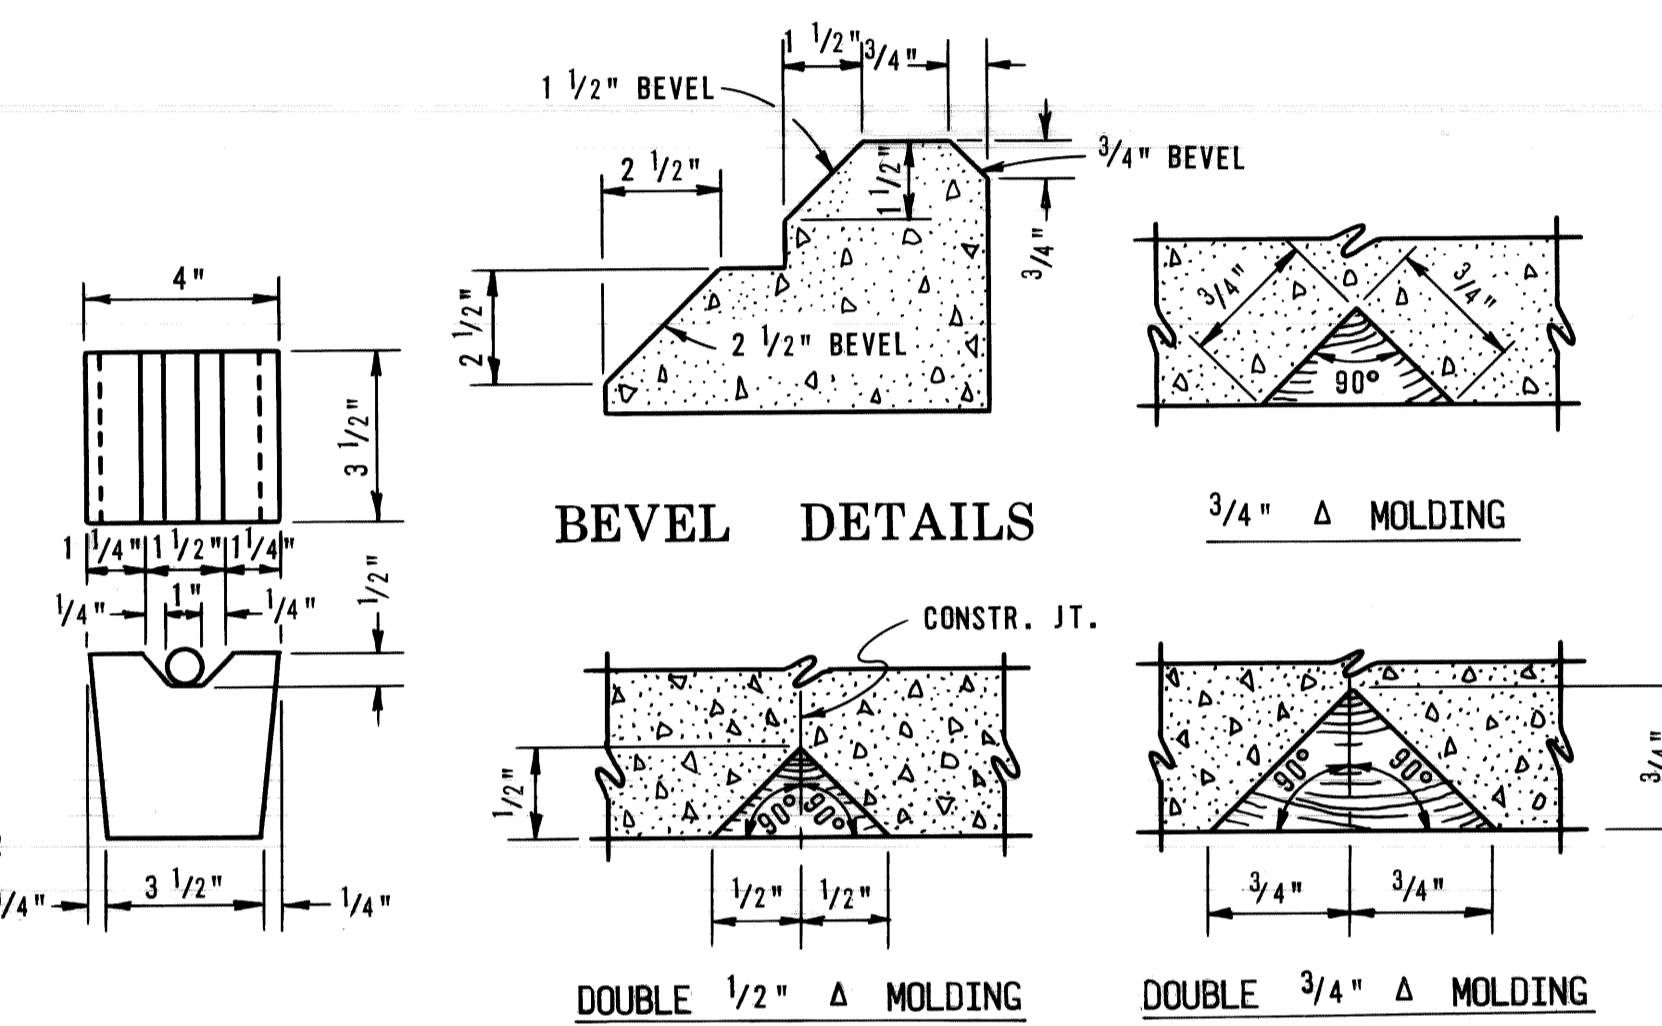


BEVEL DETAILS

MOLDING DETAILS

BAR CHAIR
DETAILS


MERCURY VAPOR LUMINAIRES		ANCHOR BOLT ASSEMBLY			
LIGHT STANDARD MOUNTING	BOLT CIRCLE "A"	ANCHOR BOLT DIA. "B"	"C"	"D"	"E"
	1 1/2"	1"	1 1/2"	9/8"	2 1/2"

NOTE: For Handhole
Use Spring City Electrical
Mfg. Type ER Cat. No.
120606 NEMA 4 Raintight,
Cast Iron Hot Dip Galvanized,
with cover. (12x6x6)

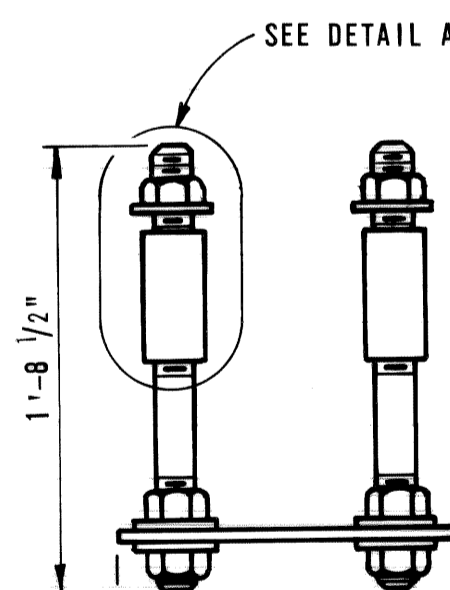


ANCHOR BOLT
ASSEMBLY


"B" ϕ x 1'-0" THREADED ROD AND "B" ϕ x 6" STUD WITH 3
HEX NUTS 3 WASHERS, AND ONE COUPLING.
ANCHOR BOLT ASSEMBLY:
THE ASSEMBLY SHALL BE GALVANIZED IN ACCORDANCE WITH
A.S.T.M. A-153.

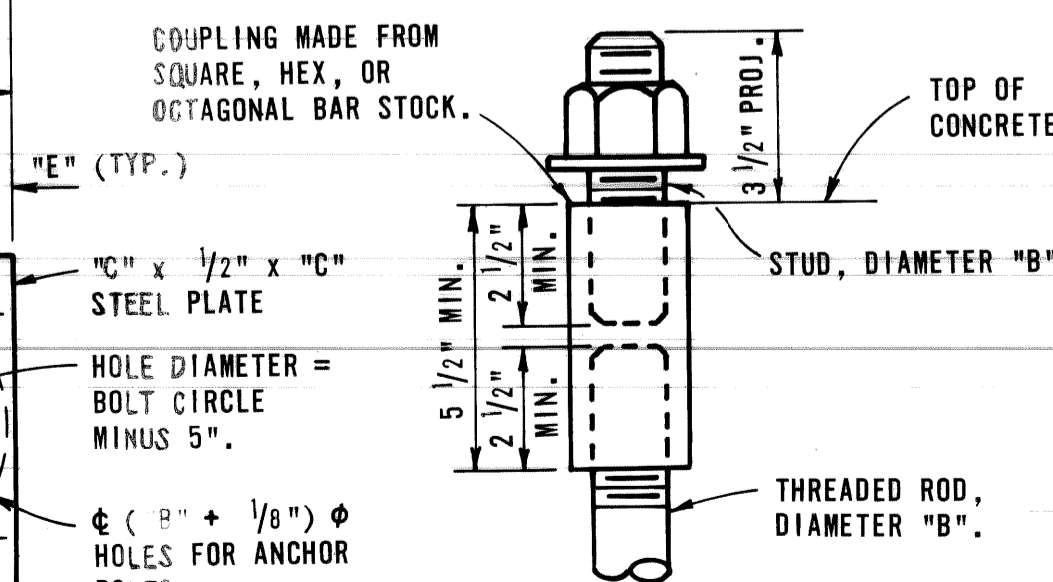

DETAIL A

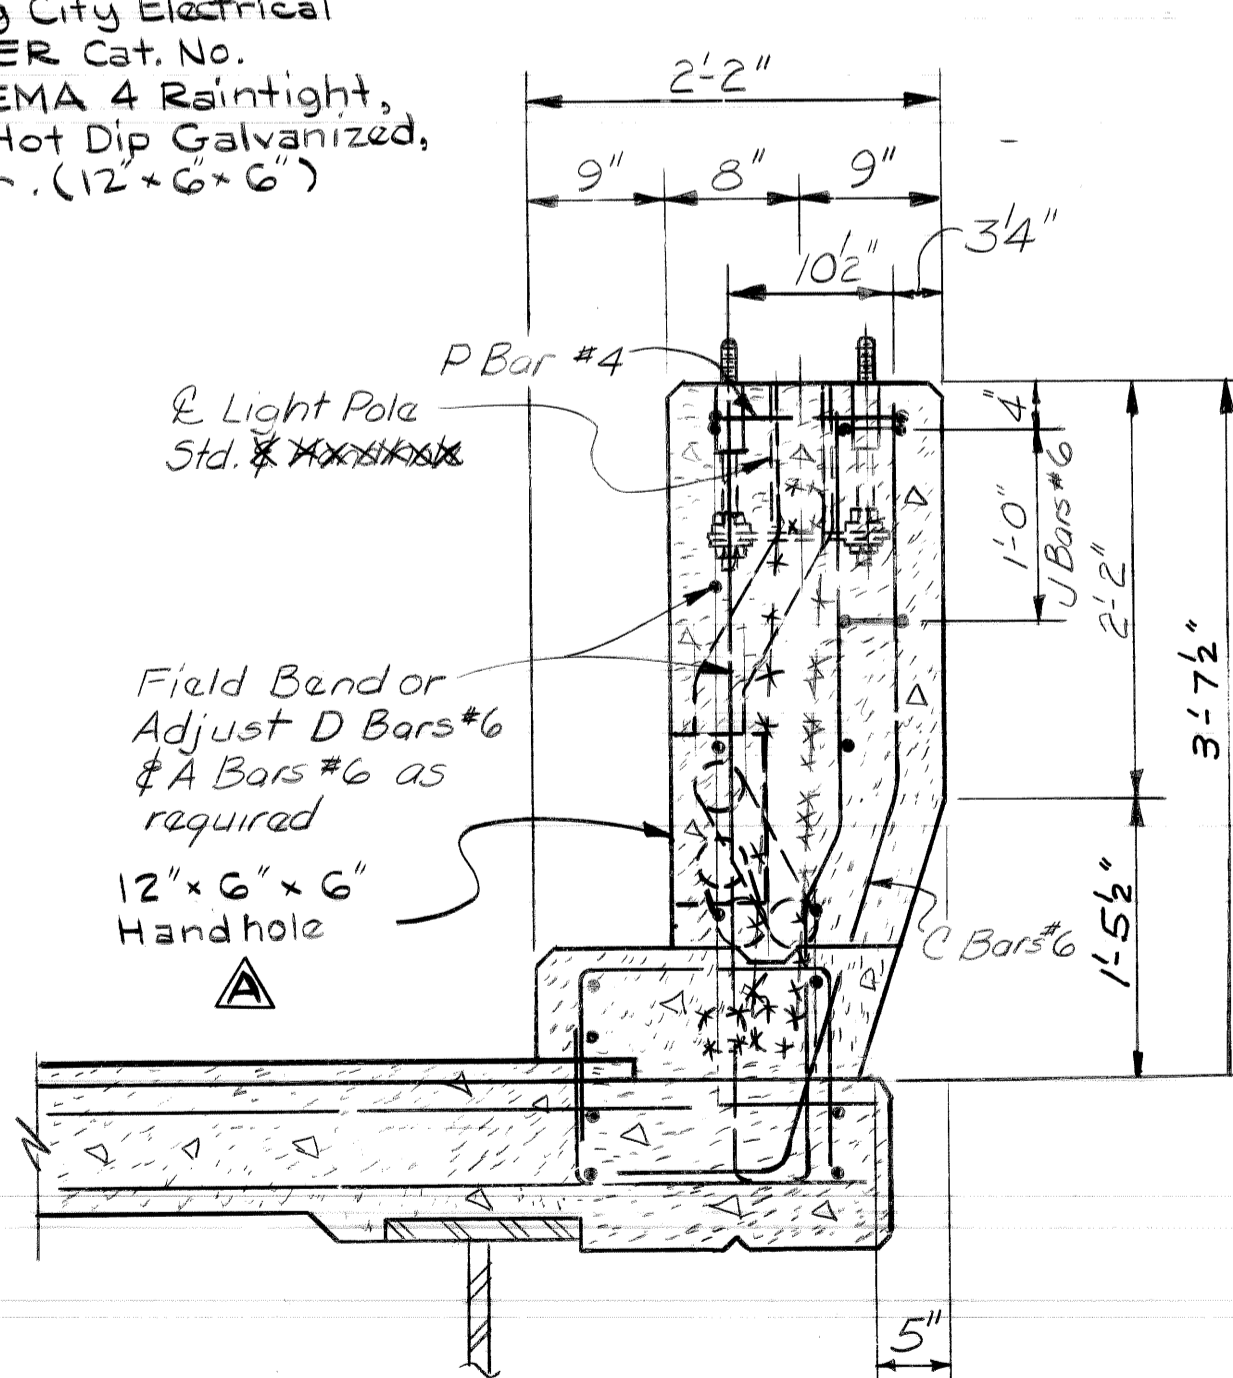


SECTION C - C

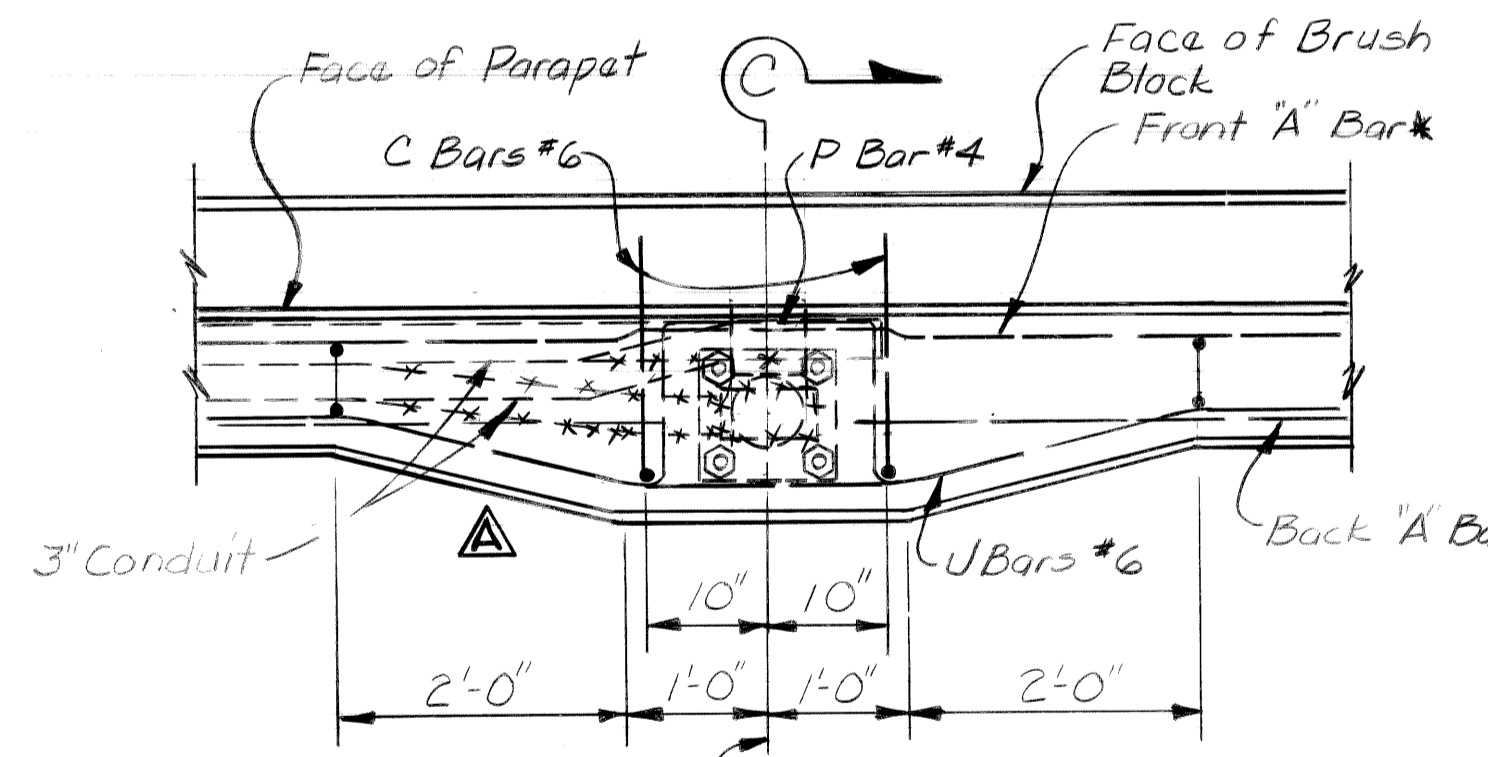

LIGHT STANDARD - SPECIAL PLAN VIEW

* Field Bend Top (Front) Longitudinal "A" Bar to clear
light standard anchor; cut top (back) longitudinal
A Bar so not to interfere light standard
anchor or conduit.

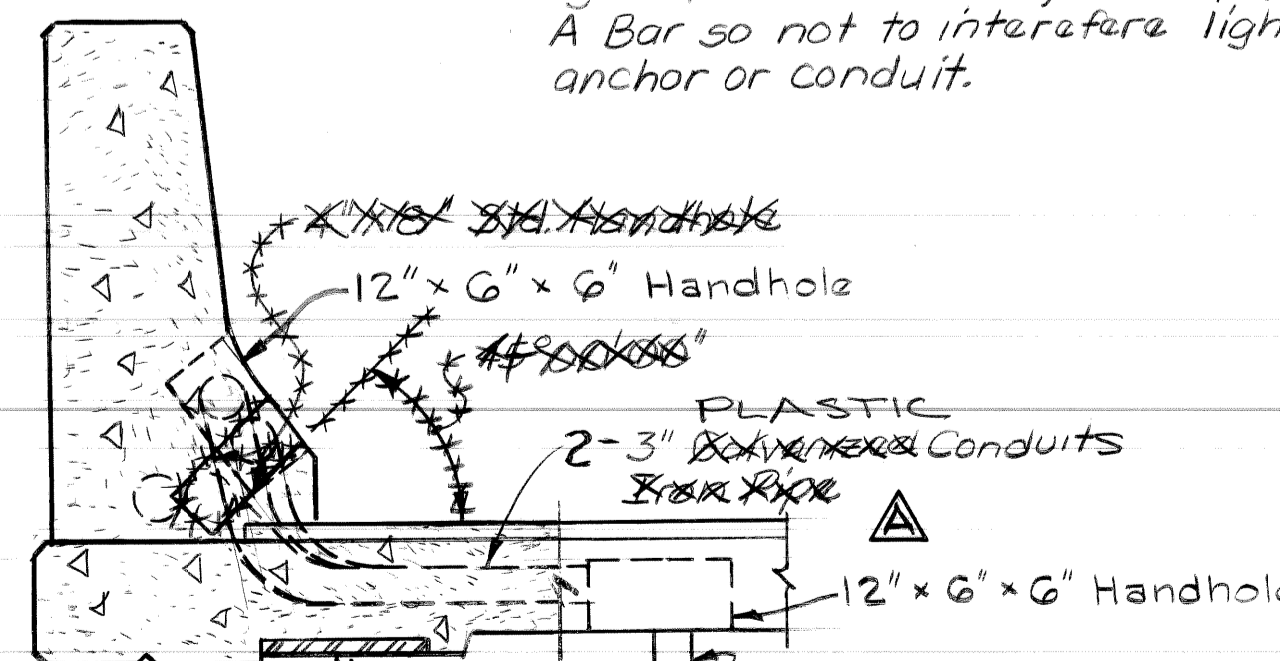

SPECIAL HANDHOLE DETAIL
(See Span 8 Superstructure Details)

REVISIONS
▲ New Handhole Detail, Reposition Handhole Add Notes/SJP 11-15-79

NOTES:

CONCRETE BARRIER - BRIDGE OF THE TYPE CALLED FOR WILL BE PAID FOR AT THE CONTRACT UNIT PRICE PER LINEAL FOOT, WHICH PRICE INCLUDES PAYMENT IN FULL FOR ALL WORK AND MATERIAL ABOVE TOP OF SLAB, EXCEPT STEEL REINFORCEMENT WHICH WILL BE PAID FOR SEPARATELY. LENGTH OF RAIL IS MEASURED FROM END TO END OF BARRIER WITH NO DEDUCTION FOR EXPANSION JOINTS.

THE STEEL PLATE AND THE NECESSARY MOUNTING HARDWARE LOCATED AT THE LIGHT STANDARD ARE INCIDENTAL TO THE BARRIER. THE PLATE AND ALL HARDWARE SHALL BE GALVANIZED IN ACCORDANCE WITH A.S.T.M. DESIGNATION A123. ALL WORK AND MATERIAL REQUIRED FOR PREPARATION AND GALVANIZING ARE INCIDENTAL.

A RUBBED SURFACE FINISH IS NOT REQUIRED ON THE BARRIER RAILING.

CONCRETE BARRIER - BRIDGE SHALL BE CONSTRUCTED IN ACCORDANCE WITH SECTION 6.12 OF THE STANDARD SPECIFICATIONS.



▲ The handholes shall be placed in the bottom of the slab span 8 at opposite slab fascias and towards the interior of the fascia girders. The slab steel reinforcement shall be adjusted, as required, to permit placement of the handholes. The handholes will be placed over the north half of the pier cap of Pier 7-12. Vertical pieces of conduit will extend from the bottom of the slab, at the handholes, to the top of the pier cap and shall be connected by a horizontal length of conduit that is securely fastened to the top of the pier cap of Pier 7-12. Installation shall meet the approval of the Engineer.

DATE: August, 1979

STATE OF MICHIGAN
DEPARTMENT OF STATE HIGHWAYS AND TRANSPORTATION

BARRIER RAILING, LIGHT STANDARD,
BAR CHAIR, MOLDING AND BEVEL DETAILS

APPROVED:	J. C. Trasky	4/24/79	DATE
APPROVED:	DESIGN SUPERVISING ENGINEER	4/24/79	DATE
	ENGINEER - BRIDGE DESIGN		
SQUAD BOSS	W. D. B.	11-13-78	
DRAWN BY	J. L. R.	11-13-78	
REVISED BY	K. G. R.	11-13-78	
CHECKED BY	W. D. B.	11-13-78	
			SHEET OF
			DRN. NO. S83

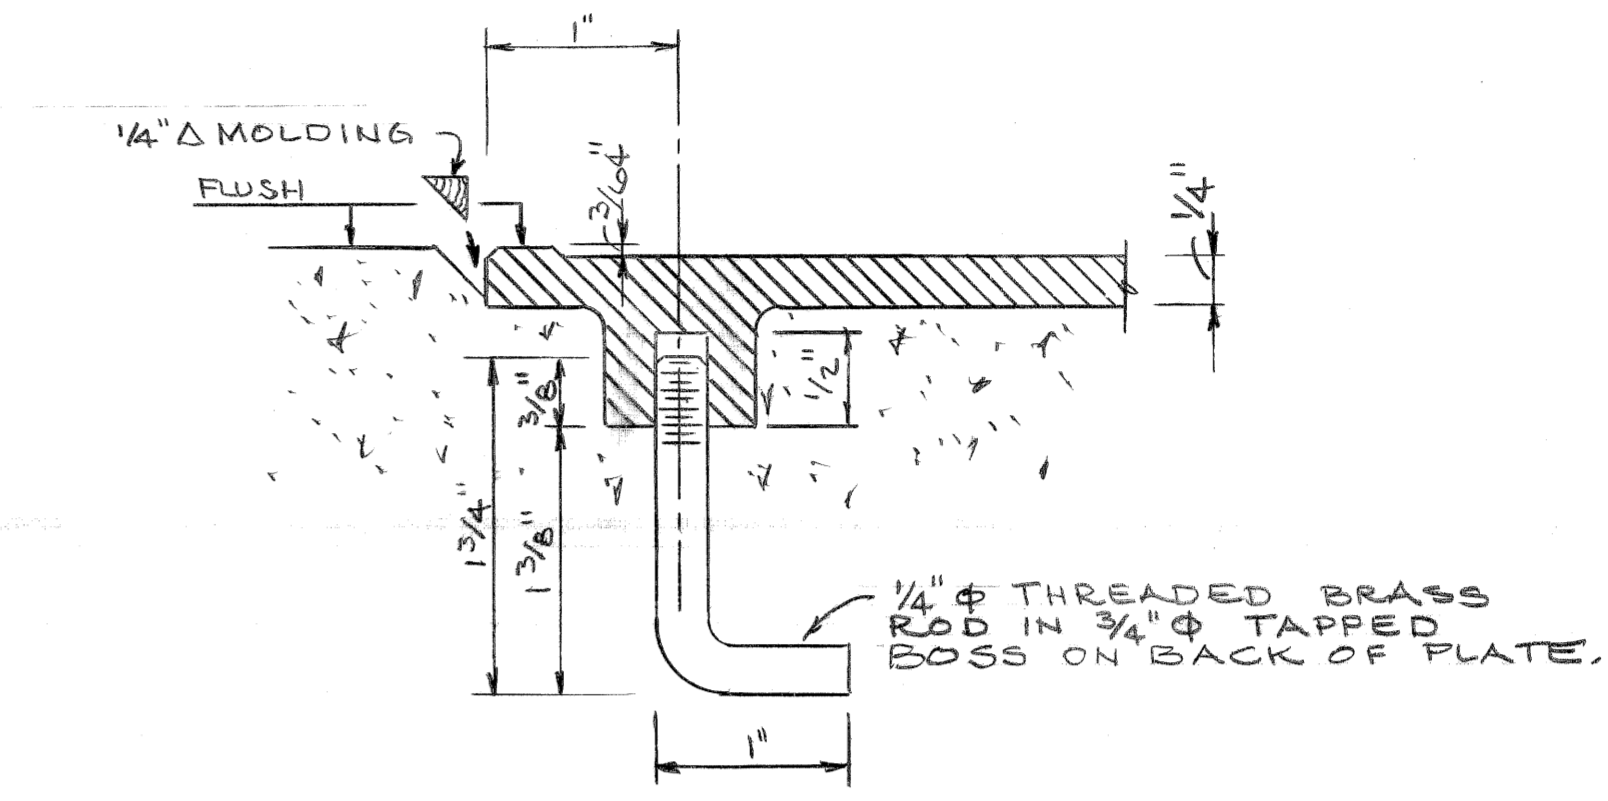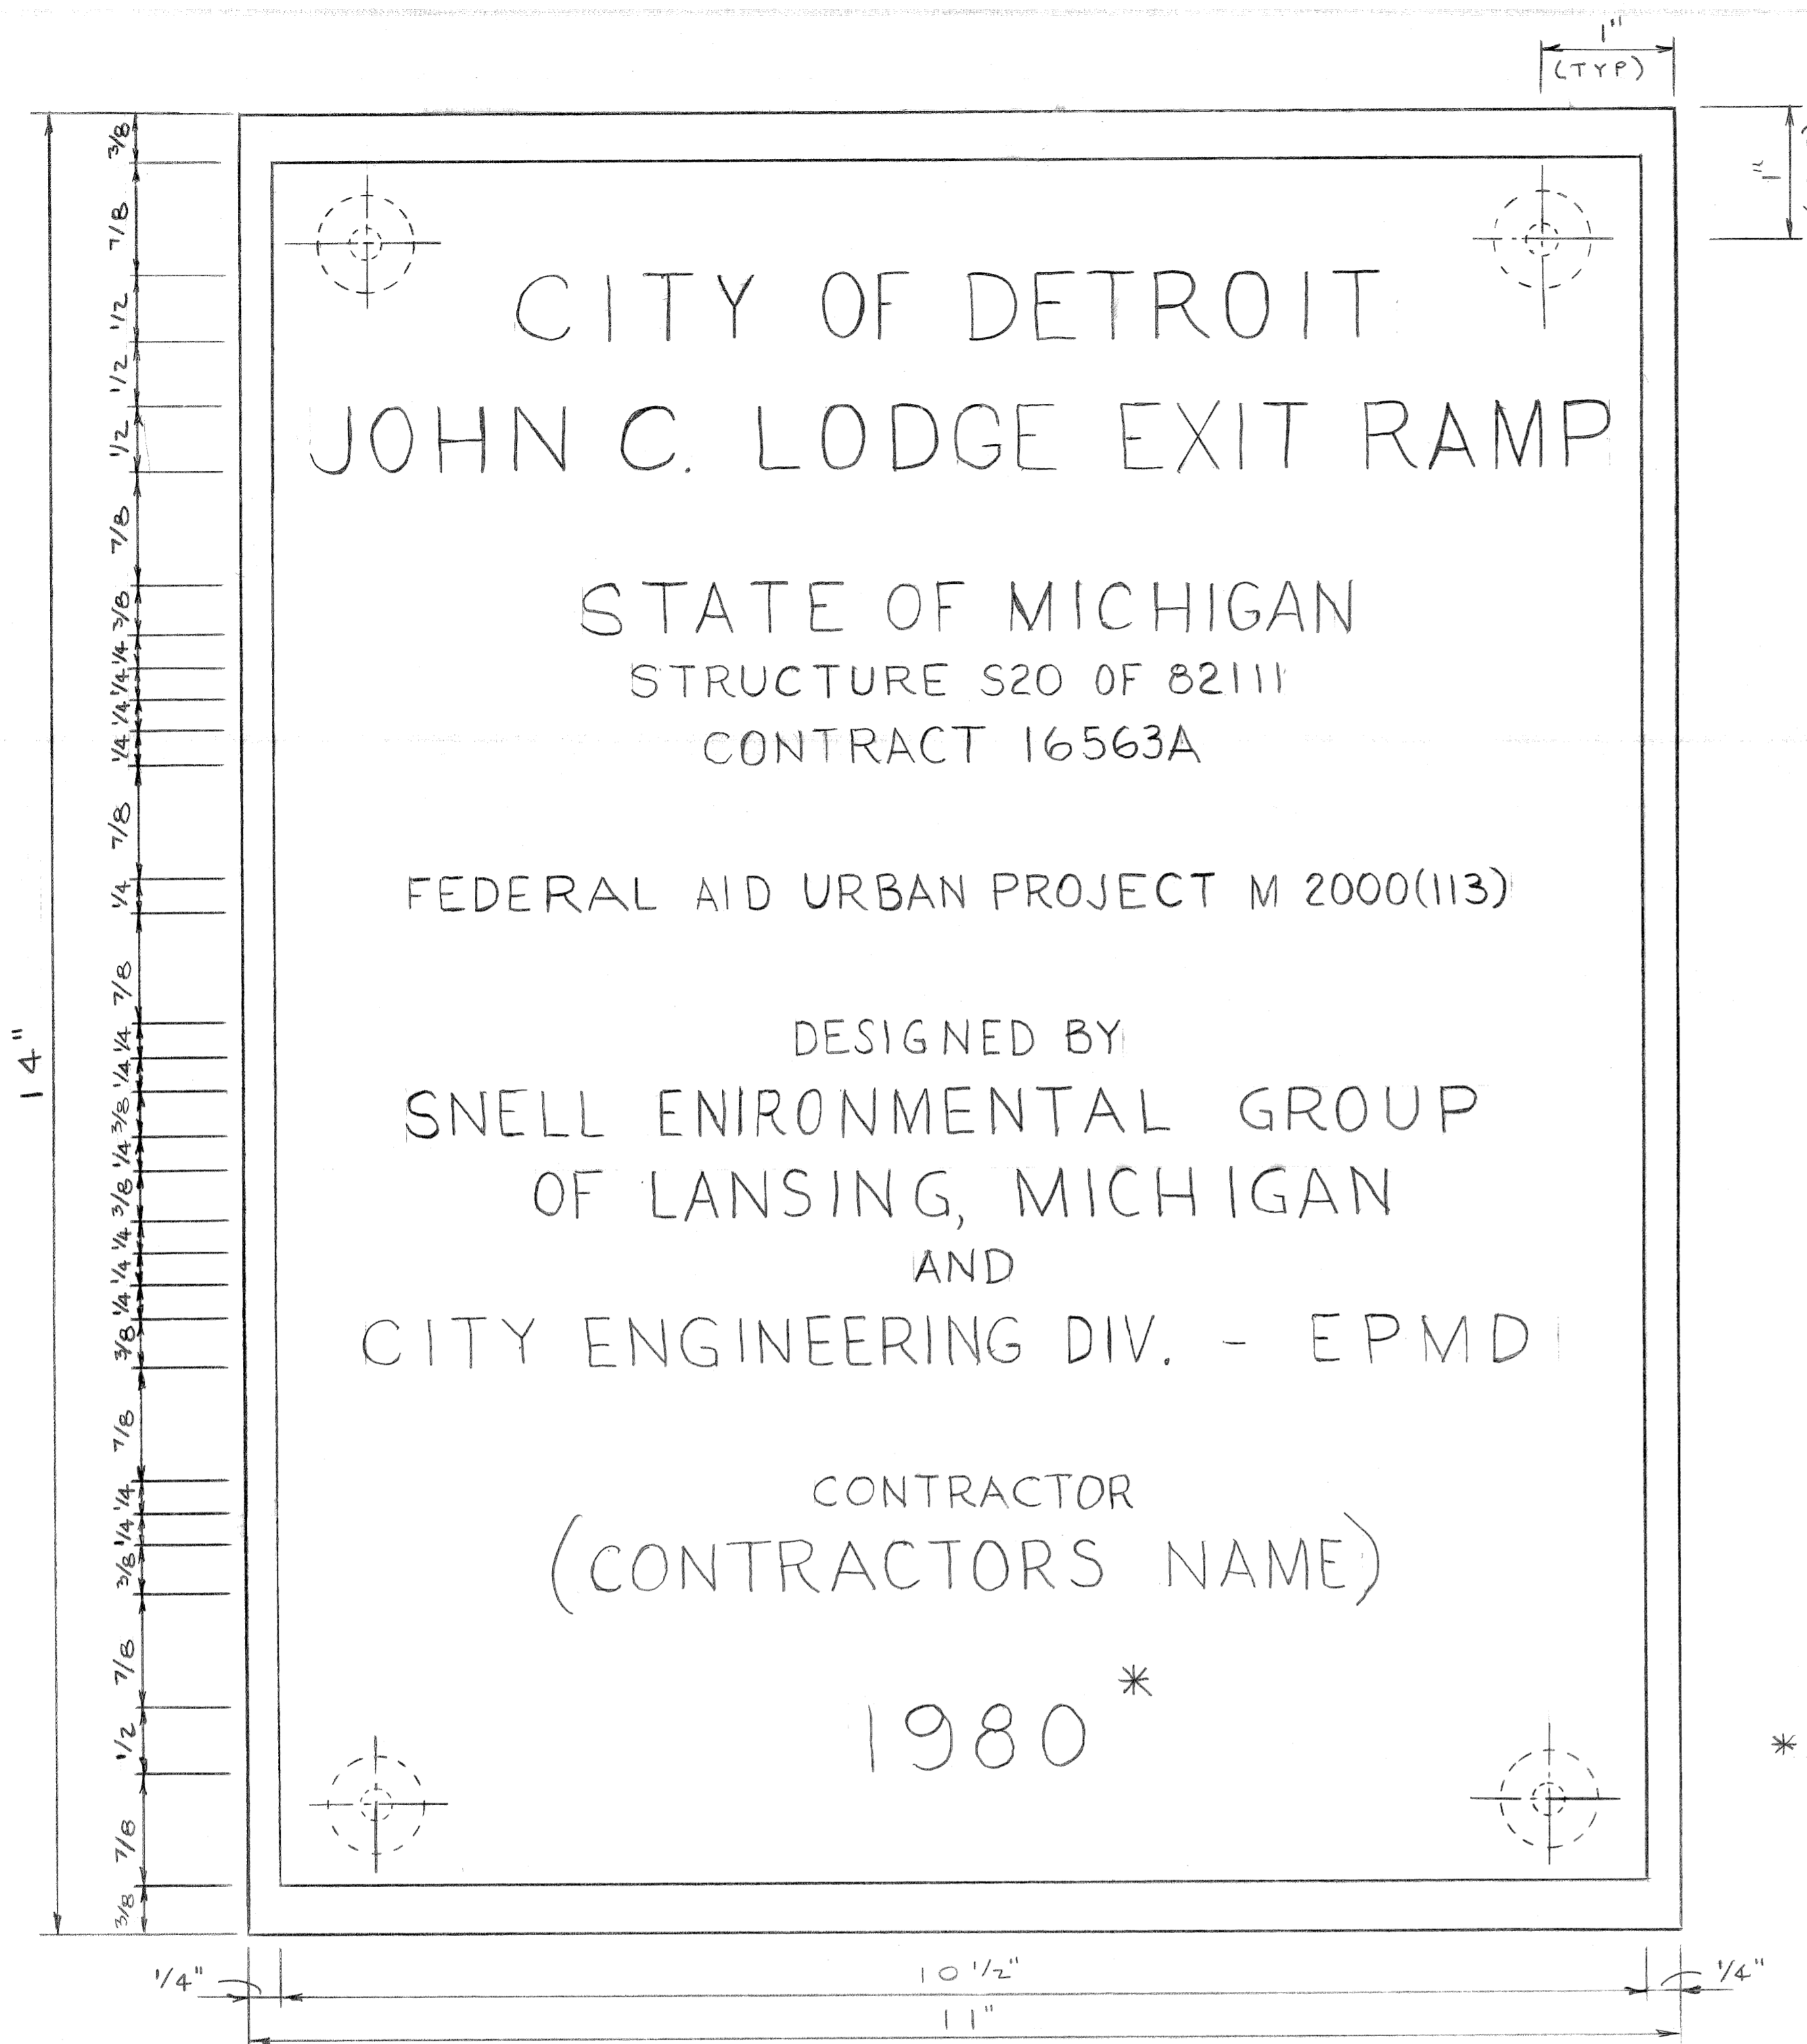

— ANCHORAGE DETAIL —

NOTES:
 SET NAME PLATE FLUSH WITH FACE OF CONCRETE AND FRAME WITH 1/4" Δ MOLDING TO FORM A REVEAL AROUND THE PLATE.
 SEE THE SPECIAL PROVISION IN THE PROPOSAL FOR ADDITIONAL DETAILS.

QUANTITY	UNIT
NAME PLATE	1 EACH

* OR YEAR SUPERSTRUCTURE IS COMPLETED

— NAME PLATE —
 FULL SCALE

<table border="1"> <thead> <tr> <th>COORD</th> <th>DESCRIPTION</th> <th>DRN</th> <th>CK'D</th> <th>AP'D</th> <th>DATE</th> </tr> </thead> <tbody> <tr> <td> </td> <td> </td> <td> </td> <td> </td> <td> </td> <td> </td> </tr> </tbody> </table>		COORD	DESCRIPTION	DRN	CK'D	AP'D	DATE							REVISIONS LOCATED BY COORDINATES ON SHEET 1 2 3 4 5 6 7 8 9 10 11	DESIGNED BY: <i>R. F. ...</i> DRAWN BY: <i>R. F. ...</i> TRACED BY: CHECKED BY:	APPROVED: CITY OF DETROIT CITY ENGINEERING DIVISION - EPMD	JOHN C LODGE EXIT RAMP AND JEFFERSON AVE. RECONSTRUCTION AT THE JOE LOUIS ARENA BRIDGE NAME PLATE DETAILS	SHEET ___ OF ___ SHEETS CONTRACT NO. 16563A DRWG NO. S-85 DATE AUG 1979
COORD	DESCRIPTION	DRN	CK'D	AP'D	DATE													


QUANTITY SHEET - E

BRIDGE ITEMS	AS PER PLANS												AS CONSTRUCTED													
	SHEET NO'S.		S-9	S-15	S-27	S-28	S-33	S-48	S-49	S-63	S-76	S-85	SHEET NO'S.		S-9	S-15	S-27	S-28	S-33	S-48	S-49	S-63	S-76	S-85		
	TOTALS	UNITS											TOTALS	UNITS												
REMOVAL OF PORTIONS OF STRUCTURES	1	L.S.			1								1	L.S.												
UNCLASSIFIED FOUNDATION EXCAVATION	3582	C.Y.			2648			934					3820	C.Y.											1028	
STRUCTURE BACKFILL (CIP)	3130	C.Y.			3130								5212	C.Y.												
TEMPORARY STEEL SHEET PILING	275	S.F.		275									0	S.F.												
STEEL PILES, FURNISHED AND DRIVEN (12")	7630	L.F.			7630								7720	L.F.											7720	
SPLICES, STEEL PILES (12")	187	EA.			187								80	EA.											80	
C.I.P. CONCRETE PILES, FURNISHED AND DRIVEN, 75 TON	950	L.F.							950				996	L.F.											996	
C.I.P. CONCRETE PILES, FURNISHED AND DRIVEN, 120 TON	2565	L.F.							2565				2733	L.F.											2733	
C.I.P. CONCRETE PILES, FURNISHED AND DRIVEN, 300 TON	4725	L.F.							4725				4681	L.F.											4681	
CONCRETE GRADE X	3	C.Y.			3								0	C.Y.											0	
SUBSTRUCTURE CONCRETE	3017	C.Y.			1813			1204					3022	C.Y.											1206	
SUPERSTRUCTURE CONCRETE	923	C.Y.											941	C.Y.											941	
FORMING, FINISHING AND CURING SUPERSTRUCTURE CONCRETE	1	L.S.											1	L.S.											1	
STEEL REINFORCEMENT	501,128	LBS.			170,128			169,223					497,743	LBS.												153,882
STEEL REINFORCEMENT, EPXY COATED	89000	LBS.											97,486	LBS.												97,486
LOW TEMPERATURE PROTECTION, SUBSTRUCTURE CONCRETE	3017	C.Y.			1813								3017	C.Y.												1204
LOW TEMPERATURE PROTECTION, SUPERSTRUCTURE CONCR.	1070	C.Y.											0	C.Y.												0
CLEAR PROTECTIVE COATING FOR SUBSTRUCTURE CONCRETE	12687	S.F.			826			11861					12900	S.F.												12016
PROTECTIVE SEALANT COATING FOR CONCRETE	836	S.F.						836					798	S.F.												798
1/4" PREFORMED NEOPRENE JOINT SEAL	60	L.F.											60	L.F.												60
EXPANSION JOINT DEVICE - 2" MINIMUM TRAVEL	71	L.F.											71	L.F.												71
EXPANSION JOINT DEVICE - 3" MINIMUM TRAVEL	191	L.F.											189	L.F.												189
LIGHT STANDARD ANCHOR ASSEMBLY - PLASCO	13	EA.											13	EA.												13
DRAIN CASTING ASSEMBLY - TYPE 3	5	EA.											5	EA.												5
EXPANSION JOINT DRAIN	17	EA.			17								17	EA.												17
3" CONDUIT	1725	L.F.											1711	L.F.												1711
CONSTRUCTING BRIDGE DECK SURFACE	3516	S.Y.											3513	S.Y.												3513
LATEX MODIFIED SURFACING MIXTURE	147	C.Y.											169.4	C.Y.												169.4
NAME PLATE	1	EA.											1	EA.												1
3" GALVANIZED IRON PIPE	74	L.F.											0	L.F.												0
STRUCTURAL STEEL, FURNISHING AND ERECTING ASSORTS.	1,170,000	LBS.						1,170,000					1,141,216	LBS.												1,141,216
STRUCTURAL STEEL, ERECTION WASH PLATE	1,170,000	LBS.						1,170,000					1,141,216	LBS.												1,141,216
3/4" ELASTOMERIC BEARING	37	S.F.											37	S.F.												37
1" ELASTOMERIC BEARING	32	S.F.											32	S.F.												32
2" ELASTOMERIC BEARING	12	S.F.											12	S.F.												12
3" ELASTOMERIC BEARING	25	S.F.											25	S.F.												25
4" ELASTOMERIC BEARING	6	S.F.											6	S.F.												6
5" ELASTOMERIC BEARING	1	S.F.											1	S.F.												1
BEAR DEVELOPERS	585	TONS											570.6	TONS												570.6
FIELD PAVING	5	S.F.											5	S.F.												5
1 1/2" ELASTOMERIC BEARING	6	S.F.											6	S.F.												6
1/4" ELASTOMERIC BEARING	16	S.F.											16	S.F.												16
3/8" ELASTOMERIC BEARING	6	S.F.											6	S.F.												6
2" FIBER JOINT FILLER	700	S.F.			473								623	S.F.												213
2" FIBER JOINT FILLER	540	S.F.		540									540	S.F.		540										540
BRIDGE RAILING S&S WRAPEX TYPE - SPEC'A -	179	L.F.											180	L.F.												180
8" CLASS A SEWER - TRENCH DETAIL 9	83	L.F.			83								84	L.F.												84
48" BULKHEAD	4	EA.			4								15	EA.												15
FOUNDATION DRAINS 6"	1663	L.F.		255	1408								1663	L.F.		255	1408									1663
5" CONCRETE SIDEWALK	1165	S.F.			1165								1141	S.F.												1141
CONCRETE BARRIER - BRIDGE, TYPE 3	1495	L.F.											1571	L.F.												1571


CHECKED
 CONTRACT SECTION
 DATE 5/13/82

EXTRAS TO PLAN


Auth 2005 Bridge Lighting Handholes	Install approved cast iron handhole @ each light standard on barrier railing - 1 unit	= \$24,033.34	(show on "as constructed" plans)
Auth 2009 - Pier downspout Cleanouts	Install C.I. Cleanouts @ Piers 10-13-8-5-1	36 @ \$55.00 ea.	= \$1980.00 (show on "as constructed" plans)
Auth 2010 - Str. Steel addition	Install additional Str. Steel - Span 2	1 UNIT = \$21,327.47	(show on "as constructed" plans)
Auth 2013 - Saw-cutting latex overlay @ Pier Tops & construction joints	Saw joints in latex overlay @ piers & construction joints	509' LFT @ 5.562	= \$2830.04 (show on "as constructed" plans)

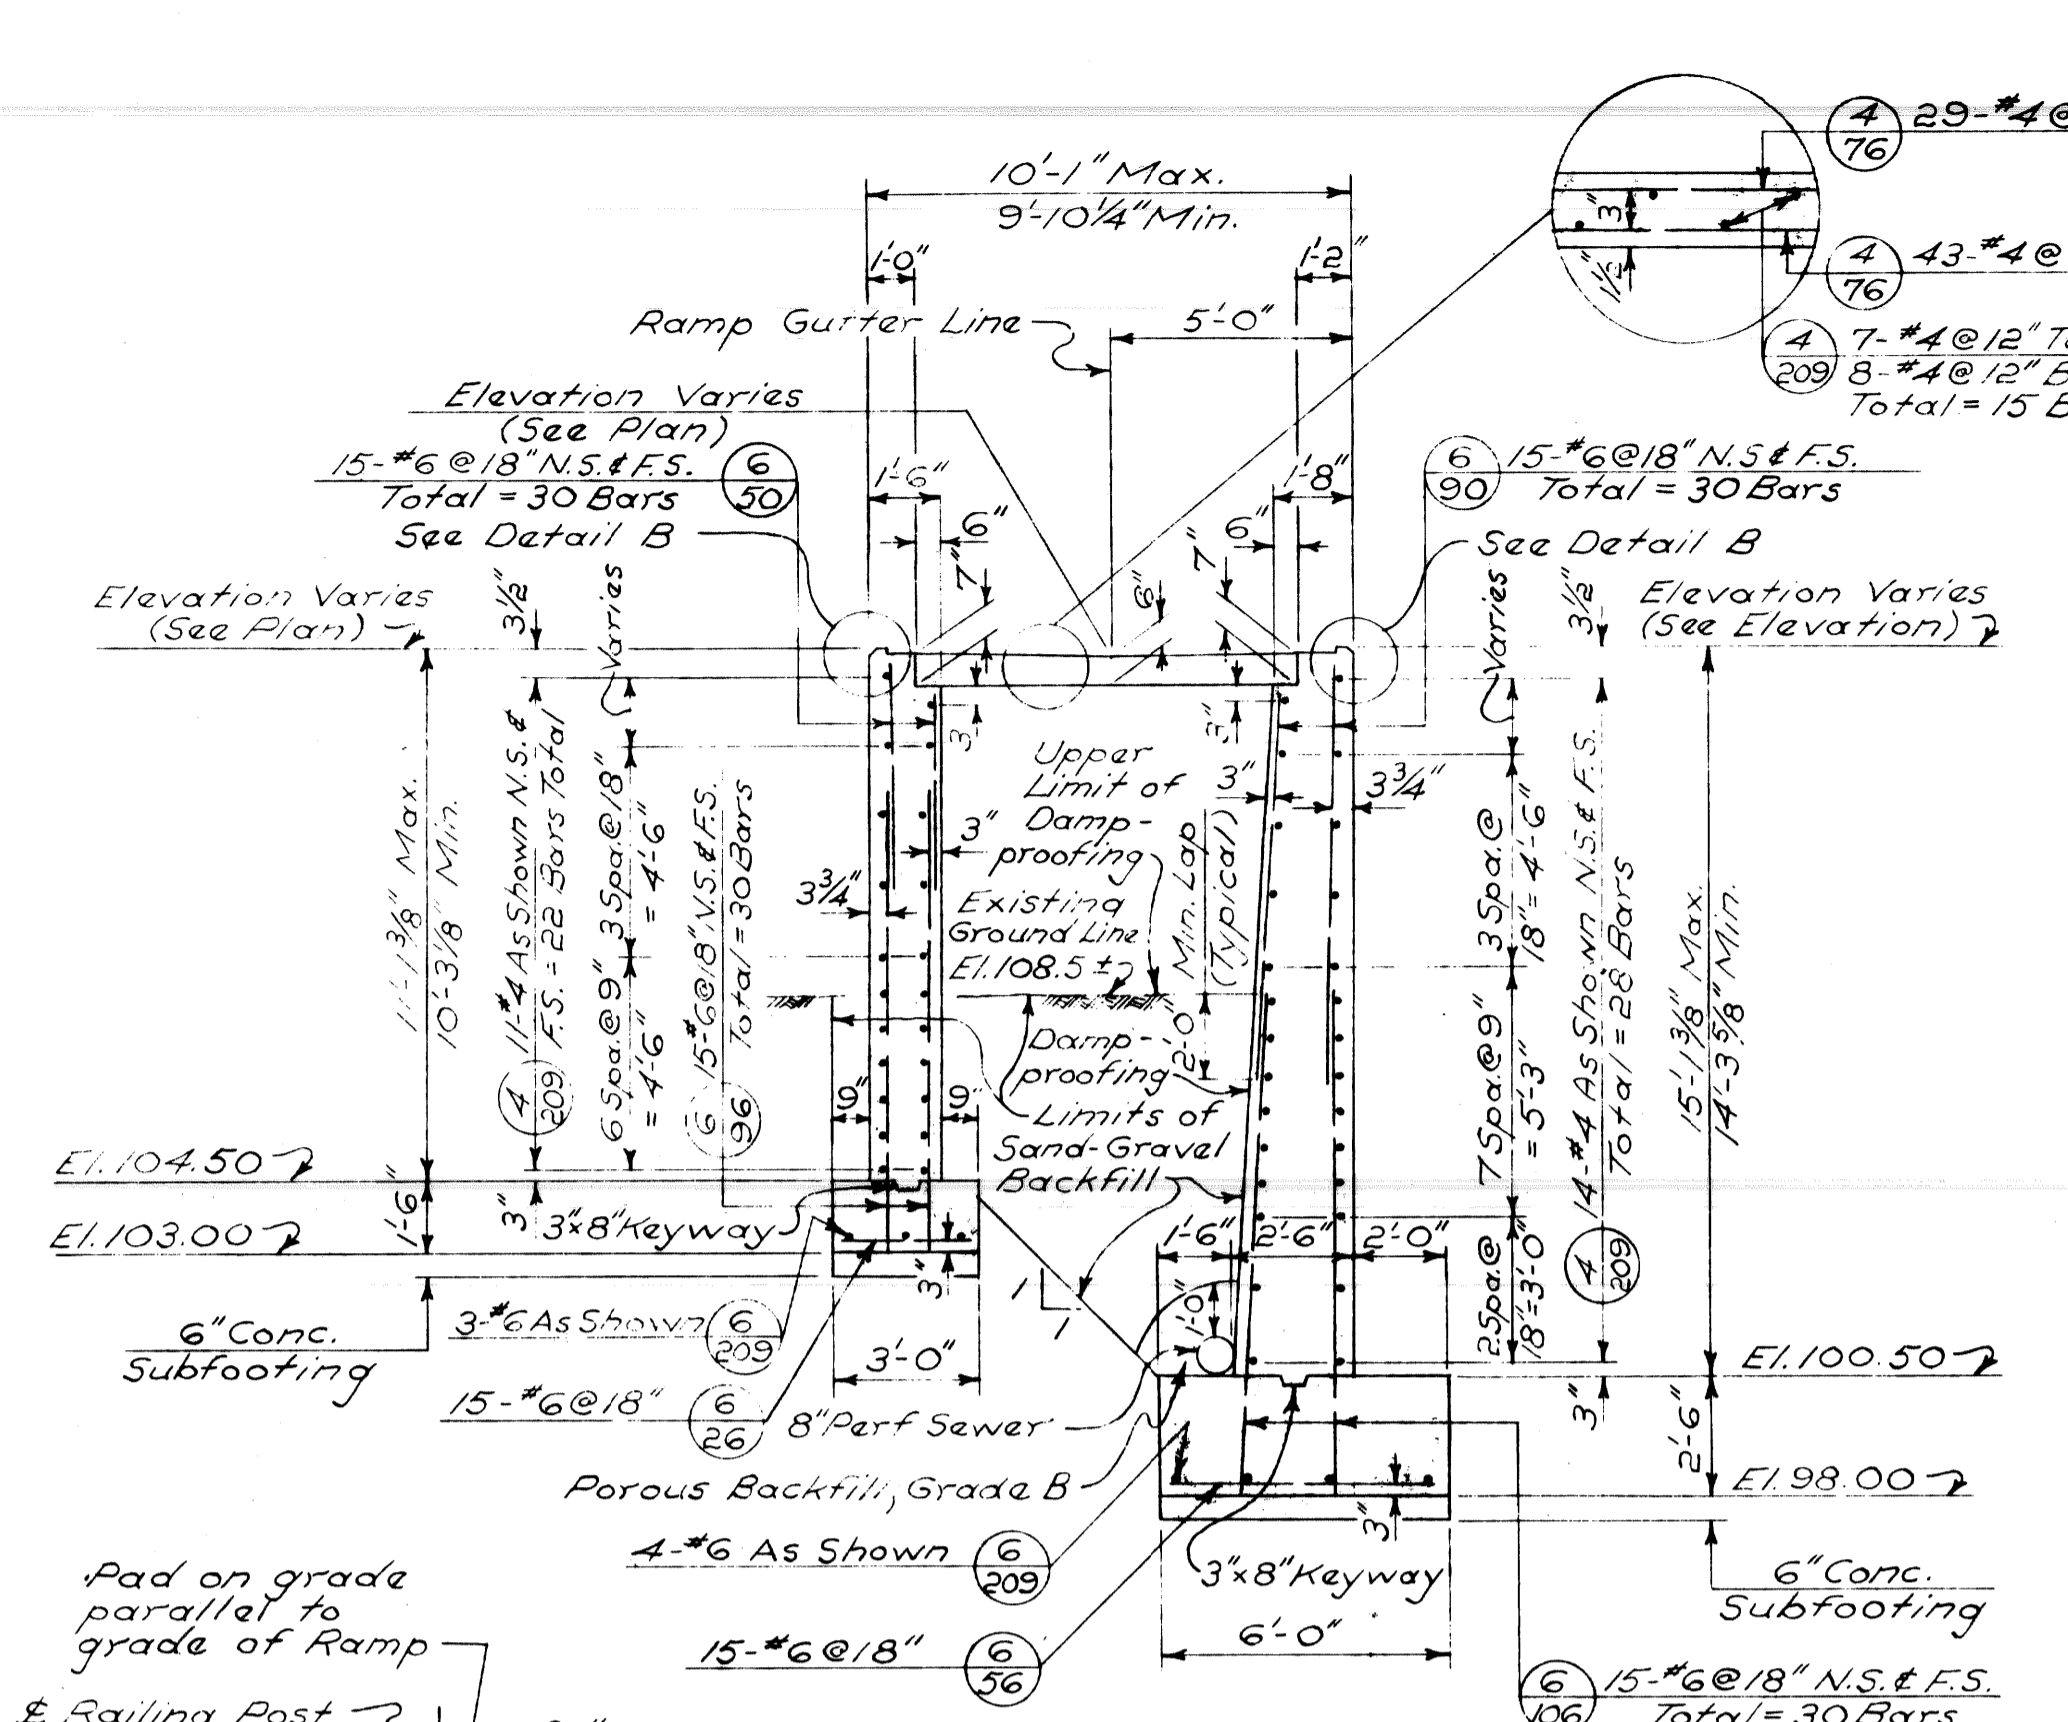


SECTION F-F
Scale: 1/4" = 1'-0"

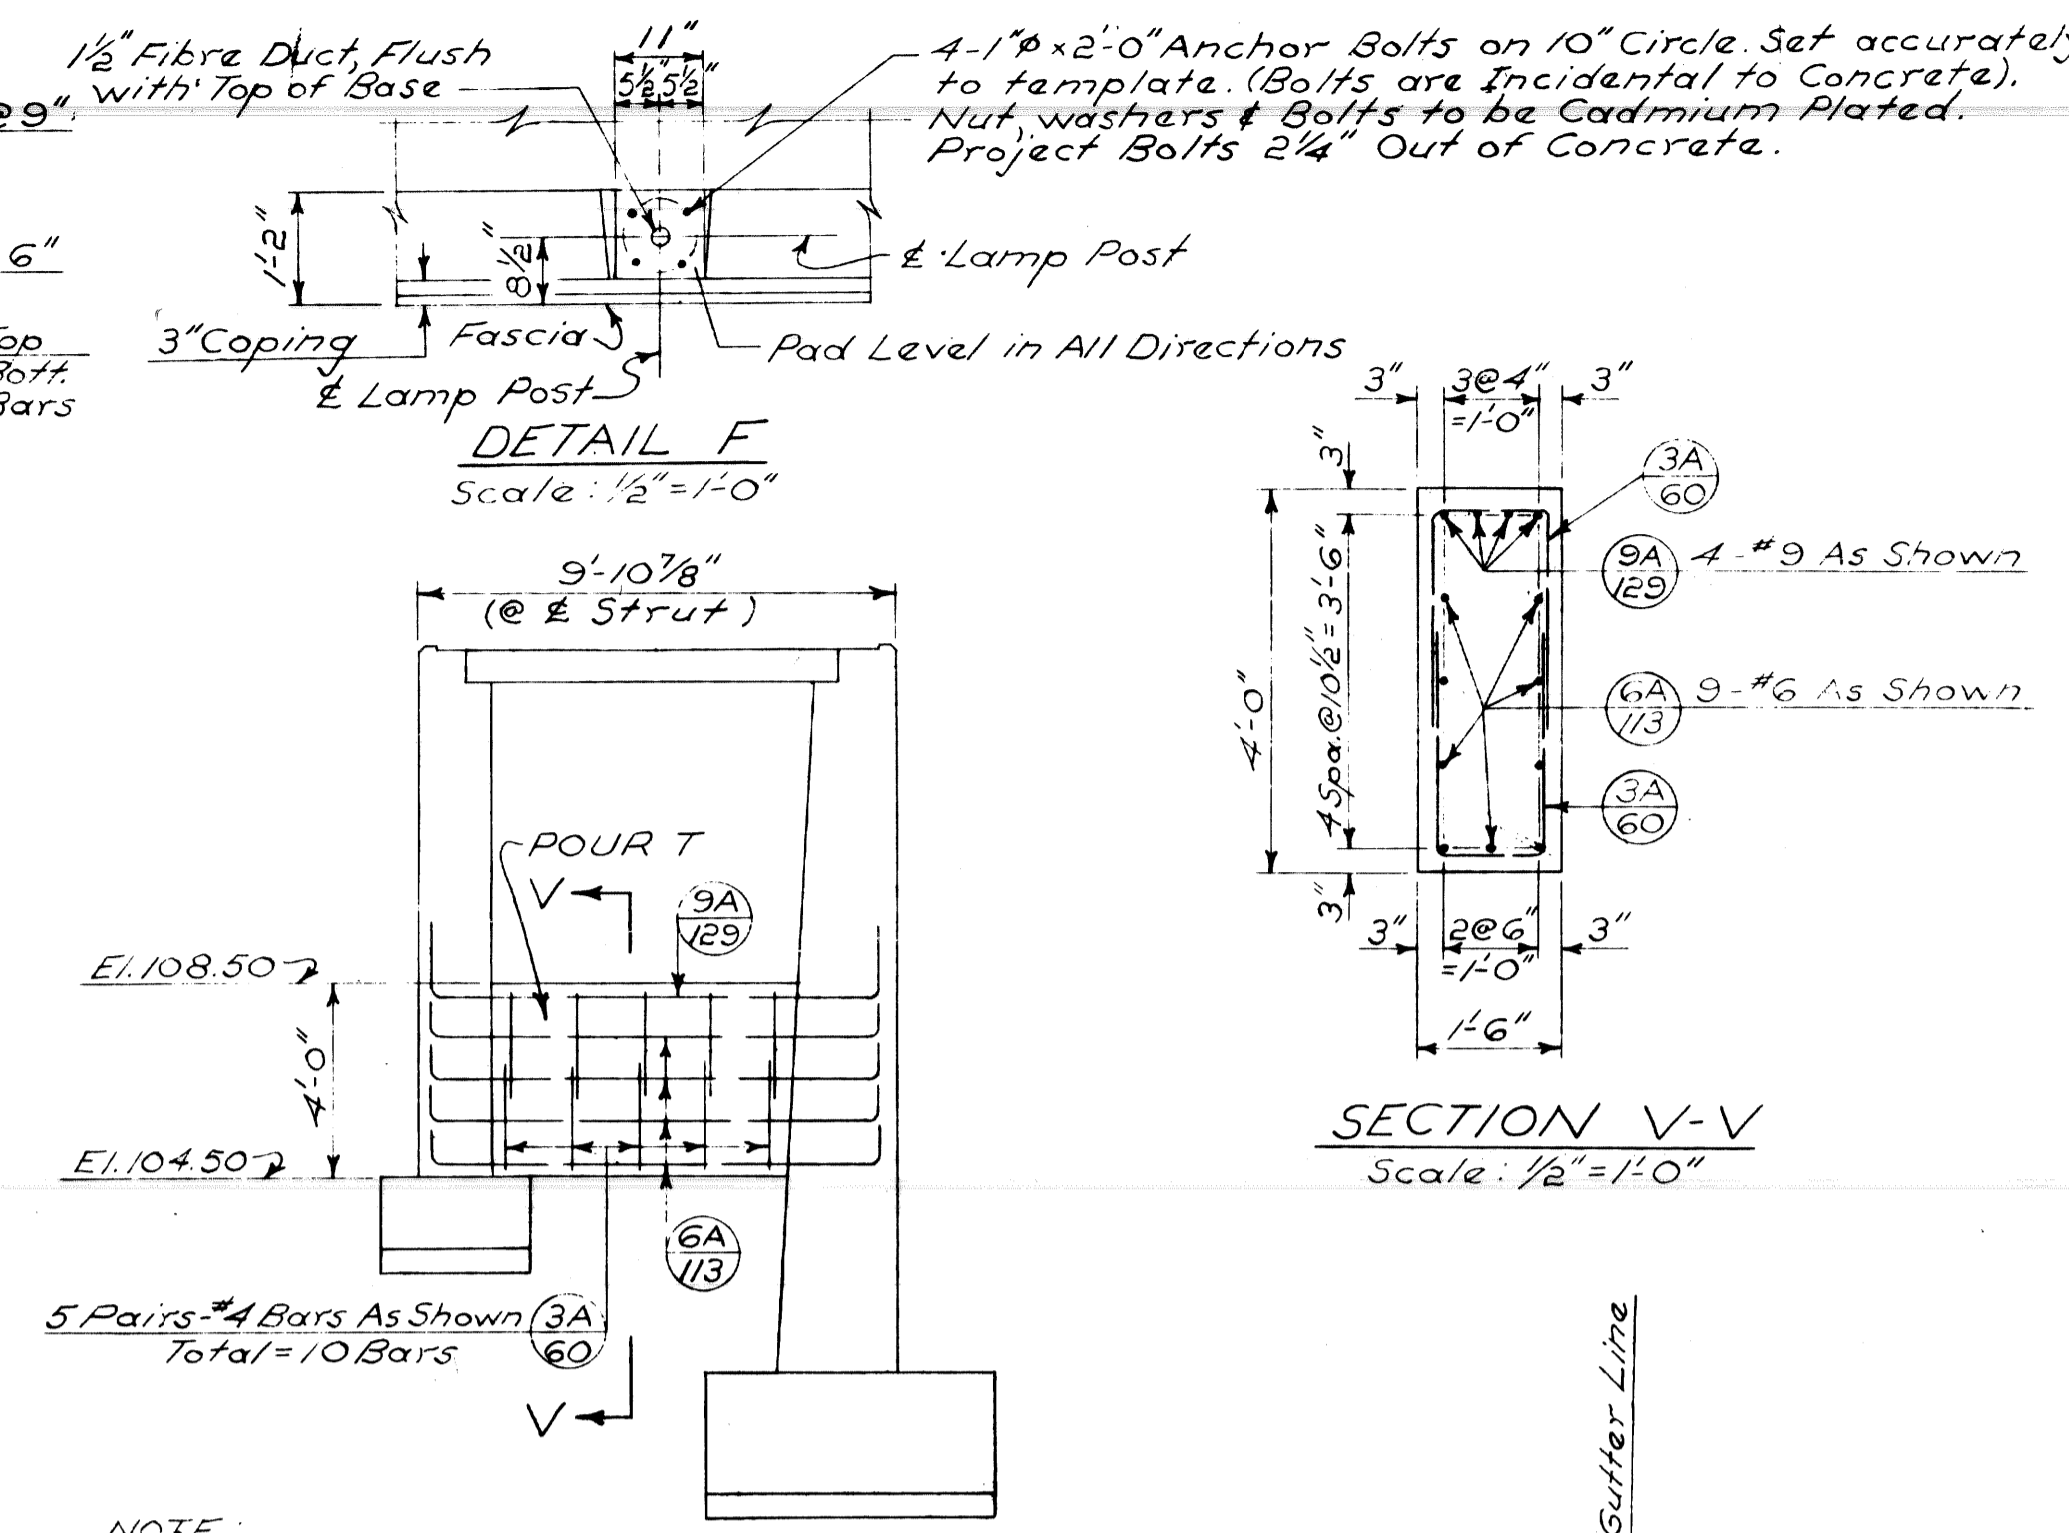


DETAIL OF REINFORCED CONCRETE STRUT
Scale: 1/4" = 1'-0"

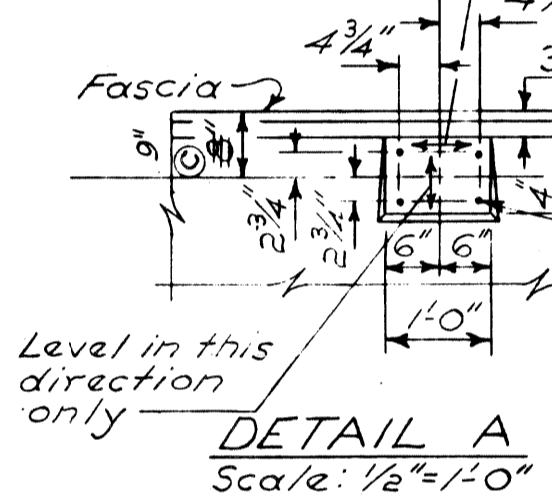


DETAIL A
Scale: 1/2" = 1'-0"

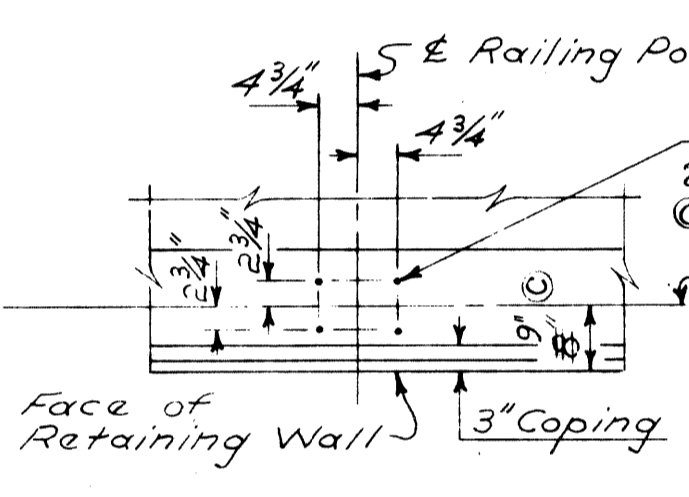


DETAIL C
Scale: 1/2" = 1'-0"

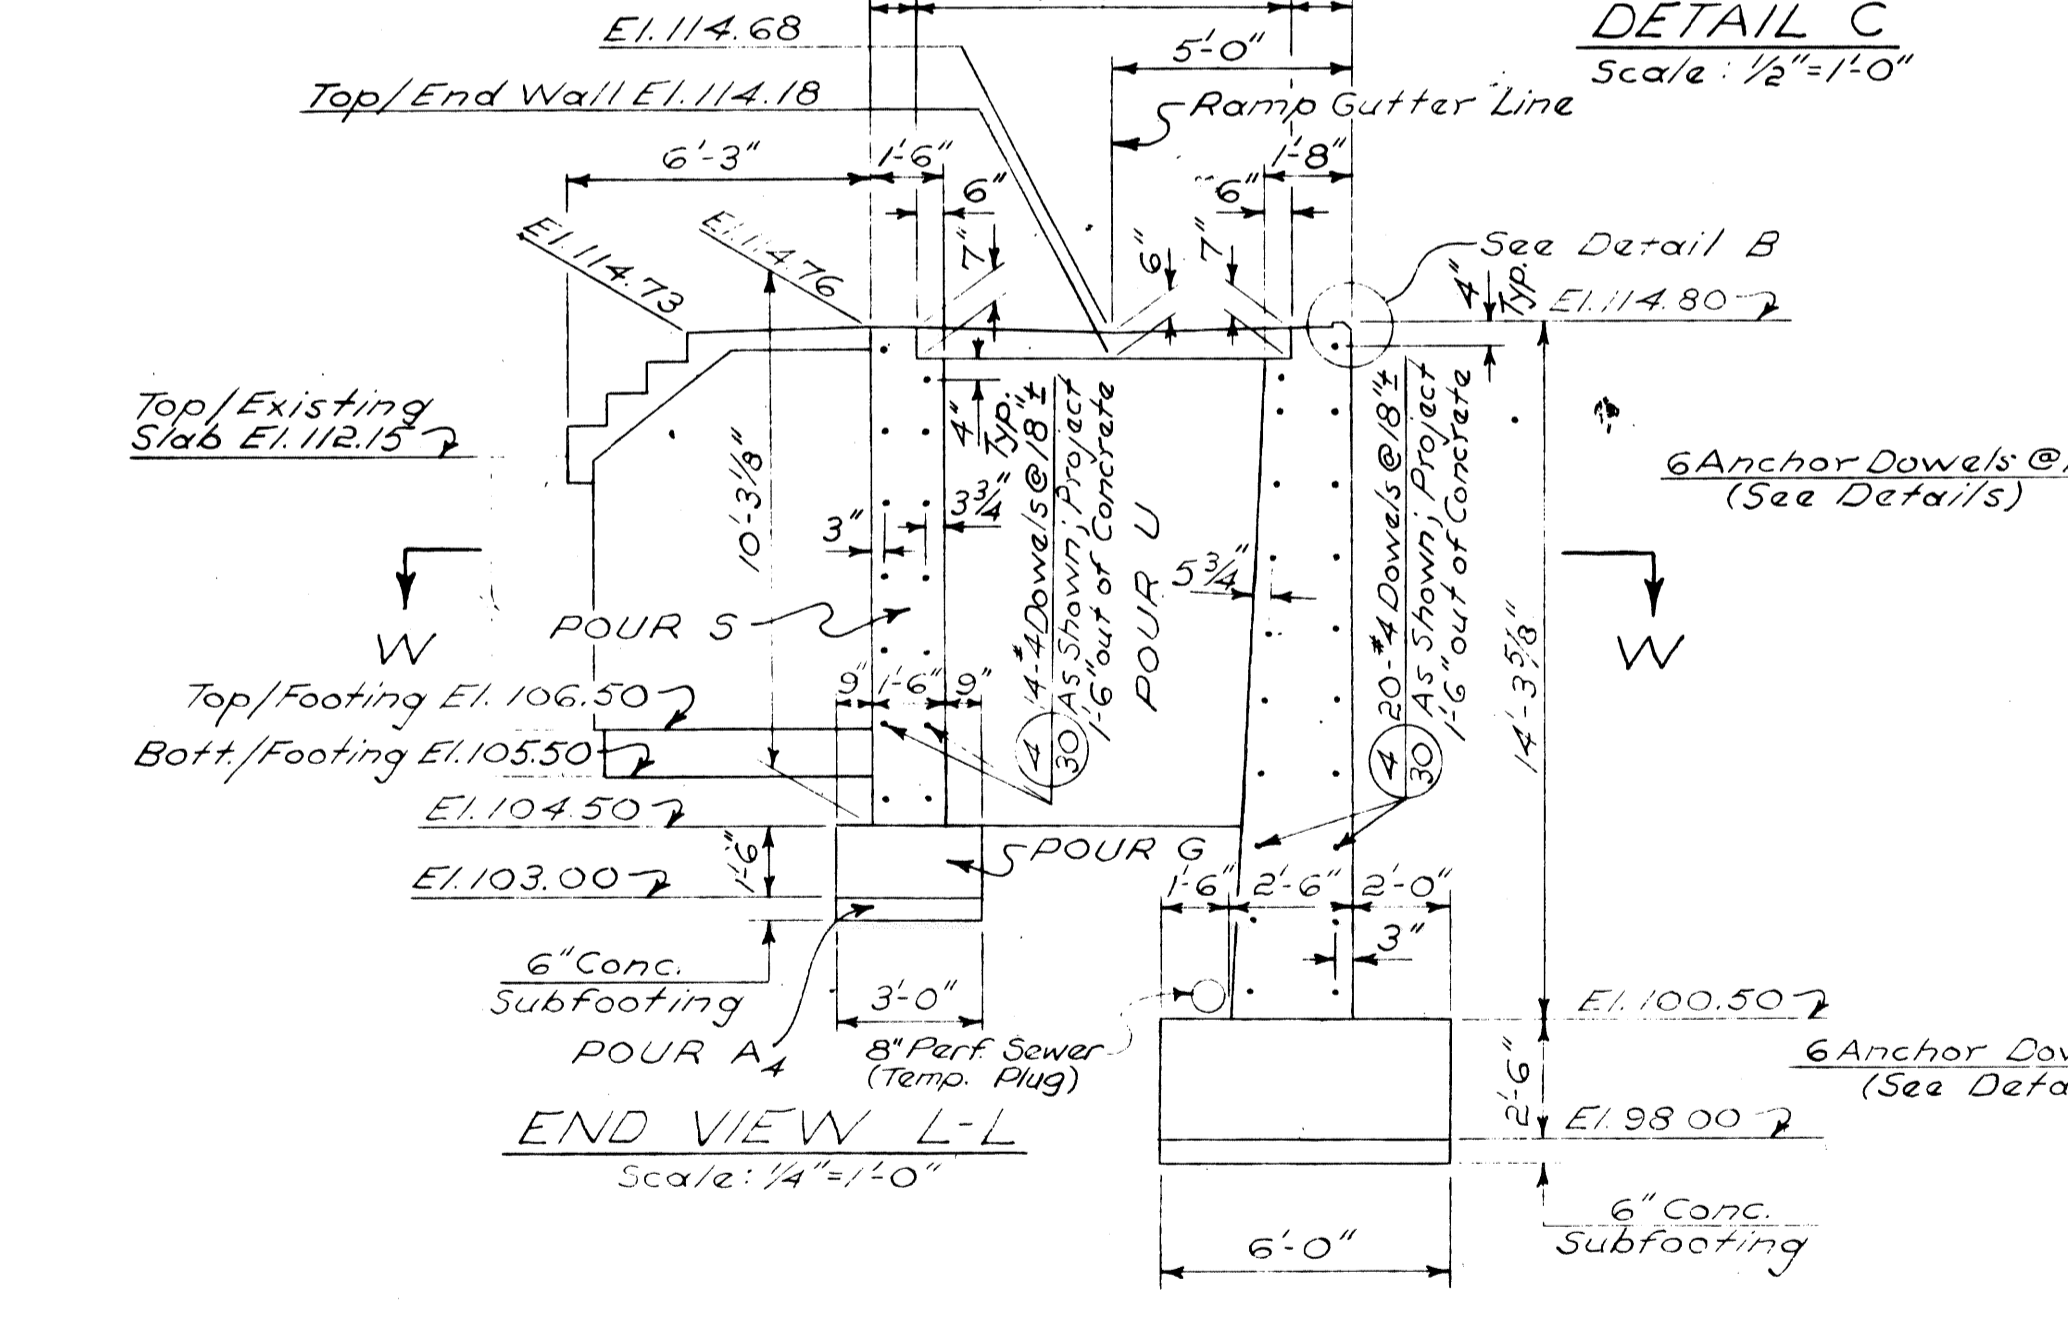


END VIEW L-L
Scale: 1/4" = 1'-0"

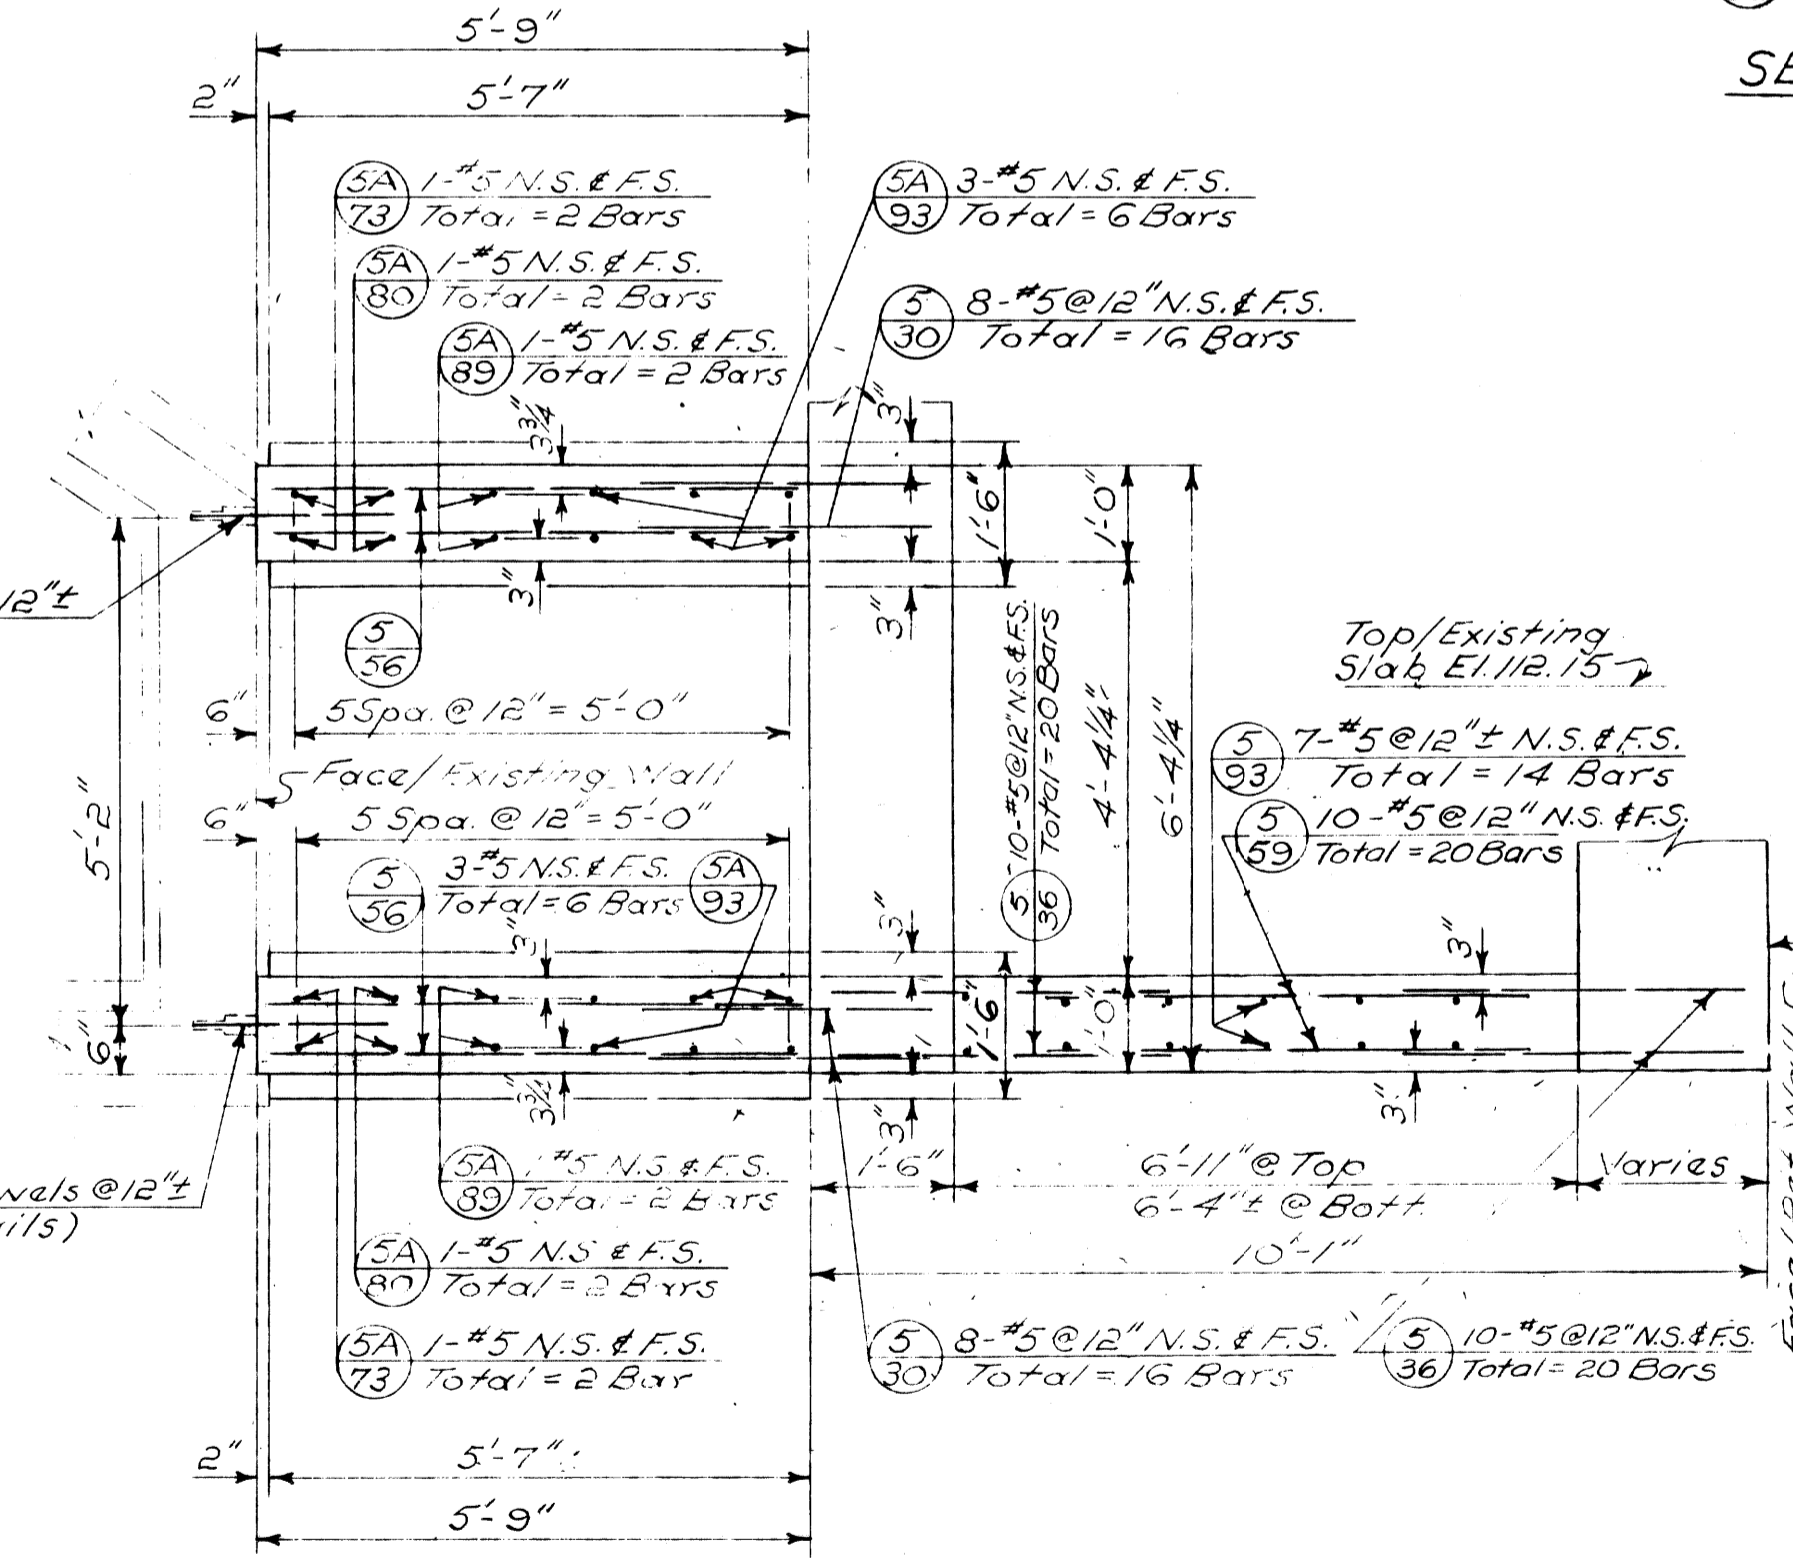


SECTION W-W
Scale: 1/8" = 1'-0"

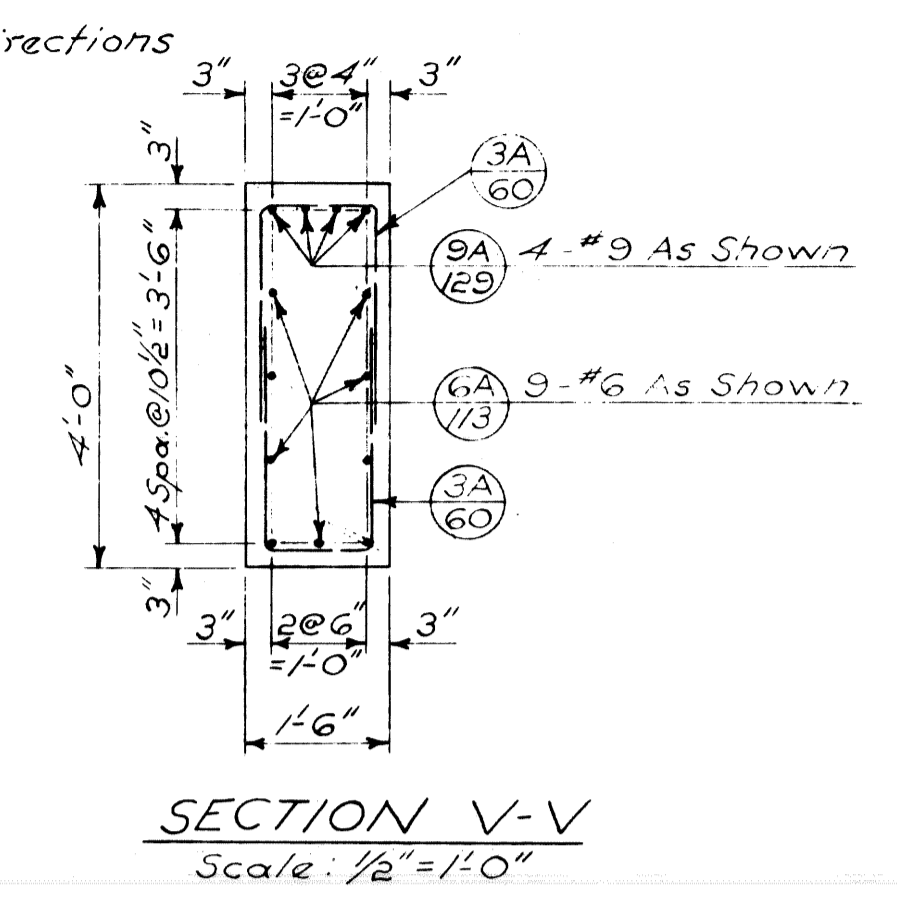


SECTION V-V
Scale: 1/2" = 1'-0"

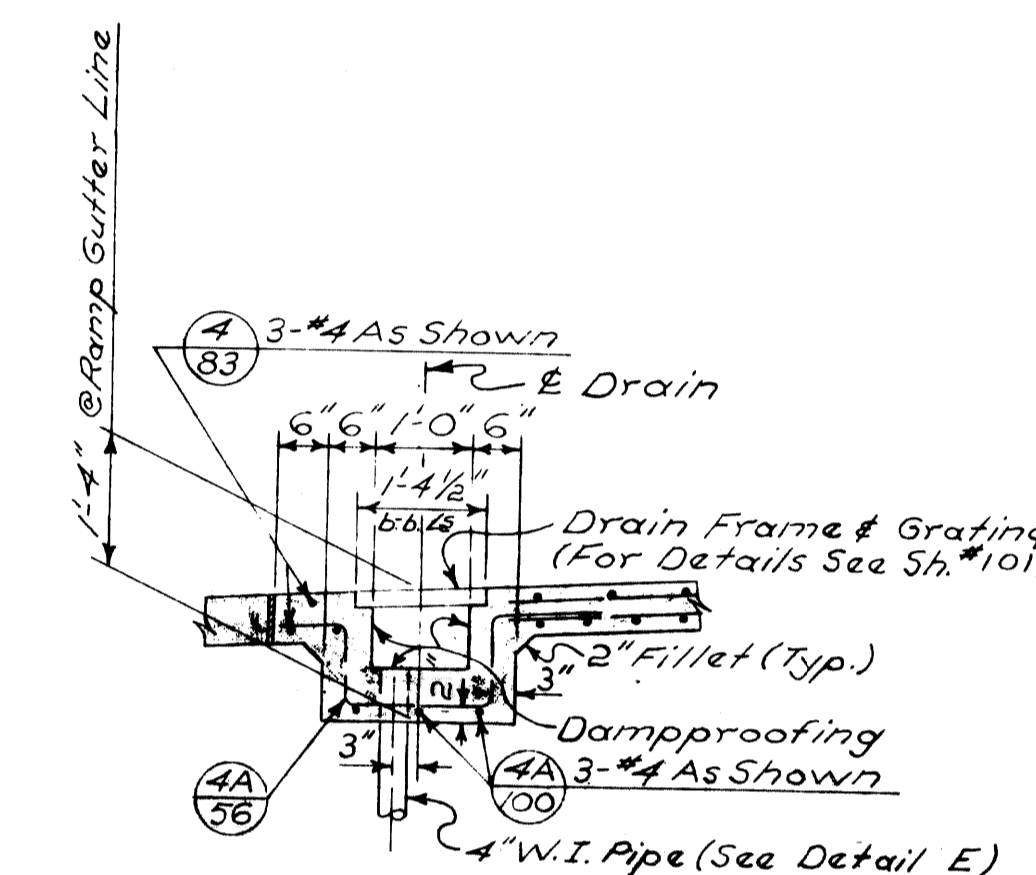

SECTION K-K
Scale: 1/2" = 1'-0"

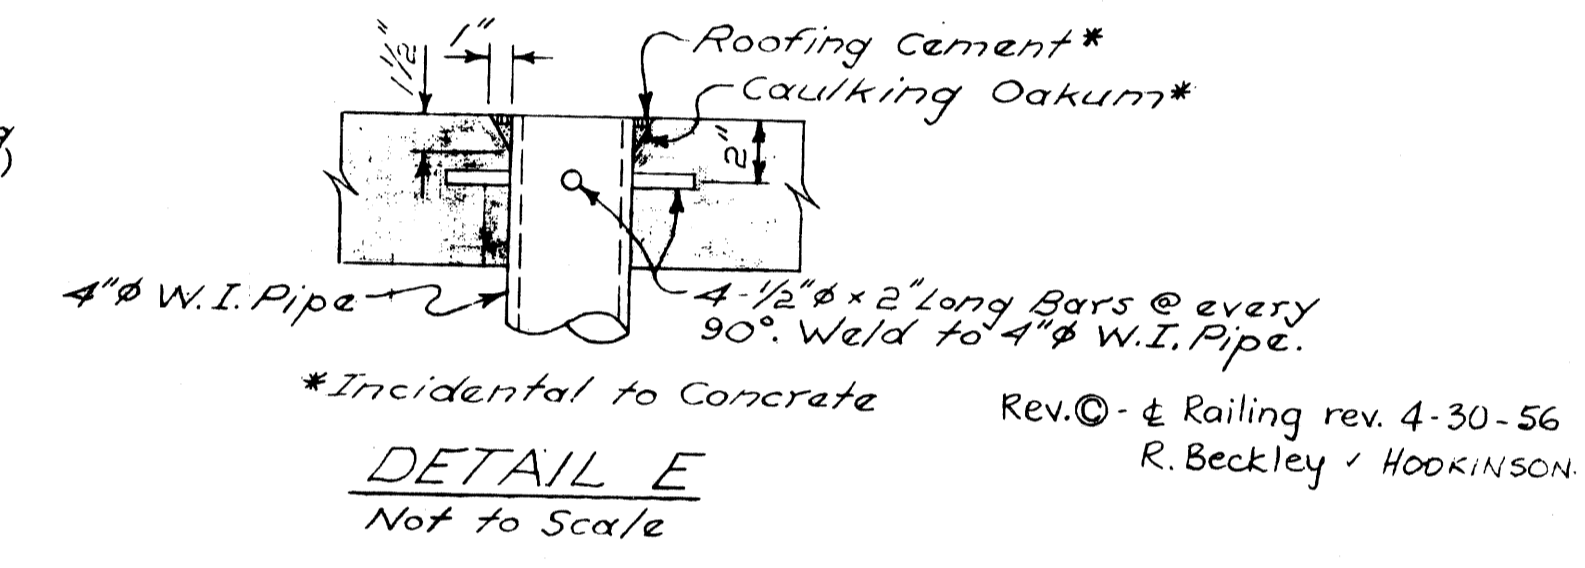




DETAIL E
Not to Scale

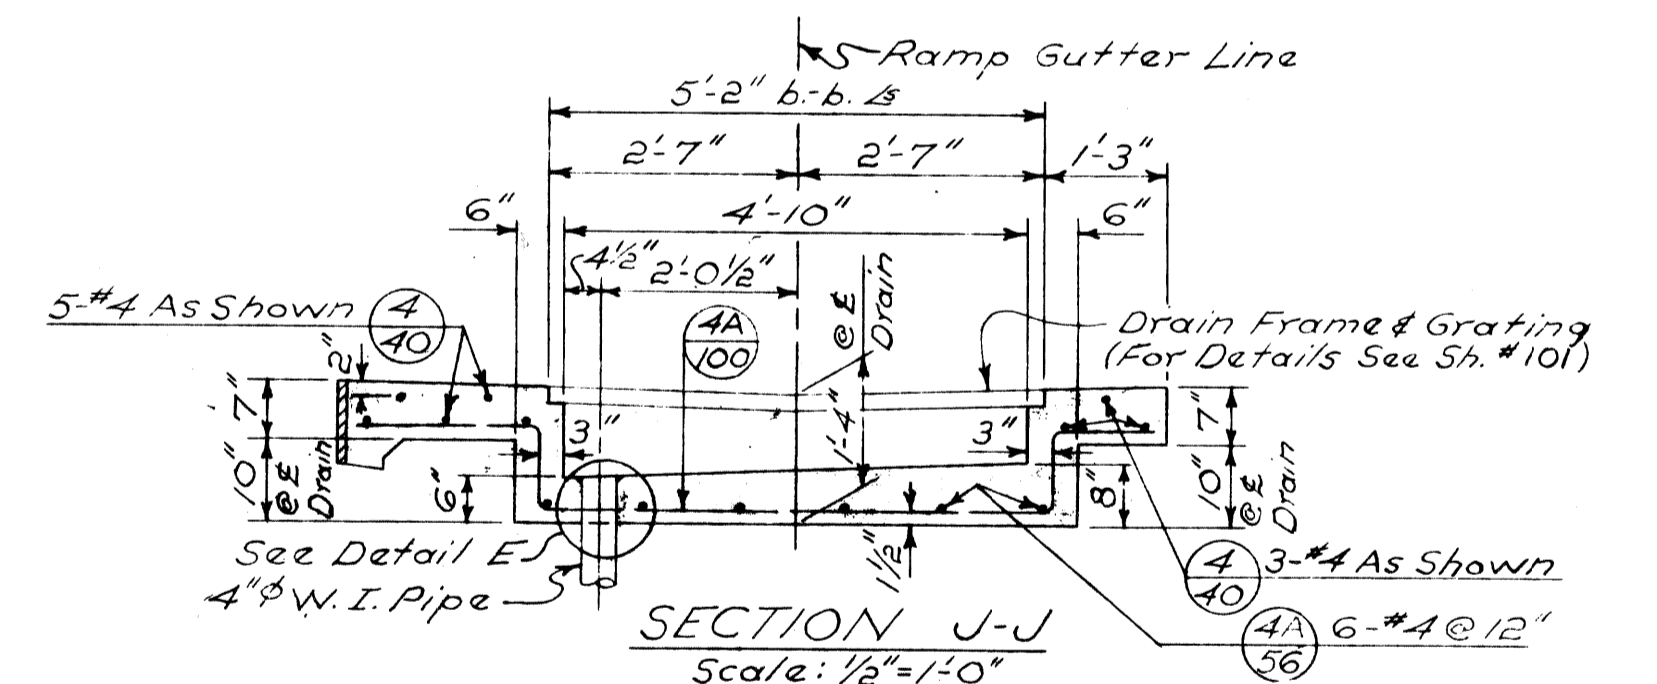

SECTION J-J
Scale: 1/8" = 1'-0"

**JOHN C. LODGE EXPRESSWAY
UNION DEPOT CROSSING
PEDESTRIAN BRIDGE
RETAINING WALL "C" AND RAMP DETAILS (CONT'D.)**


















DESIGNED BY		APPROVED:		CITY OF DETROIT CITY ENGINEERING DIVISION - EPMD	JOHN C. LODGE EXIT RAMP AND JEFFERSON AVE. RECONSTRUCTION AT THE JOE LOUIS ARENA RAMP - REFERENCE DRAWING RETAINING WALL C AND RAMP DETAILS	SHEET _____ OF _____ SHEETS CONTRACT NO. 16563A PRWG NO. SR-2 DATE AUG 1979
DRAWN BY						
TRACED BY						
CHECKED BY J.M. FAK						

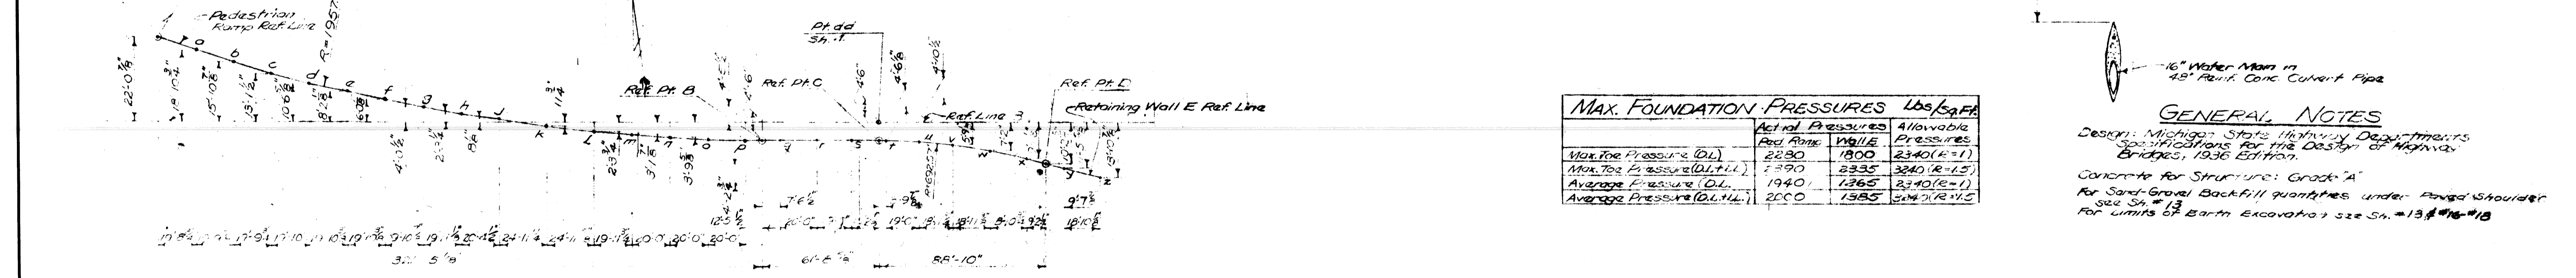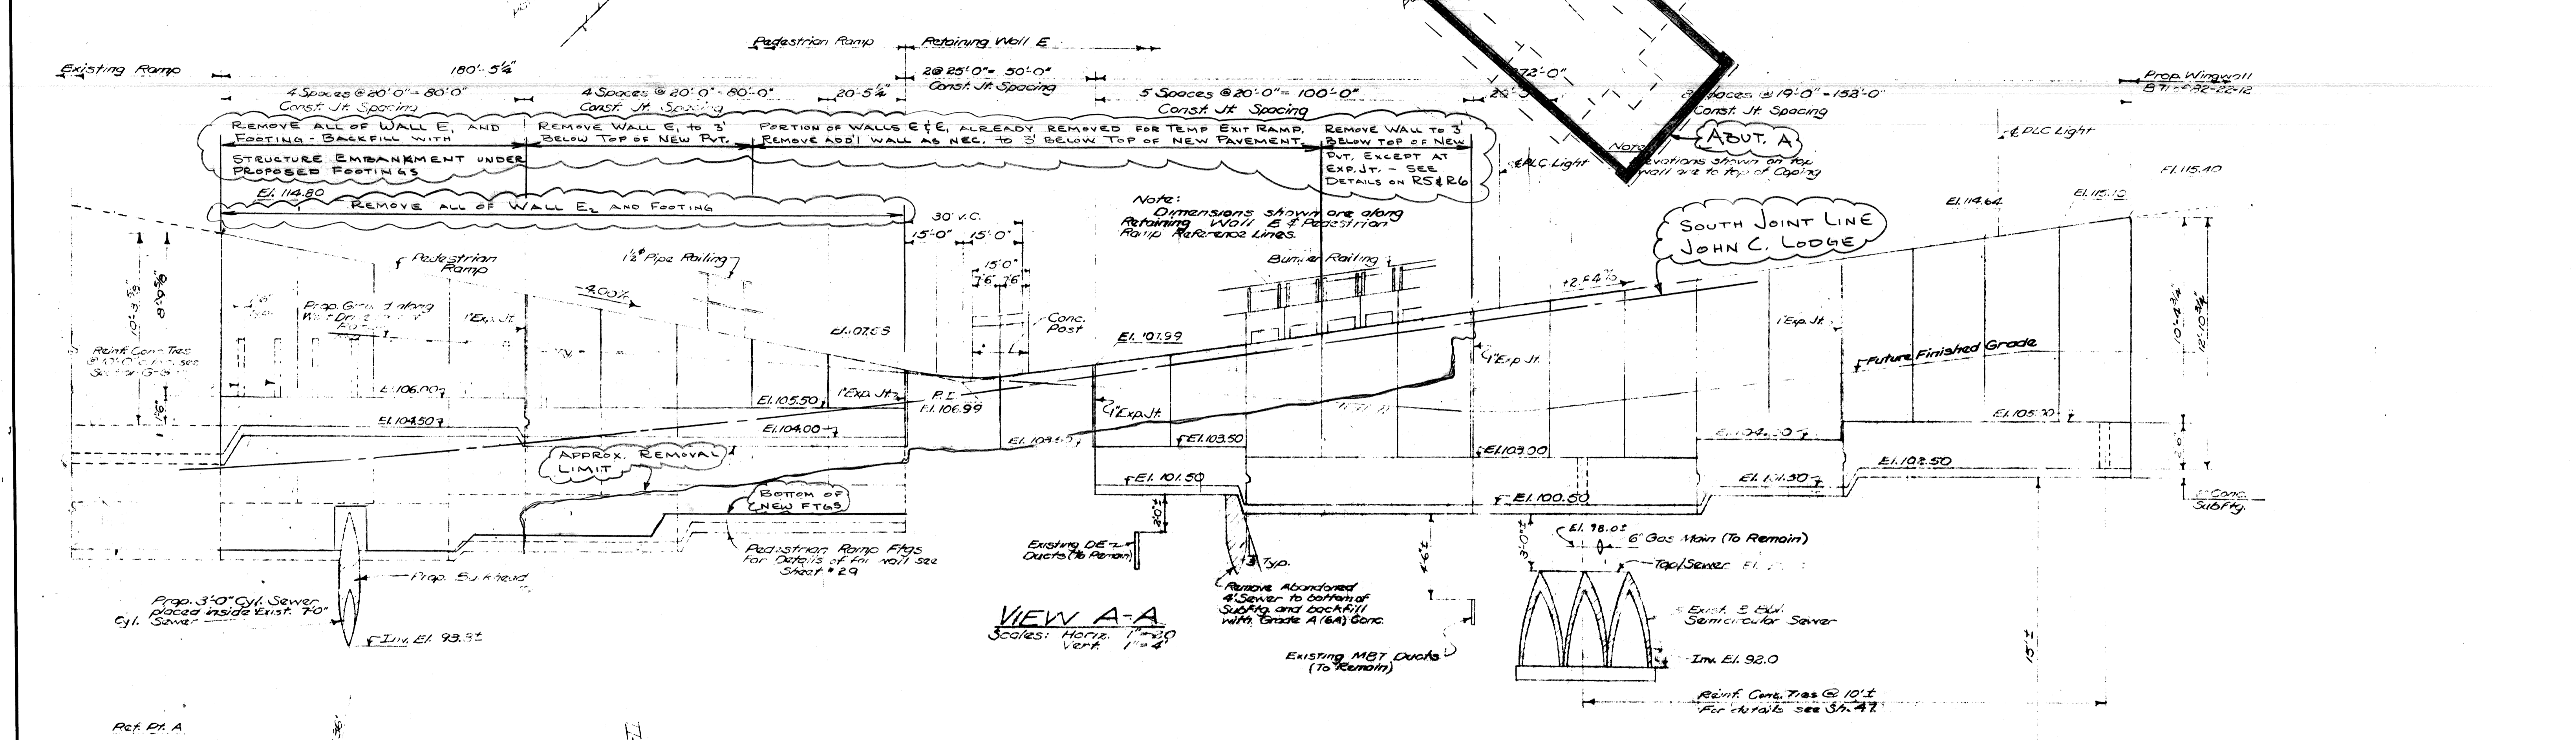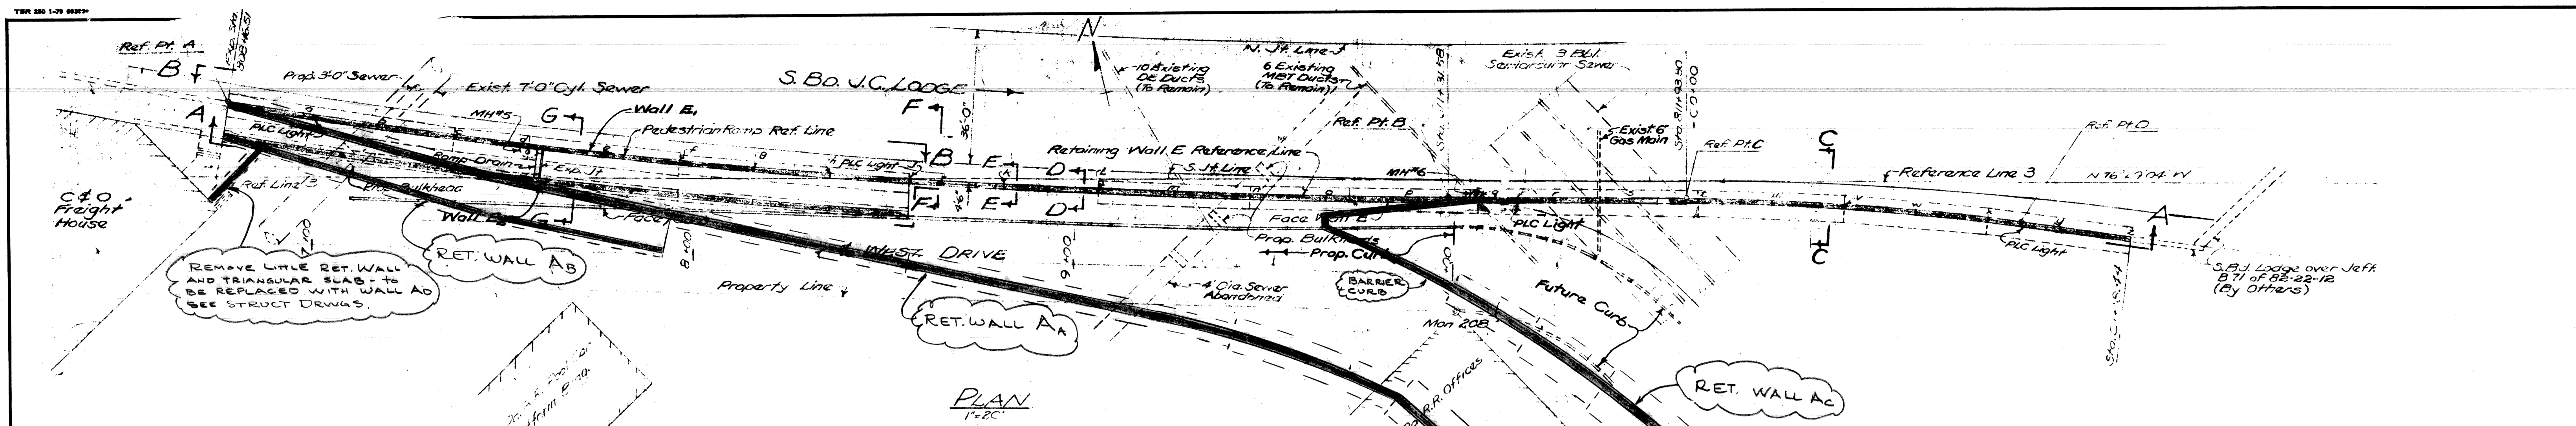







MAX. FOUNDATION PRESSURES			Lbs./sq.ft.
	Actual Pressures	Allowable Pressures	
	Red. Rate	W/ILE	
Max. Toe Pressure (DL)	2280	1800	2340 (E=1)
Max. Toe Pressure (DL+LL)	2390	2335	2340 (E=1)
Average Pressure (DL)	1940	1265	2340 (E=1)
Average Pressure (DL+LL)	2000	1385	2340 (E=1)

GENERAL NOTES
 Design: Michigan State Highway Department Specifications for the Design of Highway Bridges, 1936 Edition.
 Concrete for Structure: Grade "A"
 For Sand-Gravel Backfill quantities under Pavement Shoulder see Sh. # 13
 For limits of Earth Excavation see Sh. # 13, # 16, # 18

REVISIONS LOCATED BY COORDINATES ON SHEET				REFERENCE DRAWINGS	DESIGNED BY DRAWN BY TRACED BY CHECKED BY <i>J.M. RAK</i>	APPROVED:	CITY OF DETROIT CITY ENGINEERING DIVISION - EPMD	JOHN C. LODGE EXIT RAMP AND JEFFERSON AVE. RECONSTRUCTION AT THE JOE LOUIS ARENA RAMP-REFERENCE DRAWING GENERAL PLAN OF PED. RAMP AND WALL E	SHEET ___ OF ___ SHEETS CONTRACT NO. 16563A DRWG NO. SR-3 DATE AUG 1970
---	--	--	--	--------------------	--	-----------	---	---	--

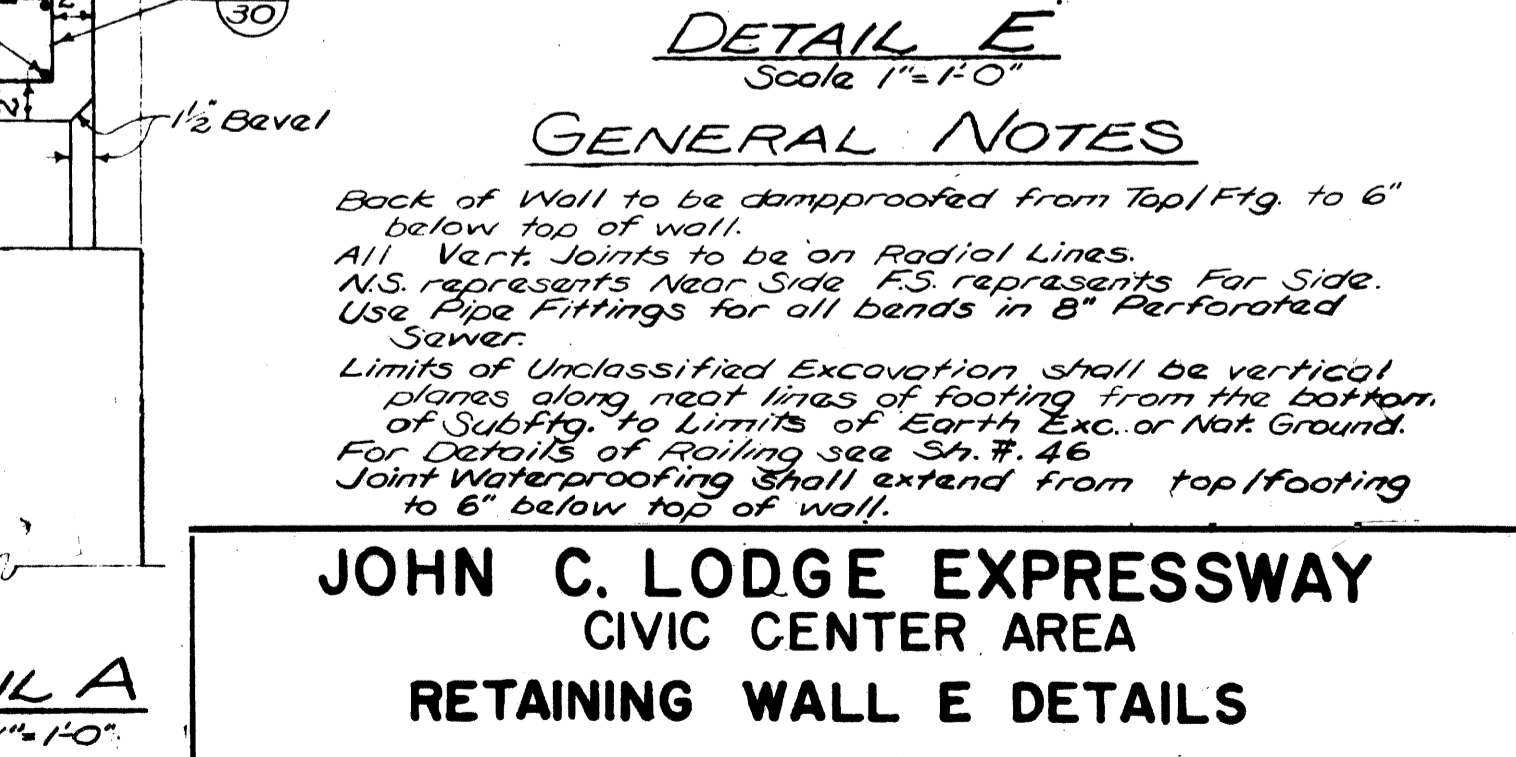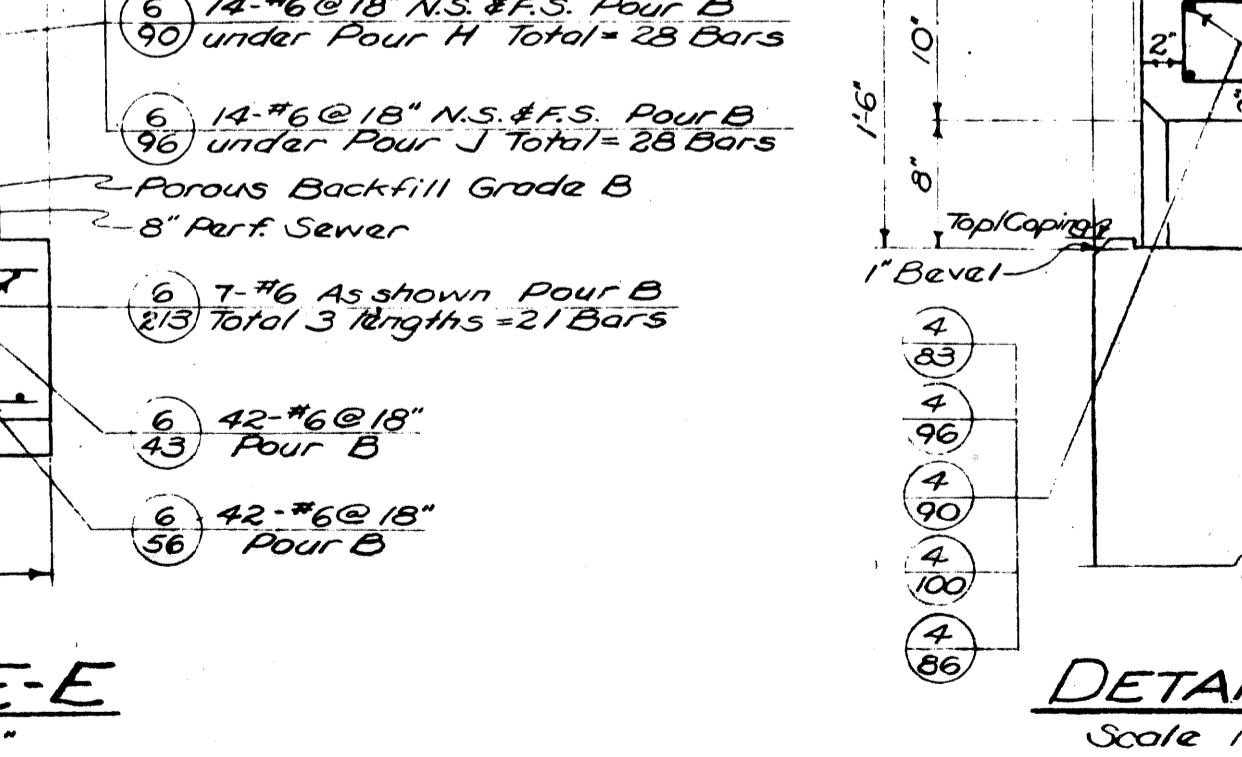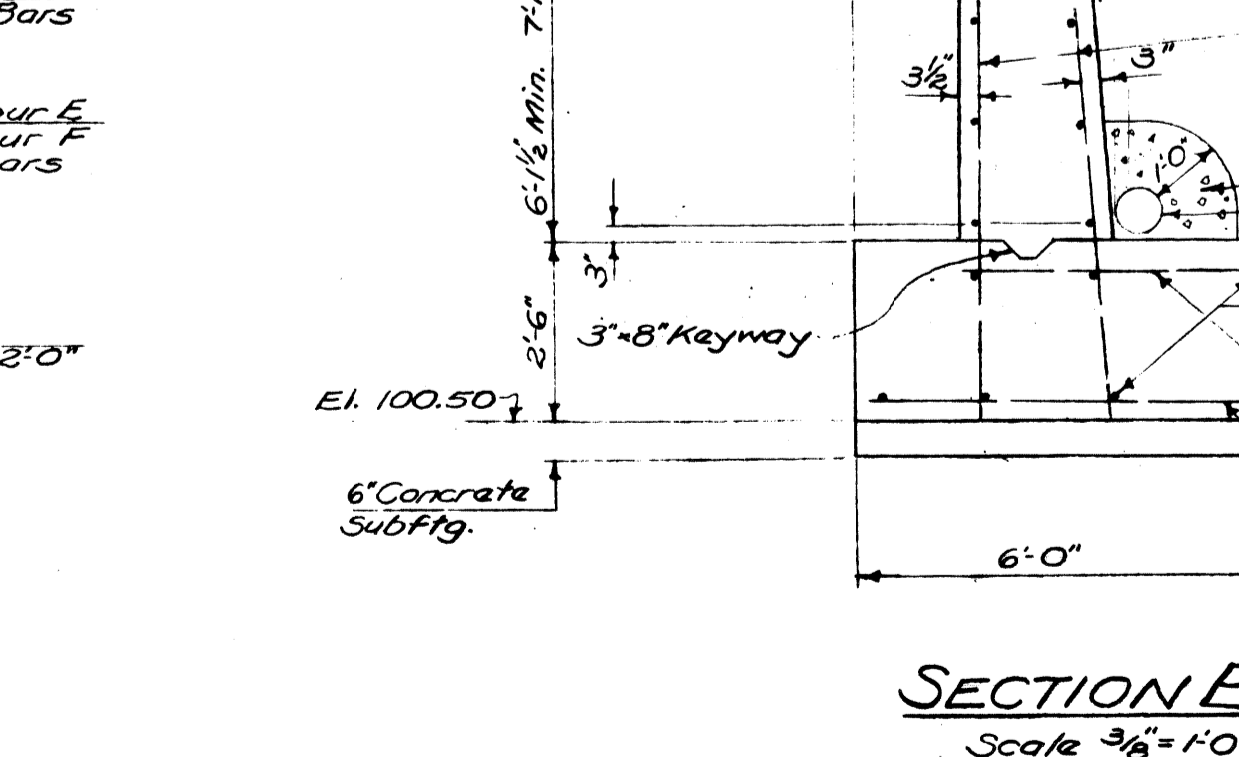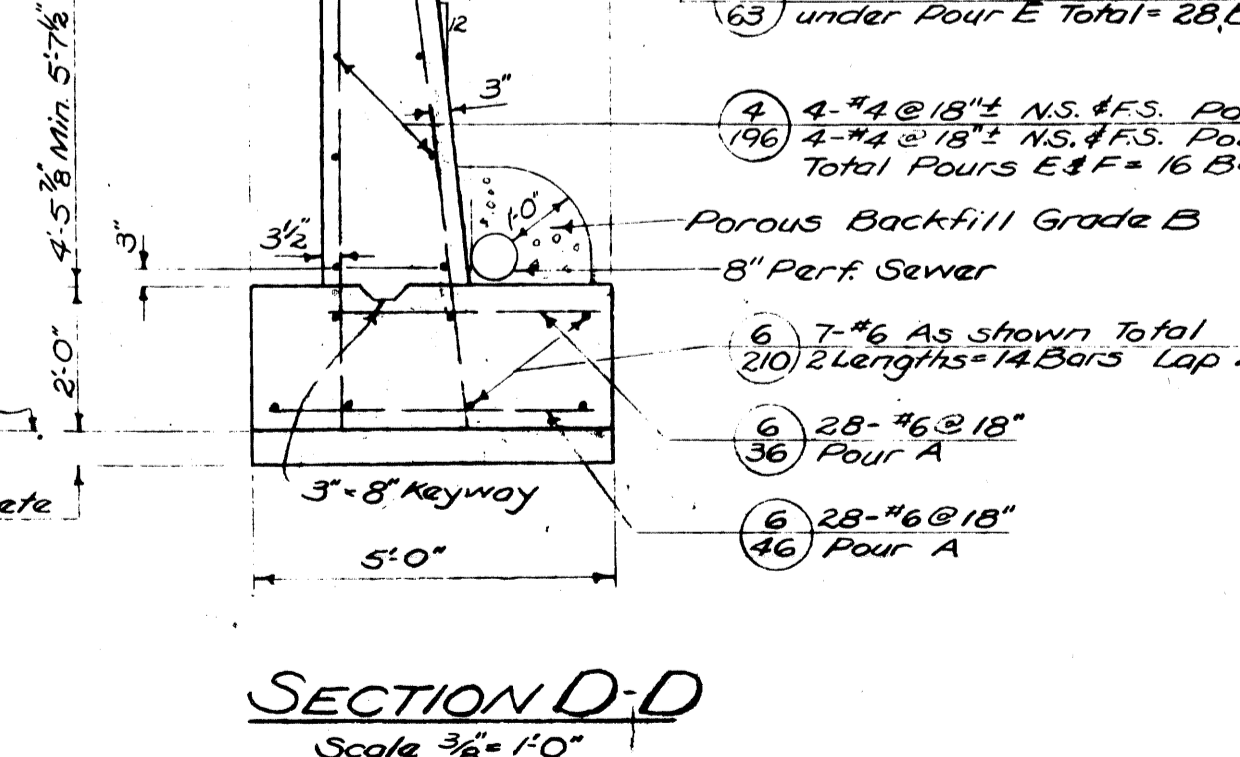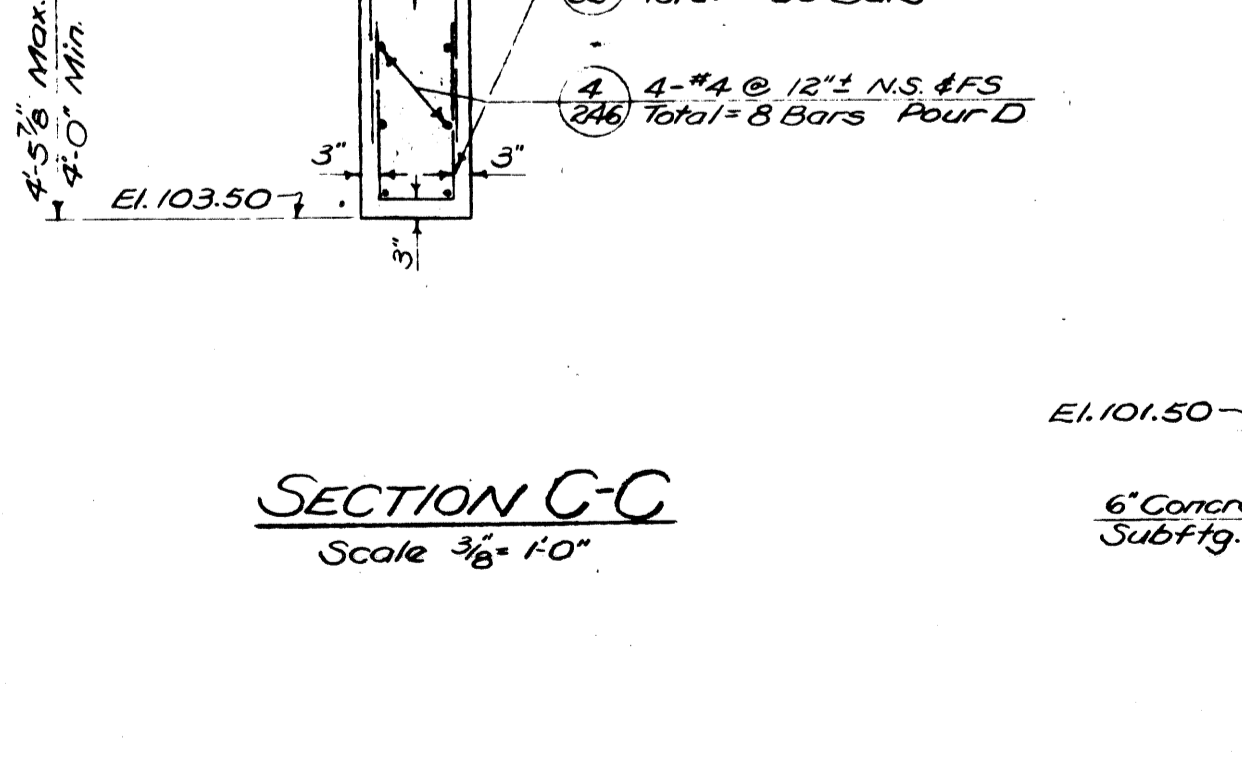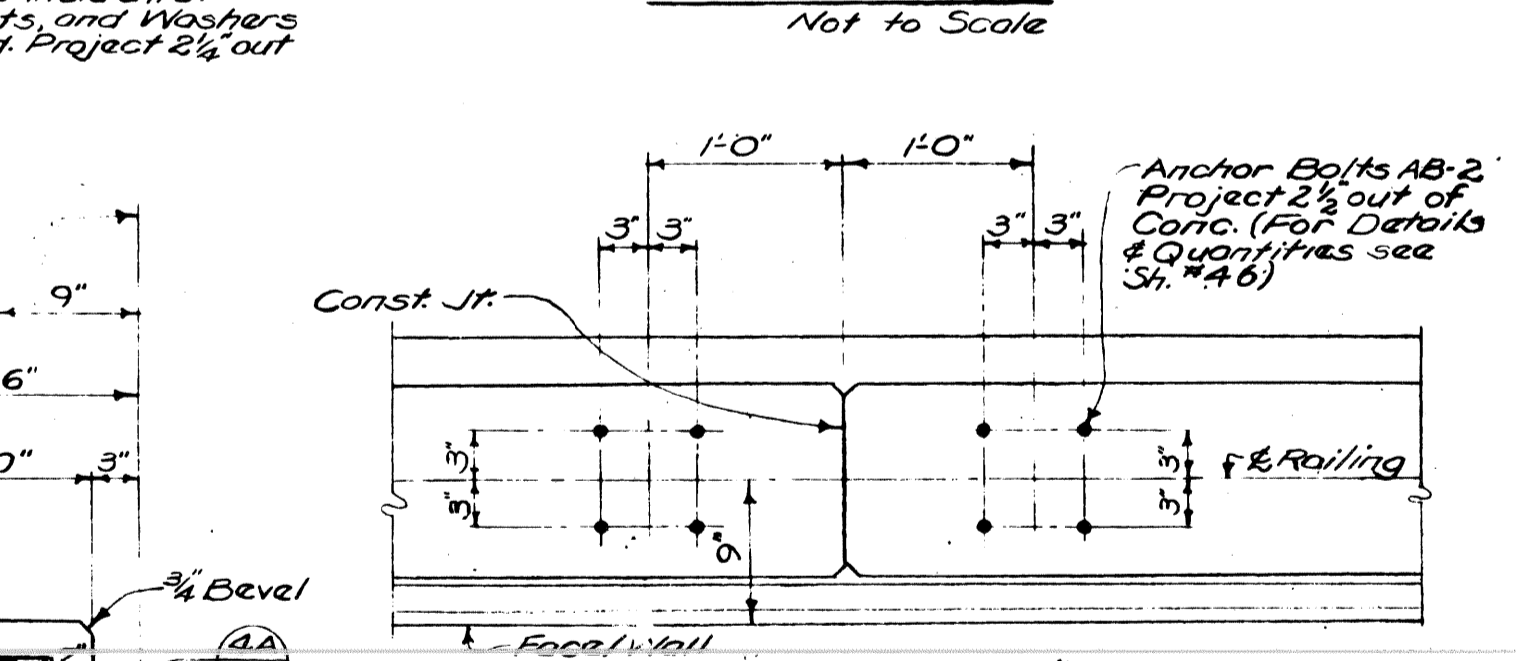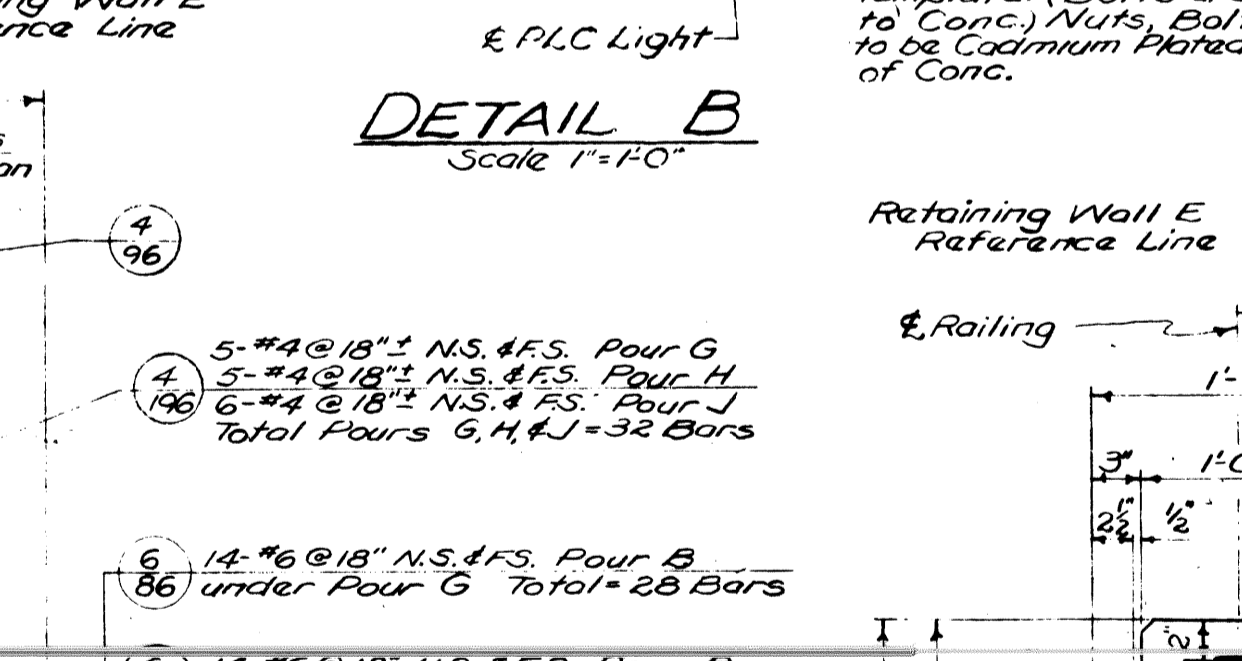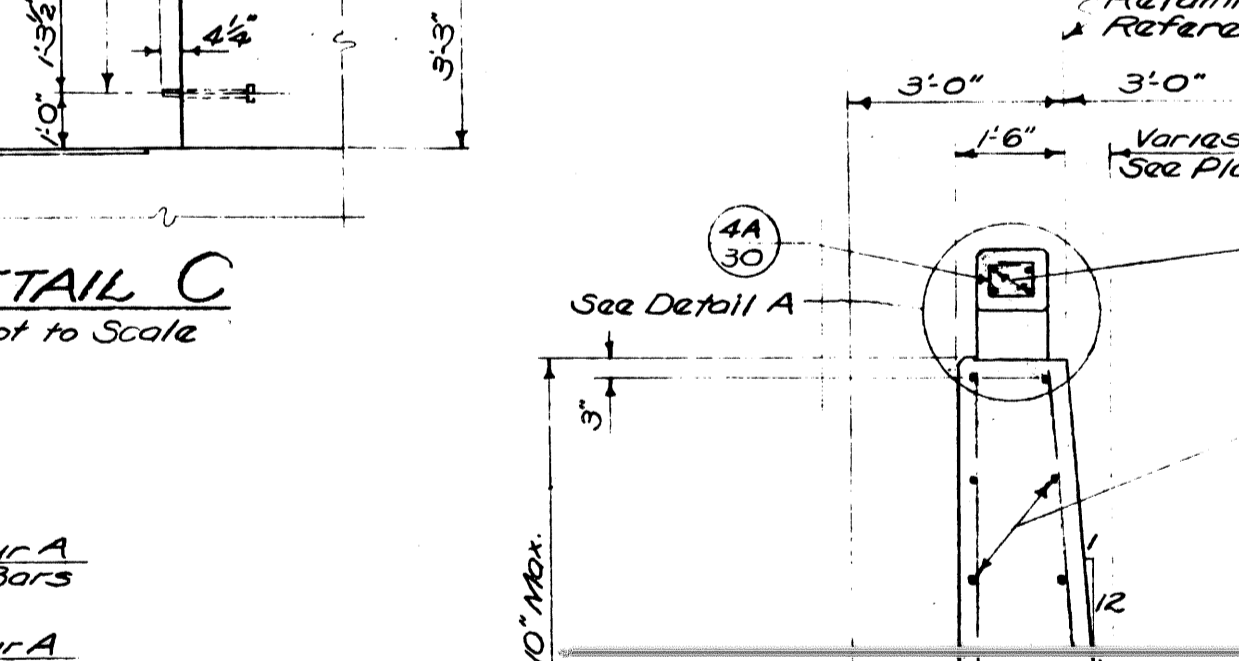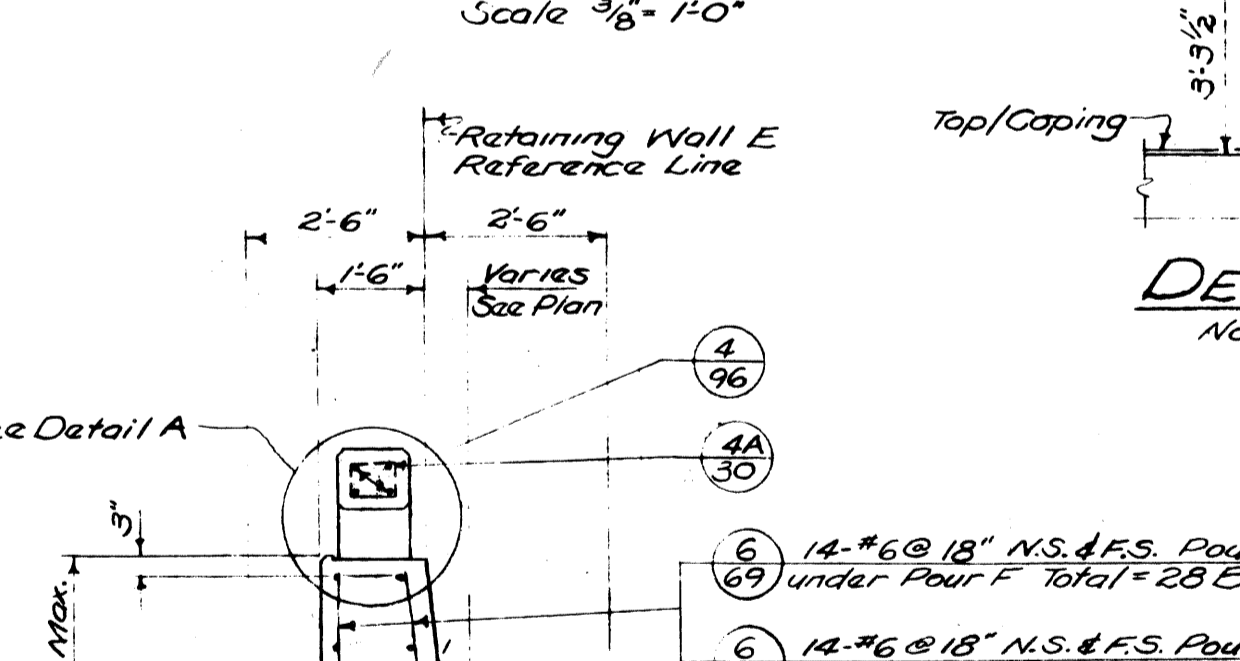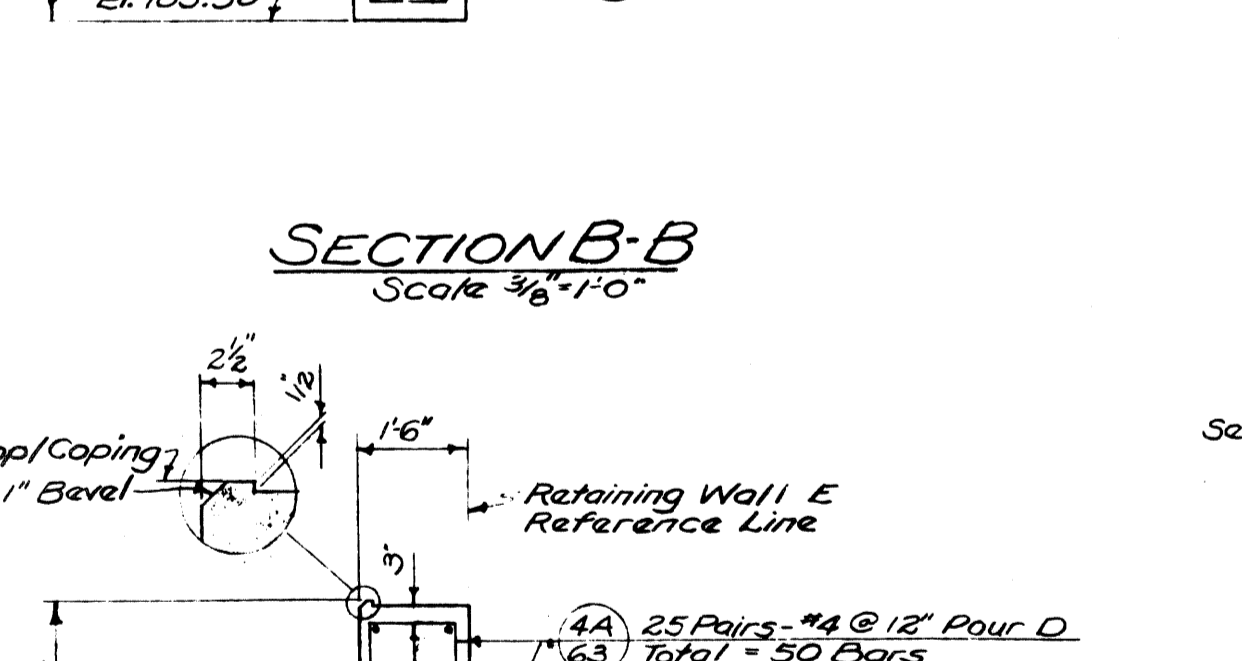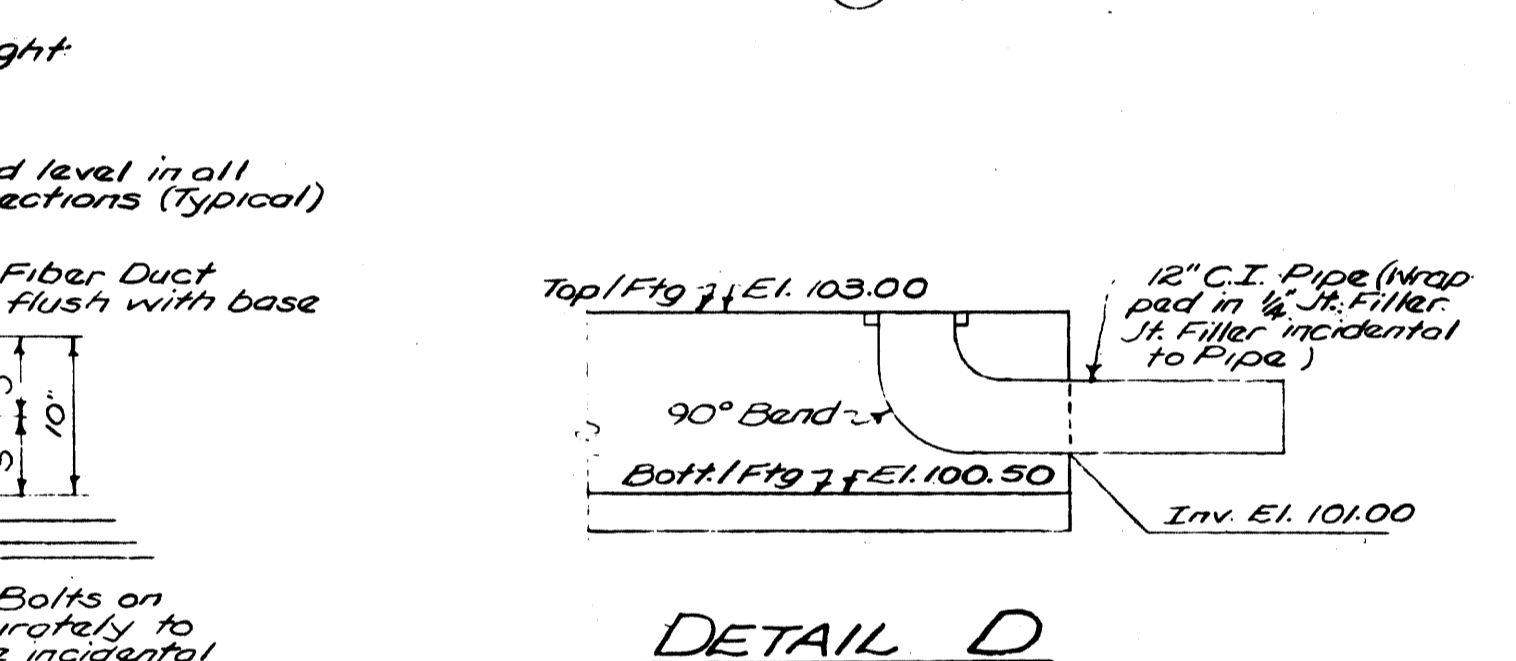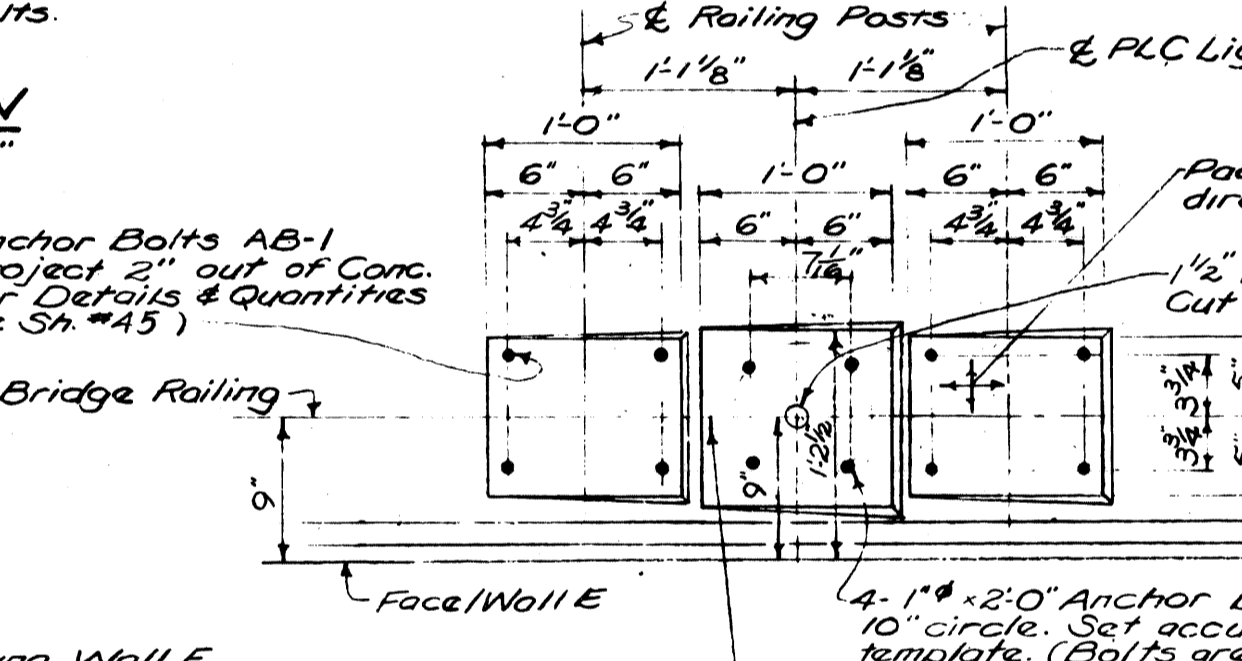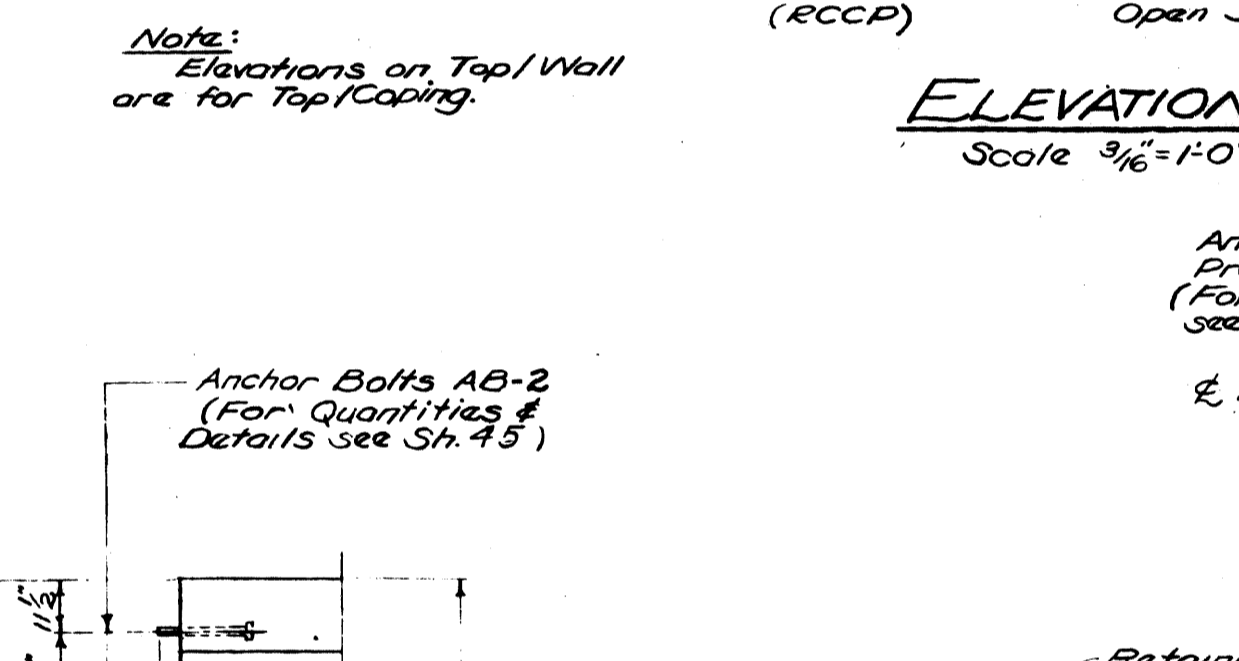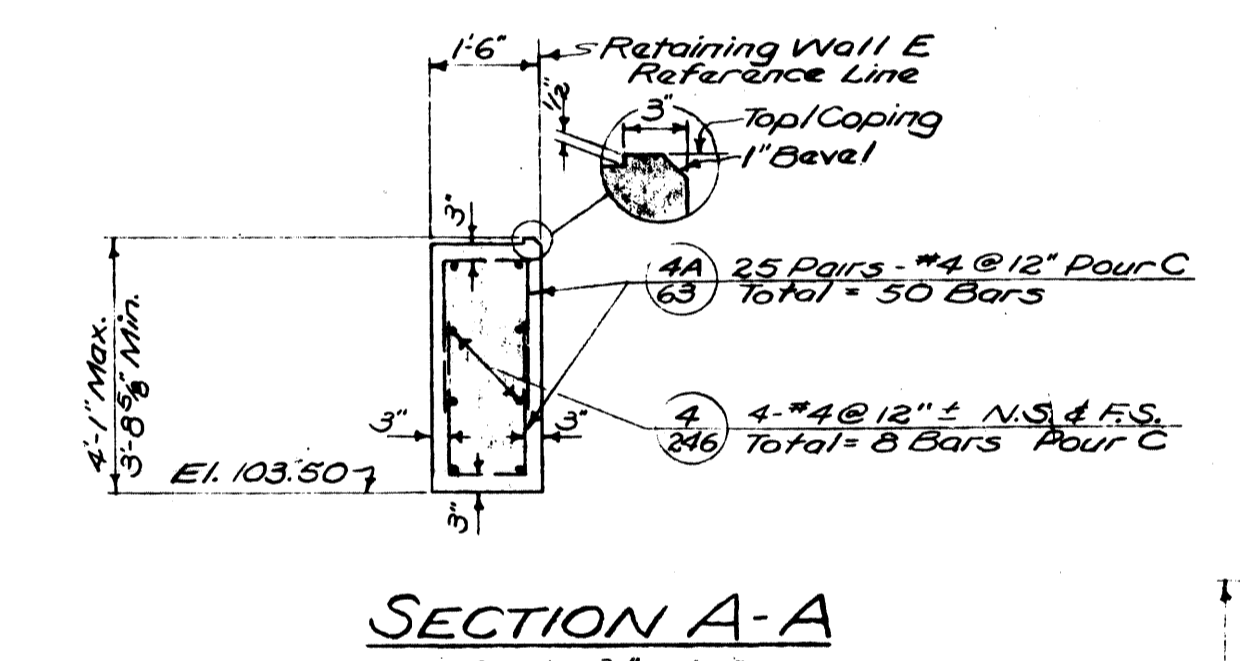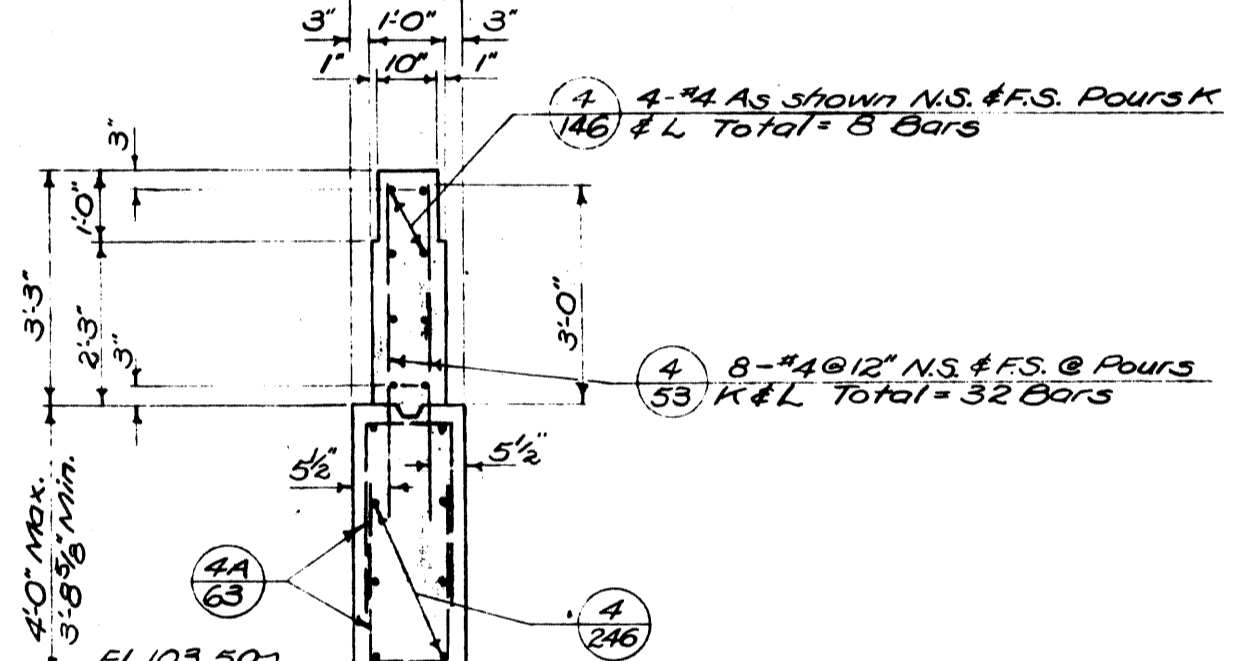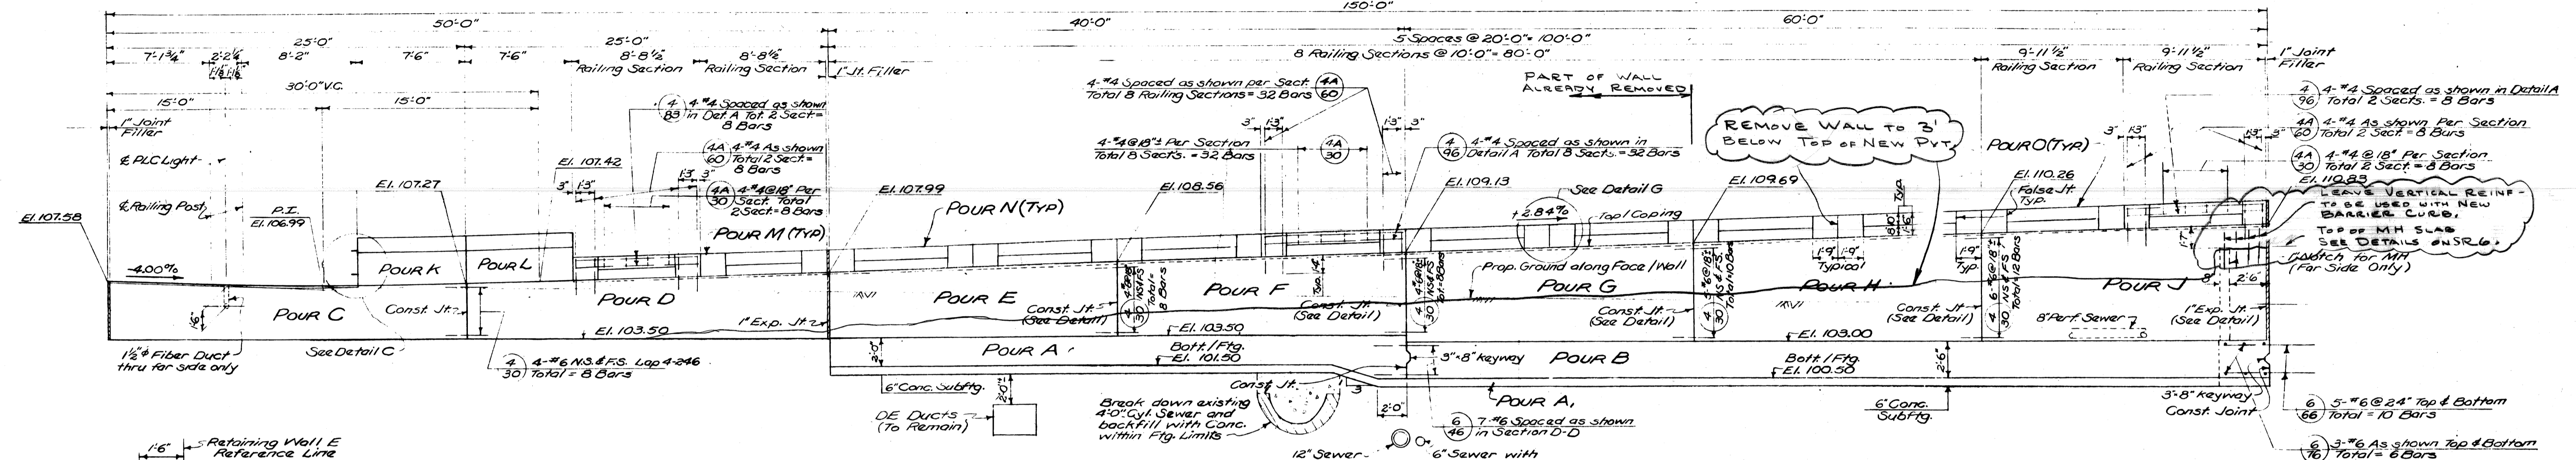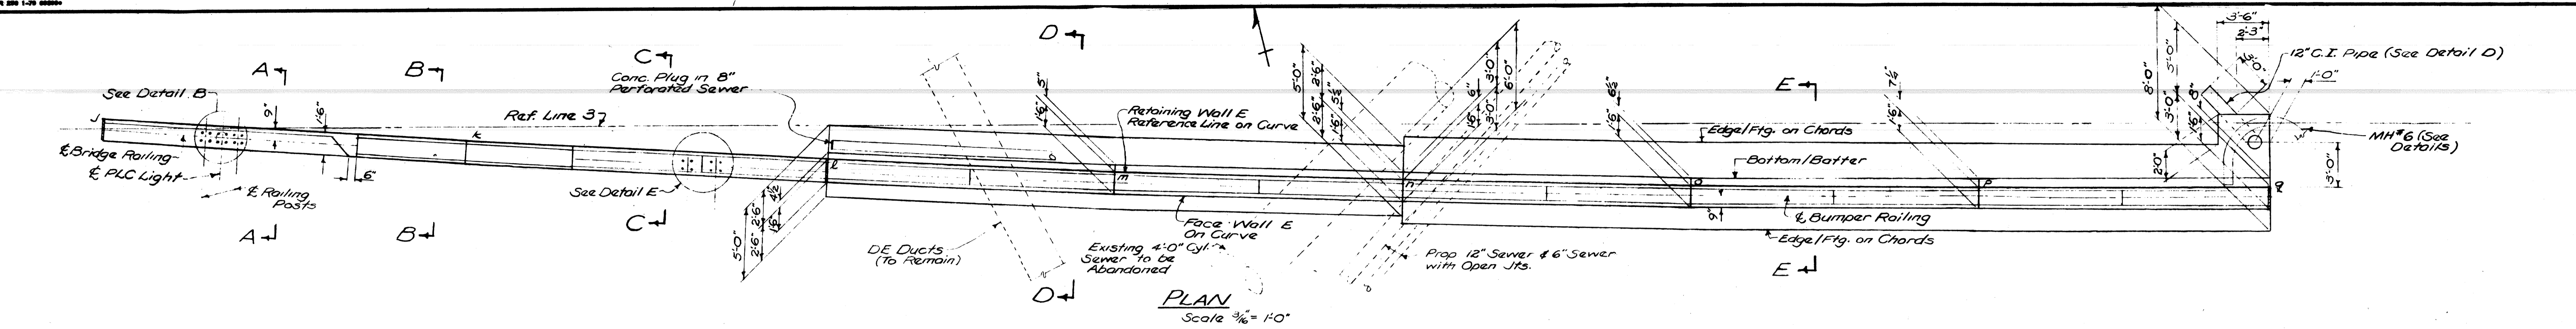

REFERENCE DRAWINGS		DESIGNED BY	APPROVED:	CITY OF DETROIT CITY ENGINEERING DIVISION - EPMD	JOHN C. LODGE EXIT RAMP AND JEFFERSON AVE RECONSTRUCTION AT THE JOE LOUIS ARENA RAMP - REFERENCE DRAWING WALL E DETAILS	SHEET ___ OF ___ SHEETS CONTRACT NO. 16563A DRWG NO. SR-5 DATE AUG 1979
DRAWN BY		TRACED BY	DESIGNED BY			
CHECKED BY		DESIGNED BY	DESIGNED BY			
COORD		DESCRIPTION	DRW CKD APVD DATE			

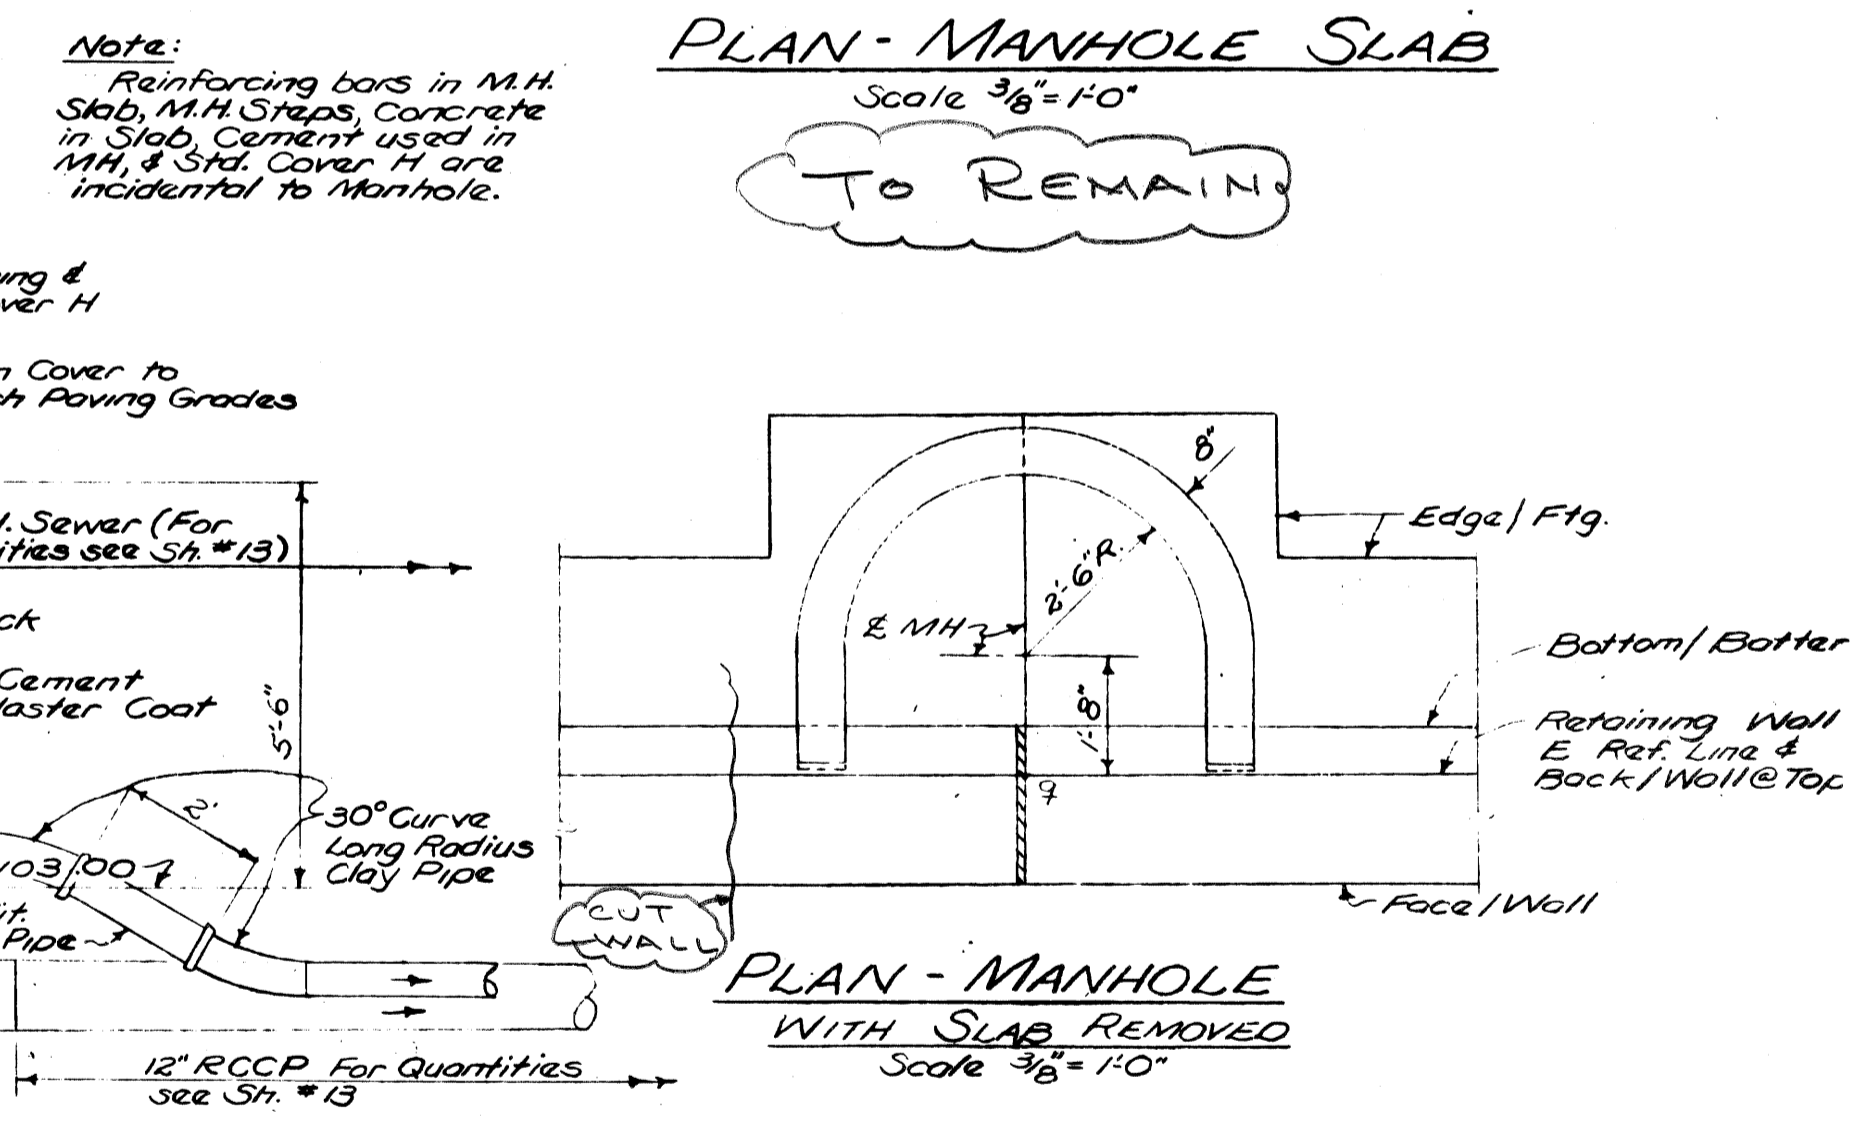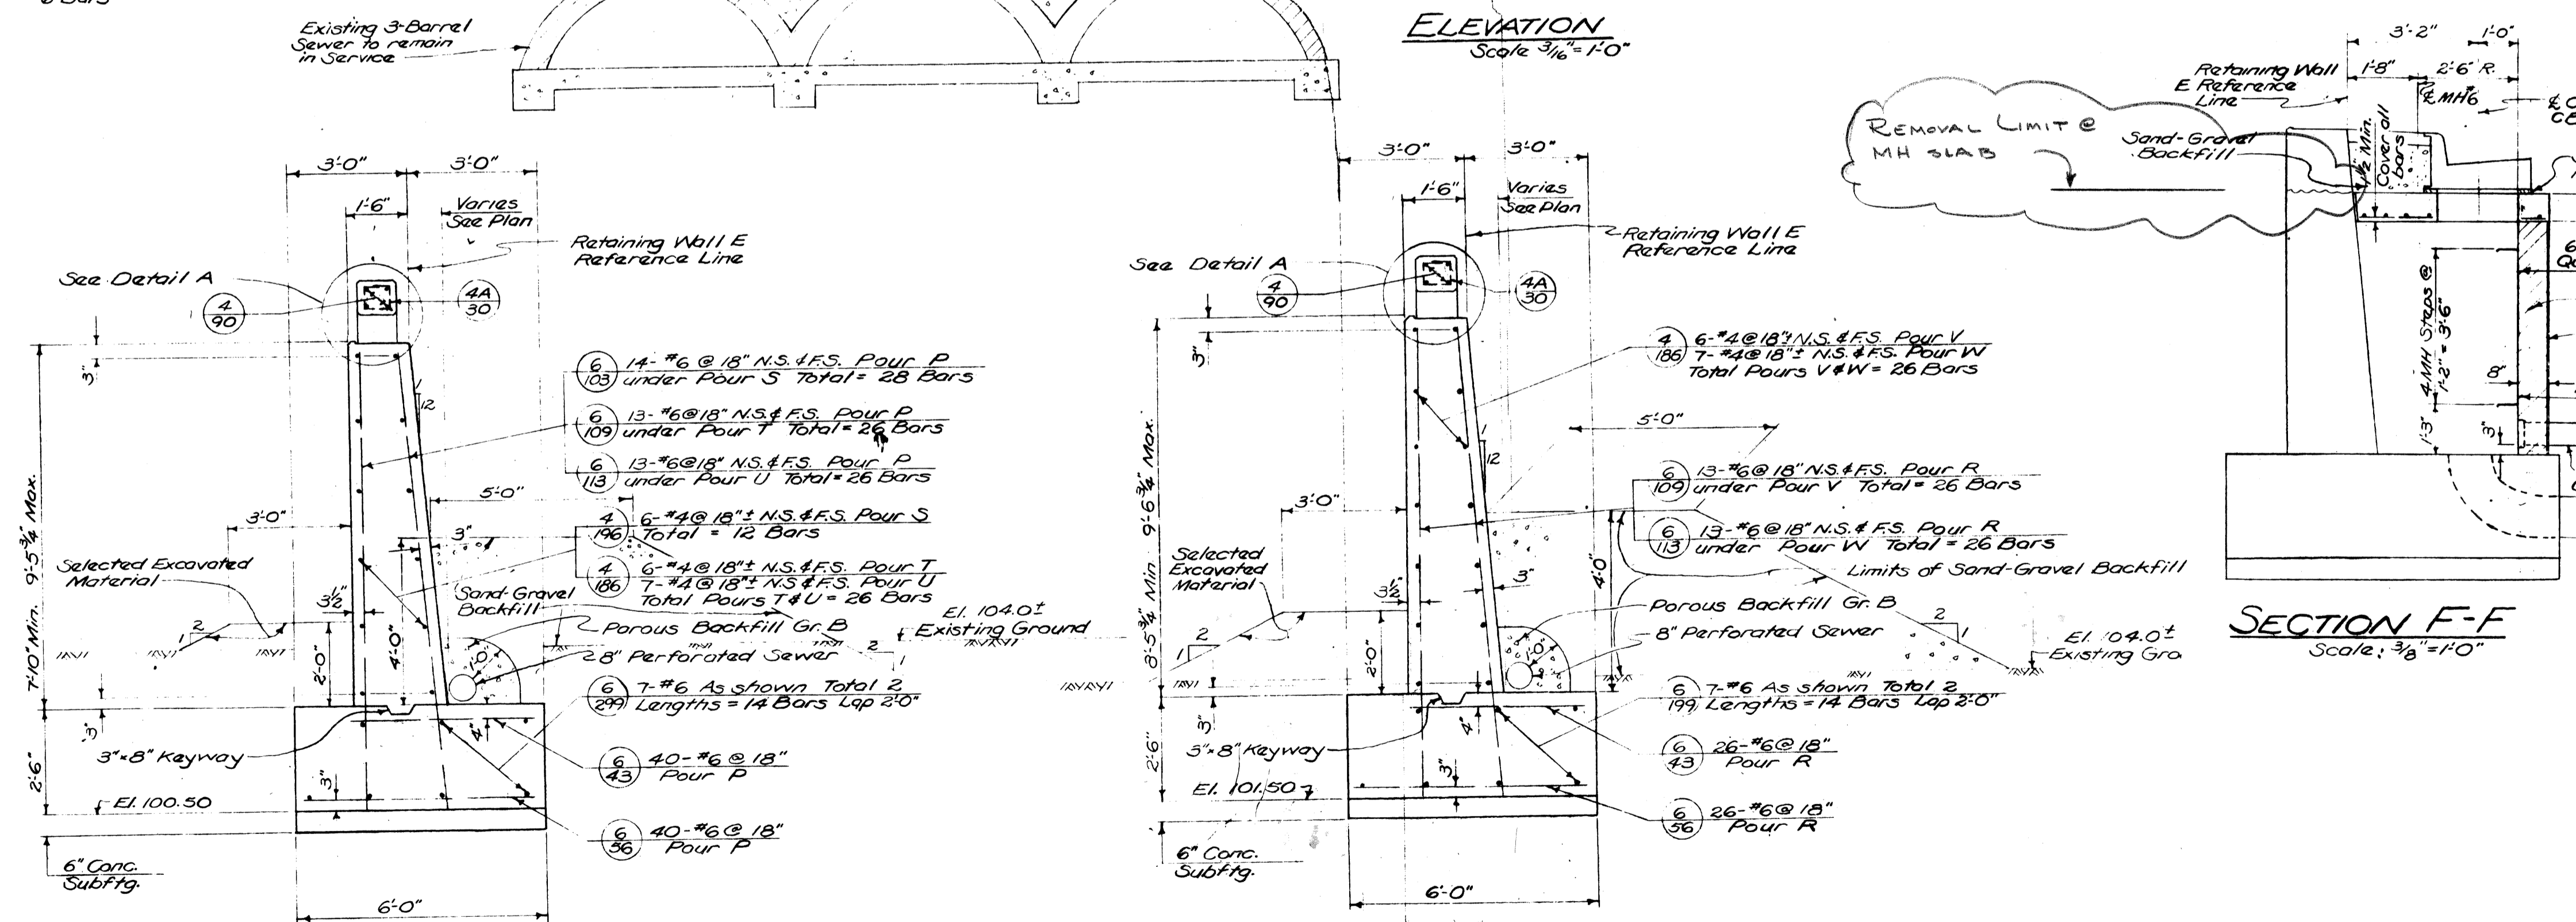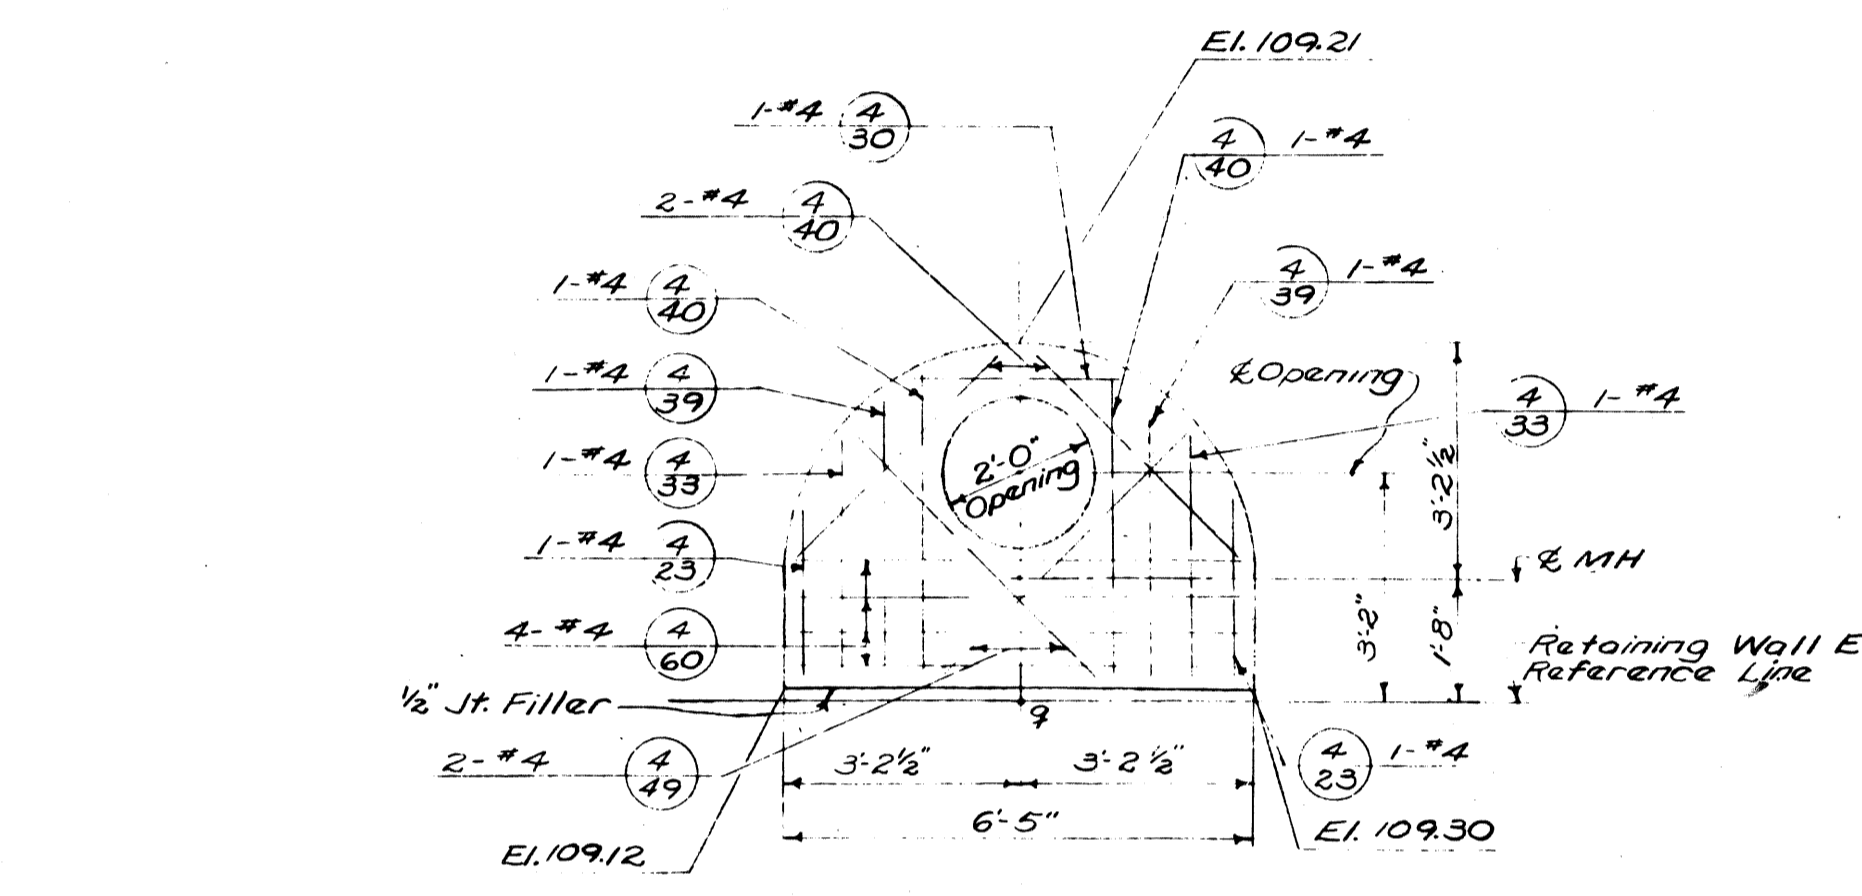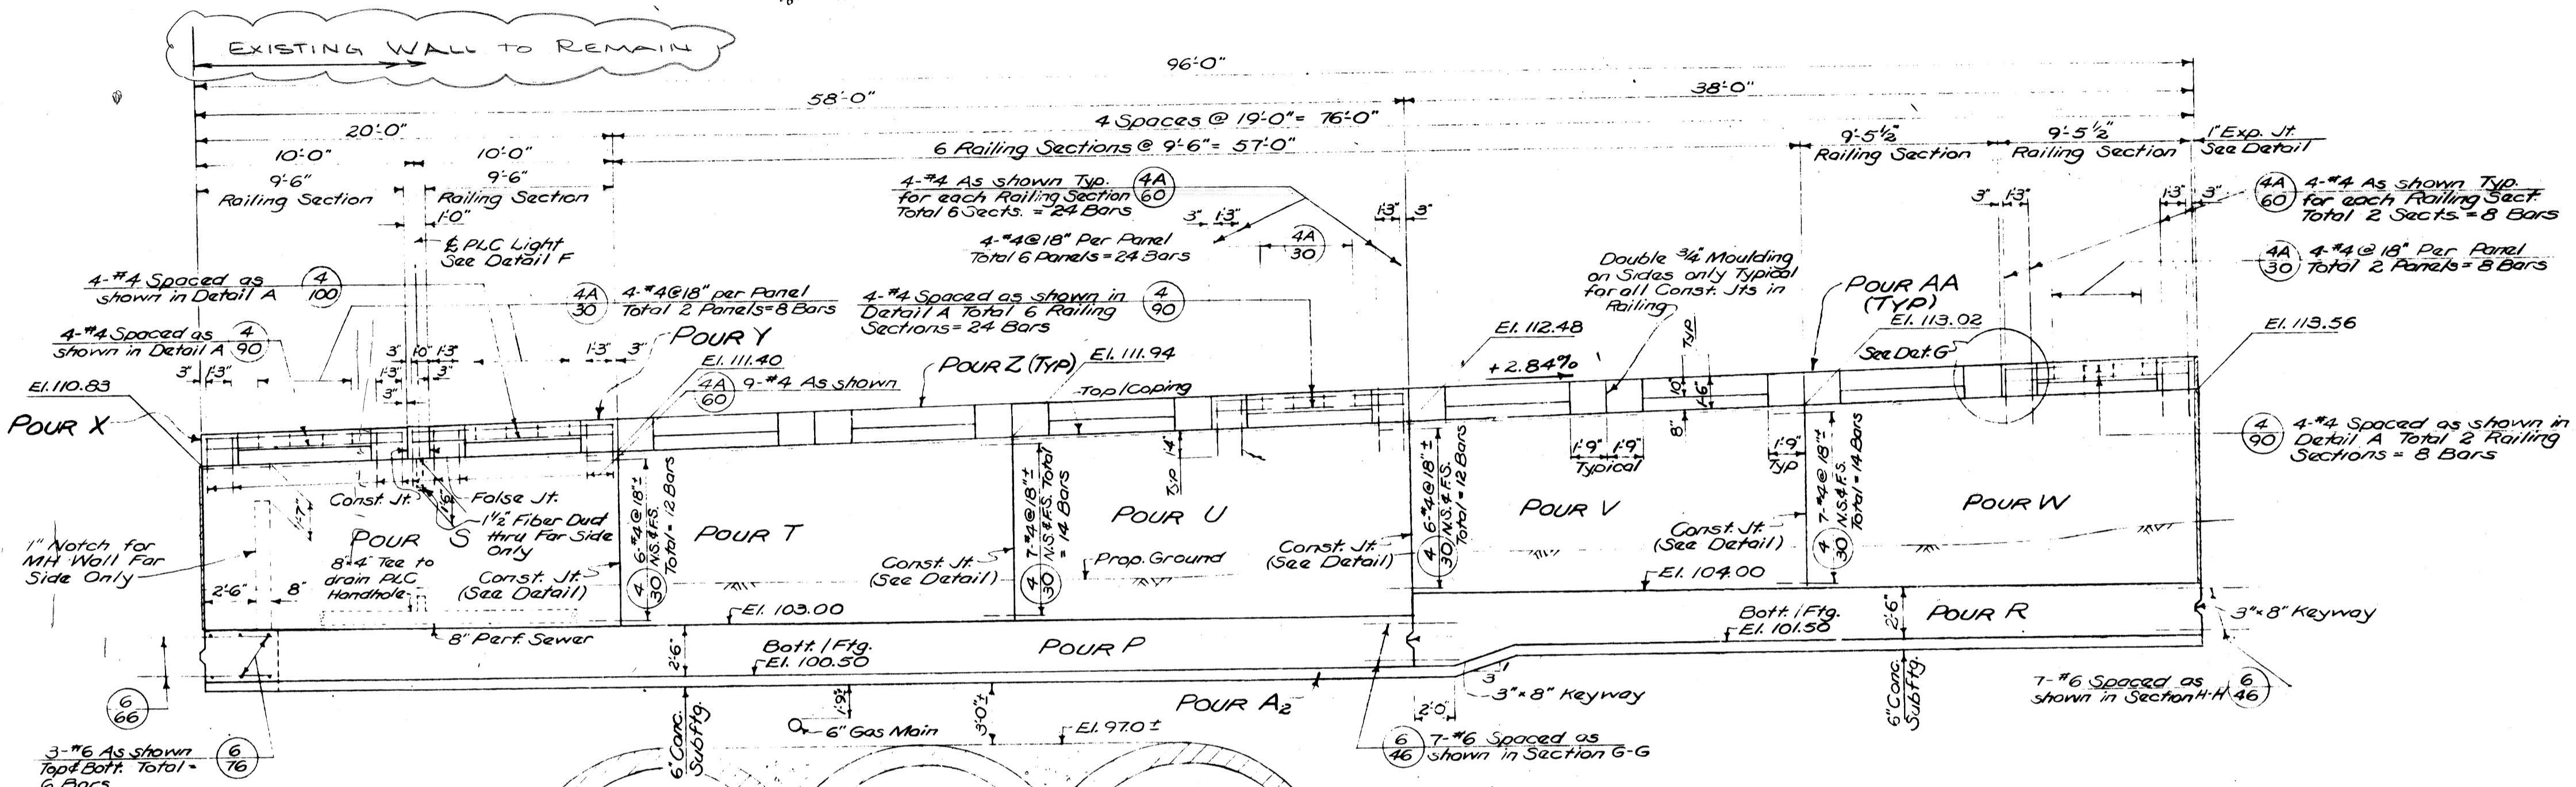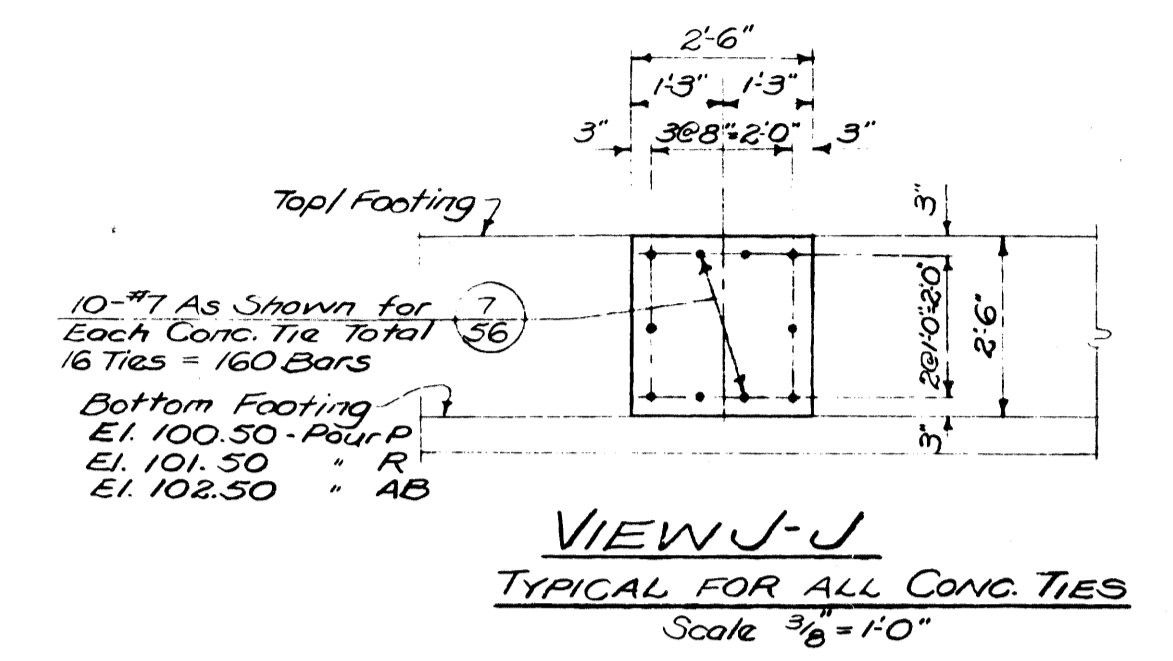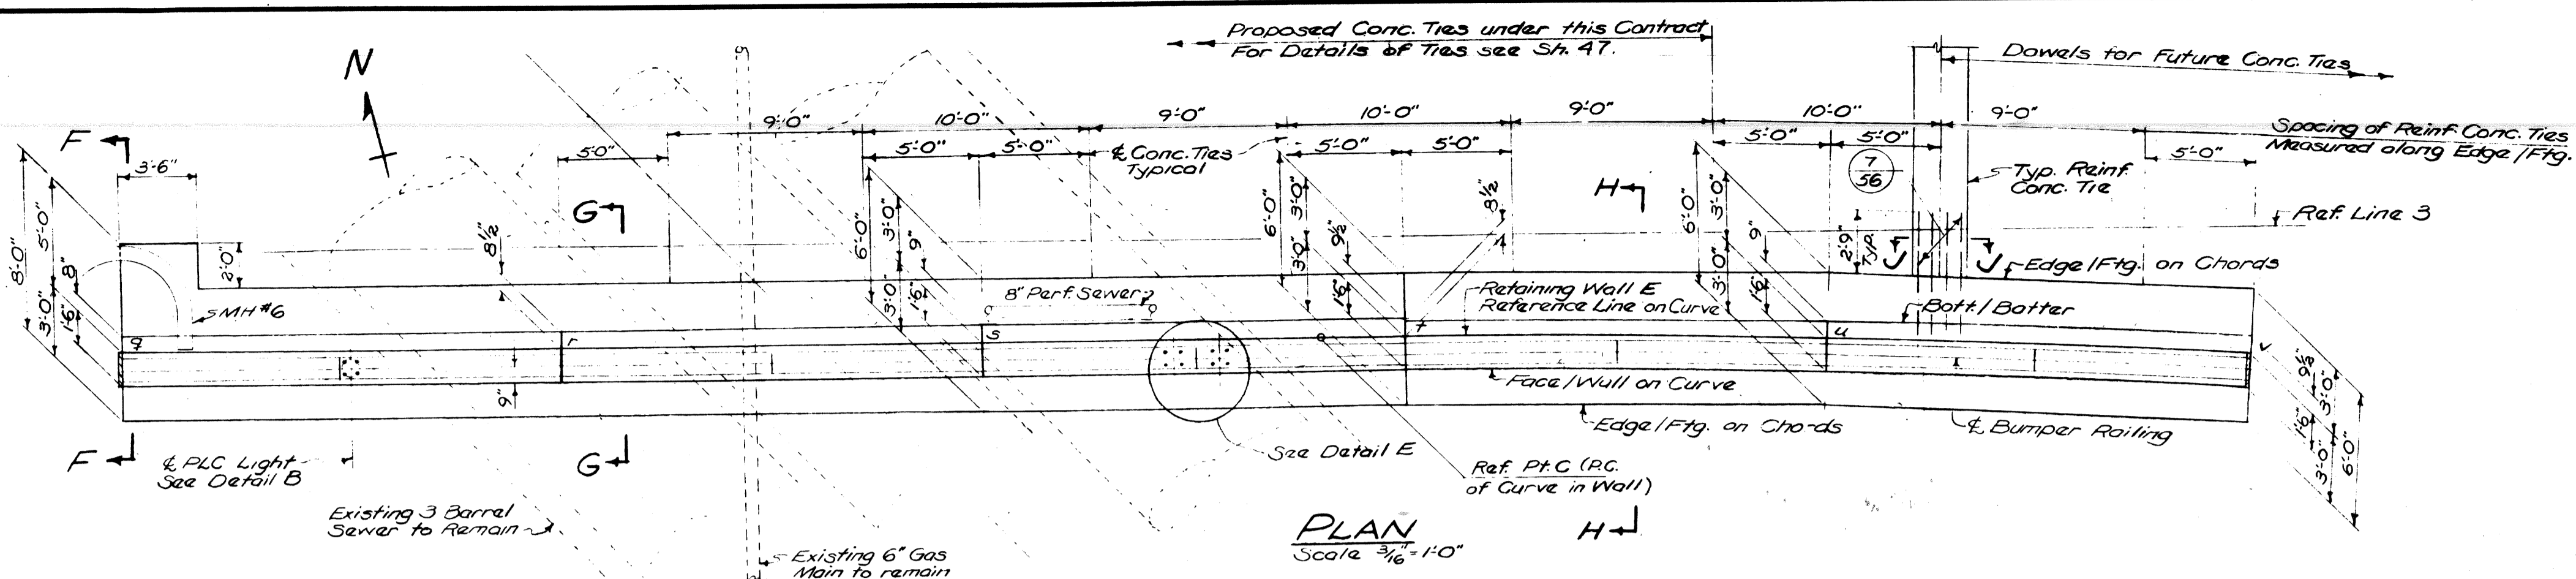

**JOHN C. LODGE EXPRESSWAY
CIVIC CENTER AREA
RETAINING WALL E DETAILS (Cont'd)**

<table border="1"> <tr> <td>COORD</td> <td>DESCRIPTION</td> <td>DRN</td> <td>CHK'D</td> <td>APV'D</td> <td>DATE</td> </tr> <tr> <td> </td> <td> </td> <td> </td> <td> </td> <td> </td> <td> </td> </tr> </table>				COORD	DESCRIPTION	DRN	CHK'D	APV'D	DATE							<table border="1"> <tr> <td>DESIGNED BY</td> <td> </td> </tr> <tr> <td>DRAWN BY</td> <td> </td> </tr> <tr> <td>TRACED BY</td> <td> </td> </tr> <tr> <td>CHECKED BY</td> <td>J.M. R.K.</td> </tr> </table>	DESIGNED BY		DRAWN BY		TRACED BY		CHECKED BY	J.M. R.K.	<table border="1"> <tr> <td>APPROVED:</td> <td> </td> </tr> </table>	APPROVED:		<p>CITY OF DETROIT CITY ENGINEERING DIVISION - EPMD</p>	<p>JOHN C. LODGE EXIT RAMP AND JEFFERSON AVE RECONSTRUCTION AT THE JOE LOUIS ARENA RAMP - REFERENCE DRAWING WALL E DETAILS</p>	<p>SHEET ___ OF ___ SHEETS CONTRACT NO. 16563A DRWG NO. SR-6 DATE AUG 1973</p>
COORD	DESCRIPTION	DRN	CHK'D	APV'D	DATE																									
DESIGNED BY																														
DRAWN BY																														
TRACED BY																														
CHECKED BY	J.M. R.K.																													
APPROVED:																														