

**CHARLEMAGNE AVE.**  
 FROM W.L. LOTS No. 31 & 42 TO N.L. GRATIOT.  
 NEW PAVING 3 1/2" SH. ASPHALT ON 8" CONCRETE BASE.  
 30 FT. WD.

CHARLEMAGNE FROM GRATIOT TO GUNSTON  
 NOTE: CHANGED TO GUNSTON

Widening of Charlemagne Street & Corner  
 10-19-54  
 C.C.

CHANGE TO  
 GUNSTON AVE

SCALE: HOR. 1" = 100'	DATE: 10-23-25
VER. 1" = 10'	
PLAN DRAWN BY	H.J. SMART
PLAN CHECKED BY	C.E. S.
PROFILE DRAWN BY	H.J. S.
NOTATIONS MADE BY	
CHECKED BY	

CS 20  
 -46  
 -26  
 2020  
 -24  
 1996

Excavation	LOTS	CITY
B.516 P. 25.	1719	157
Excavation	1996	
N. C. Straight		
Old Curb Reset	22	93
N. C. Red. Grade by Contr.	3412	319
Paving	3412	319
" Concrete Base	3412	319
Curb Concrete	100	6
Est. Stone		138
Concr. Header Sq. Yds		

CONCRETE CURB  
 AMENDED & FINAL ESTIMATE  
 October 11, 1926.






B.M. & T.P. 140.28  
 TOP OF HYD. N.W. COR.  
 CHARLEMAGNE & MARLEY.

B.M. 139.09  
 SCREW IN L.P. ON BEND AT  
 CHARLEMAGNE & MARLEY.  
 B.M. 139.96  
 TOP OF HYD. S.E. COR.  
 ROSEMARY & GRATIOT.


LOTS	CITY	TOTAL
2145	2214	102218
121	38	60150
		108336

2051 - 192

50161

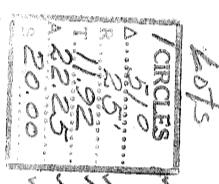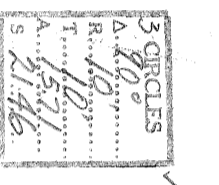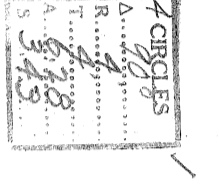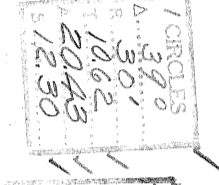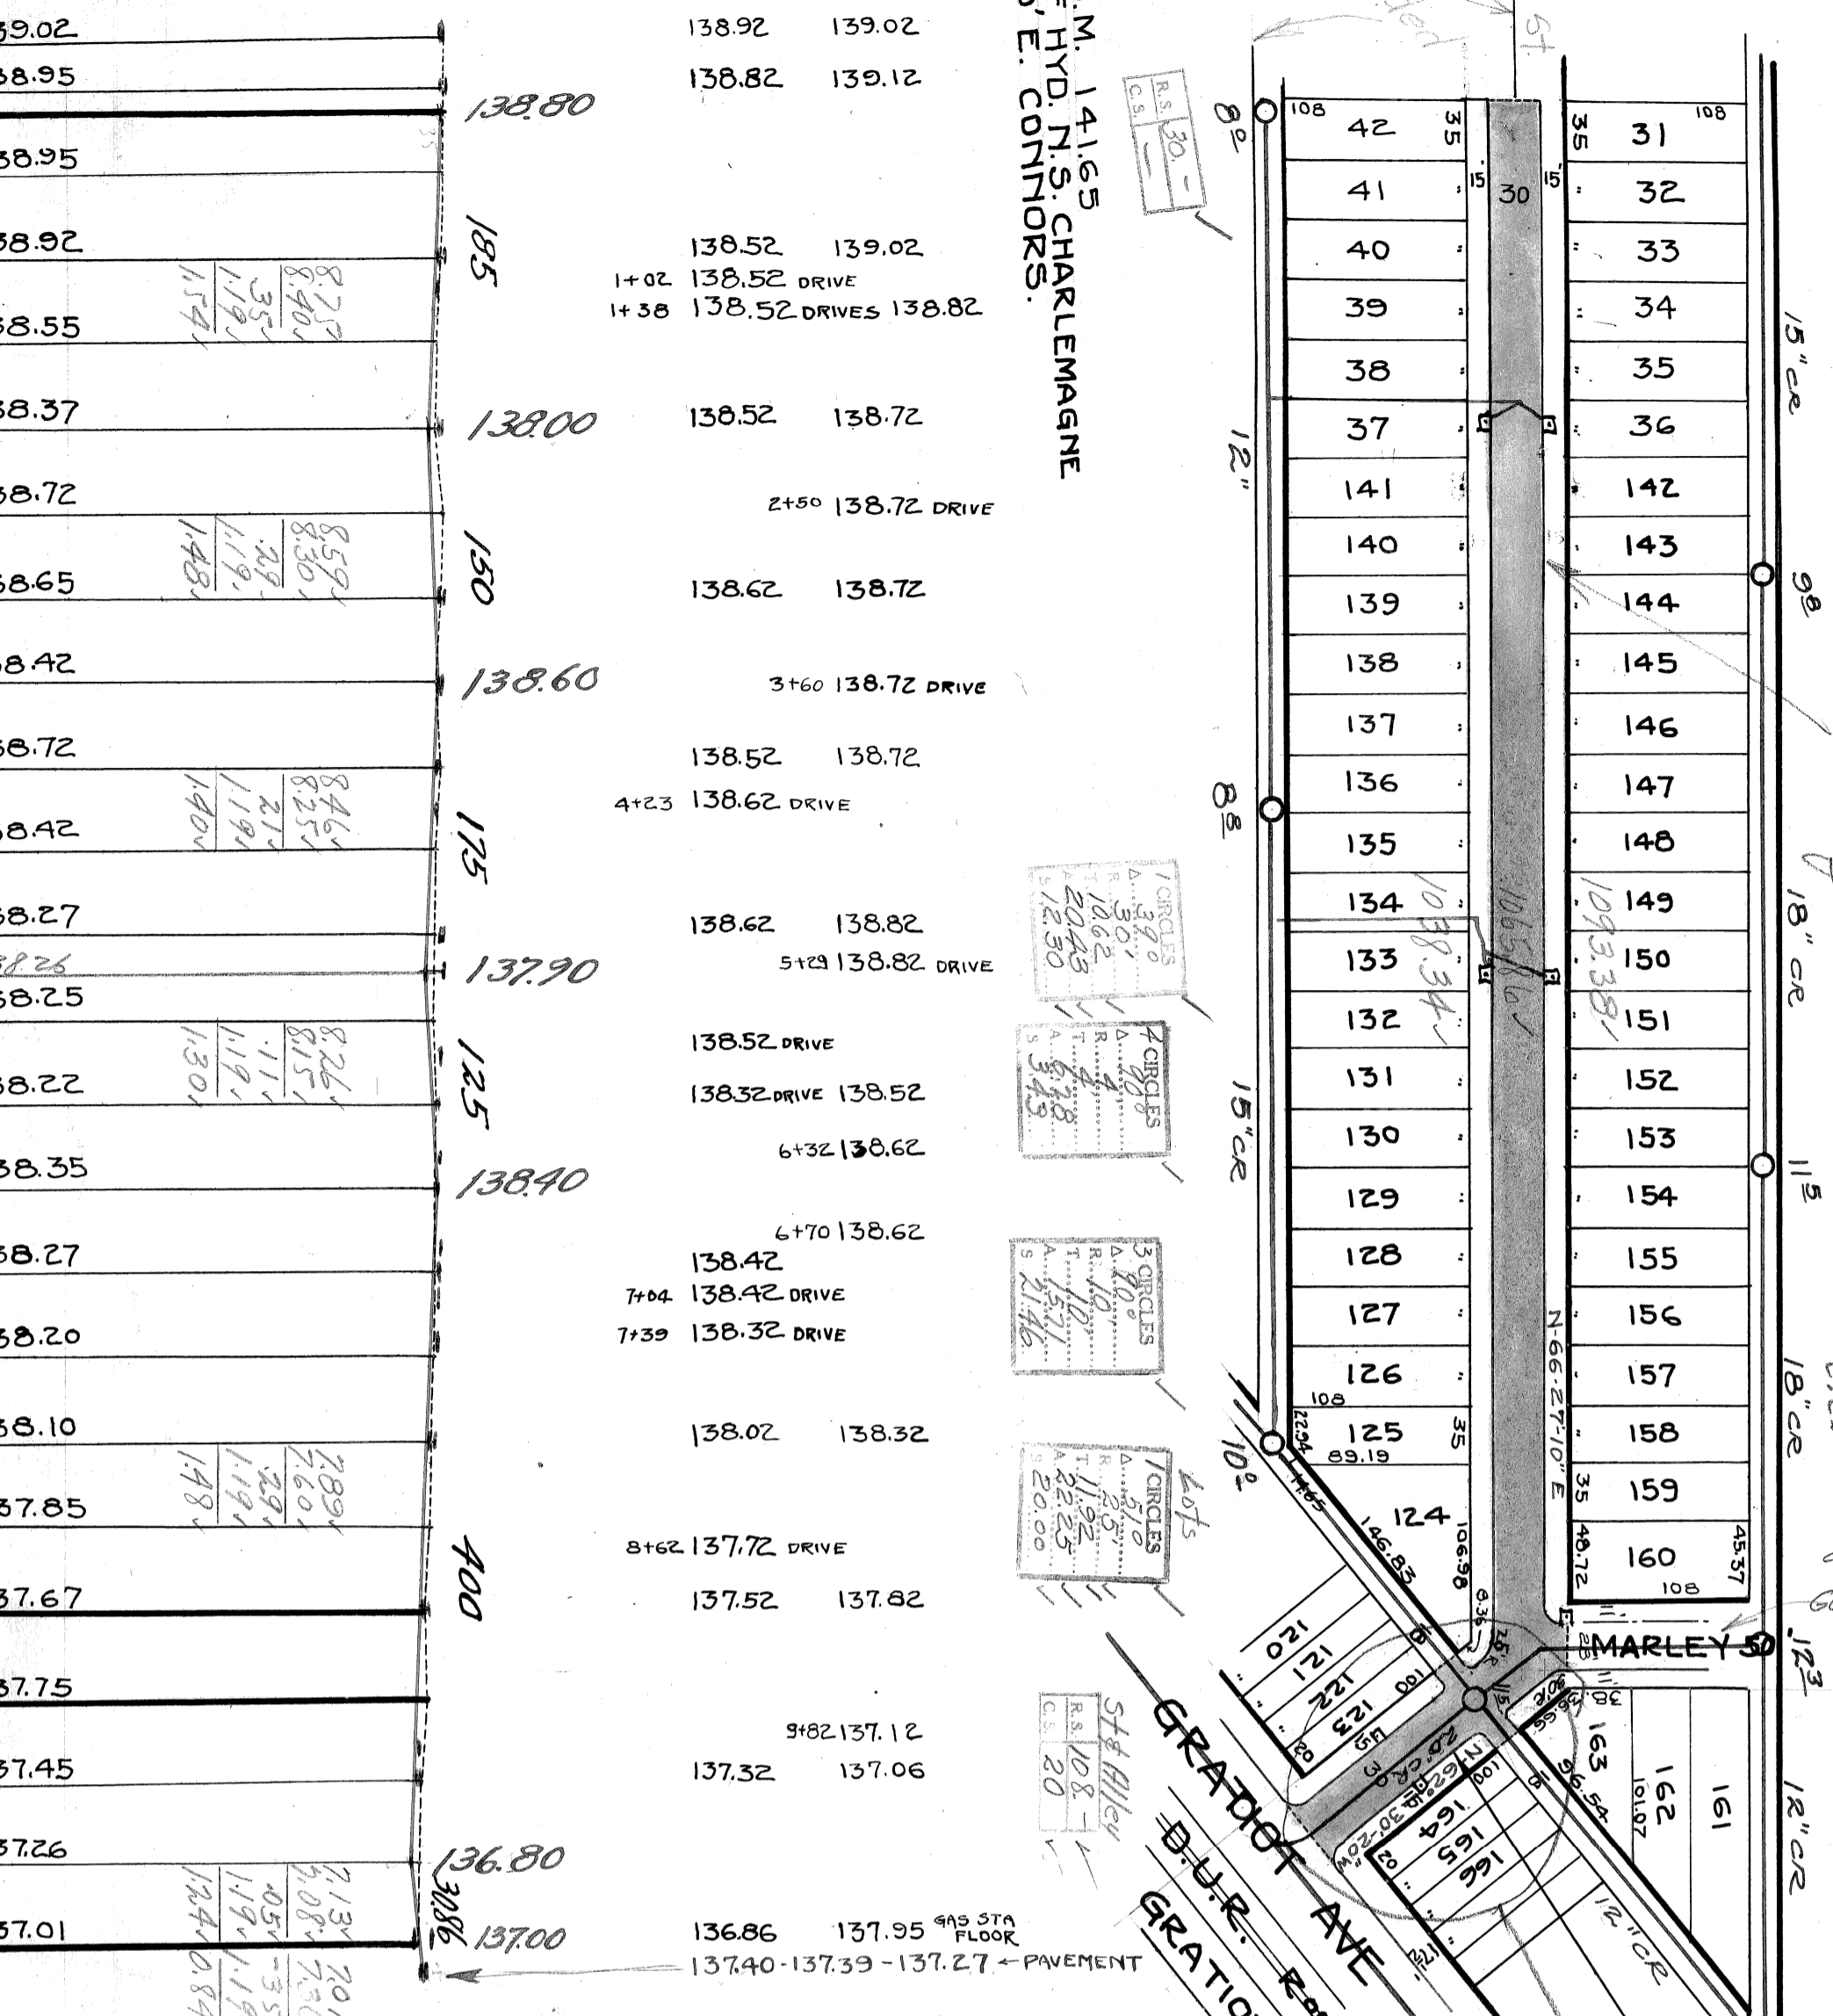

139.02	138.92	139.02
138.95	138.82	139.12
138.95	138.80	
138.92	185	138.52 139.02
138.55		1+02 138.52 DRIVE
138.37	138.00	1+38 138.52 DRIVES 138.82
138.72		2+50 138.72 DRIVE
138.65	150	138.62 138.72
138.42	138.60	3+60 138.72 DRIVE
138.72		138.52 138.72
138.42	175	4+23 138.62 DRIVE
138.27	137.90	138.62 138.82
138.25		5+29 138.82 DRIVE
138.22	125	138.52 DRIVE
138.35	138.40	138.32 DRIVE 138.52
138.27		6+32 138.62
138.20		6+70 138.62
138.10		138.42
137.85		7+04 138.42 DRIVE
137.67		7+39 138.32 DRIVE
137.75		138.02 138.32
137.45		8+62 137.72 DRIVE
137.26		137.52 137.82
137.01		9+82 137.12
		137.32 137.06
		9+95 STA FLOOR
		136.86 137.95
		137.40-137.39-137.27 - PAVEMENT

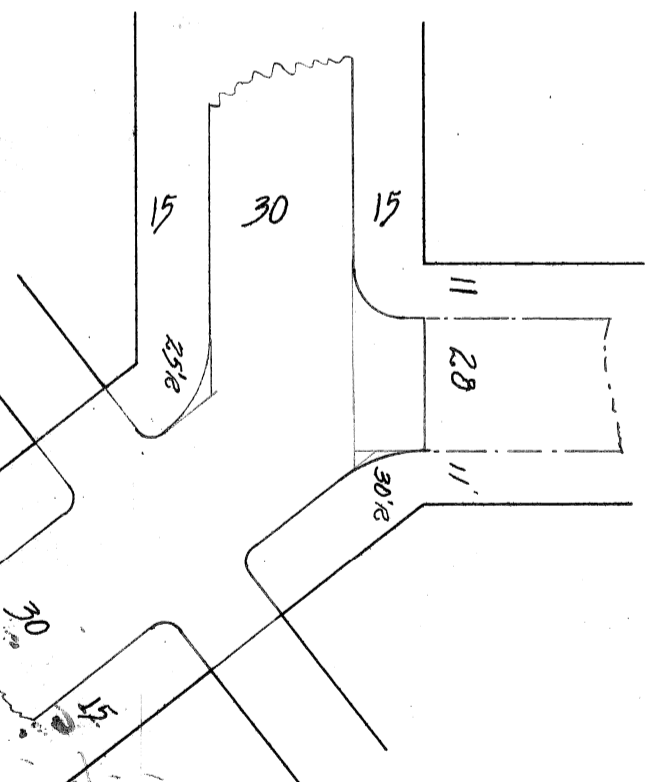

96	26
30.9	104
26	137.06
136.80	137.16