

DEPARTMENT OF PUBLIC WORKS DETROIT  
CITY ENGINEERS OFFICE - DIVISION OF PAVING DESIGN  
**STREET PAVING PLAN**  
PURITAN AVENUE

NAME OF STREET: PURITAN AVENUE  
FROM: W.P.L. OF CHATHAM  
TO: E.P.L. OF DACOSTA  
TYPE OF PAVEMENT: DRAINAGE ONLY  
WIDTH: 36 FT.

REQUESTED BY: Fox 4-7-49 (PHONE)  
LAMPHERE - DACOSTA - Requested by Miller 12-2-50  
WELER STARTED DRAINAGE 5/14/49

BENCH MARKS	ELEVATION
B.M. #113-301 SPIKE IN 24" OAK, N.E. COR. PURITAN & LAHSER	151.288
ARROW ON HYD. S.E. COR. PURITAN & CHATHAM	154.921
" " " S.W. " " & LAMPHERE	153.651
" " " S.E. " " & DACOSTA	155.451

**NOTE**  
 AT (A) CONSTRUCT 7 STD. 18"x12" Y BRASS COMPLETS & CONNECT TO EXISTING JEWEL MANHOLE AT MAIN & ADJUST TOPS OF 2 EXISTING JEWEL MANHOLES  
 AT (B) ABANDON EXISTING CATCH BASIN & BRICK OUTLET  
 AT (C) CONSTRUCT SMALL FURNISH & INSTALL STD. PLAT TYPE CATCH BASIN FRAME & GRATES  
 NOTIFY D.P.W. TO SALVAGE OLD COITINGS

CARD NO.	
INDEX NO.	73
TOPO. NO.	121
RECORD NO.	

DESIGNED BY: *Anna Babing*  
 DRAWN BY: *Anna Babing*  
 TRACED BY: *W.H.D.*  
 CHECKED BY: *W.H.D.*  
 APPROVED: *J.L. Martin*  
 ENGINEER OF STREETS  
*Martin R. Fisher*  
 ASST. CITY ENGINEER


NO. SCALE: 1" = 2'	DATE: 12-13-43	COMPUTED: 123
PLAN CHECKED: 223	A.F. GRADE: 6.5	CHECKED: 6.5
LOT 2L: 1440	LENGTH: 720	46
CITY TOTAL: 226	LENGTH: 118	00
CITY TOTAL: 1666	LENGTH: 893	46

QUANTITIES	LOTS	CITY
EXCAVATION	1173	331
STRAIGHT CURB NEW	1425	42
OLD CURB RESET		
CIRCULAR CURB	166	166
PAVING	2882	670
CONCRETE BASE		
WALKS	144	144
MANHOLES - ADJ.	1	1
BASINS - CONST.	5	2

PROGRESS	START	FINISH
DATE		

BLUE PRINT ISSUED FOR:	
GRADE ONLY	
CATCHBASINS	
PAVING-CLASS.	
DEPT. OF WATER SUPPLY	
GAS CO.	

SEWER OK	DATE: 1-20-44
INDEXED	
REVISIONS: GRADE CHANGE 5/26/49	
E.N.E.	

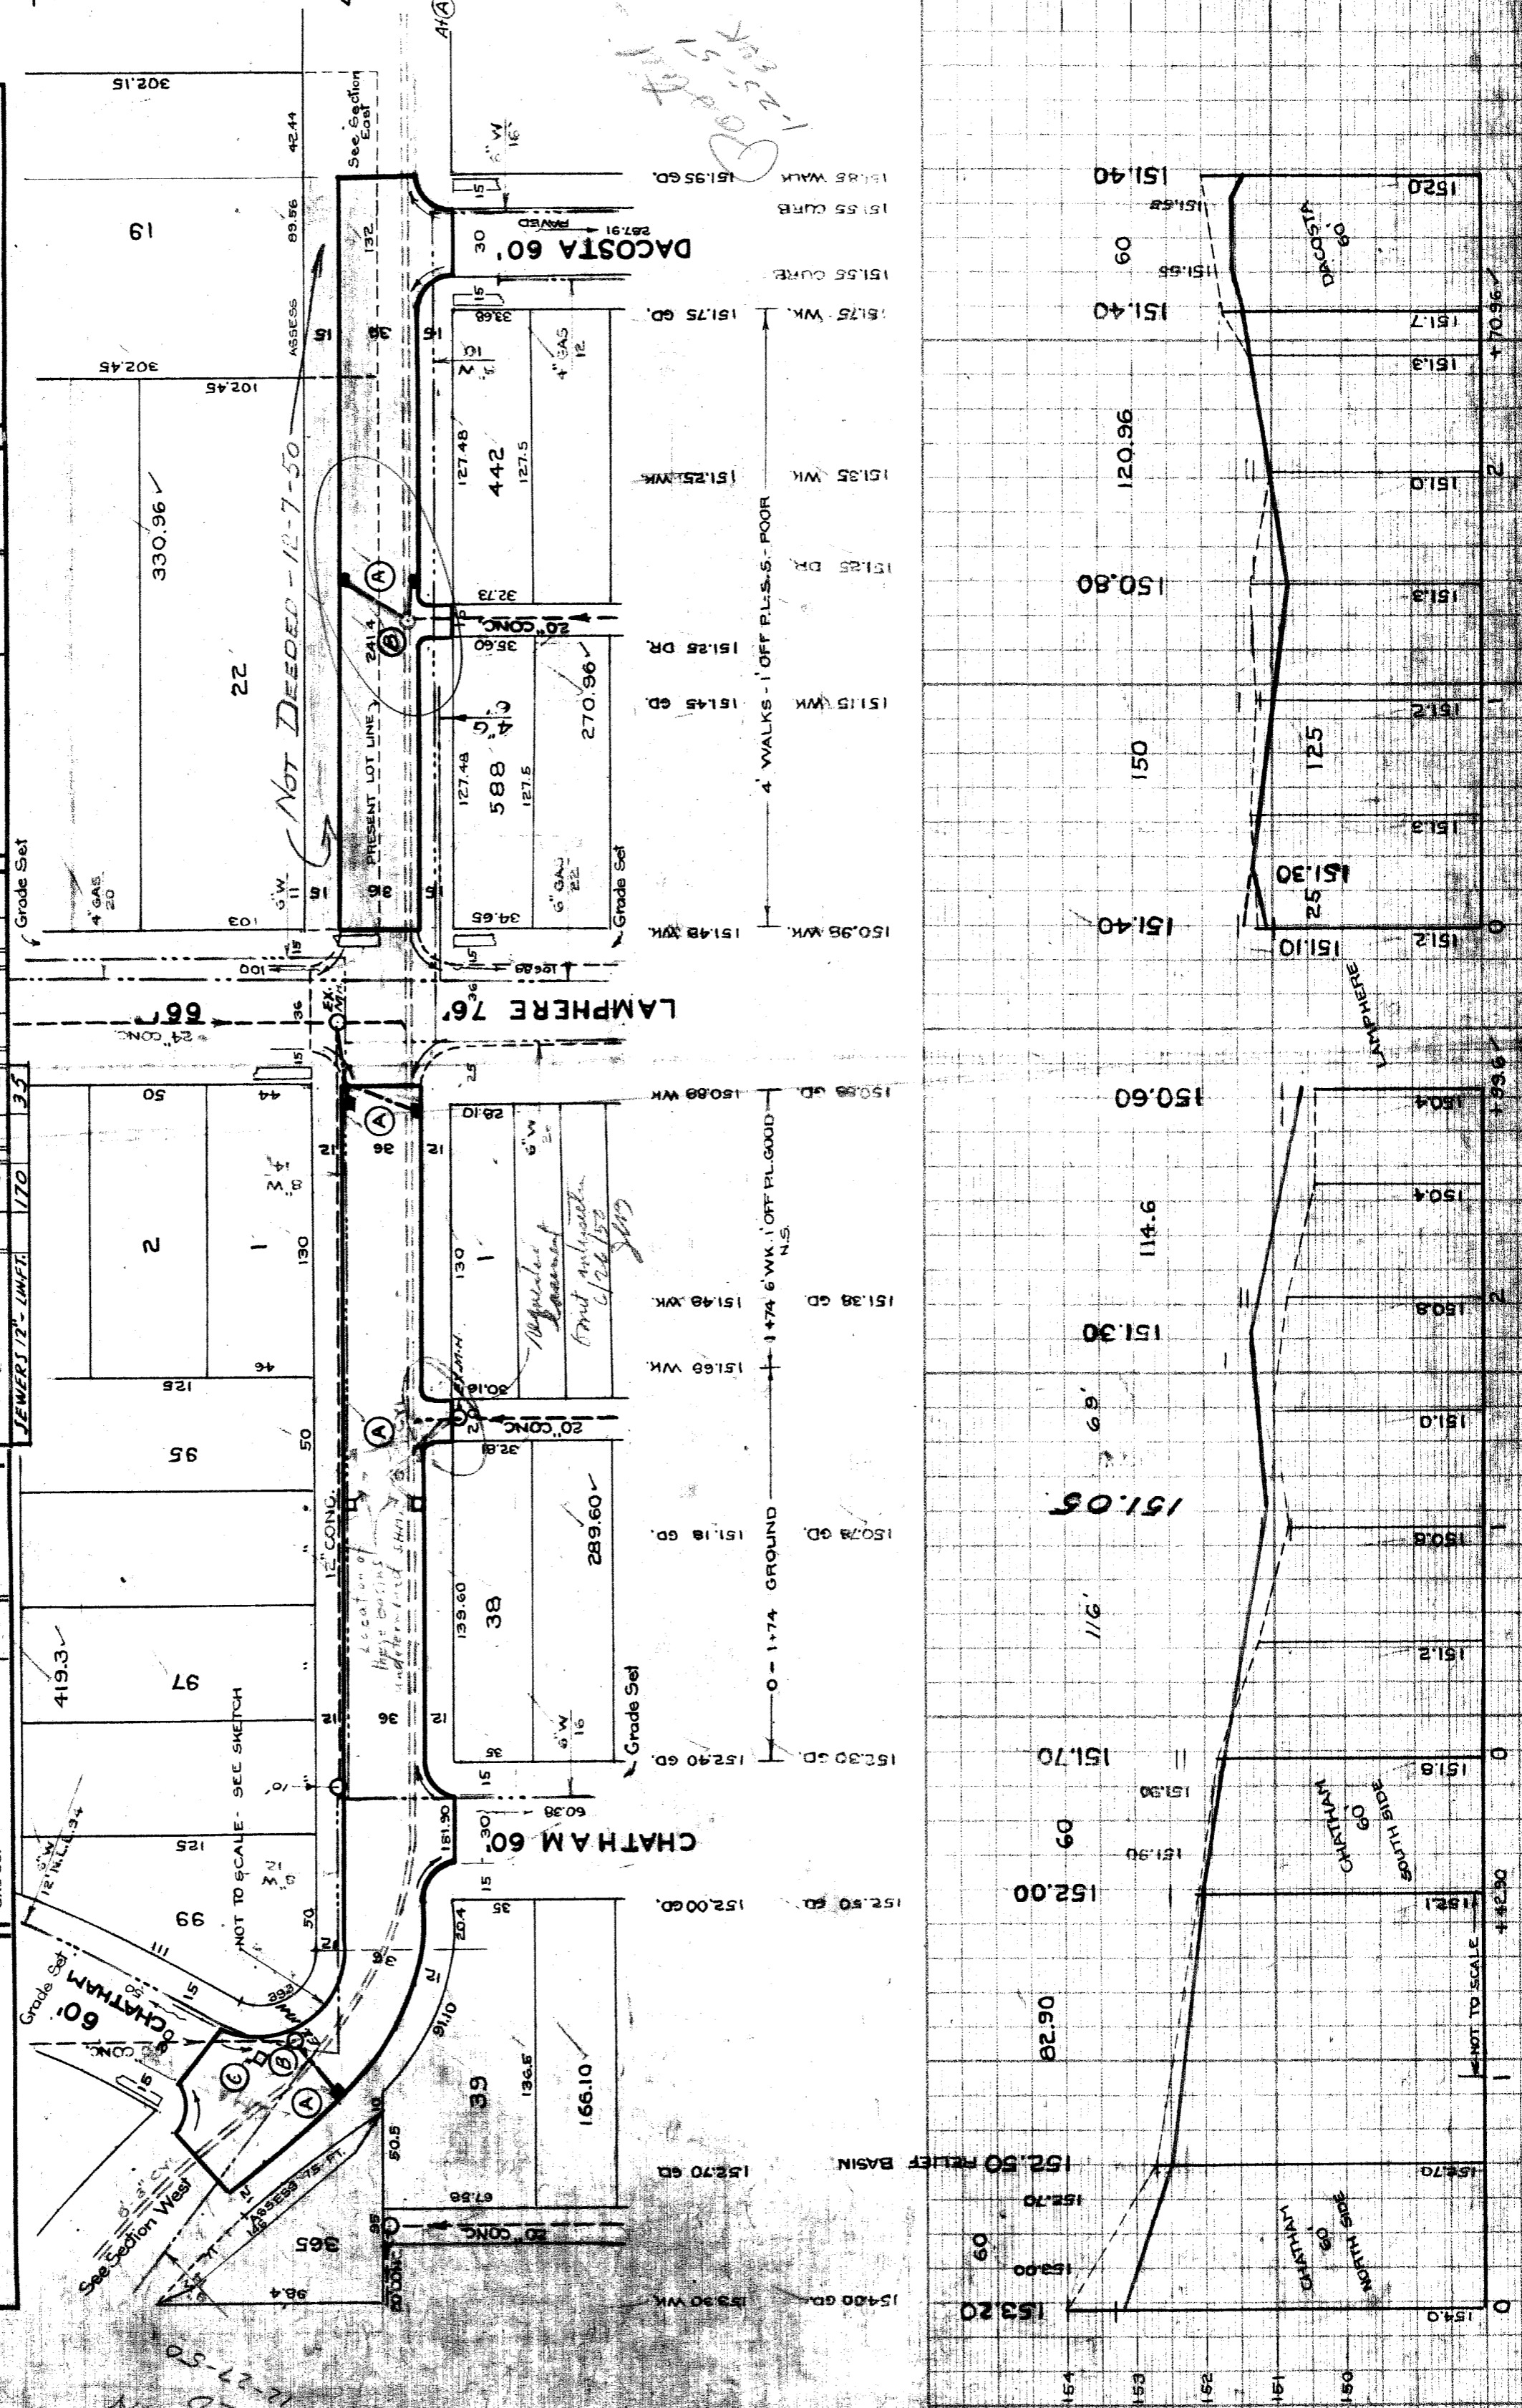

INDEXED  
 REVISIONS: GRADE CHANGE 5/26/49  
 E.N.E.

CHATHAM SOUTH SIDE  
 CHATHAM NORTH SIDE  
 LAMPHERE  
 DACOSTA  
 SCALE: 1" = 50 FT.