

A-3099 To Width Board

DEPARTMENT OF PUBLIC WORKS DETROIT
 CITY ENGINEER'S OFFICE - DIVISION OF PAVING DESIGN

STREET PAVING PLAN

NAME OF STREET: SHIELDS AVE. 60'
 FROM: MCNICHOLS RD.
 TO: N. OF NANCY AVE.

TYPE OF PAVEMENT: 8" MACADAM - OIL & CHIPS WIDTH: 30'

DESIGNED BY: *G. Kennedy*
 DRAWN BY: F.C. Keywick
 TRACED BY: *G. Kennedy*
 CHECKED BY: *Walter R. Fisher*
 APPROVED: *Walter R. Fisher*
 ENGINEER OF STREETS
 ASST CITY ENGINEER

6-28-39 WATER MAIN O.K.




DRAINAGE COMPLETED 12-9-39
 PAVING COMPLETED 12-9-39

REVISION FOR ALLEY RETURNS NORTH OF NANCY 10-18-39 1/6

410505

BOOK 1180 PAGE 64
 DATE 3-8-1938
 PLAN CHECKED 9/9/39
 PROFILE CHECKED 9/9/39
 GRADE CHECKED 9/9/39
 INDEX NO. 1645
 TOPO. NO. 77263
 RECORD NO. 94863


PLAN	PROFILE	COMPUTED
FCR	GRADE	LENGTH
1	182	76
2	187	105
3	197	105
4	200	105
5	200	105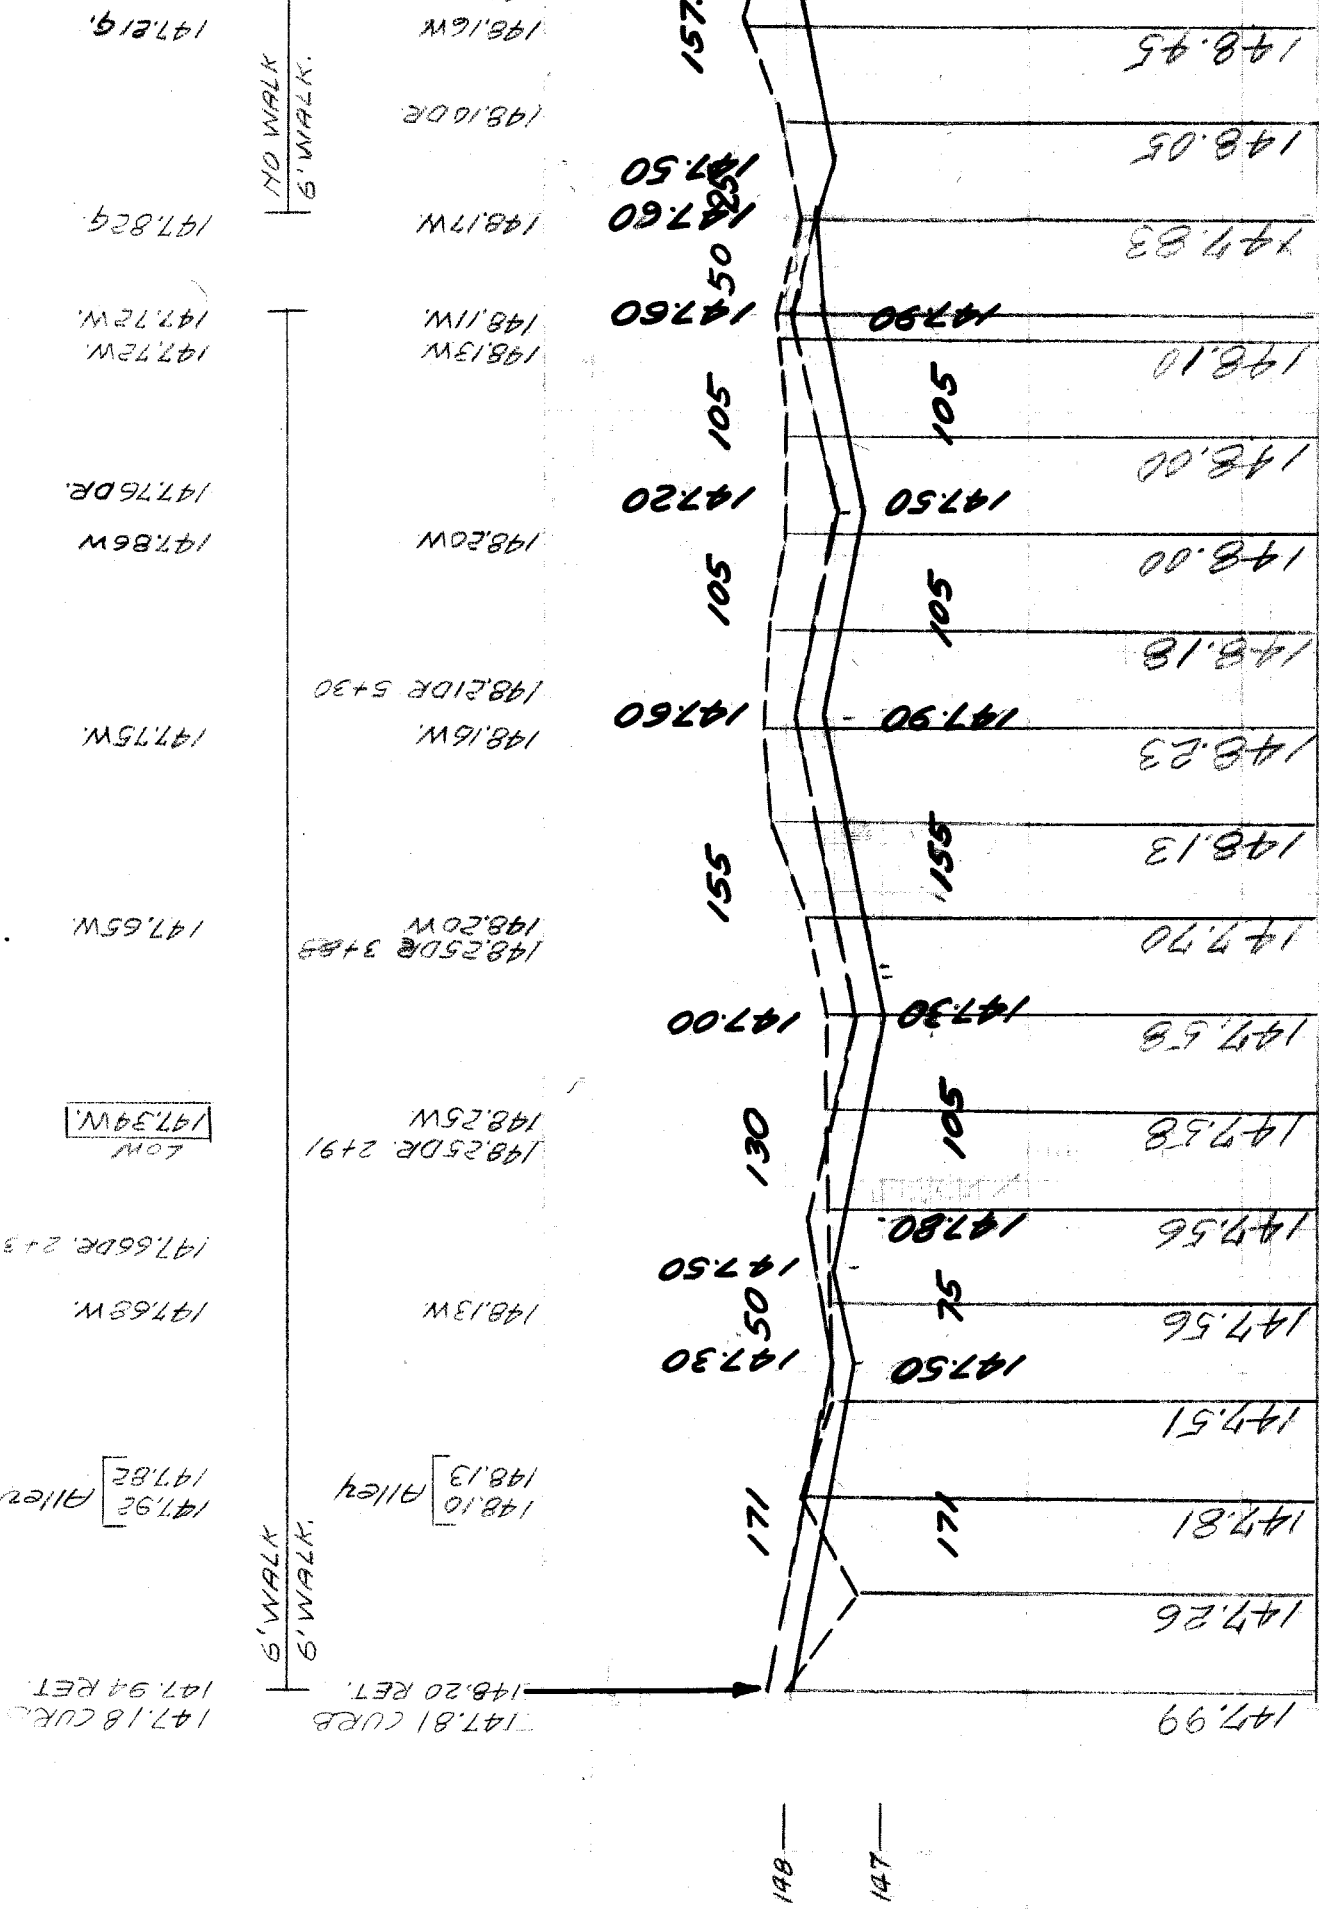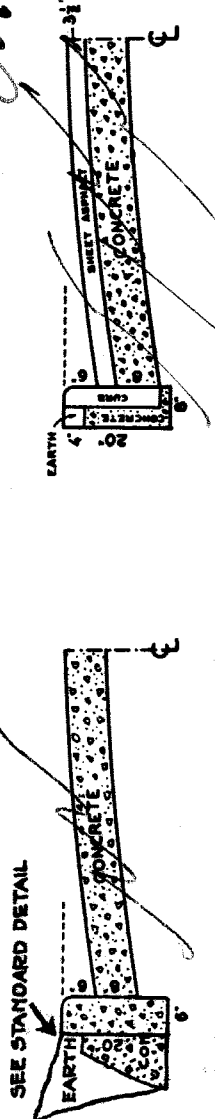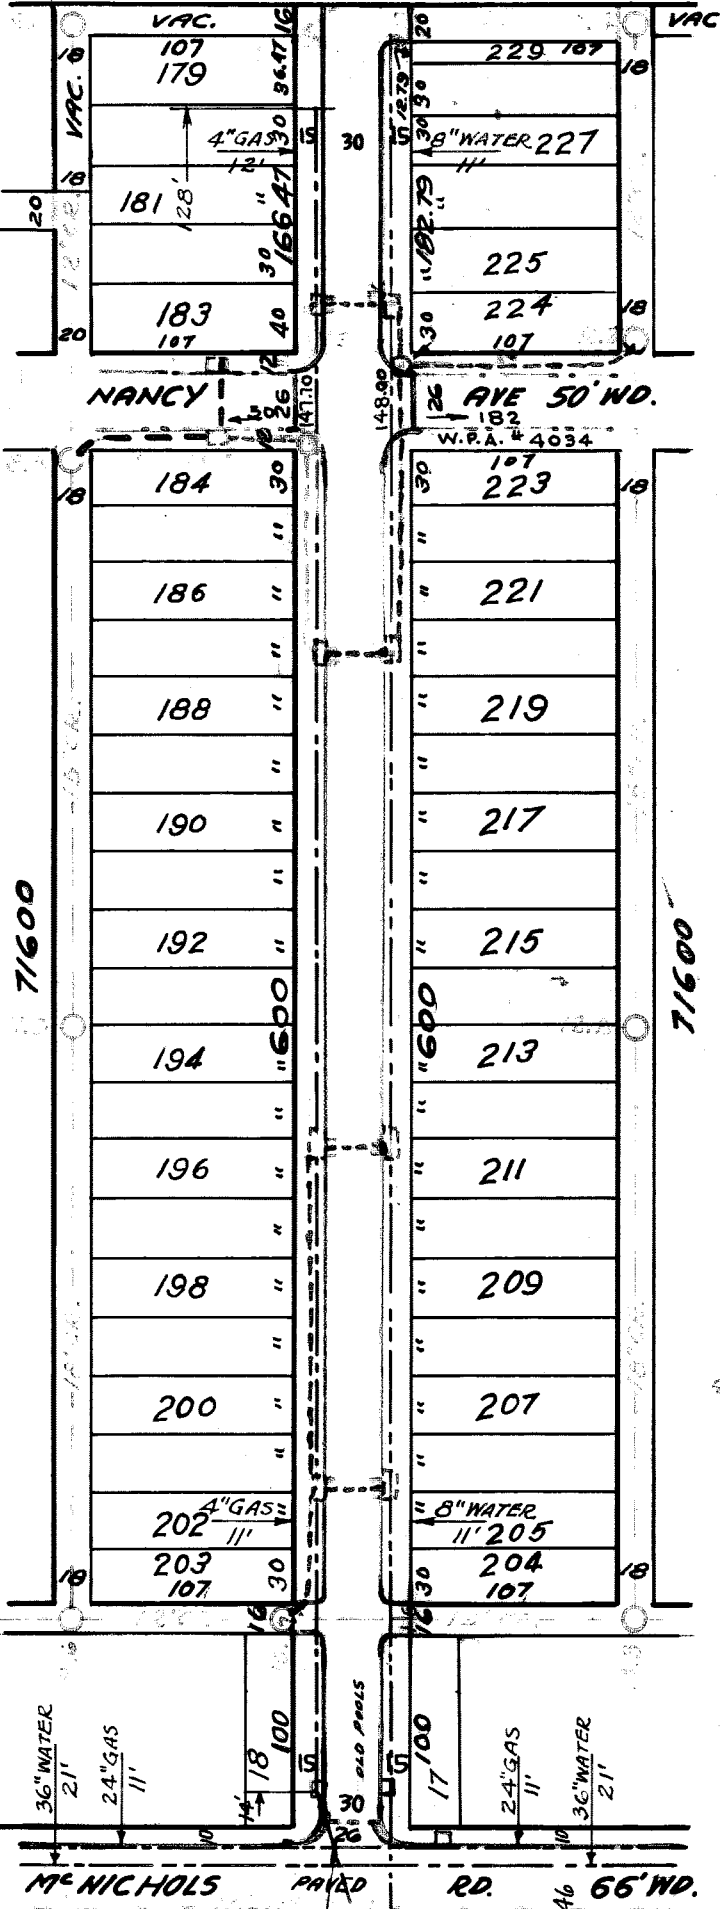
SUMP MANHOLE BASINS BY W.P.A.
 4-2-3-38.

EXISTING POOLS & BASINS. NEW

BENCH MARKS.
 B.M. NAIL IN S. SIDE 30" MAPLE TREE ON MCNICHOLS RD. 149.99
 TO E. OF SUNSET. 150.98
 B.M. ARROW ON HYD. - E. SIDE JUSTINE HOUSE #17156 150.94
 B.M. ARROW ON HYD. - S.E. COR. SHIELDS & MCNICHOLS 151.00
 B.M. ARROW ON HYD. - E. SIDE SHIELDS, OPP HOUSE #17166 151.01
 B.M. ARROW ON HYD. - S.E. COR. SHIELDS & NANCY 151.01

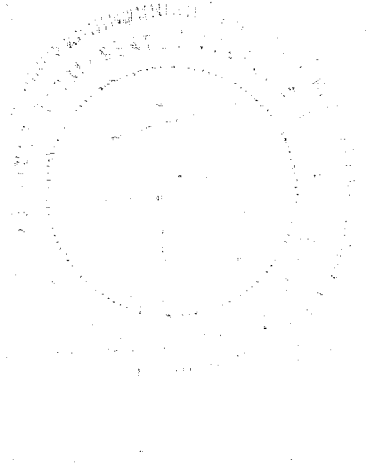

DESIGNED BY	APPROVED
<i>G. Kennedy</i>	<i>Walter R. Fisher</i>
DRAWN BY	ENGINEER OF STREETS
F.C. Keywick	<i>Walter R. Fisher</i>
TRACED BY	ASST CITY ENGINEER
<i>G. Kennedy</i>	<i>Walter R. Fisher</i>

6-28-39 WATER MAIN O.K.

DRAINAGE COMPLETED.....
 PAVING COMPLETED 12-9-39

REVISION FOR ALLEY RETURNS NORTH OF NANCY 10-18-39 1/6

410505