

WORK ORDER

FILE 104

Michigan Department
of Transportation
1137 (06/20)

DISTRIBUTION: Original - Contractor
Copies - Region

* Indicate extra items of work with asterisk

Delivery/Project Engineer
C & T, Contracts Unit

NO.
2

CONTROL SECTION NO.

JOB NO.

PW-7045 WIGLE Phase II

FED. NO.

CONTRACTOR


Major Contracting



SUBJECT

Deletion of Sidewalk and Tree Grates on East Side of 4th Street.


The Contractor is instructed to delete from the contract the installation of all sidewalk and tree grates on the east side of 4th Street, as this work will be performed under a separate contract. Adjustments will be made based on existing line items, an estimated schedule of values is included below. The attached marked up drawing shows the extent of work that is being deleted from the contract.

All working drawings and field coordination shall be through the City of Detroit and their designated representatives. The work shall be conducted in a timely manner to prevent delays to the project schedule. All work will be completed and paid for according to the 2020 MDOT Standard Specifications for Construction, the City of Detroit Department of Public Works City Engineering Division Standard Specifications for Paving and Related Construction (March 2009) and the contract documents. It is the Prime Contractor's responsibility to ensure that all affected subcontractors are made aware of this work order. END WORK ORDER

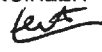			OTHER			
STATION		TO STATION	CHANGE		* EXTRA	
ITEM CODE NO.	ITEM OF WORK		QUANTITY	UNIT	UNIT PRICE	COST
8030010	Detectable Warning Surface		-9	Ft	\$50.00	-\$450.00
8037010	_ Sidewalk Ramp, ADA, Modified		-225	Sft	\$12.00	-\$2,700.00
8037010	_ Sidewalk Ramp, Conc, 4 inch, Modified		-2550	Sft	\$7.00	-\$17,850.00
8507050	_ Tree Pit		-9	Ea	\$1,000.00	-\$9,000.00
8507050	_ Tree Grate		-9	Ea	\$2,000.00	-\$18,000.00
						\$0.00
						\$0.00
						\$0.00
					EXT COST	-\$48,000.00
CONTRACTOR		DATE	DELIVERY / PROJECT ENGINEER			DATE
Bryan Marshall			 			2/12/2023

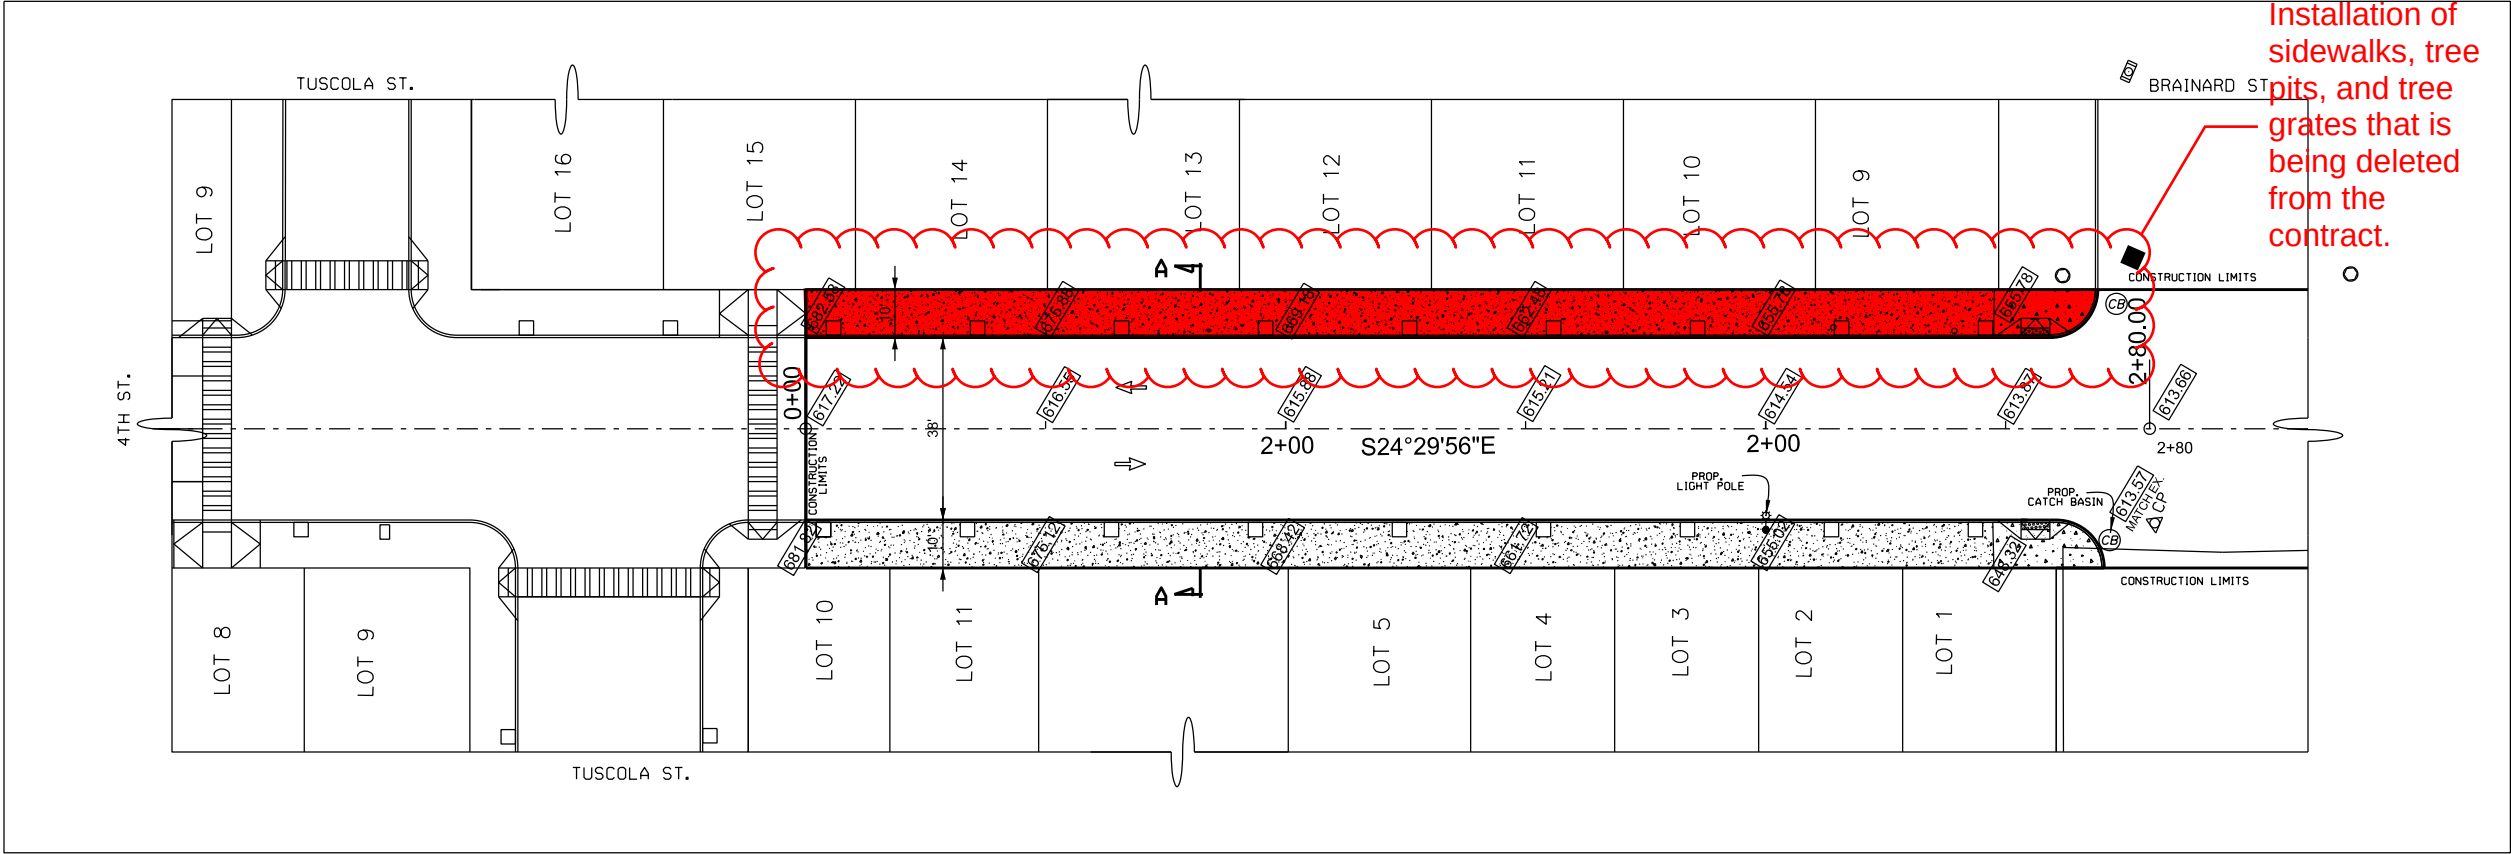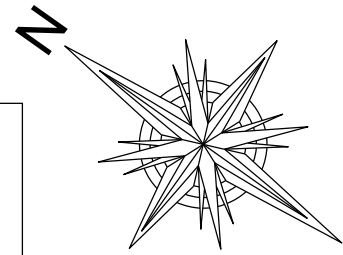


CONSTRUCTION PLAN
SCALE / 1"=40'

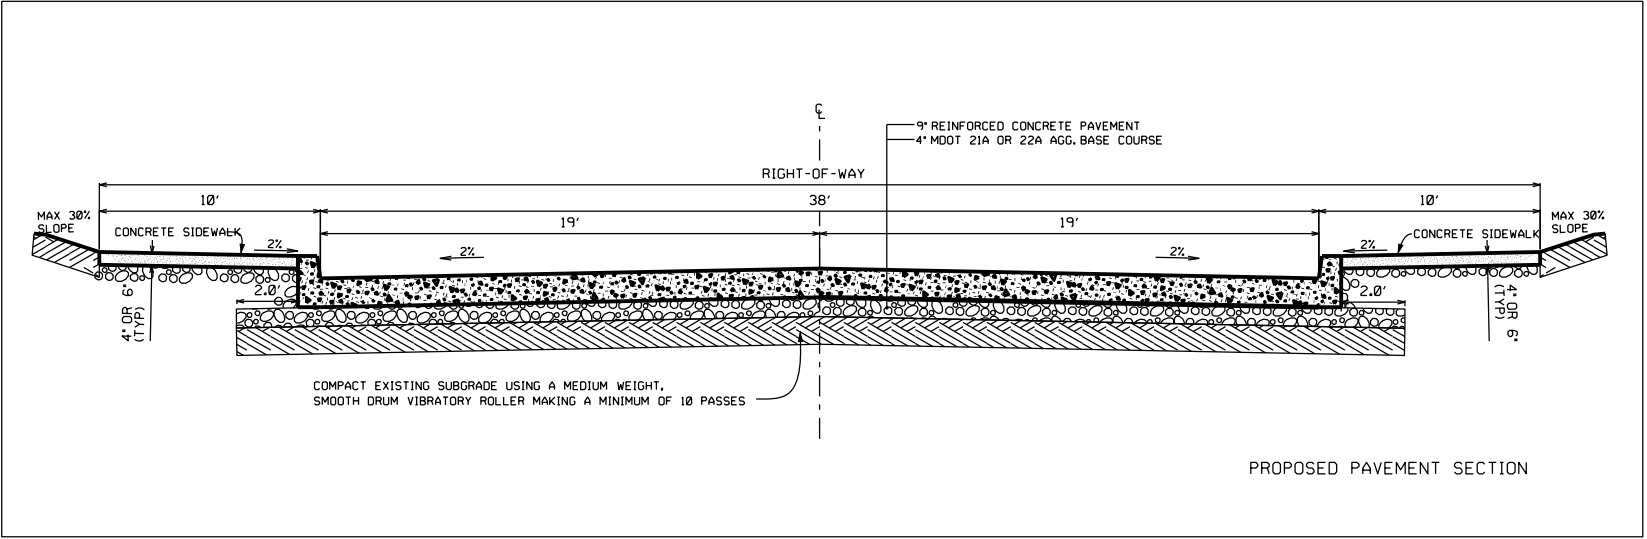

SECTION A-A
NO SCALE

LEGEND

-  PROPOSED 4' CONCRETE SIDEWALK
-  PROPOSED 6' CONCRETE SIDEWALK
-  PROPOSED CONCRETE PAVEMENT WITH INTEGRAL CURB REINFORCED 9 INCH
-  PROPOSED TREE PIT

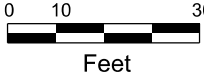FINAL ROW PLAN REVISIONS (SUBMITTAL DATE: 06 / 21 / 21)								 DEPARTMENT OF PUBLIC WORKS DPW CITY ENGINEERING DIVISION CITY OF DETROIT 2 WOODWARD AVENUE DETROIT, MI 48226		DESIGNED BY : PAMELA LEMME	APPROVED BY :	CS:	4TH STREET EXTENSION - PHASE 2 FROM TUSCOLA ST. TO BRAINARD ST. CONSTRUCTION PLAN AND SECTION	DRAWING	SHEET
NO.	DATE	AUTH	DESCRIPTION	NO.	DATE	AUTH	DESCRIPTION			DRAWN BY : SARMAD AL TAMEEMI	DATE: 05 / 06 / 2022	JN: PW-7045		1	3 OF 8
										CHECKED BY : STEVEN BANNASCH					