

THE IMPROVEMENTS COVERED BY THESE PLANS SHALL BE DONE IN ACCORDANCE WITH THE MICHIGAN DEPARTMENT OF TRANSPORTATION 1990 STANDARD SPECIFICATIONS AND SUPPLEMENTAL SPECIFICATIONS.

CITY OF DETROIT
 IN CO-OPERATION WITH
 MICHIGAN DEPARTMENT OF TRANSPORTATION
 AND
~~FEDERAL HIGHWAY ADMINISTRATION~~
~~FEDERAL AID-URBAN PROJECT NO. MICHIGAN M-2000~~
 CONTROL SECTION EDA 82522 JOB NO. 31809 A

TRAFFIC COUNT - RUSSELL ST.




DESIGN SPEED 35MPH
 POSTED SPEED 25MPH
 ADT (1990) 46
 ADT (2010) 150

INDEX OF SHEETS

1. TITLE SHEET
2. TYPICAL SECTIONS
3. ALIGNMENT PLAN
4. CONSTRUCTION SEQUENCE
5. REMOVAL AND UTILITY PLAN
6. PAVING PLAN
7. INTERSECTION DETAIL GRADE
8. PAVEMENT MARKINGS
- 9-II. SPECIAL STANDARDS & DETAILS
12. QUANTITY SHEET
- 13-21. P.L.D. PLANS AND QUANTITIES

STANDARD PLANS

- II-286
- II-29E
- IV-84E
- II-39K
- V-100B
- II-40G
- VI-125H
- II-416
- II-42F

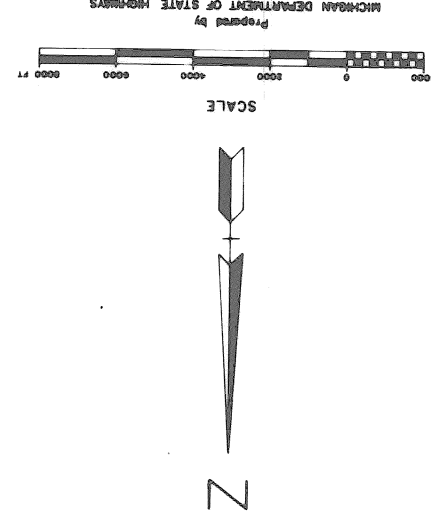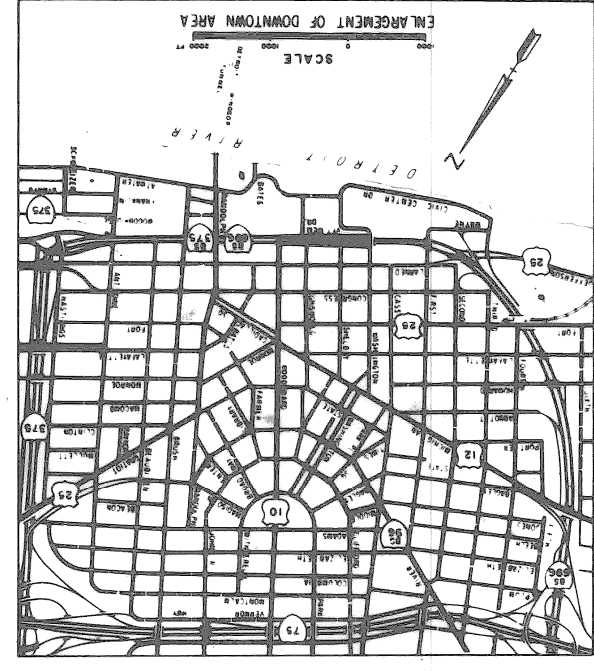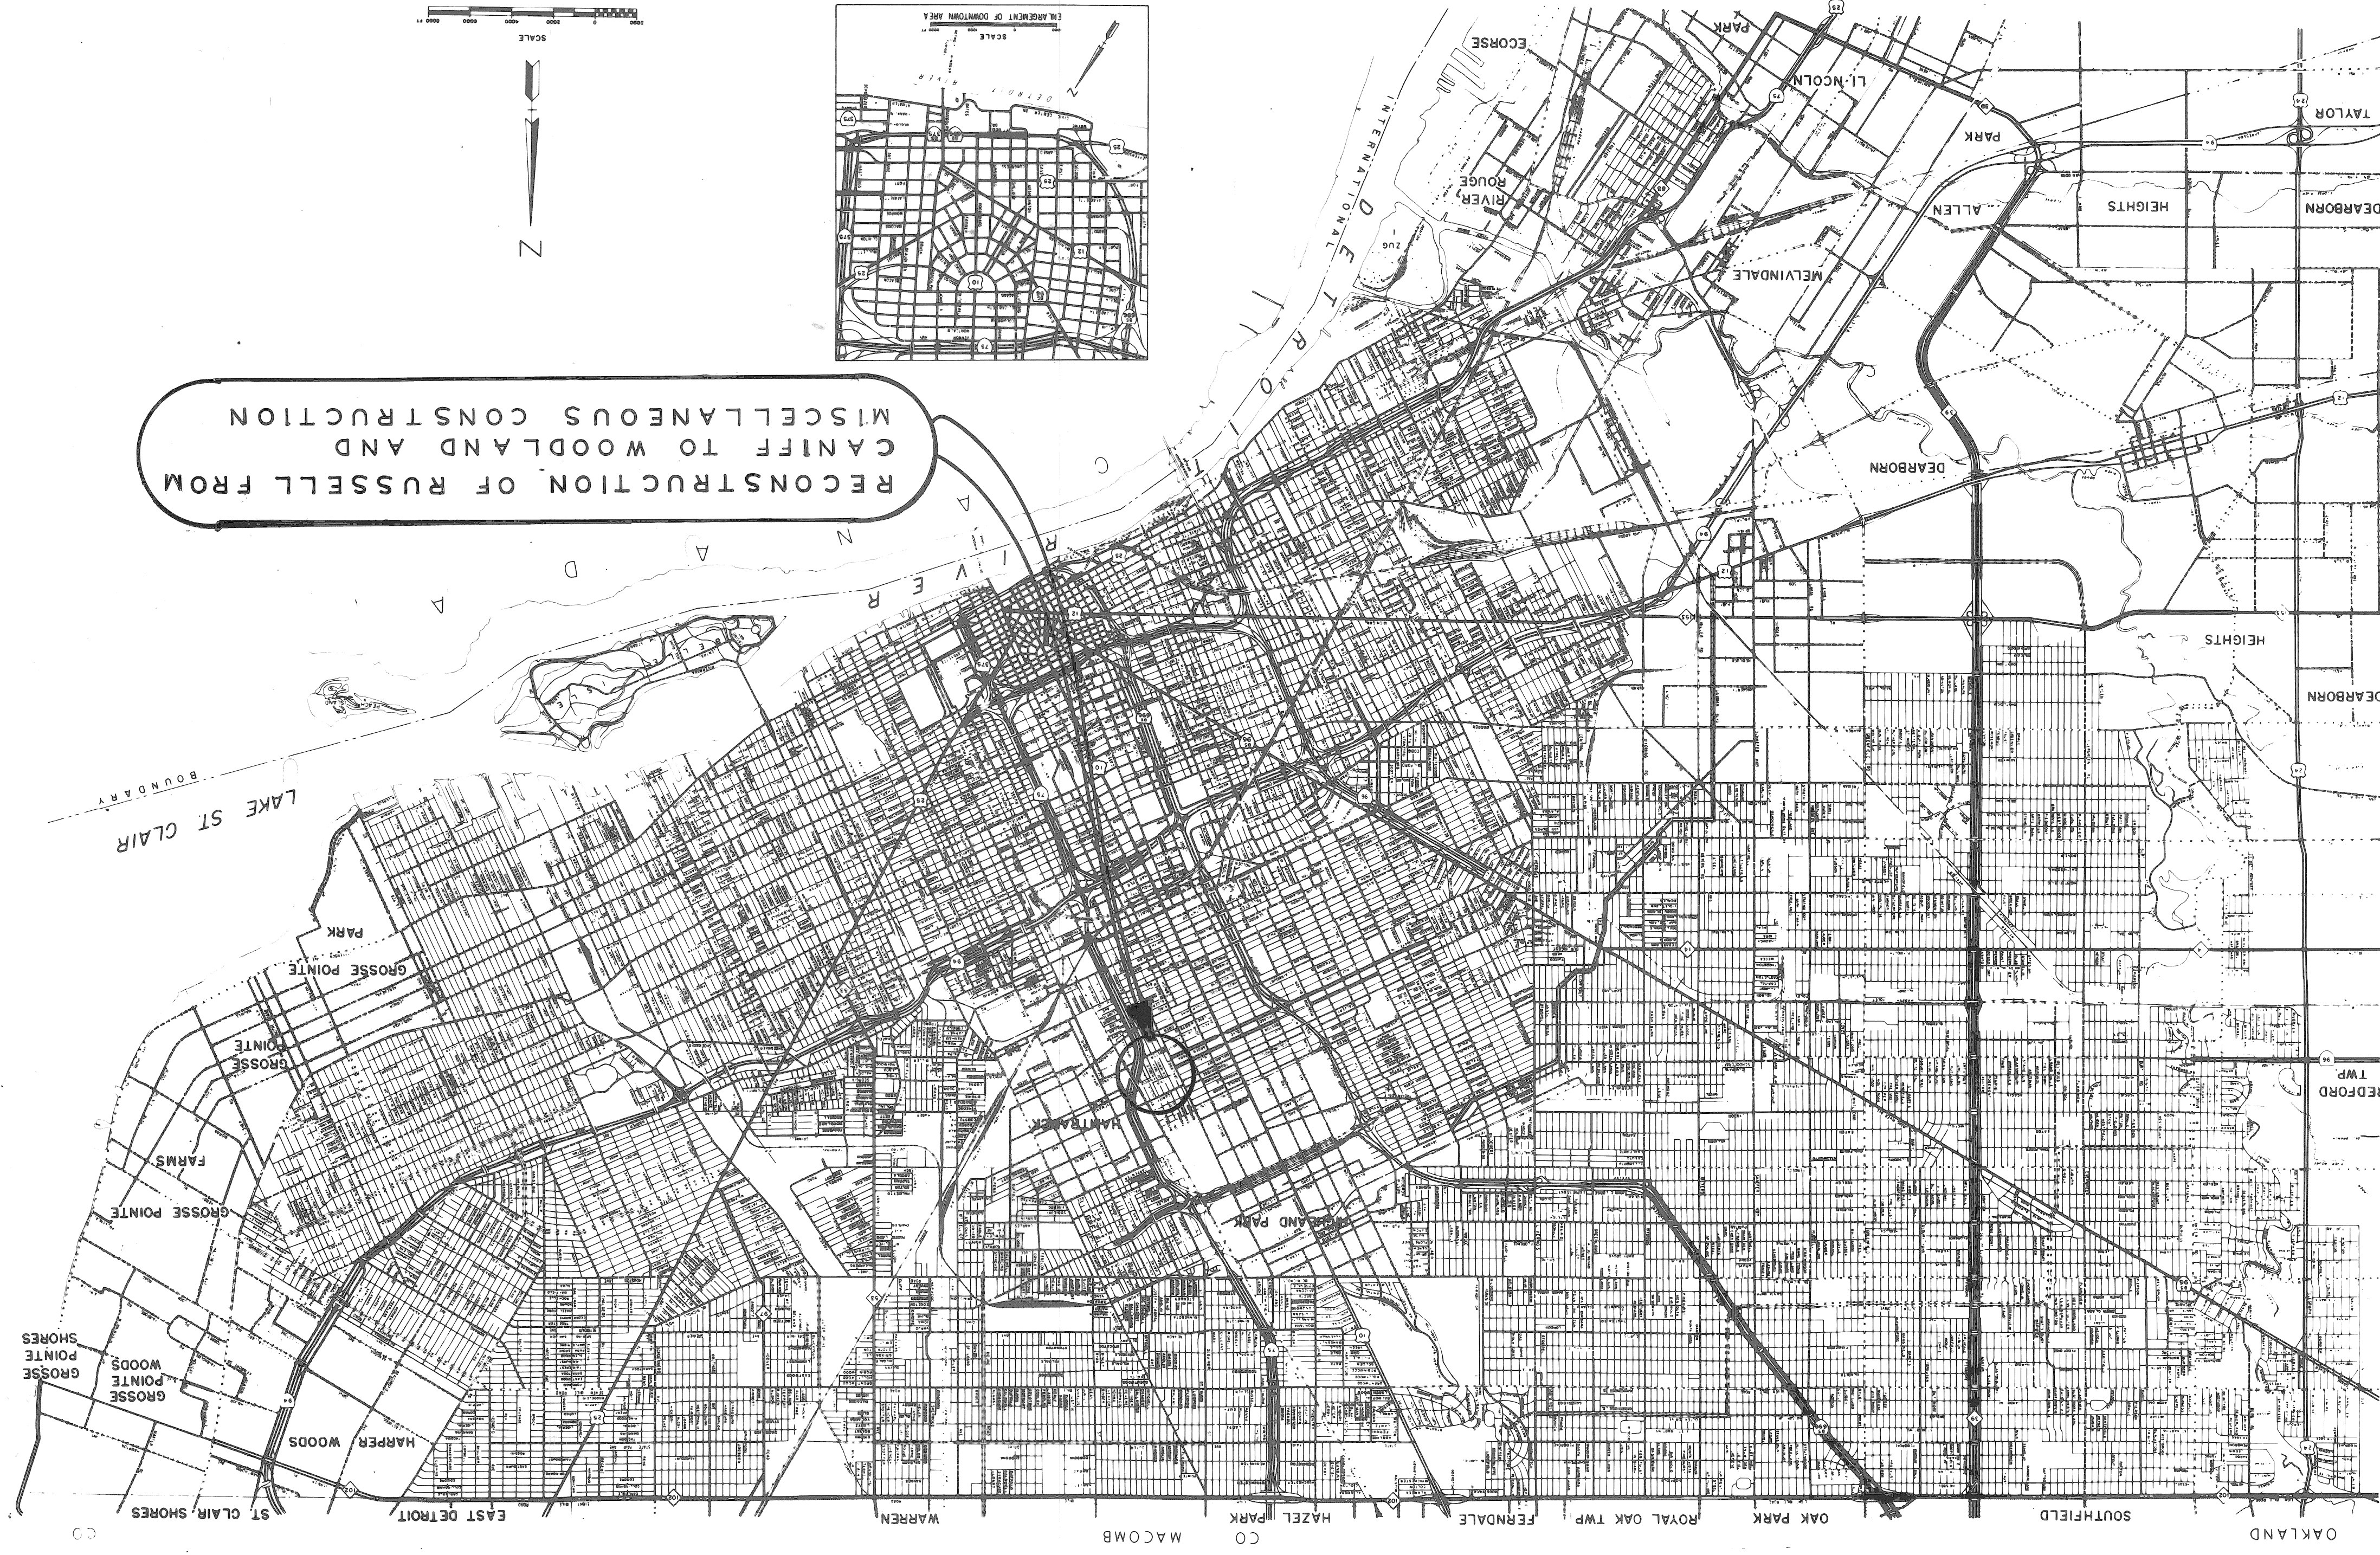

ITEM NO. _____ CONTRACT FOR G, DS, P, & UTILITIES

LOCAL AUTHORITY APPROVAL
 CITY OF DETROIT
 CITY ENGINEERING DEPARTMENT

APPROVED BY: *E. M. Murray* DEPUTY DIRECTOR DATE: 6/1/92

APPROVED BY: *Clay R. Zappino* DIRECTOR DATE: 6-1-92

PREPARED UNDER SUPERVISION OF
 REGISTERED PROFESSIONAL ENGINEER
William L. Tally
 REGISTRATION NO. 26185

CITY OF DETROIT
 ORGANIZATION

DETROIT, MICHIGAN
 ADDRESS

(SEAL) WILLIAM L. TALLY
 REGISTERED PROFESSIONAL ENGINEER
 No. 26185
 STATE OF MICHIGAN
 20185

F.W.A.	STATE	PROJECT NO.	FISCAL YEAR	SHEET NO.	TOTAL SHEETS
5	MICH.				
STREET	CITY	COUNTY	TWP.	SHEET NO.	TOTAL SHEETS

CONTROL SECTION EDA 82522, JOB NO. 31809 A

ELEMENTS FOR 4' ROADWAY



PAVEMENT WIDTH	CURB FACE	T	A	B	C	D	E	L	S
4.4'	7"	0	0.1	0.2	0.3	0.4	0.5	0.6	0.7
		0.583	0.583	0.583	0.583	0.583	0.583	0.583	0.583
		0.308	0.308	0.308	0.308	0.308	0.308	0.308	0.308
		0.217	0.217	0.217	0.217	0.217	0.217	0.217	0.217
		0.683	0.683	0.683	0.683	0.683	0.683	0.683	0.683
		0.458	0.458	0.458	0.458	0.458	0.458	0.458	0.458
		0.317	0.317	0.317	0.317	0.317	0.317	0.317	0.317
		0.533	0.533	0.533	0.533	0.533	0.533	0.533	0.533
		0.883	0.883	0.883	0.883	0.883	0.883	0.883	0.883
		17.5	17.5	17.5	17.5	17.5	17.5	17.5	17.5
		0.351	0.351	0.351	0.351	0.351	0.351	0.351	0.351
		16.0	16.0	16.0	16.0	16.0	16.0	16.0	16.0
		0.389	0.389	0.389	0.389	0.389	0.389	0.389	0.389
		14.5	14.5	14.5	14.5	14.5	14.5	14.5	14.5
		0.424	0.424	0.424	0.424	0.424	0.424	0.424	0.424
		13.0	13.0	13.0	13.0	13.0	13.0	13.0	13.0
		0.455	0.455	0.455	0.455	0.455	0.455	0.455	0.455
		11.5	11.5	11.5	11.5	11.5	11.5	11.5	11.5
		0.483	0.483	0.483	0.483	0.483	0.483	0.483	0.483
		10.0	10.0	10.0	10.0	10.0	10.0	10.0	10.0
		0.507	0.507	0.507	0.507	0.507	0.507	0.507	0.507

MISCELLANEOUS QUANTITIES

MOBILIZATION	LUMP SUM	1
FLAG CONTROL	LUMP SUM	1
MINOR TRAFFIC DEVICES	LUMP SUM	1
FIELD OFFICE	MONTHS	3

ESTIMATED QUANTITIES FOR USE AT THE DISCRETION OF THE ENGINEER

REMOVING MASONRY AND CONC. STRUCTURES 100 CUB. YDS.
 SUBGRADE UNDERCUTTING, TYPE II - 100 CU. YDS.
 4" CONCRETE SIDEWALK - 264 SQ. FT.
 REMOVING SIDEWALK - 23 SQ. YDS.
 REMOVING PAVT. (REPAIR) 10 SQ. YDS.
 CONC. PAVT. REPAIR, 10" NONREINFORCED 10 SQ. YDS.
 CLASS A SODDING - 43 SQ. YDS.
 TOPSOIL SURFACE - 3" - 43 SQ. YDS.
 WATER - 1 UNIT
 SEWER CLEANOUT - 100 LIN. FT.
 CEMENT - 3 TONS
 CONCRETE CURB DETAIL "C" - 50 LIN. FT.
 CLEANING TRASHAGE STR. - 10 EACH

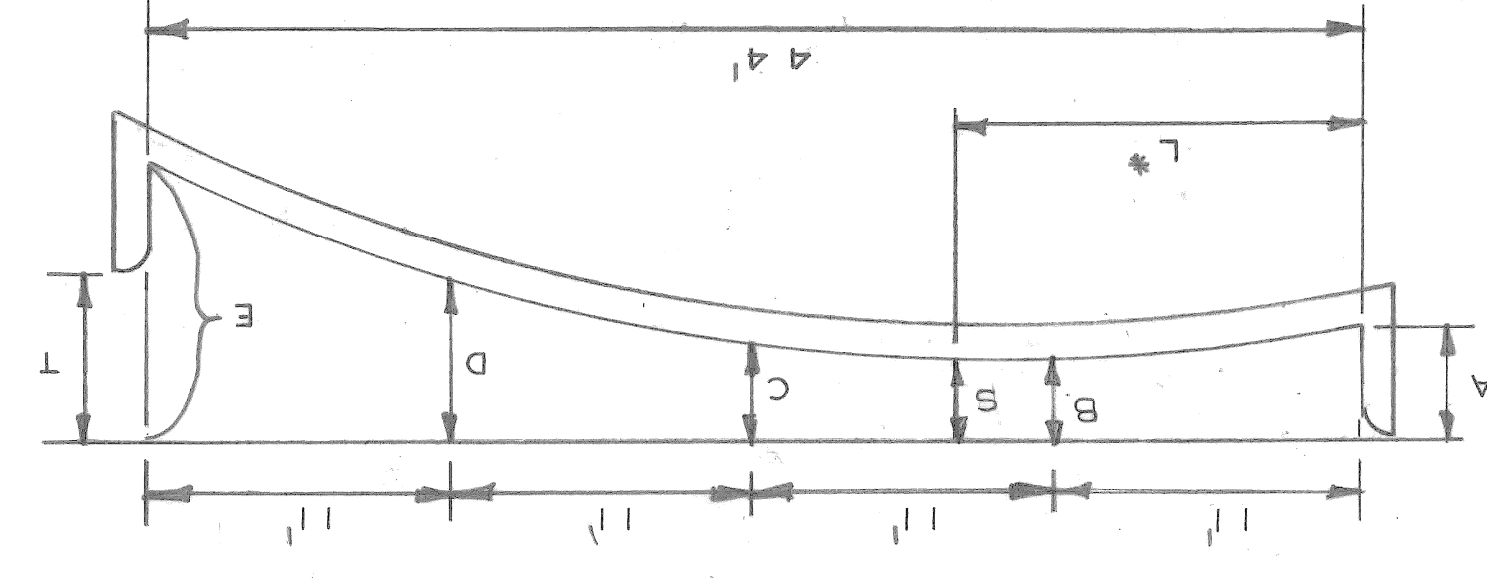
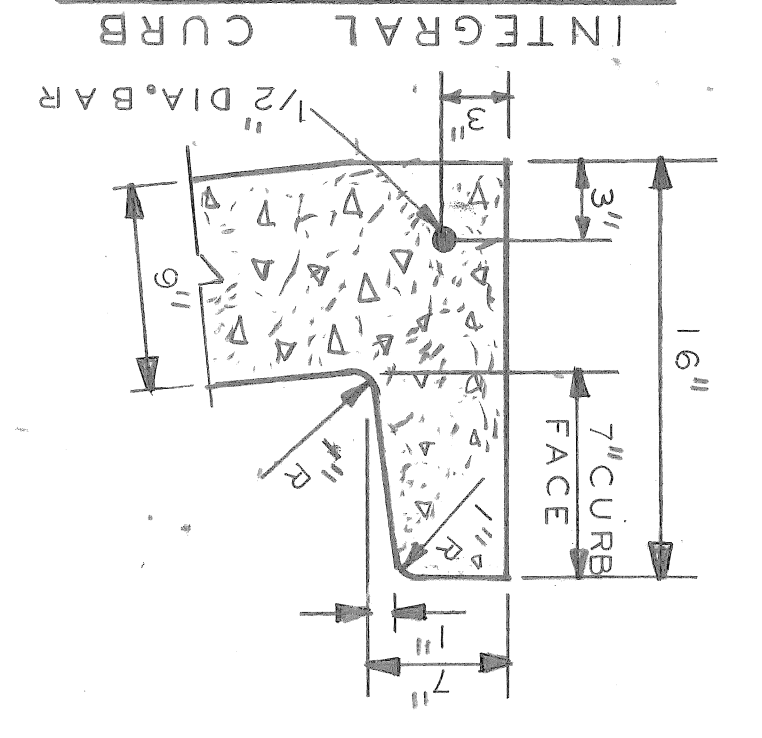


- EARTHWORK LEGEND
- CLASS A SODDING WITH 3" TOPSOIL
 - SELECTED EXCAVATED MATERIAL (INCIDENTAL TO PAVING COSTS)
 - AGGREGATE BASE CONCRETE (4" IN PLACE)
 - GRANULAR MATERIAL CLASS II (SEE NOTE #2)

TYPICAL CROSS SECTION - PROPOSED ROADWAY WIDTH VARIES


* SIDEWALK SLOPES ARE TO BE 3/8"/FT. UNLESS THE ENGINEER DETERMINES THAT A MINIMUM SLOPE OF 1/4"/FT. OR A MAXIMUM SLOPE OF 3/4"/FT. MUST BE USED TO MEET EXISTING CONDITIONS.
 ** SLOPE VARIABLE WIDTH PAVEMENT AT 3/8"/FT. FROM B OR D JOINT TO CURB.

- NOTES
1. THE PROPOSED CURB SHALL BE INTEGRAL CURB (SEE DETAIL THIS SHEET), REGARDLESS OF CONSTRUCTION METHOD, THE PROPOSED CURB SHALL BE PAID FOR AS 1" CONC. PAVEMENT - REINF. 9" WITH INTEGRAL CURB.
 2. BACKFILL, IF REQUIRED UNDER PROPOSED SIDEWALKS SHALL BE GRANULAR MATERIAL CLASS II.
 3. PLACE 4" CONC. SIDEWALK TO FACE OF BUILDING WHERE BUILDING FEONTS ON PROPERTY LINE.

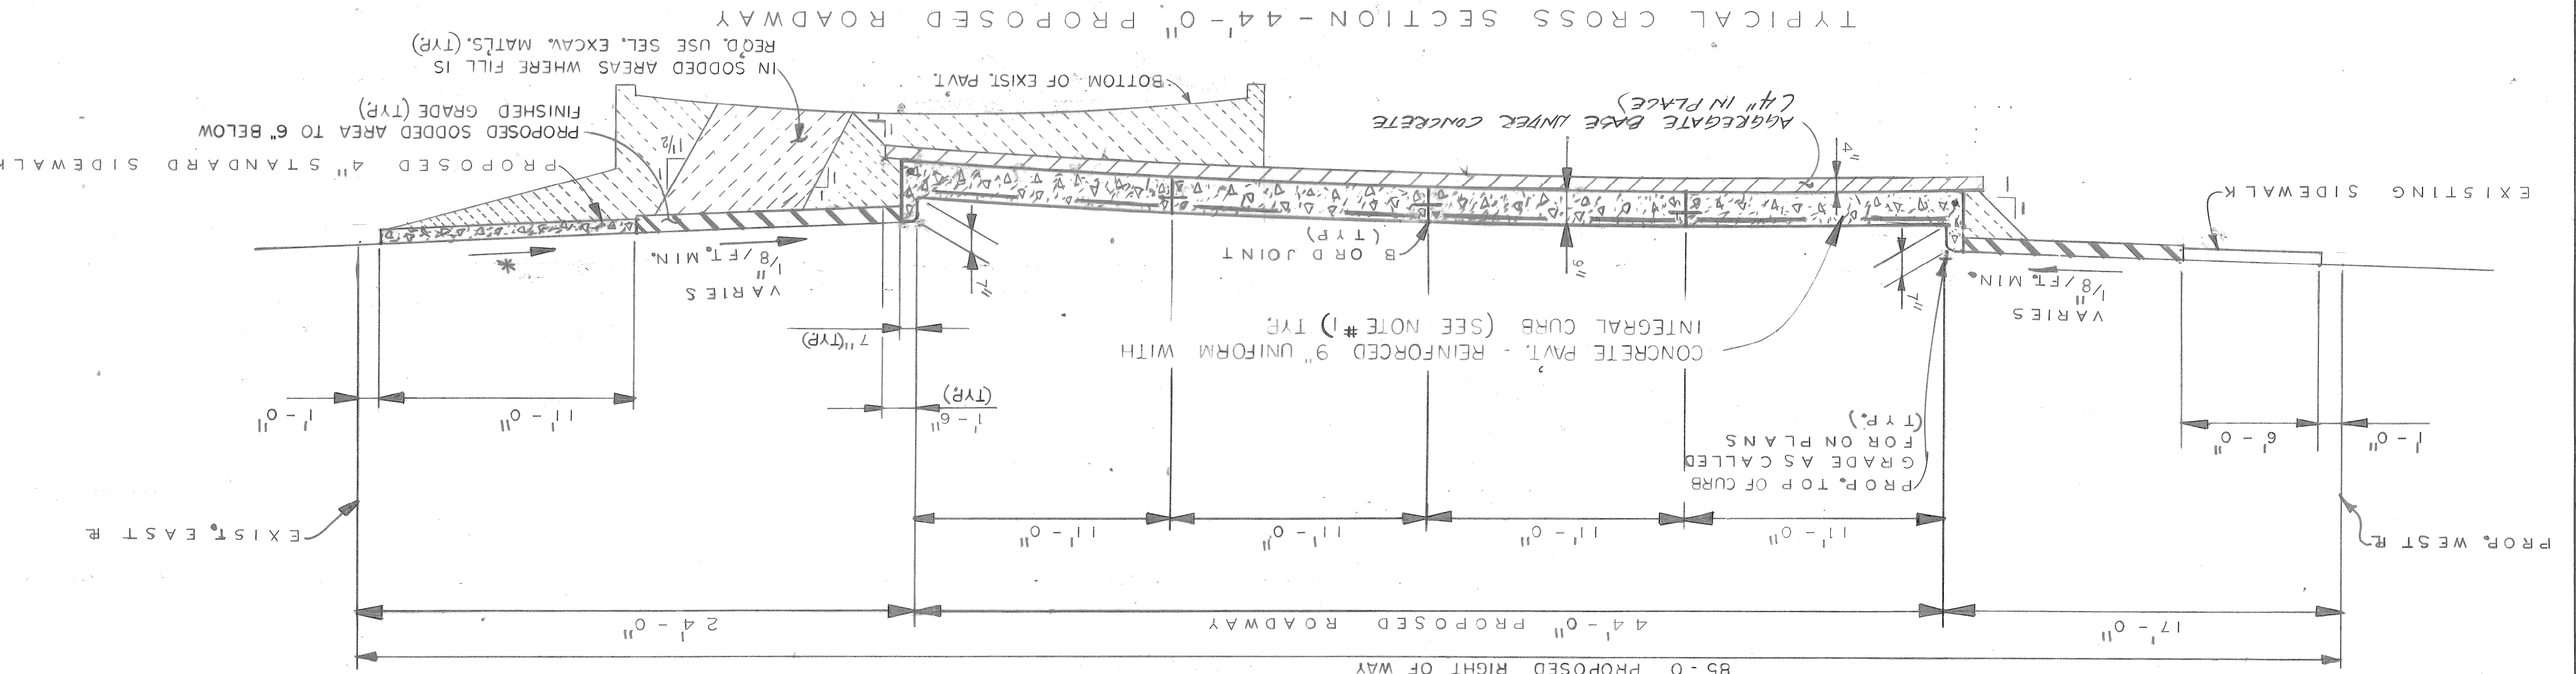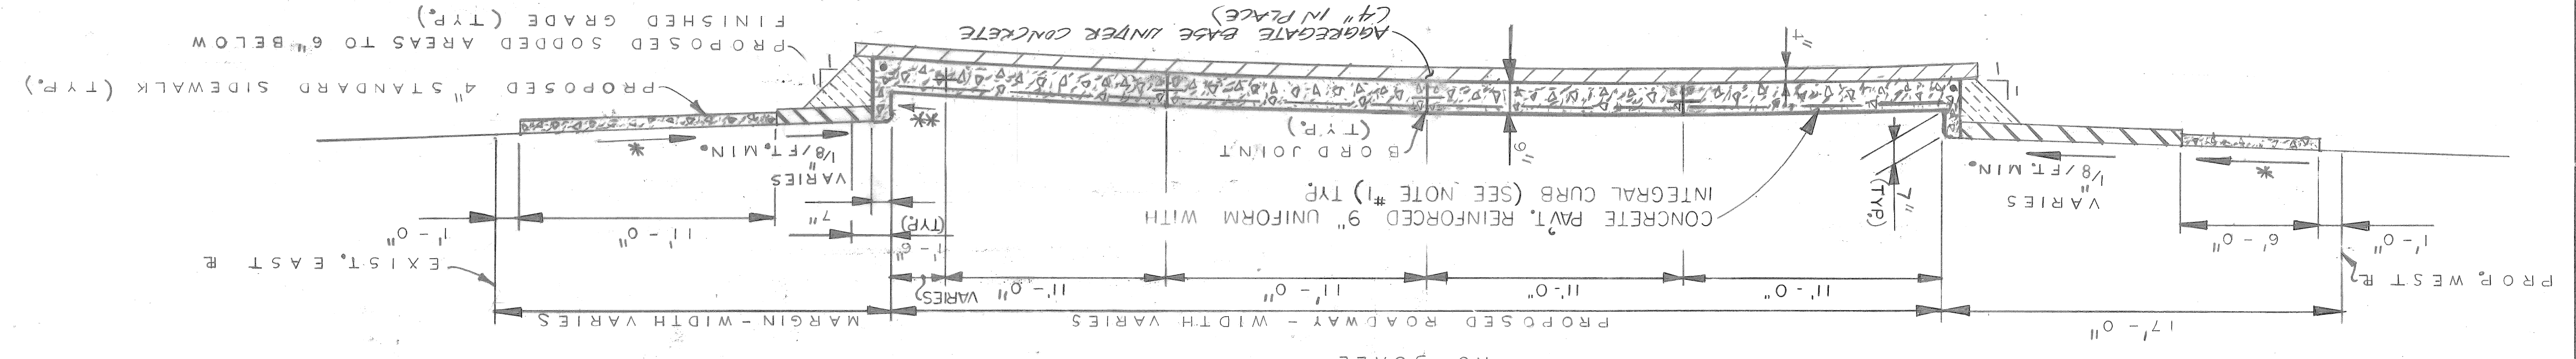

- JOINT LEGEND
- ⓐ LONGITUDINAL BULKHEAD JOINT, ACCORDING TO M.D.O.T. STANDARD DRAWING II - 416
 - ⓓ LONGITUDINAL LANE THE JOINT WITH THE BAR, ACCORDING TO M.D.O.T. STANDARD DRAWING II - 416
 - ⓑ OPTIONAL, B OR D

SHEET 4 OF 21 SHEETS		CONTRACT NO. 31809A		ASSIGNMENT NO. 91-60-01		DATE APRIL, 92	
RECONSTRUCTION OF RUSSELL FROM CANIFF TO WOODLAND AND MISCELLANEOUS CONSTRUCTION		CITY OF DETROIT		BUREAU OF STREETS AND HIGHWAYS		CITY ENGINEERING DEPARTMENT	
DESIGNED BY N.H.		DRAWN BY J.J.		CHECKED BY N.W.		APPROVED: <i>William J. Hall</i> ENGINEER OF STREETS HIGHWAY ENGINEER	
REVISIONS LOCATED BY COORDINATES ON SHEET		DESCRIPTION		DATE		DR. N. CK. G. A. V. D. DATE	

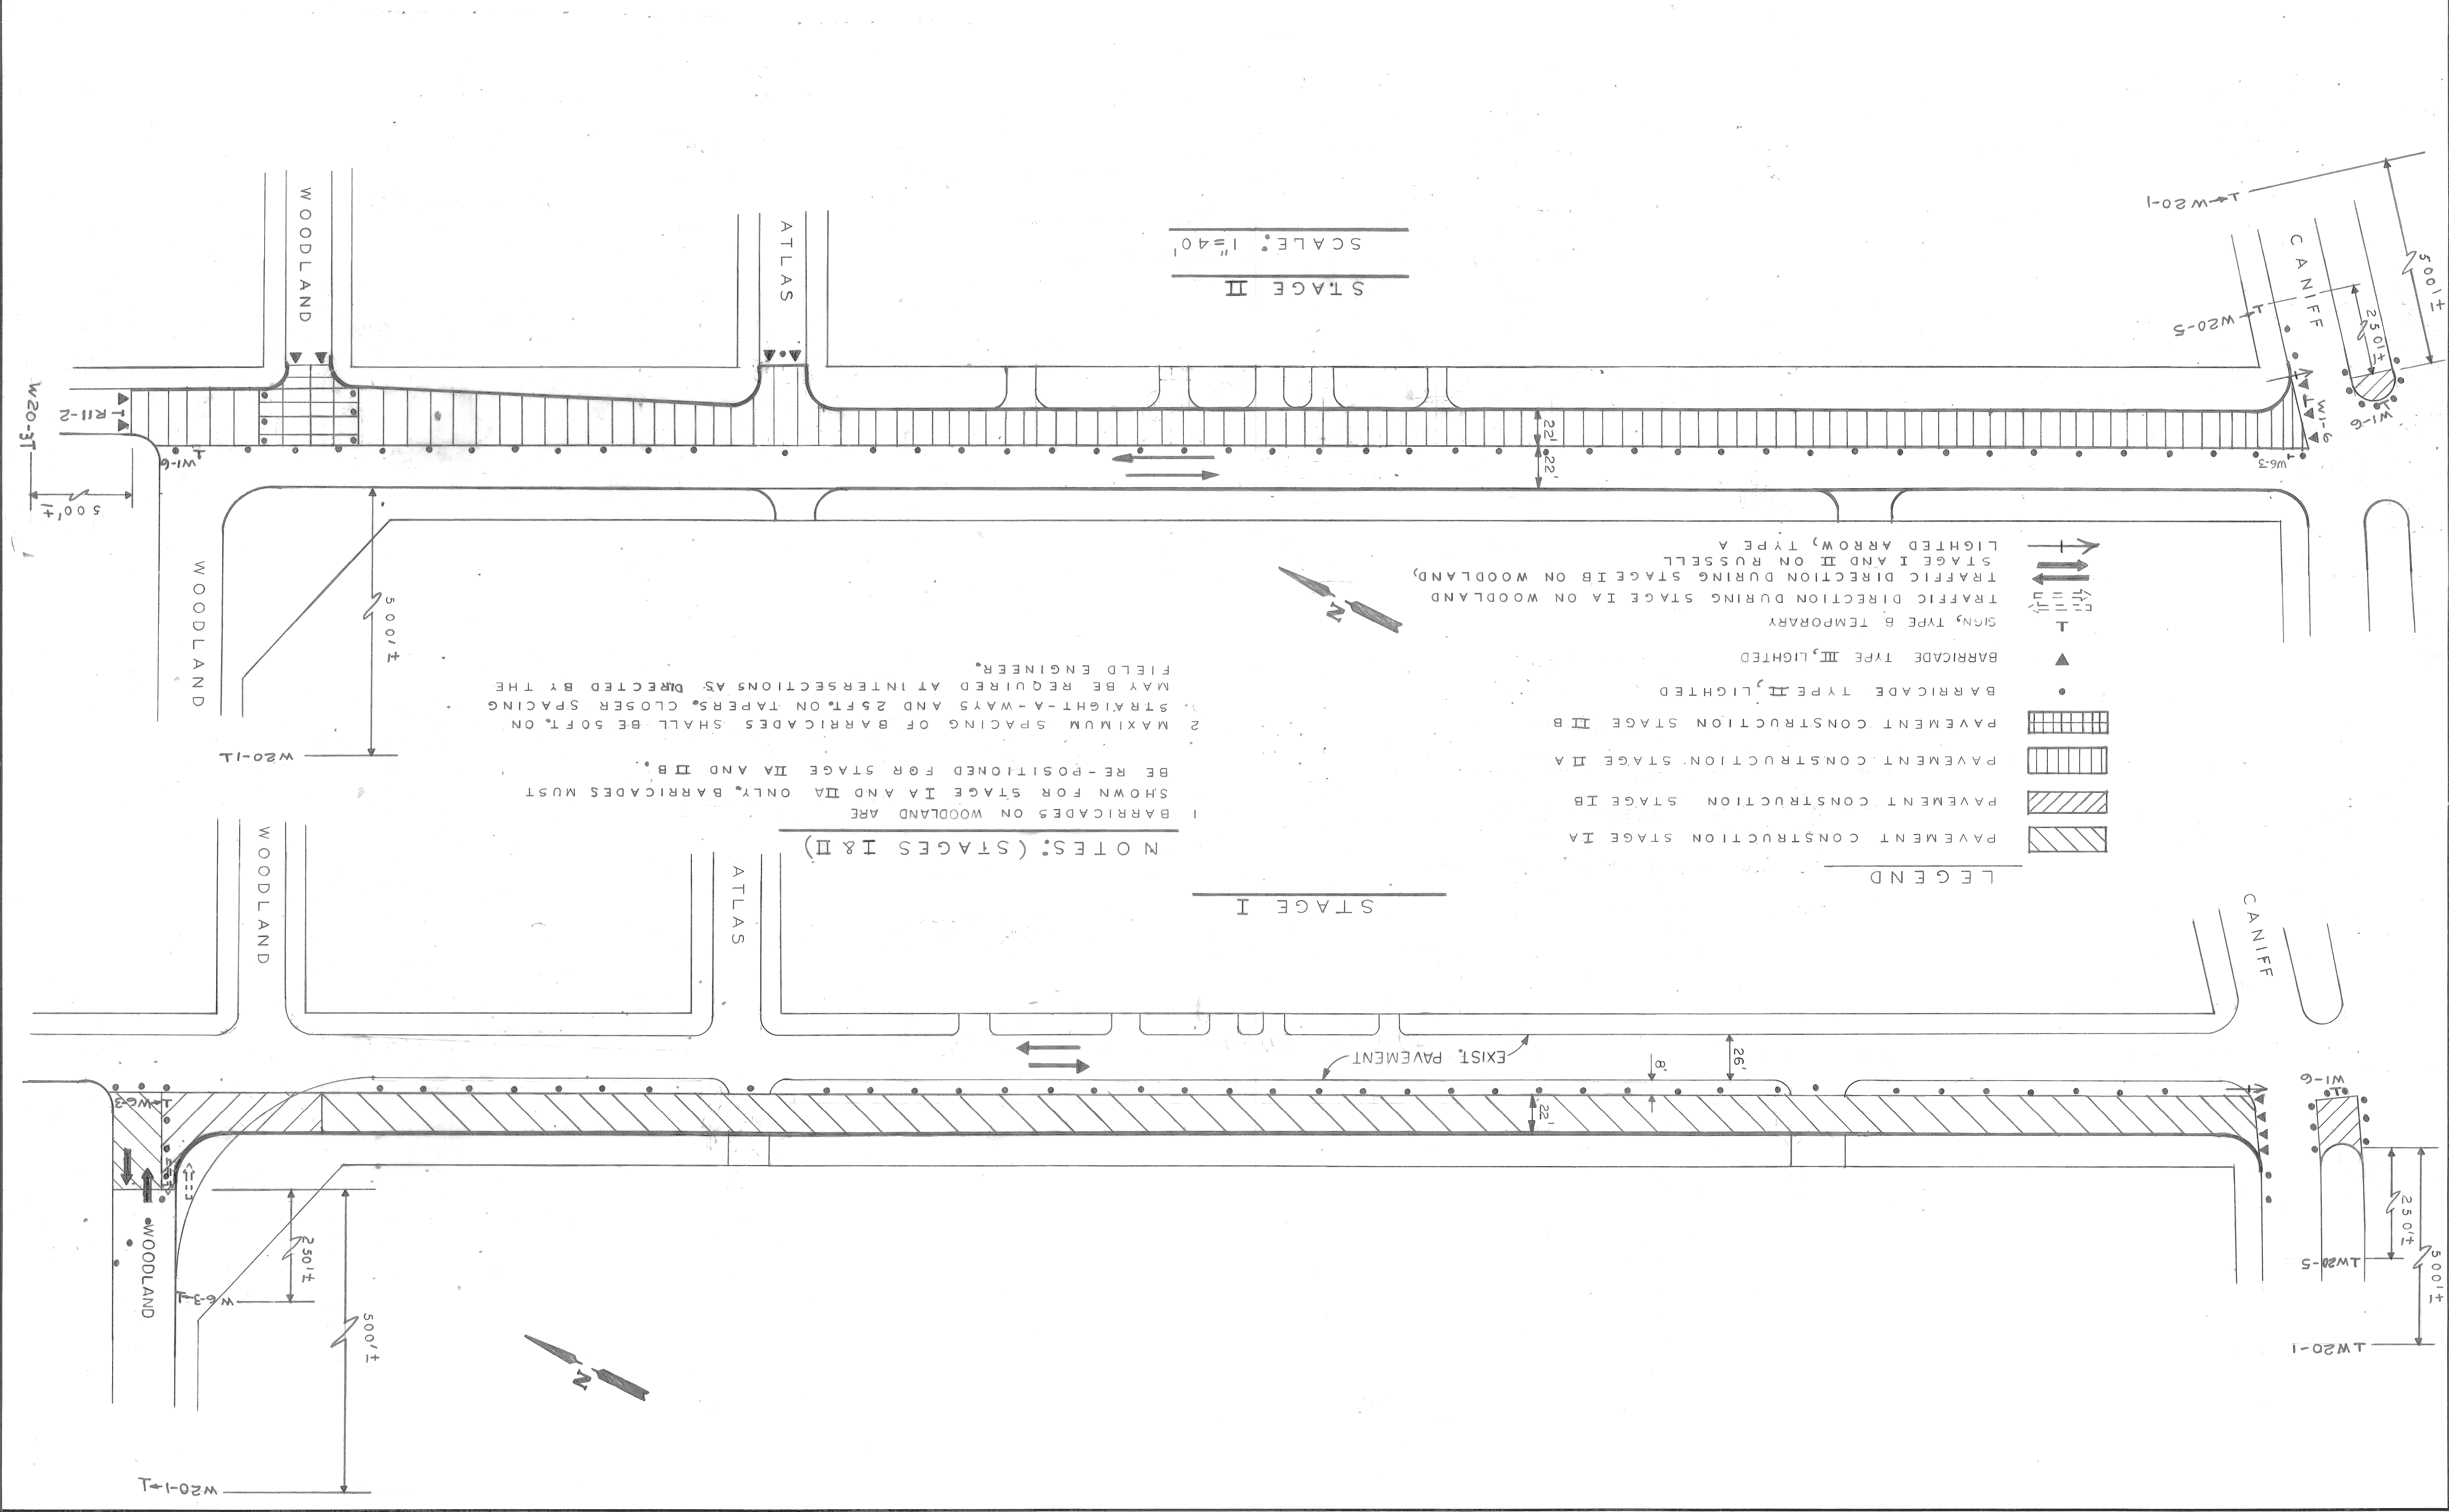

LEGEND

- PAVEMENT CONSTRUCTION STAGE IA
- PAVEMENT CONSTRUCTION STAGE IB
- PAVEMENT CONSTRUCTION STAGE IIA
- PAVEMENT CONSTRUCTION STAGE IIB
- BARRICADE TYPE III, LIGHTED
- SIGN, TYPE B TEMPORARY
- TRAFFIC DIRECTION DURING STAGE IA ON WOODLAND
- TRAFFIC DIRECTION DURING STAGE IB ON WOODLAND
- LIGHTED ARROW, TYPE A

NOTES: (STAGES I & II)

- 1 BARRICADES ON WOODLAND ARE SHOWN FOR STAGE IA AND IIA ONLY. BARRICADES MUST BE RE-POSITIONED FOR STAGE IIB AND IIB.
- 2 MAXIMUM SPACING OF BARRICADES SHALL BE 50 FT. ON STRAIGHT-A-WAYS AND 25 FT. ON TAPERS. CLOSER SPACING MAY BE REQUIRED AT INTERSECTIONS AS DIRECTED BY THE FIELD ENGINEER.





SCALE: 1"=40'

STAGE II

STAGE I

SHEET 4 OF 21 SHEETS		CONTRACT NO. 31809A		ASSIGNMENT NO. 91-60-01		DATE APRIL, 92	
RECONSTRUCTION OF RUSSELL FROM CANIFF TO WOODLAND AND MISCELLANEOUS CONSTRUCTION		CITY OF DETROIT		BUREAU OF STREETS AND HIGHWAYS		CITY ENGINEERING DEPARTMENT	
DESIGNED BY N.H.		DRAWN BY J.J.		CHECKED BY N.W.		APPROVED: <i>William J. Hall</i> ENGINEER OF STREETS HIGHWAY ENGINEER	
REVISIONS LOCATED BY COORDINATES ON SHEET		DESCRIPTION		DATE		DR. N. CK. G. A. V. D. DATE	

DATE APRIL 92		INDEXED		NO. 91-60-01		ASSIGNMENT		CONTRACT NO. 31809A		SHEET 7 OF 21 SHEETS	
INTERSECTION DETAIL GRADE		WOODLAND AND MISCELLANEOUS CONSTRUCTION		RECONSTRUCTION OF RUSSELL FROM CANIFF TO		CITY OF DETROIT		ENGINEERING DEPARTMENT		BUREAU OF STREETS AND HIGHWAYS	
FOR		APPROVED		BY		CHECKED BY		PLAN		GRADE	
N. H.		J. J.		N. W.		CHECK		ESTIMATE		FINAL	
REVISIONS		DESCRIPTION		DATE		BY		CHECKED BY		DATE	

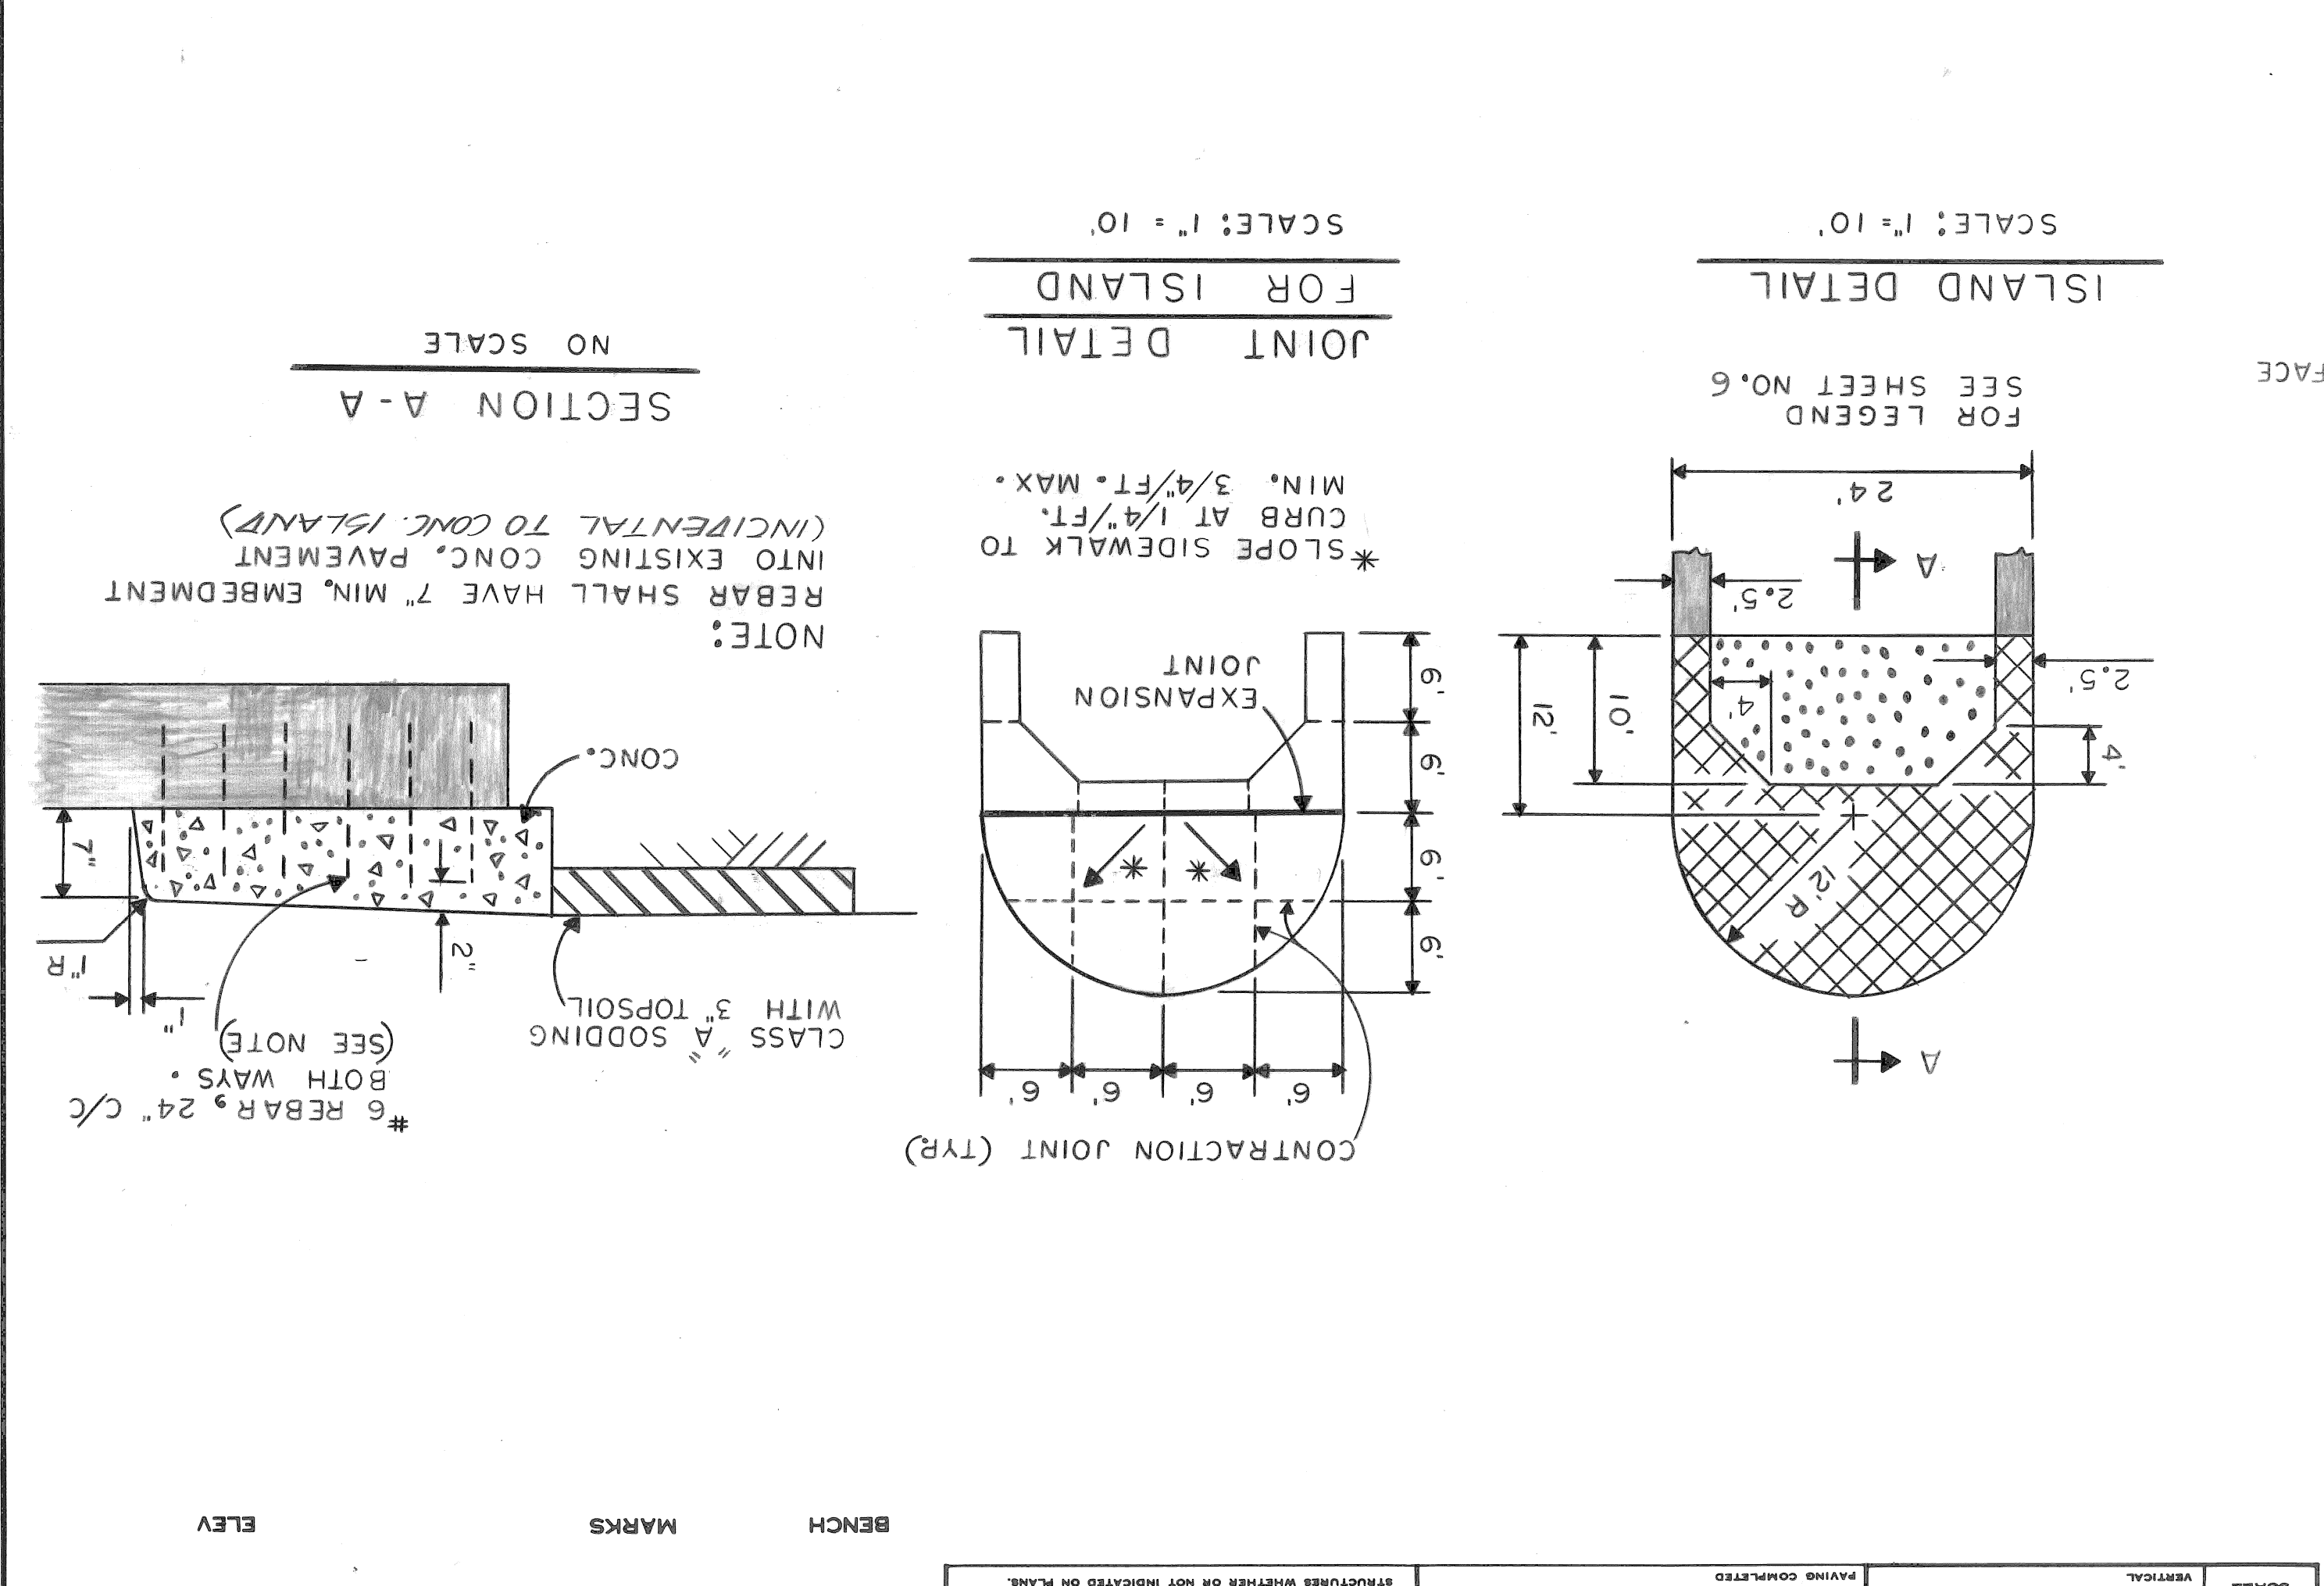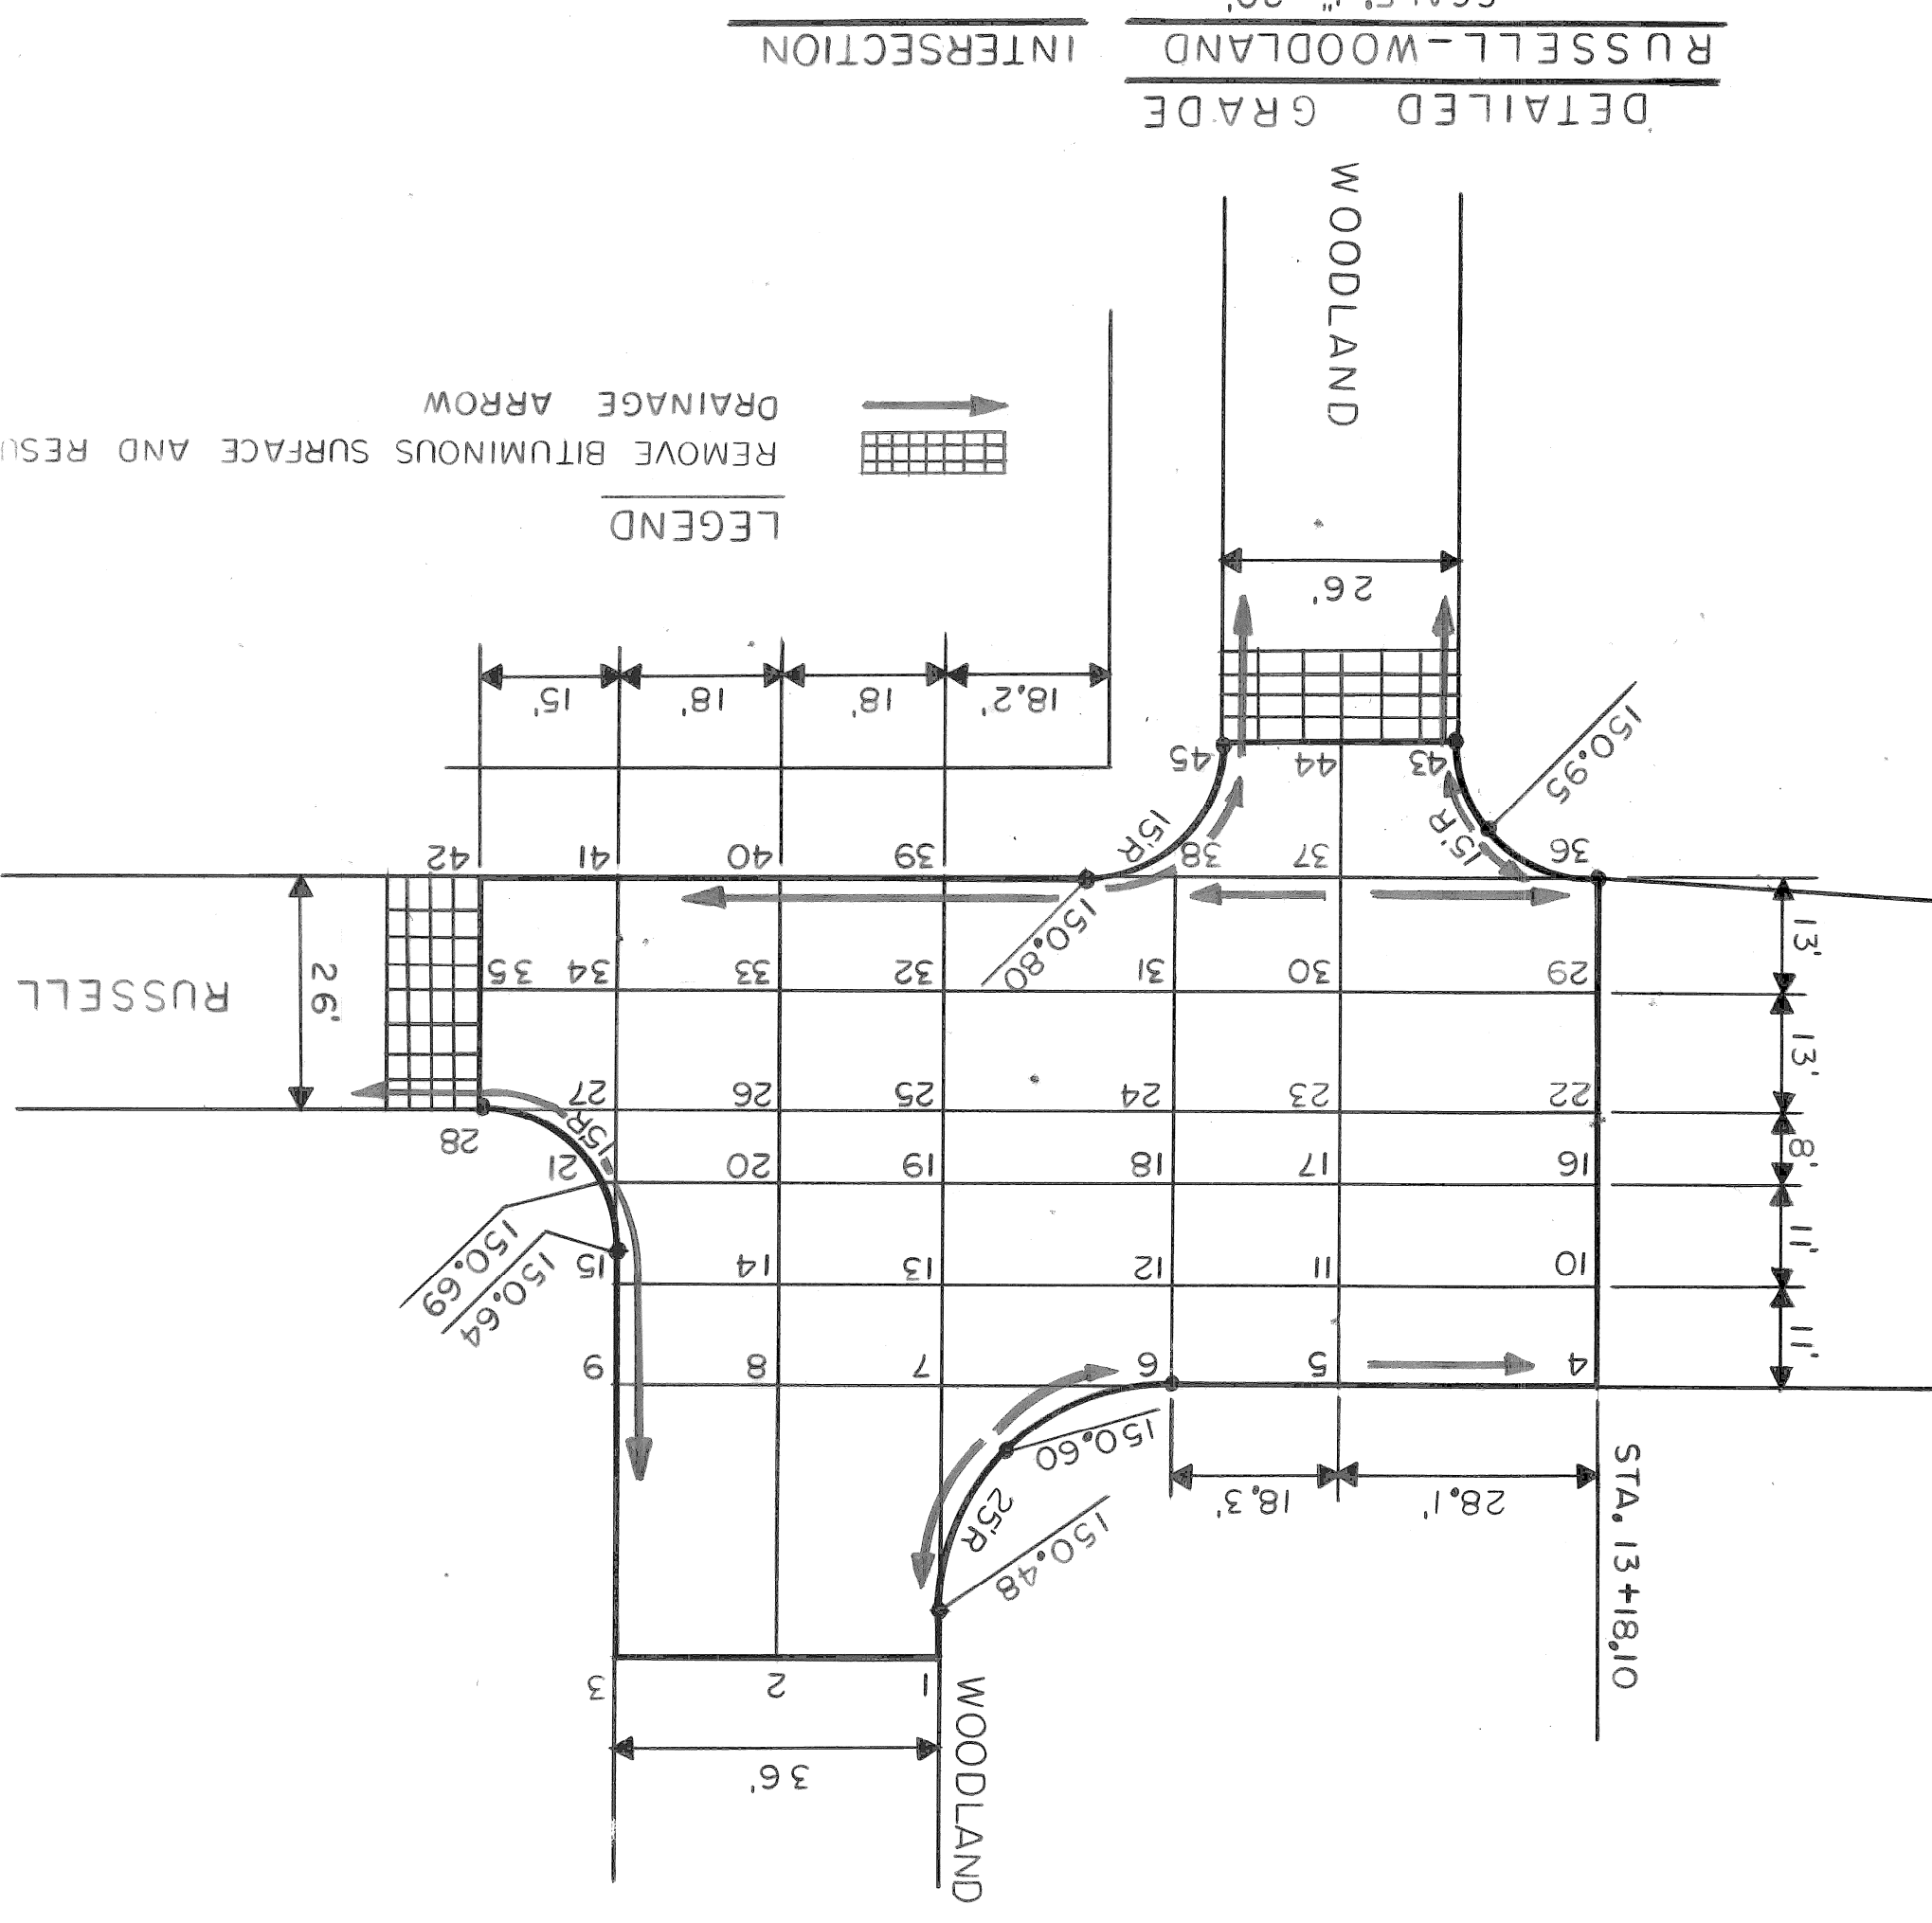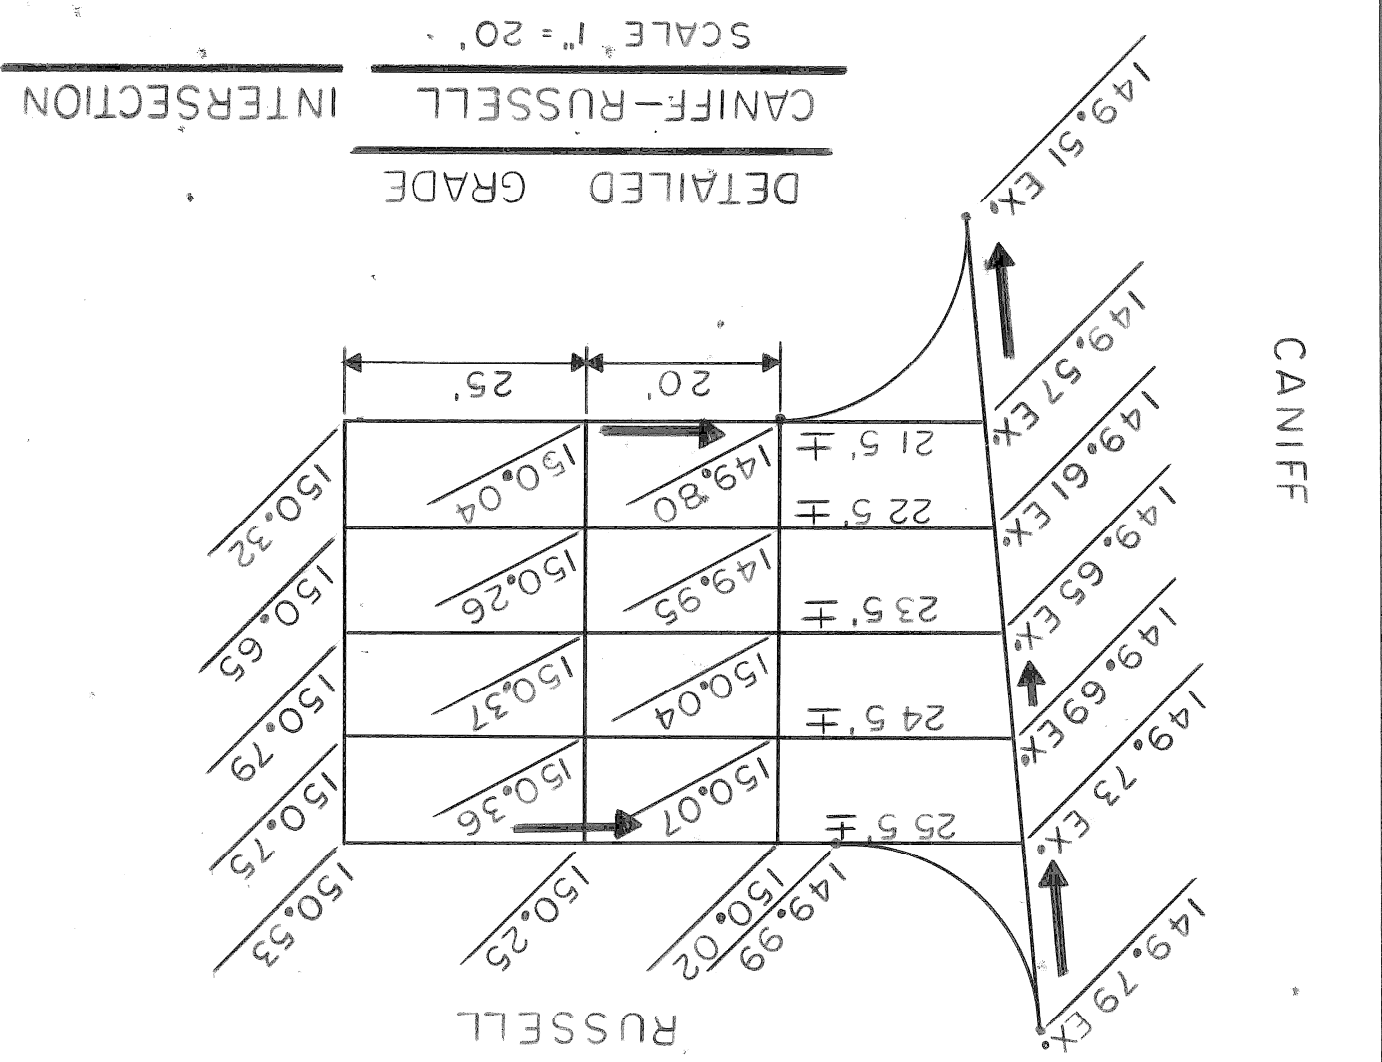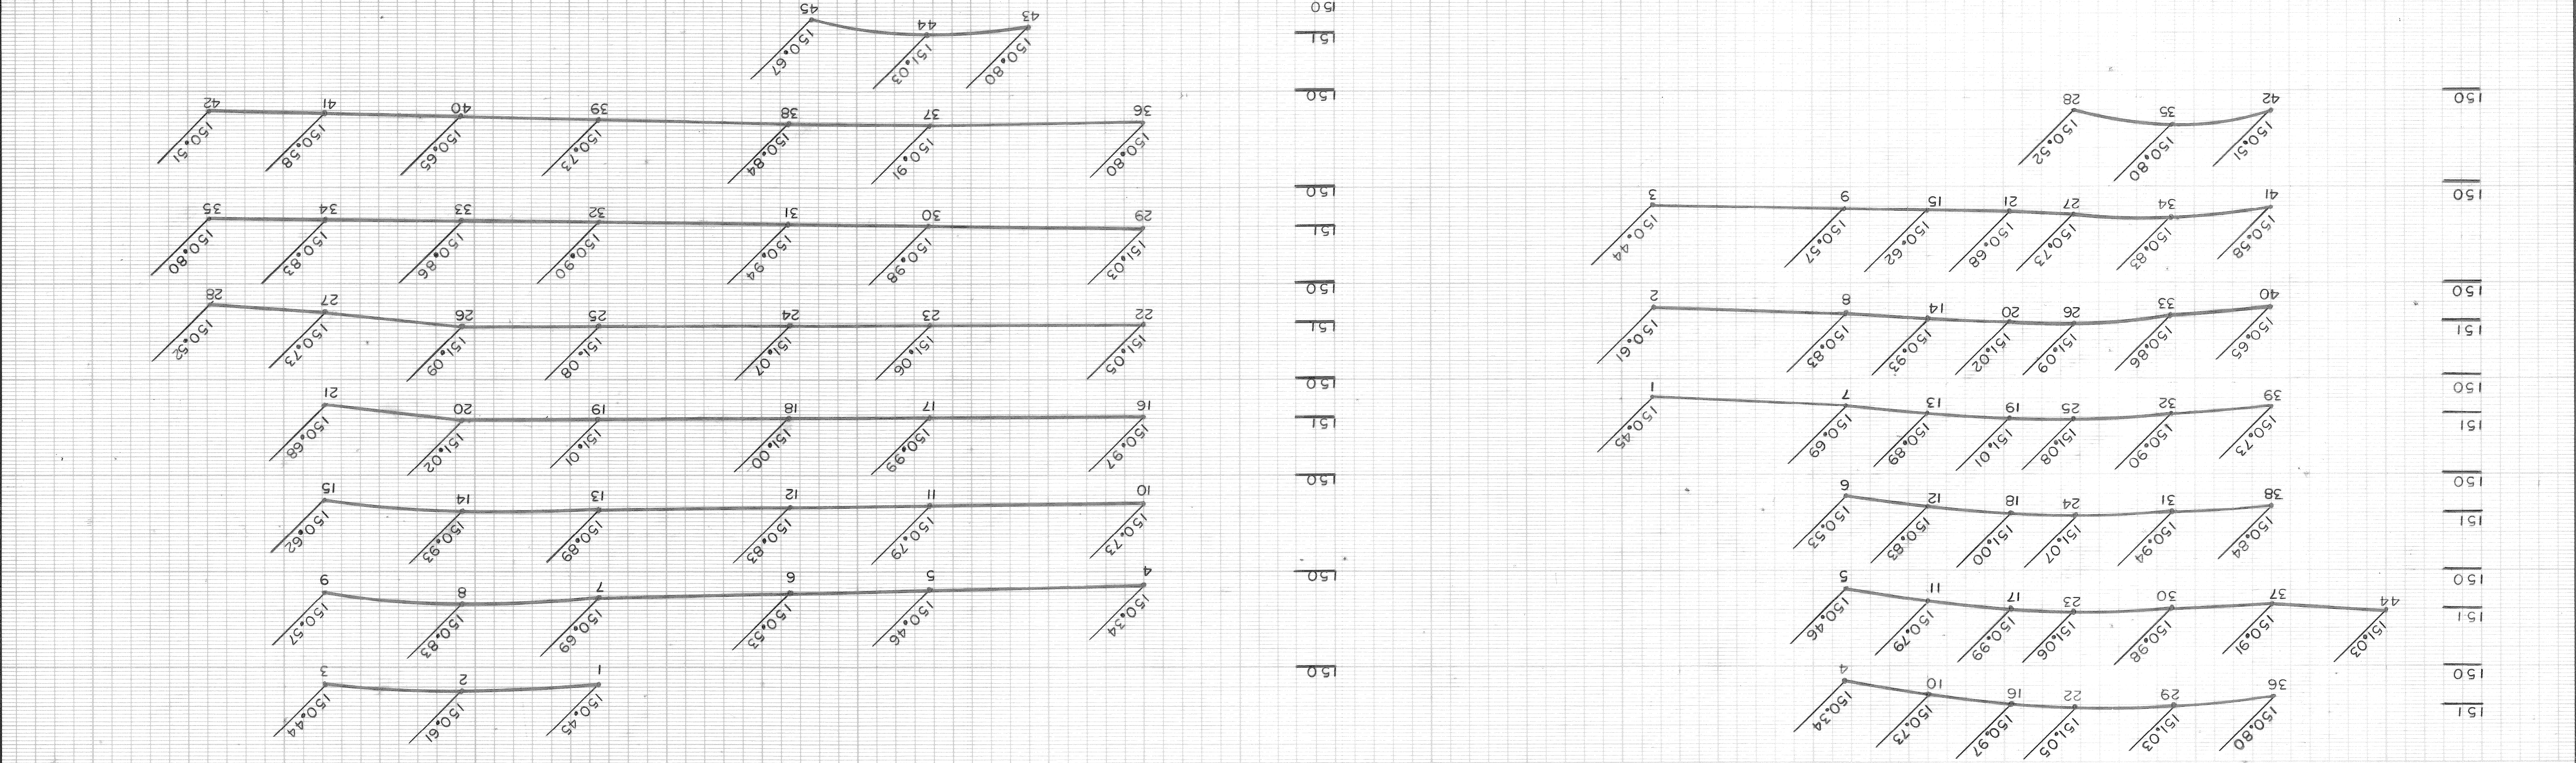


BOOK	NO.	DATE	REPAIR STARTING CONSTRUCTION
SCALE	HORIZONTAL	VERTICAL	NO. SYMBOLS
MARKS	BENCH	ELEV.	NOTE - FOR SYMBOLS

NO.	DATE	DESCRIPTION	REVISIONS LOCATED BY COORDINATES ON SHEET	
			COORD.	DESCRIPTION

DESIGNED BY	E.W.P.
DRAWN BY	
TRACED BY	
CHECKED BY	


APPROVED: *E.W.P.*

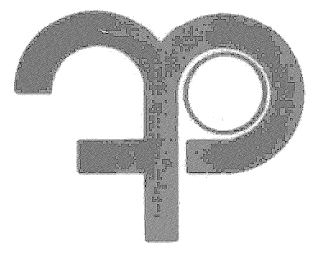

CITY OF DETROIT
DEPARTMENT OF TRANSPORTATION
TRANSPORTATION ENGINEERING

RECONSTRUCTION OF RUSSELL FROM
 CANIFF TO WOODLAND AND
 MISCELLANEOUS CONSTRUCTION
 PAVEMENT MARKINGS

SHEET 8 OF 22 SHEETS
 SCALE: 1" = 40'
 DRWG NO. CL-138
 DATE 12-3-90

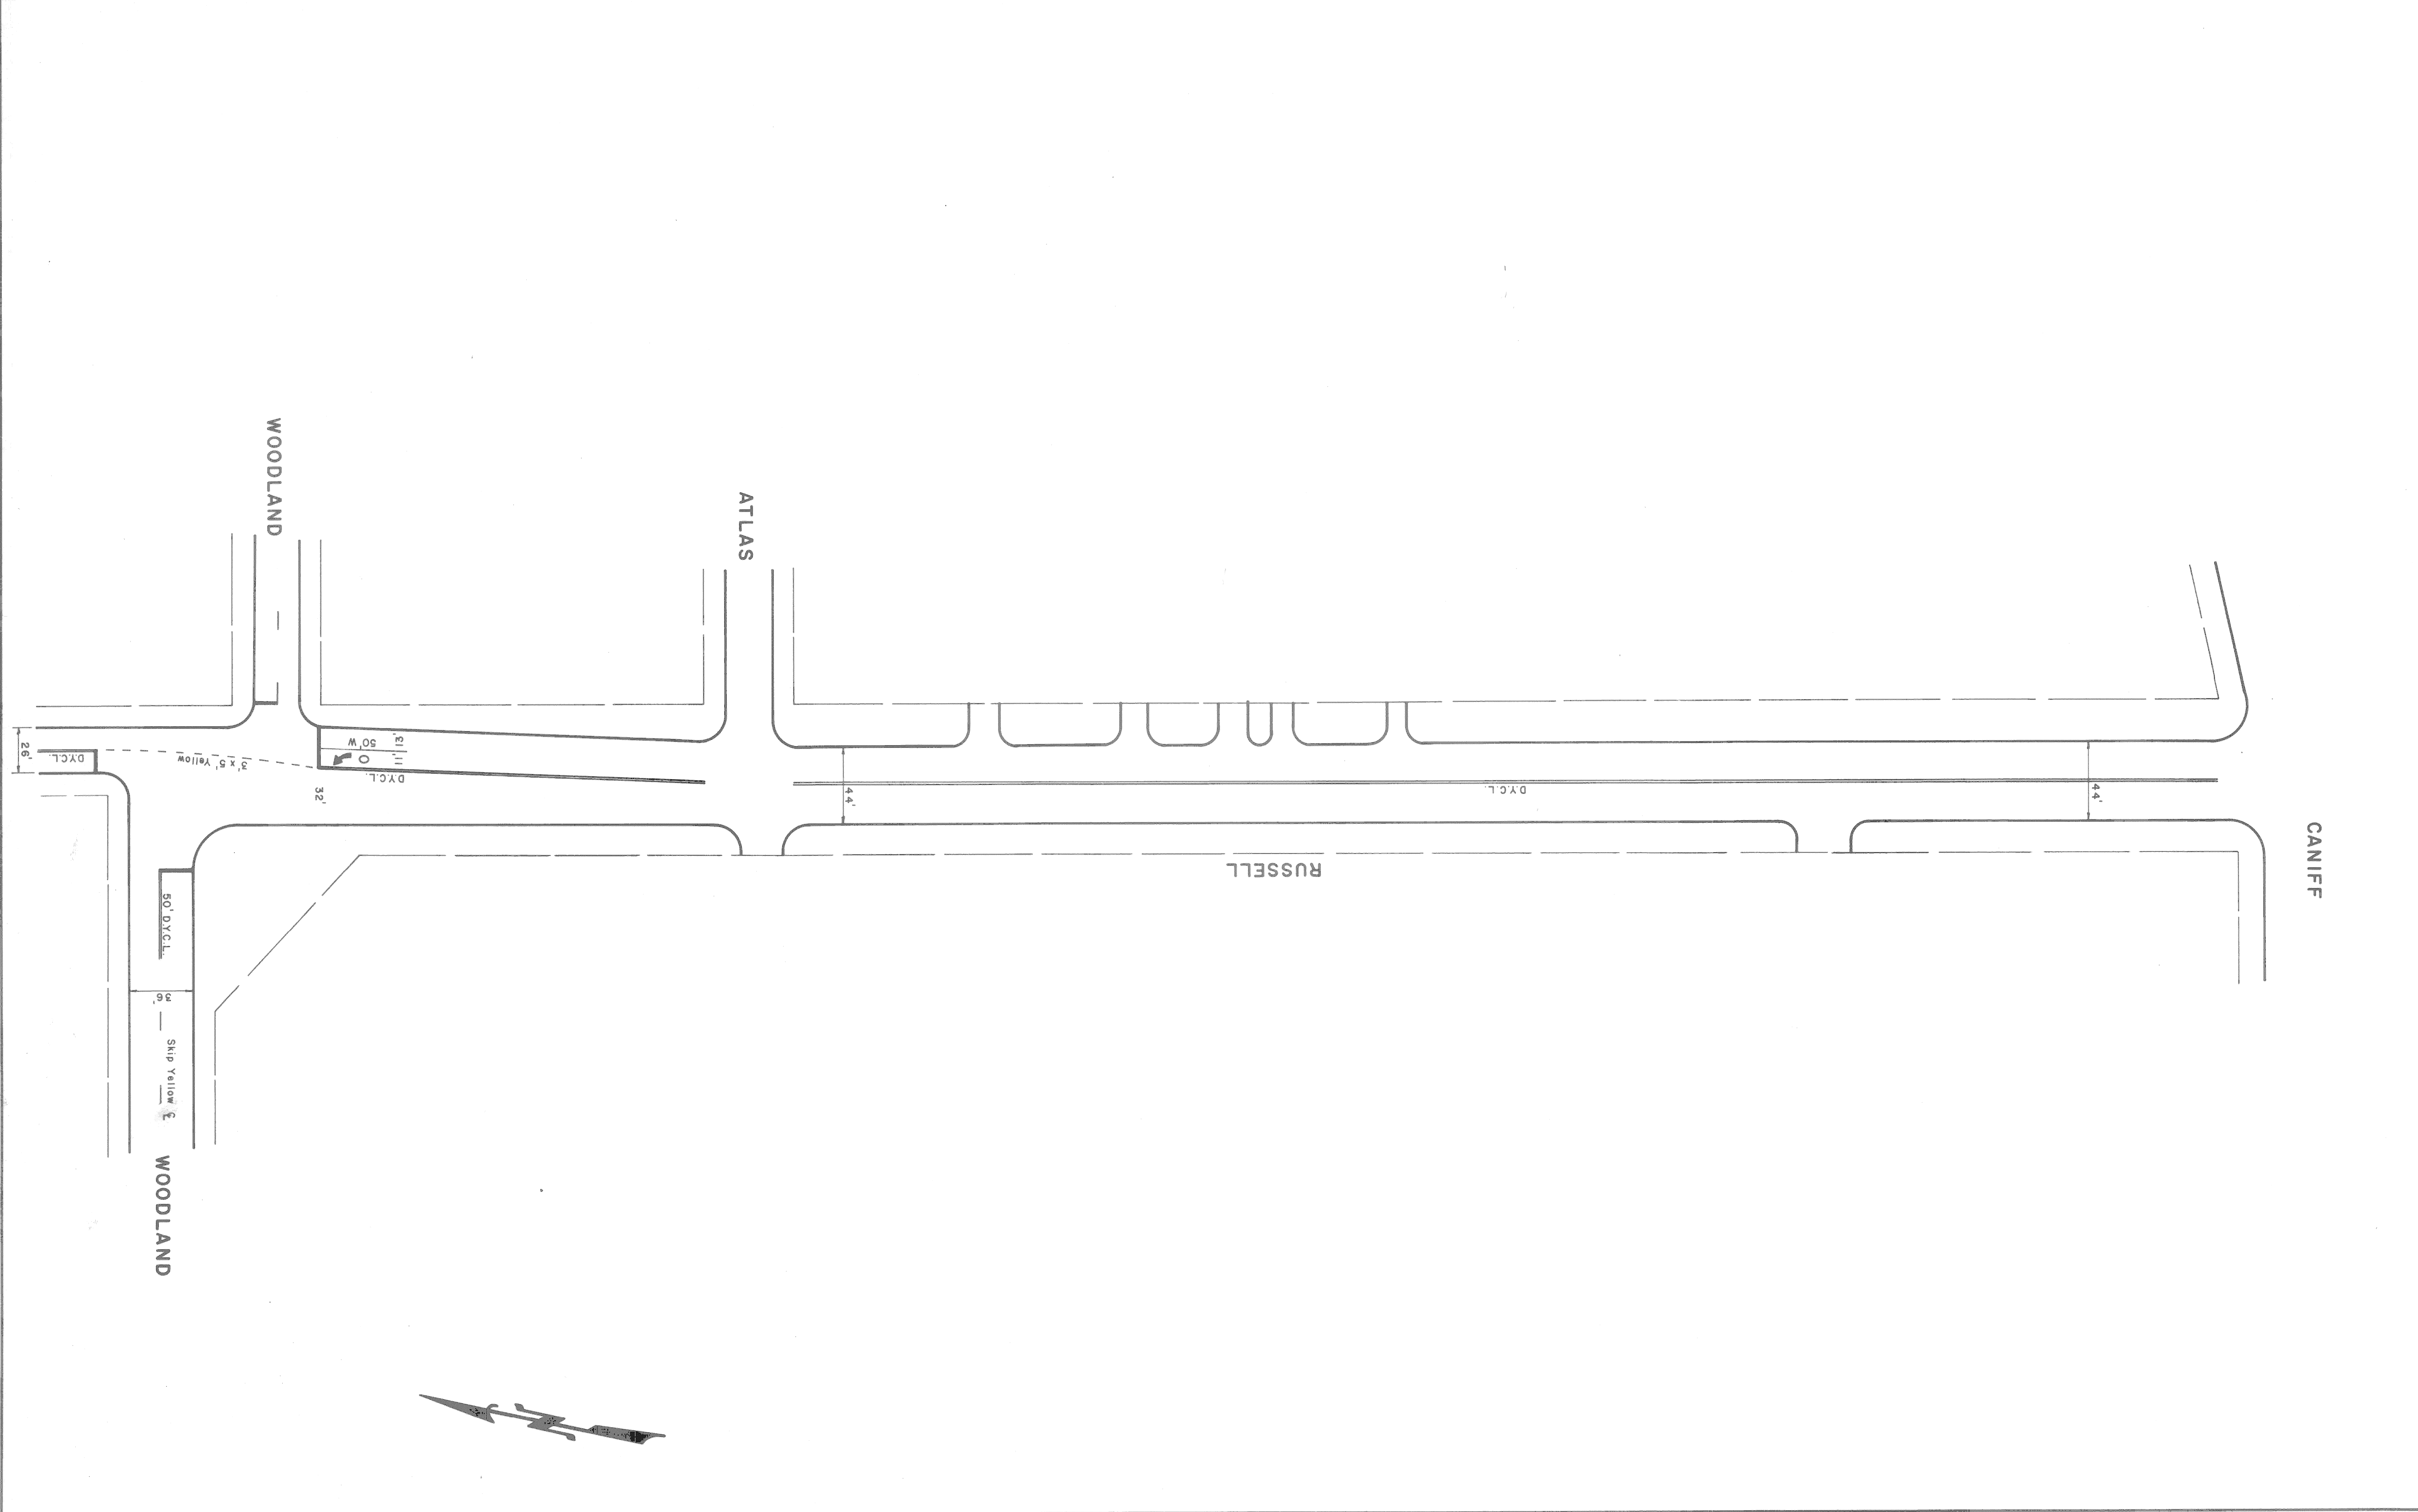


DETAILS OF STANDARD
 CATCH BASINS "A" & "B"
 AND FLAT GRATE & FRAME

CITY OF DETROIT
 DEPARTMENT OF PUBLIC WORKS
 CITY ENGINEERS OFFICE

APPROVED	IN CHARGE	DATE	NO. SCALE
<i>J. E. ...</i>			
ENGINEER OF STREETS	ENGINEER OF EXHIBITS	ENGINEER OF ...	ENGINEER OF ...
<i>...</i>	<i>...</i>	<i>...</i>	<i>...</i>


STANDARD FLAT GRATE AND FRAME

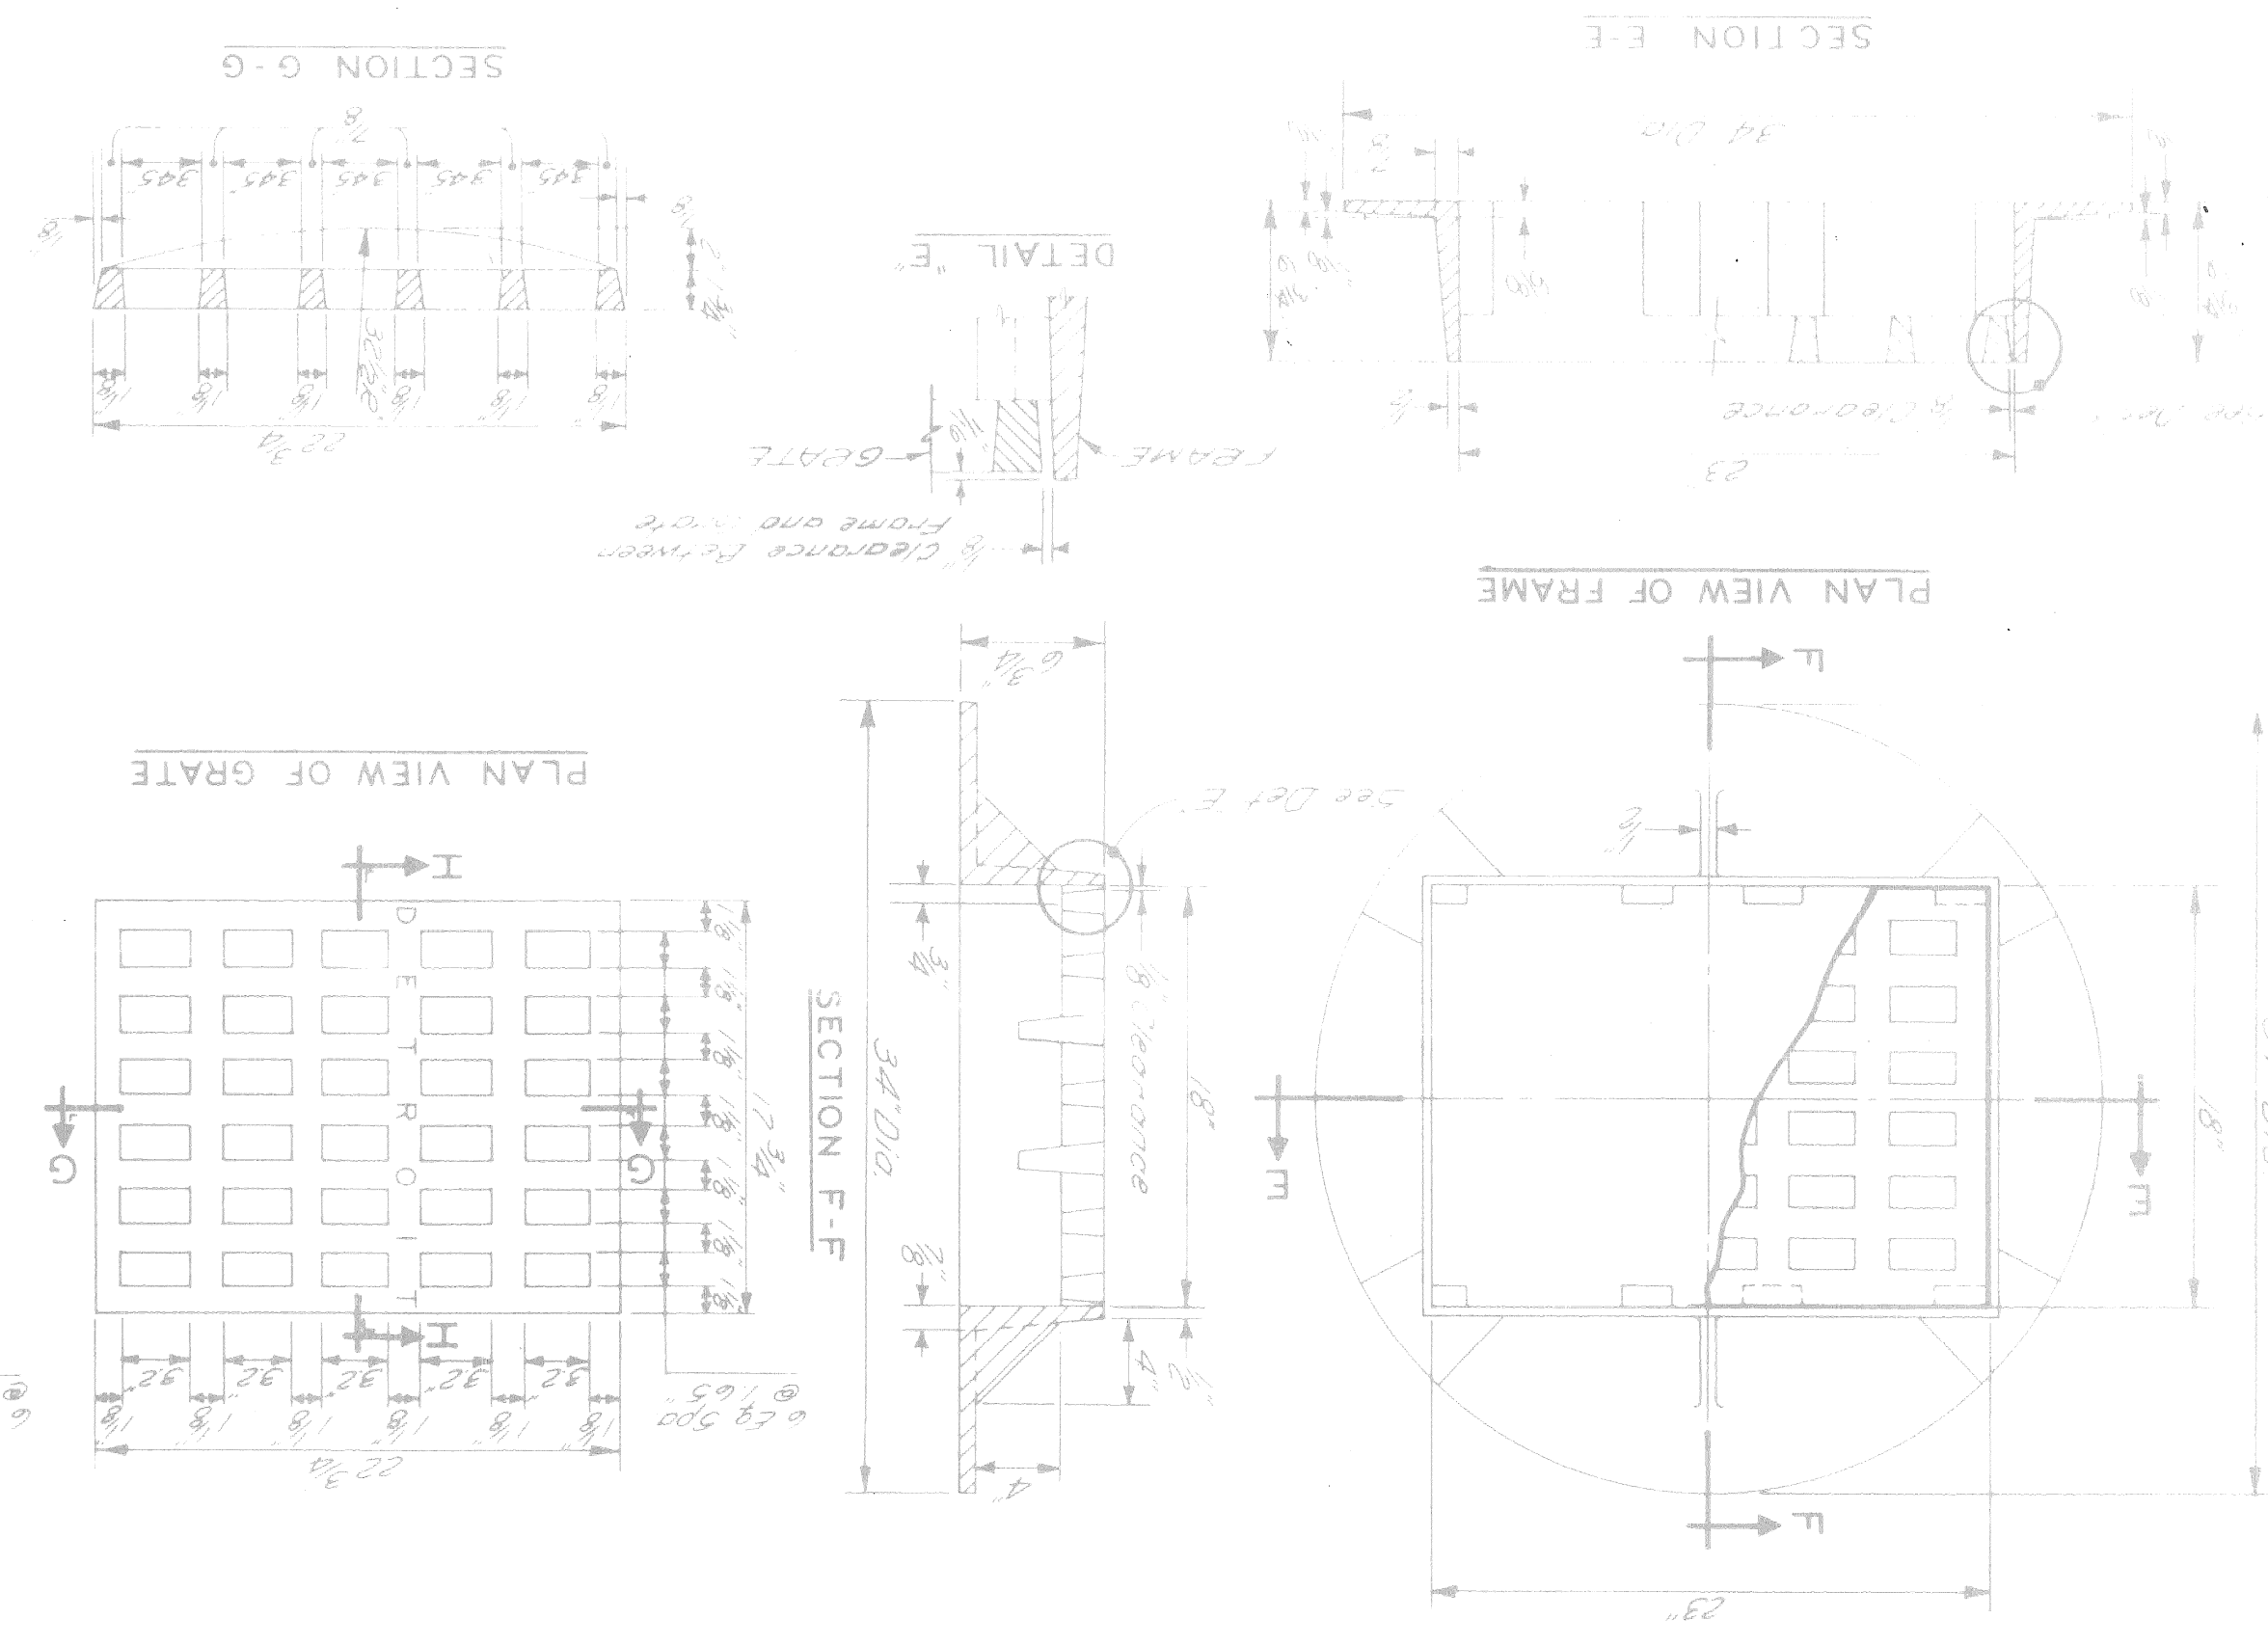


- The materials & workmanship shall be in accordance with the current Standard Specifications.
- Center of catch basin shall be 20 inches from back of curb.
- All sizes & flow lines of pipe, and elevations for top & bottom of structures shall be determined from the plans or construction requirements.
- The bell shall be removed from the first length of outlet pipe projecting through the wall of the structures.
- When any structure is constructed of precast concrete or concrete block, the top of the masonry shall be left sufficiently low to permit proper adjustment of cover to grade by the use of mortar or bricks as directed by the Engineer.
- A Trap, as detailed on this sheet, shall be placed where called for in the outlet sewer line of catch basins "B". This trap shall be set into the masonry wall as shown on the detail. The space between the faces of the wall & the trap shall be completely filled with cement mortar or concrete, so as to hold trap securely in place.
- The traps will be paid for separately of the Contract Unit Price each, which price shall include the extra catch basin construction required and for furnishing and installing the trap.
- A plaster coat of mortar 1/2 inch in thickness shall be applied to the outer surface of the structure as shown. A 1/2 inch cement plaster coat shall be placed on the inside of all sumps.
- Contractor shall verify elevations of existing utilities to enable construction to indicated elevations shown on drawings. It necessary, invert elevations shown on the drawings may be altered in the field to clear existing utilities. Such alterations upward or downward, shall be of no change in contract price.
- When precast concrete pipe sections are used for catch basins, either a section of the inlet and outlet pipes or an opening or eye for the inlet & outlet pipes shall be cast into the wall of the catch basin pipe when it is being manufactured. Eyes in precast pipe sections shall be furnished to accommodate a flexible joint connection, such as Press-Wedge by Press-Box Basket Corp. or Res-Seal by Seales Mfg. Corp.
- For limit for sewers shall be inside faces of structures unless otherwise noted.

GENERAL NOTES



DETAIL OF TRAP FOR CATCH BASIN "B"

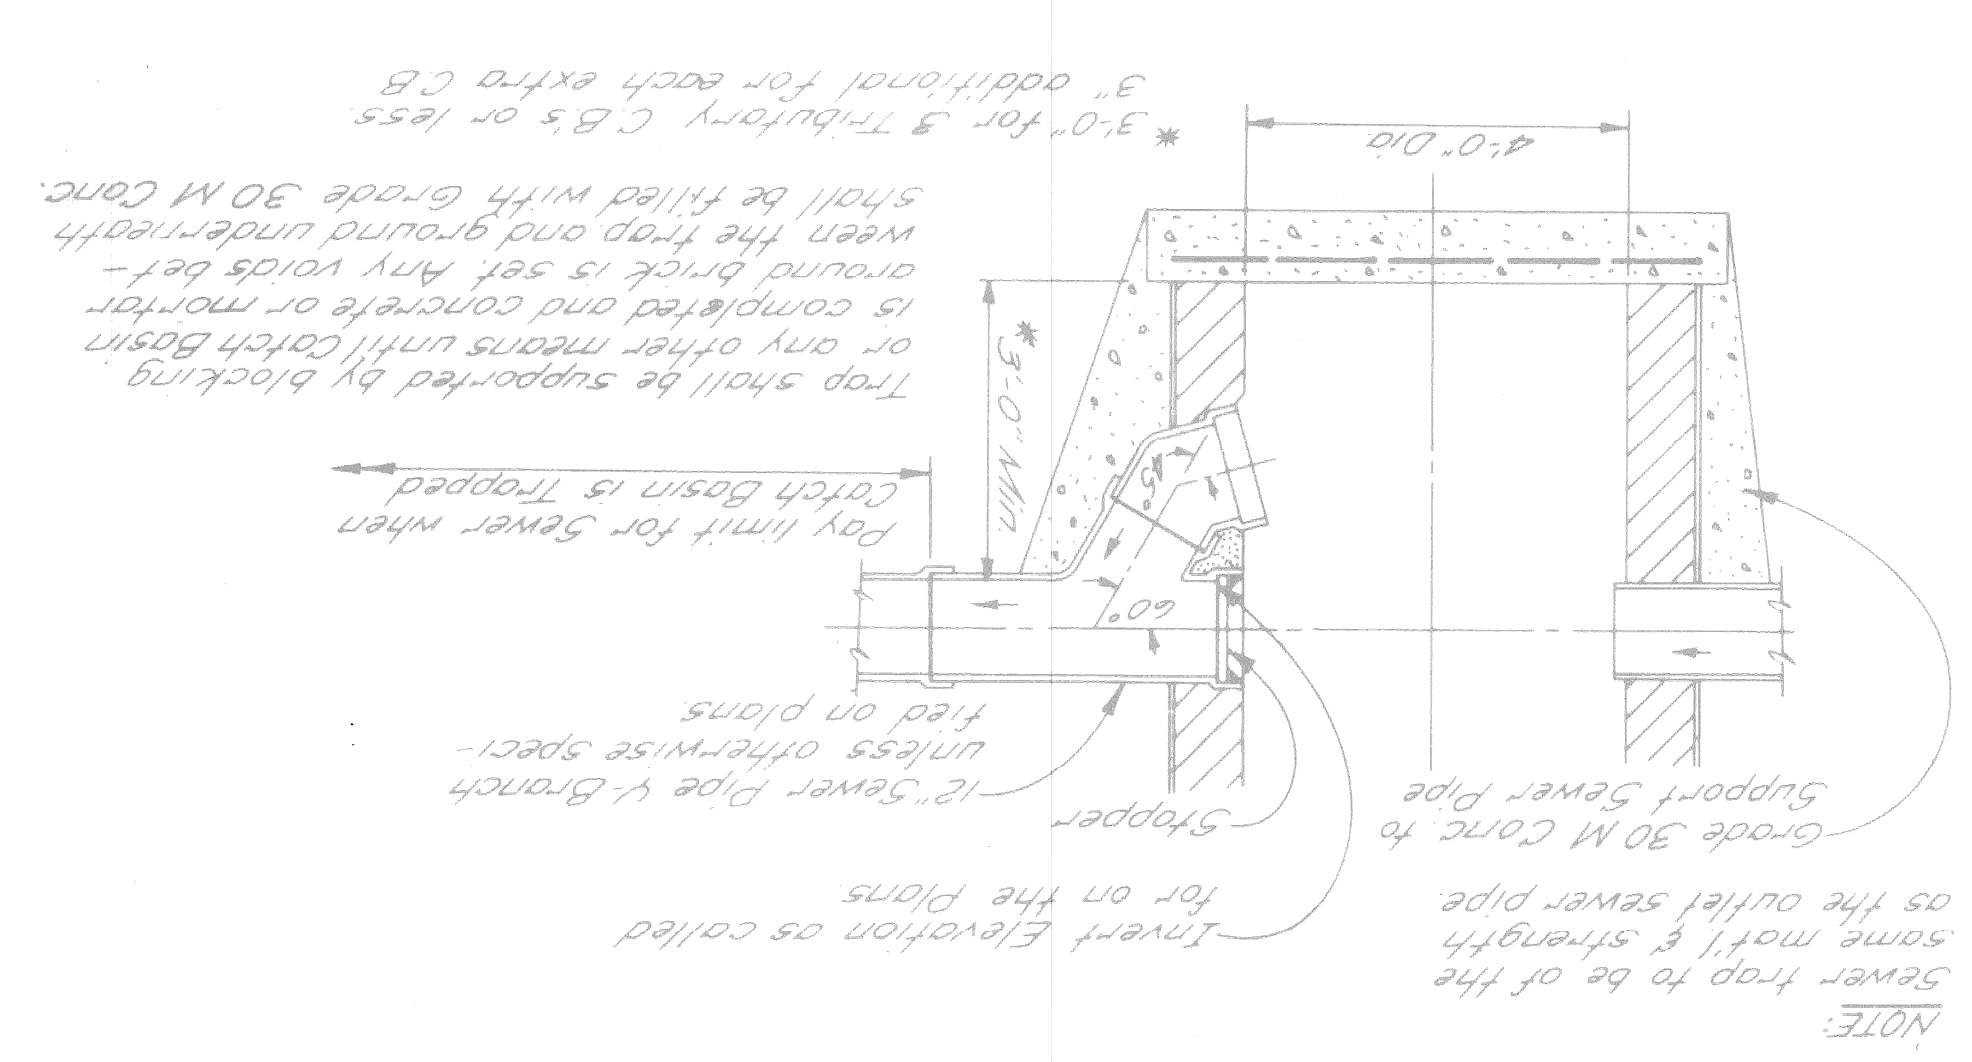



CATCH BASIN "B"

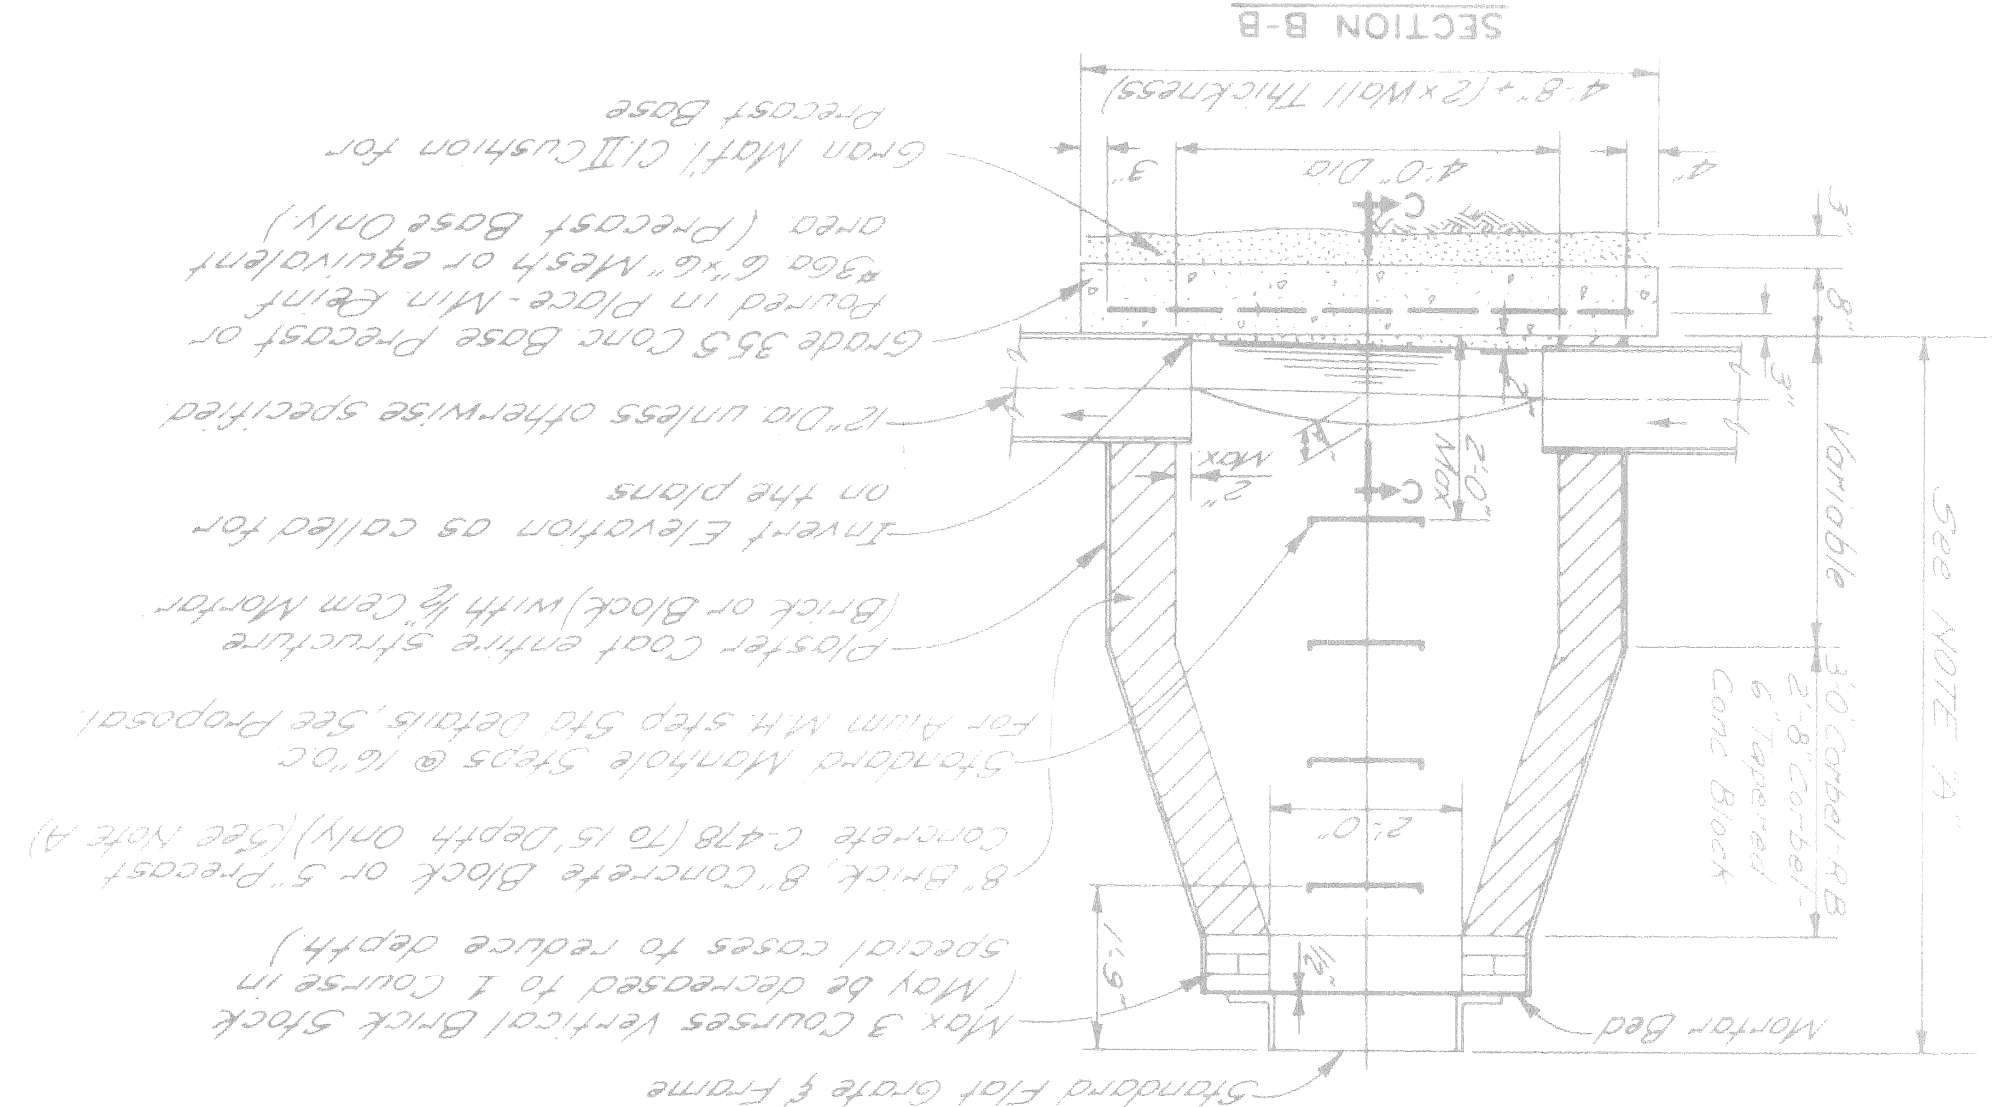


DETAIL OF SUMP FOR CATCH BASIN "B"

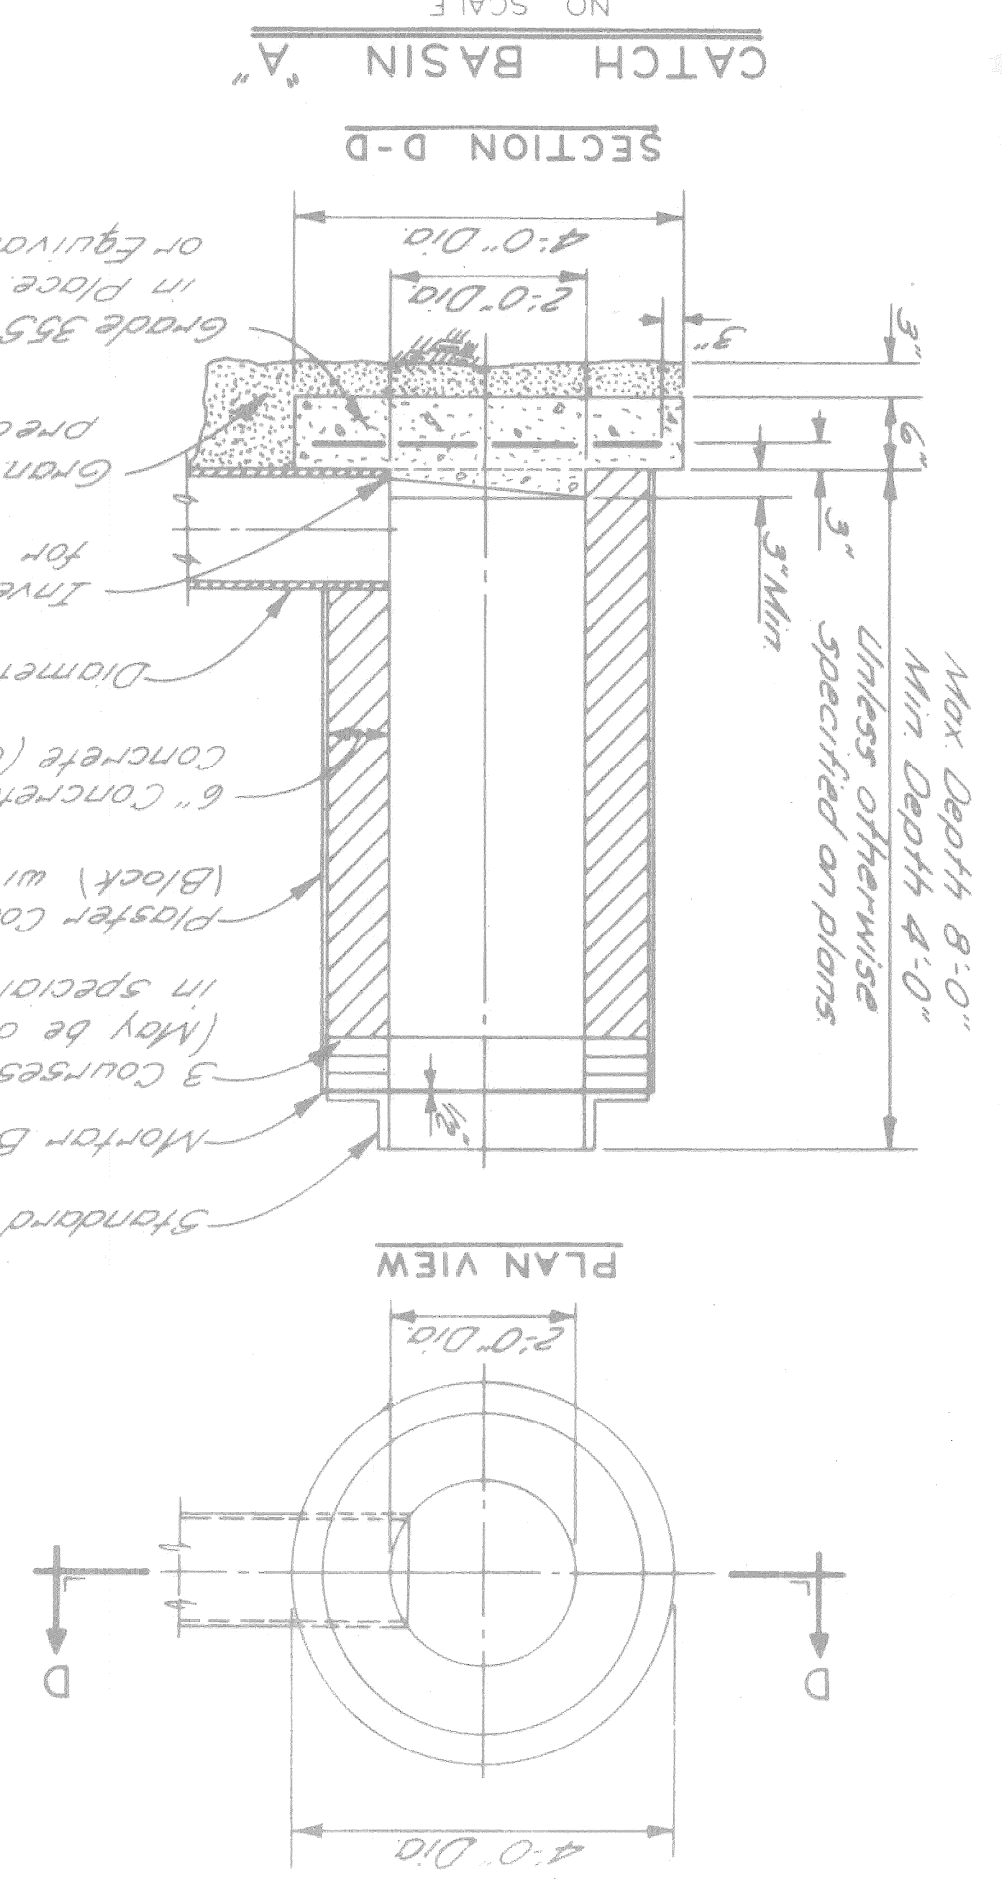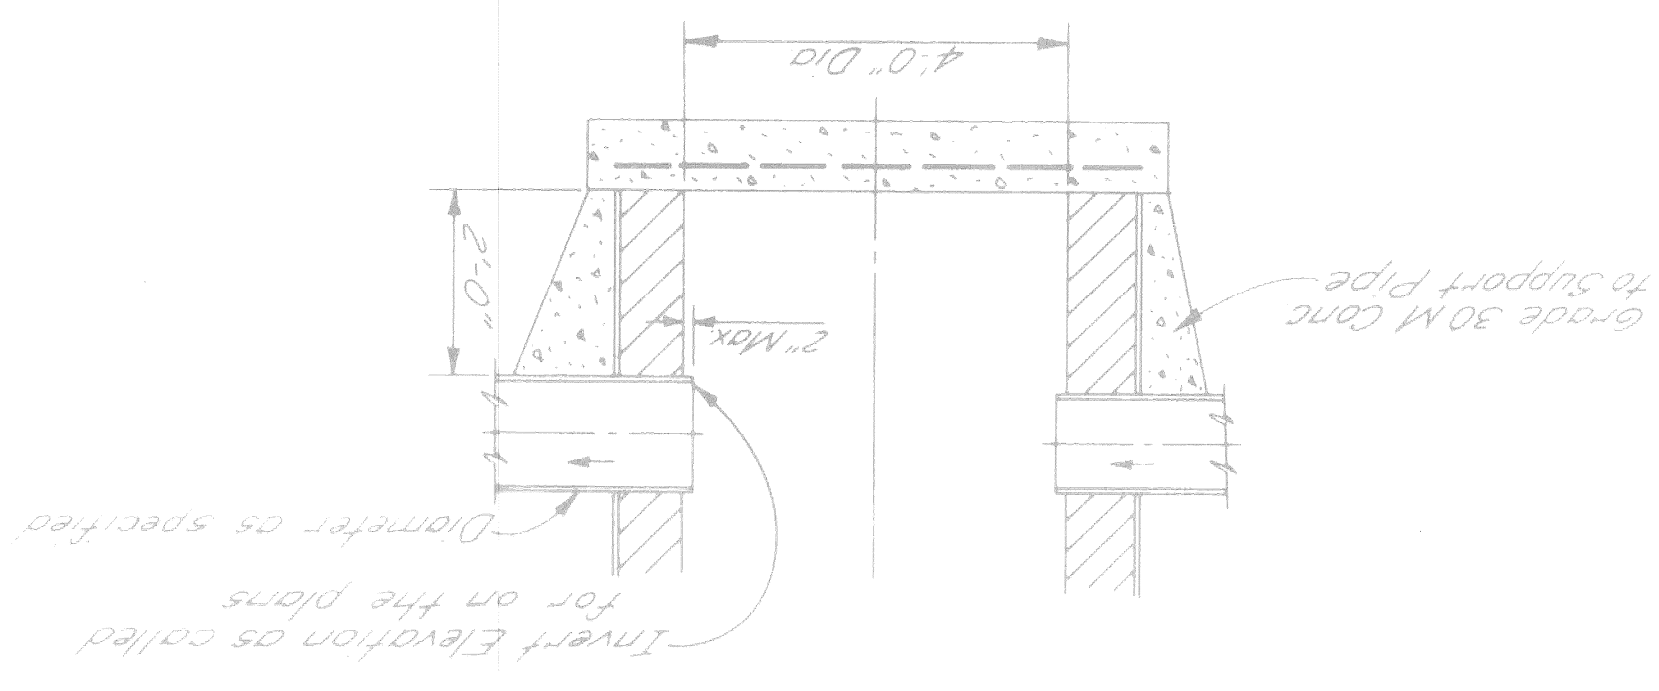


SECTION C-C

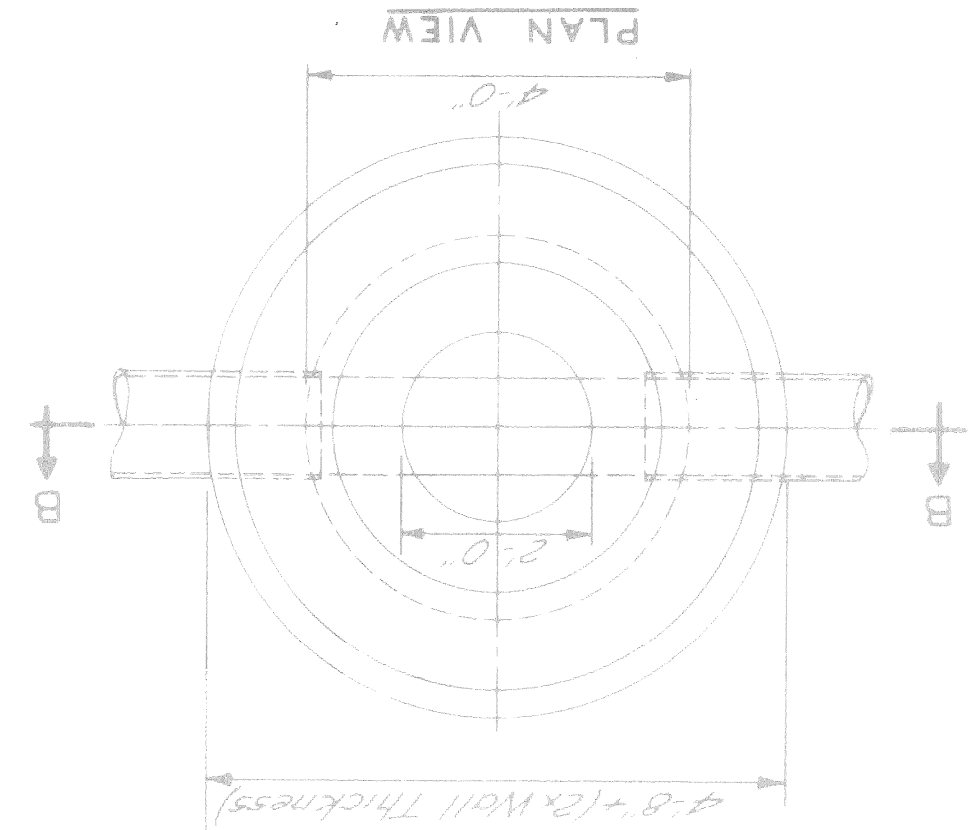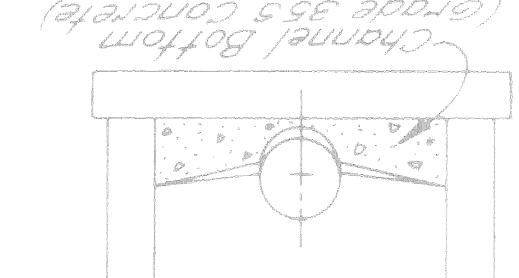




SPECIAL DETAILS		CITY OF DETROIT		CITY ENGINEERING DEPARTMENT		SPECIAL MOWER RAMP		1975	
DATE APRIL 92	DRWG NO. 91-60-01	CONTRACT NO. 31809 A	SHEET 10 OF 22 SHEETS	FOR	APPROVED:	DESIGNED BY	DRAWN BY	TRACED BY	CHECKED BY

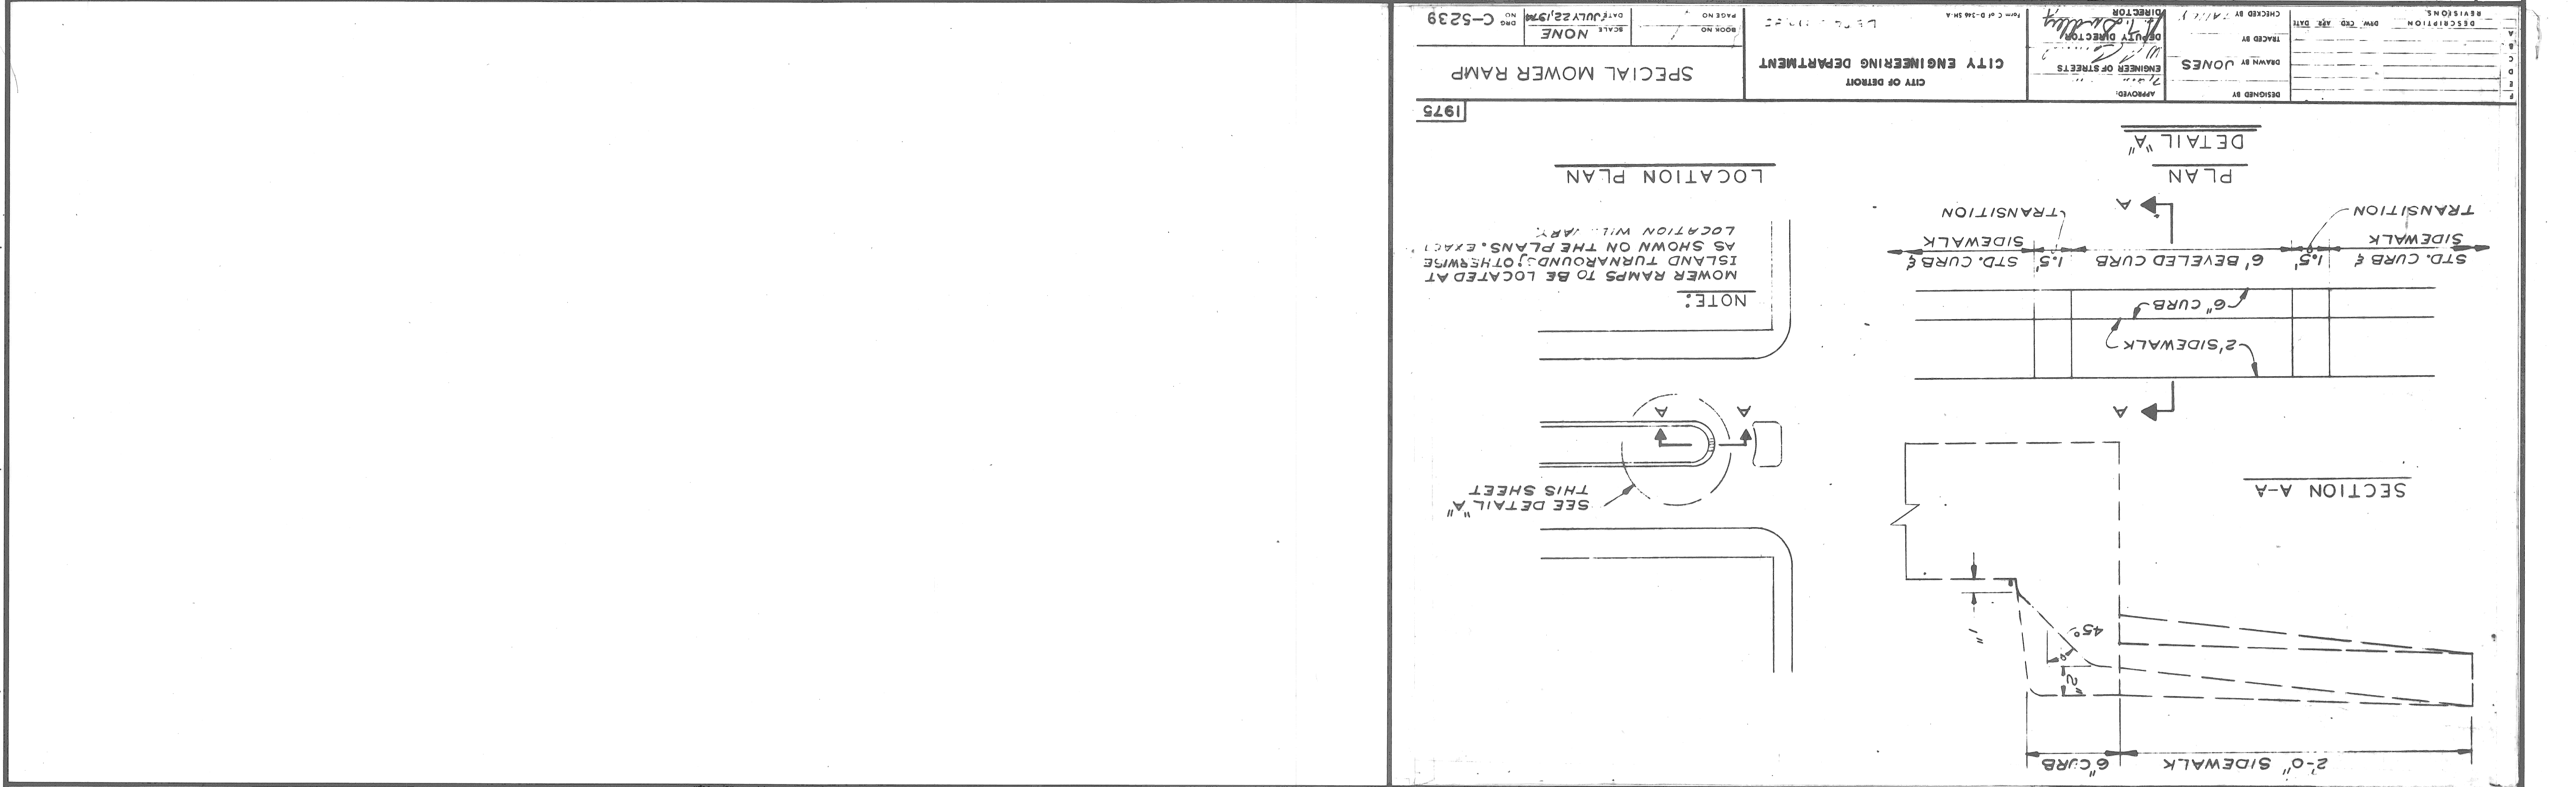




ALLEY INSTALLATION STANDARD 18"x12" SPECIAL Y-CATCH BASIN		CITY OF DETROIT DEPARTMENT OF PUBLIC WORKS BUREAU OF DESIGN		STANDARD DESIGN 18"x12" SPECIAL Y-CATCH BASIN		CITY OF DETROIT DEPARTMENT OF PUBLIC WORKS BUREAU OF DESIGN		1975	
DATE 7-16-59	DRWG NO. C-4399	SCALE 3/4" = 1'-0"	BOOK NO. DETAIL STANDARD NO 22	DATE 8-19-66	DRWG NO. C-4388	SCALE 1/4" = 1'-0"	BOOK NO. DETAIL STANDARD NO 11	DATE 7-16-59	DRWG NO. C-4399

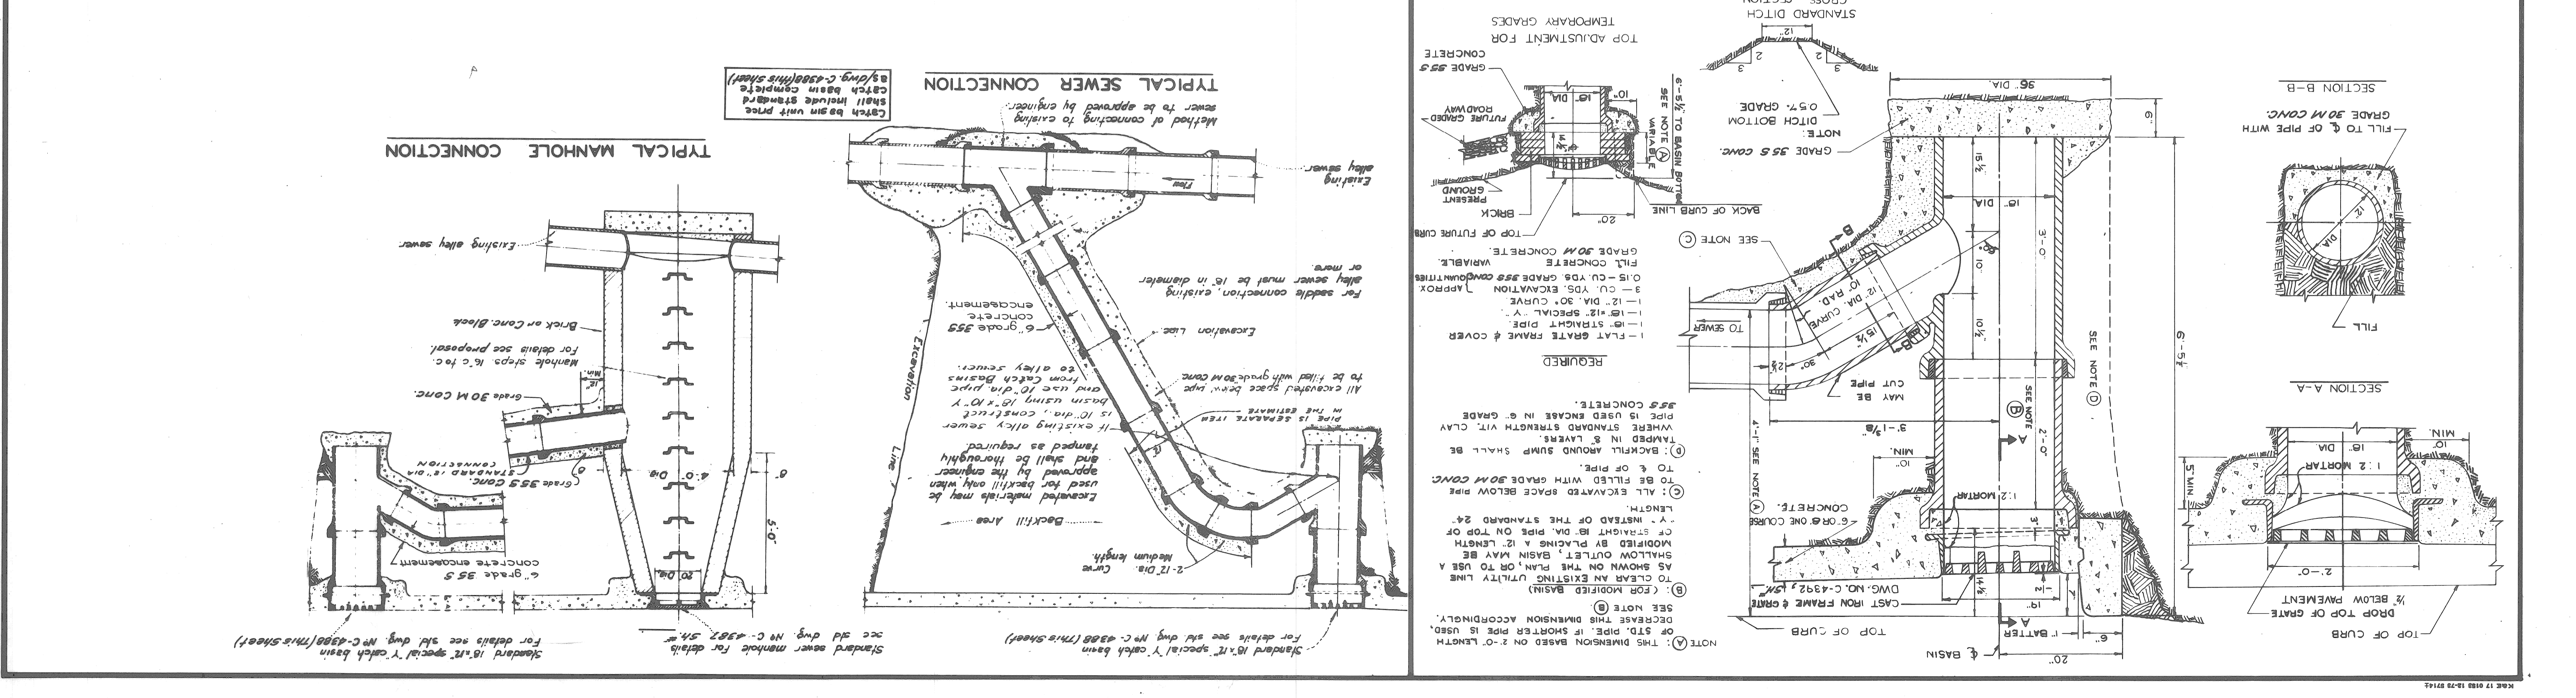

SHEET 10 A OF 21		IV-84E		4-22-88	6-6-88	BY: <i>[Signature]</i>		ENGINEER OF TRAFFIC AND SAFETY	CHECKED BY: C.L.
TRENCH DETAILS 8, 9, 10, 11, 12 & 13 TO APPLY ON CITY OF DETROIT UTILITIES		MICHIGAN DEPARTMENT OF TRANSPORTATION BUREAU OF HIGHWAYS STANDARD PLAN FOR UTILITY TRENCHES		4-22-88	6-6-88	DEPT. DIRECTOR - HIGHWAYS		ENGINEER OF TRAFFIC AND SAFETY	1 OF 3
PREPARED BY: <i>[Signature]</i>		DESIGN DIVISION		ENGINEER OF MATERIALS & TECHNOLOGY		ENGINEER OF TRAFFIC AND SAFETY		2 OF 3	IV-84E
ENGINEER OF DESIGN		ENGINEER - ROAD DESIGN		ENGINEER OF MAINTENANCE		ENGINEER OF TRAFFIC AND SAFETY		3 OF 3	IV-84E

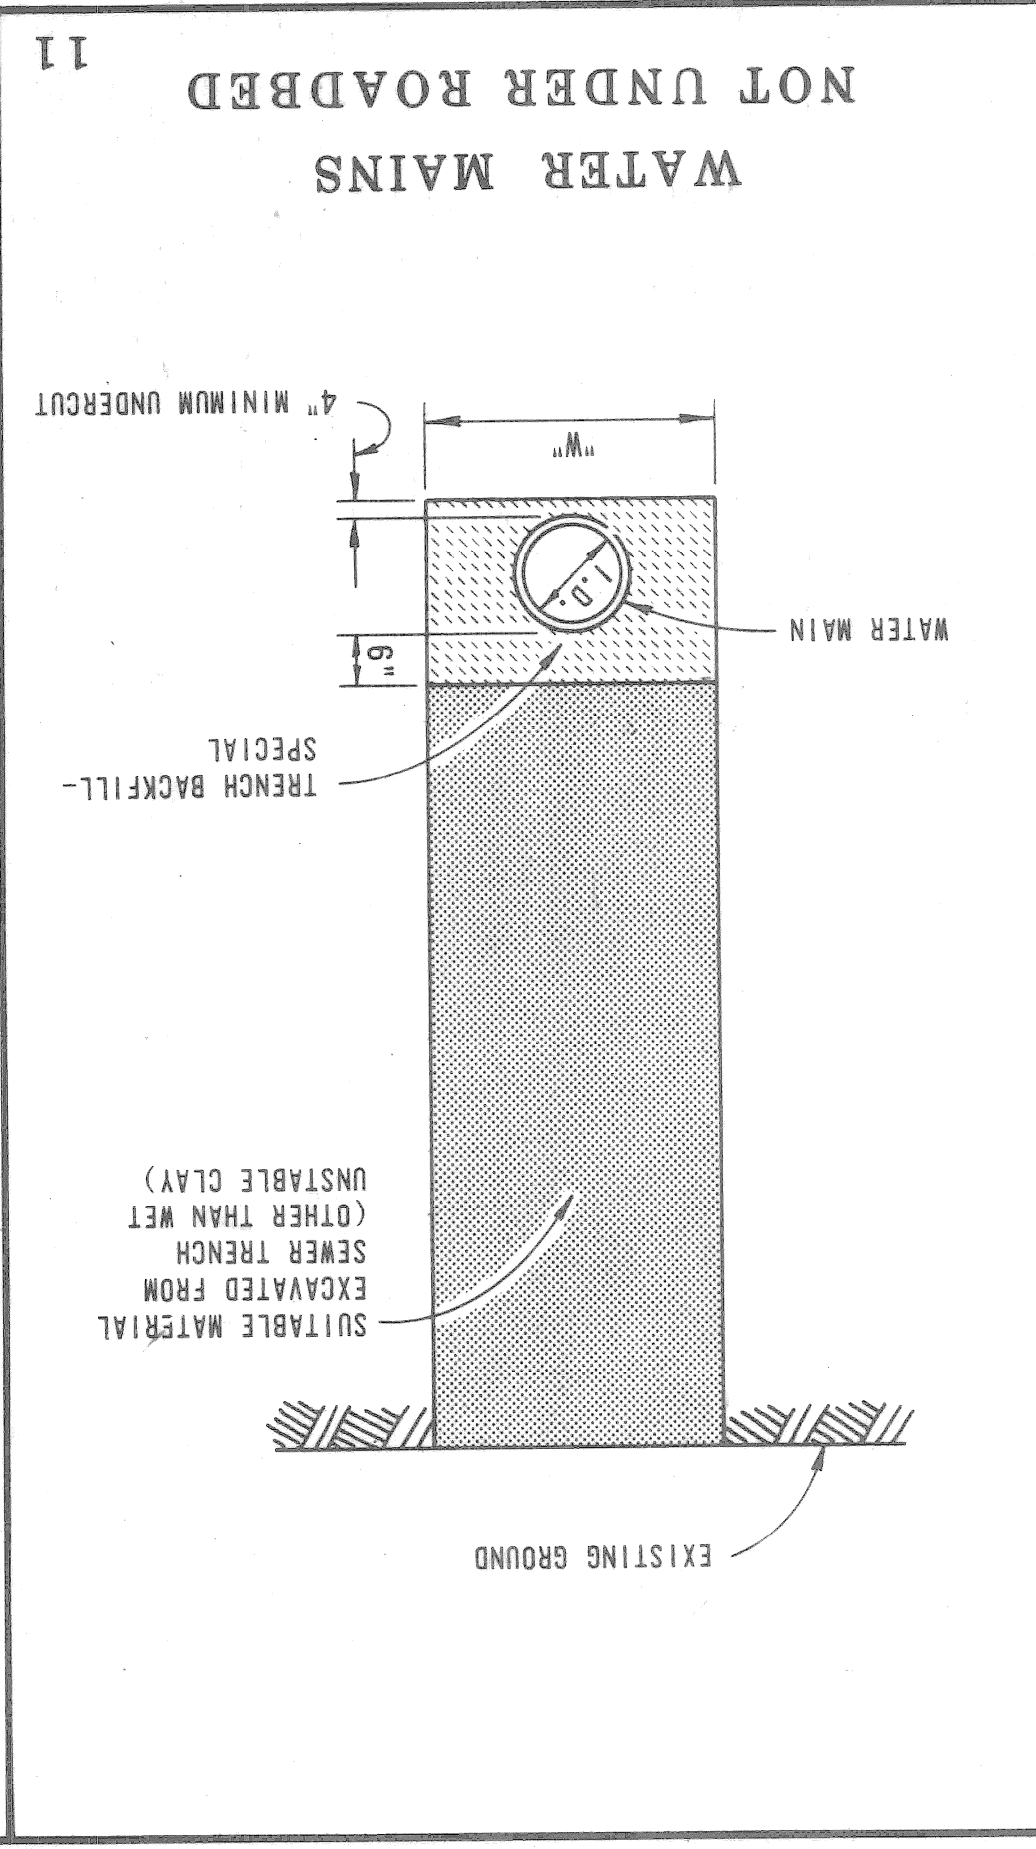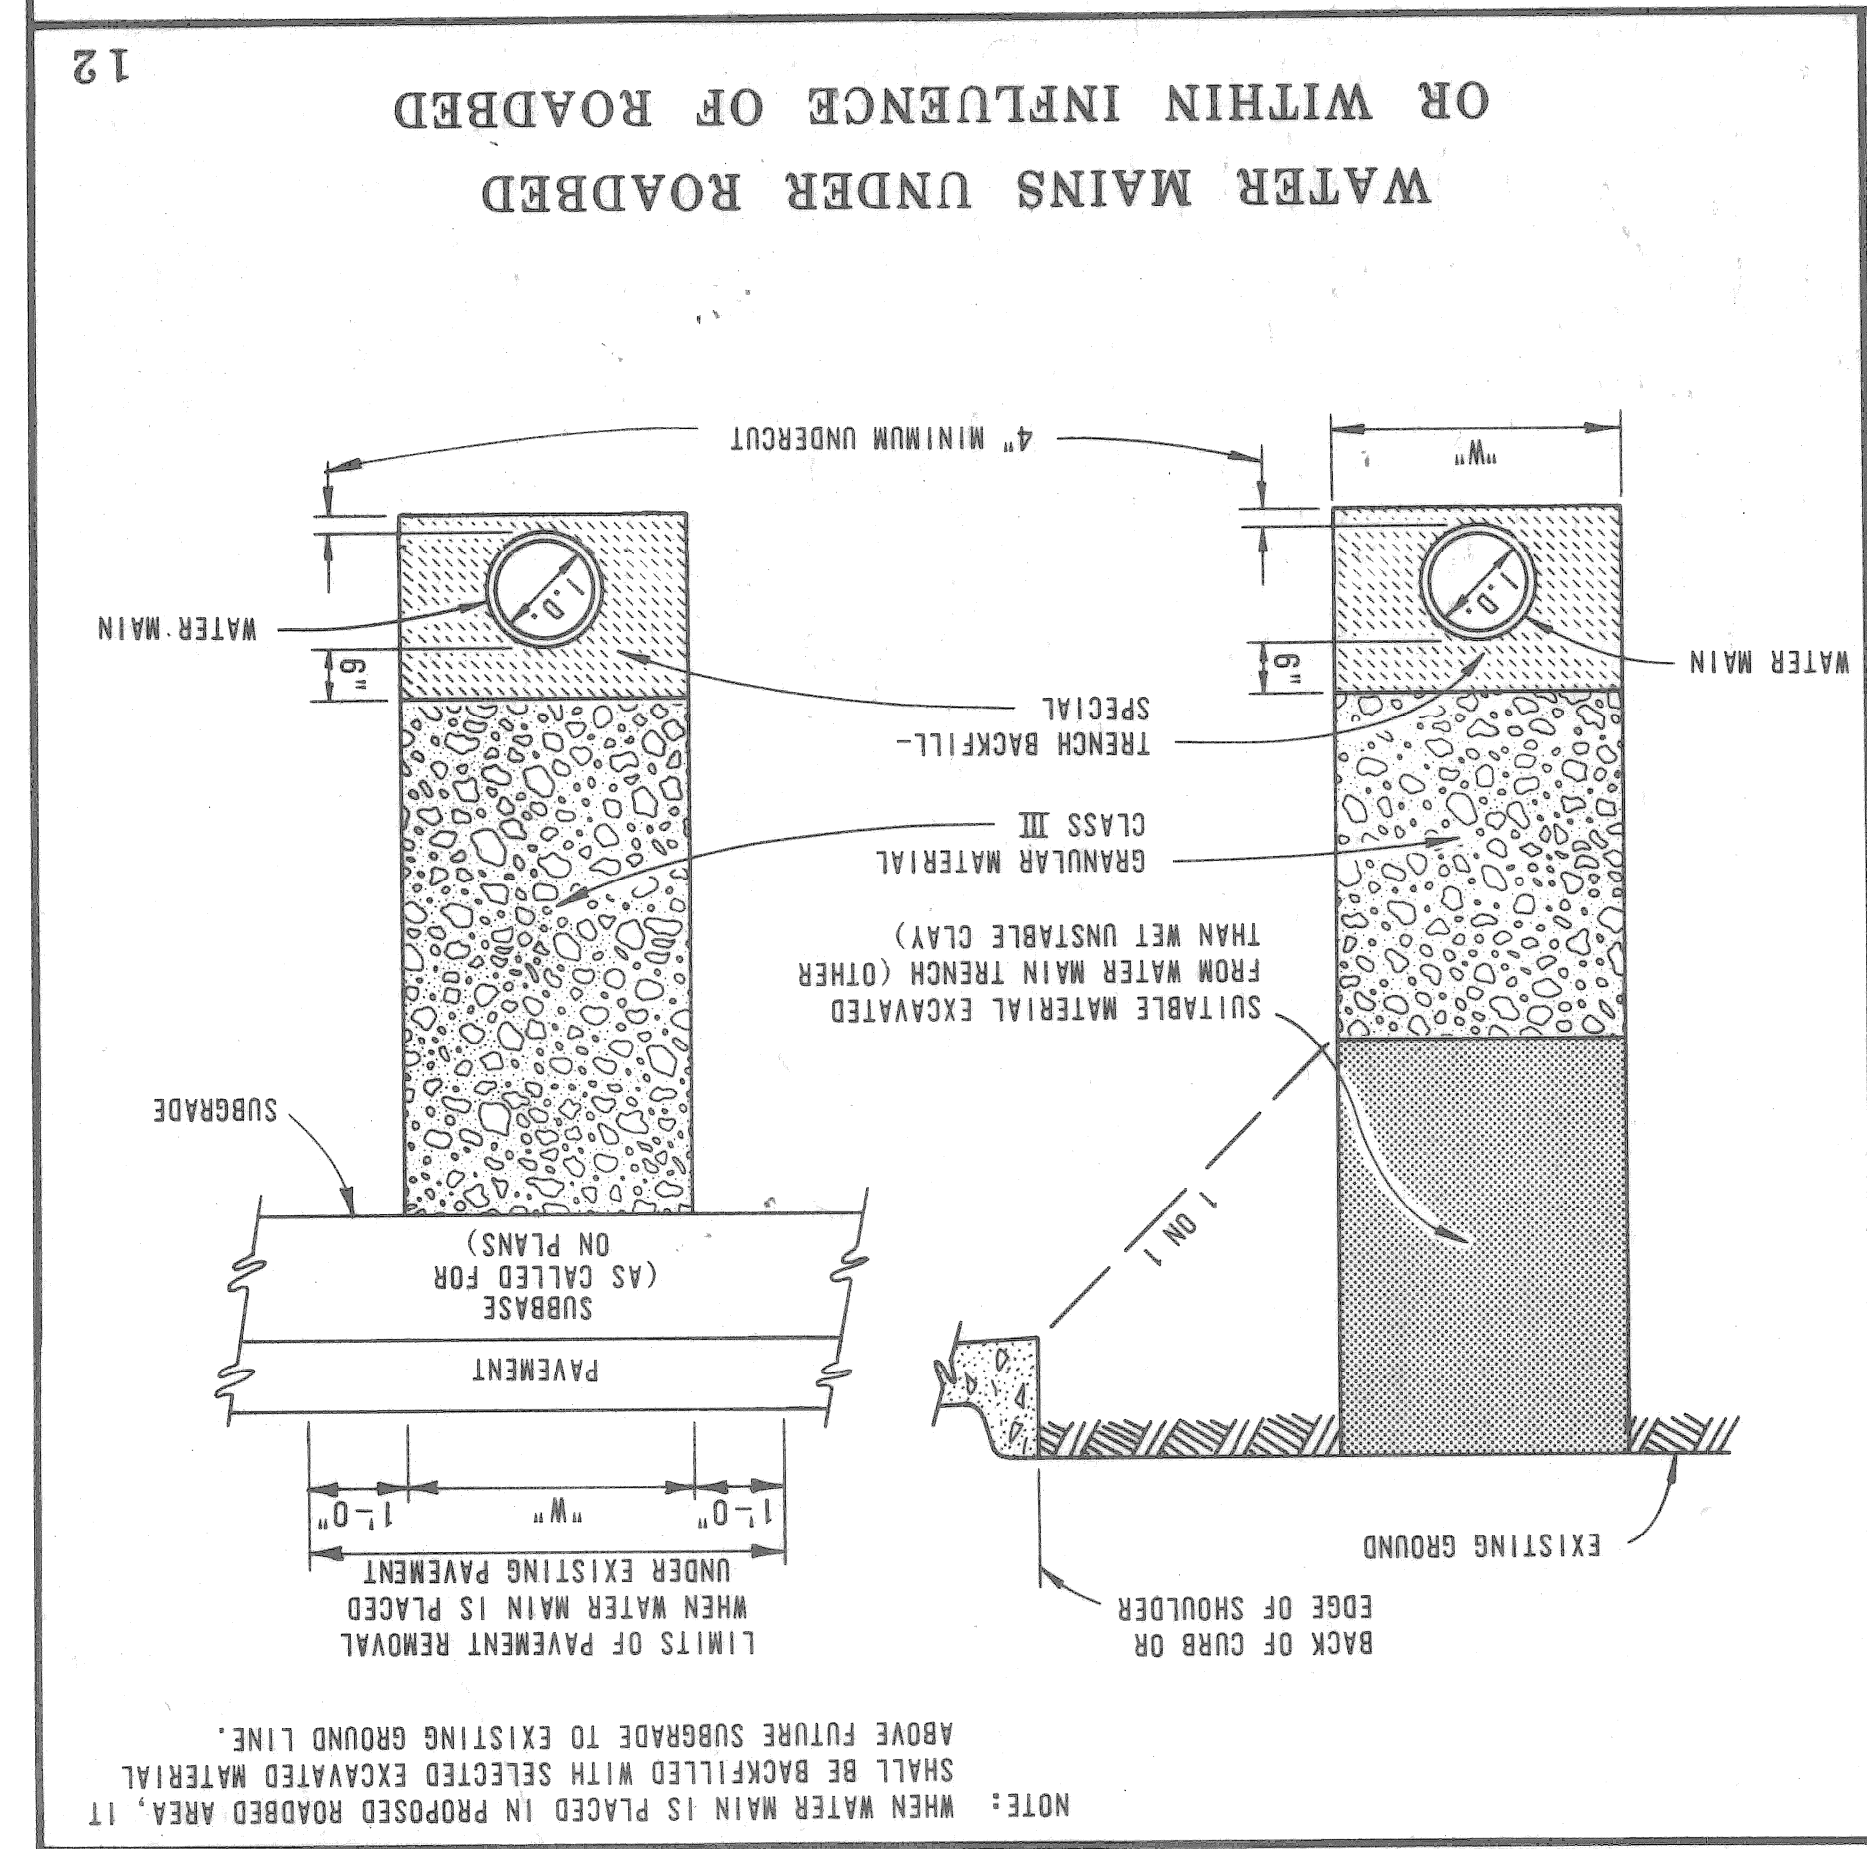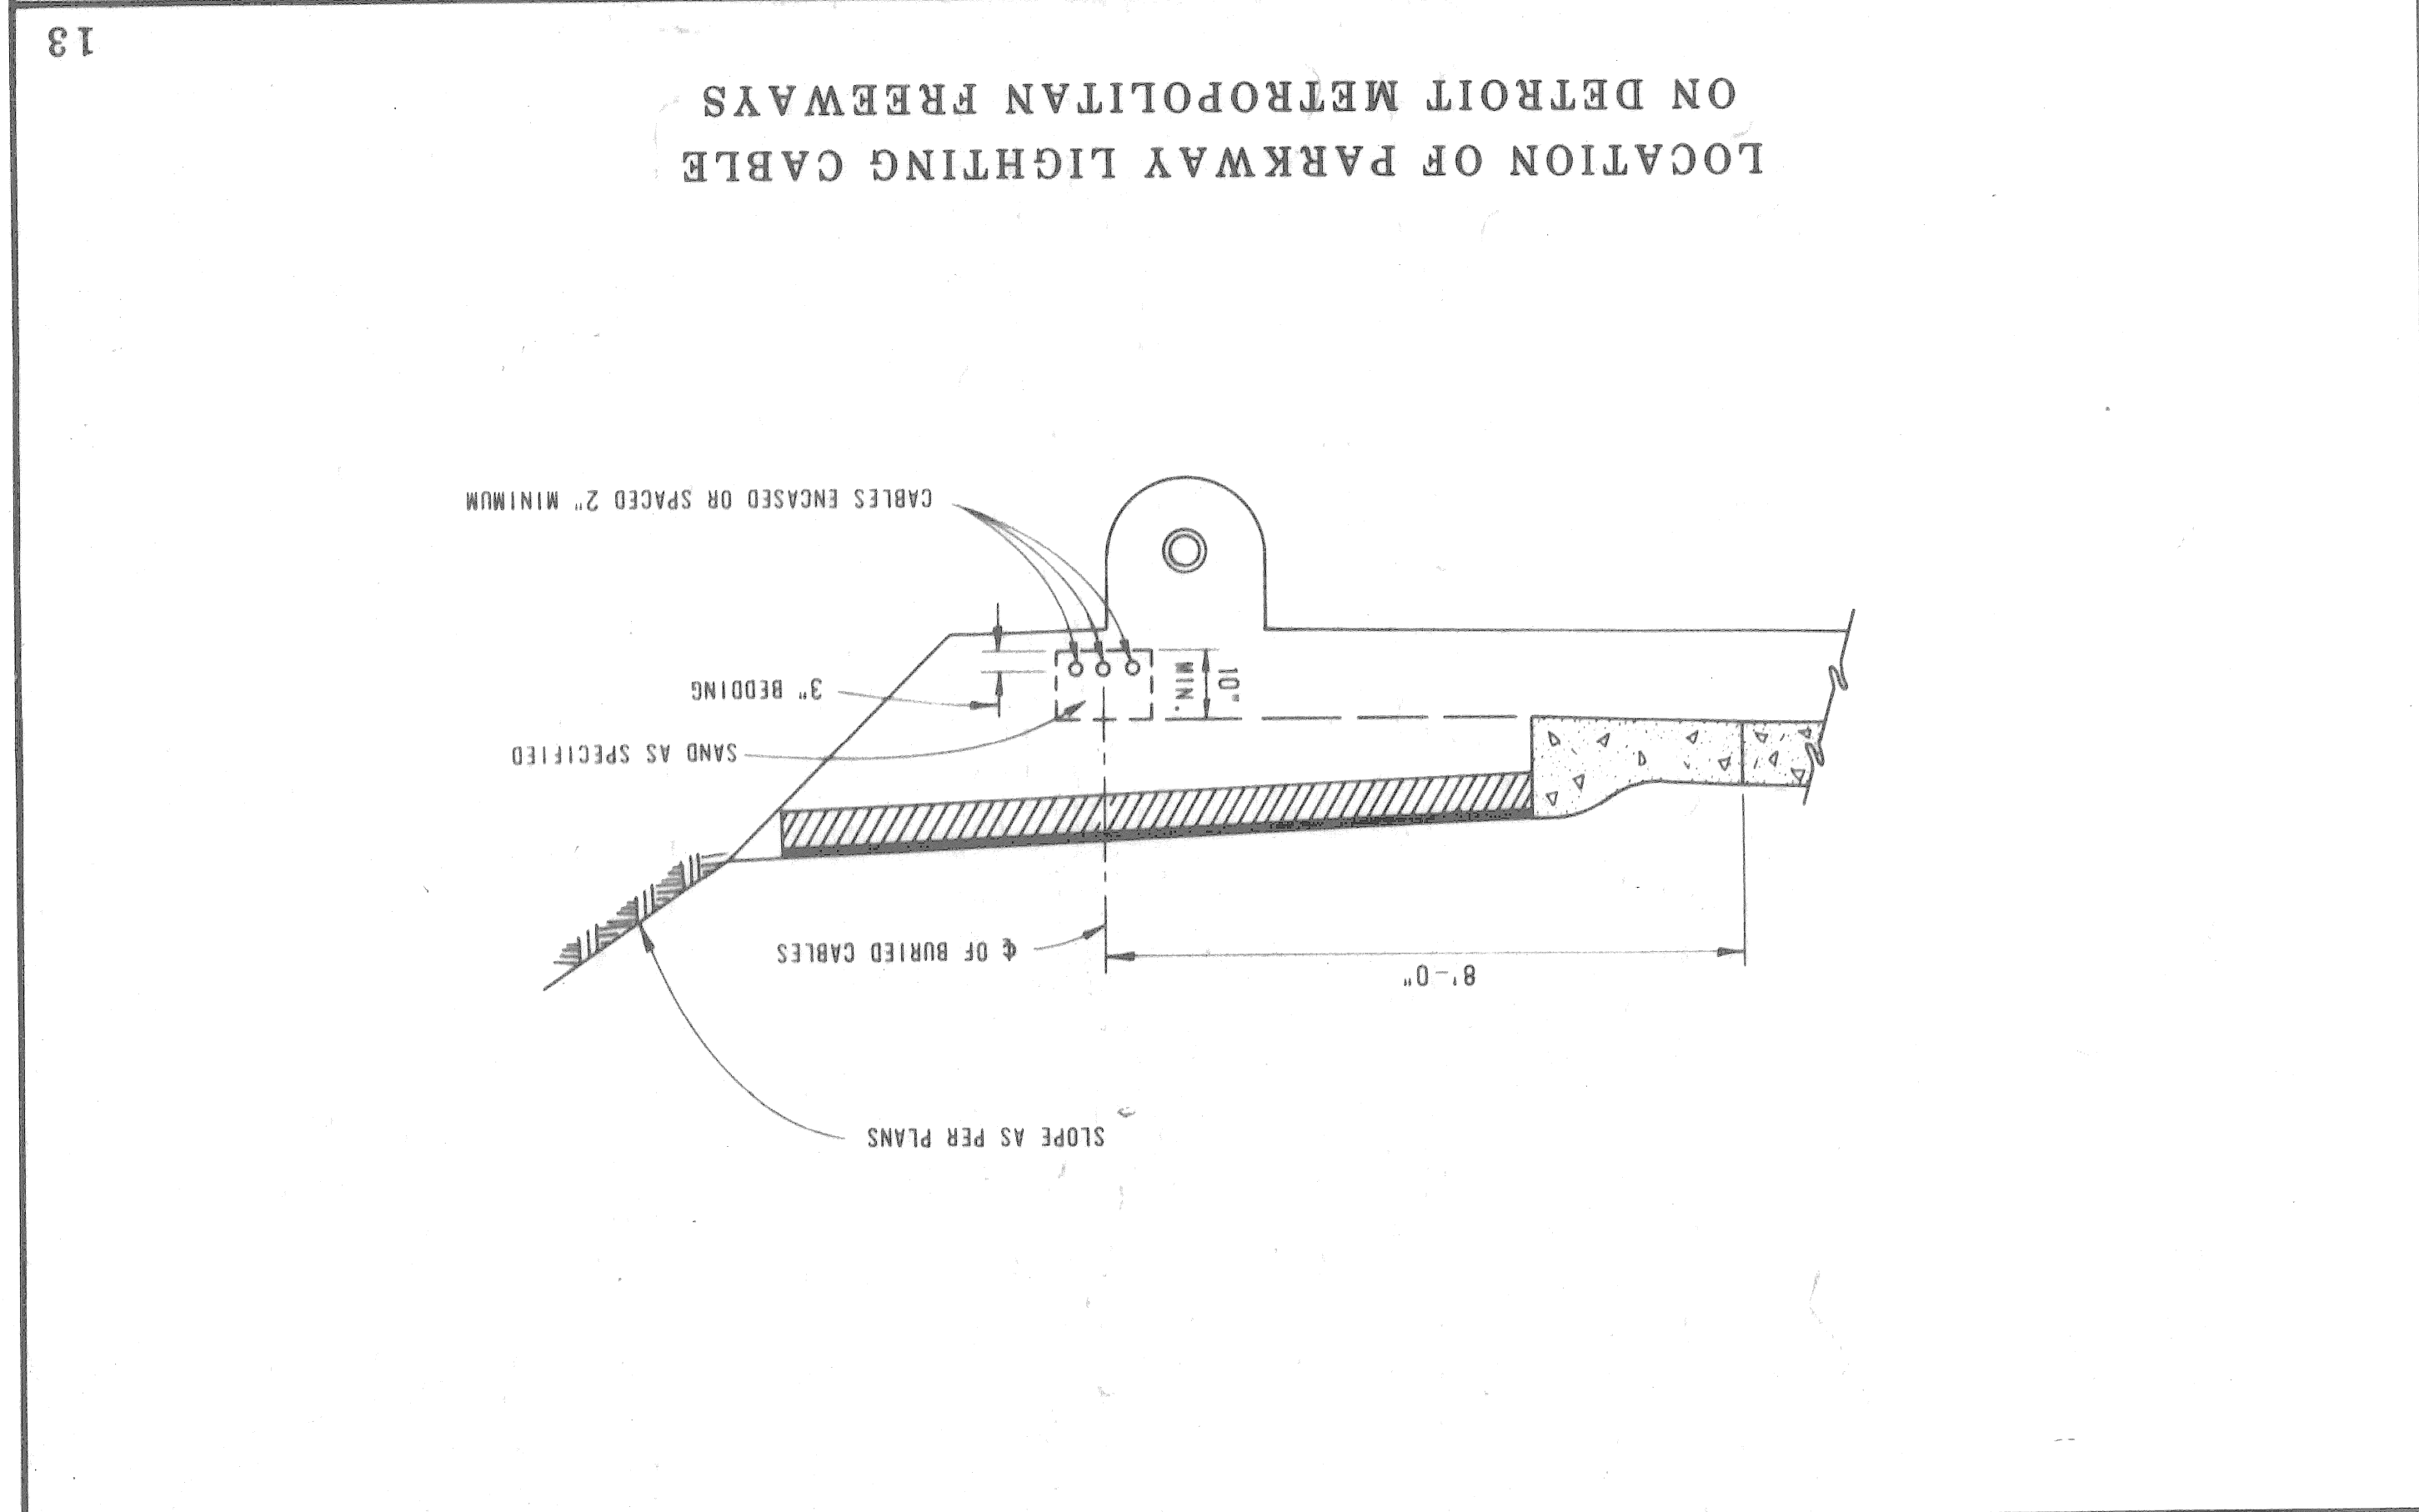

SHEET 1 OF 3		IV-84E		4-22-88	6-6-88	BY: <i>[Signature]</i>		ENGINEER OF TRAFFIC AND SAFETY	CHECKED BY: C.L.
TRENCH DETAILS 8, 9, 10, 11, 12 & 13 TO APPLY ON CITY OF DETROIT UTILITIES		MICHIGAN DEPARTMENT OF TRANSPORTATION BUREAU OF HIGHWAYS STANDARD PLAN FOR UTILITY TRENCHES		4-22-88	6-6-88	DEPT. DIRECTOR - HIGHWAYS		ENGINEER OF TRAFFIC AND SAFETY	1 OF 3
PREPARED BY: <i>[Signature]</i>		DESIGN DIVISION		ENGINEER OF MATERIALS & TECHNOLOGY		ENGINEER OF TRAFFIC AND SAFETY		2 OF 3	IV-84E
ENGINEER OF DESIGN		ENGINEER - ROAD DESIGN		ENGINEER OF MAINTENANCE		ENGINEER OF TRAFFIC AND SAFETY		3 OF 3	IV-84E

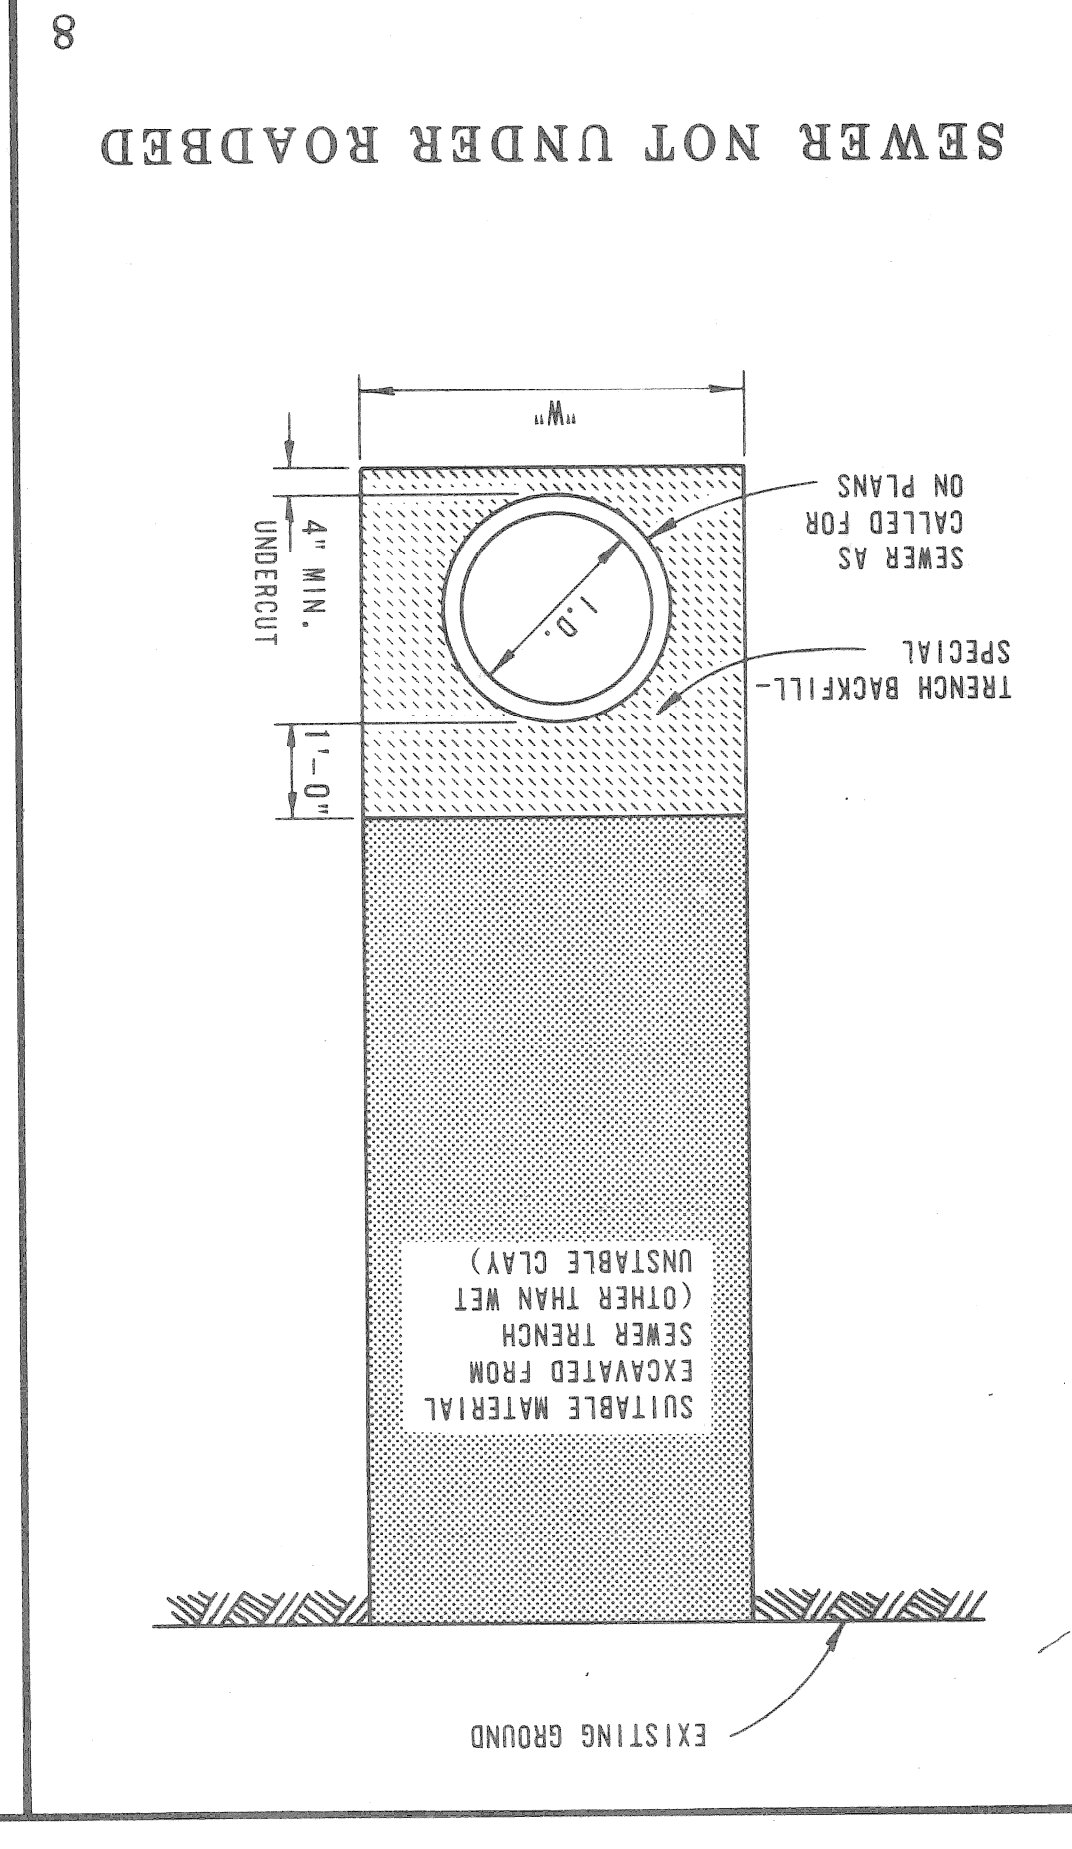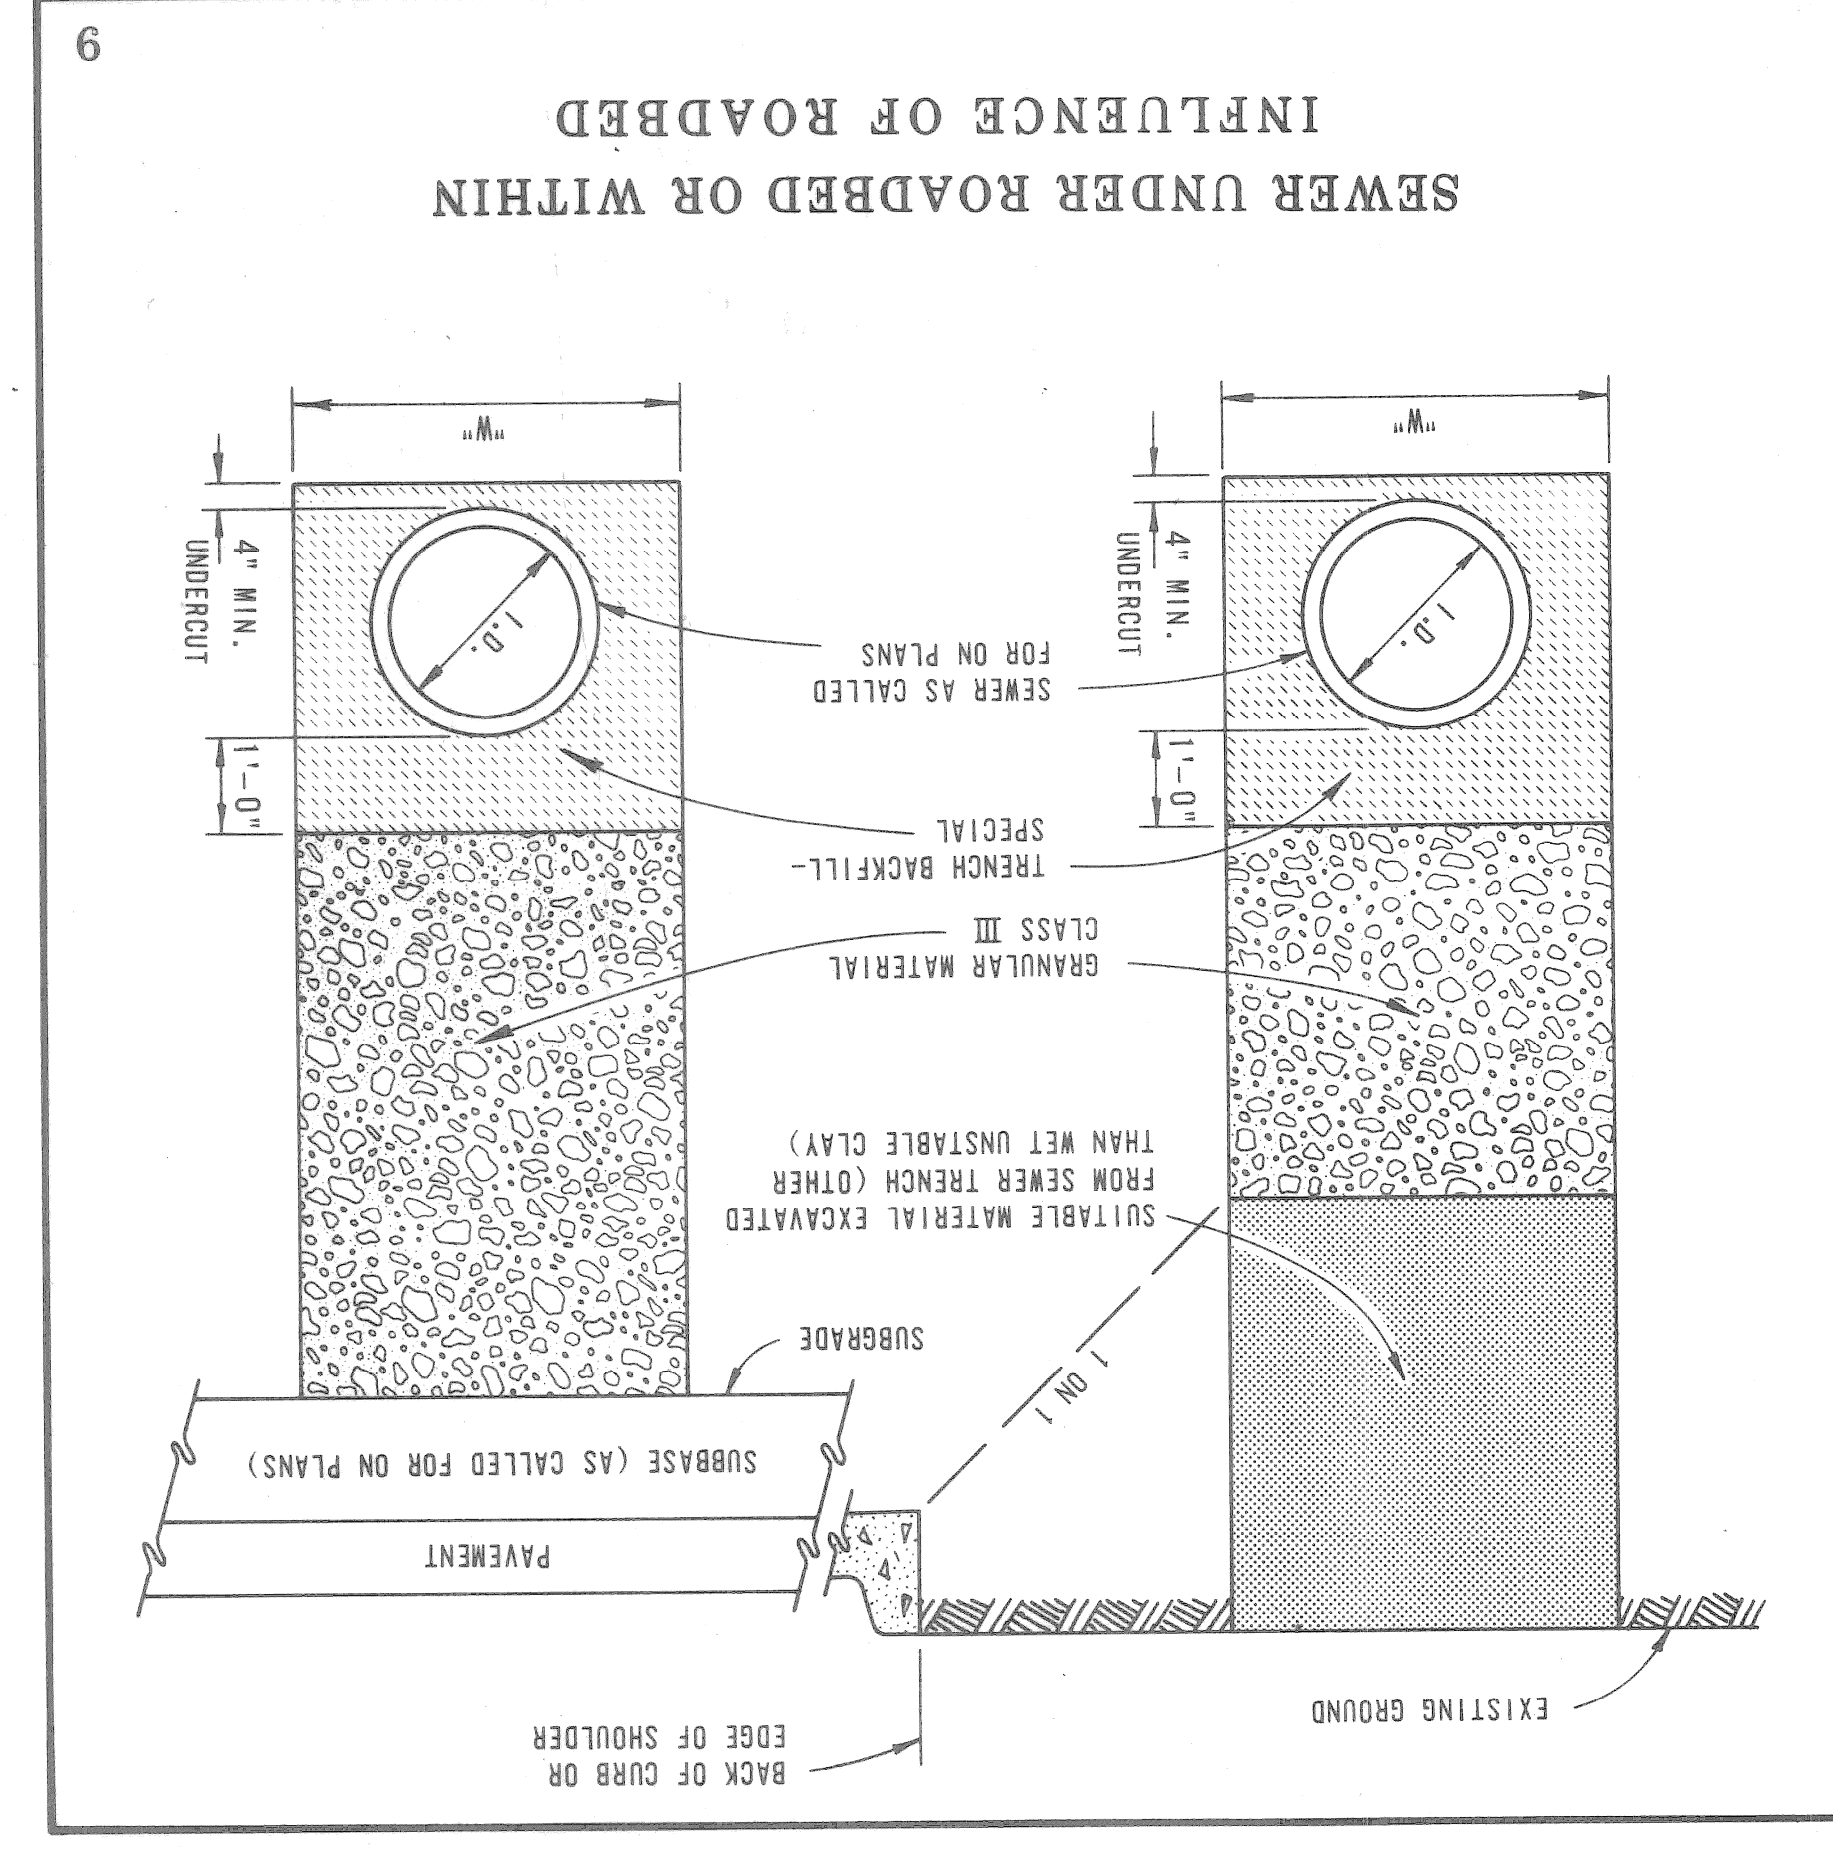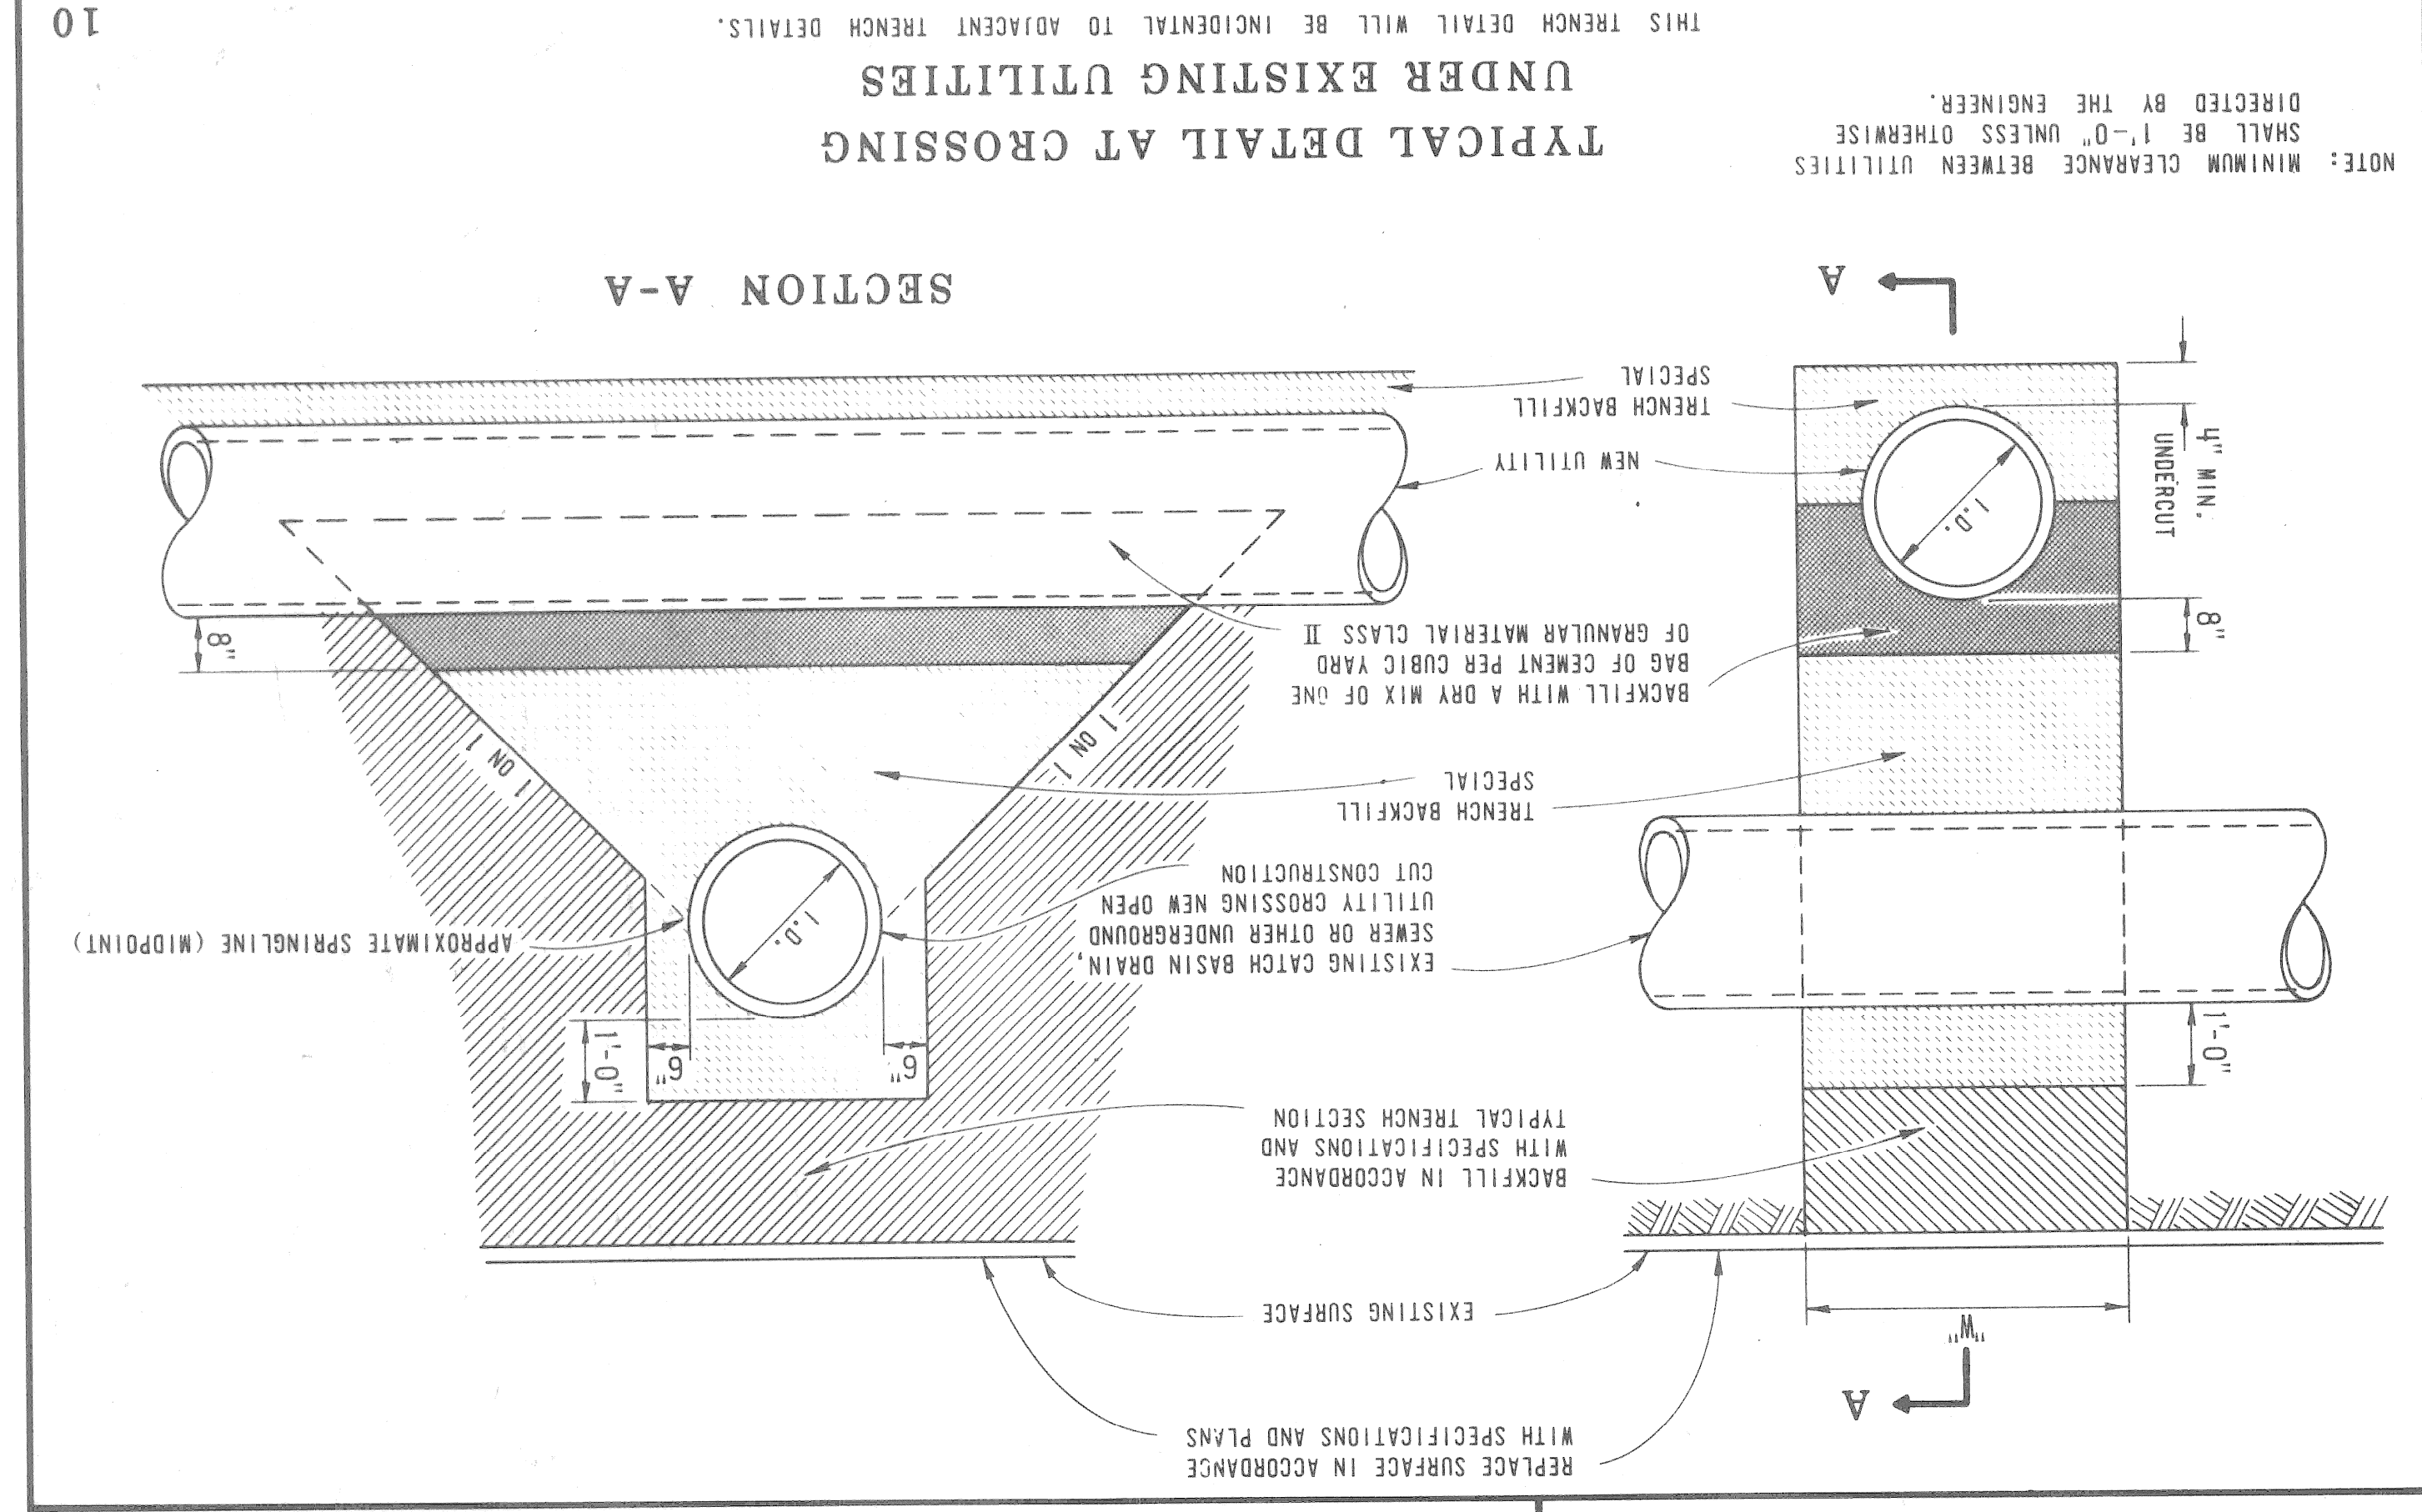

ENGINEER - BRIDGE DESIGN
 ENGINEER - ROAD DESIGN
 ENGINEER OF MAINTENANCE
 ENGINEER OF MATERIALS & TECHNOLOGY
 ENGINEER OF TRAFFIC AND SAFETY
 DEPT. DIRECTOR - HIGHWAYS
 DEPARTMENT DIRECTOR
 JAMES P. PIZZ
 6-6-88
 F.H.W.A. APPROVAL
 4-22-88
 PLAN DATE
 IV-84E
 SHEET 3 OF 3

CHECKED BY: C.L.L.
 DRAWN BY: J.L.R.
 PREPARED BY
 DESIGN DIVISION
 MICHIGAN DEPARTMENT OF TRANSPORTATION

MICHIGAN DEPARTMENT OF TRANSPORTATION
 BUREAU OF HIGHWAYS STANDARD PLAN FOR
 UTILITY TRENCHES
 ON CITY OF DETROIT UTILITIES
 TRENCH DETAILS 8, 9, 10, 11, 12 & 13 TO APPLY

ESTIMATED PAVEMENT REMOVAL WIDTH IS TO BE TRENCH WIDTH "W" PLUS
 1' EACH SIDE OF THE TRENCH (6' MINIMUM).

I.D. PIPE SIZE (INCHES)	TRENCH WIDTH (FEET)	I.D. PIPE SIZE (INCHES)	TRENCH WIDTH (FEET)
60	9.5	18	3.0
54	8.0	21	3.5
48	7.0	24	4.0
42	6.0	30	5.0
36	5.0	36	6.0
30	4.0	42	7.0
24	3.0	48	8.0
LESS THAN	3.0	54	9.5
10.5	11.0	60	10.0
11.0	11.5	72	11.0
12.0	12.0	78	11.5
13.0	12.5	84	12.0
13.5	13.0	90	12.5
14.0	13.5	96	13.0
	14.0	102	13.5
		108	14.0

NOTES:
 BEDDING UNDER THE UTILITY SHALL BE AS SHOWN OR THE TRENCH MAY
 BE UNDERCUT BELOW THE UTILITY AND THE UNDERCUT MATERIAL REPLACED WITH
 TRENCH BACKFILL - SPECIAL. BACKFILLING SHALL BE IN ACCORDANCE WITH THE
 CURRENT STANDARD SPECIFICATIONS.
 BACKFILL FOR UTILITY TRENCHES ABOVE TRENCH BACKFILL - SPECIAL SHALL
 BE AS FOLLOWS:
 (A) GRANULAR MATERIAL CLASS III SHALL BE USED TO BACKFILL
 UTILITY TRENCHES UNDER ROADBED.
 (B) GRANULAR MATERIAL CLASS III SHALL BE USED TO BACKFILL
 UTILITY TRENCHES OUTSIDE THE ROADBED BUT WITHIN THE 1 ON 1
 ZONE OF INFLUENCE SHOWN. IT WILL ALSO BE USED AS BACKFILL
 UNDER SIDEWALKS, SURFACED AREAS, AND MISCELLANEOUS STRUCTURES.
 (C) MATERIAL EXCAVATED FROM THE UTILITY TRENCHES SHALL BE USED
 TO BACKFILL UTILITY TRENCHES OUTSIDE THE LIMITS OF THE
 1 ON 1 ZONE OF INFLUENCE AND SHALL BE COMPACTED TO NOT
 LESS THAN 90% OF MAXIMUM UNIT WEIGHT.
 GRANULAR MATERIAL CLASS I OR II MAY BE USED WHERE GRANULAR
 MATERIAL CLASS III IS CALLED FOR ON PLANS.
 SUFFICIENT TRENCH WIDTH SHALL BE PROVIDED TO ALLOW FREE WORKING
 SPACE AND TO PERMIT COMPACTING THE BACKFILL AROUND THE PIPE.
 THE FOLLOWING TRENCH WIDTHS ARE TO BE USED AS A GUIDE ONLY:

WATER MAINS IN REINFORCED
 CONCRETE ENCASMENT


NOTE: REINFORCEMENT SHALL BE ACCORDING
 TO DETAILS SHOWN ON PLANS.

EXISTING GROUND OR
 BOTTOM OF SUBBASE
 BACKFILL REQUIREMENTS ARE
 SIMILAR TO REGULAR WATER
 MAIN TRENCH SECTIONS
 REINFORCED
 CONCRETE
 ENCASMENT
 WATER MAIN
 UNDISTURBED EARTH

PIPE SIZE	ENCASMENT SIZE	TRENCH WIDTH
6" THRU 12"	3'-0"	3'-0"
16"	3'-6"	3'-6"
24"	4'-6"	4'-6"
30"	5'-0"	5'-0"
36"	5'-6"	5'-6"
42"	6'-0"	6'-0"
48"	7'-0"	7'-0"
54"	7'-6"	7'-6"
60"	8'-0"	8'-0"
66"	8'-6"	8'-6"
72"	9'-0"	9'-0"

REQUIRED ENCASMENT SIZE FOR
 RESPECTIVE PIPE SIZES

SHEET 108 OF 21

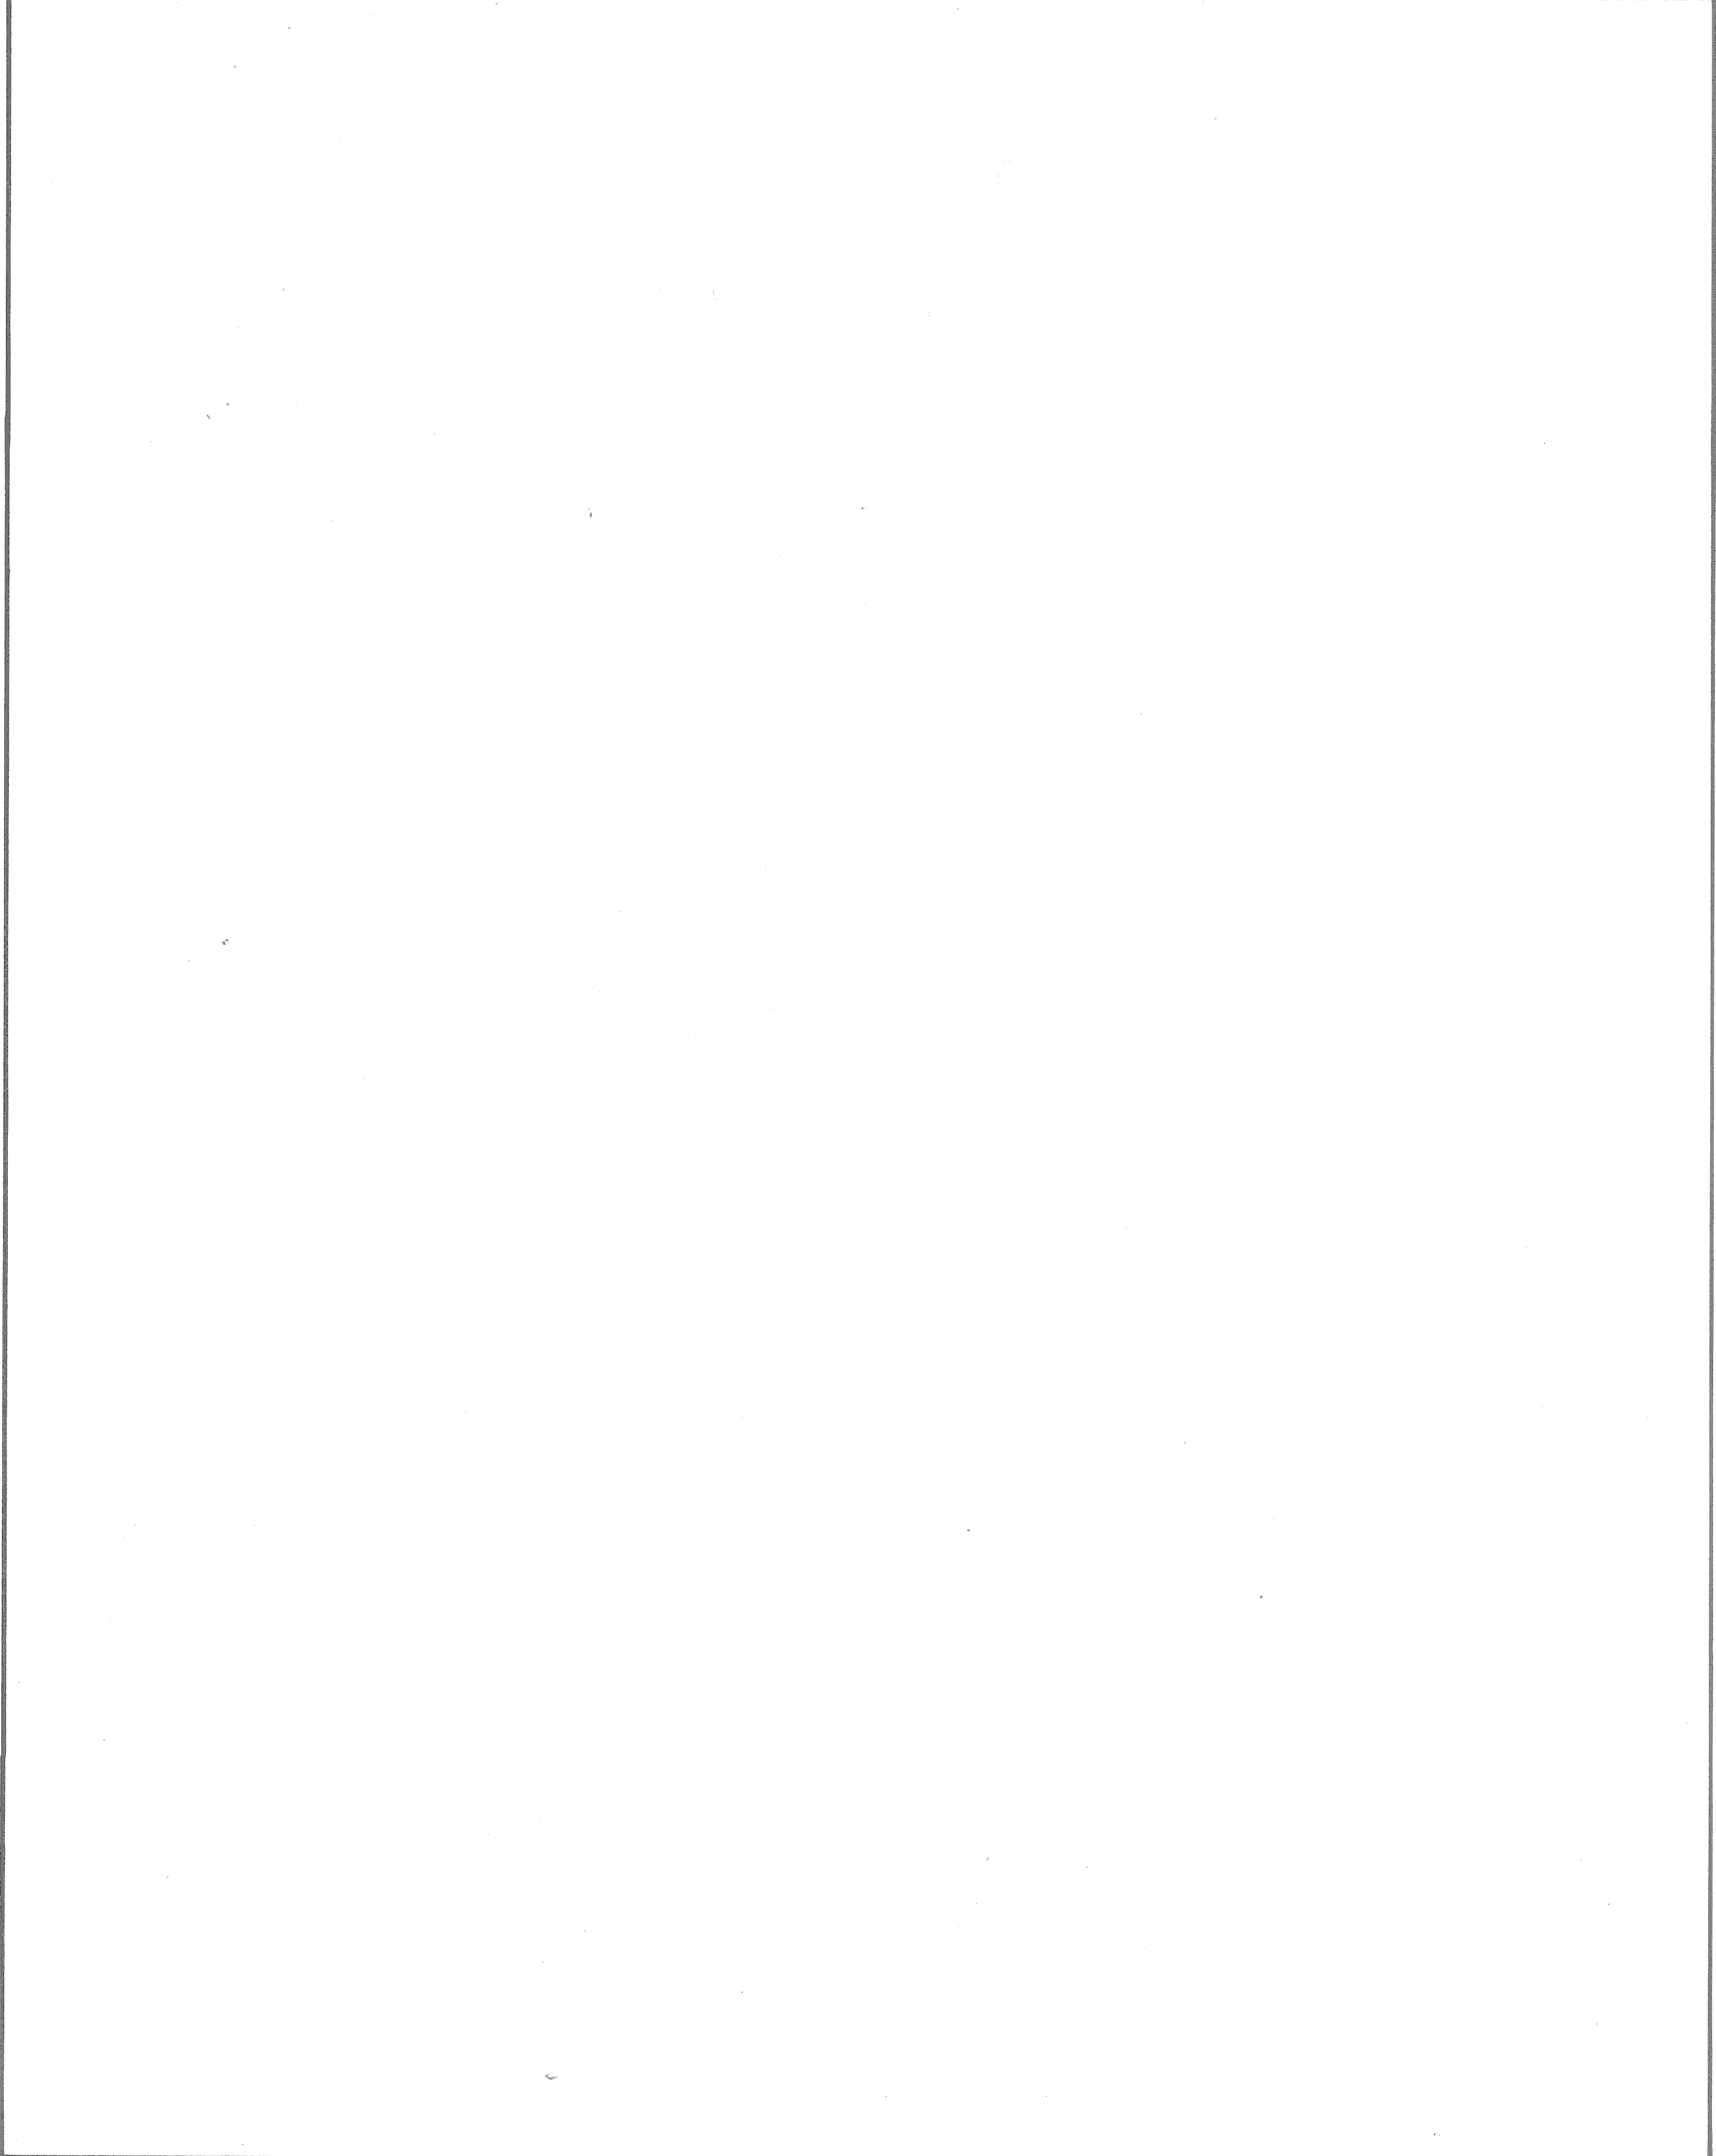

QUANTITY SHEET - E

AS CONSTRUCTED

SHEET NOS.	UNITS	TOTALS	TOTALS	TOTALS	UNITS
AS	PER	PLANS	REMOVING PAVEMENT	4,812	Sq. Yd.
			REMOVING CURB	1,162	Sq. Yd.
			REMOVING SIDEWALK	1,75	Lm. Ft.
AS	PER	PLANS	REMOVING PAV'T. (Repair)	10	Sq. Yd.
			REMOVING PAV'T. (Repair)	10	Sq. Yd.
			CONC. PAV'T. (Repair, 10" Nonreinforced)	10	Sq. Yd.
AS	PER	PLANS	REMOVING DRAINAGE STRUCTURES	7	Each
			ABANDONING DRAINAGE STRUCTURES	2,554	Cu. Yd.
			EARTH EXCAVATION	2,554	Cu. Yd.
AS	PER	PLANS	EMBANKMENT (C.I.P.) GRANULAR MAT'L, CL. II	250	Cu. Yd.
			SUBGRADE UNDERCUTTING TYPE II	100	Cu. Yd.
			REMOVING MASONRY AND CONCRETE STRUCTURES	6,955	Sq. Yd.
AS	PER	PLANS	AGGREGATE BASE UNDER CONCRETE (4" in Place)	58	Sq. Yd.
			REMOVE BITUMINOUS SURFACE	8	Ton
			BITUMINOUS APPROACHES	6,708	Sq. Yd.
AS	PER	PLANS	CONCRETE PAVEMENT - Reinforced - 9" w/Integral Curb	350	Sq. Yd.
			CONCRETE PAV'T. - Nonreinforced 8"	739	Lm. Ft.
			SEWER TAP - 12"	4	Each
AS	PER	PLANS	CATCH BASIN "A"	4	Each
			CATCH BASIN "B" ("B" WITH TRAP)	4	Each
			RECONSTRUCTING STRUCTURES	1	Each
AS	PER	PLANS	ADJUSTING WATER SHUT-OFF	5	Each
			ADJUSTING COVERS	5	Each
			CLEANING DRAINAGE STRUCTURES (Non Federal)	10	Each
AS	PER	PLANS	SEWER CLEANOUT (Non Federal)	100	Lm. Ft.
			RECONSTRUCT GATE WELL	2	Each
			CONCRETE CURB DETAIL "CD"	100	Lm. Ft.
AS	PER	PLANS	CONCRETE ISLAND, 7'	40	Sq. Yd.
			CONCRETE SIDEWALK, 4'	13,462	Sq. Ft.
			CONCRETE SIDEWALK, 6'	2,648	Sq. Ft.
AS	PER	PLANS	FIELD OFFICE	3	Months
			SIDEWALK RAMP	100	Each
			BARRICADE, TYPE III, LIGHTED, UNFINISHED	65	Each
AS	PER	PLANS	BARRICADE, TYPE III, LIGHTED, OPERATED	65	Each
			BARRICADE, TYPE III, LIGHTED, FINISHED	9	Each
			BARRICADE, TYPE III, LIGHTED, OPERATED	6	Each
AS	PER	PLANS	SIGN TYPE "B" TEMPORARY	160	Sq. Ft.
			LIGHTED ARROW, TYPE A, FINISHED	1	Each
			LIGHTED ARROW, TYPE A, OPERATED	1	Each
AS	PER	PLANS	CLASS A SODDING	2,177	Sq. Yd.
			TOPSOIL SURFACE - 3"	2,177	Sq. Yd.
			WATER	5	Units
AS	PER	PLANS	FIRE HYDRANT	1	Each
			REMOVE HYDRANT - METHOD I	1	Each
			REMOVE HYDRANT - METHOD II	1	Each
AS	PER	PLANS	MOBILIZATION	1	Lump Sum
			MINOR TRAFFIC DEVICES	1	Lump Sum
			FLAG CONTROL	1	Lump Sum
AS	PER	PLANS	TEMPORARY PAVEMENT MARKING, TYPE R, 4", WHITE	100	Lm. Ft.
			TEMPORARY PAVEMENT MARKING, 4" WHITE	50	Lm. Ft.
			TEMPORARY PAVEMENT MARKING, 4" YELLOW	2,280	Lm. Ft.
AS	PER	PLANS	TEMPORARY PAVEMENT MARKING, 18" STOP BAR	68	Lm. Ft.
			THERMOPLASTIC PAVEMENT MARKINGS, 6" YELLOW	200	Lm. Ft.
			THERMOPLASTIC PAVEMENT MARKINGS, 6" YELLOW	200	Lm. Ft.

M.K. PLAN ESTIMATE BY _____ CHECKED BY _____ DATA COMPLETED _____ DATE _____
 PROJ. ENG. _____ HISTORY CHECKED _____ ENTERED ON PLANS BY _____ DATE _____
 RECONSTRUCTION OF RUSSELL FROM CANIFF TO WOODLAND SHEET _____ DATE: APRIL, 1992
 ASSIGNMENT NO. 91-60-01 AND MISCELLANEOUS CONSTRUCTION 12 OF 21