


SECTION 13
TODS FILE
CITY OF DETROIT



BAGLEY AVE

BAGLEY AVE

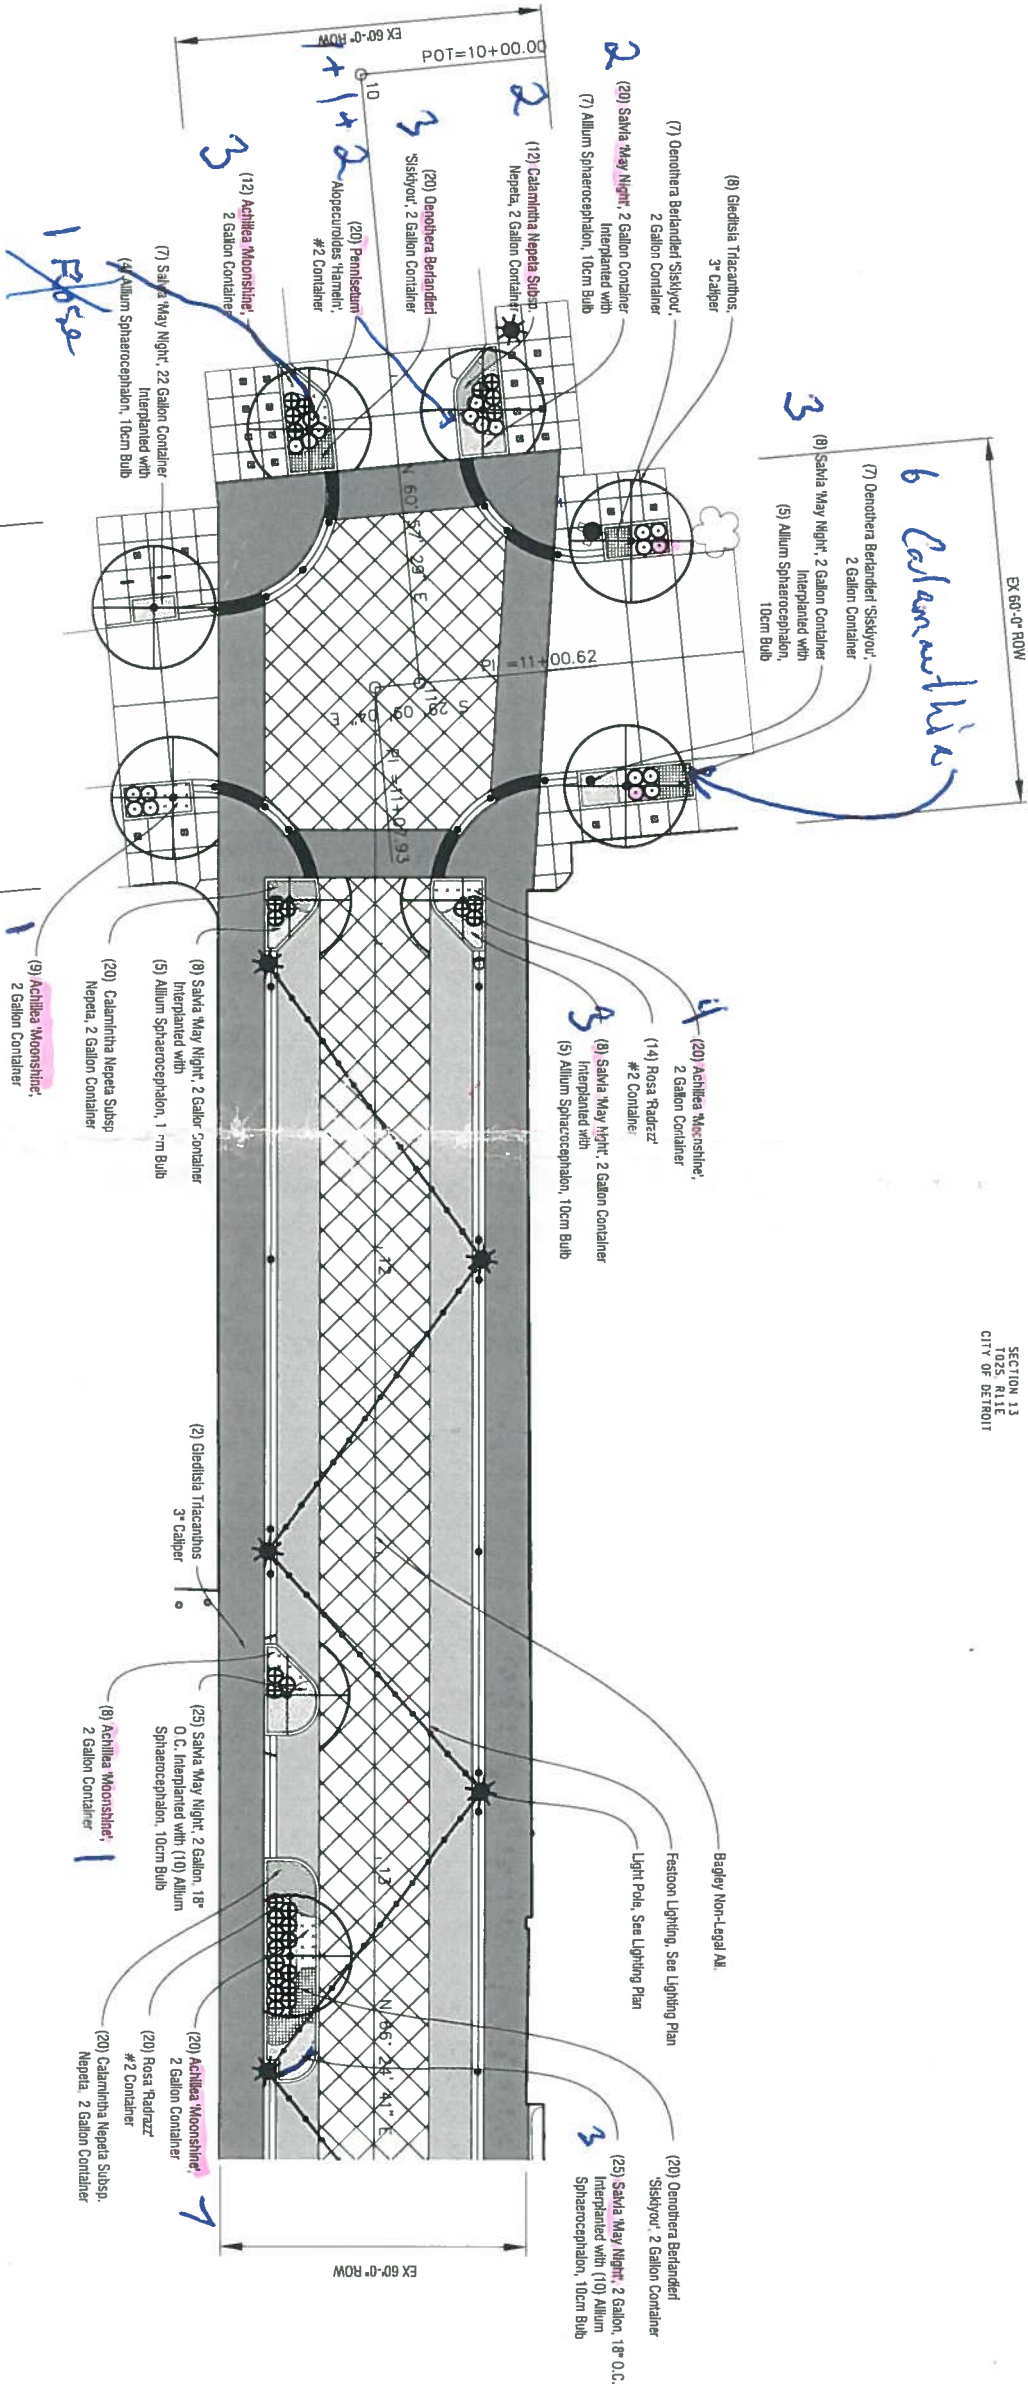


SPECIAL LEGEND THIS SHEET

- PARKING PAVEMENT ZONE
- PEDESTRIAN PAVEMENT ZONE
- MAINLINE PAVEMENT JOINT PATTERN
- SEWALK JOINT PATTERN
- SEWALK EXPANSION JOINT
- TACTILE WARNING PAVEMENT
- DETECTABLE WARNING PAVEMENT
- DECORATIVE TILE

QUANTITIES, THIS SHEET

KEY QTY.	UNIT	PAY ITEM	NOTES
101	Each	Salvia May Night, 2 Gallon Container	18" O.C.
46	Each	Allium Sphaerocephalon, 10cm Bulb	Interplanted in Salvia
54	Each	Oenothera Berlandieri Siskiyout, 2 Gallon Container	18" O.C.
52	Each	Calamittha Nepeta Subsp. Nepeta, 2 Gallon Container	18" O.C.
61	Each	Achillea Moonshine, 2 Gallon Container	18" O.C.
20	Each	Pennisetum Alopecuroides Hammett, #2 Container	
31	Each	Rosa Radrazz, #2 Container	
10	Each	Gleditsia Tricantus, 3" Caliper	Single, Straight Trunk

FINAL ROW PLAN REVISIONS			SUBMITTAL DATE			DESCRIPTION	livingLAB
NO	DATE	AUTH	NO	DATE	AUTH		

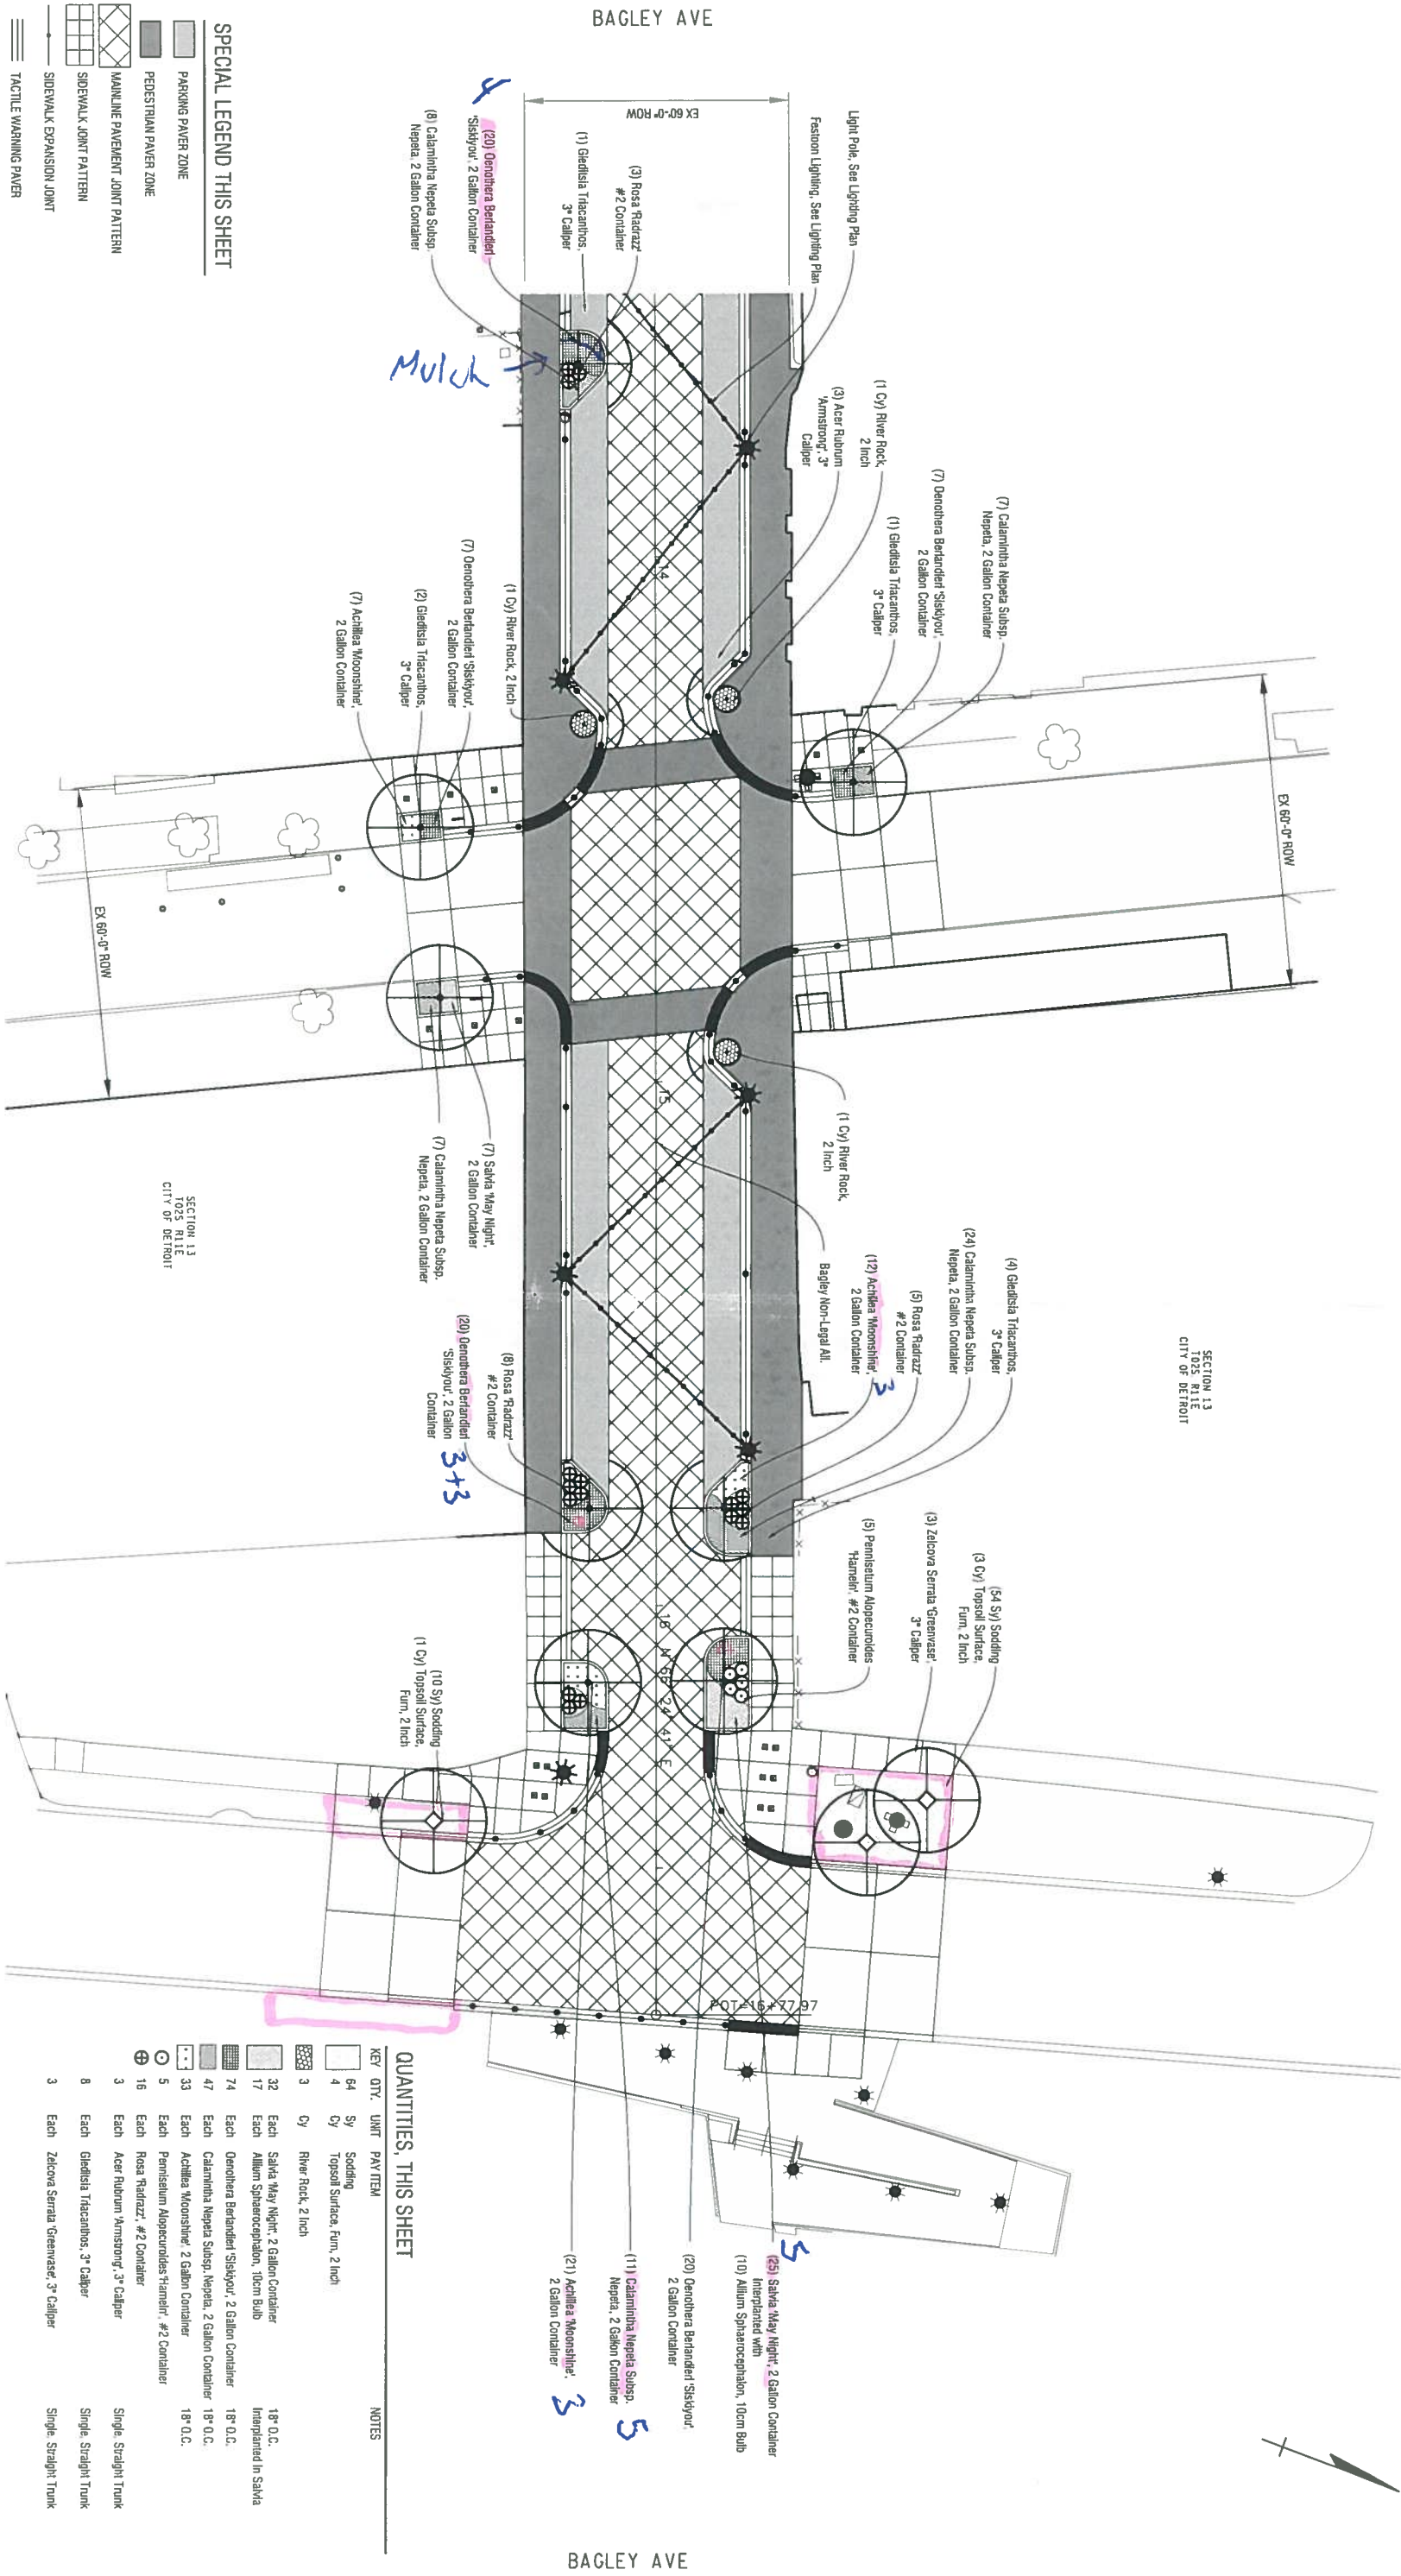

SPECIAL LEGEND THIS SHEET

- PARKING PAVEMENT ZONE
- PEDESTRIAN PAVEMENT ZONE
- MAINLINE PAVEMENT JOINT PATTERN
- SIDEWALK JOINT PATTERN
- SIDEWALK EXPANSION JOINT
- TACTILE WARNING PAVEMENT
- DETECTABLE WARNING PAVEMENT
- DECORATIVE TILE

QUANTITIES, THIS SHEET

KEY	QTY	UNIT	PAY ITEM	NOTES
64	SY		Sodding	
4	CY		Topsoil Surface, 10cm Bulb	
3	CY		River Rock, 2 inch	
32	Each		Salvia May Night, 2 Gallon Container	18" O.C.
17	Each		Allium Sphaerocephalon, 10cm Bulb	
74	Each		Oenothera Bielandii 'Siskiyou', 2 Gallon Container	18" O.C.
47	Each		Calaminka Nepeta Subsp. Nepeta, 2 Gallon Container	18" O.C.
33	Each		Acetilla Moonshine, 2 Gallon Container	18" O.C.
5	Each		Pennisetum Alopecuroides 'Hamlet', #2 Container	
16	Each		Rosa Radrazz, #2 Container	Single, Straight Trunk
3	Each		Acer Rubrum 'Armstrong', 3" Caliper	Single, Straight Trunk
8	Each		Gleditsia Tricantios, 3" Caliper	Single, Straight Trunk
3	Each		Zelkova Serata 'Greenwave', 3" Caliper	Single, Straight Trunk

NO.	DATE	AUTH.	DESCRIPTION
1	05/08/2019	JN:PW-7007	BAGLEY STREETSCAPE

livingLAB

Detroit



SECTION 13
1025 R11E
CITY OF DETROIT

DATE: 05/08/2019

JN:PW-7007
BAGLEY STREETSCAPE

LANDSCAPE SHEET
BAGLEY STREETSCAPE
STA 13+50 TO STA 16+77.97 (POE)

DRAWING
BAG LND5
002