



QUANTITIES, THIS SHEET


- | KEY | QTY | UNIT | PAY ITEM | NOTES |
|---|-----|------|--|-----------------------|
|  | 101 | Each | Sawa Hwy Mgmt, 2 Gallon Container | 18" O.C. |
|  | 46 | Each | Alum Sphearcocophan, 10cm Bulb | Interplanted in Sawa |
|  | 54 | Each | Qonetha Belandari, 2 Gallon Container | 18" O.C. |
|  | 52 | Each | Cadenrina Negera Subsp, Negera, 2 Gallon Container | 18" O.C. |
|  | 61 | Each | Archiba Moonshine, 2 Gallon Container | 18" O.C. |
|  | 20 | Each | Perintisaur Alapocundus Hamlet, #2 Container | |
|  | 31 | Each | Rosa Radzetz, #2 Container | |
|  | 10 | Each | Gaedusa Titarantus, 3" Caliper | Single Straight Trunk |

FINAL ROW PLAN REVISIONS		(SUBMITTAL DATE)		DESCRIPTION
NO	DATE	NO	DATE	
livingLAB  Detroit 0 30 HORZ. (FT)				
		DATE: 05/08/2019		
		JN-PW-7007		
		BAGLEY STREETSCAPE		
		LANDSCAPE SHEET		DRAWING
		BAGLEY STREETSCAPE		SHEET
		STA 10+40.31 (POB) TO STA 13+50		BAG LNS
				001
				37

23RD STREET

W FISHER SERVICE DRIVE

SECTION 12
-025, R11E
CITY OF DETROIT

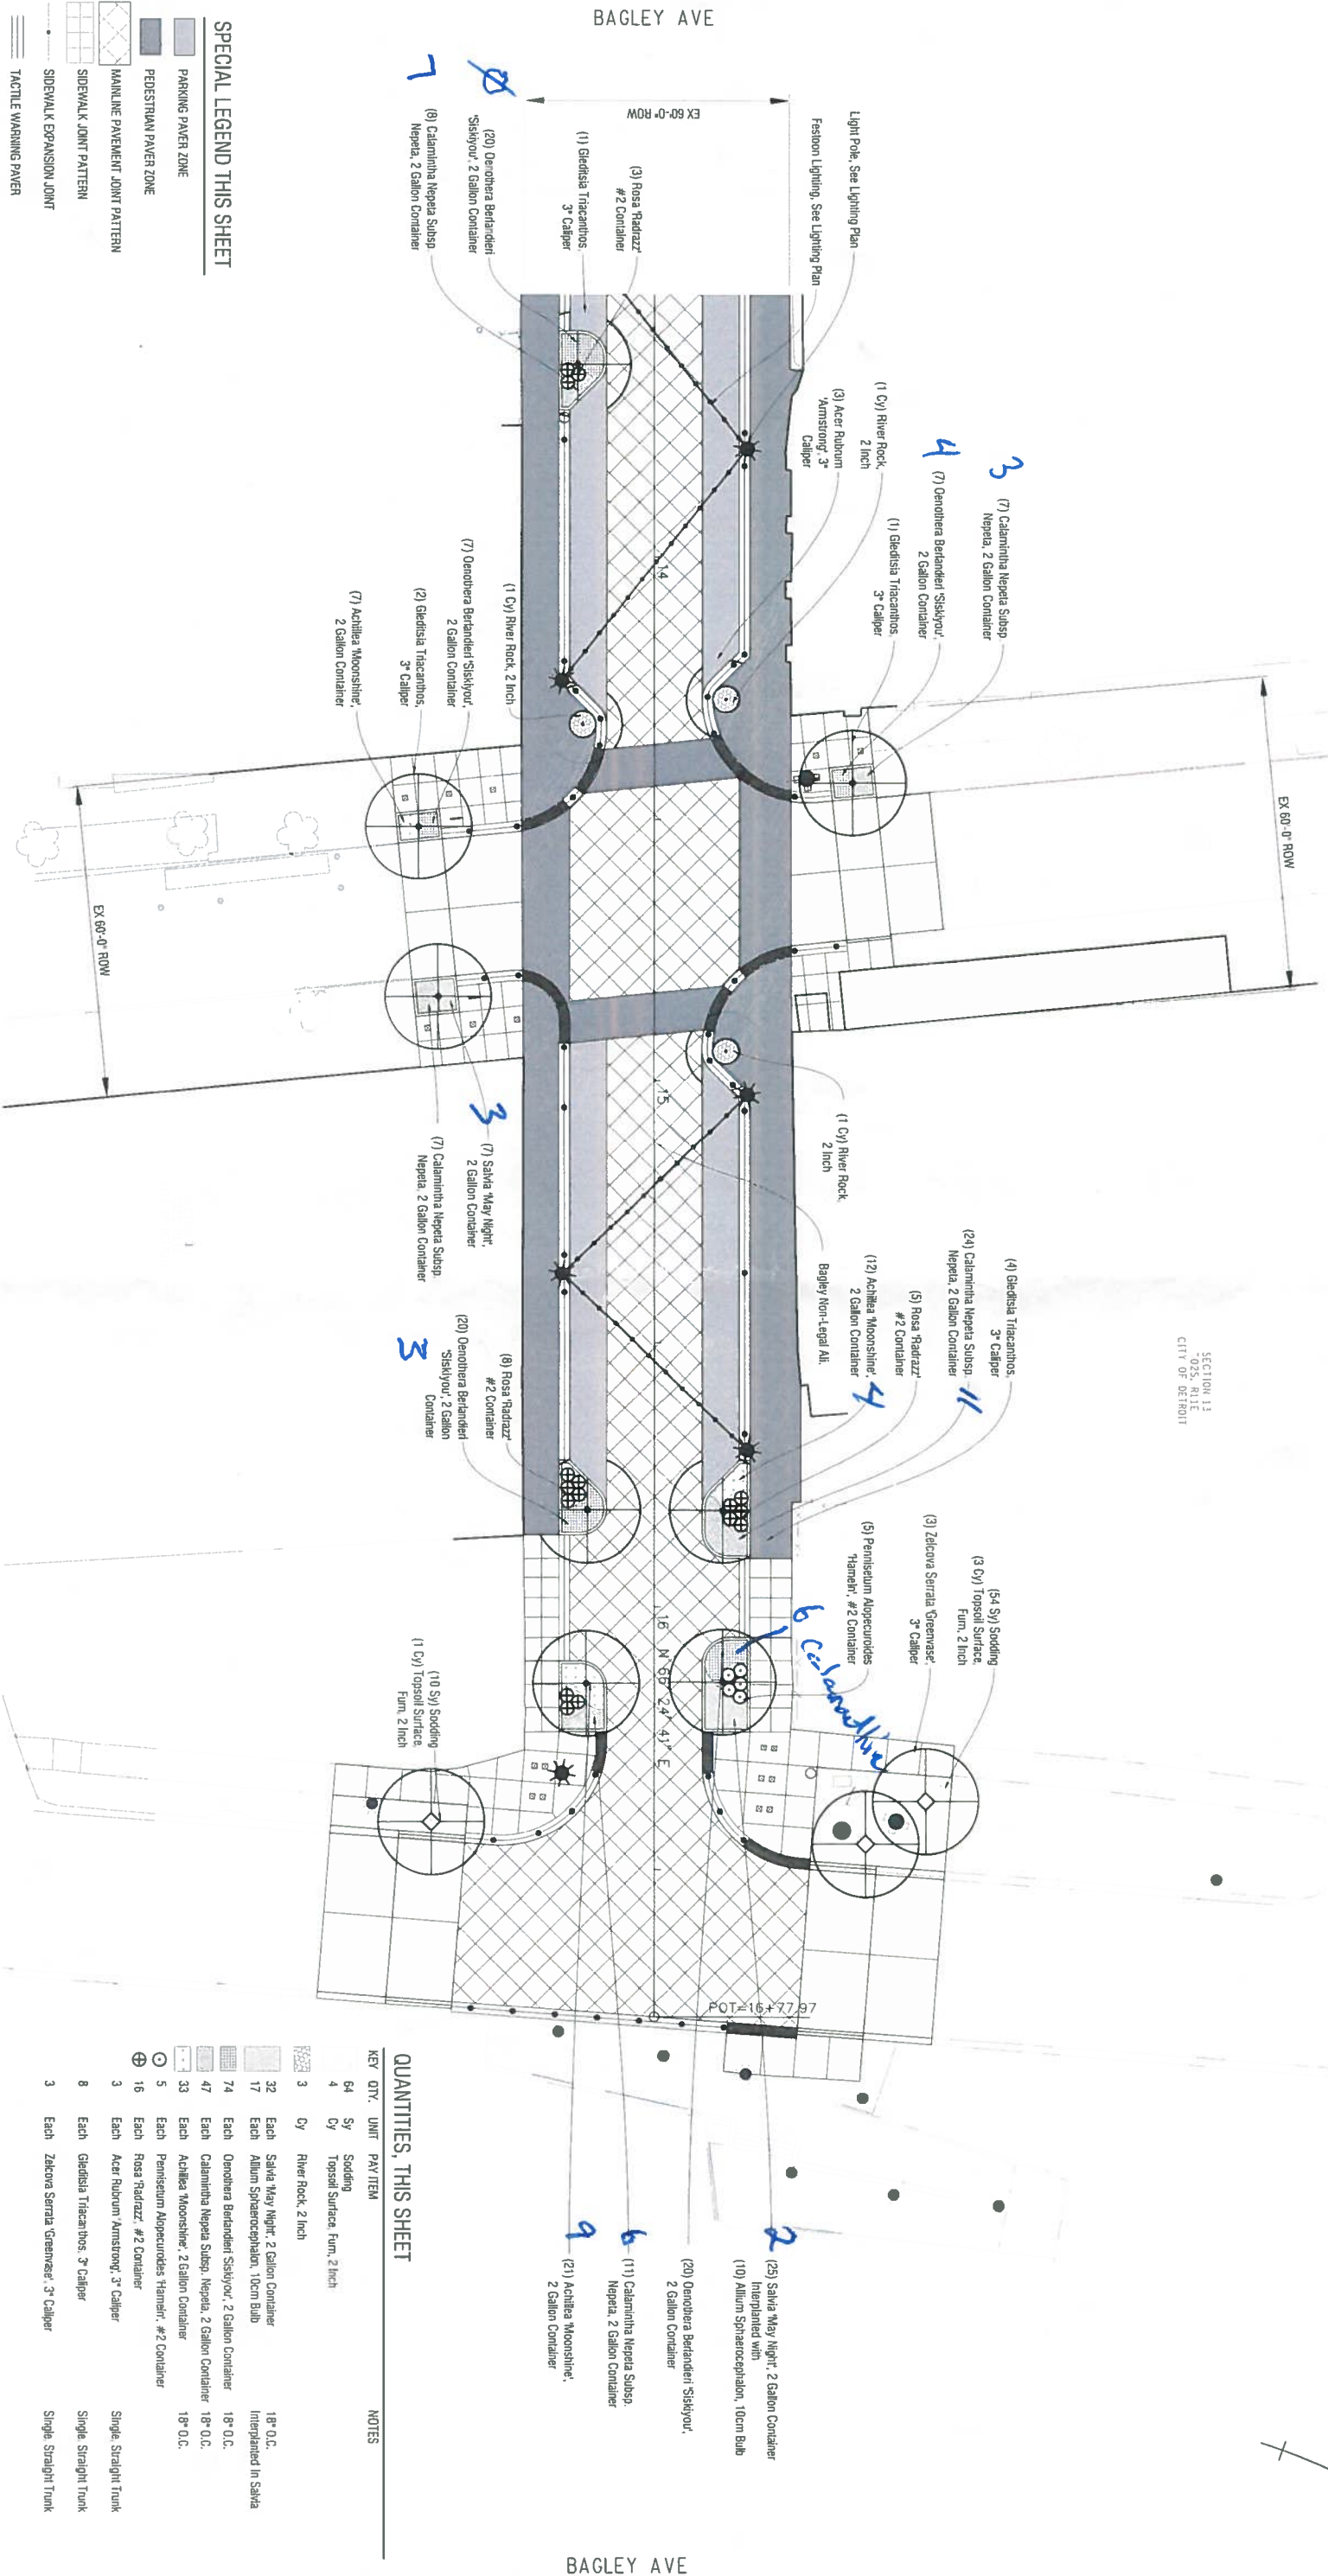

QUANTITIES, THIS SHEET

KEY	QTY.	UNIT	PAY ITEM	NOTES
64	Sy		Sodding	
4	Cy		Topsoil Surface, Furn, 2 inch	
3	Cy		River Rock, 2 inch	
32	Each		Salvia 'May Night', 2 Gallon Container	18" O.C.
17	Each		Allium Sphaerocephalon, 10cm Bulb	Interplanted in Salvia
74	Each		Oenothera Bielandieri 'Siskiyou', 2 Gallon Container	18" O.C.
47	Each		Calamintha Nepeta Subsp. Nepeta, 2 Gallon Container	18" O.C.
33	Each		Achillea Moonshine, 2 Gallon Container	18" O.C.
5	Each		Pennisetum Alopecuroides 'Hammer', #2 Container	
16	Each		Rosa 'Radrazz', #2 Container	
3	Each		Acer Rubrum 'Armstrong', 3" Caliper	Single Straight Trunk
8	Each		Glehnia Tricantios, 3" Caliper	Single Straight Trunk
3	Each		Zakona Sierra 'Greenasee', 3" Caliper	Single Straight Trunk

SPECIAL LEGEND THIS SHEET

- PARKING PAVEMENT ZONE
- PEDESTRIAN PAVEMENT ZONE
- MAINLINE PAVEMENT JOINT PATTERN
- SIDEWALK JOINT PATTERN
- SIDEWALK EXPANSION JOINT
- TACTILE WARNING PAVEMENT
- DETECTABLE WARNING PAVEMENT
- DECORATIVE TILE

NO.	DATE	AUTH.	DESCRIPTION

FINAL ROW PLAN REVISIONS

(SUBMITTAL DATE:)

DESCRIPTION

livingLAB

Detroit

0 30

HORIZ. (FT)

FILE:

NO.	DATE	AUTH.	DESCRIPTION

DATE	05/08/2019
JN:PW	7007
BAGLEY STREETSCAPE	

LANDSCAPE SHEET	DRAWING SHEET
BAGLEY STREETSCAPE	BAG LINDS
STA 13+50 TO STA 16+77.97 (POE)	002
	38