

PROJECT Kercheval Streetscape

PROJECT NO. 10812.001 (Detroit St. Task 1)

SUBMITTAL NO. 08 - Trash Receptacle

DESCRIPTION Trash Receptacle

DATE RECEIVED 5/5/2020

DATE RETURNED 5/6/2020

Review is only for the limited purpose of checking for general conformance with information given and the design concept expressed in the Contract Documents. Refer to attached for additional SmithGroup comments and/or review codes. The final review code prevails.

SMITHGROUP ACTION		
DISCIPLINE	REVIEWED BY	REVIEW CODE
Landscape Architecture	Brian Charlton	Approved as Noted
FINAL REVIEW CODE:		Approved as Noted


GENERAL REVIEW COMMENTS:

Trash Receptacles are Approved as Noted below:

- Install per manufacturer's recommendations.
- Field verify and confirm trash receptacle locations and orientation on-site with Engineer prior to proceeding with installation. Trash receptacle locations shall maintain accessible ADA pedestrian access paths/walks.
- Orient the side with the access door towards the street and the opposite side with the Detroit Logo towards the sidewalk.
- Anchor receptacle in place per manufacturer recommendations and per plans
- Provide rain bonnet lid per plans
- Provide hot dipped galvanizing before powdercoating with black finish

- Provide high density plastic liner and drill (3) - 1/4" dia. drainage holes in the bottom of the liner
- Provide lockable side-door opening
- Provide decal with standard Detroit Logo as shown

* ALL DIMENSIONS ARE IN INCHES *

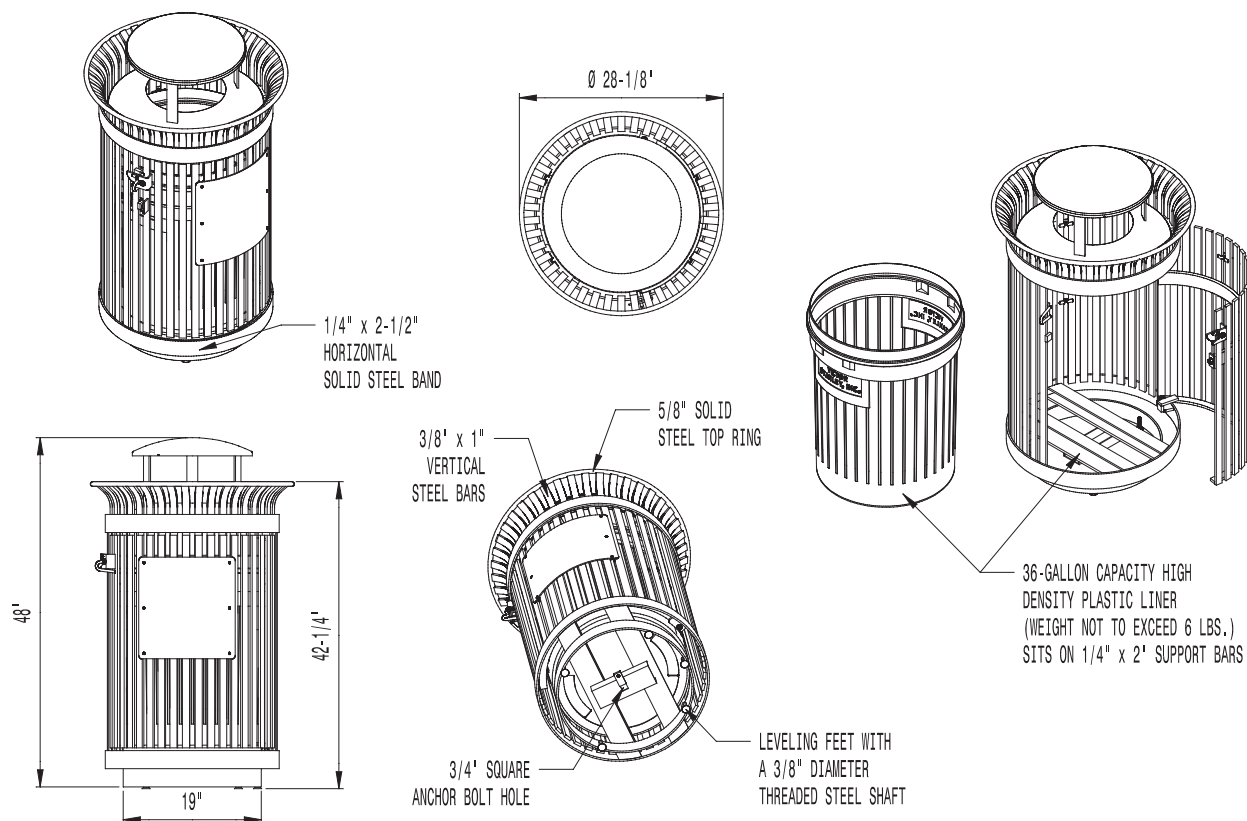

AVAILABLE OPTIONS:

POWDER COATING

10 STANDARD COLORS, 2 OPTIONAL METALLIC COLORS,
CUSTOM COLORS (INCLUDING THE RAL RANGE)

CUSTOM PLAQUES & DECALS

AVAILABLE WITH STEEL PLAQUES IN VARIOUS SIZES AND PRESSURE SENSITIVE
VINYL OUTDOOR DECALS.

LIDS

STANDARD TAPERED FORMED LID. AVAILABLE WITH OPTIONAL DOME LID,
DOME LID WITH STAINLESS STEEL ASHTRAY, CONVEX LID, CONVEX LID
WITH SELF-CLOSING DOOR, RAIN BONNET LID (AS SHOWN), RAIN BONNET LID WITH
STAINLESS STEEL ASHTRAY, AND RECYCLE LIDS. ASHTRAYS AVAILABLE WITH
OPTIONAL ASHTRAY COVER.

SECURITY

SHOWN WITH STANDARD LOCKABLE LATCH AVAILABLE WITH OPTIONAL KEYED
LOCK BOX, LID BOLTED IN PLACE, AVAILABLE WITH OPTIONAL MOUNT WITH
3 IN-LINE ANCHOR HOLES AND OPTIONAL BOTTOM PLATE COVER.

NOTES:

1. DRAWINGS NOT TO SCALE. DO NOT SCALE DRAWINGS.
2. ALL FABRICATED METAL COMPONENTS ARE STEEL SHOTBLASTED, ETCHED, PHOSPHATIZED, PREHEATED, AND ELECTROSTATICALLY POWDER-COATED WITH T.G.I.C. POLYESTER POWDER COATINGS. PRODUCTS ARE FULLY CLEANED AND PRETREATED, PREHEATED AND COATED WHILE HOT TO FILL CREVICES AND BUILD FILM COATING. COATED PARTS ARE THEN FULLY CURED TO COATING MANUFACTURER'S SPECIFICATIONS. THE THICKNESS OF THE RESULTING FINISH AVERAGES 8-10 MILS (200-250 MICRONS).
3. OIL IMPREGNATED BRONZE BUSHINGS AND STAINLESS STEEL PIVOT PINS FOR DOOR MOVEMENT, STANDARD 3/16" SOLID STEEL LATCH ASSEMBLY OR OPTIONAL PATENTED STAINLESS STEEL KEYED LOCK ASSEMBLY.
4. THIS VICTOR STANLEY, INC. PRODUCT MUST BE PERMANENTLY AFFIXED TO THE GROUND. CONSULT YOUR LOCAL CODES FOR REGULATIONS.
5. VICTOR STANLEY, INC., PLASTIC INNER LINERS ARE MOLDED ON TOOLING DESIGNED FOR AND OWNED BY VICTOR STANLEY, INC. THEY OFFER MAXIMUM CAPACITY AND STRENGTH WITH LIGHTWEIGHT CONSTRUCTION USING CRITICAL MOLDED RIBS, INTEGRAL HANDHOLDS, AND HIGH-STRENGTH MATERIALS. THIS MINIMIZES HANDLING DIFFICULTY AND FACILITATES EASY EMPTYING AND STORAGE WHILE AFFORDING LONG SERVICE LIFE.
6. ANCHOR BOLT NOT PROVIDED BY VICTOR STANLEY, INC.
7. FOR HIGH SALT ABUSIVE CLIMATES, HOT DIP GALVANIZING BEFORE POWDER COATING IS AVAILABLE. SEE WRITTEN SPECIFICATIONS FOR DETAILS.
8. ALL SPECIFICATIONS ARE SUBJECT TO CHANGE. CONTACT MANUFACTURER FOR DETAILS.
9. THIS PRODUCT IS SHIPPED FULLY ASSEMBLED.



36-GALLON SIDE-DOOR-OPENING LITTER RECEPTACLE
SHOWN: OPTIONAL RAIN BONNET LID
OPTIONAL 14" x 14" PLAQUE



Drawn By: TJJK
Rev: 09/05/2019
Layout ID: 4816-01a

CUSTOM DECAL FOR SD-42 PLAQUE

CLIENT: MAJOR CEMENT

GRAPHICS APPLICATION: The graphics will be digitally printed onto a pressure sensitive vinyl decal and applied to a pre-powder coated steel plaque.

PLAQUE SIZE: 14" H x 14" W

PLAQUE COLOR: Black

DECAL SIZE: 11.375" H x 11.375" W

VINYL MATERIAL COLOR: White

PRINTED COLOR(S): PMS 309, PMS 7473, PMS 692

Customer Approval

Date: ____/____/____



Specifications and art are subject to change at manufacturer's discretion to ensure proper fit and/or optimum output.

P.O. Drawer 330, Dunkirk, MD 20754

1.800.368.2573 (USA + Canada)

TEL 301.855.8300

FAX 410.257.7579

sales@victorstanley.com

VICTORSTANLEY.COM