
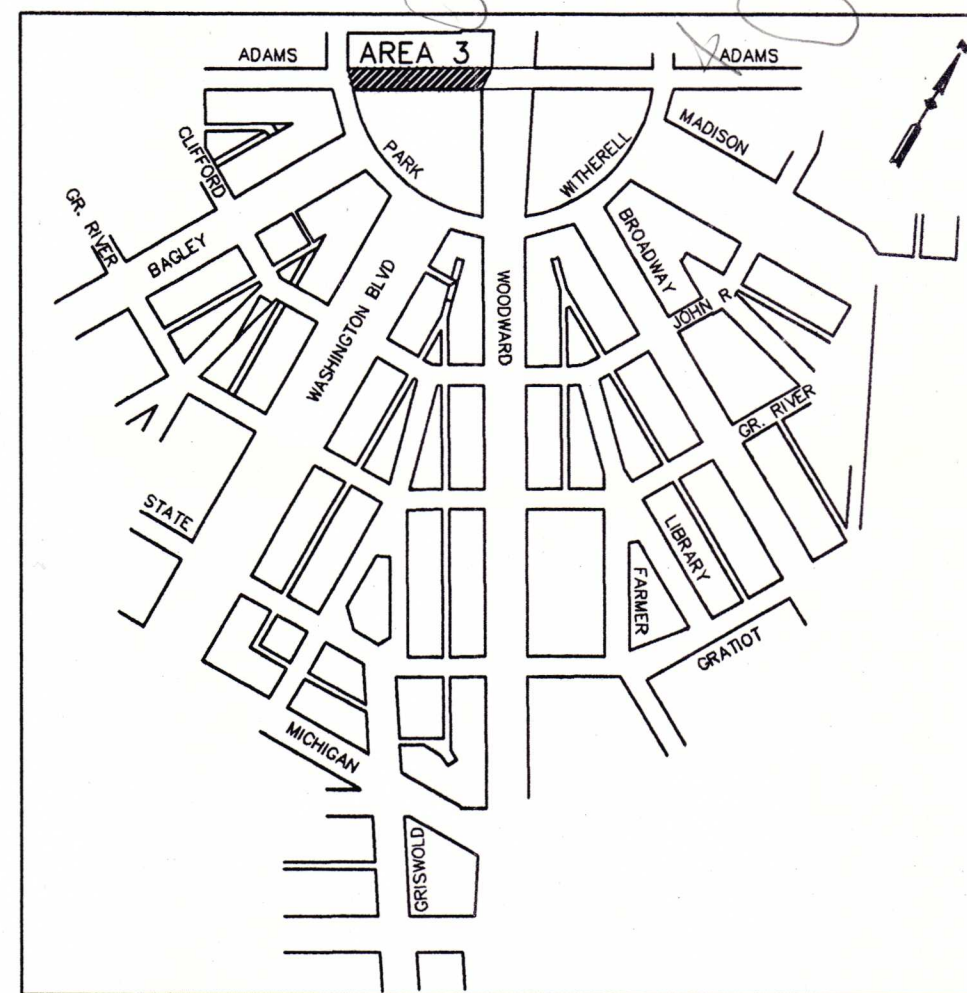


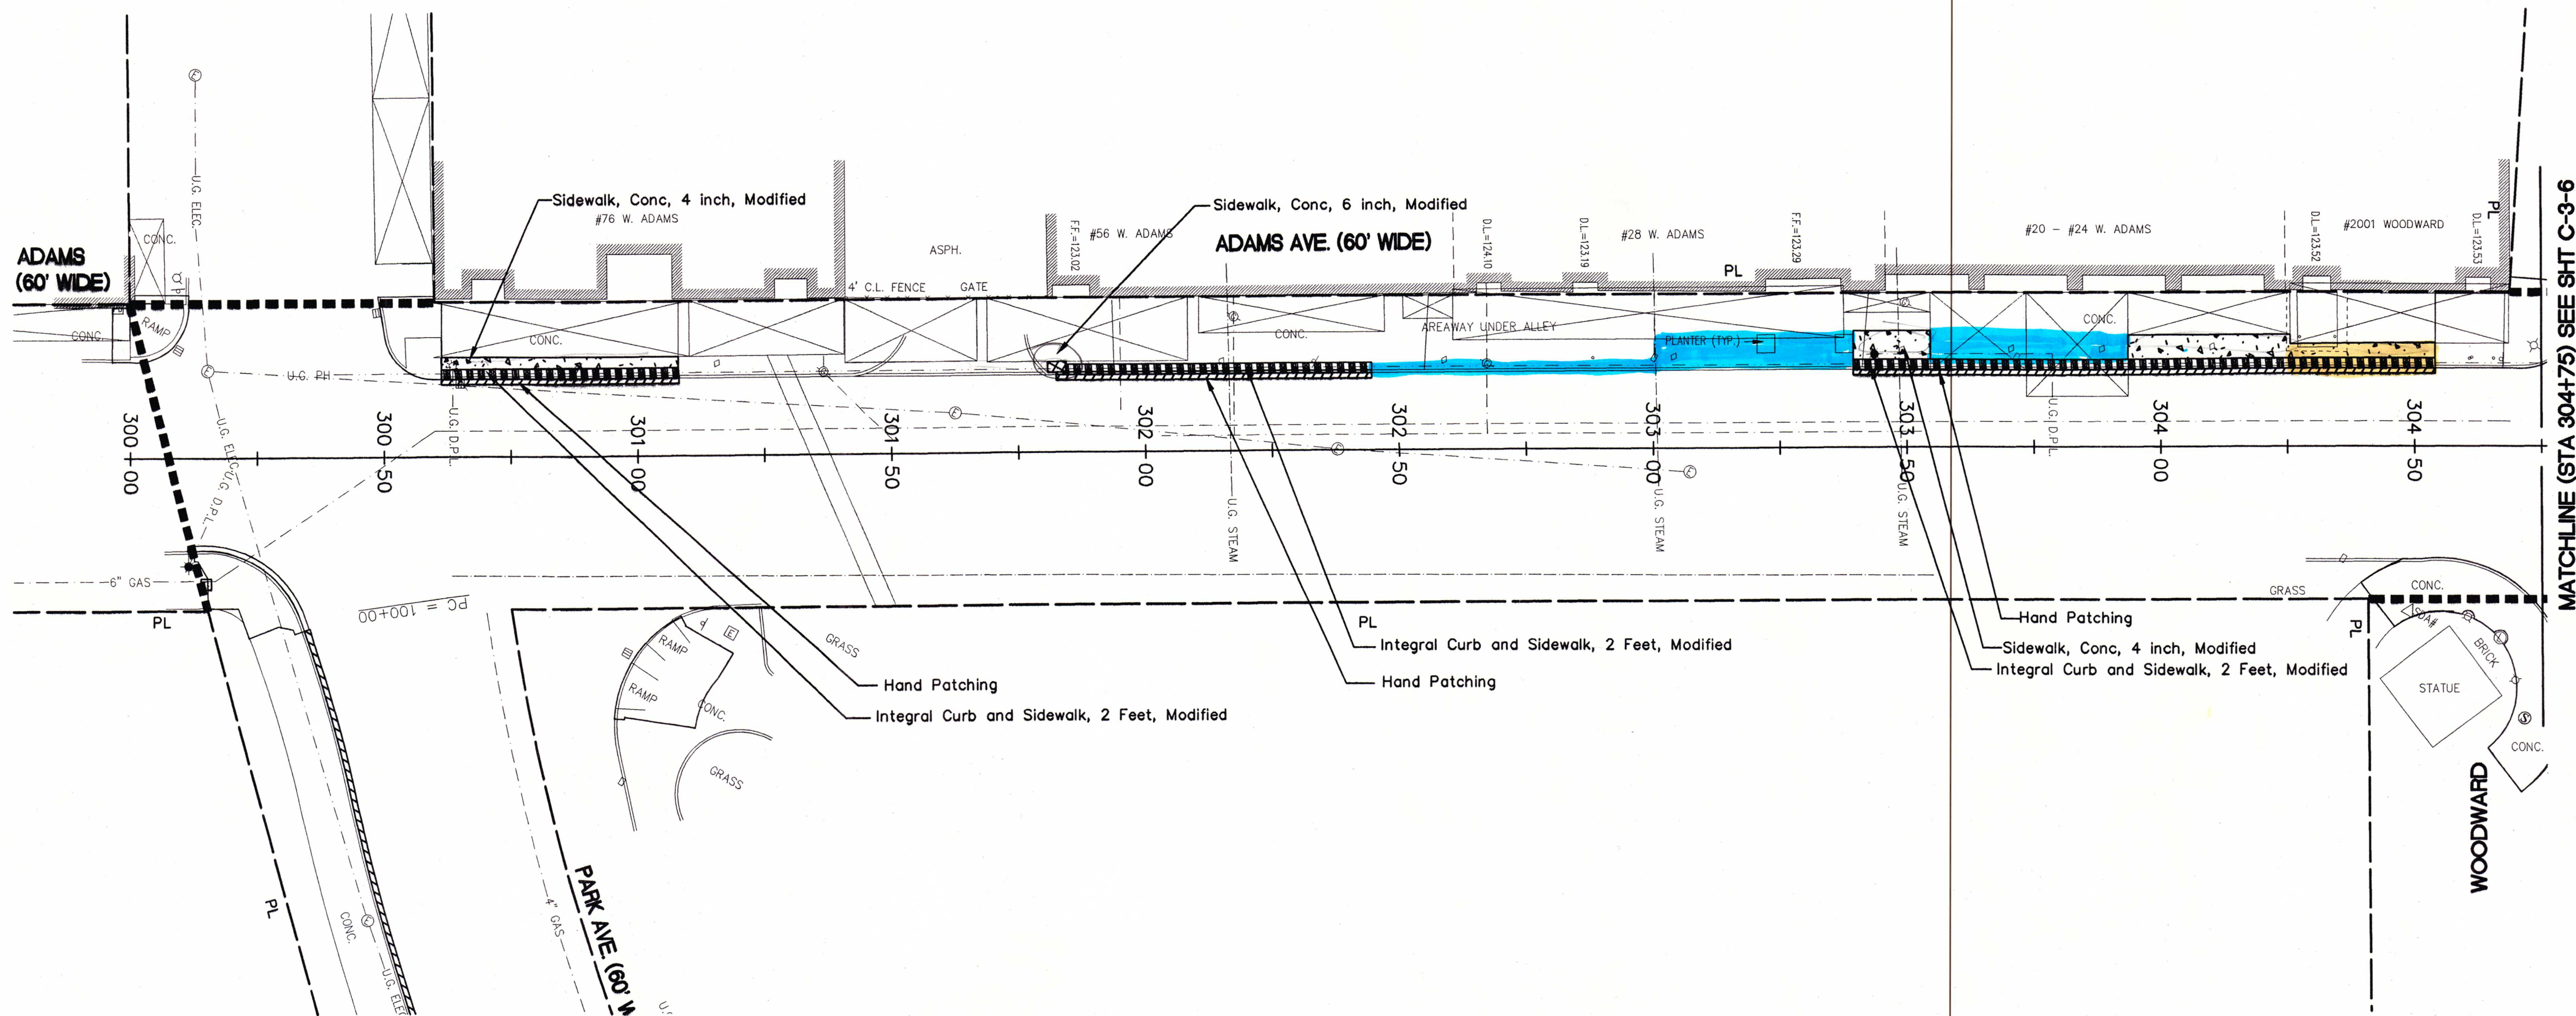

- CONSTRUCTION LEGEND**
- Sidewalk, Conc, 4 inch, Modified
 - Sidewalk, Conc, 6 inch, Modified
 - Integral Curb and Sidewalk, Conc, 4 inch, Modified
 - Integral Curb and Sidewalk, Conc, 6 inch, Modified
 - Integral Curb and Sidewalk, 2 Feet, Modified
 - Conc Pavt, Misc, Nonreinf, 8 inch
 - Hand Patching
 - Brick Paving, Modified
 - LIMITS OF CONSTRUCTION ON CROSS STREET
 - PROPERTY LINE

NOTE:
FOR SIDEWALK CONSTRUCTION OVER
VAULTS DETAILS SEE SHT # X-1.

PARTICIPATING QUANTITIES, THIS SHEET		
PAY ITEM	UNIT	QUANTITY
Integral Curb and Sidewalk, 2 Feet, Modified	Ft	227
Sidewalk, Conc, 4 inch, Modified	Sft	398
Sidewalk, Conc, 6 inch, Modified	Sft	13
Conc Pavt, Misc, Nonreinf, 8 inch, Modified	Syd	-
Hand Patching	Ton	4

AS-BUILT

3 WORKING DAYS
BEFORE YOU DIG
CALL MISS DIG.
1-800-482-7171
For free location of public utility lines

REVISIONS	DESCRIPTION	CHK'D	APP'VD	DATE
F				
E				
D				
C				
B				
A				

DRAWN BY: MW
DESIGNED BY: KD
CHECKED BY: MH
APPROVED BY: MH

LOWER WOODWARD CROSS STREETS IMPROVEMENTS
CITY OF DETROIT- DOWNTOWN DEVELOPMENT AUTHORITY

CONSTRUCTION PLAN
ADAMS (NORTH) - PARK TO MATCHLINE (STA 304+75)

SCALE: 1"=20' DATE: 08-28-08

hamiltonanderson
220 W. CONGRESS, SUITE 400
DETROIT, MI 48226
PHONE: (313) 967-4700
FAX: (313) 967-4707
www.hamiltonanderson.com

UES
20349 Alderton Street, Suite 200
DETROIT, MI 48219-9550
PHONE: (313) 434-8282
FAX: (313) 537-7945
www.urbanengineering.com

MANSELL
Manzell Associates, INC.
3508 Grand River
Farmington, MI 48335
PHONE: (248) 473-7070
FAX: (248) 473-8190

DDA CITY OF DETROIT
DOWNTOWN DEVELOPMENT AUTHORITY

500 Griswold, Suite 2200,
Detroit, MI 48228
P: (313) 963-2940
F: (313) 963-8893

SECTION MAP	TOWN	RANGE	SECTION	PORTION CODE
-	-	-	-	-

M.D.P.H./D.N.R. PERMIT NO.
REF. NO. DE06001.OT
CONTRACT NO.
FILE NO.
DRAWING NO. C-3-5