
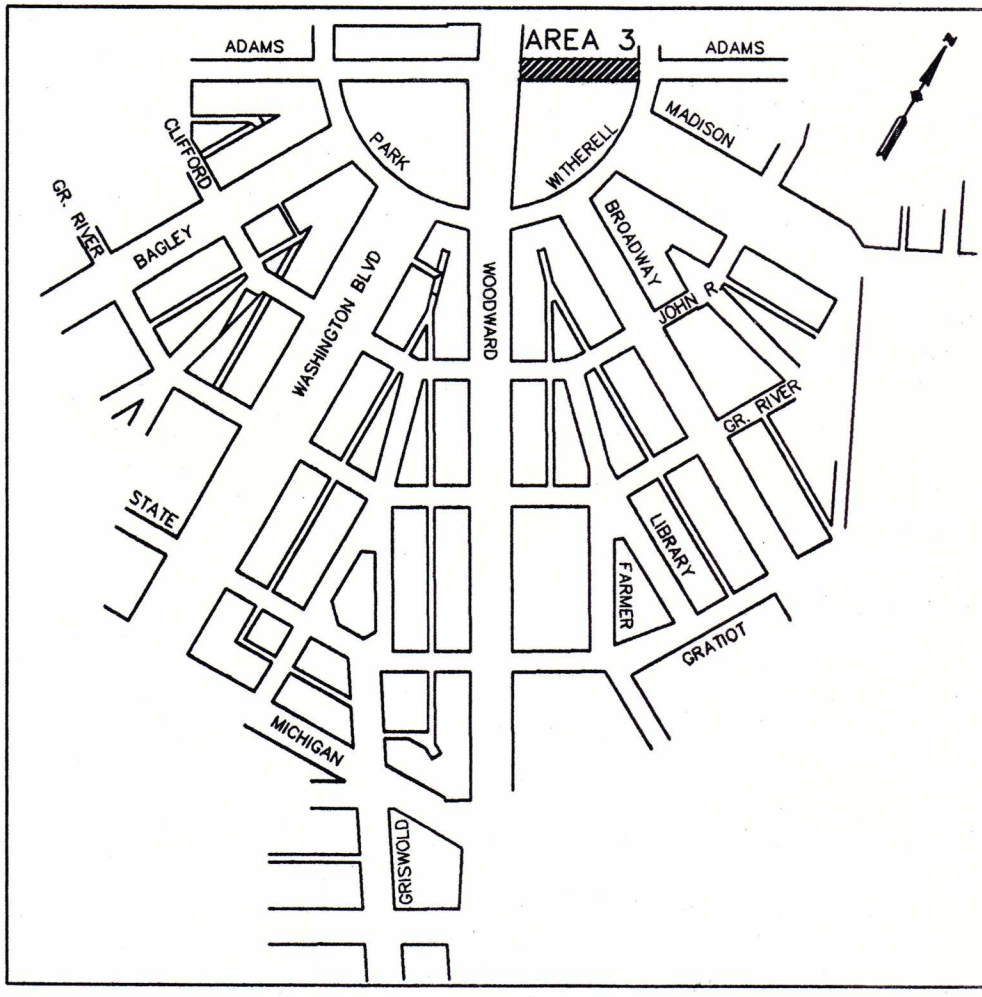


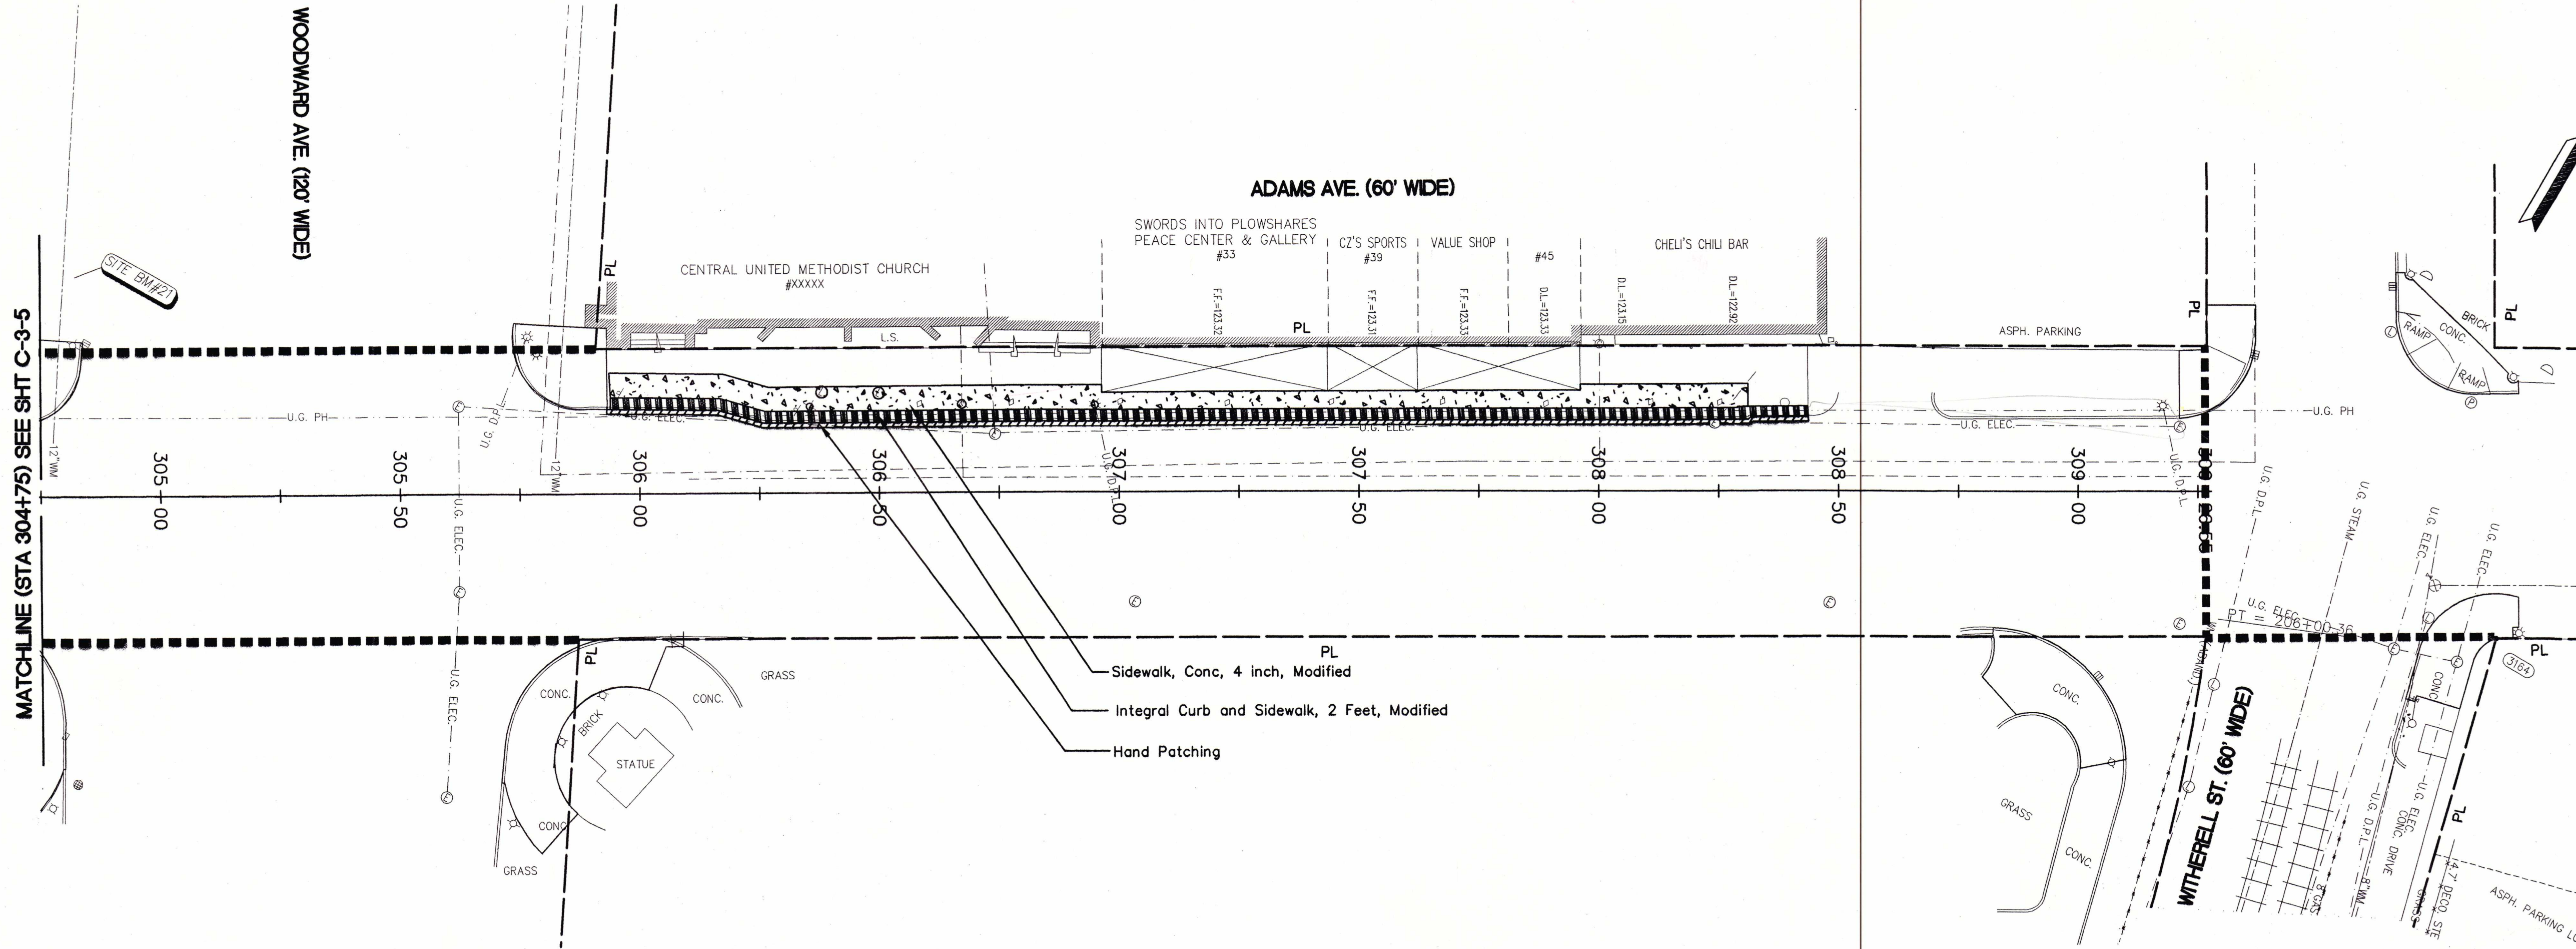

- KEY PLAN**
- CONSTRUCTION LEGEND**
- Sidewalk, Conc, 4 inch, Modified
 - Sidewalk, Conc, 6 inch, Modified
 - Integral Curb and Sidewalk, Conc, 4 inch, Modified
 - Integral Curb and Sidewalk, Conc, 6 inch, Modified
 - Integral Curb and Sidewalk, 2 Feet, Modified
 - Conc Pavt, Misc, Nonreinf, 8 inch
 - Hand Patching
 - Brick Paving, Modified
 - LIMITS OF CONSTRUCTION ON CROSS STREET
 - PROPERTY LINE

NOTE:
FOR SIDEWALK CONSTRUCTION OVER
VAULTS DETAILS SEE SHT # X-1.

PARTICIPATING QUANTITIES, THIS SHEET		
PAY ITEM	UNIT	QUANTITY
Integral Curb and Sidewalk, 2 Feet, Modified	Ft	253
Sidewalk, Conc, 4 inch, Modified	Sft	1176
Sidewalk, Conc, 6 inch, Modified	Sft	-
Conc Pavt, Misc, Nonreinf, 8 inch, Modified	Syd	-
Hand Patching	Ton	5

AS-BUILT

3 WORKING DAYS
BEFORE YOU DIG
CALL MISS DIG.
1-800-482-7171
For free location of public utility lines

BASE BID

F E D C B A				DRAWN BY: MW DESIGNED BY: KD CHECKED BY: MH APPROVED BY: MH	DESCRIPTION REVISIONS	CHK'D	APPVD	DATE																																																																																																																																																																																																																																																																																																																																																																																																																																																																																																																																																																																										
----------------------------	--	--	--	--	------------------------------	-------	-------	------	--	--	