
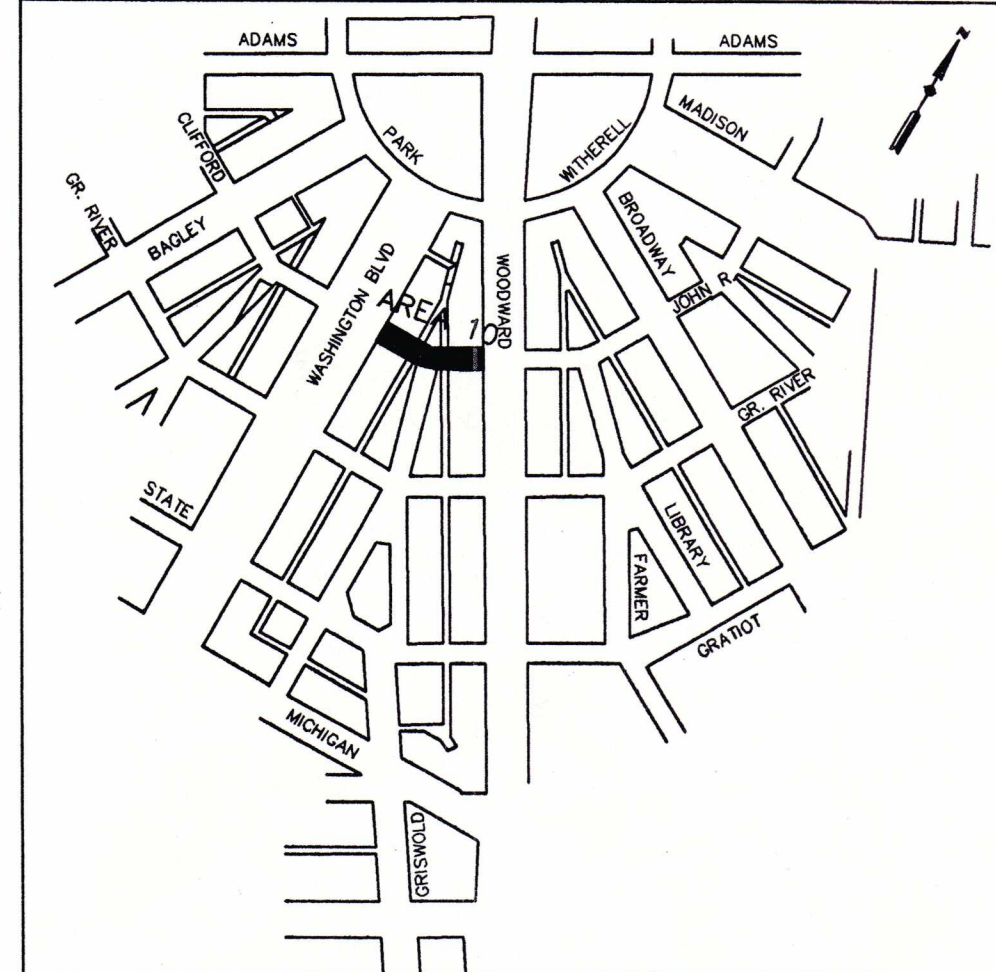


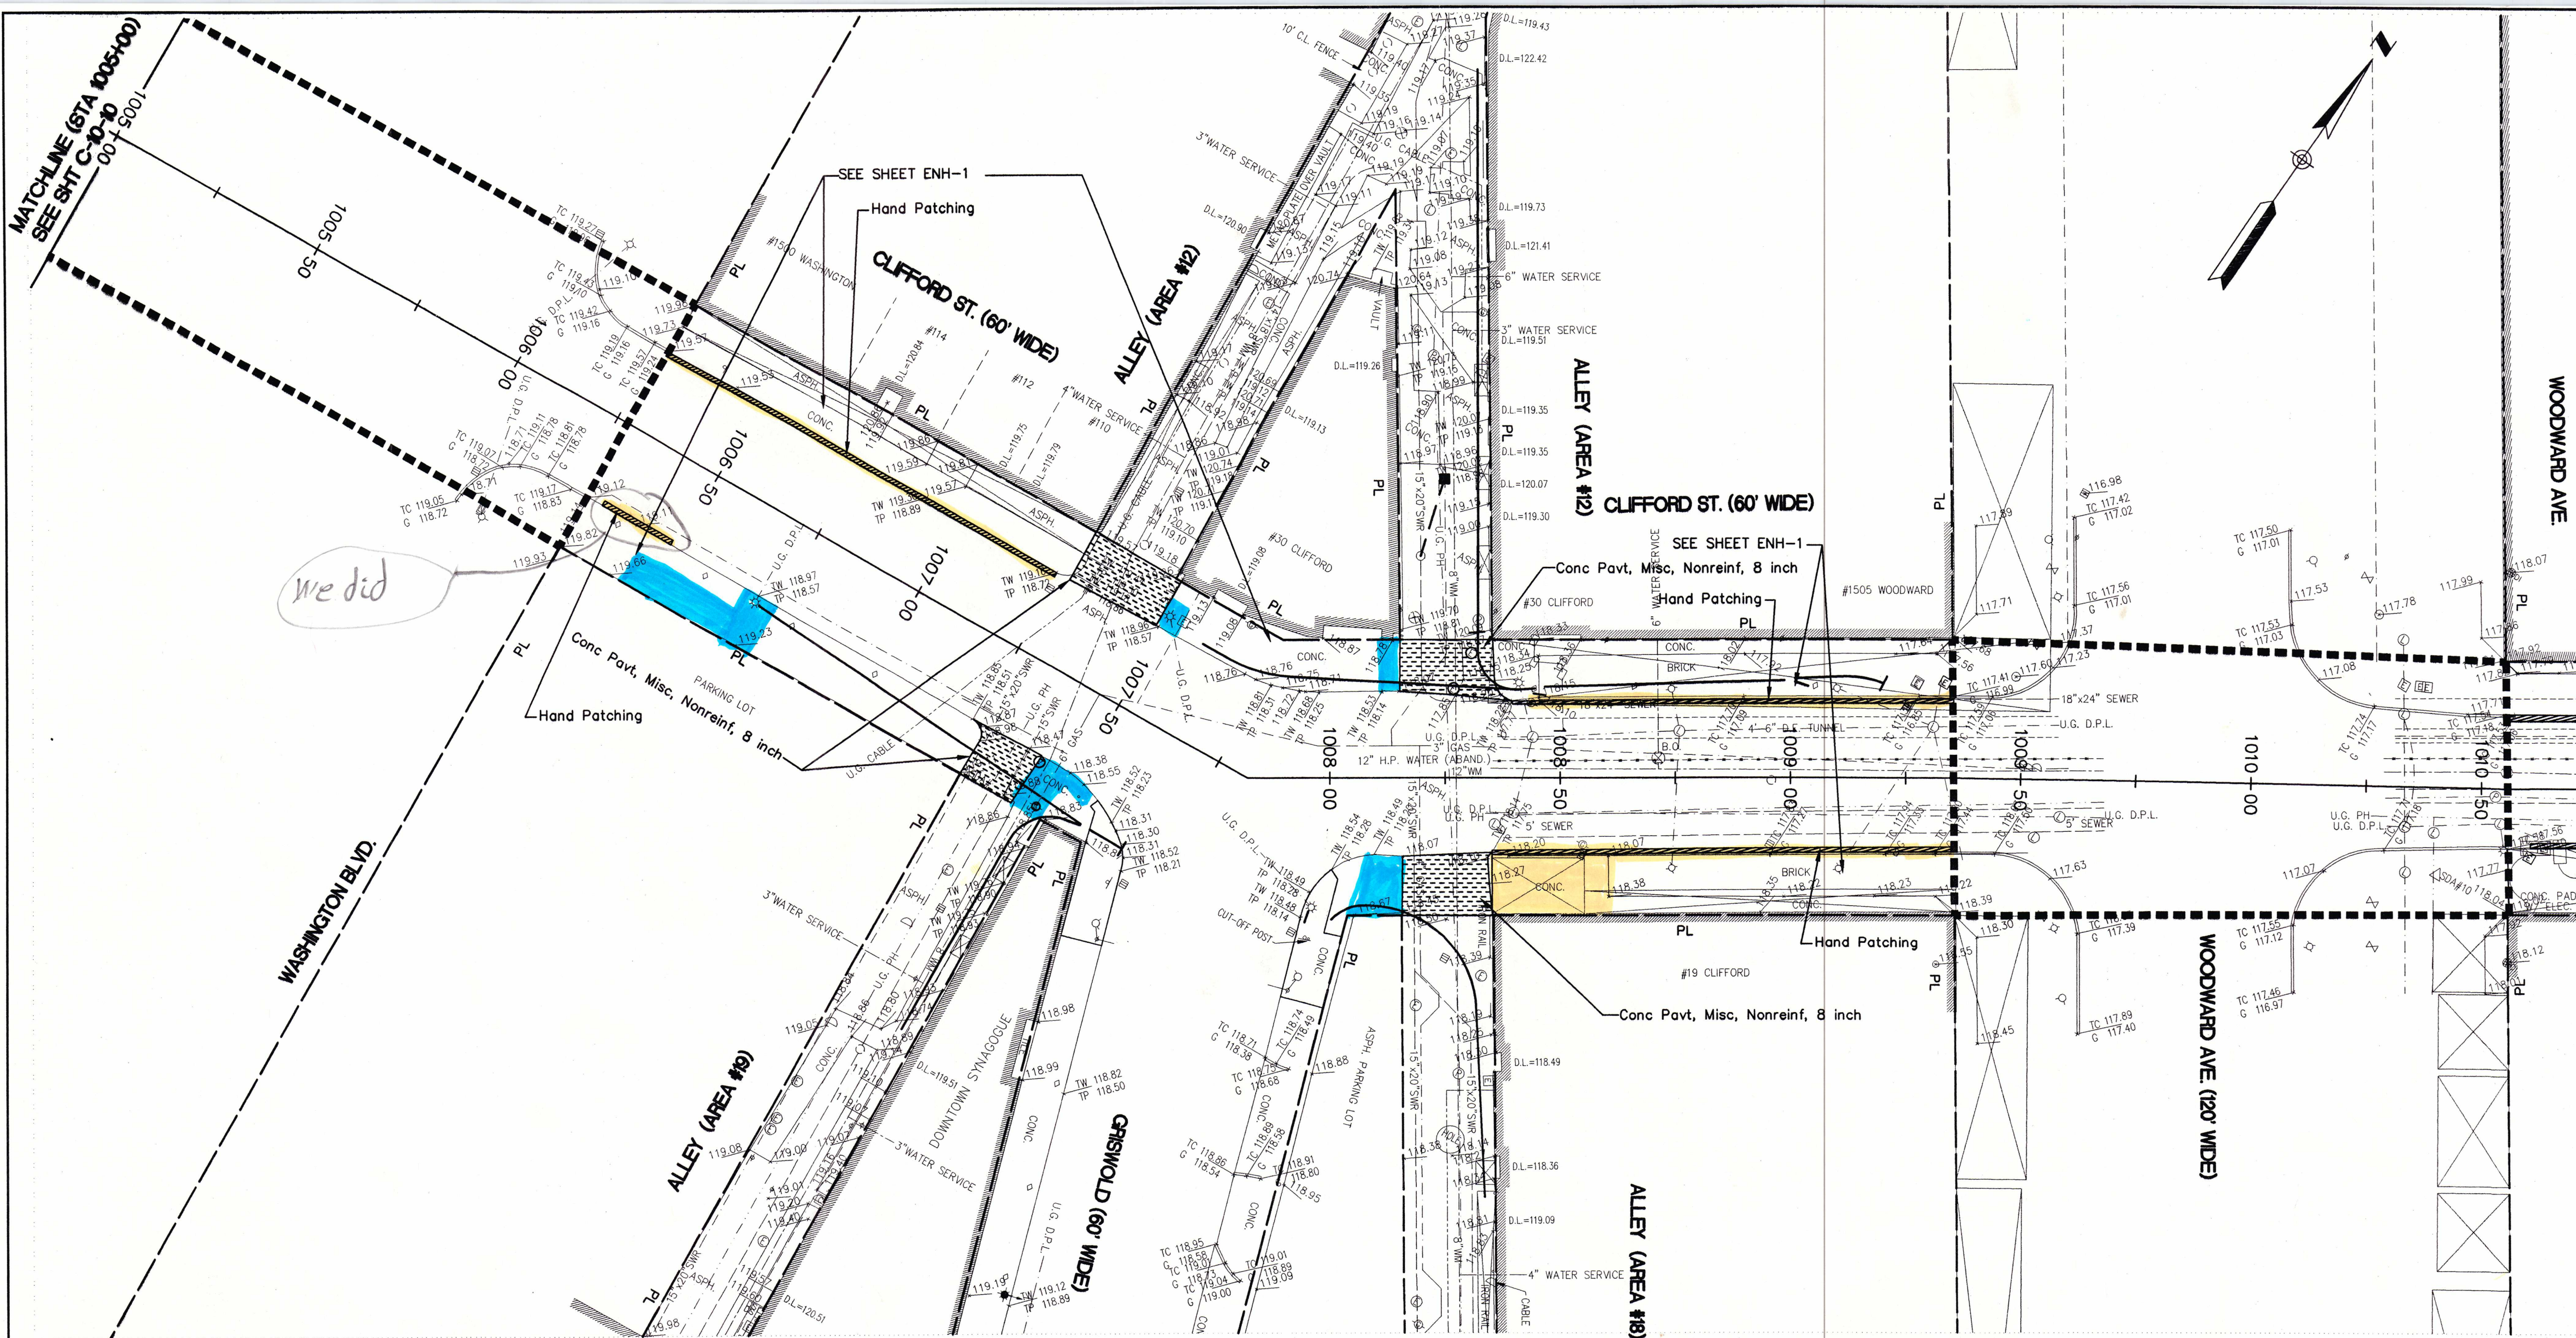

- CONSTRUCTION LEGEND**
- Sidewalk, Conc, 4 inch, Modified
 - Sidewalk, Conc, 6 inch, Modified
 - Integral Curb and Sidewalk, Conc, 4 inch, Modified
 - Integral Curb and Sidewalk, Conc, 6 inch, Modified
 - Integral Curb and Sidewalk, 2 Feet, Modified
 - Conc Pavt, Misc, Nonreinf, 8 inch
 - Hand Patching
 - Brick Paving, Modified
 - LIMITS OF CONSTRUCTION ON CROSS STREET
 - PROPERTY LINE

NOTE:
FOR SIDEWALK CONSTRUCTION OVER
VAULTS DETAILS SEE SHT # X-1.

PARTICIPATING QUANTITIES, THIS SHEET		
PAY ITEM	UNIT	QUANTITY
Integral Curb and Sidewalk, 2 Feet, Modified	Ft	-
Sidewalk, Conc, 4 inch, Modified	Sft	-
Sidewalk, Conc, 6 inch, Modified	Sft	-
Conc Pavt, Misc, Nonreinf, 8 inch, Modified	Syd	99
Hand Patching	Ton	5

AS-BUILT

3 WORKING DAYS
BEFORE YOU DIG
CALL MISS DIG.
1-800-482-7171

F E D C B A	DESCRIPTION	CHKD	APPRD	DATE	DRAWN BY: MW	LOWER WOODWARD CROSS STREETS IMPROVEMENTS CITY OF DETROIT- DOWNTOWN DEVELOPMENT AUTHORITY	CONSTRUCTION PLAN CLIFFORD - MATCHLINE (STA 1005+00) TO MATCHLINE (STA 1010+75)	SCALE: 1"=20'	DATE: 08-28-08	220 W. CONGRESS, SUITE 400 DETROIT, MI 48226 PHONE: (313) 967-4700 FAX: (313) 967-4707 www.hamiltonanderson.com	16580 Wyoming Avenue, DETROIT, MI 48221-2882 PHONE: (313) 341-5797 FAX: (313) 341-0205 www.consulting.com	20349 Alderton Street, Suite 200 DETROIT, MI 48219-9550 PHONE: (313) 434-8282 FAX: (313) 537-7945 www.urbanengineering.com	Mansell Associates, INC. 33608 Grand River Farmington, MI 48335 PHONE: (248) 473-7070 FAX: (248) 473-9190	CITY OF DETROIT DOWNTOWN DEVELOPMENT AUTHORITY 500 Griswold, Suite 2200, Detroit, MI 48228 P: (313) 963-2940 F: (313) 963-8893	M.D.P.H./D.N.R. PERMIT NO. REF. NO. DE06001.OT CONTRACT NO. FILE NO. DRAWING NO. C-10-11
					CHECKED BY: MH										
					APPROVED BY: MH										
					REVISIONS										