


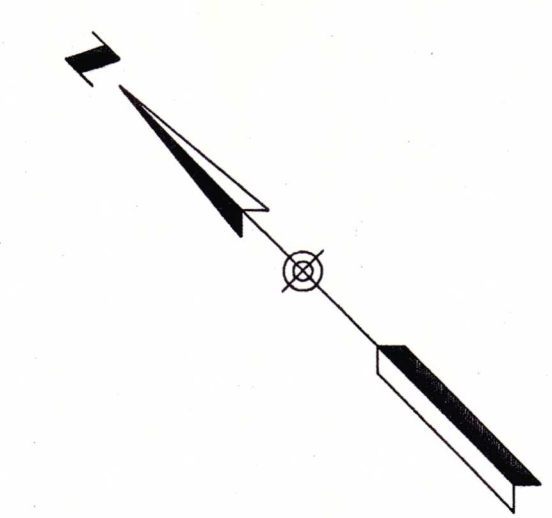

	Sidewalk, Conc, 4 inch, Modified
	Sidewalk, Conc, 6 inch, Modified
	Integral Curb and Sidewalk, Conc, 4 inch, Modified
	Integral Curb and Sidewalk, Conc, 6 inch, Modified
	Integral Curb and Sidewalk, 2 Feet, Modified
	Conc Pavt, Misc, Nonrein, 8 inch
	Hand Patching
	Brick Paving, Modified

NOTE:
FOR SIDEWALK CONSTRUCTION OVER
VAULTS DETAILS SEE SHT # X-1.

NON PARTICIPATING QUANTITIES, THIS SHEET		
PAY ITEM	UNIT	QUANTITY
Integral Curb and Sidewalk, 2 Feet, Modified	Ft	—
Sidewalk, Conc, 4 inch, Modified	Sft	1248
Sidewalk, Conc, 6 inch, Modified	Sft	219
Conc Pavt, Misc, Nonreinr, 8 inch, Modified	Syd	—
Hand Ditching	Ton	—

AS-BUILT

**3 WORKING DAYS
BEFORE YOU DIG
CALL MISS DIG.**

1-800-482-7171
For the location of utility lines

BASE BID

E D C B A					DRAWN BY: MW	 220 W. CONGRESS, SUITE 400 DETROIT, MI 48221-5282 PHONE: (313) 567-4700 FAX: (313) 957-4707 www.spaldingdecker.com	 16800 Wyoming Avenue, DETROIT, MI 48221-5282 PHONE: (313) 341-5797 FAX: (313) 341-0205 www.consulteng.com	 20349 Algerton Street, Suite 200 DETROIT, MI 48218-9549 PHONE: (313) 434-8282 FAX: (313) 537-7945 www.urbanengineeringolutions.com	 Manselli Associates, INC. 33606 Grand River Farmington, MI 48335 PHONE: (248) 473-7070 FAX: (248) 473-8190	 CITY OF DETROIT DOWNTOWN DEVELOPMENT AUTHORITY				M.D.P.H./D.N.R. PERMIT NO.	
					DESIGNED BY: KD					REF. NO.	DE06001.0T				
					CHECKED BY: MH					CONTRACT NO.					
					APPROVED BY: MH					FILE NO.					
	DESCRIPTION	CHK'D	APP'VD	DATE	CONSTRUCTION PLAN FARMER (EAST + WEST) - JOHN R. TO MATCHLINE (STA 503+00)	SCALE: 1"=20'	DATE: 08-28-08	SECTION MAP		TOWN	RANGE	SECTION	PORTION CODE	DRAWING NO.	C-5-2
	REVISIONS							-	-	-	-	-	-		