


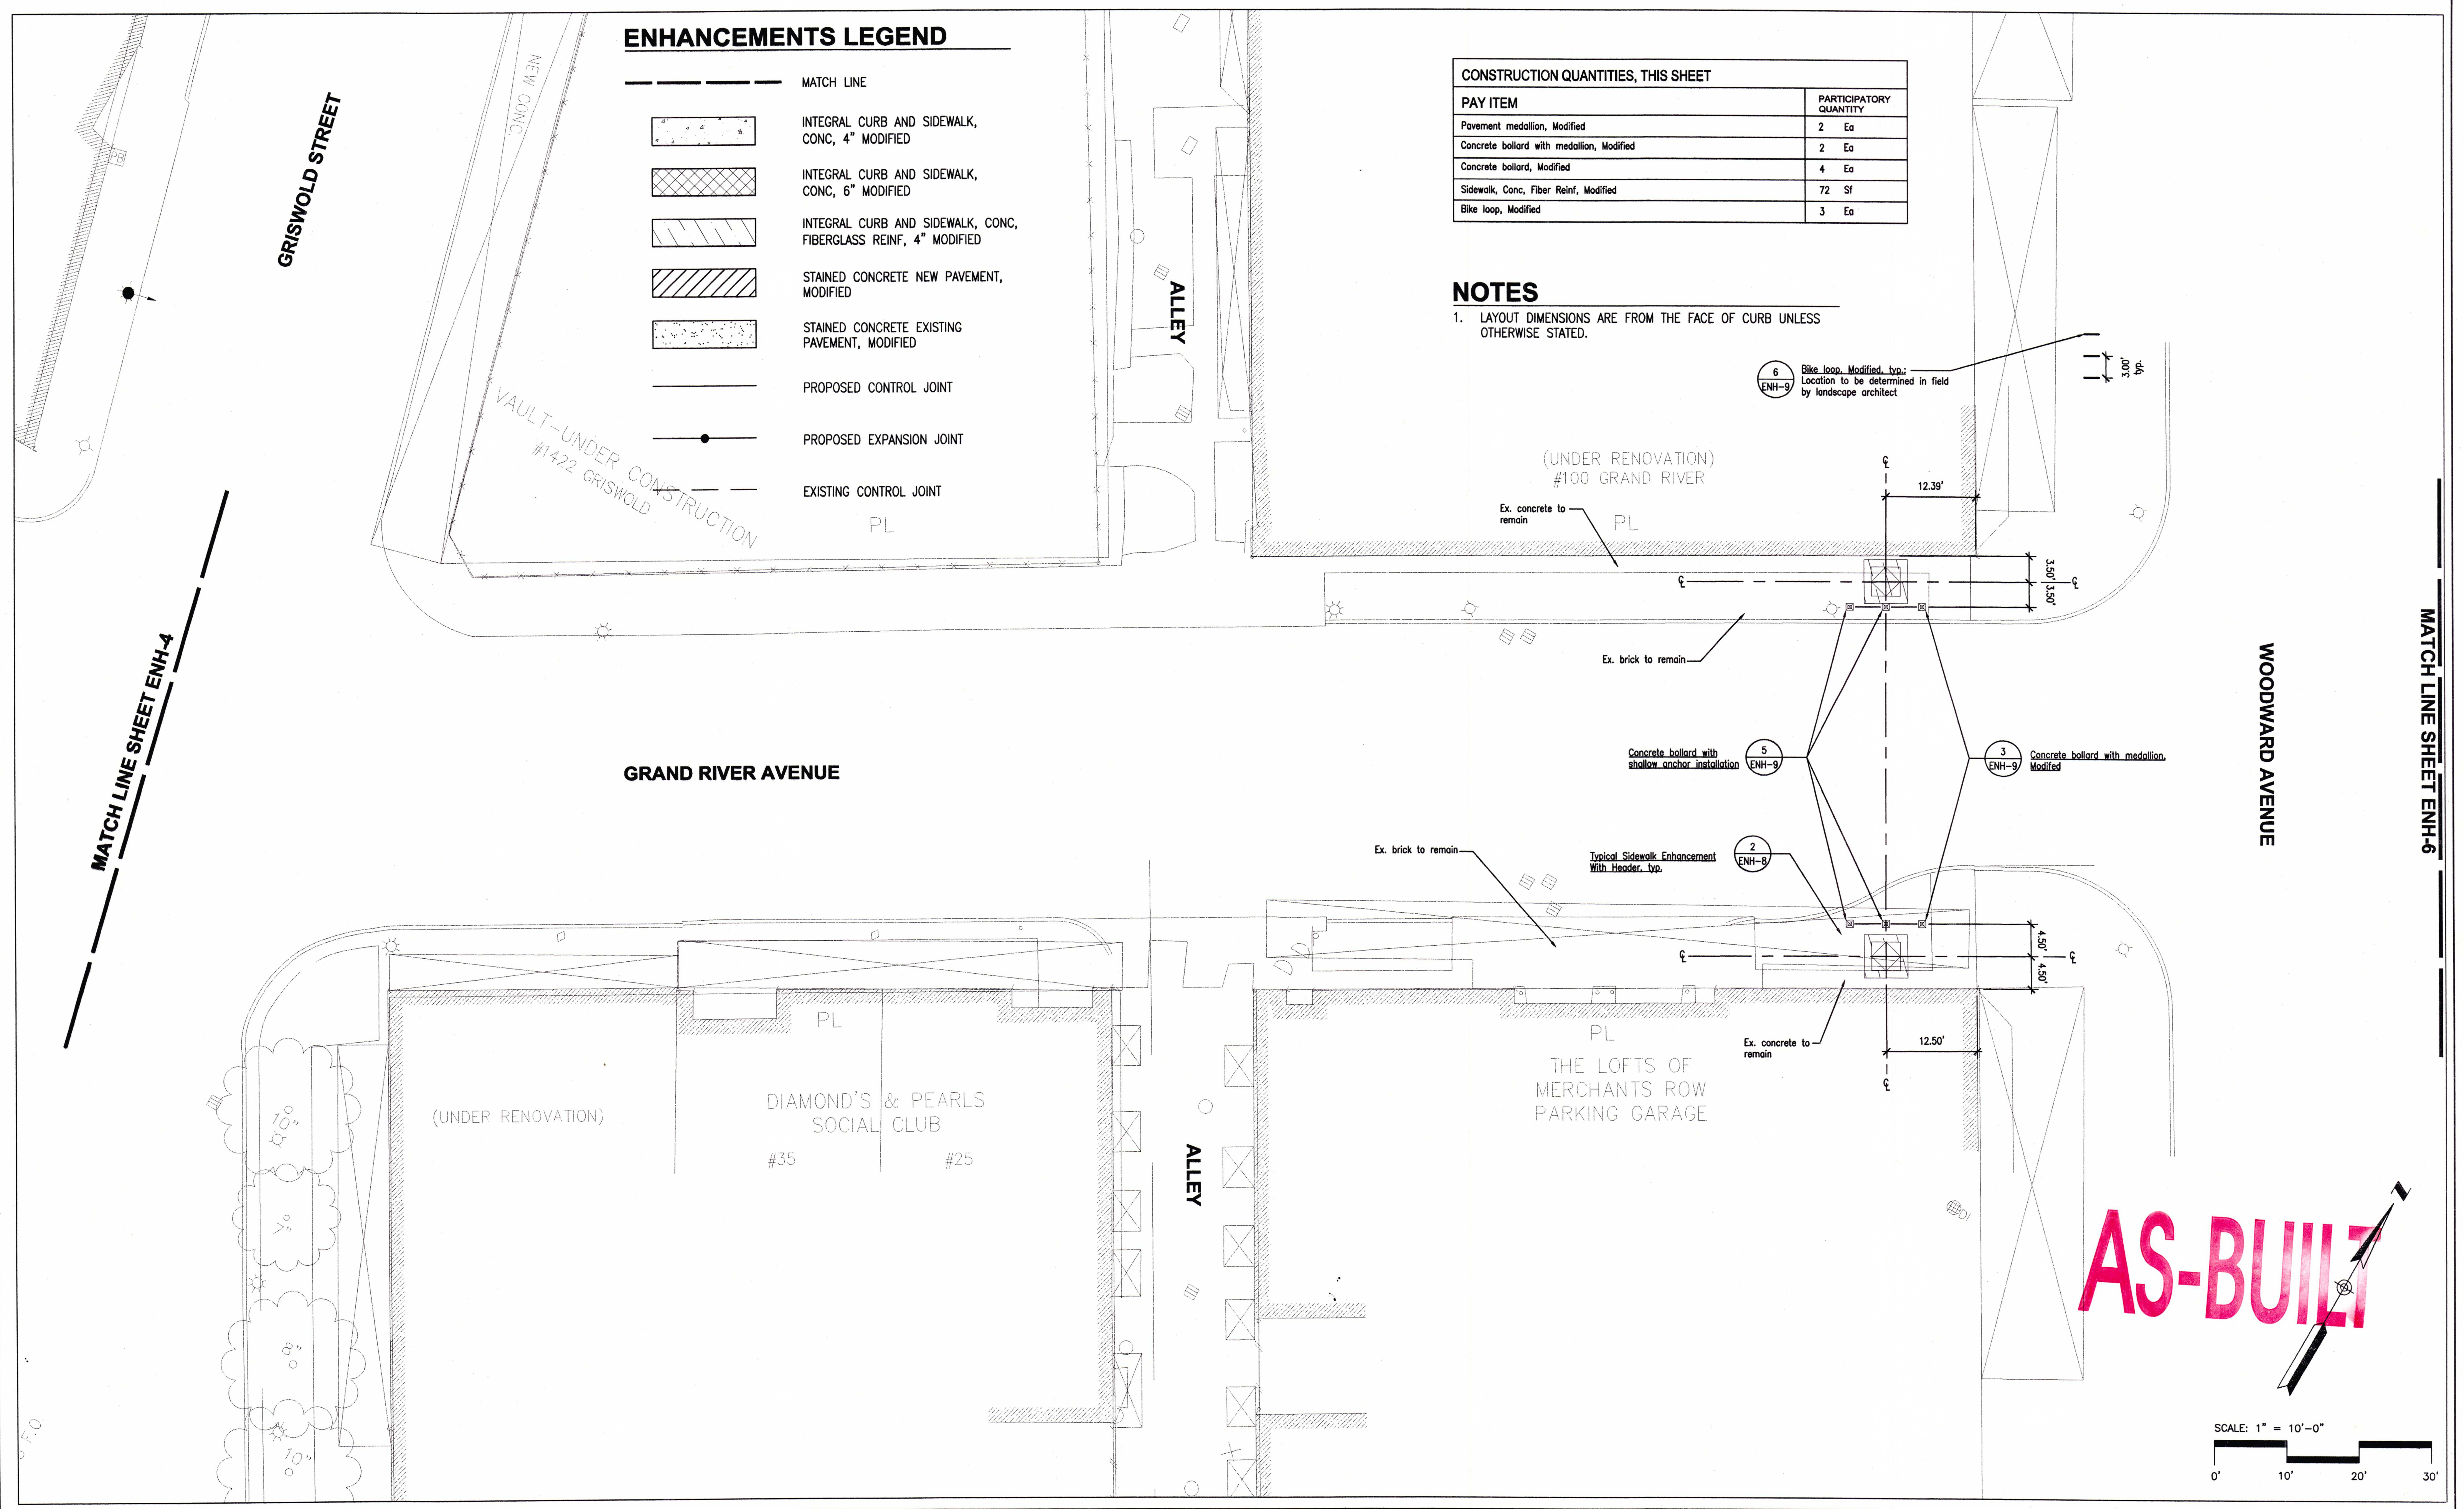

ENHANCEMENTS LEGEND

- MATCH LINE
- INTEGRAL CURB AND SIDEWALK, CONC, 4" MODIFIED
- INTEGRAL CURB AND SIDEWALK, CONC, 6" MODIFIED
- INTEGRAL CURB AND SIDEWALK, CONC, FIBERGLASS REINF, 4" MODIFIED
- STAINED CONCRETE NEW PAVEMENT, MODIFIED
- STAINED CONCRETE EXISTING PAVEMENT, MODIFIED
- PROPOSED CONTROL JOINT
- PROPOSED EXPANSION JOINT
- EXISTING CONTROL JOINT

CONSTRUCTION QUANTITIES, THIS SHEET	
PAY ITEM	PARTICIPATORY QUANTITY
Pavement medallion, Modified	2 Ea
Concrete bollard with medallion, Modified	2 Ea
Concrete bollard, Modified	4 Ea
Sidewalk, Conc, Fiber Reinf, Modified	72 Sf
Bike loop, Modified	3 Ea

NOTES

- LAYOUT DIMENSIONS ARE FROM THE FACE OF CURB UNLESS OTHERWISE STATED.

6 Bike loop, Modified, typ. Location to be determined in field by landscape architect

(UNDER RENOVATION) #100 GRAND RIVER

Ex. concrete to remain

Ex. brick to remain

Concrete bollard with shallow anchor installation

Concrete bollard with medallion, Modified

Typical Sidewalk Enhancement With Header, typ.


Ex. brick to remain

Ex. concrete to remain

THE LOFTS OF MERCHANTS ROW PARKING GARAGE

DIAMOND'S & PEARLS SOCIAL CLUB #35 #25

AS-BUILT

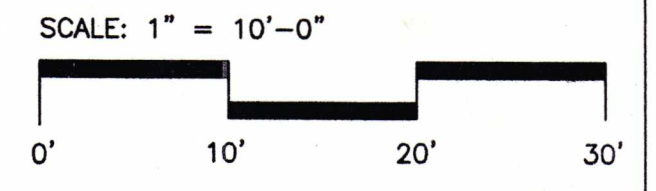

F E D C B A	DESCRIPTION	CHKD	APPVD	DATE	DRAWN BY: MS	LOWER WOODWARD CROSS STREETS IMPROVEMENTS CITY OF DETROIT - DOWNTOWN DEVELOPMENT AUTHORITY PROPOSED PLAN GRAND RIVER - GRISWOLD TO WOODWARD SCALE: 1"=10' DATE: 11-15-07	220 W. CONGRESS, SUITE 400 DETROIT, MI 48226 PHONE: (313) 967-4700 FAX: (313) 967-4707 www.spaldingredecor.com	Consulting Engineering Associates, Inc. 16580 Wyoming Avenue DETROIT, MI 48221-2882 PHONE: (313) 341-5797 FAX: (313) 341-0205 www.consulteng.com	20349 Alden Street, Suite 200 DETROIT, MI 48219-8550 PHONE: (313) 434-8282 FAX: (313) 537-7945 www.urbanengineeringassociates.com	MANSSELL 33608 Grand River Farmington, MI 48335 PHONE: (248) 473-7070 FAX: (248) 473-8190	DDA CITY OF DETROIT DOWNTOWN DEVELOPMENT AUTHORITY 500 Griswold, Suite 2200, Detroit, MI 48228 P: (313) 963-2940 F: (313) 963-8893	M.D.P.H./D.N.R. PERMIT NO.
	DESIGNED BY: LS				REF. NO. DE06001.OT							
	CHECKED BY: BJ,DT				CONTRACT NO.							
	APPROVED BY: DT				FILE NO.							
	REVISIONS				DRAWING NO. ENH-5							