


CONSTRUCTION LEGEND

	Sidewalk, Conc, 4 inch, Modified
	Sidewalk, Conc, 6 inch, Modified
	Integral Curb and Sidewalk, Conc, 4 inch, Modified
	Integral Curb and Sidewalk, Conc, 6 inch, Modified
	Integral Curb and Sidewalk, 2 Feet, Modified
	Conc Pavt, Misc, Nonreinf, 8 inch
	Hand Patching
	Brick Paving, Modified
	LIMITS OF CONSTRUCTION ON CROSS STREET
	PROPERTY LINE

NOTE:
FOR SIDEWALK CONSTRUCTION OVER VAULTS DETAILS SEE SHT # X-1.

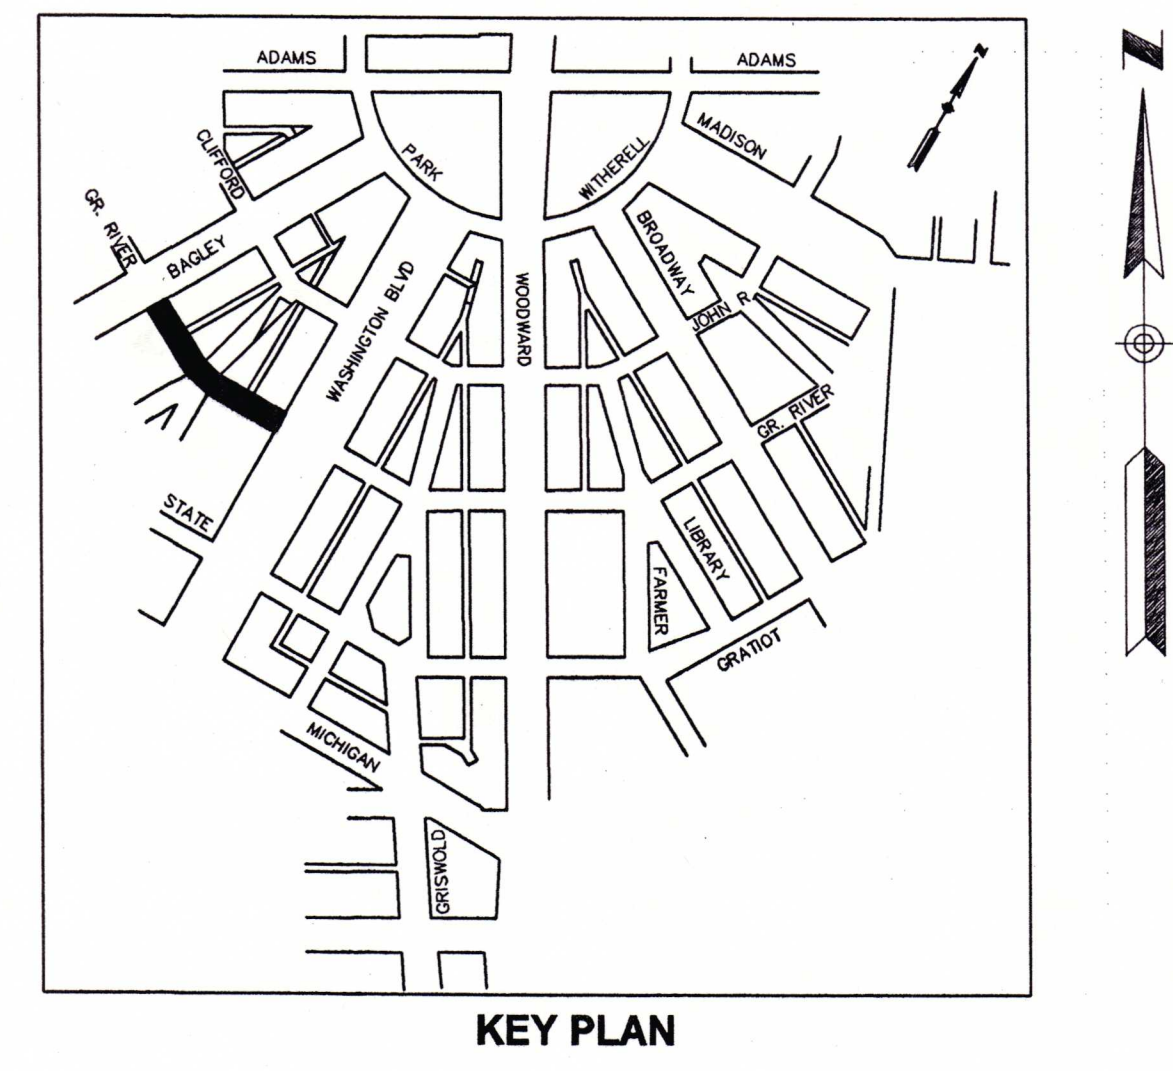

MATCHLINE (STA 907+00) SEE SHT C-9-8

NON PARTICIPATING QUANTITIES, THIS SHEET

PAY ITEM	UNIT	QUANTITY
Integral Curb and Sidewalk, 2 Feet, Modified	Ft	-
Sidewalk, Conc, 4 inch, Modified	Sft	122
Sidewalk, Conc, 6 inch, Modified	Sft	31
Conc Pavt, Misc, Nonreinf, 8 inch, Modified	Syd	23
Hand Patching	Ton	-

AS-BUILT

3 WORKING DAYS BEFORE YOU DIG. CALL MISS DIG. 1-800-482-7171

BASE BID

F				
E				
D				
C				
B				
A				
DESCRIPTION	CHK'D	APP'VD	DATE	
REVISIONS				

DRAWN BY: MW
 DESIGNED BY: KD
 CHECKED BY: MH
 APPROVED BY: MH

LOWER WOODWARD CROSS STREETS IMPROVEMENTS
 CITY OF DETROIT - DOWNTOWN DEVELOPMENT AUTHORITY

CONSTRUCTION PLAN
 GRAND RIVER - BAGLEY TO MATCHLINE (STA 907+00)

SCALE: 1"=20' DATE: 08-28-08

220 W. CONGRESS, SUITE 400
 DETROIT, MI 48226
 PHONE: (313) 967-4700
 FAX: (313) 967-4707
 www.spaldingdetester.com

hamiltonanderson
 Hamilton Anderson Associates
 1435 Renaissance Square
 Detroit, Michigan 48226
 P: 313 964 0270 F: 313 964 0170
 www.hamilton-anderson.com

16580 Wyoming Avenue
 DETROIT, MI 48221-2882
 PHONE: (313) 341-5797
 FAX: (313) 341-0205
 www.consulteng.com

20349 Alerton Street, Suite 200
 DETROIT, MI 48219-5556
 PHONE: (313) 434-8282
 FAX: (313) 537-7945
 www.urbcengineering.com

480 Ford Field, 2000 Brush Street
 Detroit, MI 48226
 PHONE: (313) 237-3900
 FAX: (313) 237-2909
 www.nhconsultants.com

33608 Grand River
 Farmington, MI 48335
 PHONE: (248) 473-7070
 FAX: (248) 473-8190

DDA CITY OF DETROIT
 DOWNTOWN DEVELOPMENT AUTHORITY

500 Griswold, Suite 2200,
 Detroit, MI 48226
 P: (313) 963-2940
 F: (313) 963-8893

SECTION MAP	TOWN	RANGE	SECTION	PORTION CODE
- - - - -	- - - - -	- - - - -	- - - - -	- - - - -

M.D.P.H./D.N.R. PERMIT NO.
 REF. NO. DE06001.OT
 CONTRACT NO.
 FILE NO.
 DRAWING NO. C-9-7