


ENHANCEMENTS LEGEND


- MATCH LINE
- INTEGRAL CURB AND SIDEWALK, CONC, 4" MODIFIED
- INTEGRAL CURB AND SIDEWALK, CONC, 6" MODIFIED
- INTEGRAL CURB AND SIDEWALK, CONC, FIBERGLASS REINF, 4" MODIFIED
- STAINED CONCRETE NEW PAVEMENT, MODIFIED
- STAINED CONCRETE EXISTING PAVEMENT, MODIFIED
- PROPOSED CONTROL JOINT
- PROPOSED EXPANSION JOINT
- EXISTING CONTROL JOINT

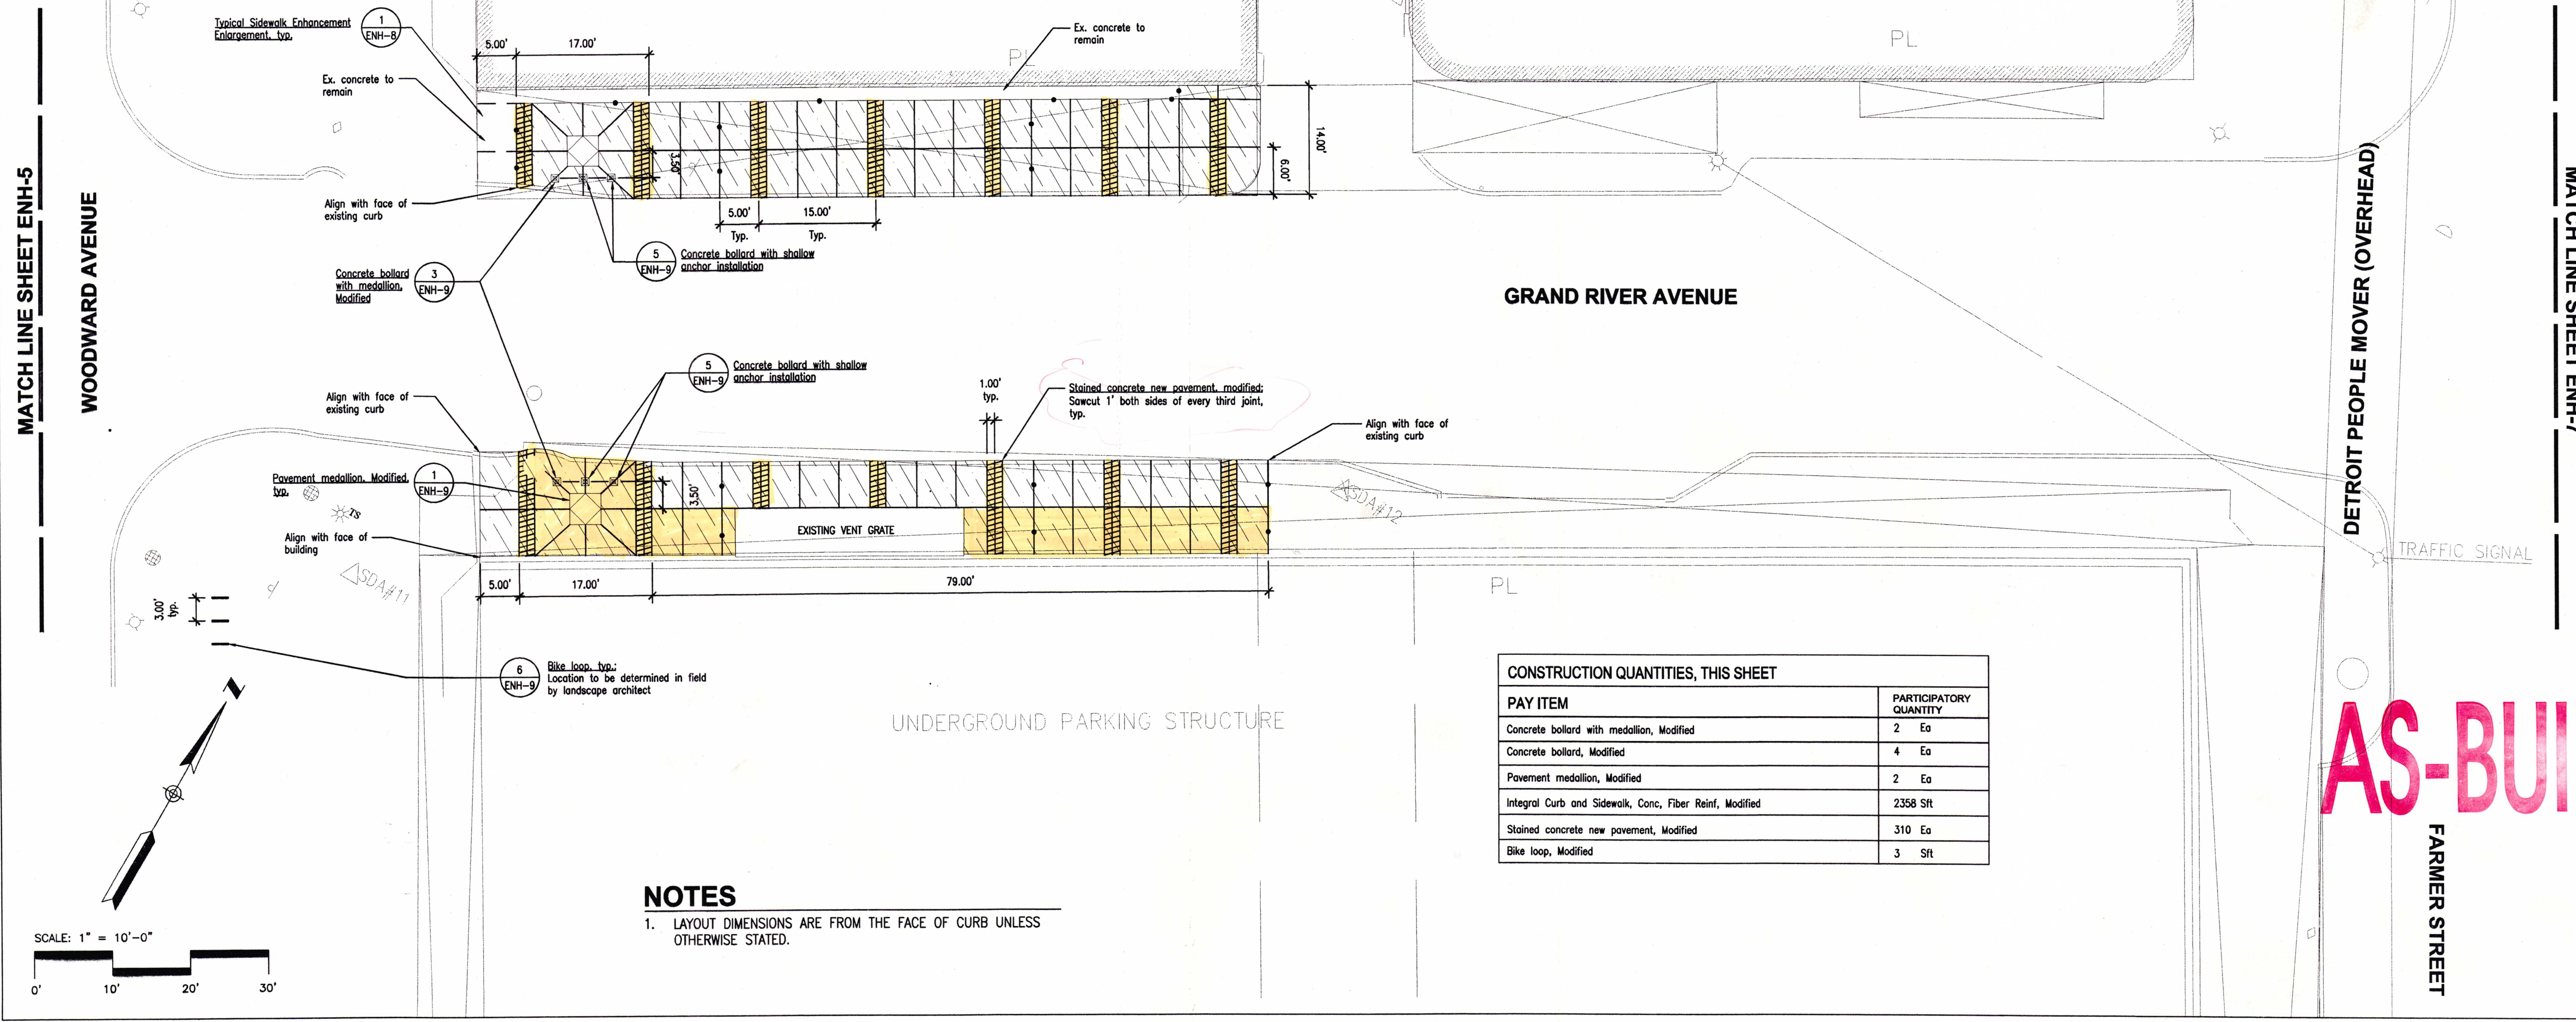

CONSTRUCTION QUANTITIES, THIS SHEET	
PAY ITEM	PARTICIPATORY QUANTITY
Concrete bollard with medallion, Modified	2 Ea
Concrete bollard, Modified	4 Ea
Pavement medallion, Modified	2 Ea
Integral Curb and Sidewalk, Conc, Fiber Reinf, Modified	2358 Sft
Stained concrete new pavement, Modified	310 Ea
Bike loop, Modified	3 Sft

NOTES

- LAYOUT DIMENSIONS ARE FROM THE FACE OF CURB UNLESS OTHERWISE STATED.

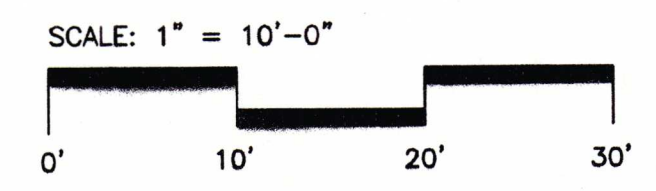

F E D C B A	DESCRIPTION	CHK'D	APP'D	DATE	DRAWN BY: MS DESIGNED BY: LS CHECKED BY: BJD APPROVED BY: DT	LOWER WOODWARD CROSS STREETS IMPROVEMENTS CITY OF DETROIT- DOWNTOWN DEVELOPMENT AUTHORITY PROPOSED PLAN GRAND RIVER - WOODWARD TO FARMER SCALE: 1"=10'	220 W. CONGRESS, SUITE 400 DETROIT, MI 48226 PHONE: (313) 387-4700 FAX: (313) 967-4707 www.hamiltonanderson.com	Consulting Engineering Associates, Inc. 16580 Wyoming Avenue, DETROIT, MI 48221-2882 PHONE: (313) 341-5797 FAX: (313) 341-0205 www.consulteng.com	20349 Alden Street, Suite 200 P.O. Box 19550 DETROIT, MI 48219-9550 PHONE: (313) 434-8282 FAX: (313) 537-7945 www.urbanengineering.com	500 Griswold, Suite 2200, Detroit, MI 48228 P: (313) 963-2940 F: (313) 963-8893	M.D.P.H./D.N.R. PERMIT NO. REF. NO. DE06001.OT CONTRACT NO. FILE NO. DRAWING NO. ENH-6
	REVISIONS										

AS-BUILT