
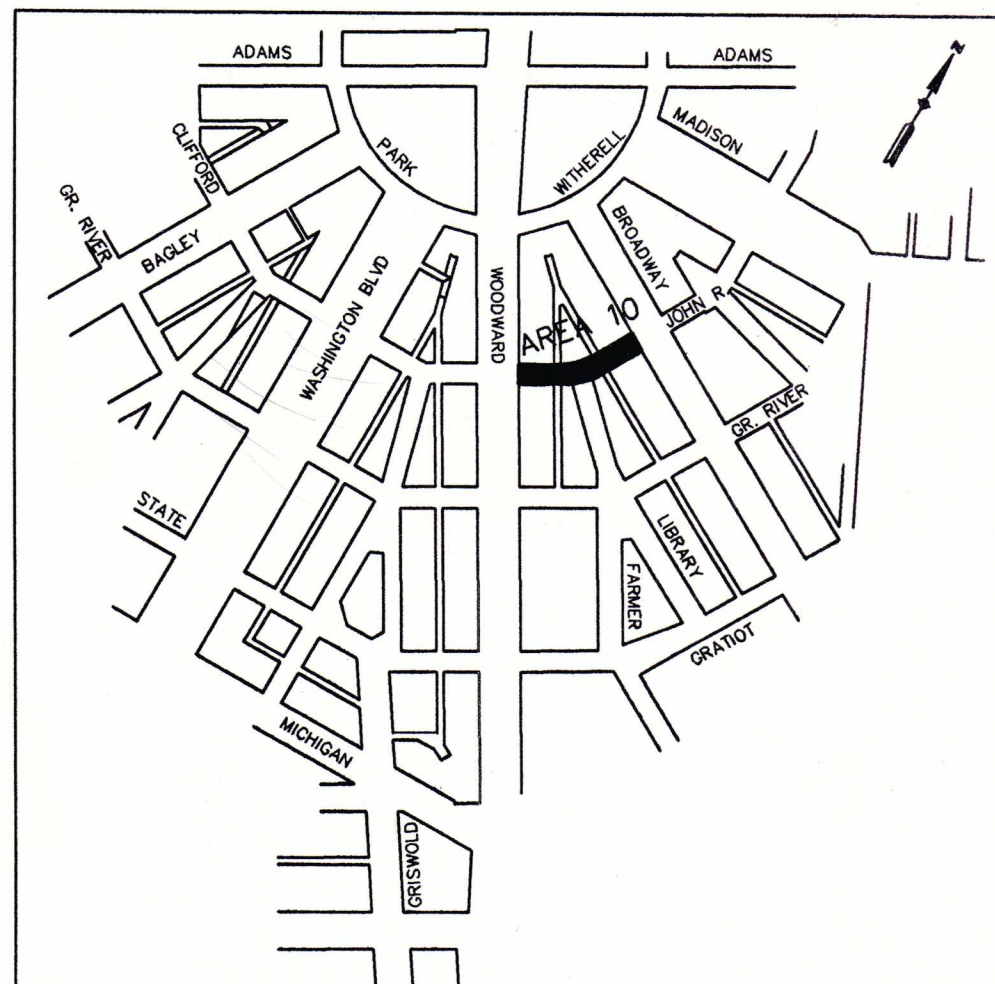
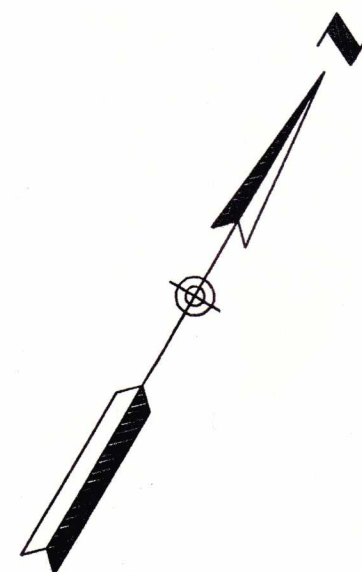


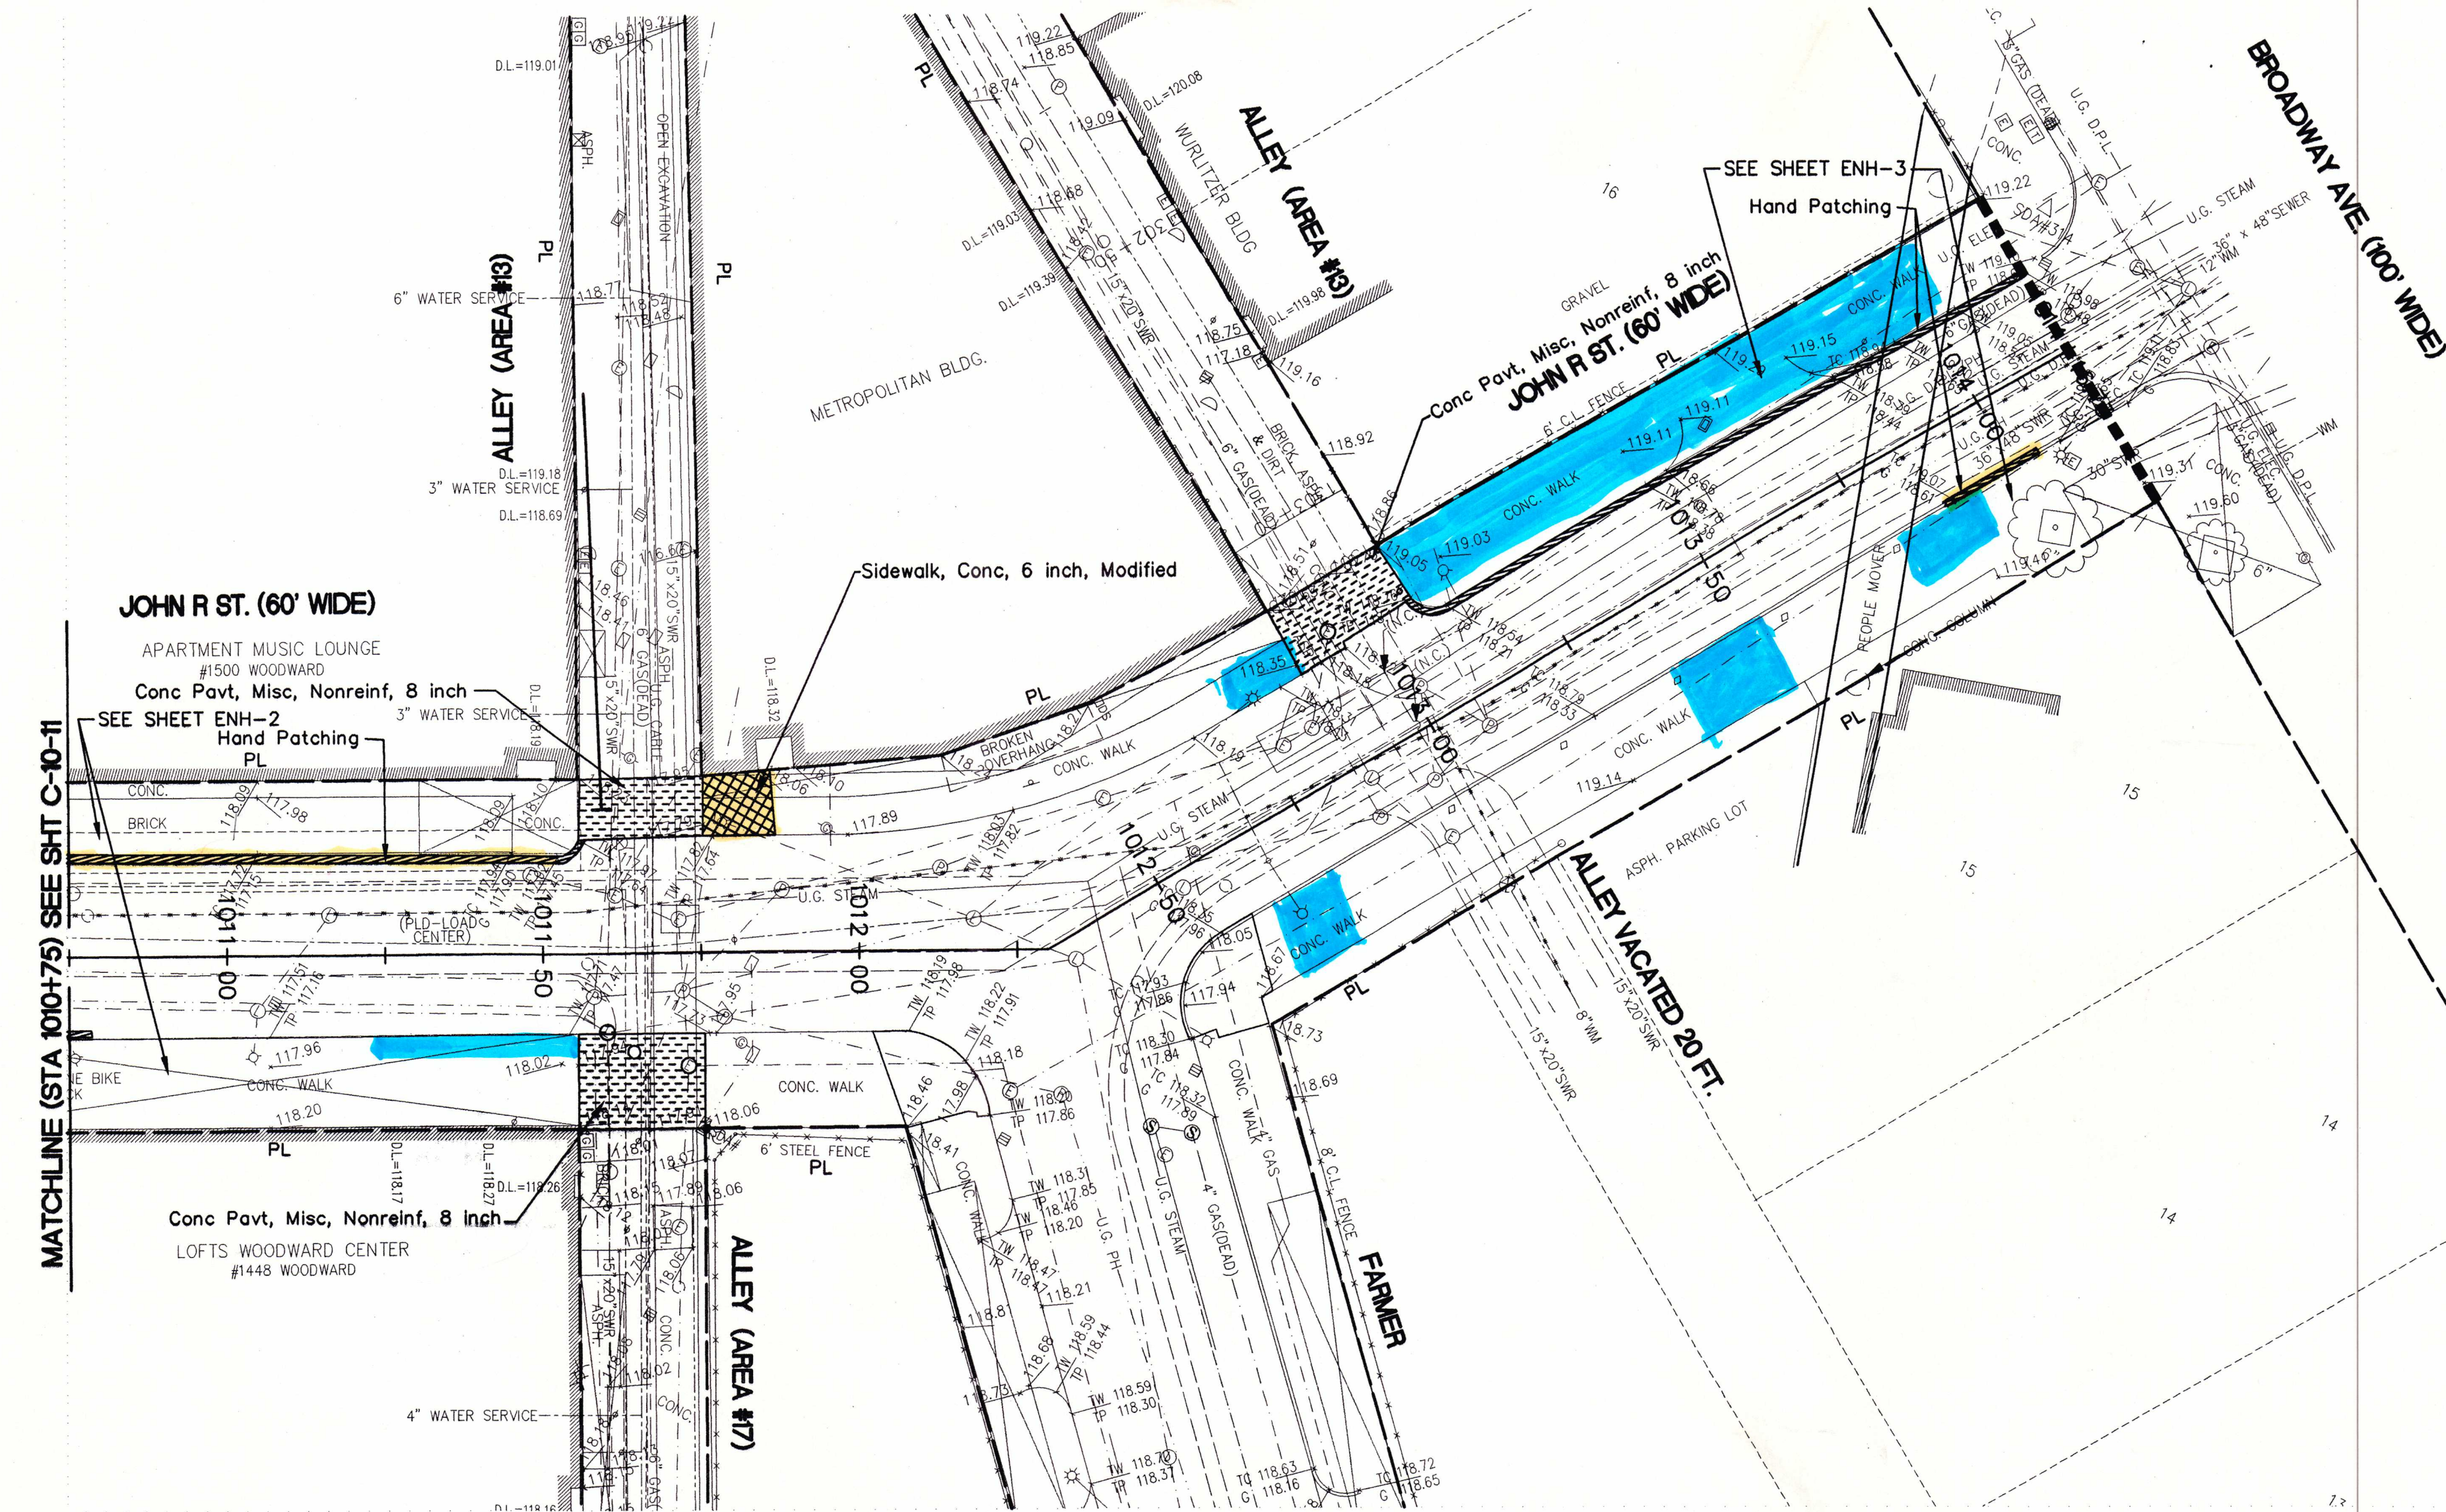

KEY PLAN

CONSTRUCTION LEGEND

- Sidewalk, Conc, 4 inch, Modified
- Sidewalk, Conc, 6 inch, Modified
- Integral Curb and Sidewalk, Conc, 4 inch, Modified
- Integral Curb and Sidewalk, Conc, 6 inch, Modified
- Integral Curb and Sidewalk, 2 Feet, Modified
- Conc Pavt, Misc, Nonrein, 8 inch
- Hand Patching
- Brick Paving, Modified
- LIMITS OF CONSTRUCTION ON CROSS STREET
- PROPERTY LINE

NOTE:
FOR SIDEWALK CONSTRUCTION OVER
VAULTS DETAILS SEE SHT # X-1.

PARTICIPATING QUANTITIES, THIS SHEET		
PAY ITEM	UNIT	QUANTITY
Integral Curb and Sidewalk, 2 Feet, Modified	Ft	-
Sidewalk, Conc, 4 inch, Modified	Sft	-
Sidewalk, Conc, 6 inch, Modified	Sft	110
Conc Pavt, Misc, Nonrein, 8 inch, Modified	Syd	77
Hand Patching	Ton	5

AS-BUILT

3 WORKING DAYS
BEFORE YOU DIG
CALL MISS DIG.
1-800-482-7171
For the location of public utility lines

BASE BID

F					DRAWN BY: MW	 220 W. CONGRESS, SUITE 400 DETROIT, MI 48226 PHONE: (313) 967-4700 FAX: (313) 967-4707 www.hamilton-anderson.com	 16580 Wyoming Avenue, DETROIT, MI 48221-2882 PHONE: (313) 341-3797 FAX: (313) 341-0205 www.consulting.com	 20349 Alderton Street, Suite 200 DETROIT, MI 48219-9550 PHONE: (313) 434-8282 FAX: (313) 537-7945 www.urbanengineeringolutions.com	 CITY OF DETROIT DOWNTOWN DEVELOPMENT AUTHORITY 500 Griswold, Suite 2200, Detroit, MI 48226 P: (313) 963-2940 F: (313) 963-8893	M.D.P.H./D.N.R. PERMIT NO.	
E				DESIGNED BY: KD	REF. NO. DE060010T						
D				CHECKED BY: MH	CONTRACT NO.						
C				APPROVED BY: MH	FILE NO.						
B					DRAWING NO. C-10-12						
A											
DESCRIPTION		CHK'D	APVD	DATE							
REVISIONS											

LOWER WOODWARD CROSS STREETS IMPROVEMENTS
CITY OF DETROIT - DOWNTOWN DEVELOPMENT AUTHORITY

CONSTRUCTION PLAN
JOHN R. (NORTH + SOUTH) - MATCHLINE G-G TO BROADWAY

SCALE: 1"=20'

DATE: 08-28-08