




CONSTRUCTION LEGEND

- NOTE:
FOR SIDEWALK CONSTRUCTION OVER
VAULTS DETAILS SEE SHT # X-1.

AS-BUILT

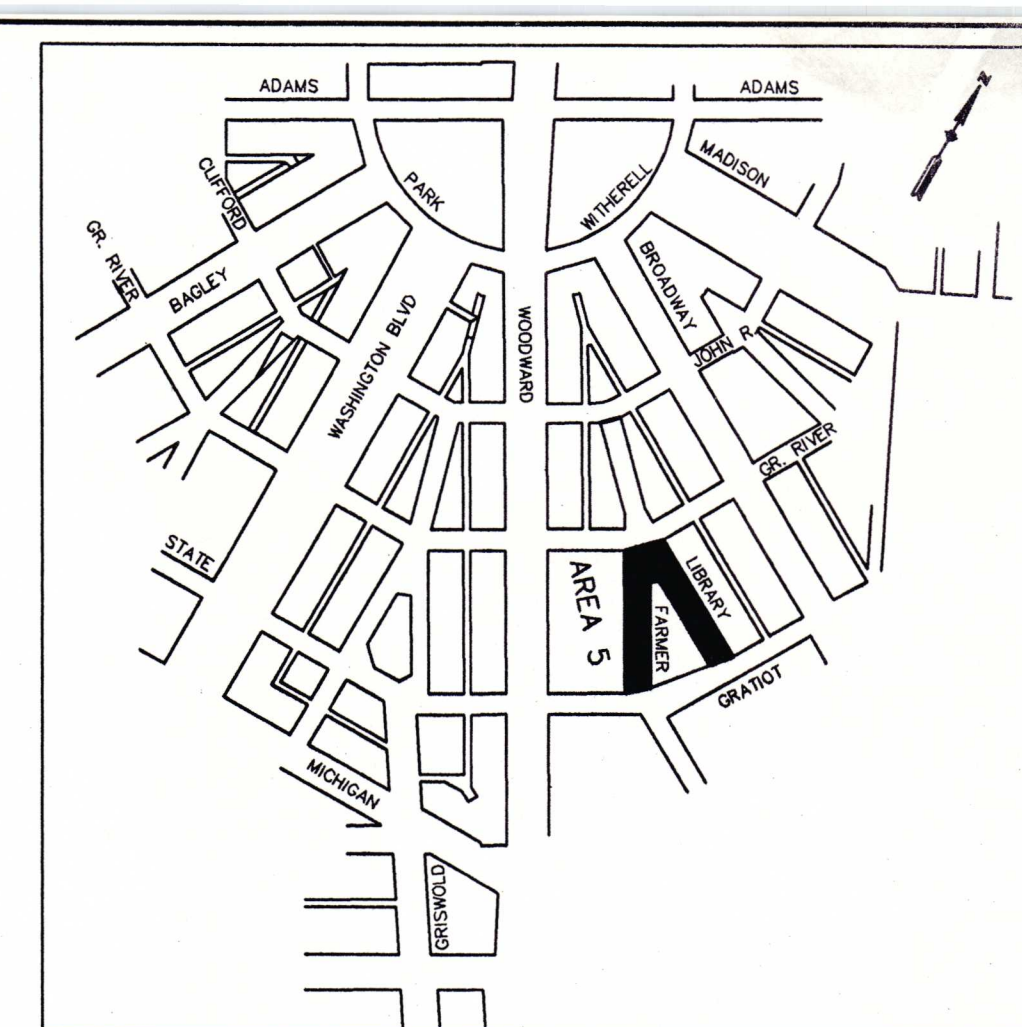

BASE BID

E D C B A					DRAWN BY: MW	 220 W. CONGRESS, SUITE 400 DETROIT, MI 48226 PHONE: (313) 967-4700 FAX: (313) 967-4700 www.spaldingdecker.com  16580 Warming Avenue, DETROIT, MI 48221-2882 PHONE: (313) 541-5477 FAX: (313) 541-0205 www.consultang.com  20349 Adamson Street, Suite 200 DETROIT, MI 48219-9550 PHONE: (313) 434-6282 P: (313) 537-7845 www.urbonengineeringolutions.com  480 Ford Field, 2000 Brush Street Detroit, MI 48226 PHONE: (313) 237-3900 FAX: (313) 237-3909 www.rthiconsultants.com  Manzell Associates, INC. Farmington, MI 48335 PHONE: (248) 473-7070 FAX: (248) 473-8190	 CITY OF DETROIT DOWNTOWN DEVELOPMENT AUTHORITY 500 Griswold, Suite 2200, Detroit, MI 48228 P: (313) 963-2940 F: (313) 963-8893	M.D.P./D.N.R. PERMIT NO.
					DESIGNED BY: KD			REF. NO.
					CHECKED BY: MH			CONTRACT NO.
					APPROVED BY: MH			FILE NO.
	DESCRIPTION	CHK'D	APP'VD	DATE	CONSTRUCTION PLAN LIBRARY/FARMER (EAST + WEST) - MATCHLINE (STA 503+00) TO GRATIOT SCALE: 1"=20' DATE: 08-28-08	SECTION MAP TOWN RANGE SECTION PORTION CODE C-5, 6-3		