



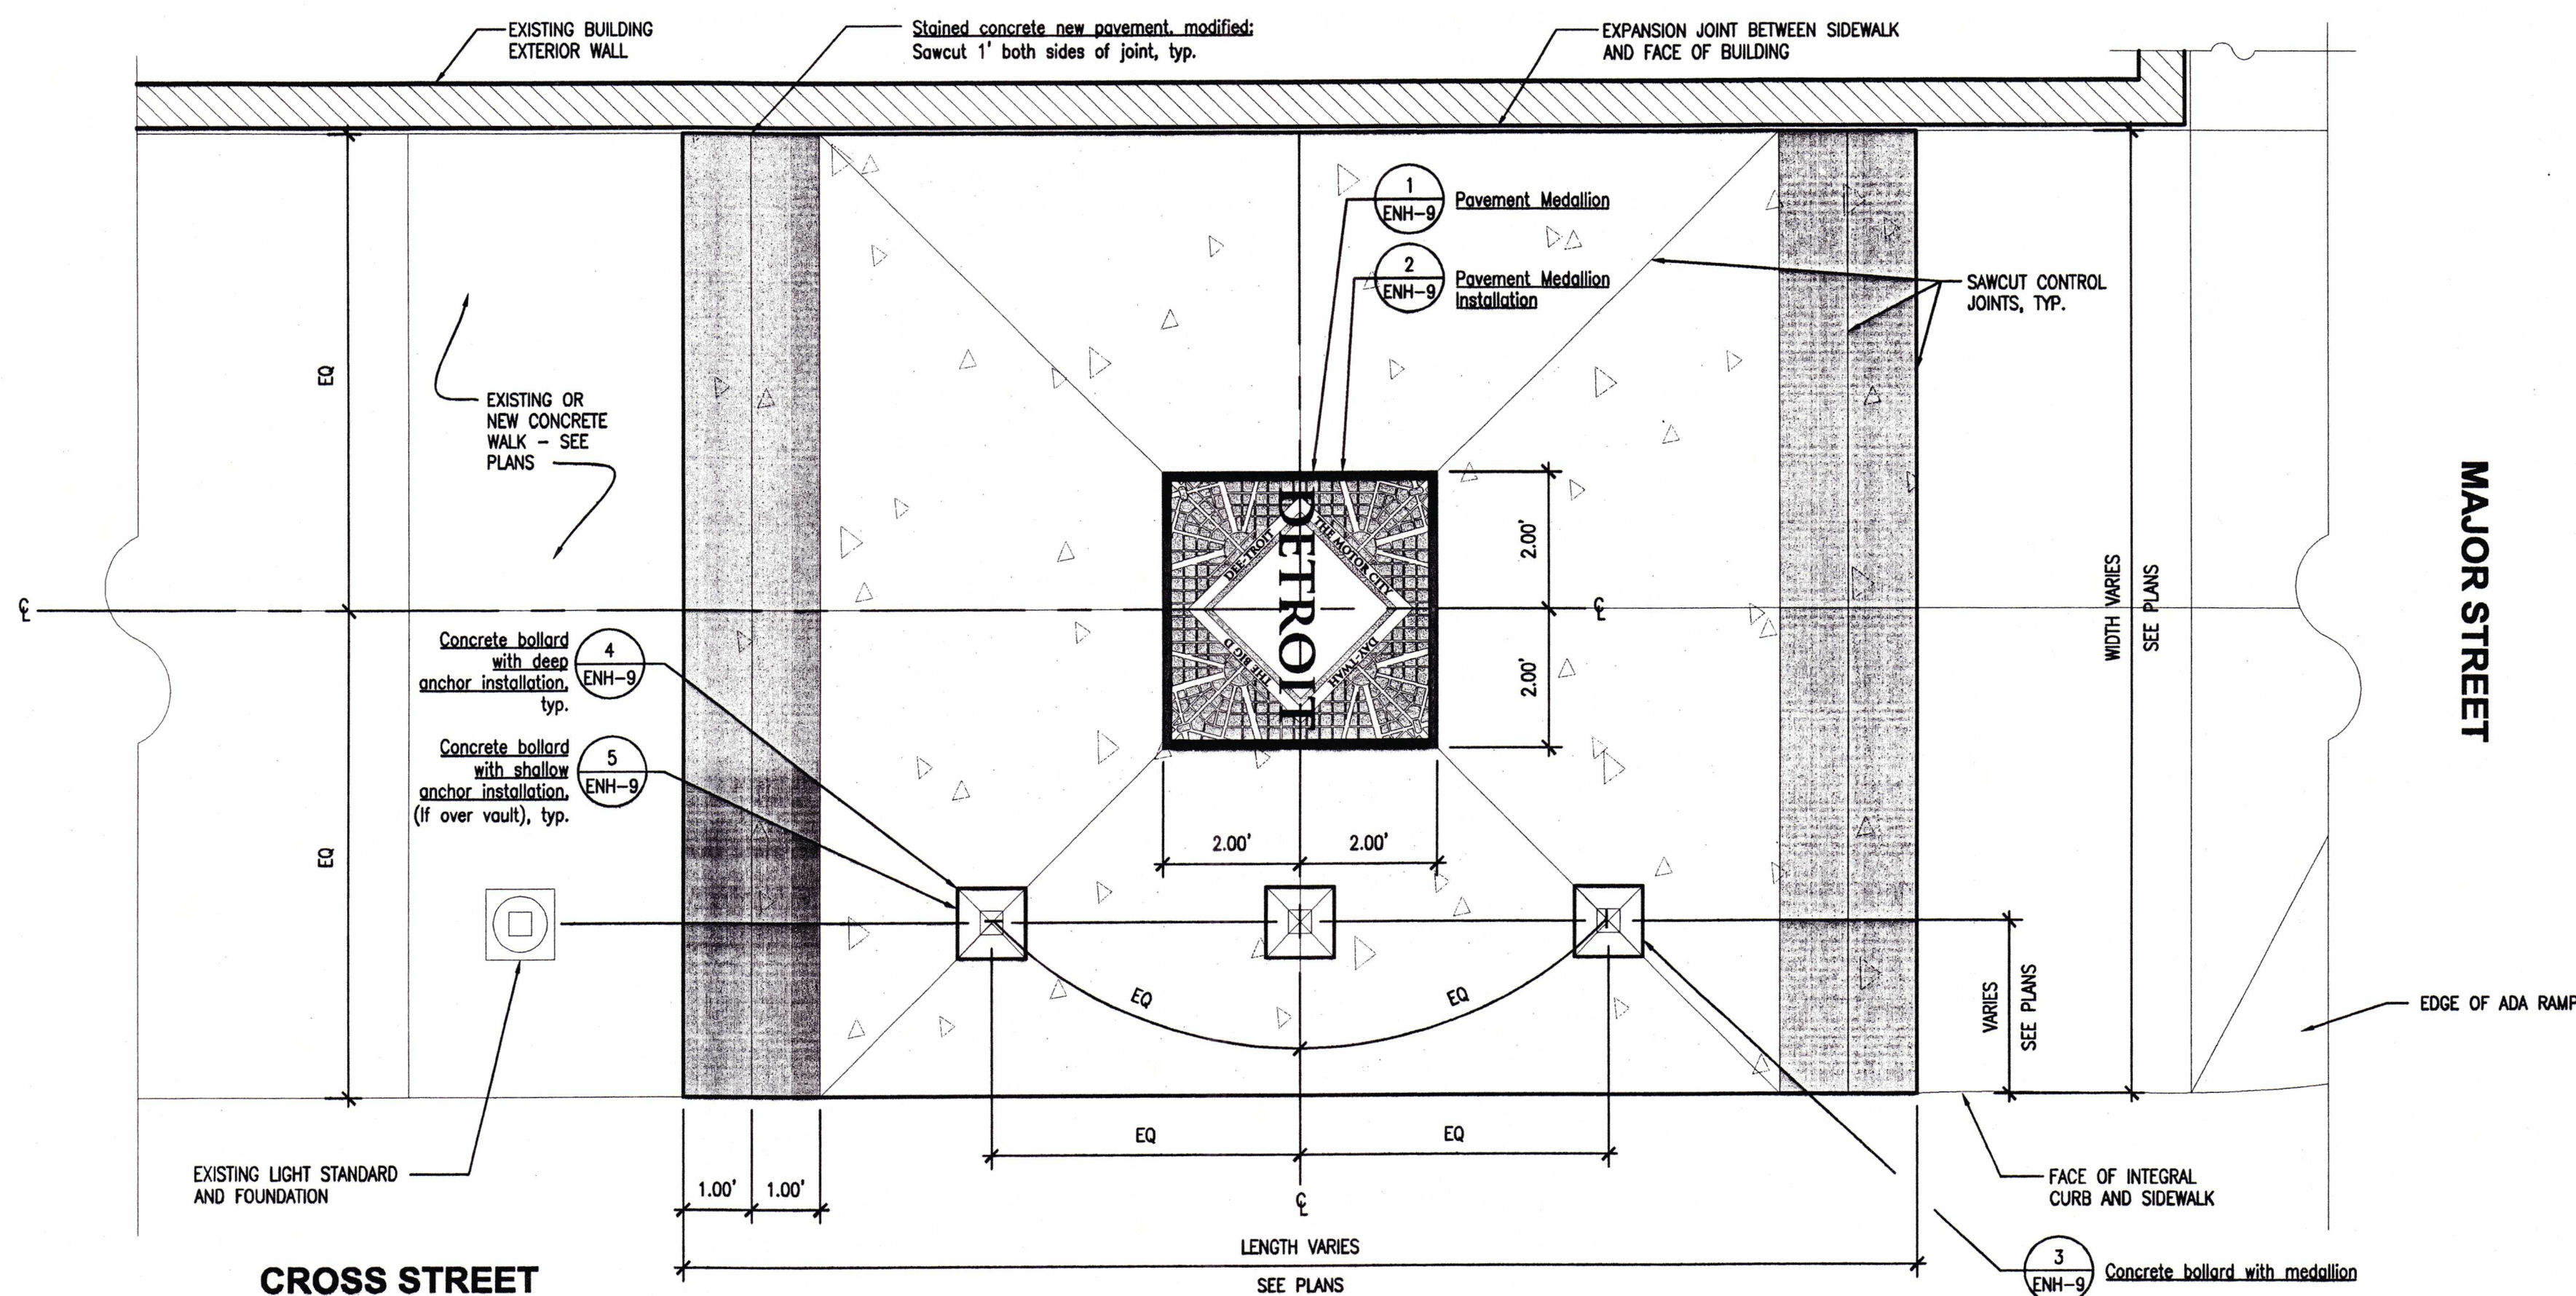

CROSS STREET

1 TYPICAL SIDEWALK ENHANCEMENT ENLARGEMENT
ENH-8 SCALE: 1/2"=1'-0"

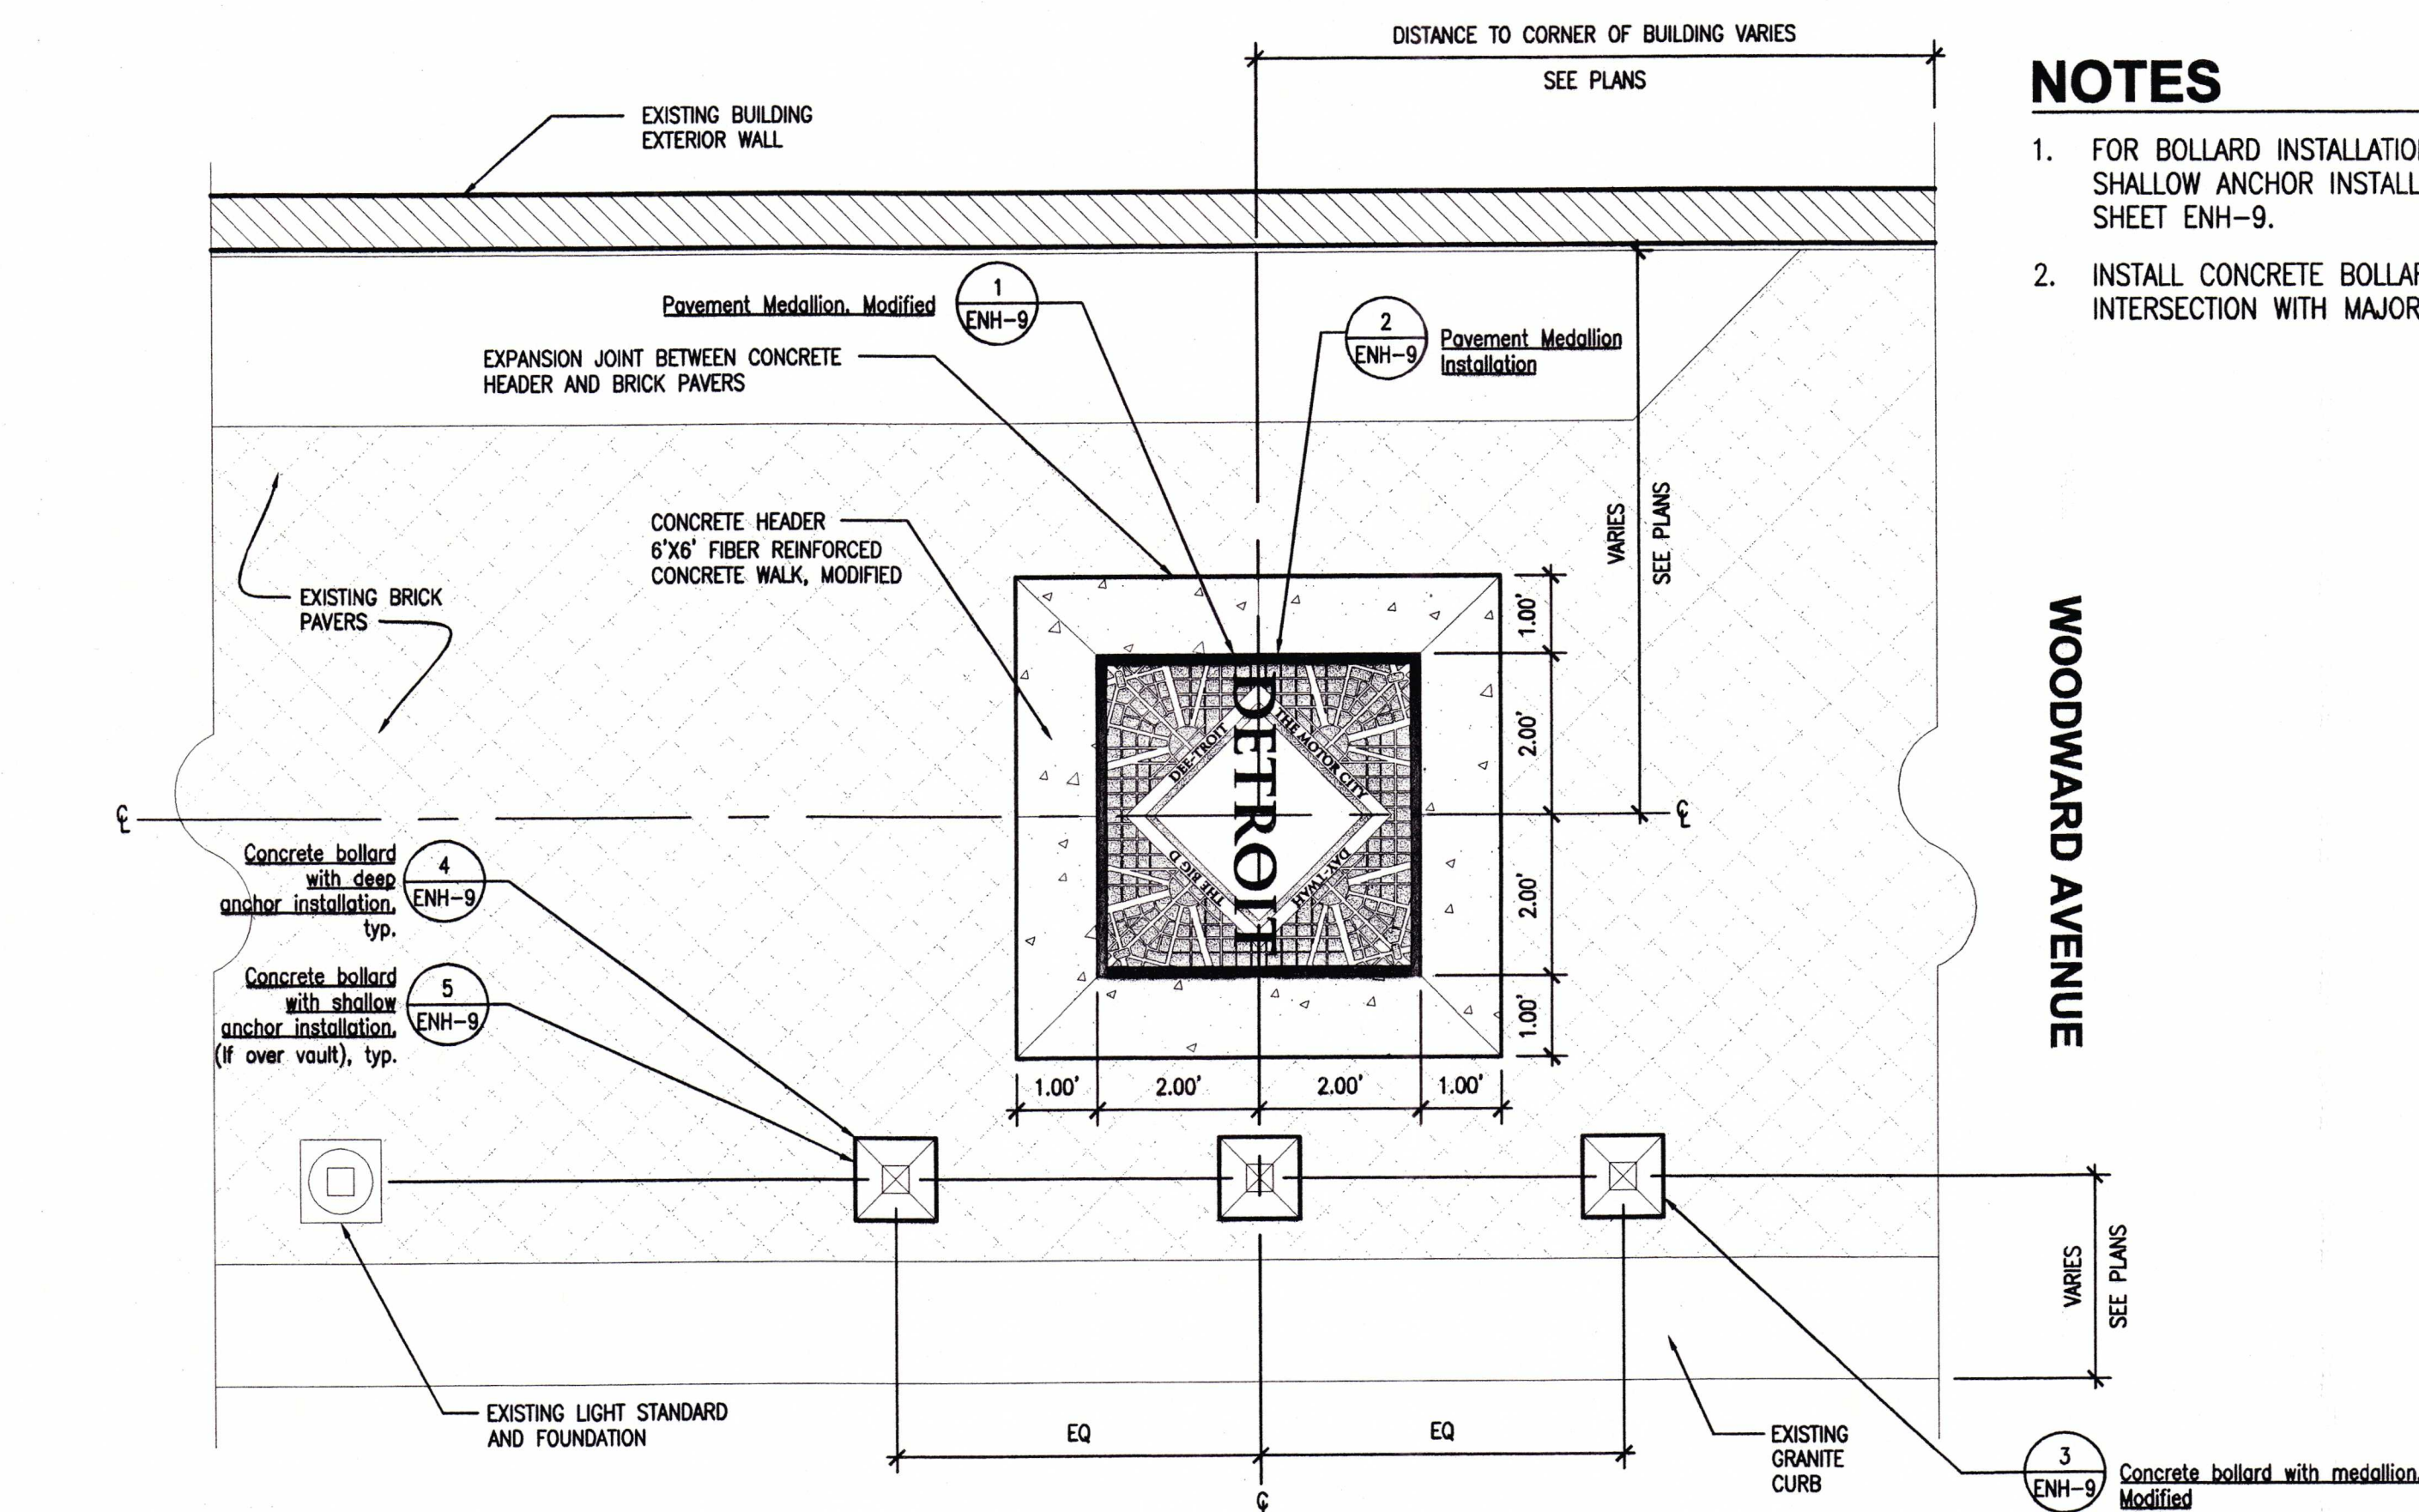


2 TYPICAL SIDEWALK ENHANCEMENT WITH HEADER
ENH-8 SCALE: 1/2"=1'-0"


NOTES

- FOR BOLLARD INSTALLATIONS OVER VAULT SPACES, USE SHALLOW ANCHOR INSTALLATION AS SHOWN IN DRAWING 5, SHEET ENH-9.
- INSTALL CONCRETE BOLLARD WITH MEDALLION CLOSEST TO INTERSECTION WITH MAJOR STREET AS SHOWN IN PLANS.

WOODWARD AVENUE

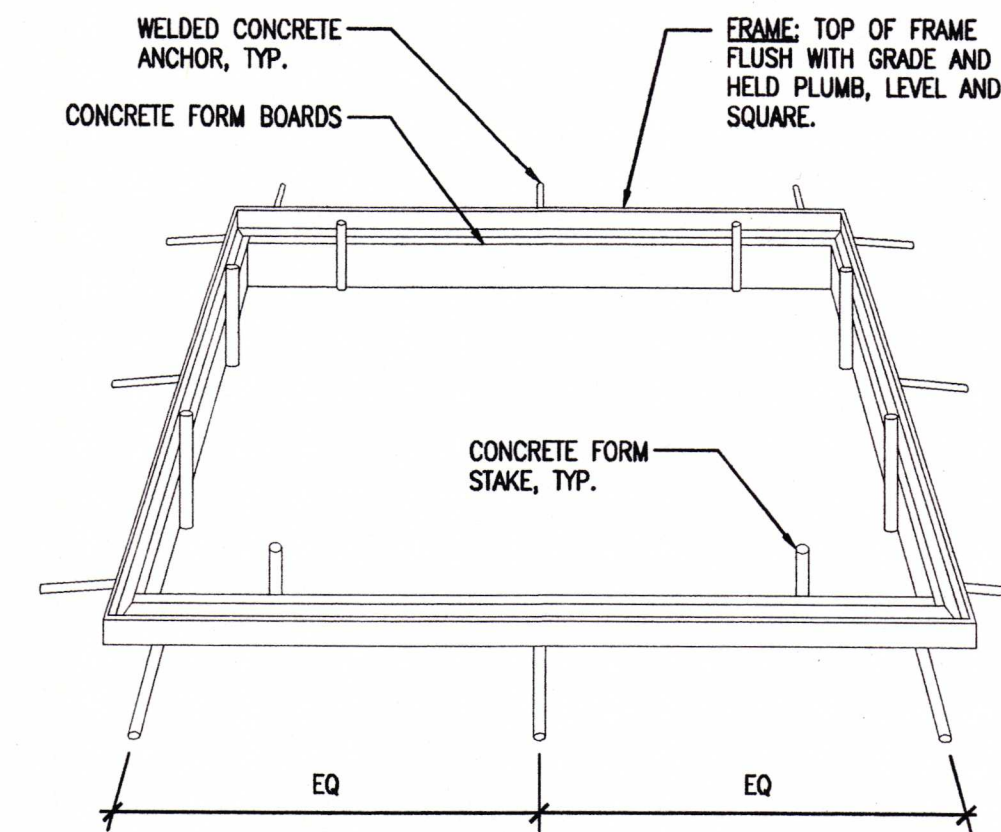


5 TREE GRATE FRAME
ENH-8 NTS

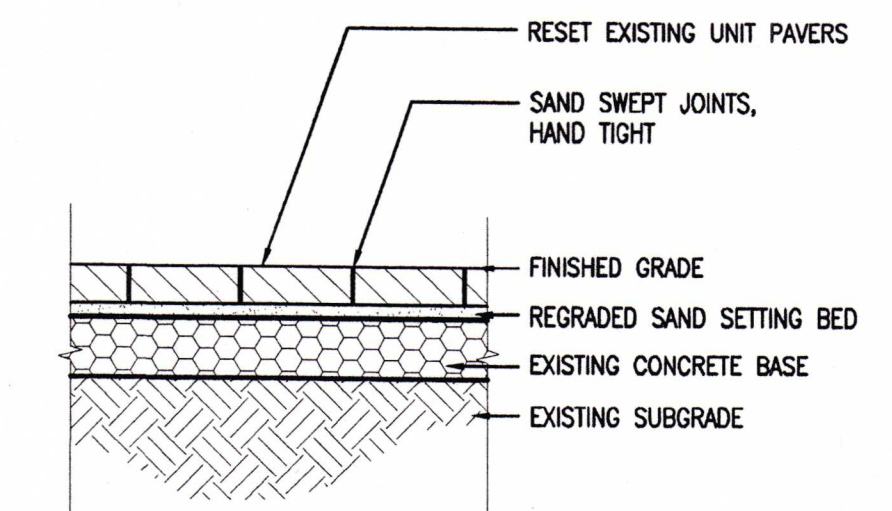


NOTES:
REGRADE EXISTING SAND SETTING BED TO ELIMINATE HIGH AND LOW SPOTS.


6 BRICK PAVER RESETTING @ CAPITOL PARK
ENH-8 1"=1'-0"

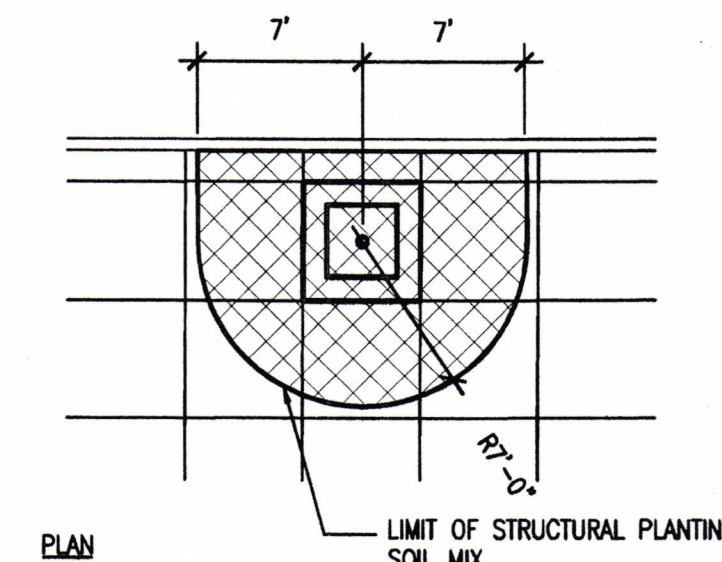

PLAN

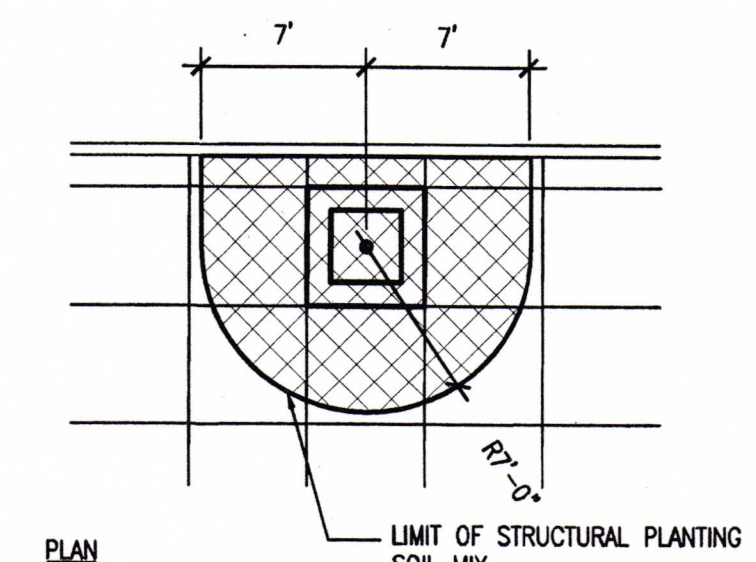


PLAN

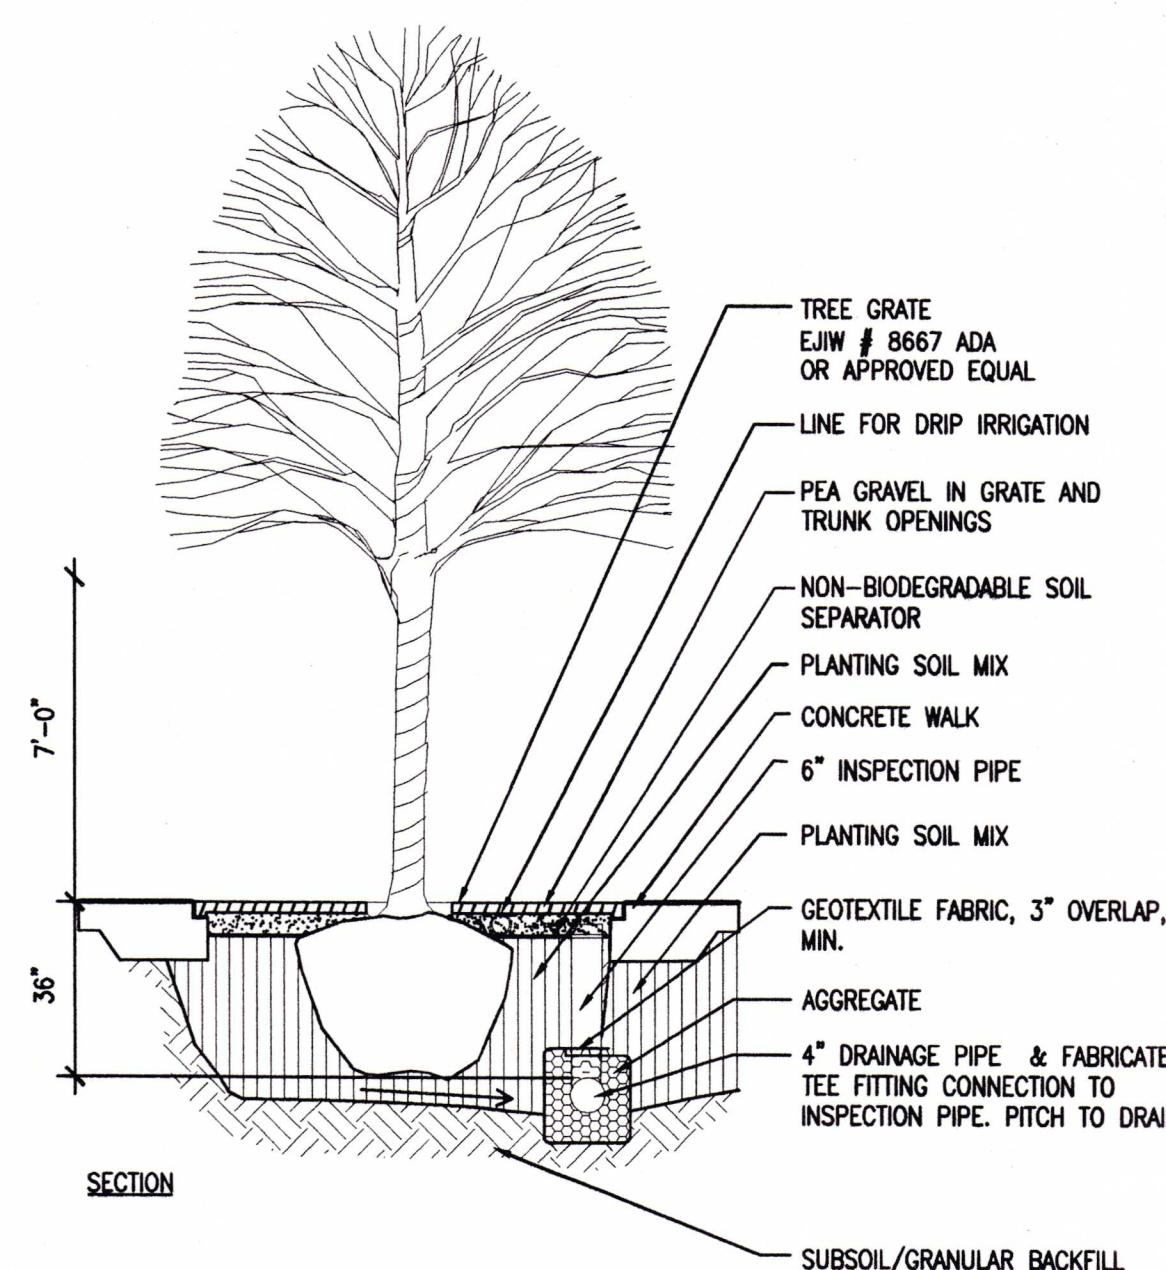

SECTION

3 TREE IN GRATE
ENH-8 NTS

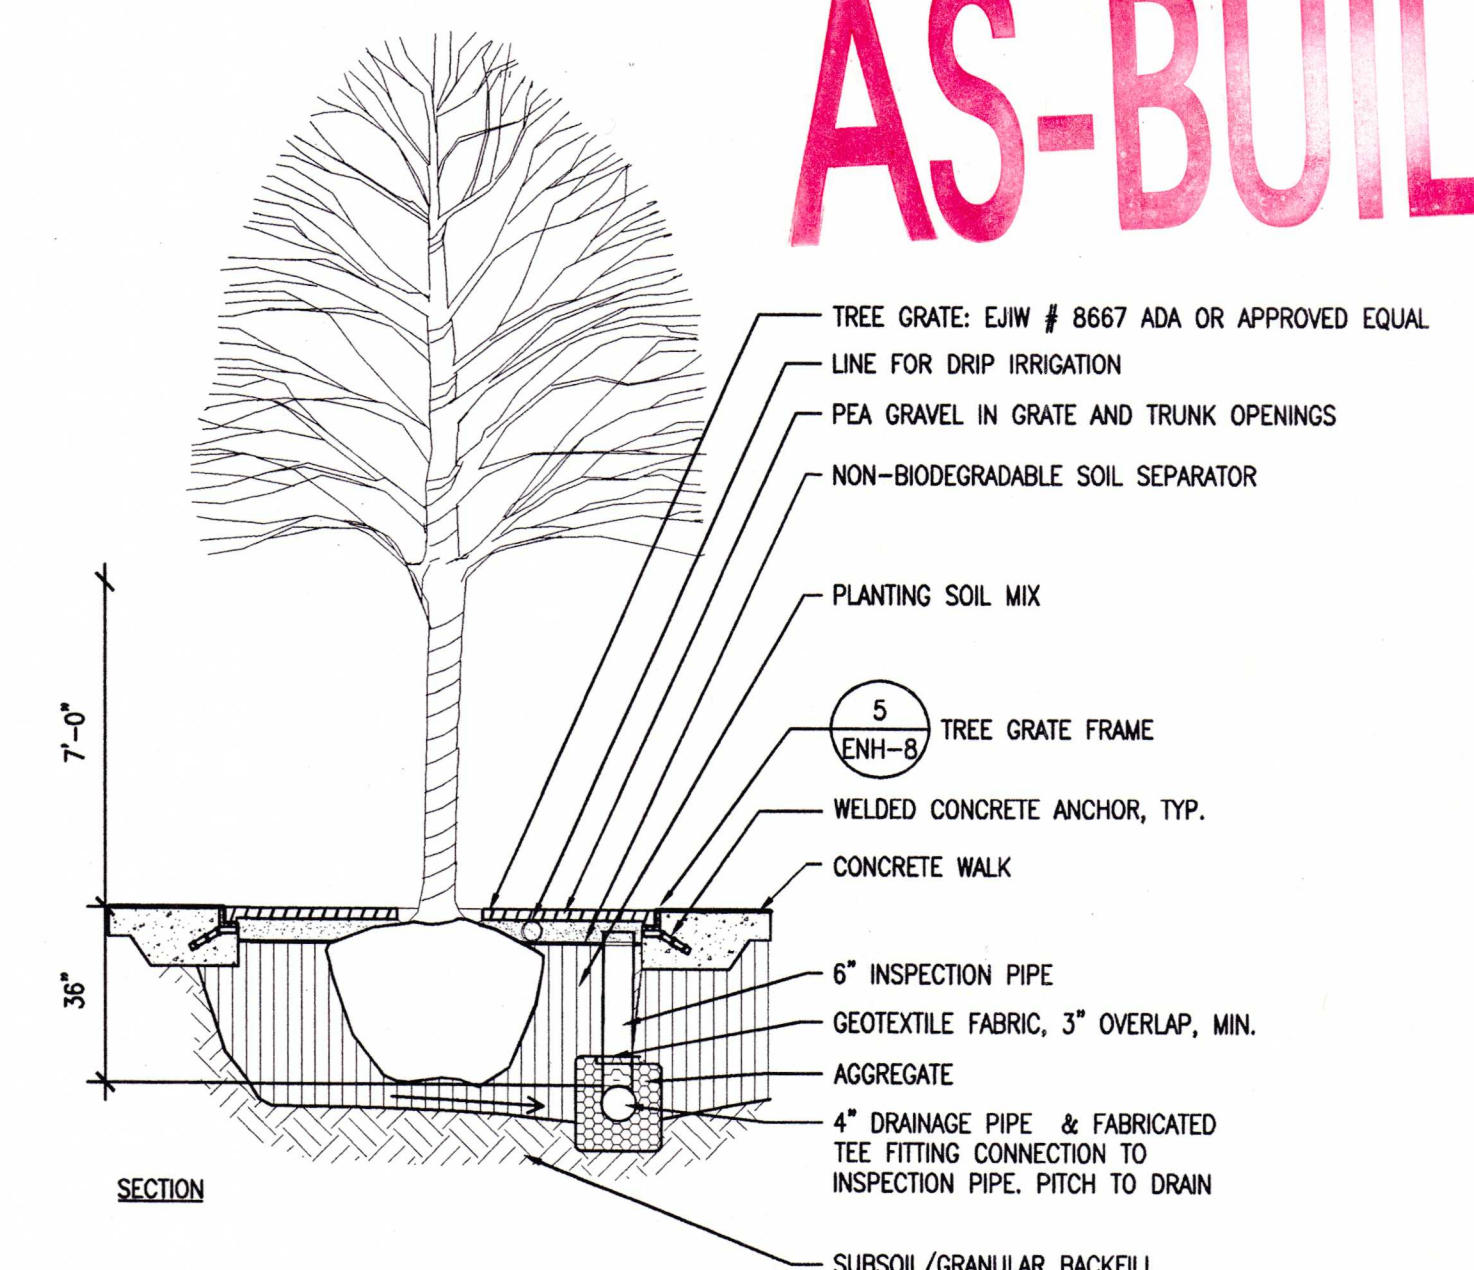

SECTION

4 TREE IN GRATE WITH FRAME
ENH-8 NTS

AS-BUILT

F					DRAWN BY: MS
E					DESIGNED BY: LS
D					CHECKED BY: BJD/T
C					APPROVED BY: DT
B					
A					
DESCRIPTION		CHK'D	APP'D	DATE	
REVISIONS					

LOWER WOODWARD CROSS STREETS IMPROVEMENTS
CITY OF DETROIT- DOWNTOWN DEVELOPMENT AUTHORITY

**ENHANCEMENT
CONSTRUCTION DETAILS**

SCALE: AS SHOWN

DATE: 11-15-07

220 W. CONGRESS, SUITE 400
DETROIT, MI 48226
PHONE: (313) 967-4700
FAX: (313) 967-4707
www.apdindesign.com

Hamilton Anderson Associates

480 Ford Field, 2000 Brush Street
Detroit, MI 48226
PHONE: (313) 237-3948
FAX: (313) 237-3909
www.ntriconsultants.com

16580 Wyoming Avenue,
DETROIT, MI 48221-2882
PHONE: (313) 341-5797
FAX: (313) 341-0205
www.consolideng.com

UES

20349 Alabon Street, Suite 200
P.O. Box 19050
DETROIT, MI 48219-9550
PHONE: (313) 434-6282
FAX: (313) 537-7945
www.urboengineering.com

MANSSELL

Mansell Associates, Inc.
33608 Grand River
Farmington, MI 48335
PHONE: (248) 473-7070
FAX: (248) 473-8190

DDA

**CITY OF DETROIT
DOWNTOWN DEVELOPMENT AUTHORITY**

500 Griswold, Suite 2200,
Detroit, MI 48228
P: (313) 963-2940
F: (313) 963-8893

SECTION MAP	TOWN	RANGE	SECTION	PORTION CODE
-	-	-	-	-

M.D.P.H./D.N.R. PERMIT NO.
REF. NO. DE06001.0T
CONTRACT NO.
FILE NO.
DRAWING NO. ENH-8