
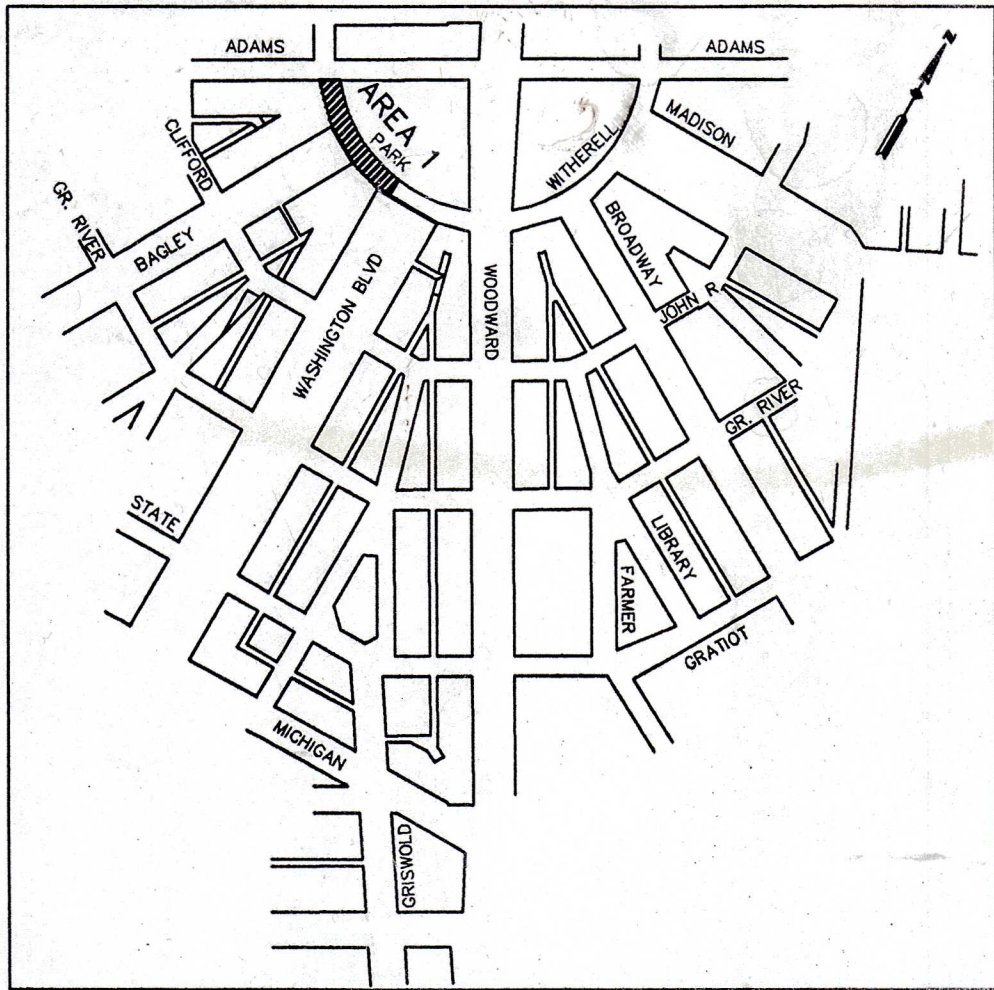


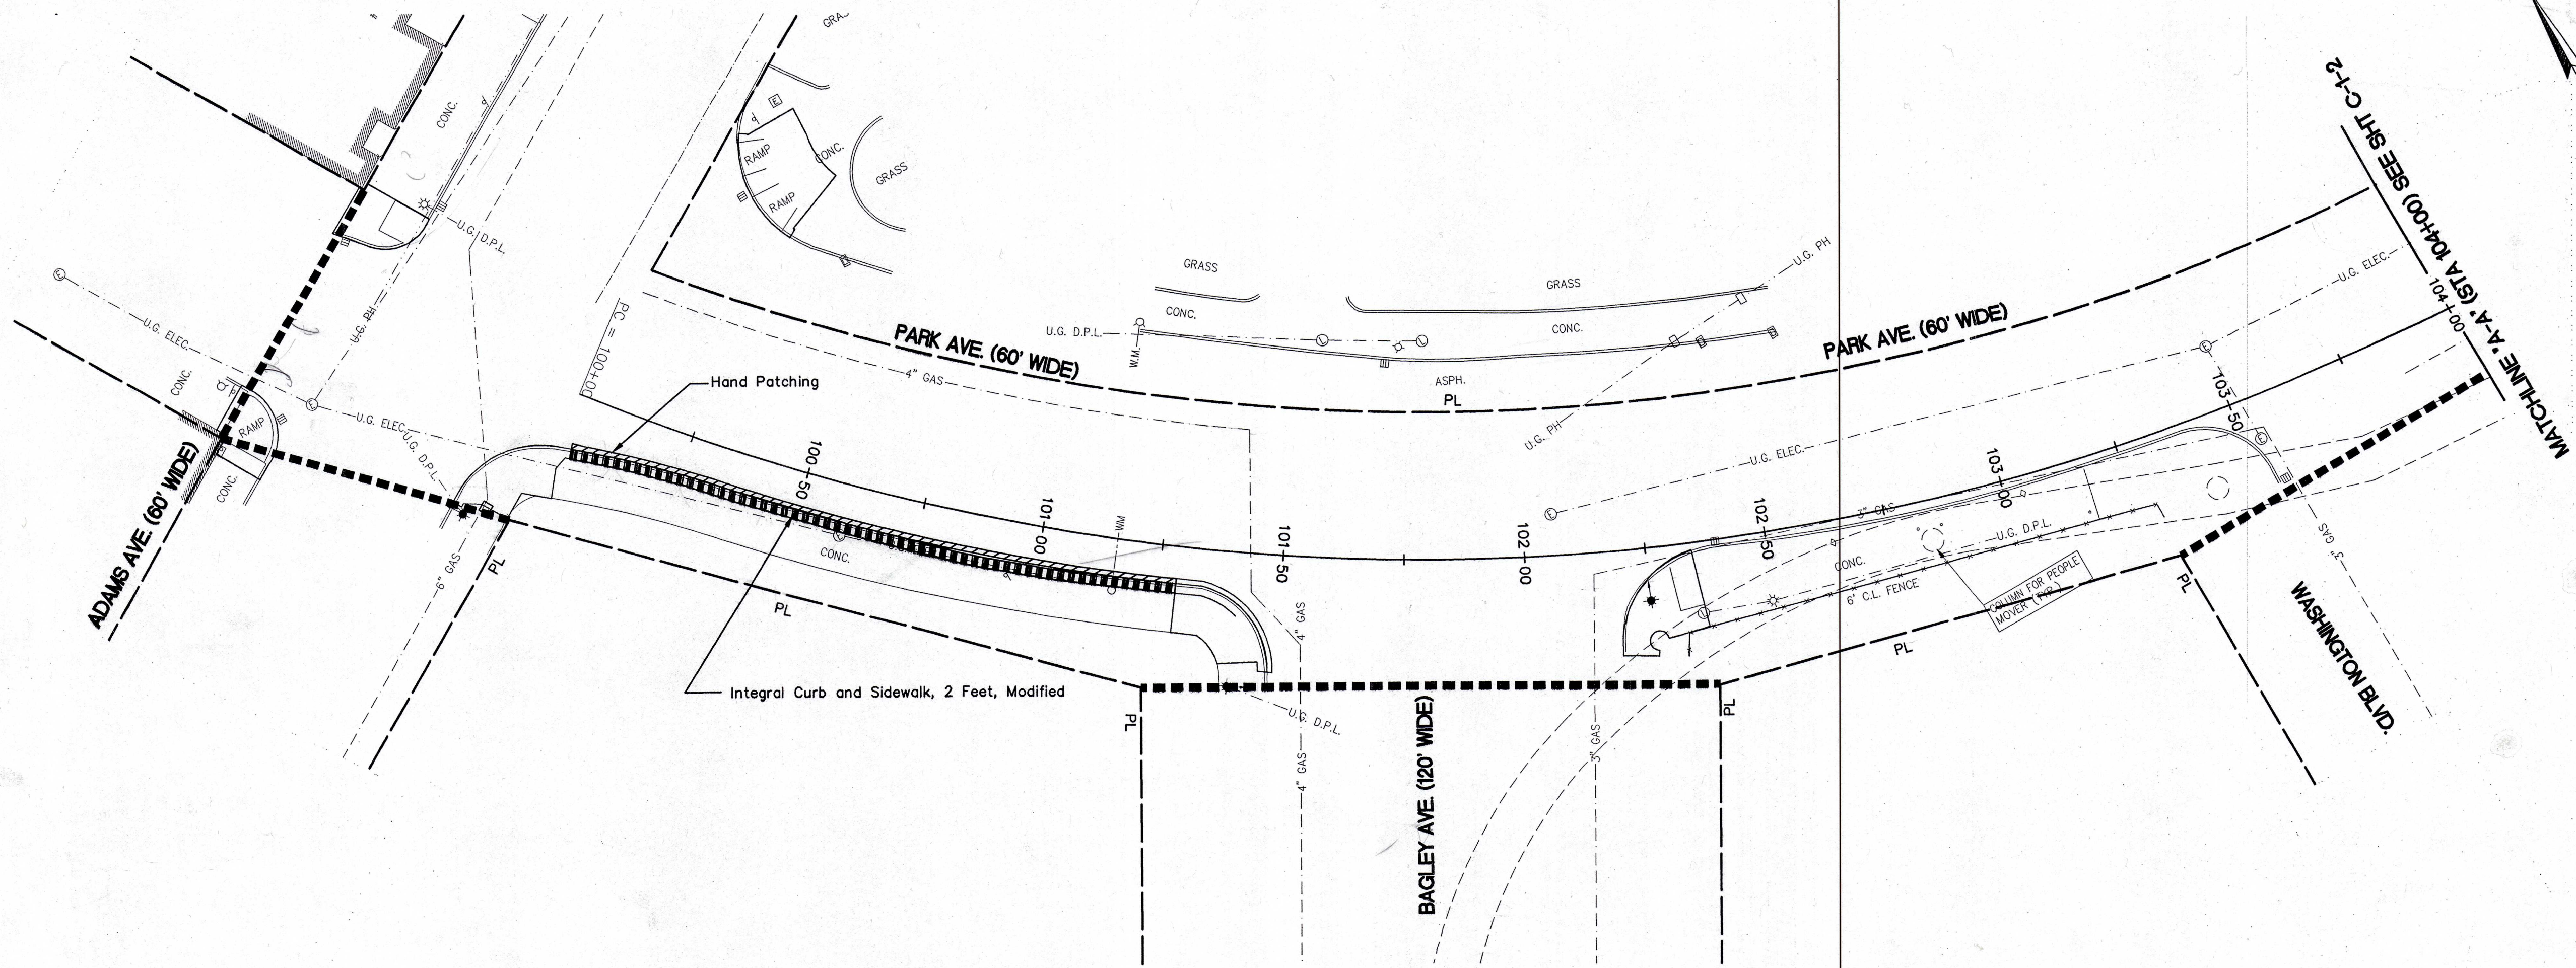

KEY PLAN

CONSTRUCTION LEGEND

- Sidewalk, Conc, 4 inch, Modified
- Sidewalk, Conc, 6 inch, Modified
- Integral Curb and Sidewalk, Conc, 4 inch, Modified
- Integral Curb and Sidewalk, Conc, 6 inch, Modified
- Integral Curb and Sidewalk, 2 Feet, Modified
- Conc Pavt, Misc, Nonrein, 8 inch
- Hand Patching
- Brick Paving, Modified
- LIMITS OF CONSTRUCTION ON CROSS STREET
- PROPERTY LINE

NOTE:
FOR SIDEWALK CONSTRUCTION OVER
VAULTS DETAILS SEE SHIT # X-1.

PARTICIPATING QUANTITIES, THIS SHEET

PAY ITEM	UNIT	QUANTITY
Integral Curb and Sidewalk, 2 Feet, Modified	Ft	126
Sidewalk, Conc, 4 inch, Modified	Sft	-
Sidewalk, Conc, 6 inch, Modified	Sft	-
Conc Pavt, Misc, Nonrein, 8 inch, Modified	Syd	-
Hand Patching	Ton	3

Addes Work
Work Not Done
AS-BUILT CORRECTIONS

AS-BUILT

3 WORKING DAYS
BEFORE YOU DIG
CALL MISS DIG.
1-800-482-7171
For the location of public utility lines

BASE BID

F E D C B A				DRAWN BY: MW	 LOWER WOOD
----------------------------	--	--	--	--------------	--