

MATCHLINE 'A-A' (STA 104+00) SEE SHT C-1-1

WASHINGTON BLVD. (95' WIDE)

PARK AVE. (60' WIDE)

WITHERELL ST. (60' WIDE)

WOODWARD AVE. (200' WIDE)

COLUMN FOR PEOPLE
MOVER (TYP.)

ENCLOSED
STAIR WELL


3" WATER SERVICE

24" COLUMN
W/PLANTER

200' L.S.

CONC.
BRICK

TAVERN ON THE
#1570 WOODWARD

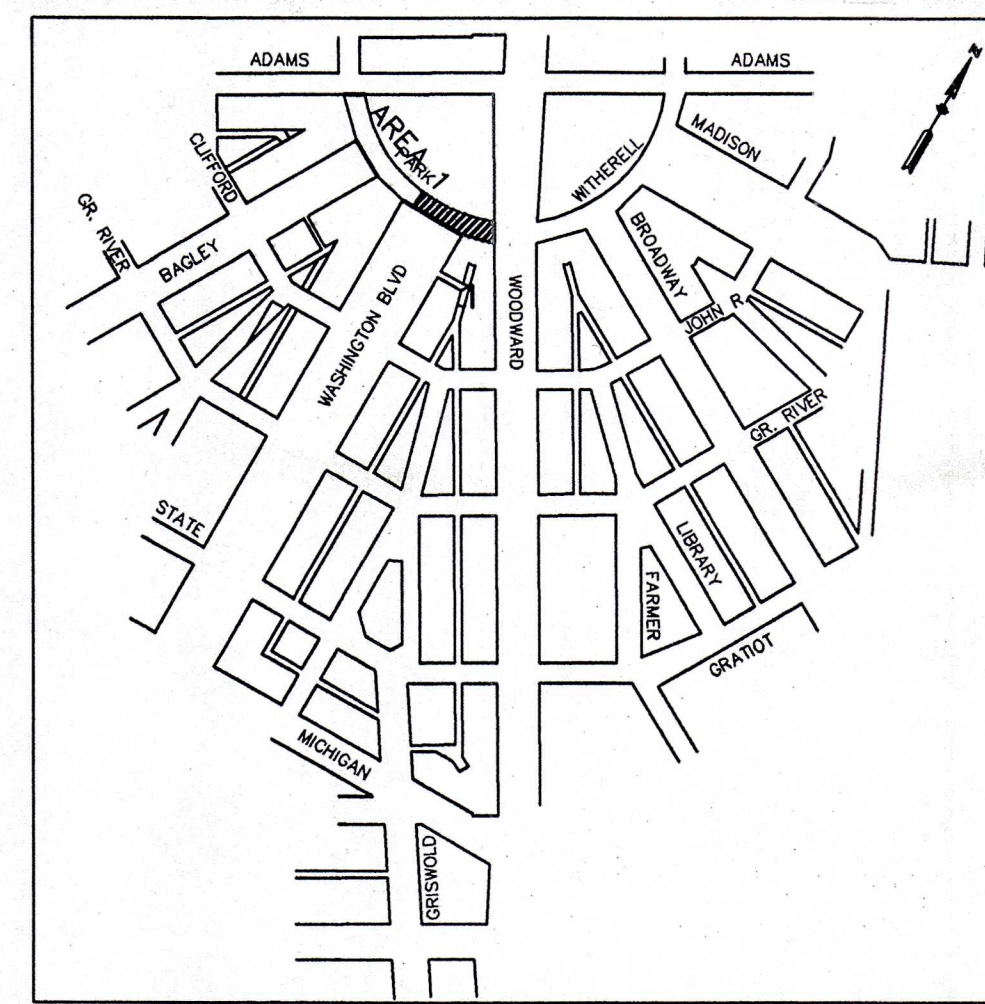

KEY PLAN

CONSTRUCTION LEGEND

- Sidewalk, Conc, 4 inch, Modified
- Sidewalk, Conc, 6 inch, Modified
- Integral Curb and Sidewalk, Conc, 4 inch, Modified
- Integral Curb and Sidewalk, Conc, 6 inch, Modified
- Integral Curb and Sidewalk, 2 Feet, Modified
- Conc Pavt, Misc, Nonreinf, 8 inch
- Hand Patching
- Brick Paving, Modified
- LIMITS OF CONSTRUCTION ON CROSS STREET
- PROPERTY LINE

NOTE:
FOR SIDEWALK CONSTRUCTION OVER
VAULTS DETAILS SEE SHT # X-1.

PARTICIPATING QUANTITIES, THIS SHEET

PAY ITEM	UNIT	QUANTITY
Integral Curb and Sidewalk, 2 Feet, Modified	Ft	—
Sidewalk, Conc, 4 inch, Modified	Sft	—
Sidewalk, Conc, 6 inch, Modified	Sft	—
Conc Pavt, Misc, Nonreinf, 8 inch, Modified	Syd	—
Hand Patching	Ton	—

NOTE: NO PROPOSED CONSTRUCTION ON THIS SHEET.

AS-BUILT

3 WORKING DAYS
BEFORE YOU DIG
CALL MISS DIG.
1-800-482-7171

BASE BID

F					DRAWN BY: MW
E					DESIGNED BY: KD
D					CHECKED BY: MH
C					APPROVED BY: MH
B					
A					
DESCRIPTION		CHK'D	APP'VD	DATE	
REVISIONS					

LOWER WOODWARD CROSS STREETS IMPROVEMENTS
CITY OF DETROIT- DOWNTOWN DEVELOPMENT AUTHORITY

CONSTRUCTION PLAN
PARK (SOUTH) - MATCHLINE (STA 104+00) TO WOODWARD

SCALE: 1"=20'

DATE: 08-28-08

220 W. CONGRESS, SUITE 400
DETROIT, MI 48226
PHONE: (313) 967-4700
FAX: (313) 967-4707
www.spdinspect.com

Hamilton anderson
Hamilton anderson Associates
1435 Randolph Suite 200, Detroit, Michigan 48226
P: 313 964 0270 F: 313 964 0170
www.hamilton-anderson.com

NTH
480 Ford Field, 2000 Brush Street
Detroit, MI 48226
PHONE: (313) 237-3900
FAX: (313) 237-3909
www.nthconsultants.com

16580 Wyoming Avenue,
DETROIT, MI 48221-2882
PHONE: (313) 341-5797
FAX: (313) 341-0205
www.consolting.com

LES
20349 Alderton Street, Suite 200
DETROIT, MI 48219-9550
PHONE: (313) 434-8282
FAX: (313) 537-7945
www.urbanengineering.com

MANSELL
Mansell Associates, INC.
33608 Grand River
Farmington, MI 48335
PHONE: (248) 473-7070
FAX: (248) 473-8190

DDA		CITY OF DETROIT DOWNTOWN DEVELOPMENT AUTHORITY		M.D.P.H./D.N.R. PERMIT NO.	
500 Griswold, Suite 2200, Detroit, MI 48228 P: (313) 963-2940 F: (313) 963-8893		REF. NO. DE06001.OT		CONTRACT NO.	
SECTION MAP		TOWN		FILE NO.	
RANGE		SECTION		DRAWING NO.	
PORTION CODE		C-1-2			