




CONSTRUCTION LEGEND


NOTE:
FOR SIDEWALK CONSTRUCTION OVER
VAULTS DETAILS SEE SHT # X-1.

AS-BUILT

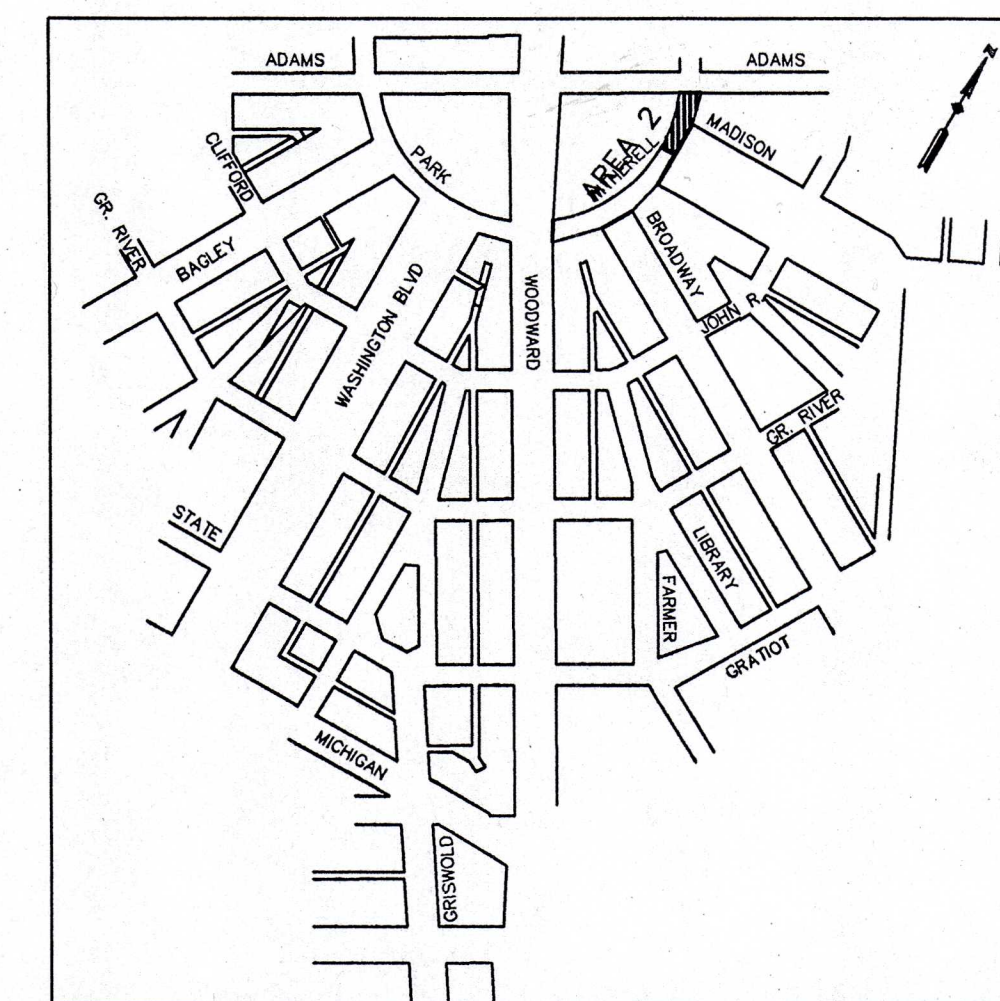

F					DRAWN BY: MW
E					DESIGNED BY: KD
D					CHECKED BY: MH
C					APPROVED BY: MH
B					
A					
	DESCRIPTION	CHK'D	APP'VD	DATE	
	REVISIONS				

DATE: 08-28-08

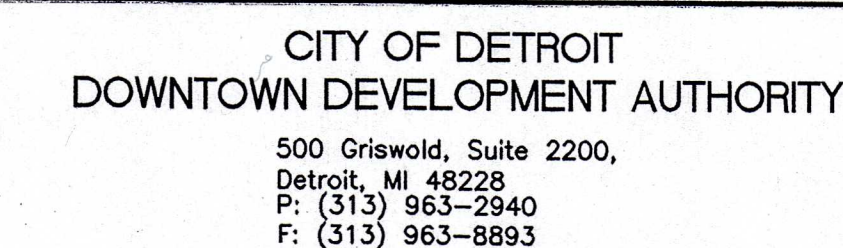

SECTION MAP				TOWN		RANGE		SECTION				PORTION CODE			
-	-	-	-	-	-	-	-	-	-	-	-	-	-	-	-

M.D.P.H./D.N.R. PERMIT NO.

REF. NO. DE06001.OT

FILE NO.

DRAWING NO. C-2-4