

BEFORE STARTING CONSTRUCTION CONTRACTOR MUST CHECK WITH UTILITIES FOR LOCATIONS OF EXISTING STRUCTURES WHETHER OR NOT INDICATED ON PLANS.

SCALE
 LOTS & ALLEYS 1" = 20'
 STREET WIDTH 1" = 20'

VERTICAL
 SUPPLEMENTARY DETAILS
 C-4373 THROUGH C-4375A C4647

DATE REVISIONS
 3-23-70 AS-BUILT POSTED J.C.

QUANTITIES	ESTIMATED	
	LOTS	CITY
EXCAVATION CU.YDS.		
PAVEMENT REMOVAL SQ.YDS.		
CURB REMOVAL LFT.		
FILL TYPE A		
ADJUST MANHOLES		
MANHOLES RE-CONSTRUCT CONC. NEW		
CATCH BASIN ADJUST		
CATCH BASIN STANDARD NEW		
12" COVER PIPE LFT.		
PAVING SQ.YDS.		

QUANTITIES	ESTIMATED	
	LOTS	CITY
PAVING SQ.YDS.		
PAVING UNITS SQ.YDS.		
CURB-TYPE II LFT.		
TEST CORES EACH		
SIDEWALK 4" STANDARD 50.FT.		
CONCRETE DRIVE 5" STD. SQ. FT.		
CONCRETE DRIVE 6" STD. SQ. FT.		
TREE REMOVAL 4"-12" DIA.		
TREE REMOVAL 13"-18" DIA.		

ASSIGNMENT NO. **A.O. 1789**

BOOK **LL 28A-6** LEVEL **5-67**

NO. Pg. DATE

LOTS 2L LENGTH

CITY 2L LENGTH

TOTAL LENGTH

DATE OF DRAW'G. **MAY 1967**

DRAINAGE COMPLETED

PAVING COMPLETED

MADE BY	CHECKED BY
<i>E. Jackson</i>	<i>W. B. Hammond</i>
PROFILE	
GRADE	
SEWER APPROVED	
ESTIMATE	
FINAL CHECK	
APPROVED	
<i>W. B. Hammond</i> ADMINISTRATIVE ENGINEER	
<i>J. Erickson</i> ENGINEER OF STREETS	
<i>J. Erickson</i> HEAD CIVIL ENGINEER	

INDEX NO.	TOPO NO.	INDEXED
2	28	✓

GROUP NO. _____ CONTRACT NO. P.W. **5762**

**STREET PAVING PLAN
CITY OF DETROIT**

DEPARTMENT OF PUBLIC WORKS-CITY ENGINEERS OFFICE

NAME OF STREET **WIDENING OF CLINTON**

FROM **100' W OF WPL OF ST. ANTOINE**

TO **10'E OF WPL OF ST. ANTOINE**

CHEAT 6 OF 6

HIGH EARLY STRENGTH CONCRETE
 5" UNIFORM + 2" BITUMINOUS CONCRETE TYPE III
 TYPE OF PAVEMENT ONE COURSE CONCRETE-INTEGRAL CURD TYPE III
 5" UNIFORM AT STREET INTERSECTION EXCEPT AS NOTED

PET. NO. _____ BY _____ DATE _____

NOTE - FOR SYMBOLS (A) ETC., SEE STANDARD DETAIL DRAWING C-4373


BENCH MARKS _____ ELEV. _____

P.L.B.M. #39-250-A N.W. COR. COLUMBIA & RIVARD 135.8
 C.B.M. ARROW HYD. S.S. GRATIOT W OF PAYNOR 125.1
 C.B.M. ARROW HYD. N.E. COR. CLINTON & ST. ANTOINE 125.1
 P.L.B.M. #39-250 ELIZABETH & HASTINGS 129.2

CURVE DATA

Curve	Angle	Radius	Tangent	Offset
A	36° 52' 12"	10'	3.33'	1.10"
A	86° 10' 57"	15'	14.03'	41.25"

OFFSET 10'

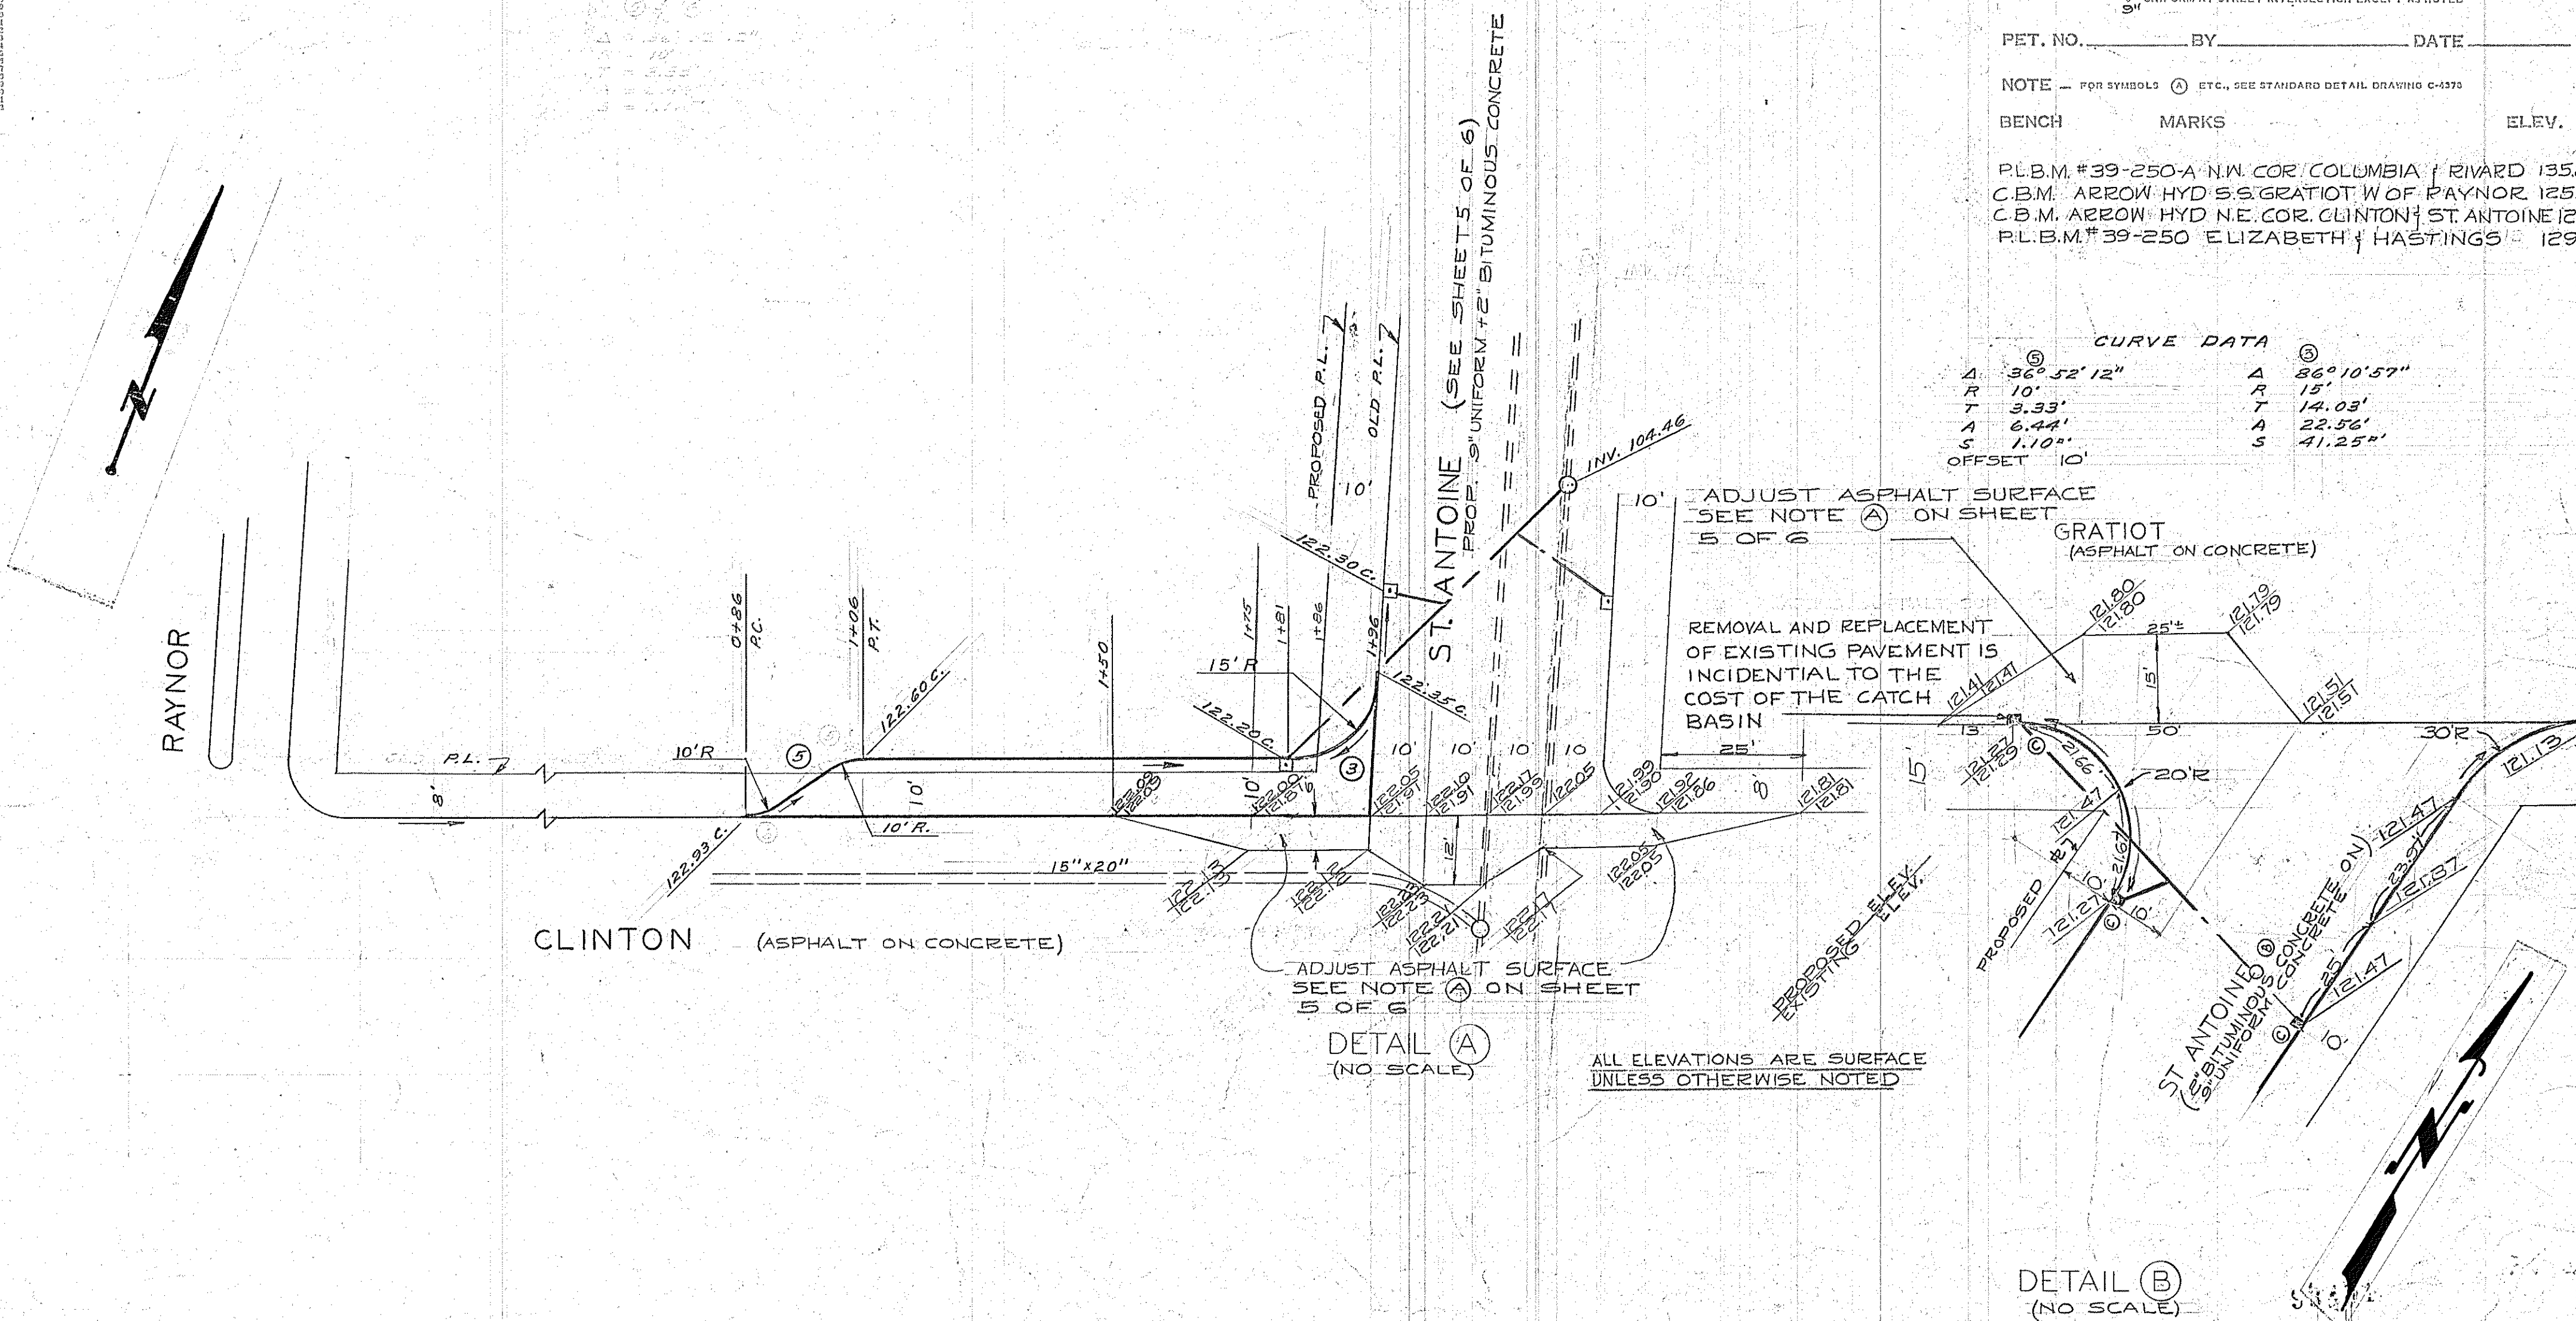

CLINTON (ASPHALT ON CONCRETE)

ADJUST ASPHALT SURFACE
SEE NOTE (A) ON SHEET
5 OF 6

DETAIL (A)
(NO SCALE)

ALL ELEVATIONS ARE SURFACE
UNLESS OTHERWISE NOTED

ADJUST ASPHALT SURFACE
SEE NOTE (A) ON SHEET
5 OF 6

REMOVAL AND REPLACEMENT
OF EXISTING PAVEMENT IS
INCIDENTAL TO THE
COST OF THE CATCH
BASIN

GRATIOT
(ASPHALT ON CONCRETE)

ST. ANTOINE
(9\"/>

DETAIL (B)
(NO SCALE)

100
101
102
200