




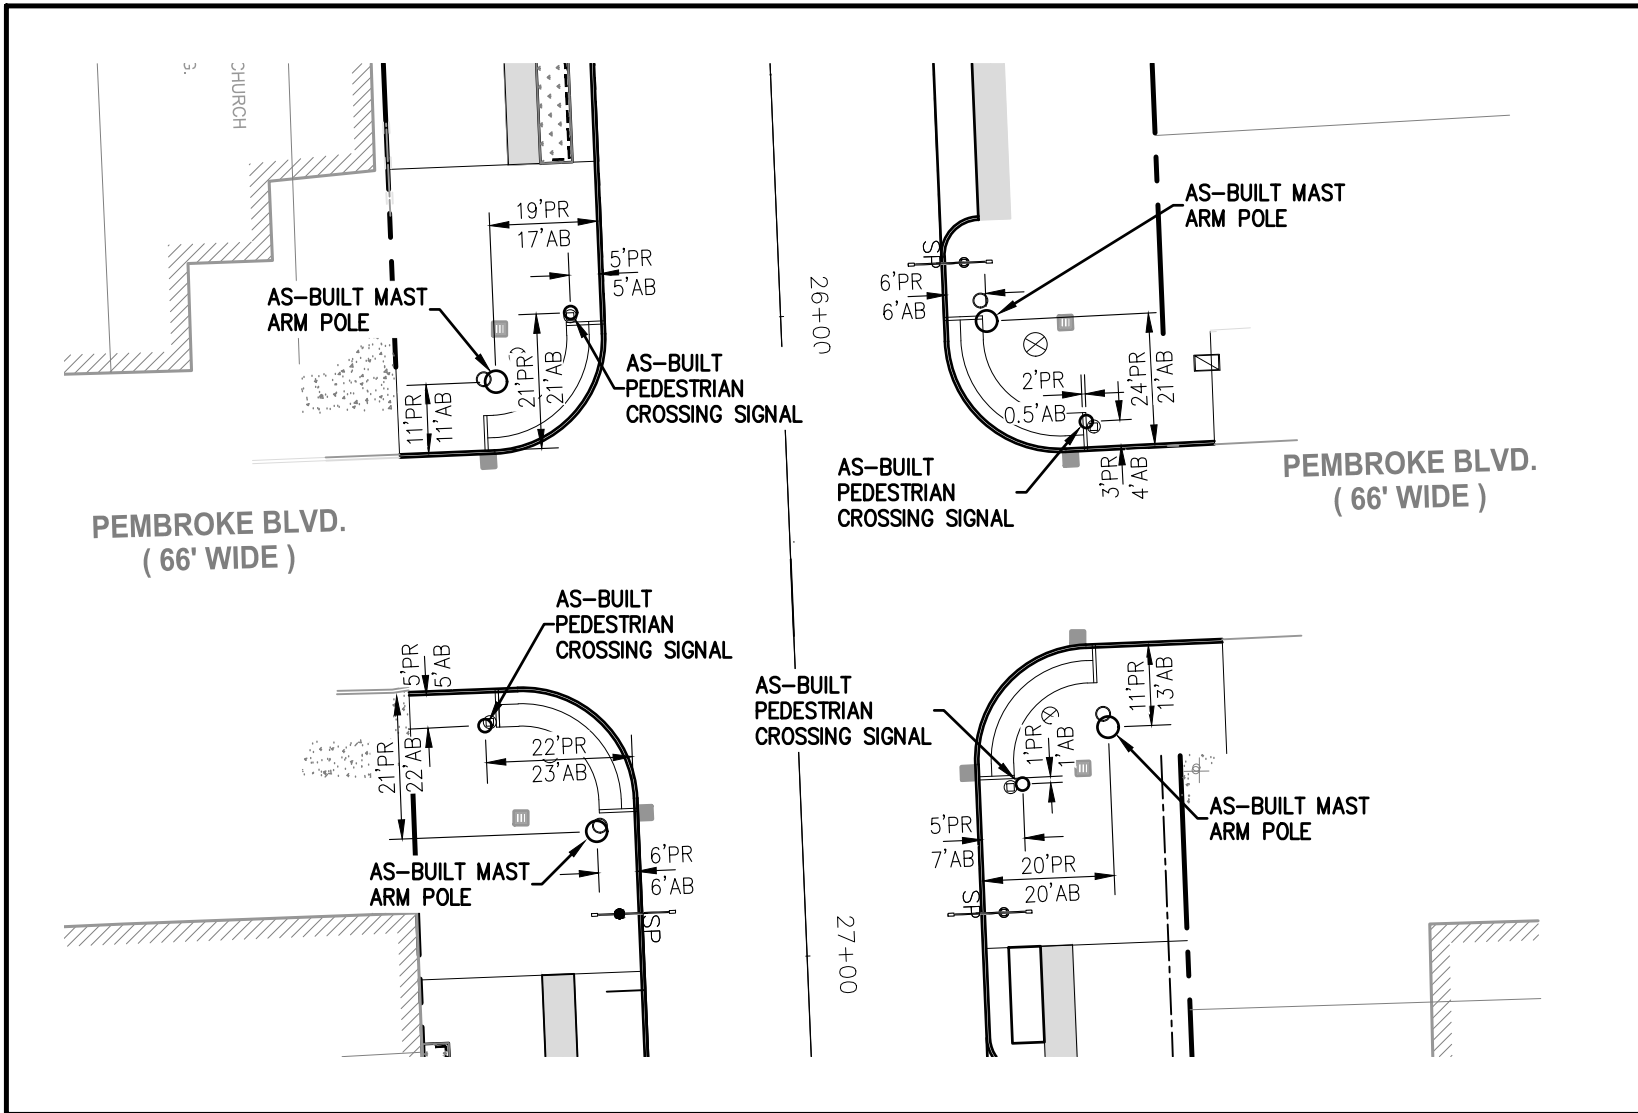

LIVERNOIS AVE. AT PEMBROKE BLVD.
SCALE: 1" = 30'

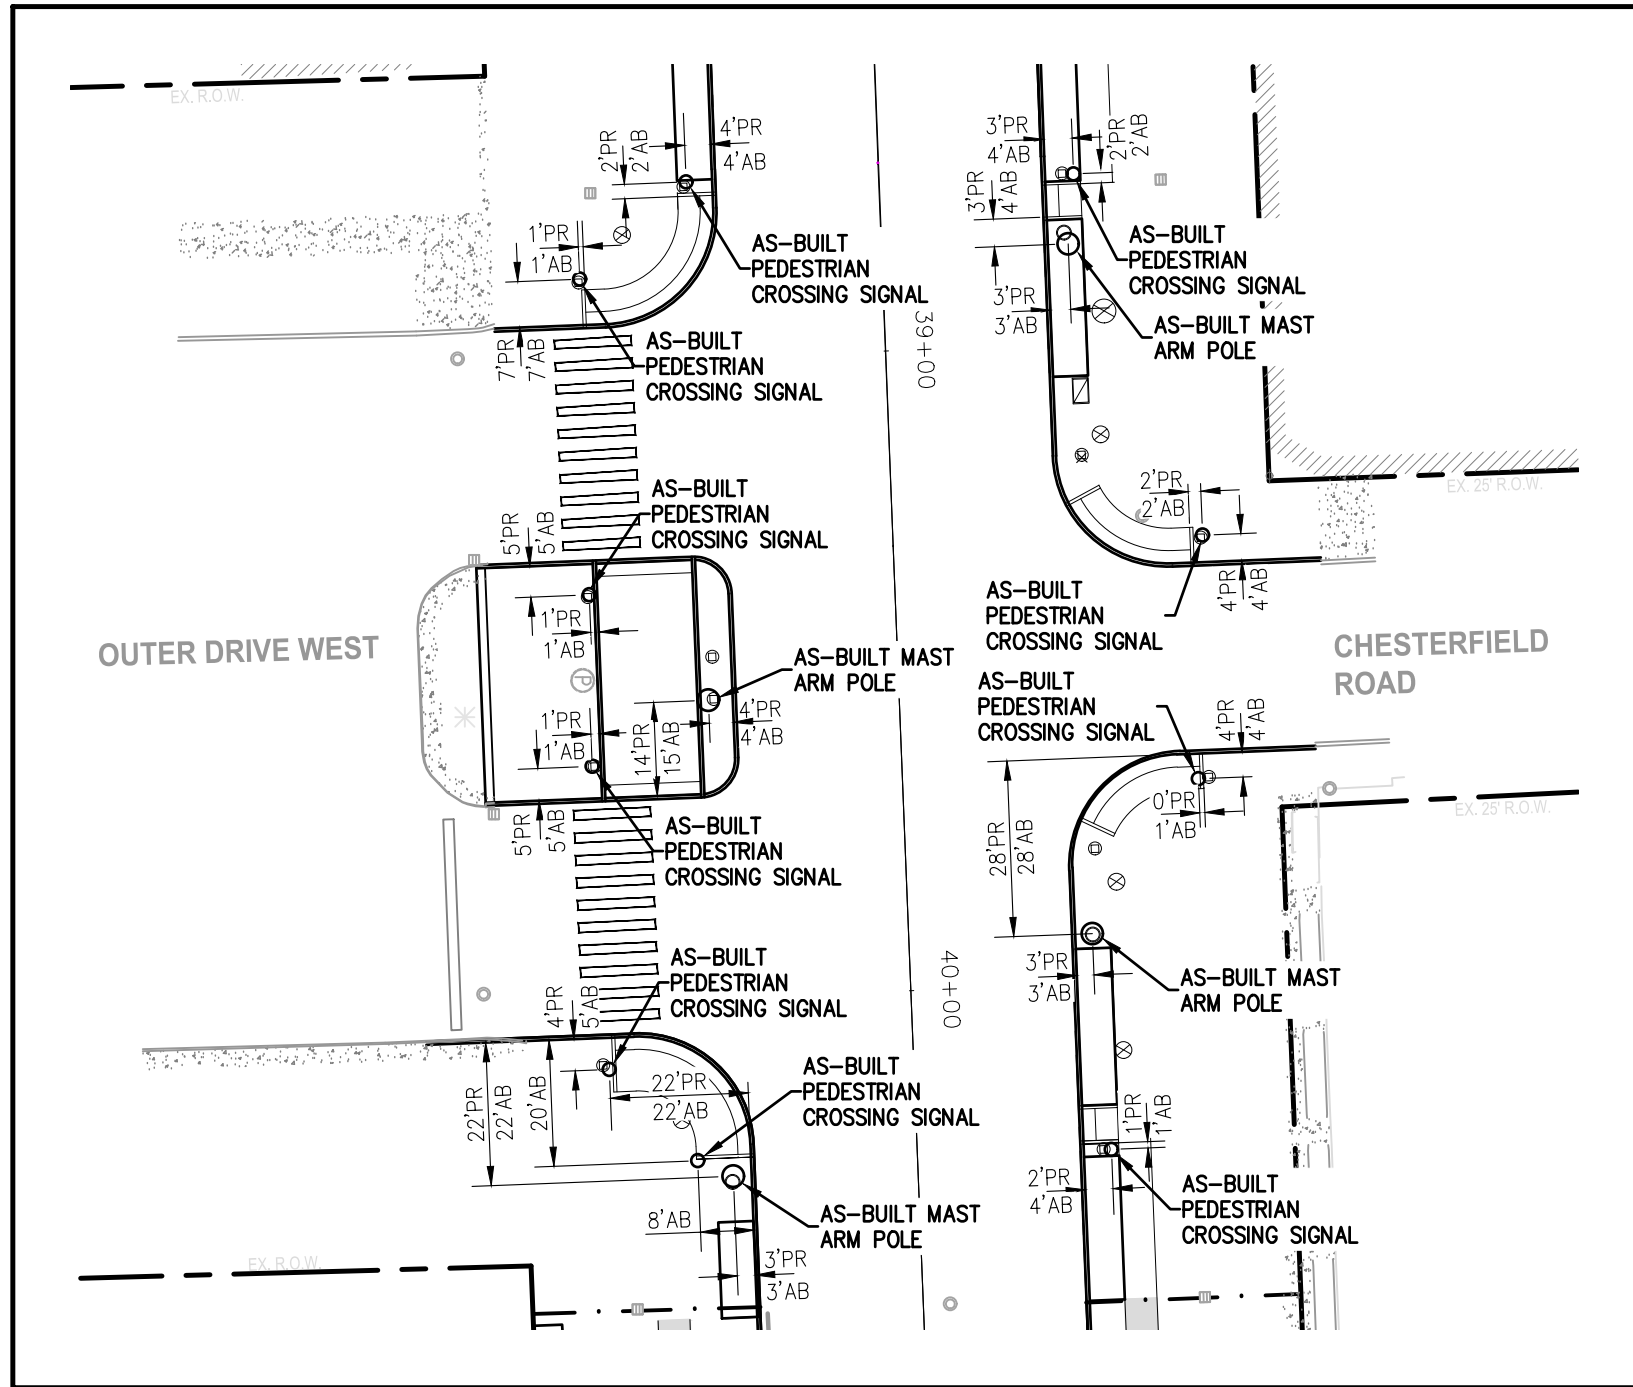

LIVERNOIS AVE. AT OUTER DRIVE
SCALE: 1" = 30'

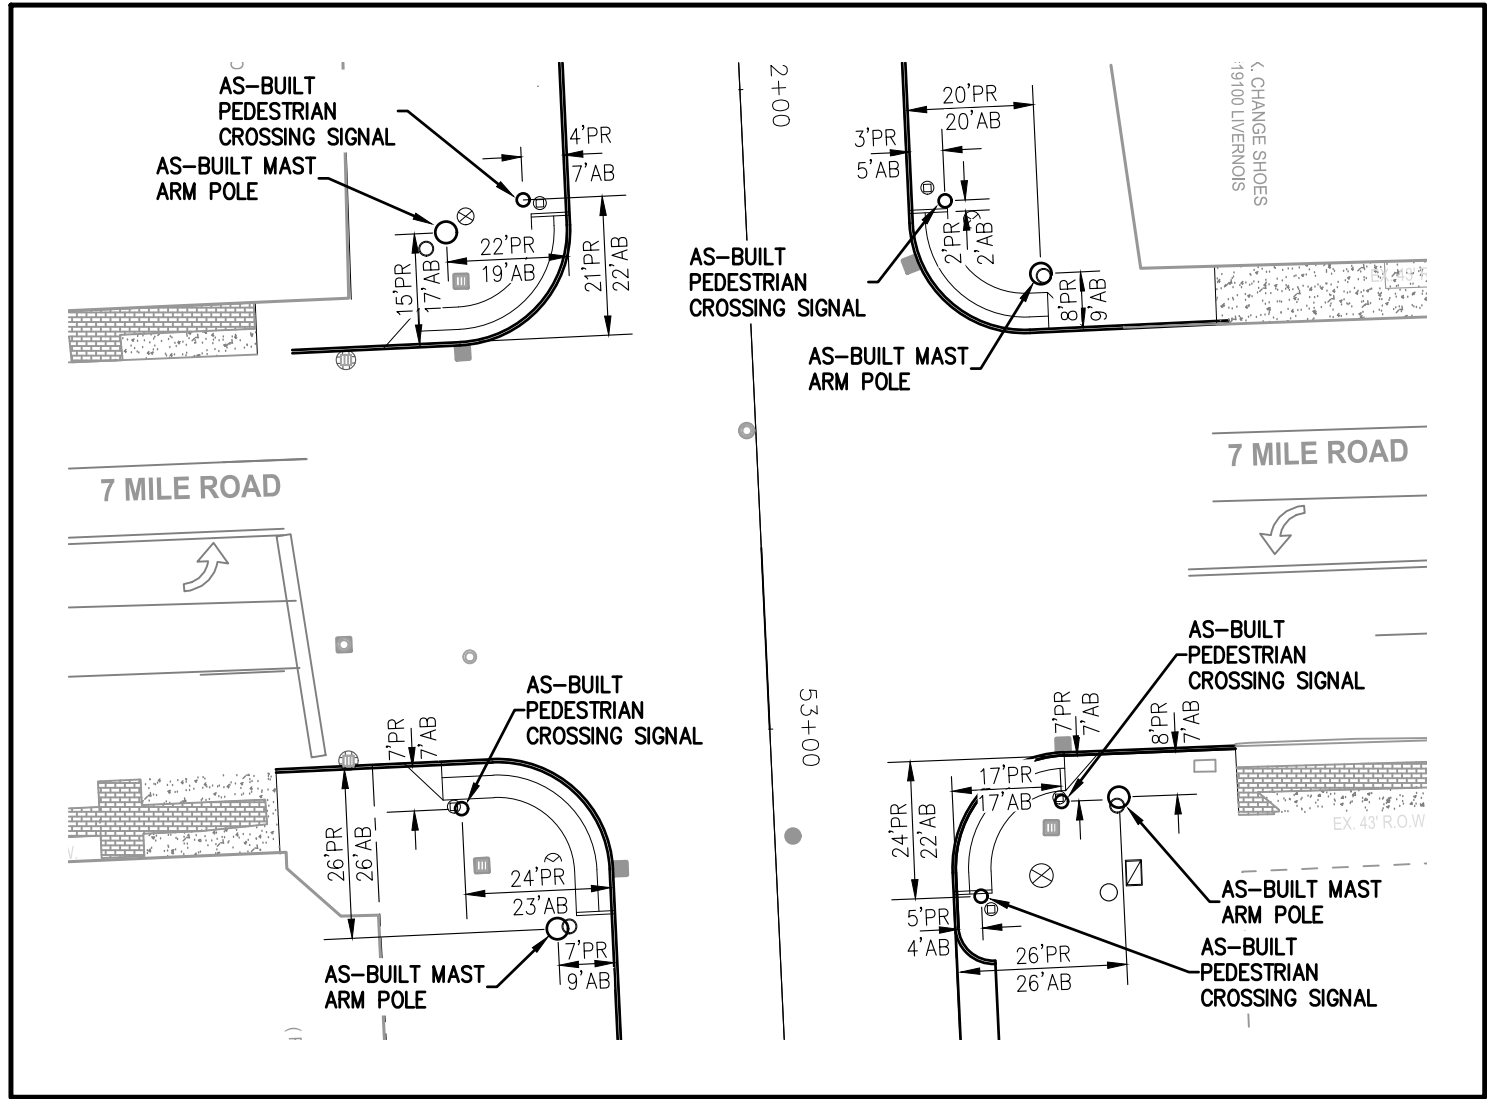

LIVERNOIS AVE. AT 7 MILE ROAD
SCALE: 1" = 30'

REVISION	DATE	BY	DESCRIPTION
1	03/25/2022	NEM	REVISED AS-BUILT OF PEDESTRIAN CROSSWALK PEDESTALS

CORE

CORE LAND CONSULTING
PROFESSIONAL SURVEYING
39425 Northwestern Hwy., Suite 320
Southfield, MI 48034
Phone: (248) 932-7120
Fax: (248) 932-7124
Email: info@corelandconsulting.com
www.corelandconsulting.com

CLIENT:

ANGELO IAFRATE
CONSTRUCTION

PROJECT LOCATION:

LIVERNOIS STREETScape

DRAWN BY: NEM

CHECKED BY: NEM

FIELD WORK BY: MDL/RTG

811

Know what's below.
Call before you dig.

Terms and Conditions for Electronic Data:

This document is provided in electronic format for the referenced project. It is understood and agreed that any use or reuse of original or altered files will be at the user's own risk and legal responsibility. It is also agreed that the electronic files provided by Core Land Consulting, LLC (CLC) are being provided for general information purposes only. Neither the electronic files nor any CAD versions are to be relied upon for design purposes, the user expressly indemnifies and holds CLC harmless for any and all claims, suits, liability, demands or other costs arising out of or resulting from the unauthorized use of these materials. CLC makes no representation as to the accuracy of the information provided by the electronic media. Data on electronic media can deteriorate or be modified without the knowledge of CLC.

SHEET:

AS-BUILT
PEDESTRIAN SIGNALS
REVISED 03/25/2022

DATE: 08/13/2020

SCALE: 1"=30'

PROJECT NO: 3125-106