
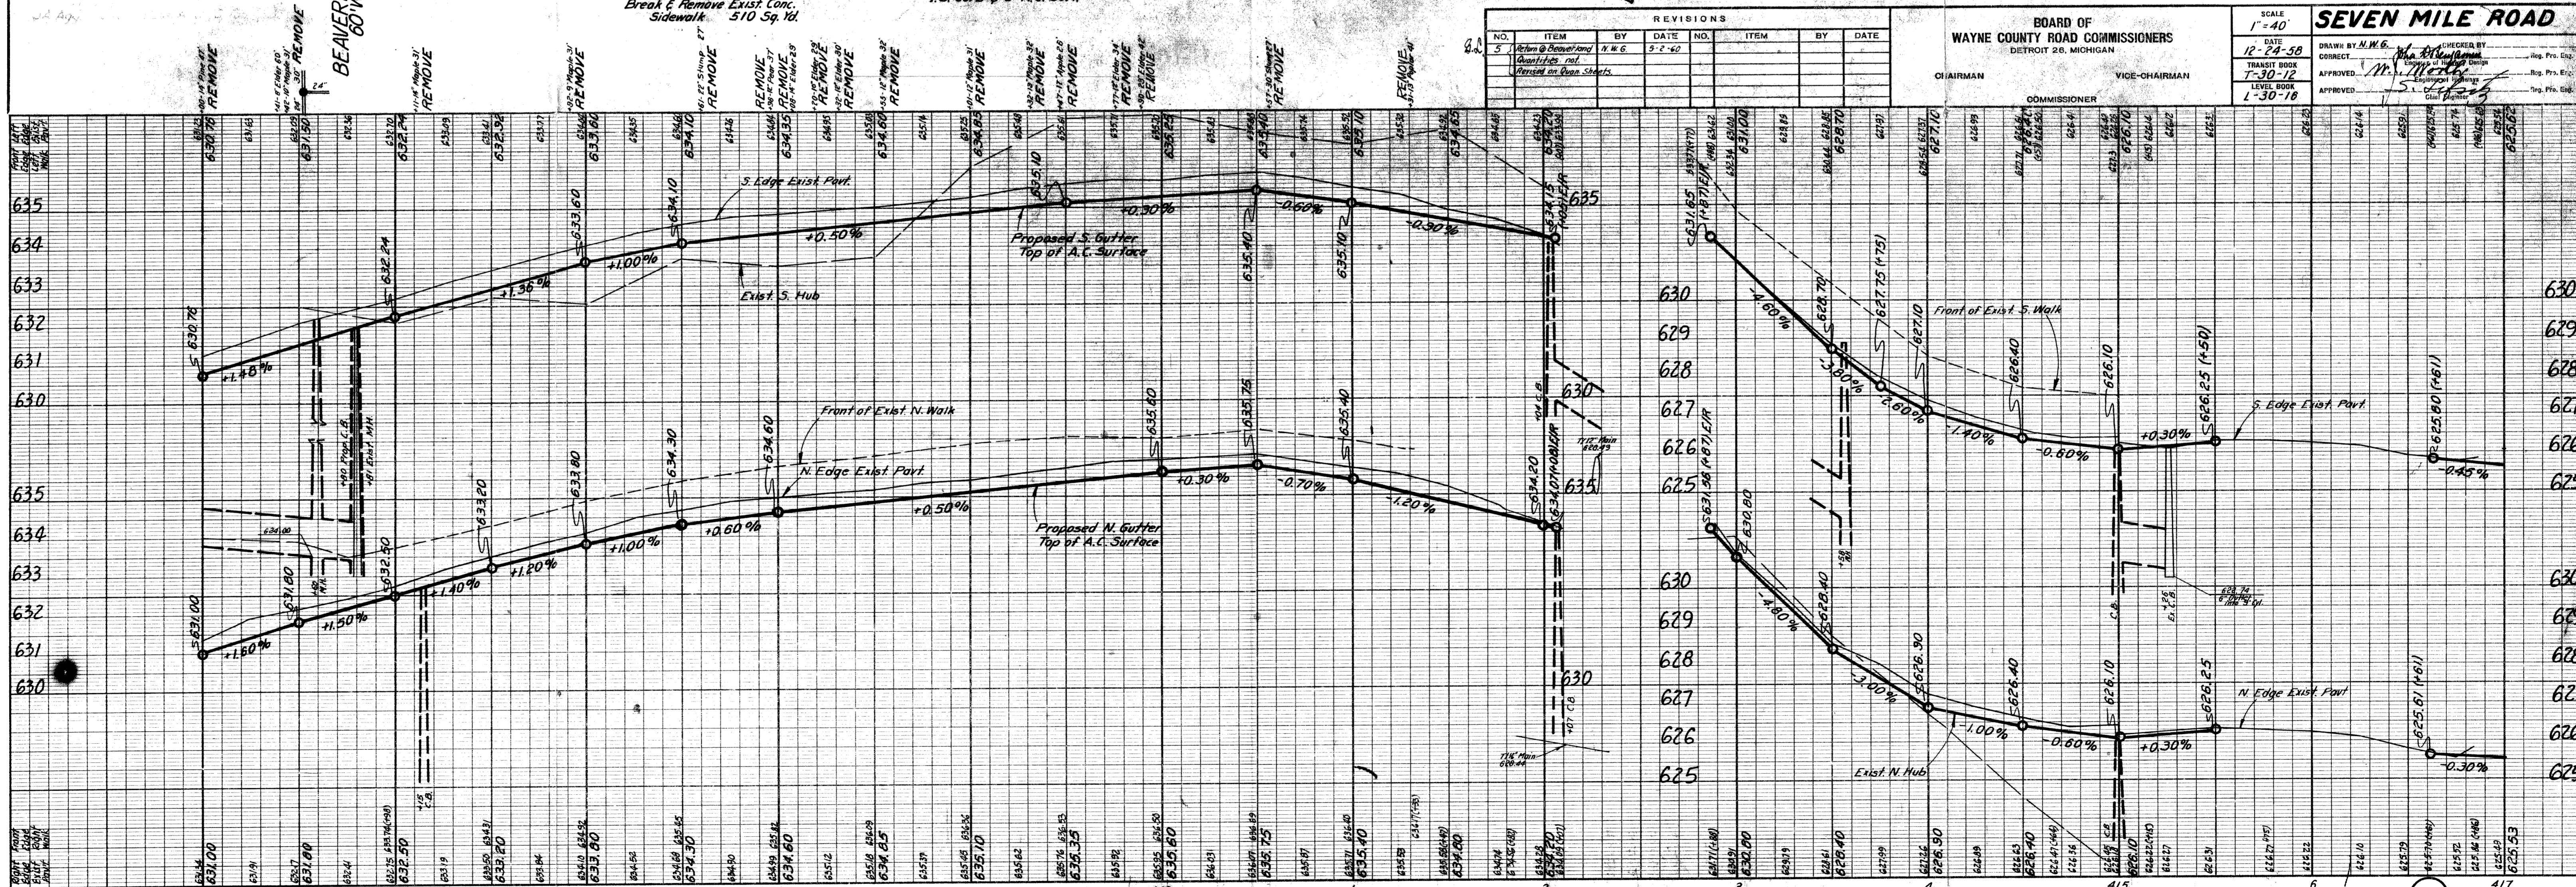


PLAN	SURVEYED	DATE
	PLOTTED	
	NOTED	
	CHECKED	
	BY	
	DATE	

PROFILE	SURVEYED	DATE
	PLOTTED	
	NOTED	
	CHECKED	
	BY	
	DATE	

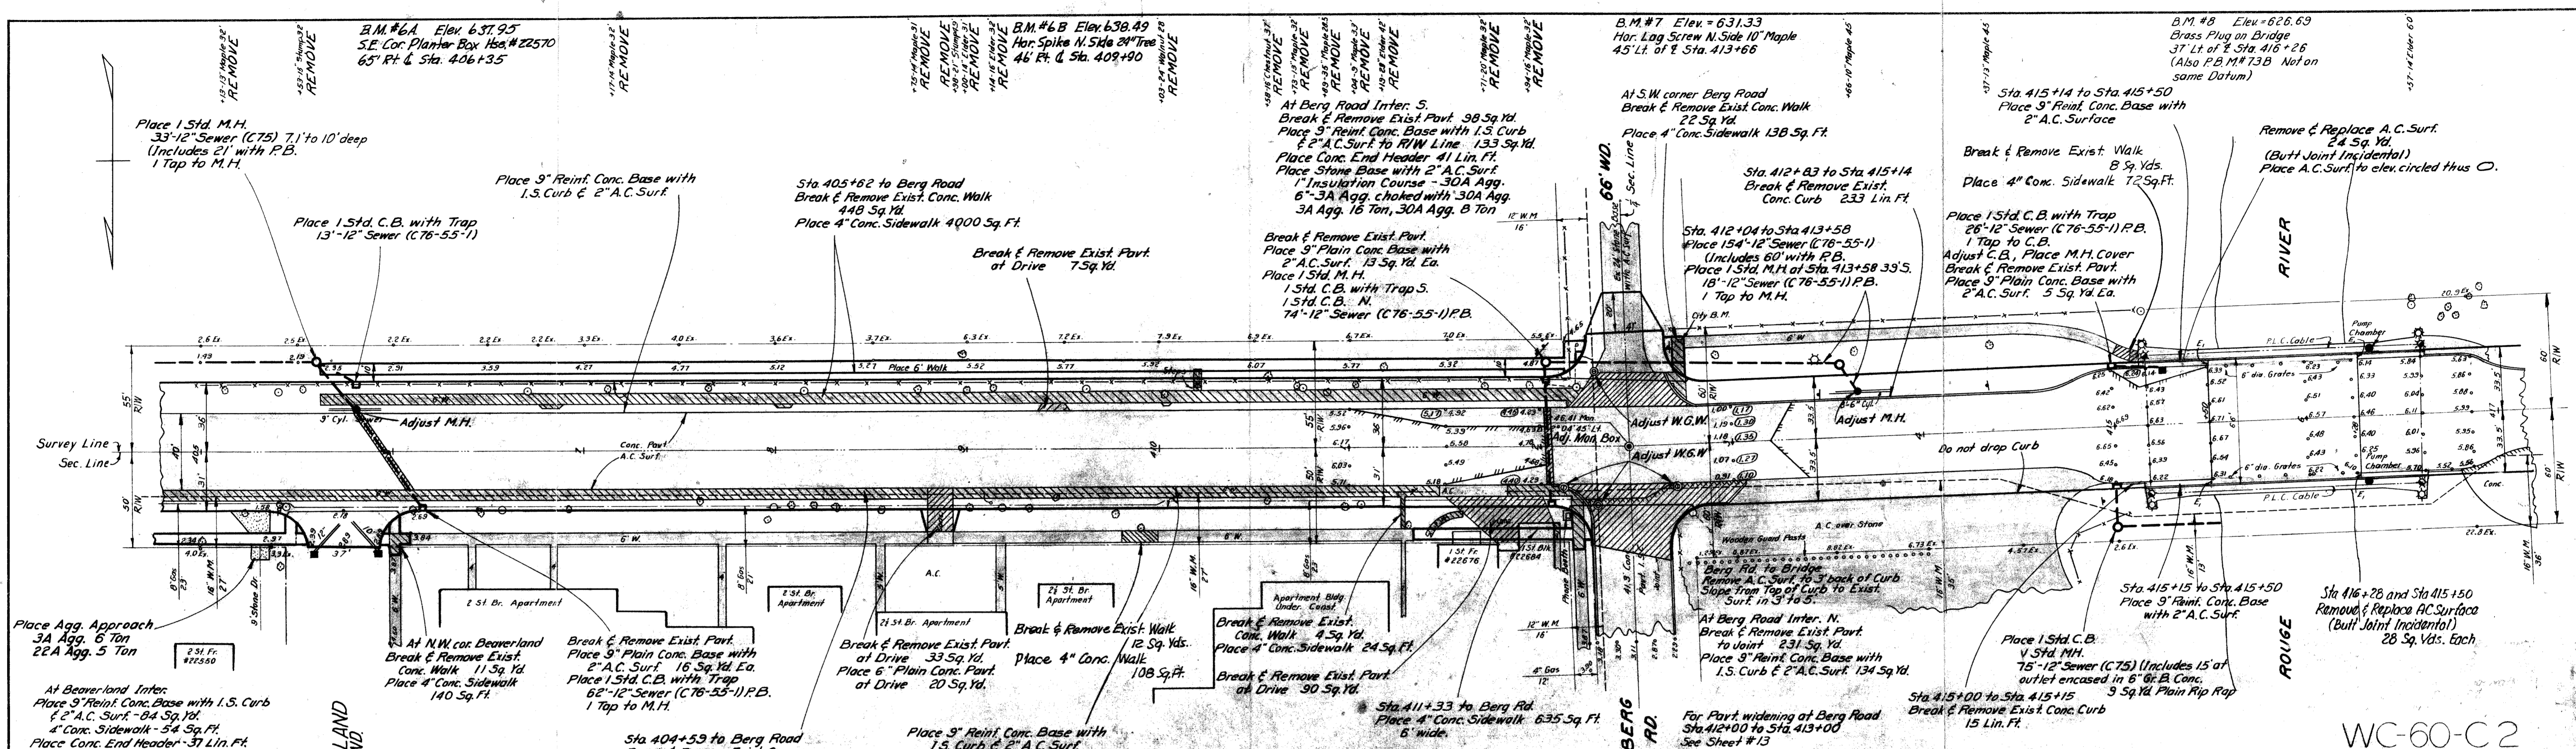

REVISIONS							
NO.	ITEM	BY	DATE	NO.	ITEM	BY	DATE
1	Item 5 Deleted	N.W.G.	5-2-60				
2	Quantities not						
3	Revised on Open Charts						


BOARD OF WAYNE COUNTY ROAD COMMISSIONERS  
 DETROIT 26, MICHIGAN  
 CHAIRMAN: \_\_\_\_\_ VICE-CHAIRMAN: \_\_\_\_\_  
 COMMISSIONER: \_\_\_\_\_

SCALE 1"=40'  
 DATE 12-24-58  
 DRAWN BY N.W.G.  
 CHECKED BY [Signature]  
 APPROVED [Signature]  
 LEVEL BOOK L-30-18

WC-60-C2  
**SEVEN MILE ROAD**

DATE	
BY	
SURVEYED	
PLOTTED	
ALIGNED CHECKED	
NOTE BOOK	
REVISIONS CHECKED	
RET. OF WORK CHECKED	
PLAN	
NO.	

DATE	
BY	
SURVEYED	
PLOTTED	
ALIGNED CHECKED	
NOTE BOOK	
REVISIONS CHECKED	
STRUCTURE NOTATIONS CHECKED	
PROFILE	
NO.	

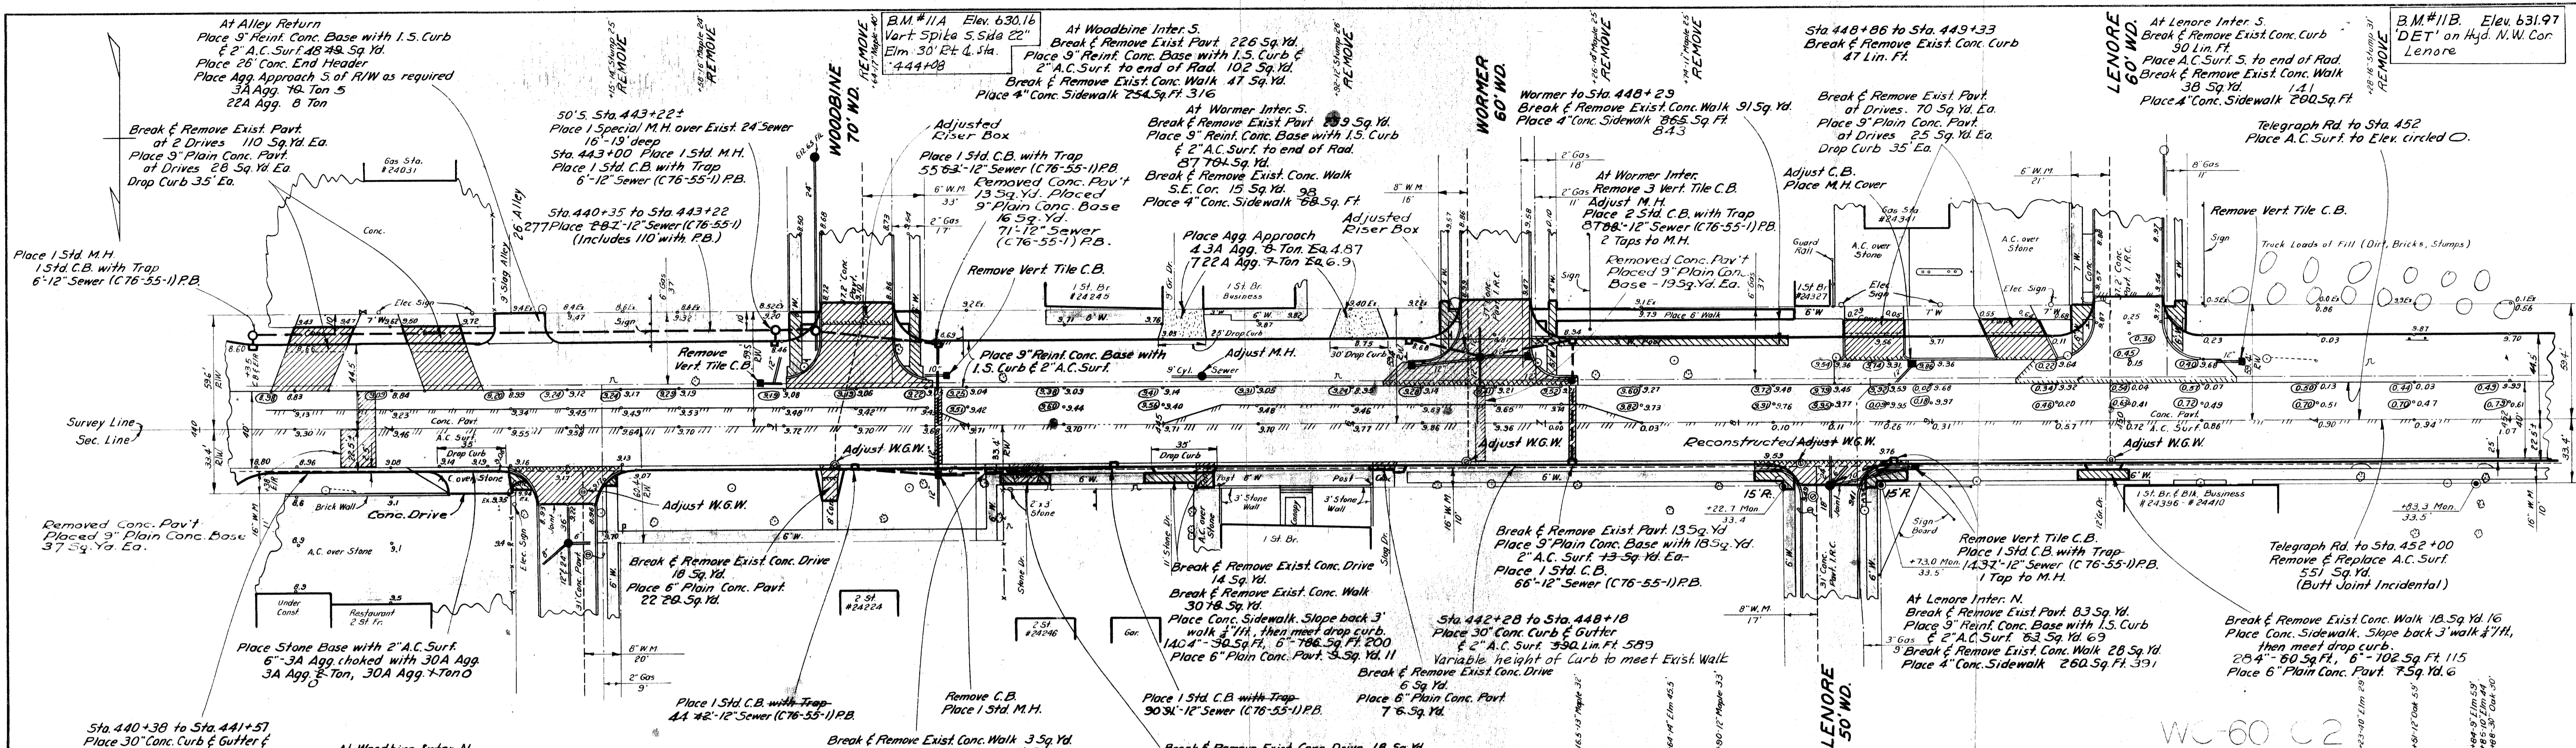

REVISIONS					
NO.	ITEM	BY	DATE	NO.	ITEM
1	As Constructed	JAM	5-8-81		

BOARD OF WAYNE COUNTY ROAD COMMISSIONERS	
DETROIT 26, MICHIGAN	
CHAIRMAN	VICE-CHAIRMAN
COMMISSIONER	

SCALE	1" = 40'
DATE	1-5-59
DESIGNED BY	M. W. G.
CHECKED BY	
APPROVED	
LEVEL BOOK	L-30-18

