


Petition #167

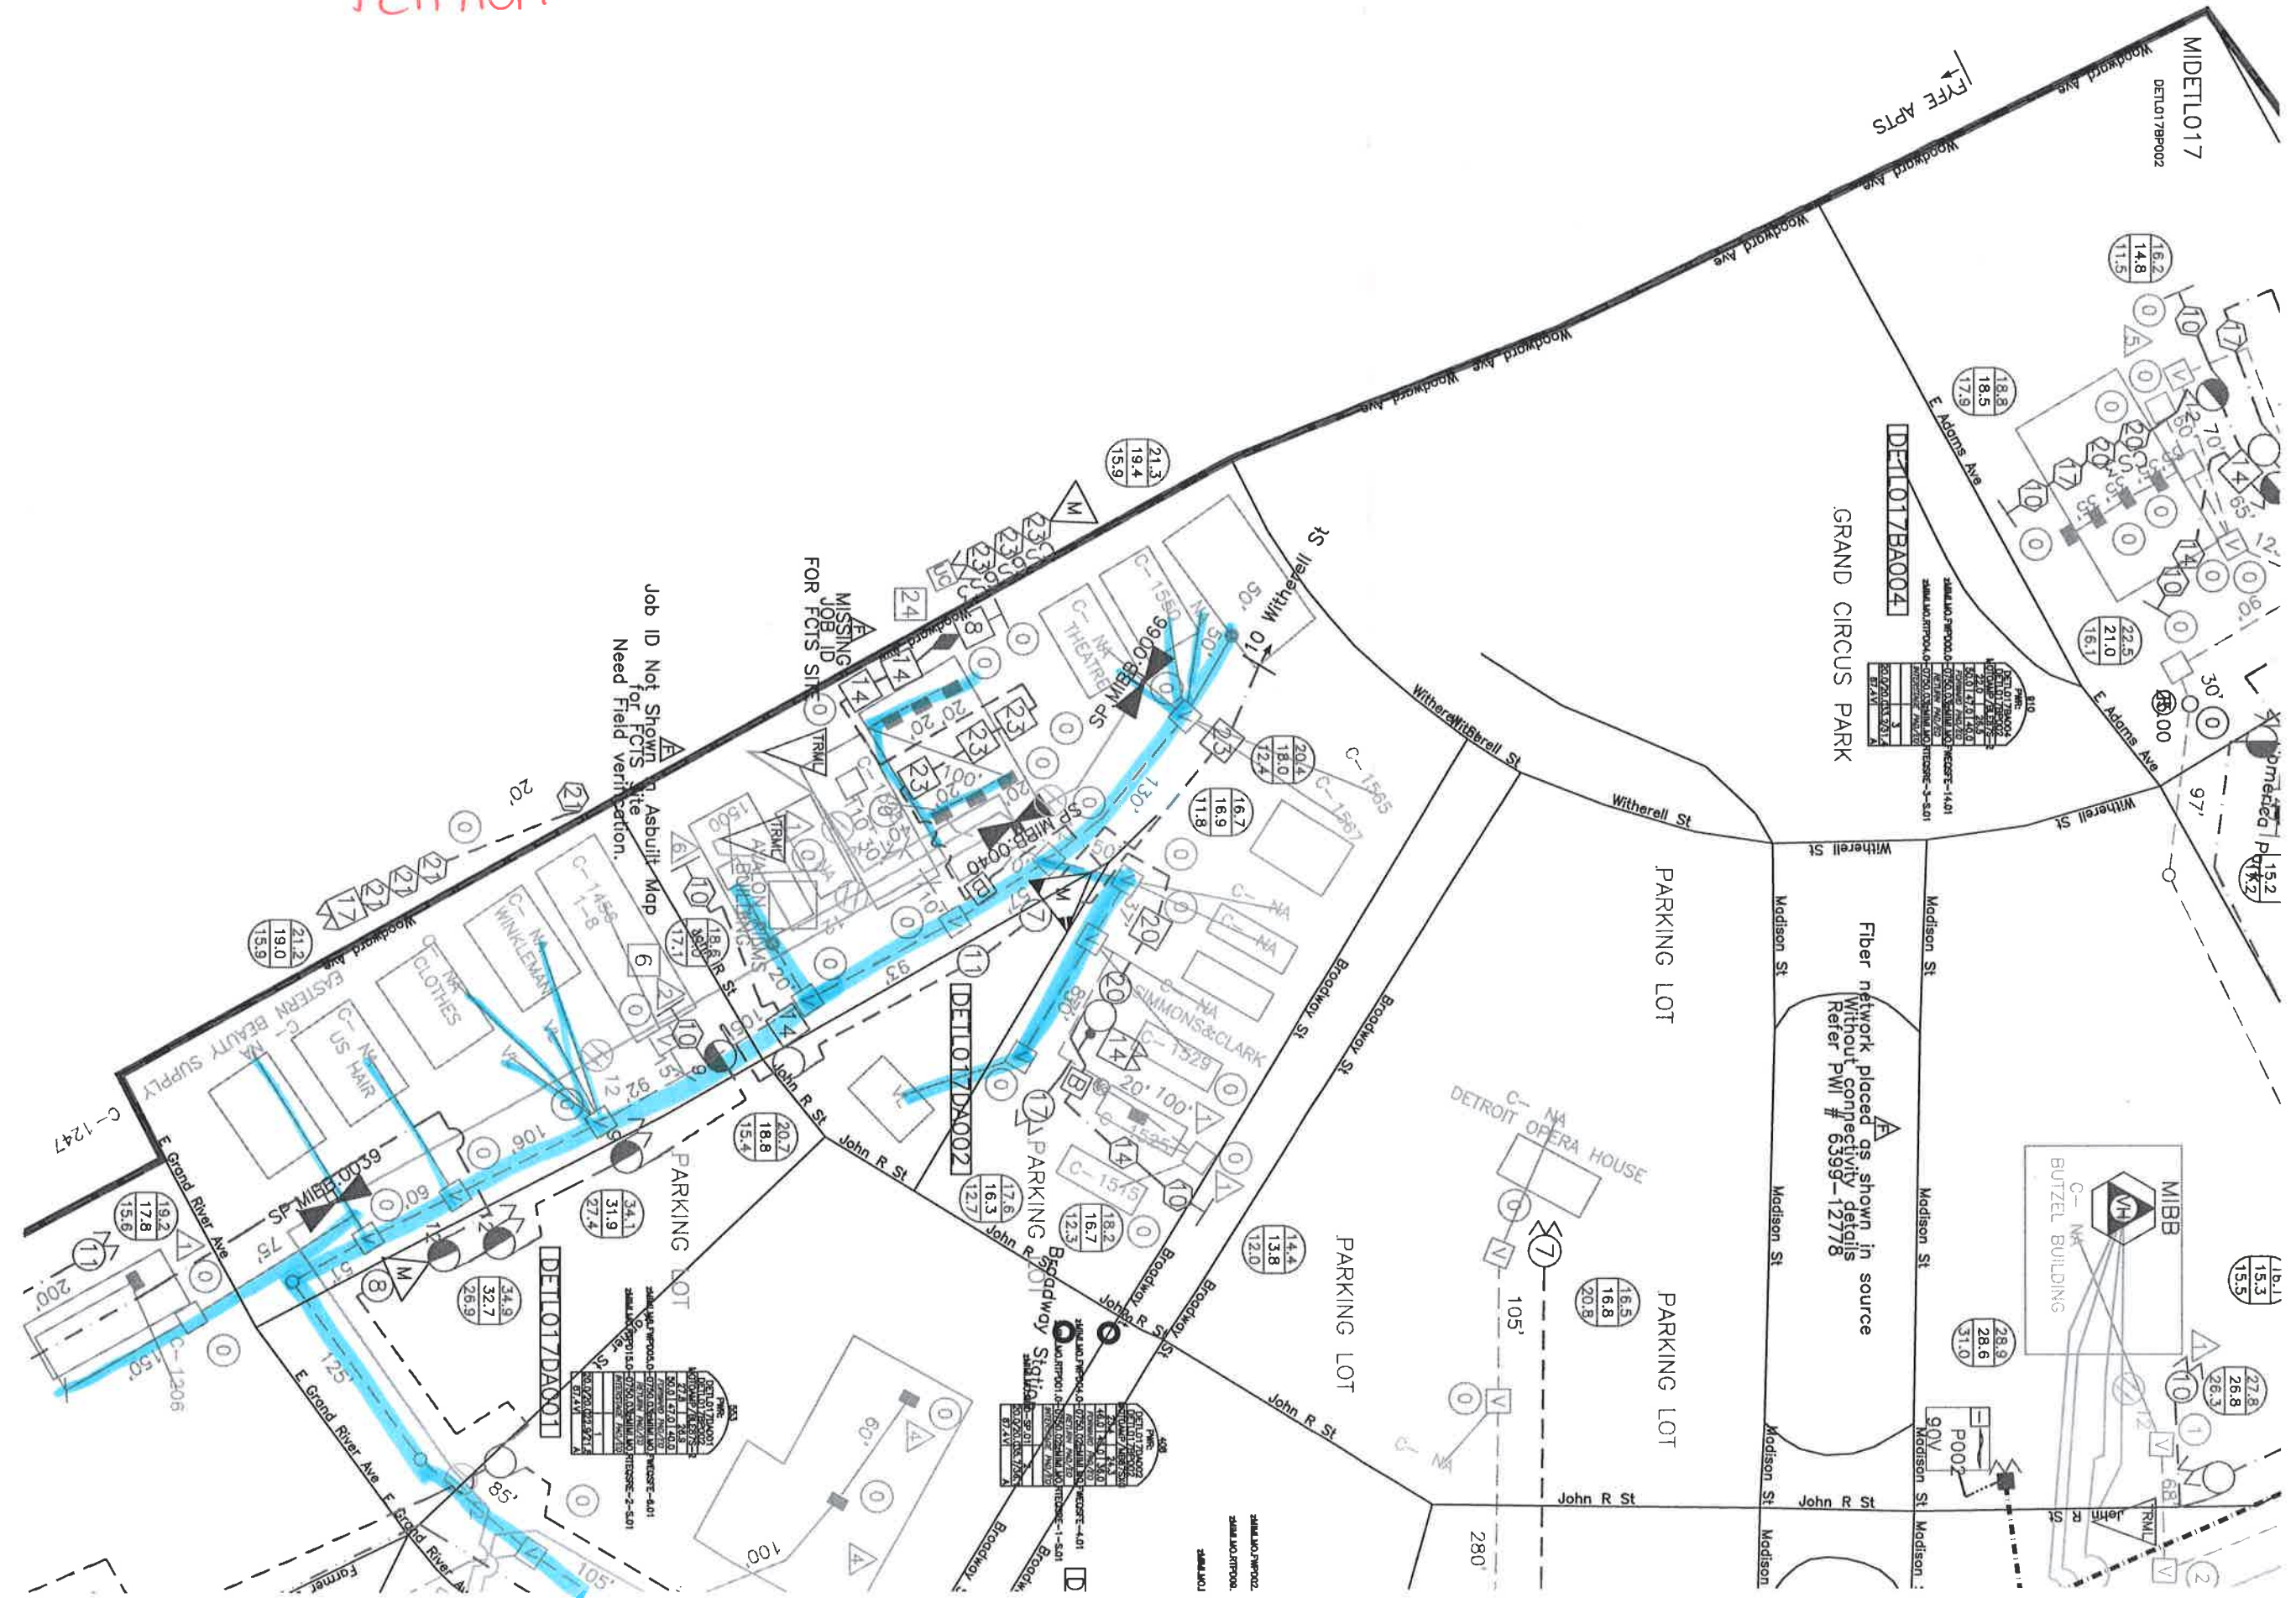


GRAND CIRCUS PARK

Fiber network placed as shown in source
Without connectivity details
Refer PWI # 6399-12778

Job ID Not Shown for FCIS.
Need Field Verification.
Asbuilt Map

MISSING JOB ID FOR FCIS SITE

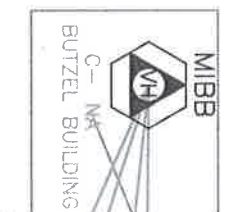

FIBER ID	LENGTH	TYPE	STATUS
FIBER-1	100'	PL	AS-BUILT
FIBER-2	150'	PL	AS-BUILT
FIBER-3	200'	PL	AS-BUILT
FIBER-4	250'	PL	AS-BUILT
FIBER-5	300'	PL	AS-BUILT
FIBER-6	350'	PL	AS-BUILT
FIBER-7	400'	PL	AS-BUILT
FIBER-8	450'	PL	AS-BUILT
FIBER-9	500'	PL	AS-BUILT
FIBER-10	550'	PL	AS-BUILT

FIBER ID	LENGTH	TYPE	STATUS
FIBER-11	600'	PL	AS-BUILT
FIBER-12	650'	PL	AS-BUILT
FIBER-13	700'	PL	AS-BUILT
FIBER-14	750'	PL	AS-BUILT
FIBER-15	800'	PL	AS-BUILT
FIBER-16	850'	PL	AS-BUILT
FIBER-17	900'	PL	AS-BUILT
FIBER-18	950'	PL	AS-BUILT
FIBER-19	1000'	PL	AS-BUILT
FIBER-20	1050'	PL	AS-BUILT

FIBER ID	LENGTH	TYPE	STATUS
FIBER-21	1100'	PL	AS-BUILT
FIBER-22	1150'	PL	AS-BUILT
FIBER-23	1200'	PL	AS-BUILT
FIBER-24	1250'	PL	AS-BUILT
FIBER-25	1300'	PL	AS-BUILT
FIBER-26	1350'	PL	AS-BUILT
FIBER-27	1400'	PL	AS-BUILT
FIBER-28	1450'	PL	AS-BUILT
FIBER-29	1500'	PL	AS-BUILT
FIBER-30	1550'	PL	AS-BUILT