


ETITION NO. 2780
 NSI CONSTRUCTION INC.
 4320 PRATT RD.
 ANN ARBOR, MICHIGAN 48103
 C/O MICHAEL BEYDOUN
 PHONE NO. 313 790-0129



SANTA MARIA AVE. 60 FT. WD.

WOODBINE AVE. 60 FT. WD.

TELEGRAPH RD. 204 FT. WD.

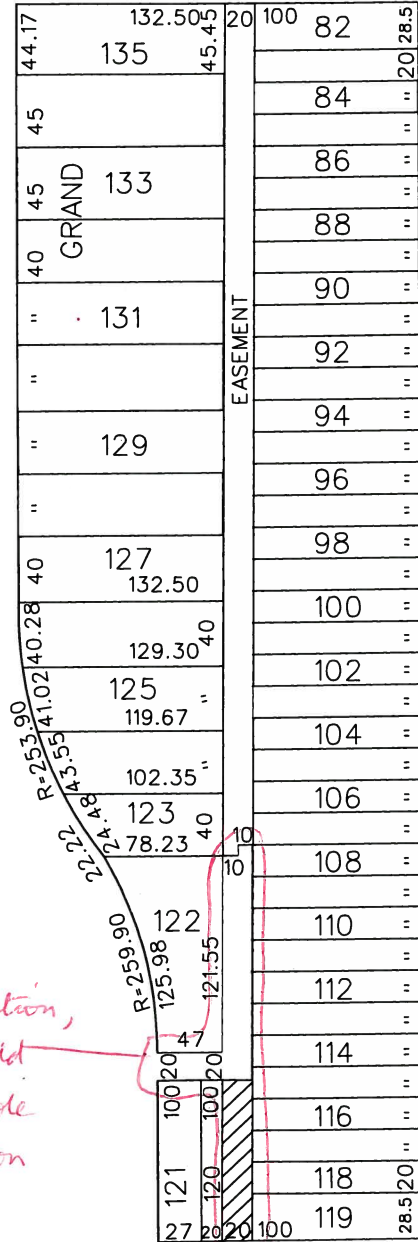

Mr. Beydoun,
 Per our phone conversation,
 it appears that you would
 like easement of this whole
 portion not just the portion
 marked in hatched

MCNICHOLS W. AVE. 66 FT. WD.

- REQUESTED CONVERSION TO EASEMENT

(FOR OFFICE USE ONLY) CARTO 122 D

REQUEST TO CONVERT TO EASEMENT THE NORTH/SOUTH PUBLIC ALLEY, 20 FT. WD. IN THE BLOCK BOUND BY MCNICHOLS W., WOODBINE, SANTA MARIA AVE. AND TELEGRAPH RD.		CITY OF DETROIT CITY ENGINEERING DEPARTMENT SURVEY BUREAU
DESCRIPTION REVISIONS DRAWN BY: WLW DATE: 08-15-14	DRWN CHKD APPD DATE CHECKED APPROVED	JOB NO. 01-01 DRWG. NO. X 2780

Walter Williams - Fwd: Regarding petition # 2780

From: Keith McCrary
To: Walter Williams
Date: 2/22/2016 3:40 PM
Subject: Fwd: Regarding petition # 2780
Attachments: Petition 2780_email to petitioner.pdf

Walter,

Please make this part of the electronic folder. See meenas email.

Keith McCrary
Supervisor of Maps and Records
Survey Bureau
City Engineering Division
Department of Public Works
[313-224-3970](tel:313-224-3970)
mccraryk@detroitmi.gov

Mike Duggan, Mayor

>>> Meena Antani 10/20/2014 9:30 AM >>>

Mr. Beydoun,

As discussed during our phone call this morning, I am sending you a sketch marked in red with the area you are requesting to easement. As you can see, the drawing I received from City Engineering Division only requests for easement of the portion marked in black hatched(i.e. the n/s alley abutting lots 115 thru 120.) Please let me know if you would like to easement all portions of the N/S as well as the E/W alleys abutting lots 108 thru 122. If that is the case, then we will need to ask City Engineering to revise the drawing to reflect that before I can respond to the petition.
Please call me if you have any questions.

Meena Antani, P. E.
Associate Traffic Engineer
City of Detroit
Department of Public Works
Traffic Engineering Division
2633 Michigan Avenue
Detroit, MI 48216
Phone: [\(313\) 224-1610](tel:313-224-1610)
Direct Ph: [\(313\) 628-5640](tel:313-628-5640)
Fax: [\(313\) 224-1304](tel:313-224-1304)
Email: antanim@detroitmi.gov

Mike Duggan, Mayor
