


PETITION NO. 359
 DETROIT HOUSING COMMISSION
 1301 E. JEFFERSON AVE.
 DETROIT, MICHIGAN 48207
 C/O MARTINA J. ORANGE
 PHONE NO. 313 877-8000



JOY RD. 120 FT. WD.

SOUTHFIELD FREEWAY

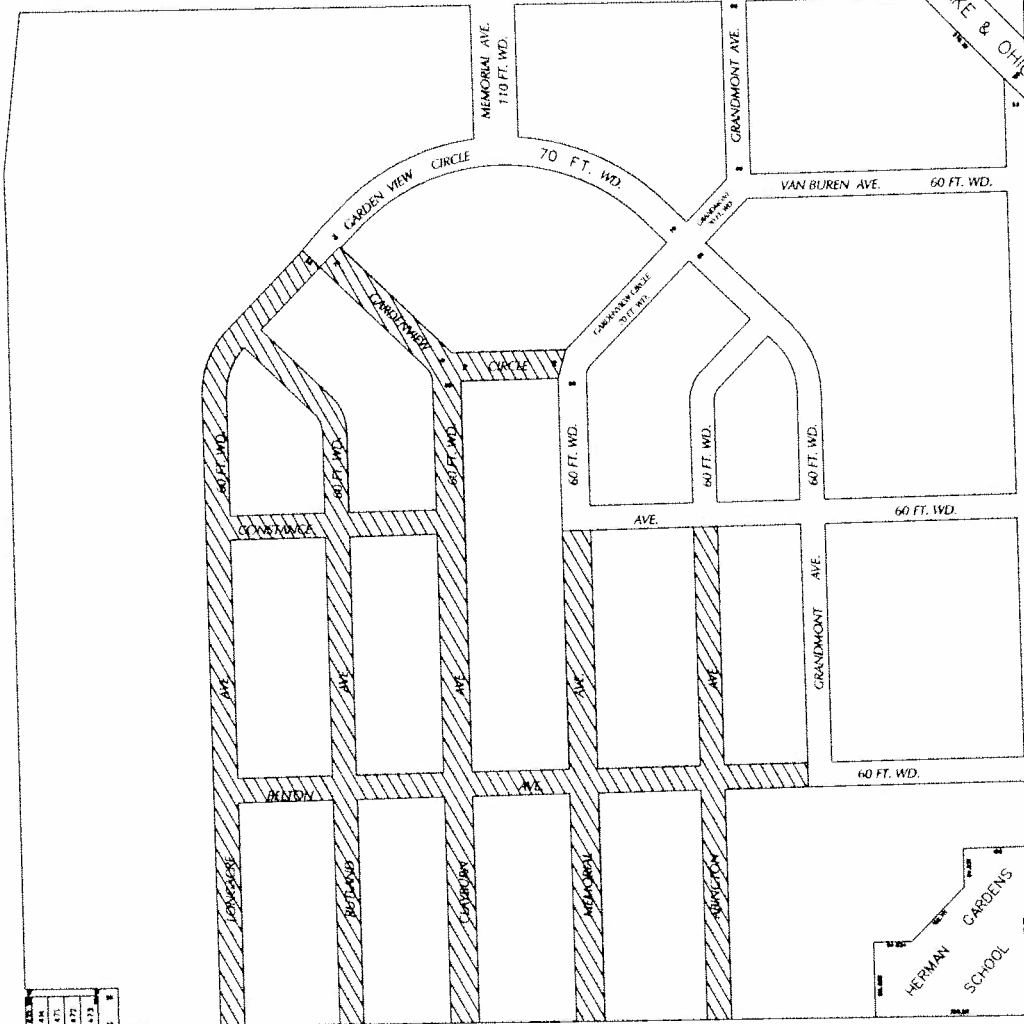

ASBURY PARK AVE. 86 FT. WD.

TIREMAN AVE. 103 FT. WD.



- REQUESTED TEMPORARY STREET CLOSURE

(FOR OFFICE USE ONLY)

CARTO 99 B


B						
A						
DESCRIPTION		DESIGN	CHECKED	APPD	DATE	
DRAWN BY		REVISIONS		CHECKED		
DATE		APPROVED				
08-04-14						

REQUEST TO TEMPORARY CLOSE
 VARIOUS PUBLIC STREET, VARIOUS WD.
 IN THE BLOCK BOUND BY
 JOY RD., ASBURY PARK, TIREMAN AVE.
 AND SOUTHFIELD FWY.


CITY OF DETROIT
 CITY ENGINEERING DEPARTMENT
 SURVEY BUREAU

JOB NO. 01-01


DRWG. NO. X 359

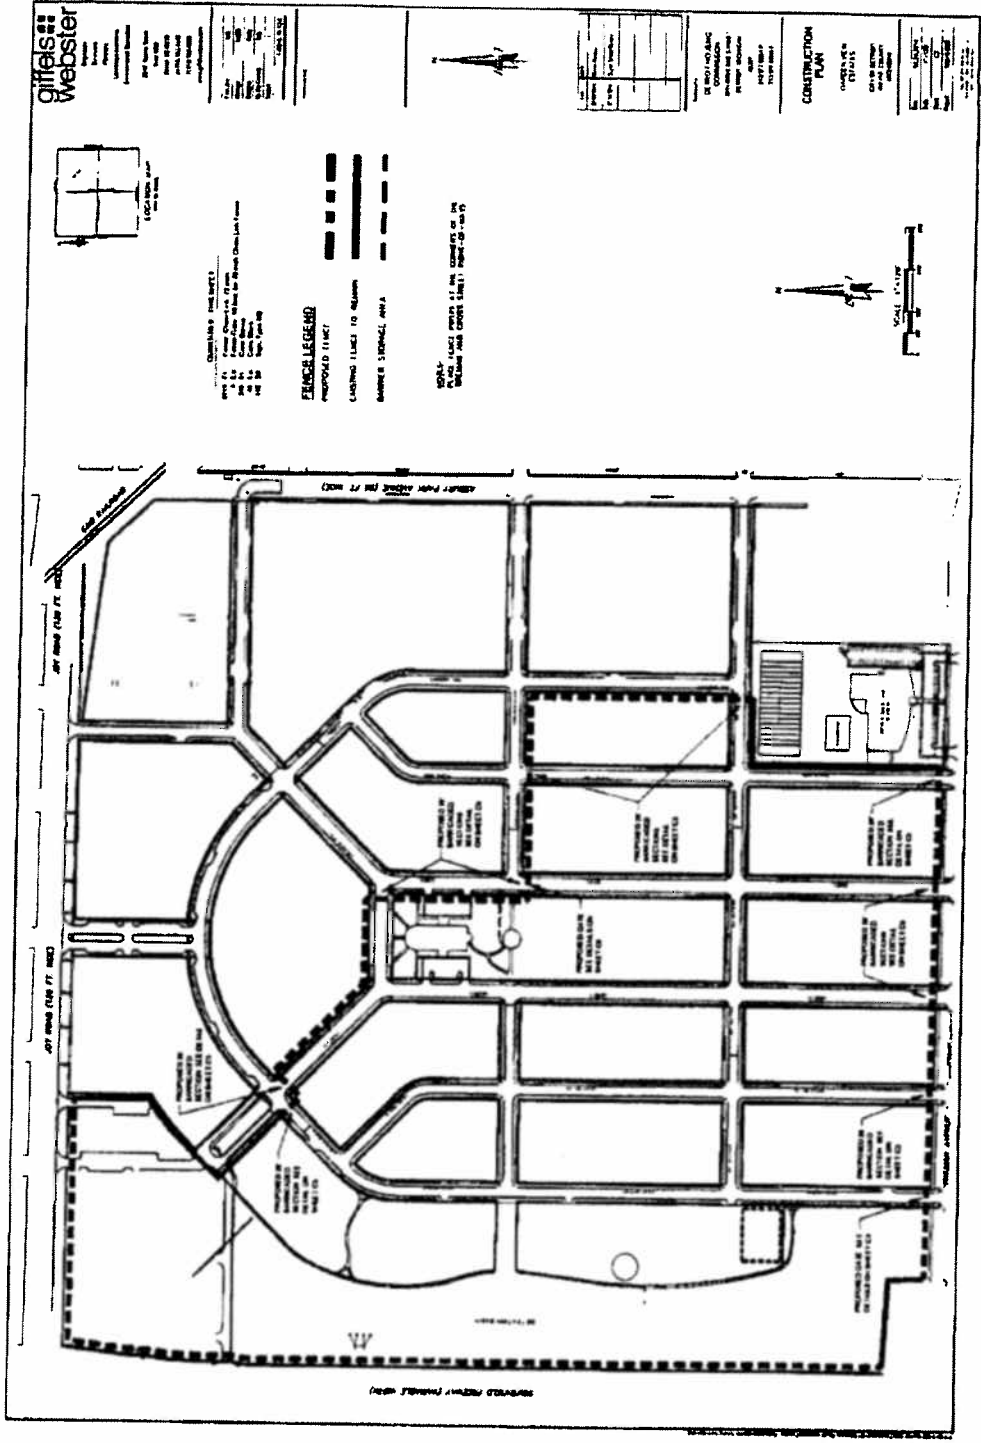



offeis
webster

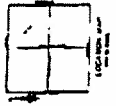


NO.	DESCRIPTION	DATE

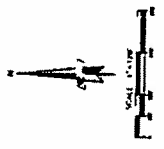

NOTE:
ONLY REFERENCE POST CONNECTION
CLIP DETAIL AND RELEVANT NOTES.

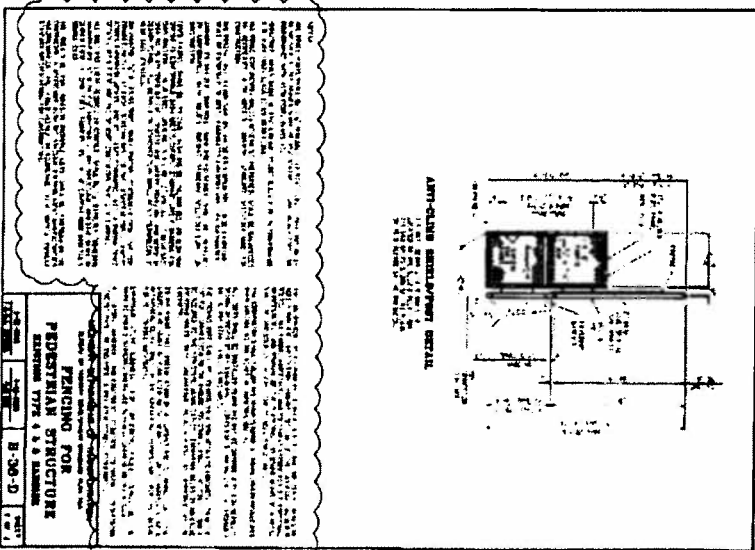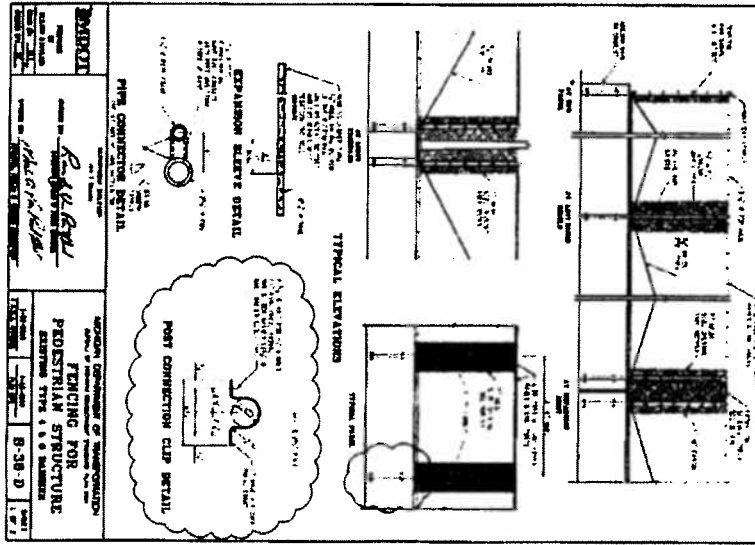

offices
weoster

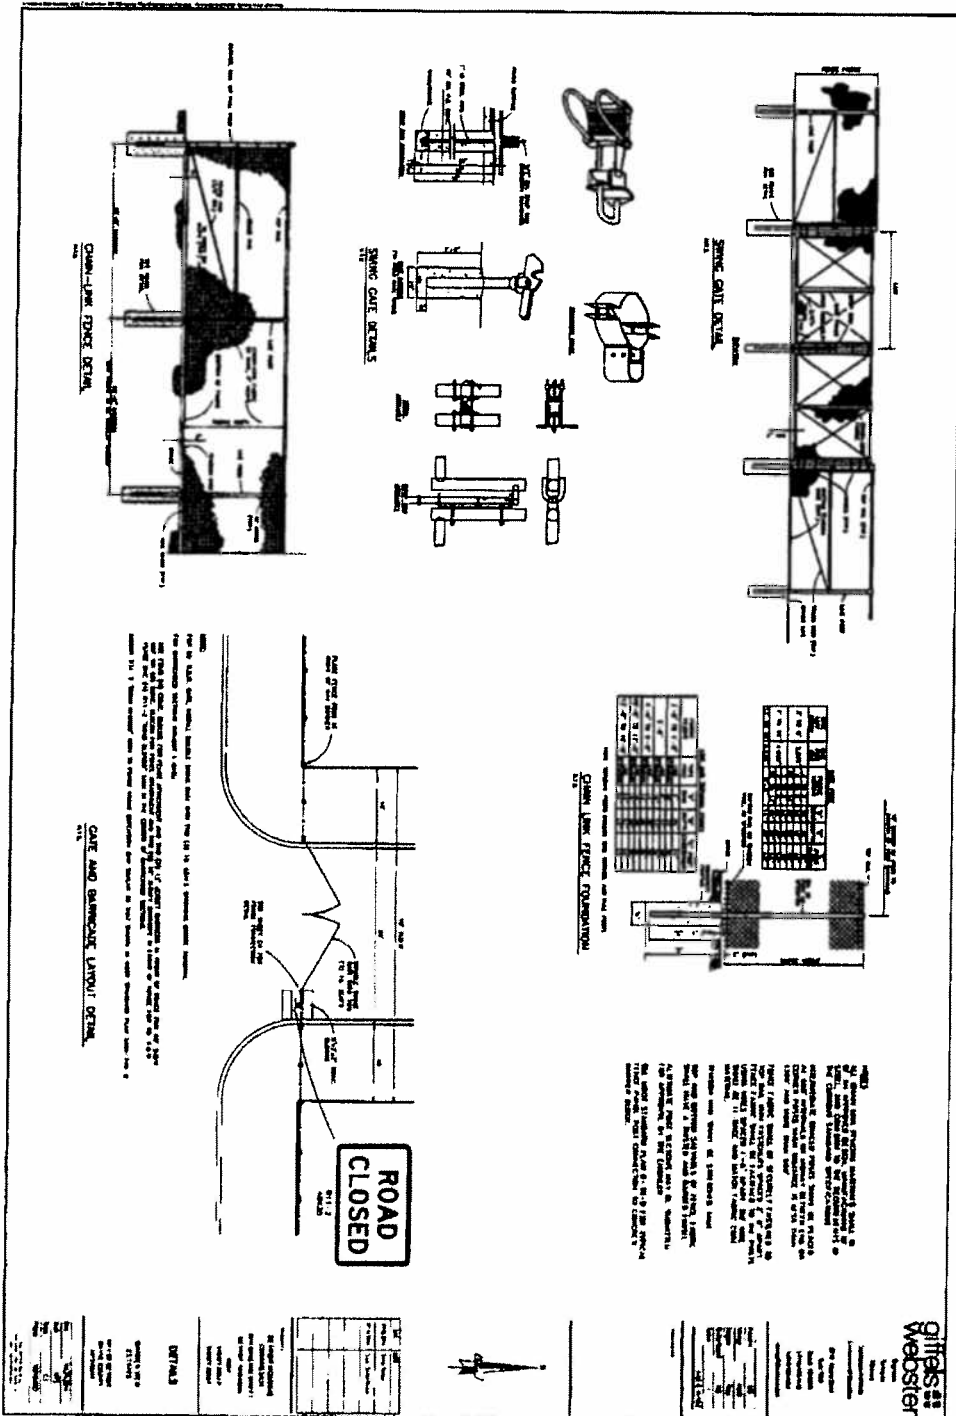

gintax
Webster

City of Detroit
City Engineering Division, Department of Public Works
Survey Bureau

NOTICE OF PROPOSED CHANGE IN PROPERTY Second Notice 9/3/14

Date: 08/04/2014

Petition: x359

- AT&T Telecommunication
- Cable Television (CATV)
- Detroit Edison (DTE)
- Michigan Consolidated Gas (DTE)
- Fire Department
- Planning & Development Department
- Public Lighting Dept. - Communication Division
- Public Lighting Dept. - Overhead Line Division
- Public Lighting Dept. - Underground Division
- Police Department
- Recreation Department
- Sanitation Division, DPW
- Street Design Bureau, DPW
- Street Maintenance Division, DPW
- Street and Traffic Division, DPW
- Water and Sewerage Dept. - Sewer Design
- Water and Sewerage Dept. - Water Design
- Vacation
- Conversion to Easement
- Dedication
- Encroachment
- Temporary Closing
- Berm Use

A petition drawing is attached. Property shown on the attached print is proposed to be changed as indicated.

Kindly report (using the back of this sheet) the nature of your services If any) affected by the proposed change and the estimated costs of removing and rerouting such services (if necessary).

Please return one copy to City Engineering Division, DPW. Retain one copy and print for you file.

Alfred Jordan, Director, Department of Public Works

By: Richard Doherty, CED DPW
 Head Engineer

TO: City Engineering Division, DPW
65 Cadillac Square, Suite 900
Detroit, Michigan 48226-2873
Survey Bureau: 313-224-3970

x359

The proposed change in property (referred to on the other side of this sheet) would affect our services as follows:

- Not Involved
- Involved; but asking you to hold action on this petition until further notice.
- Involved; but no objections to the property change .
- Involved; but no objections to the property change...provided as easement of the full width of the public right-of-way (street, alley or other public place) is reserved.
- Involved; the nature of our services, and the estimated costs of removing and/or rerouting such services are:

FIRE
(Utility or City Department)
Chris G. B. Hill
By
Chief of Plan Review
Title
10/27/14
Date
(313) 224-1341
Area code – Telephone number