

PRINCIPALS

Daniel W. Mitchell
Nancy M.D. Faught
Keith D. McCormack
Jesse B. VanDeCreek
Roland N. Alix
Michael C. MacDonald
James F. Burton
Charles E. Hart
Todd J. Sneathen

CONTROLLER

Donna M. Martin

SENIOR ASSOCIATES

Gary J. Tressel
Randal L. Ford
William R. Davis
Dennis J. Benoit
Robert F. DeFrain
Thomas D. LaCross
Albert P. Mickalich
Timothy H. Sullivan
Thomas G. Maxwell

ASSOCIATES

Marshall J. Grazioli
Colleen L. Hill-Stramsak
Bradley W. Shepler
Karyn M. Stickel
Jane M. Graham
Aaron A. Uranga
Salvatore Conigliaro
Melissa A. Coatta
Michael P. Darga
Brian K. Davies
James E. Scholl
Matthew G. Slicker
James J. Surhigh
Trevor S. Wagenmaker

HUBBELL, ROTH & CLARK, INC.

MAILING: PO Box 824
Bloomfield Hills, MI 48303-0824

SHIPPING: 555 Hulet Drive
Bloomfield Hills, MI 48302-0360

PHONE: 248-454-6300
WEBSITE: hrcengr.com

OTHER OFFICE LOCATIONS

Delhi Township
Detroit
Grand Rapids
Howell
Jackson
Kalamazoo
Lansing

November 29, 2018

AT&T
3110 Plymouth Road
Suite 301
Livonia, Michigan 48150

Sent to E-mail: ah1865@att.com

Attn: Anthony Hoover, Design Engineer, OSP

Re: Sacred Heart Major Seminary
Street Vacating – Lawton
Petition No. 1171

HRC Job No. 20170223

Dear Mr. Hoover:

In 2016, we received a Notice of Property Change Form from Joseph Paletna including an estimate for vacating Longfellow and Lawton. I have attached a copy of this correspondence and I am requesting to have this updated for Lawton and Longfellow Streets as shown on the attached plans. You have overhead lines on the existing poles along the east side of Lawton Street between Joy Road and West Chicago Blvd., the design has been altered to retain these poles as they exist.

If you have any questions or require any additional information, please contact the undersigned.

Very truly yours,

HUBBELL, ROTH & CLARK, INC.



Gary J. Tressel
Senior Associate



Melissa A. Coatta, P.E.
Associate

GJT/nef
Attachment

pc: Archdiocese of Detroit; Frank MacDonell, Michael McInerney, John Duncan
City of Detroit; Walter Williams
HRC; File

City of Detroit
City Engineering Division, Department of Public Works
Survey Bureau

NOTICE OF PROPOSED CHANGE IN PROPERTY

Date: 12/14/2018
~~06/14/2016~~

Petition: x1171

- | | |
|--|---|
| <input checked="" type="checkbox"/> AT&T Telecommunication | <input type="checkbox"/> Berm Use |
| <input type="checkbox"/> Comcast Television (CATV) | <input type="checkbox"/> Conversion to Easement |
| <input type="checkbox"/> Detroit Edison (DTE) | <input type="checkbox"/> Dedication |
| <input type="checkbox"/> Fire Department | <input type="checkbox"/> Encroachment |
| <input type="checkbox"/> Great Lakes Water Authority | <input type="checkbox"/> Temporary Closing |
| <input type="checkbox"/> Michcon (DTE) | <input checked="" type="checkbox"/> Vacation |
| <input type="checkbox"/> Planning & Development Department | |
| <input type="checkbox"/> Public Lighting Authority | |
| <input type="checkbox"/> Public Lighting Department | |
| <input type="checkbox"/> Police Department | |
| <input type="checkbox"/> Solid Waste Division, DPW | |
| <input type="checkbox"/> Street Design Bureau, DPW | |
| <input type="checkbox"/> Street Maintenance Division, DPW | |
| <input type="checkbox"/> Traffic Engineering Division, DPW | |
| <input type="checkbox"/> Water and Sewerage Department | |
| <input type="checkbox"/> _____ | |

A petition drawing is attached. Property shown on the attached print is proposed to be changed as indicated. Kindly report (using the back of this sheet) the nature of your services, if any affected by the proposed change and the estimated costs of removing and rerouting such services (if necessary).

Please return one copy to City Engineering Division, DPW within two weeks of the submittal date. Retain one copy and print for you file.

Ron Brundidge, Director, Department of Public Works

By: Richard Doherty, CED DPW
City Engineer

TO: City Engineering Division, DPW
2 Woodward Ave., Suite 642
Detroit, Michigan 48226-3462
Survey Bureau: 313-224-3970

Petition: x1171

The proposed change in property (referred to on the other side of this sheet) would affect our services as follows:

- Not Involved
- Involved; but asking you to hold action on this petition until further notice.
- Involved; but no objections to the property change.
- Involved; but no objections to the property change...provided as easement of the full width of the public right-of-way (street, alley or other public place) is reserved.

- Involved; the nature of our services and the estimated costs of removing and/or rerouting such services are: CONTACT CWO DEPT. @ (888) 901-2779

AT&T HAS CONDUIT RUNS ALONG LAWTON + LONGFELLOW + MANHOLE @ CORNER OF LAWTON / LONGFELLOW. ENGINEER FOR THIS AREA IS JOE PALETTA 313-510-7734

AT&T

(Utility or City Department)

~~JOE PALETTA~~ Ollie L Sanders
By

DESIGN ENGINEER
Title

~~12-14-16~~ 12-14-2018
Date


~~(313) 510 7734~~ 313-240-5591
Area code - Telephone number

PETITION NO. 1171
 ARCHDIOCESE OF DETROIT
 12 STATE ST.
 DETROIT, MICHIGAN 48226
 C/O MIKE MCINERNEY
 PHONE NO. 313 596-7161



WEST CHICAGO AVE. 194 FT. WD.

GENESSEE AVE. 60 FT. WD.

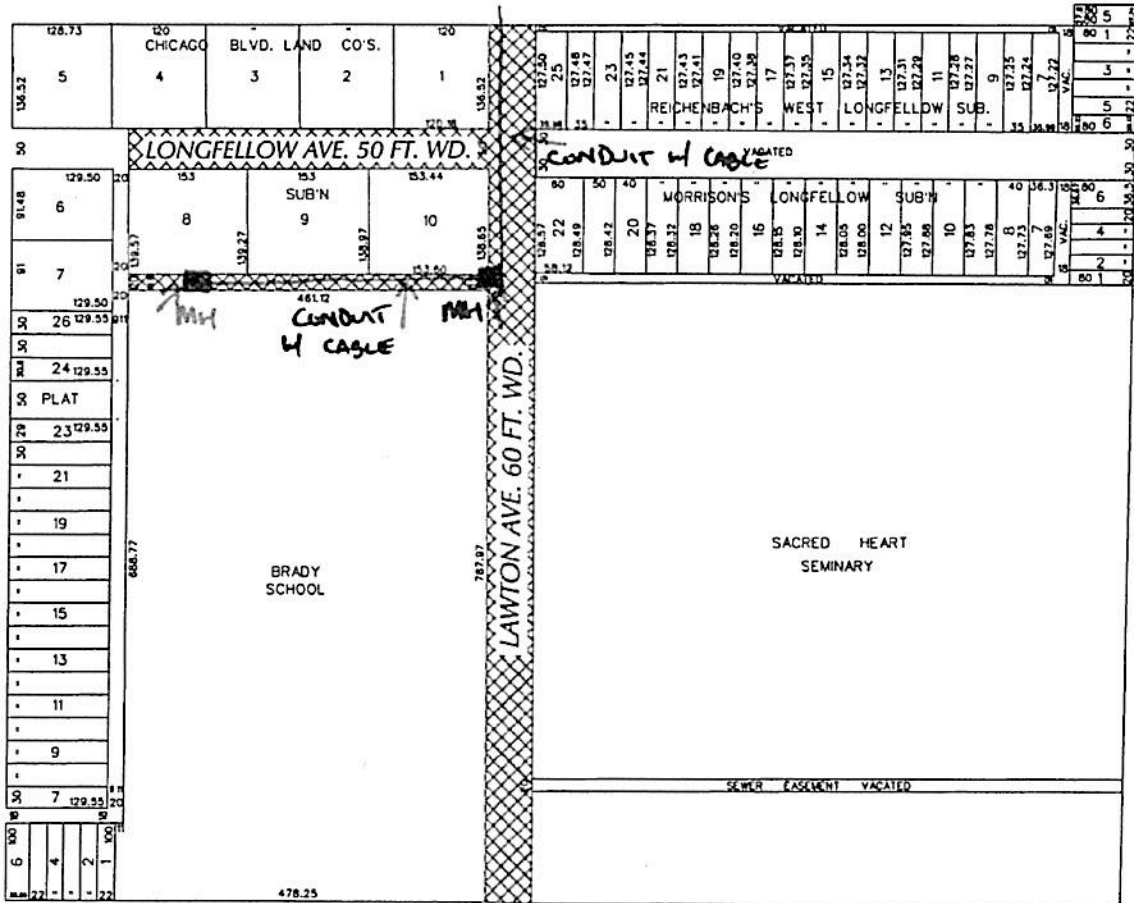

LINWOOD AVE. 86 FT. WD.

JOY RD. 66 FT. WD.



- OUTRIGHT VACATION

(FOR OFFICE USE ONLY)

CARTO 22 B

B					
A					
DESCRIPTION	DRWN	CHKD	APPD	DATE	
REVISIONS					
DRAWN BY	WLW	CHECKED			
DATE	06-14-16	APPROVED			

* REQUEST TO OUTRIGHT VACATE
 A PORTION OF LONGFELLOW AND LAWTON AVE.
 60 FT. WD. AND THE EAST/WEST
 PUBLIC ALLEY 20 FT. WD.
 IN THE AREA BOUND BY
 GENESSEE, W. CHICAGO, LINWOOD AVE.
 AND JOY RD.

CITY OF DETROIT
 CITY ENGINEERING DEPARTMENT
 SURVEY BUREAU
 JOB NO. 01-01
 DRWG. NO. X 1171