

**Walter Williams - Re: Petition #1202 - "REVISED"**

---

**From:** Edward Siegel <esiegel@jacobsst.com>  
**To:** Walter Williams <williamswl@detroitmi.gov>  
**Date:** 7/27/2017 11:07 AM  
**Subject:** Re: Petition #1202 - "REVISED"  
**Attachments:** 7272017 Revised 1202.pdf

---

Walter,


I would like to please revise my request to vacate and convert to easement, that area not already vacated, the alley to only that area between lots 96- East 10 feet of lot 100.

This request permits all users east of lot 100 to utilize the alley and exit onto East Baltimore, should it ever be usable in the future.

Please see area highlighted in red attached.

Thanks,  
Ed

PETITION NO. 1202  
 248 EAST BALTIMORE LLC  
 C/O JACOBSSTREET  
 P.O. BOX 160  
 DETROIT, MICHIGAN 48207  
 C/O EDWARD SIEGEL  
 PHONE NO. 313 638-1470

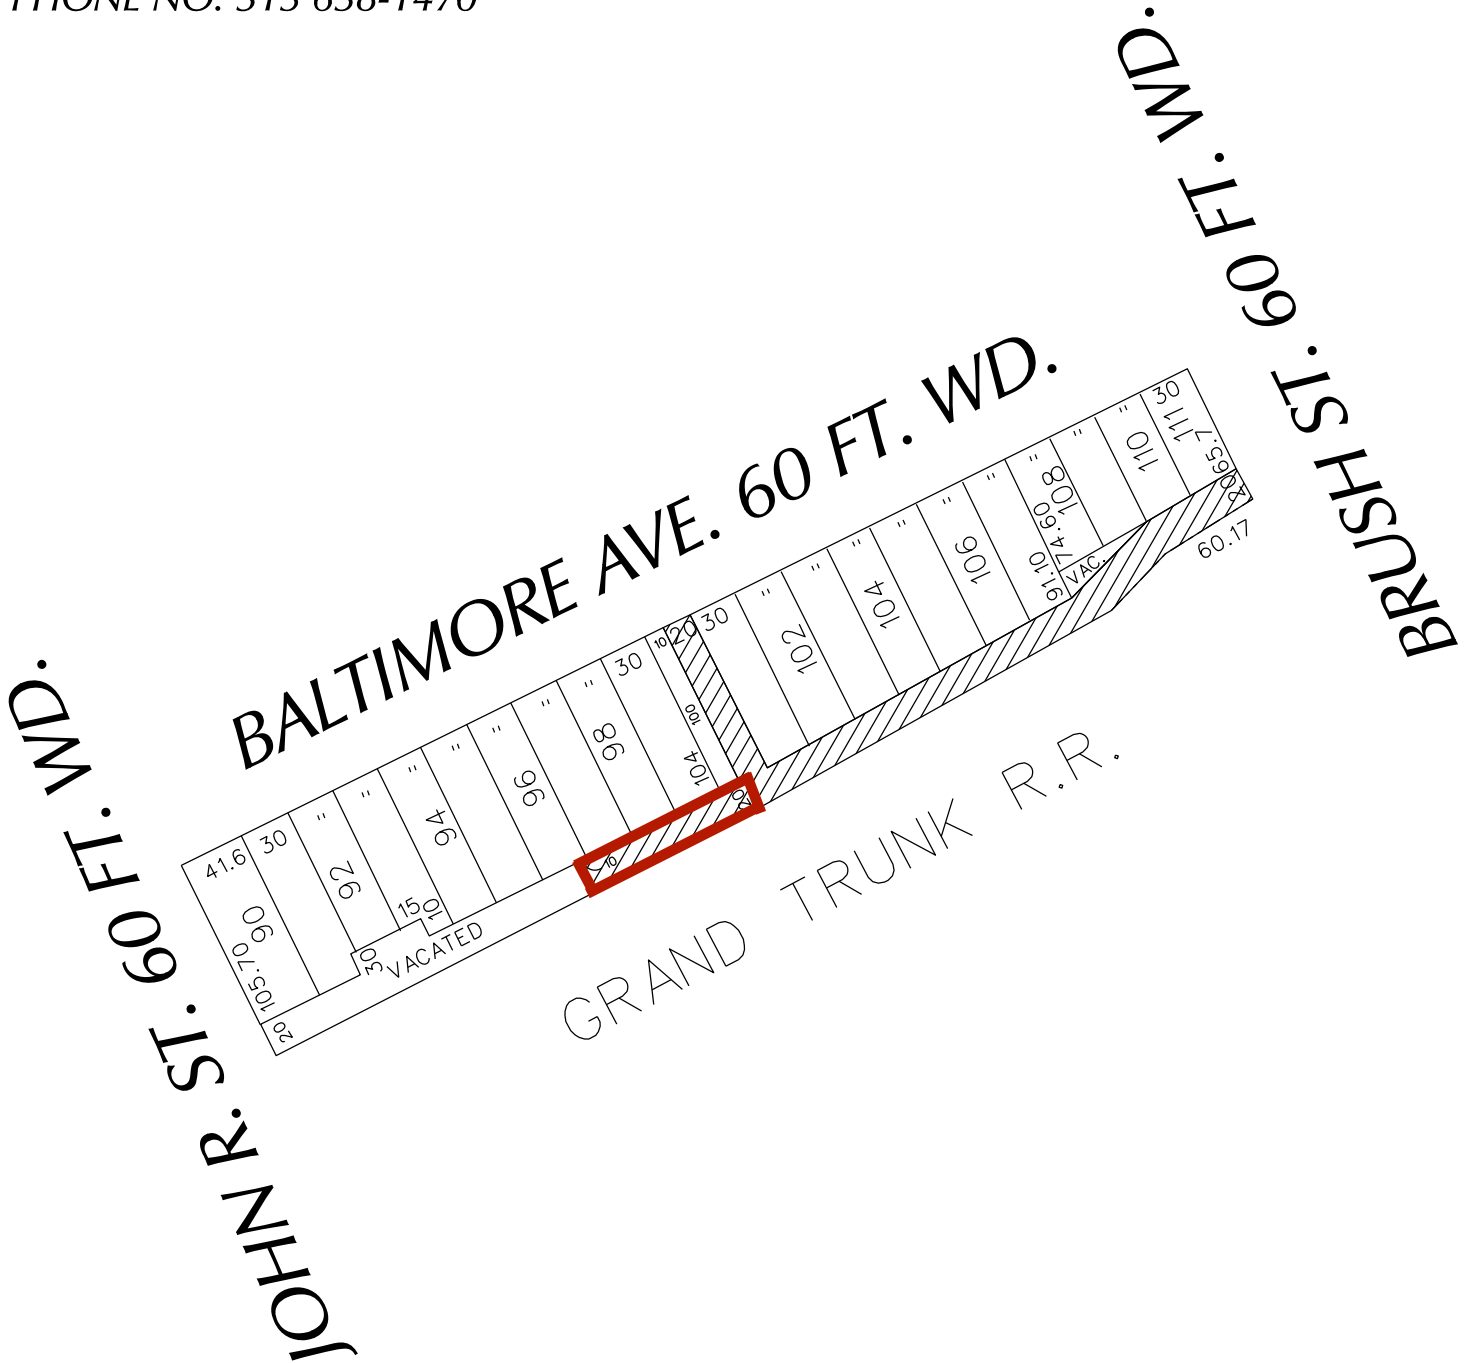

 - REQUESTED CONVERSION TO EASEMENT

(FOR OFFICE USE ONLY)

CARTO 31 F

B						REQUEST TO CONVERT TO EASEMENT A PORTION OF THE EAST/WEST AND THE NORTH/SOUTH PUBLIC ALLEY, 20 FT. WD. IN THE BLOCK BOUND BY BALTIMORE AVE., JOHN R., BRUSH ST. AND GRAND TRUNK R.R.	CITY OF DETROIT CITY ENGINEERING DEPARTMENT SURVEY BUREAU
A							JOB NO. 01-01
DESCRIPTION		DRWN	CHKD	APPD	DATE		DRWG. NO. X 1202
DRAWN BY		REVISIONS					
DATE		CHECKED					
07-06-16		APPROVED					