Walter Williams - Re: Petition #1244 - Review and Approval

From:

Christina Heximer <heximech@udmercy.edu>

To:

Walter Williams < williams wl@detroitmi.gov>

Date:

8/24/2016 10:30 AM

Subject:

Re: Petition #1244 - Review and Approval Attachments: x1244 Heximer comments.pdf; ATT00001.htm

Walter,

I was looking at the drawing a little closer, and everything looks good except for the piece of the installation furthest north. The black square that is drawn has another frame extension north of the box which is just the width of a 2x8 and is 19' long. I drew a red line on your drawing which is reattached.

Everything else looks fine.

Christina

Christina Heximer Associate Director Detroit Collaborative Design Center University of Detroit Mercy School of Architecture 4001 W. McNichols Rd. Detroit, MI 48221-3038 (t) 313.993.1037 (f) 313.993.1512

www.dcdc-udm.org

PETITION NO. 1244 DETROIT COLLABORATIVE DESIGN CENTER 4001 W. MCNICHOLS RD. DETROIT, MICHIGAN 48221 C/O CHRISTINA HEXIMER PHONE NO. 313 993-1037




CHESTERFIELD RD.
50 FT. WD.
CLUSTER DR

W. OUTER DR. 150 FT. WD.

	150	, ,	٠.	***	•		
	55	5	18	73 127	45	L	
	75	76			04		
Ŋ	140		140	125			
· -	®EASEN S	NENT 110	40.5818			4.5	
STOEPEL AVE. 60 FT. WD.	96.04 7 04	7	40	123			
9	_	9	-		1		
Æ.	3		-	121	*	120	
F	_	31				LIVERNOIS AVE. S.B.	
H		-	7	119	+1	SAV	
)EI	. 8	33			•	Š	
STC	1		7	117	*	VER	1
- 1	04 8	35			9		1
	44	86	110	آب 115 73	57.26		

WARRINGTON DR. 50 FT. WD. \Box 73.51 219 167.40 259 175.45 221 181,10 73.33 223 73.29 257 188.10 225 255 LIVERNOIS AVE. N.B. 73.16 254 CAMBRIDGE AVE. 227

CAMBRIDGE AVE. 60 FT. WD. CHESTERFIELD RD. 50 FT. WD.

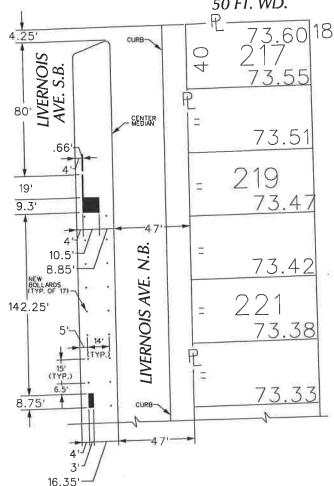

- REQUEST ENCROACHMENT (With Public Art Installation & Bollards)

(FOR OFFICE USE ONLY)

CARTO 27 D & 88 F

В						
A						
D	ESCRI	PTION	DRWN	CHKD	APPD	DATE
		REVI	SIONS			
DRAWN	BY	WLW	CHECKED			
08-24-16			APPR	OVED		

REQUEST ENCROACHMENT INTO LIVERNOIS AT 19376 - 19384 LIVERNOIS (With Public Art Installation & Bollards)

C	ITY	OF	D	ETROIT
CITY	ENGIN	IEERI	NG	DEPARTMENT
	SUI	RVEY	BU	REAU

JOB NO.	01-01	
DRWG. NO.	X 1244	