



City of Detroit  
Inter-Departmental Communication

---

**TO:** Richard Doherty, City Engineer  
City Engineering/Department of Public Works

**FROM:** Debra Singleton, Engineer  
Detroit Water and Sewerage Department

**DATE:** February 8, 2018

**RE:** Petition No. 1659  
Requested Encroachment Into Medina At 8150 Medina (With Tiebacks And  
Deadmans)

---

We have reviewed the above Petition received by this office. With regard to DWSD's interests, our comments are as follows:

- DWSD has shallow in depth water mains and sewers, which are shown in the attached plans for the area of the proposed encroachment. DWSD has no objections to the requested encroachments provided that the attached Provisions for Encroachment are strictly followed.

If you have any questions, please call me at (313) 267-8309 or Mohammed Fa Siddique at (313)-964-9245.

Sincerely,

Debra Singleton  
Engineer  
Permits

DS/MS/gj

Attachments

CC: Mohamad Farhat, CSF

Michael Duggan, Mayor

City of Detroit  
**City Engineering Division, Department of Public Works**  
**Survey Bureau**

**NOTICE OF PROPOSED CHANGE IN PROPERTY**

Date: 01/02/2018

Petition: x1659

- |  |  |
|--|--|
| <input type="checkbox"/> AT&T Telecommunication            | <input type="checkbox"/> Berm Use                |
| <input type="checkbox"/> Comcast Television (CATV)         | <input type="checkbox"/> Conversion to Easement  |
| <input type="checkbox"/> Detroit Edison (DTE)              | <input type="checkbox"/> Dedication              |
| <input type="checkbox"/> Fire Department                   | <input checked="" type="checkbox"/> Encroachment |
| <input type="checkbox"/> Great Lakes Water Authority       | <input type="checkbox"/> Outright Vacation       |
| <input type="checkbox"/> Land Bank Authority               | <input type="checkbox"/> Temporary Closing       |
| <input type="checkbox"/> Michcon (DTE)                     |  |
| <input type="checkbox"/> Planning & Development Department |  |
| <input type="checkbox"/> Public Lighting Authority         |  |
| <input type="checkbox"/> Public Lighting Department        |  |
| <input type="checkbox"/> Police Department                 |  |
| <input type="checkbox"/> Solid Waste Division, DPW         |  |
| <input type="checkbox"/> Street Design Bureau, DPW         |  |
| <input type="checkbox"/> Street Maintenance Division, DPW  |  |
| <input type="checkbox"/> Traffic Engineering Division, DPW |  |
| <input type="checkbox"/> Water and Sewerage Department     |  |
| <input type="checkbox"/> _____                             |  |

A petition drawing is attached. Property shown on the attached print is proposed to be changed as indicated. Kindly report (using the back of this sheet) the nature of your services, if any affected by the proposed change and the estimated costs of removing and rerouting such services (if necessary).

Please return one copy to City Engineering Division, DPW within two weeks of the submittal date. Retain one copy and print for you file.

Ron Brundidge, Director, Department of Public Works

By: Richard Doherty, CED DPW  
City Engineer

**TO: City Engineering Division, DPW  
2 Woodward Ave., Suite 642  
Detroit, Michigan 48226-3462  
Survey Bureau: 313-224-3970**

**Petition: x1659**

The proposed change in property (referred to on the other side of this sheet) would affect our services as follows:

- Not Involved
  
- Involved; but asking you to hold action on this petition until further notice.
  
- Involved; but no objections to the property change.
  
- Involved; objection to the property change.
  
- Involved; but no objections to the property change...provided as easement of the full width of the public right-of-way (street, alley or other public place) is reserved.
  
- Involved; the nature of our services and the estimated costs of removing and/or rerouting such services are:

\_\_\_\_\_  
(Utility or City Department)


\_\_\_\_\_  
By

\_\_\_\_\_  
Title

\_\_\_\_\_  
Date

\_\_\_\_\_  
Area code – Telephone number

PETITION NO. 1659  
 U.S. ENVIRONMENTAL PROTECTION AGENCY  
 9311 GROH RD.  
 GROSSE ILE., MICHIGAN 48138  
 C/O JAMIE BEAVER  
 PHONE NO. 971 409-2478

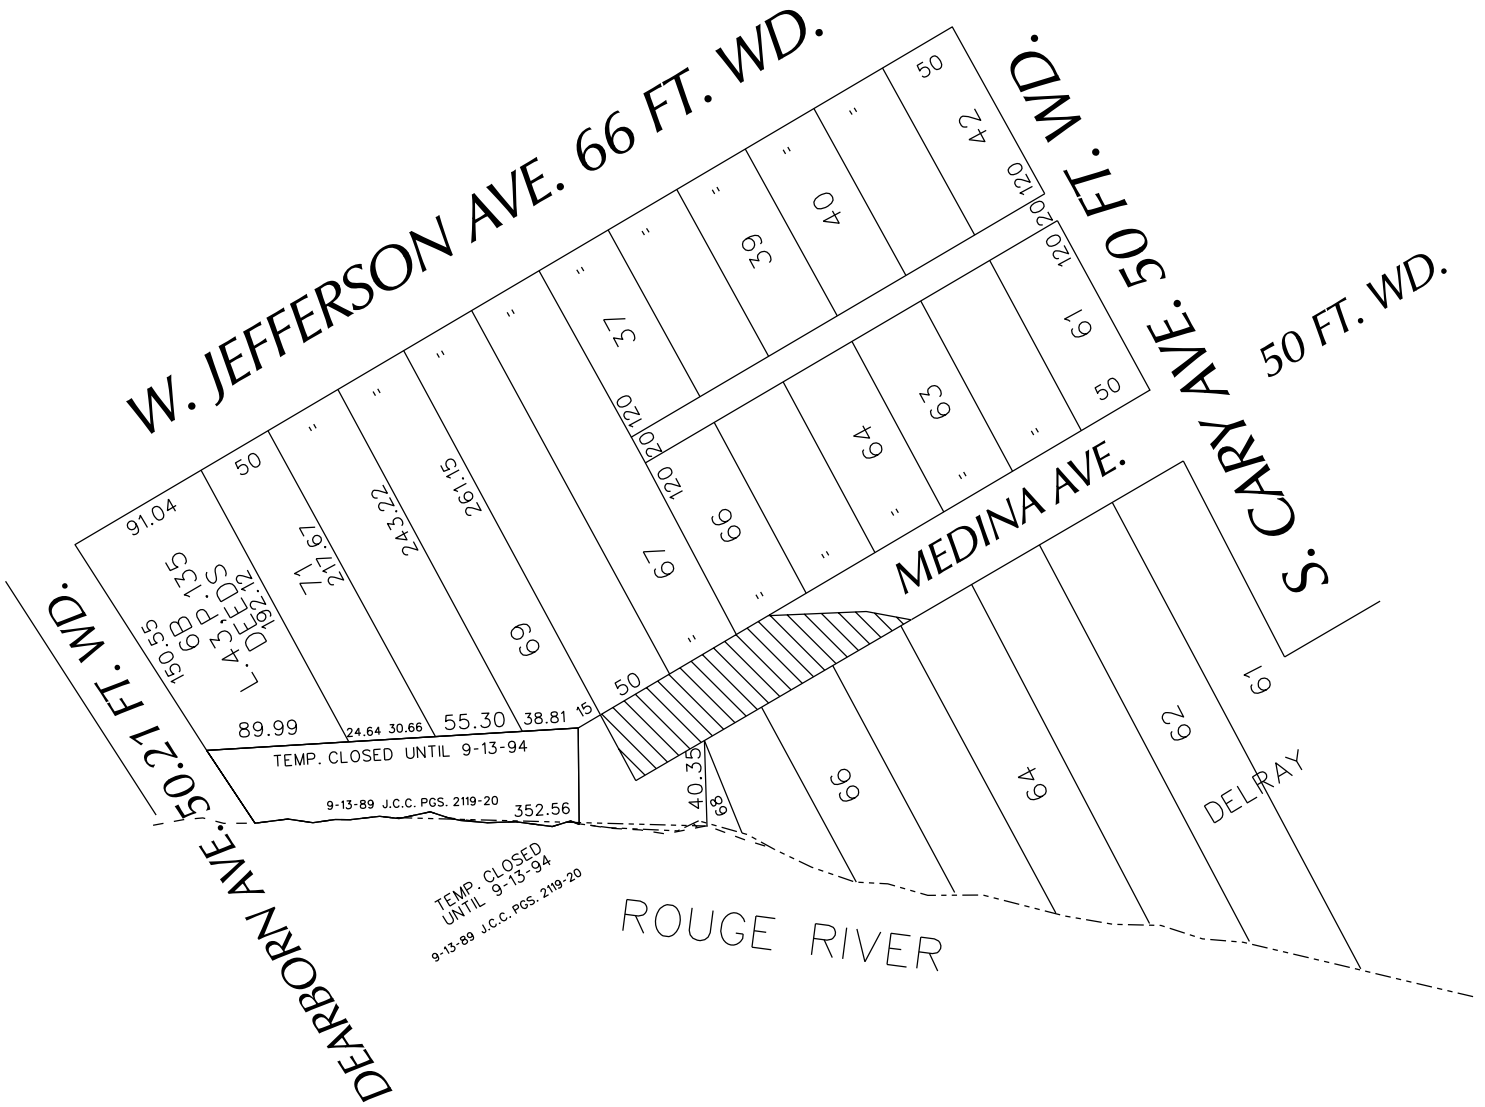

- AREA OF ENCROACHMENT

(FOR OFFICE USE ONLY)

CARTO 1 A & F

B					
A					
DESCRIPTION		DRWN	CHKD	APPD	DATE
REVISIONS					
DRAWN BY	WLW	CHECKED			
DATE	01-02-18	APPROVED			

REQUEST ENCROACHMENT  
 INTO MEDINA  
 AT 8150 MEDINA ST.  
 (With Tiebacks and Deadmans)

CITY OF DETROIT CITY ENGINEERING DEPARTMENT SURVEY BUREAU	
JOB NO.	01-01
DRWG. NO.	X 1659



## **PROVISIONS FOR ENCROACHMENT For Petition 1659**

Detroit Water and Sewerage (DWSD) agree to the proposed encroachment subject to the fulfilling of the following provisions:

1. By approval of this petition the (DWSD) does not waive any of its rights to its facilities located in the right of way, and at all time, DWSD, its agents or employees, shall have the right to enter upon the right of way to maintain, repair, alter, service, inspect, or install its facilities. All costs incident to the damaging, dismantling, demolishing, removal and replacement of structures or other improvements herein permitted and incurred in gaining access to DWSD's facilities for maintenance, repairing, alteration, servicing or inspection caused by the encroachment shall be borne by the petitioner. All costs associated with gaining access to DWSD's facilities, which could normally be expected had the petitioner not encroached into the right of way shall be borne by DWSD.
2. All construction performed under this petition shall not be commenced until after five (5) days written notice to DWSD. Seventy-two (72) hours notice shall also be provided in accordance with P.A. 53 1974, as amended, utilizing the MISS DIG one call system.
3. Construction under this petition is subject to inspection and approval by DWSD forces. The cost of such inspection shall, at the discretion of DWSD, be borne by the petitioner.
4. If DWSD facilities located within the right of way shall break or be damaged as the result of any action on the part of the petitioner, then in such event the petitioner agrees to be liable for all costs incident to the repair, replacement or relocation of such broken or damaged DWSD facilities.
5. The petitioner shall hold DWSD harmless for any damage to the encroaching device constructed or installed under this petition, which may be caused by the failure of DWSD's facilities.

## **Detroit Water & Sewerage Department (DWSD) Notes:**

- Our records indicate that there are water mains and sewers which are located in the vicinity of the proposed project limits.
- It is DWSD's requirement that any proposed utility crossing DWSD water mains or sewers perpendicularly must maintain a minimum of 18 inches vertical clearance. Also any proposed utility running adjacent to DWSD water mains and sewers must maintain a minimum of 5 feet lateral clearance including any conduit and/or manholes walls. No utility is allowed to run along the top of the water main or sewer.
- There are possibilities of several water and sewer service lines crossing in the vicinity of proposed work, field verify their location and depth to maintain our required clearance.
- Detroit Water and Sewerage Department (DWSD) prohibits the use of heavy construction equipment (bulldozers, backhoes, extremely large rollers, etc.) and or storage of building material directly over or near our mains or sewers. DWSD also prohibits the use of cranes and balls or hydraulic rams for pavement removal where the DWSD facilities are involved. If the water main or sewer facilities are broken or damaged as a result of any action on the part of the contractor, then the contractor shall be liable for all costs incidental to the repair of such broken or damaged water main/sewer facilities and appurtenances. The contractor shall waive all claims for damages under such circumstances.
- For any proposed work that involves DWSD utilities (water mains and/or sewers), an approval and a permit is required from DWSD before the commencement of work.





8150 Medina Street

W Jefferson Ave

W Jefferson Ave

W Jefferson Ave

W Jefferson Ave

Dearborn St

Medina St

Barnes St


Barnes St

Rouge River

Rouge River

Rouge River




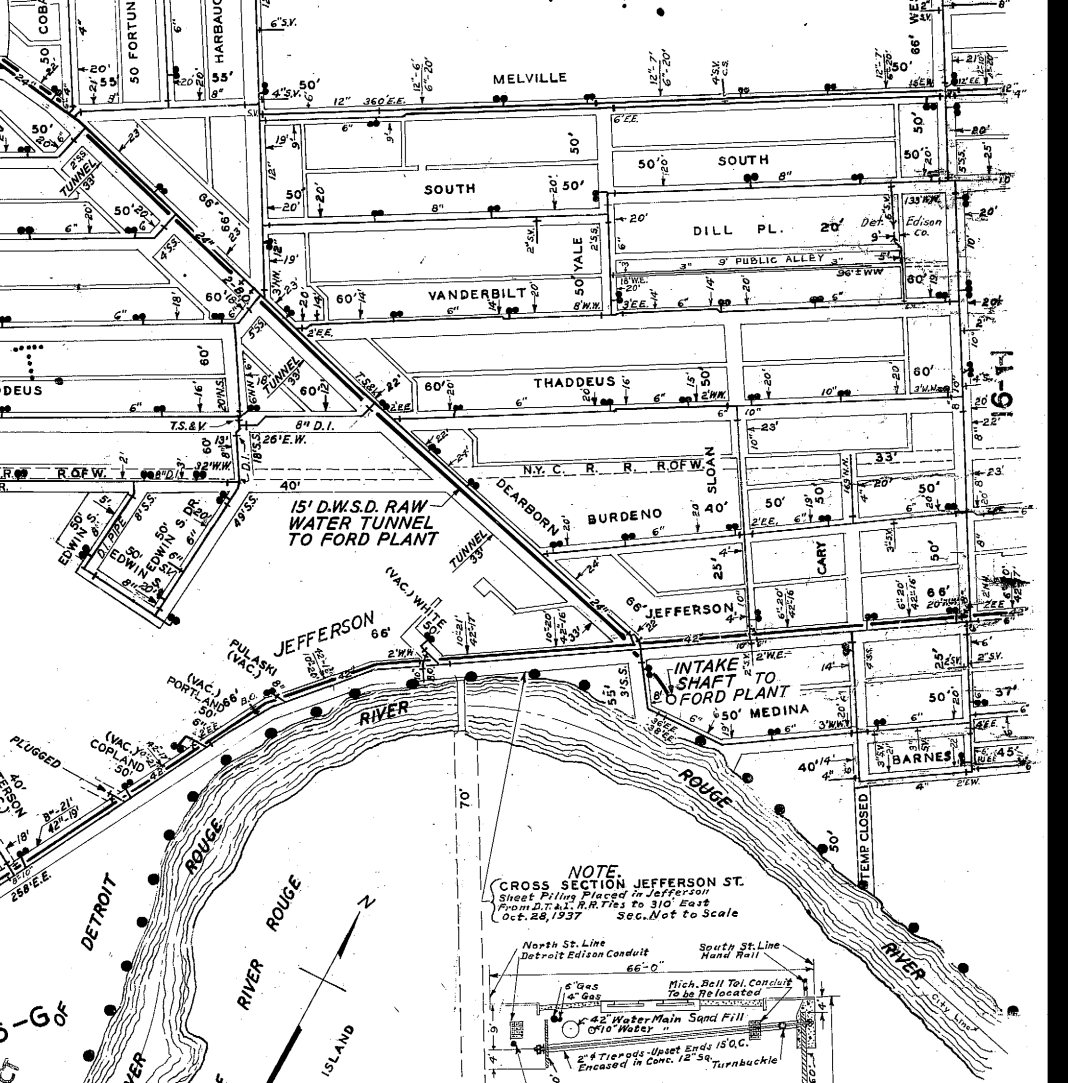


15' D.W.S.D. RAW  
WATER TUNNEL  
TO FORD PLANT

INTAKE  
SHAFT  
TO  
FORD PLANT

**NOTE.**  
CROSS SECTION JEFFERSON ST.  
Sheet Piling Placed in Jefferson St.  
From D. & M. R.R. Ties to 310' East  
Oct. 28, 1937 Sec. Not to Scale

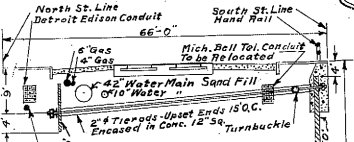

16-1

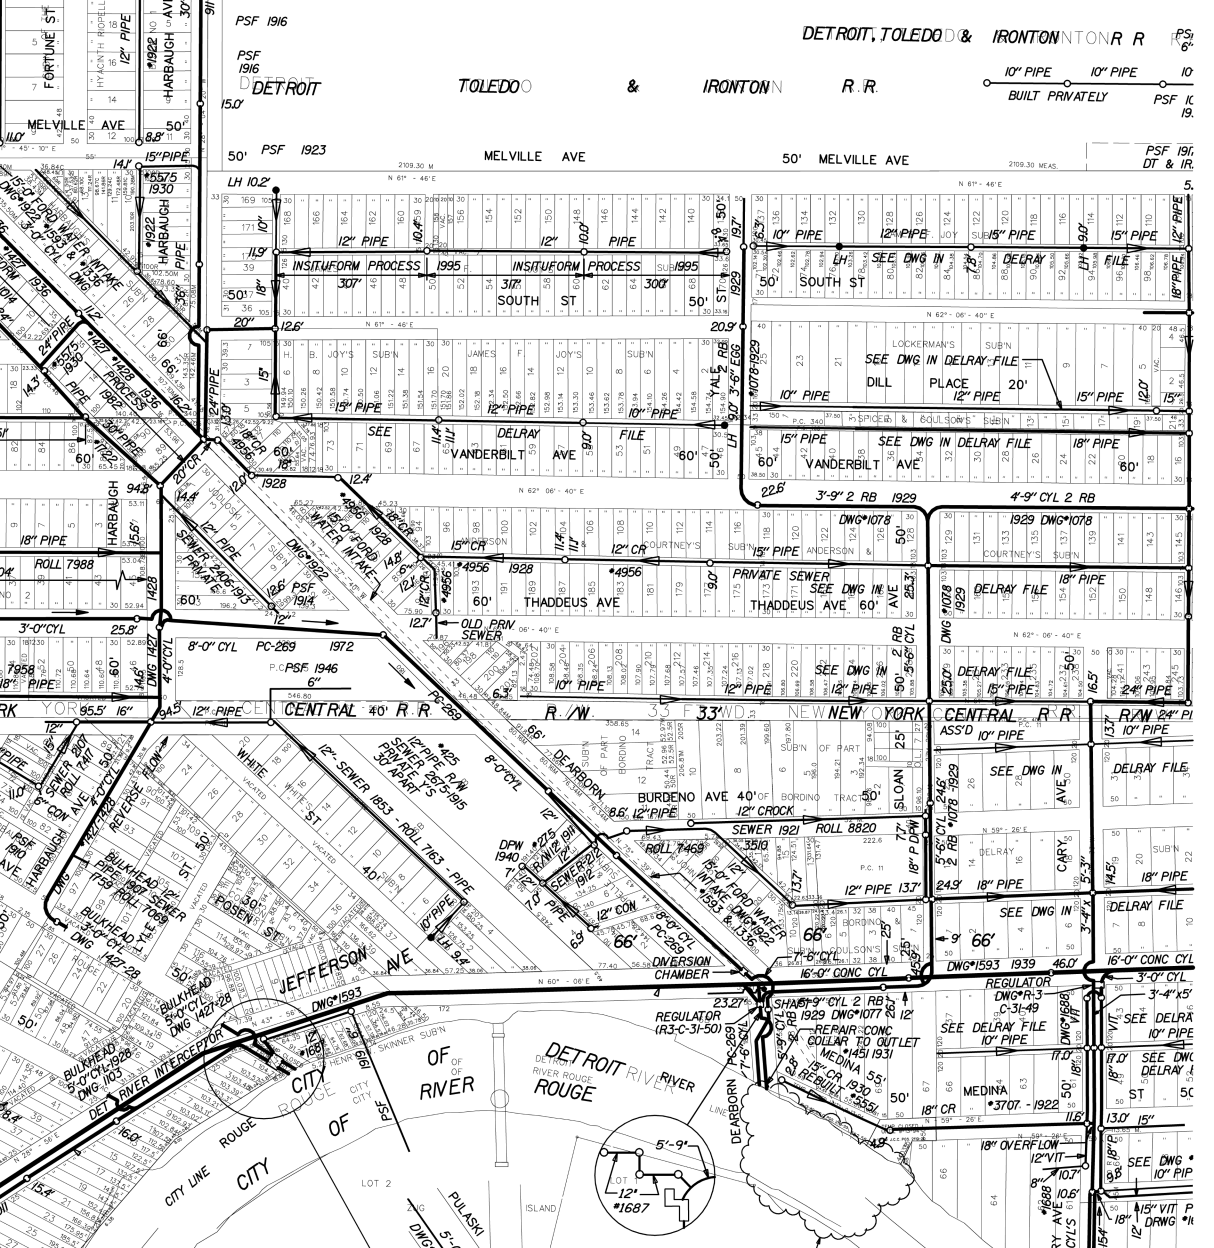

50' PSF 1923

MELVILLE AVE

50' MELVILLE AVE

PSF 1916 DT & IR

LH 10.2'

N 61° - 46' E

N 61° - 46' E

12" PIPE 12" PIPE 12" PIPE 10" PIPE 12" PIPE 15" PIPE 12" PIPE 15" PIPE 12" PIPE

INSITUFORM PROCESS 1995 INSITUFORM PROCESS 1995

SEE DWG IN DELAY-FILE

SOUTH ST 307' SOUTH ST 300'

LOCKERMAN'S SUBN SEE DWG IN DELAY-FILE

DELRAY VANDERBILT AVE 390'

DILL PLACE 12" PIPE 20' 15" PIPE 12" PIPE 15" PIPE 12" PIPE

SEE DELRAY VANDERBILT AVE 390'

SEE DWG IN DELRAY FILE 18" PIPE 18" PIPE 18" PIPE

4956 1928 4956 THADDEUS AVE 60'

DWG#1078 1929 1929 DWG#1078 18" PIPE

OLD PRN SEWER THADDEUS AVE 60'

SEE DWG IN DELAY FILE 18" PIPE 18" PIPE 18" PIPE

8-0" CYL PC-269 1972 6" PSF 1946

250' DELAY FILE 18" PIPE 18" PIPE 24" PIPE

CENTRAL 40' R R R/W

NEW NEW YORK CENTRAL R R ASS'D 10" PIPE

WHITE ST 12" SEWER 1853 - ROLL 783 PIPE

SEE DWG IN DELAY FILE

JEFFERSON AVE 12" CON 12" CON

DEARBORN RIVER

REGULATOR (R3-C-31-501)

REGULATOR (R3-C-31-501)

DETROIT RIVER ROUGE

DEARBORN RIVER

CITY LINE CITY OF ROUGE

DEARBORN RIVER

CITY OF ROUGE


DEARBORN RIVER

CITY OF ROUGE

DEARBORN RIVER

CITY OF ROUGE

DEARBORN RIVER

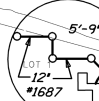



Roll 10/3/22

Sept 20 1922 74

# MEDINA LATERAL SEWER IN ALLEY

IN BLOCKS BOUNDED BY

FROM JEFFERSON TO CARY  
DETAILS


TOTAL LENGTH OF SEWER 677.50 FT. M. OR L.

" " " 18" CROCK 417.50 INC. 15-6" Y3 & 1 Bend  
" " " 15" " 260.00 " 9-6" Y3.

TWO MANHOLES INC. 6 IRON STEPS & 3-12" CON'S.

MATERIAL FOR EXTENSION OF Y3.

15-2 FT. BENDS & 240'00 of 6" CROCK

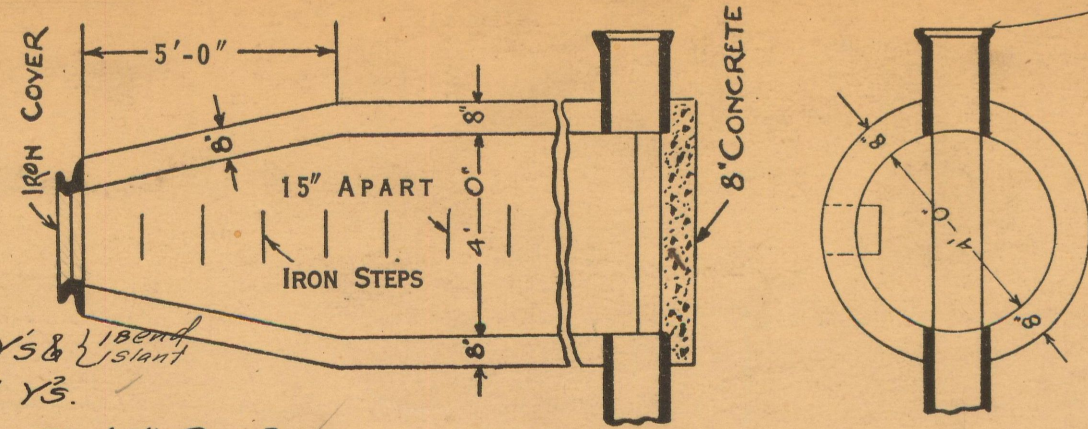


SECT'S OF M.H.

SEWER No. 3707  
ROLL No. 9017A

PETITION No. Letter to Commis. from P. G. ...  
PETITION DATE June 21, 1922  
RESOLUTION AUG 15 1922  
BIDS OPENED AUG 23 1922  
CONTRACT CONF'D Aug 29 1922  
COMPLETED OCT 3 1922  
CONT'R M. Mucci  
\$ 2,140.00


DEPARTMENT OF PUBLIC WORKS  
CITY ENGINEER'S OFFICE  
DETROIT, MICH.

Plat of Division of P.C. 45  
Rec. Oct 14 - 1851 - 43 - 45

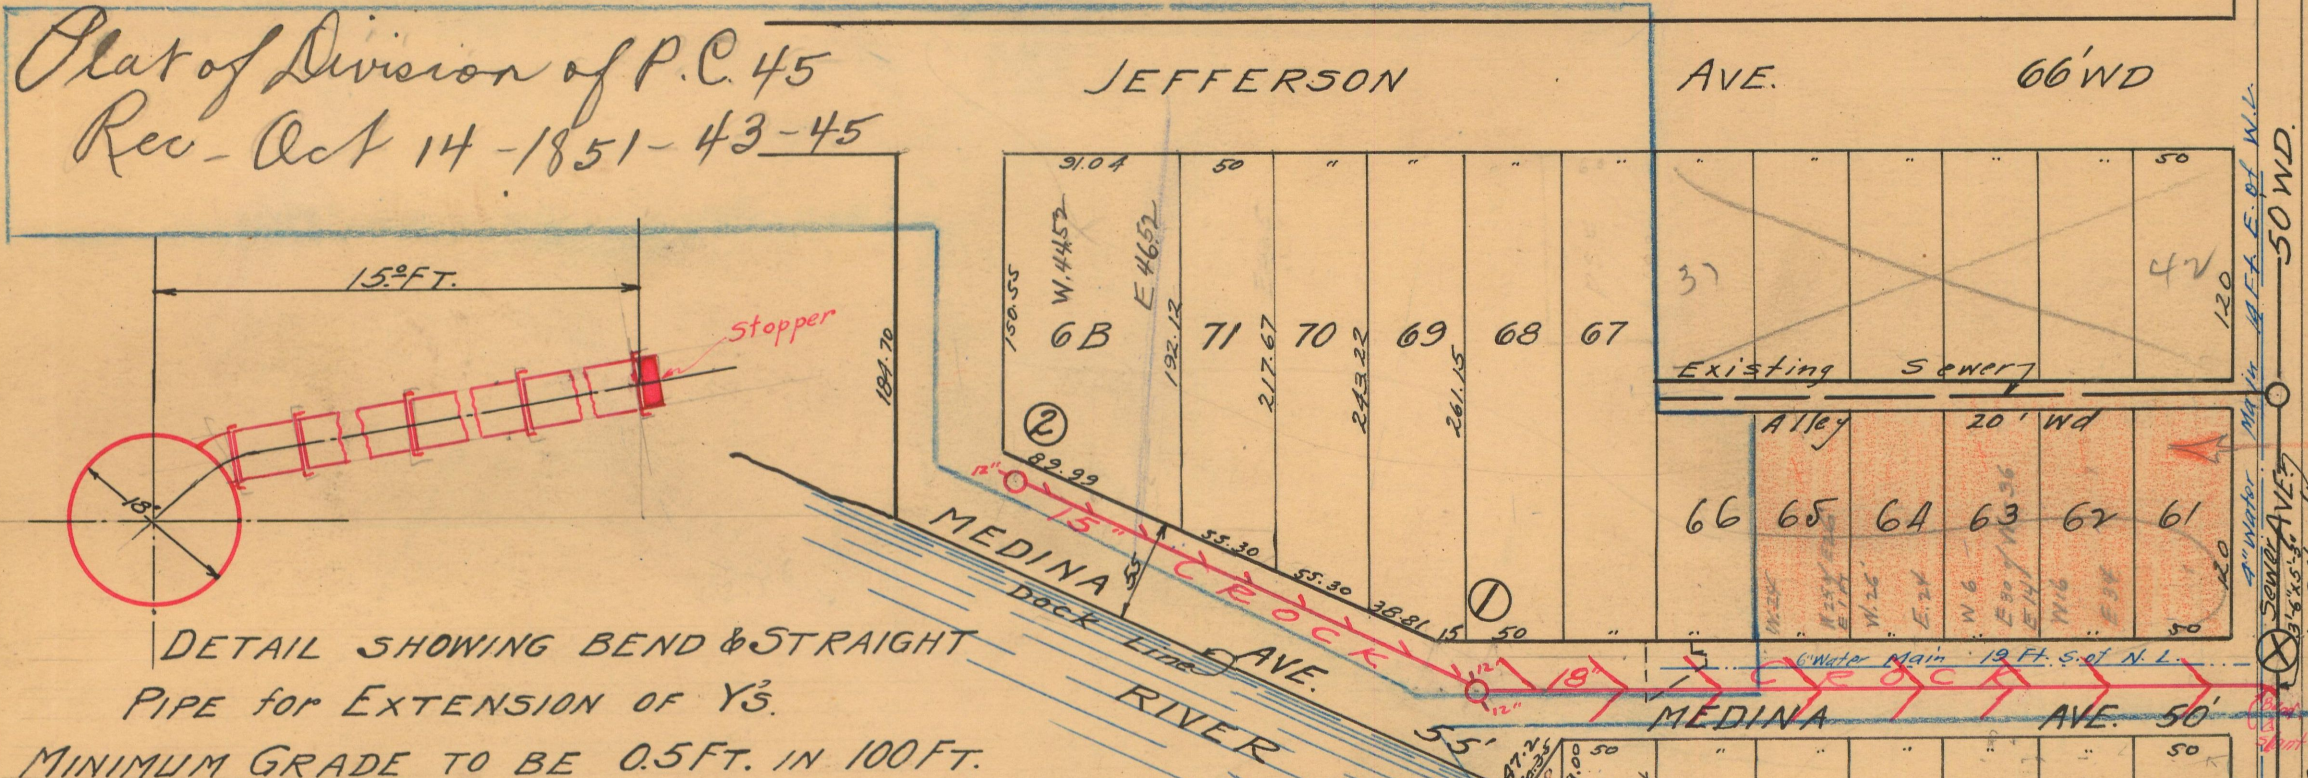

RED NOT ASSESSED  
DO NOT OK.  
1/2 \$ FOR CEN.

DETAIL SHOWING BEND & STRAIGHT  
PIPE FOR EXTENSION OF Y3.  
MINIMUM GRADE TO BE 0.5 FT. IN 100 FT.

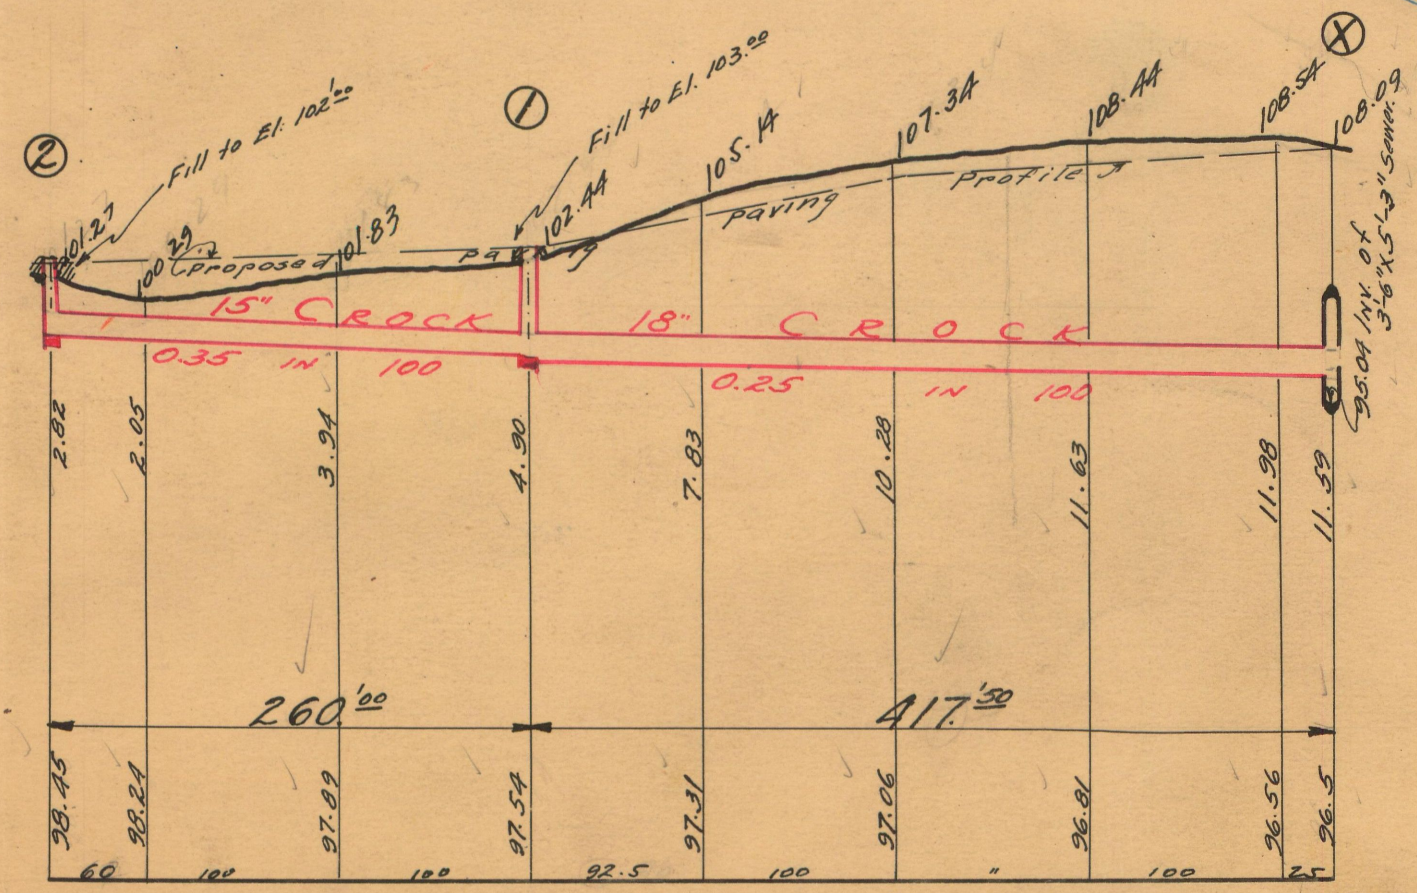

Delay - Subn. of part  
of Lot 7 - on P.C. 45  
Spring wells. Dwp.  
Wayne Co Mich.

NOTE--Contractor to furnish and set  
as markers for all connections 1/2 inch  
iron rods 2 feet long with 3 inch  
collar 6 inches long.

NOTE:--Each bidder is expected to examine the drawings, to visit the locality of the  
work, to make his own estimate of the facilities and difficulties attending the execu-  
tion of the work, including local conditions and all other contingencies, whether sur-  
face or underground, to do all his own pumping and provide proper bulk heads when  
directed by city engineer. Above costs to be borne by contractor.

28340

SCALE	VERTICAL 1"=10'
	HORIZONTAL 1"=100'
DRAWN	CHECK R3
TRACED OK	NOTE BOOK 223/119



DEPARTMENT OF PUBLIC WORKS  
CITY ENGINEER'S OFFICE  
DETROIT, MICH.


SEWER NO. 5551  
ROLL NO. PRIVATE

PETITION No. \_\_\_\_\_ DATE \_\_\_\_\_  
RESOLUTION \_\_\_\_\_ BIDS OPENED \_\_\_\_\_  
CONTRACT CONF'D \_\_\_\_\_ COMPLETED 11-1-30  
TIME LIMIT \_\_\_\_\_  
CONT'R \_\_\_\_\_ PRICE \_\_\_\_\_  
B. M. \_\_\_\_\_



# LATERAL SEWER IN ALLEY

IN BLOCKS BOUNDED BY  
REBUILDING OF 15" PIPE IN MEDINA - E. OF DEARBORN

TOTAL LENGTH OF SEWER 260.00 FT. M. OR L.  
" " " 15" PIPE = 260.00 & 9-6" Ys.  
TWO STANDARD MANHOLES INCL. IRON STEPS.

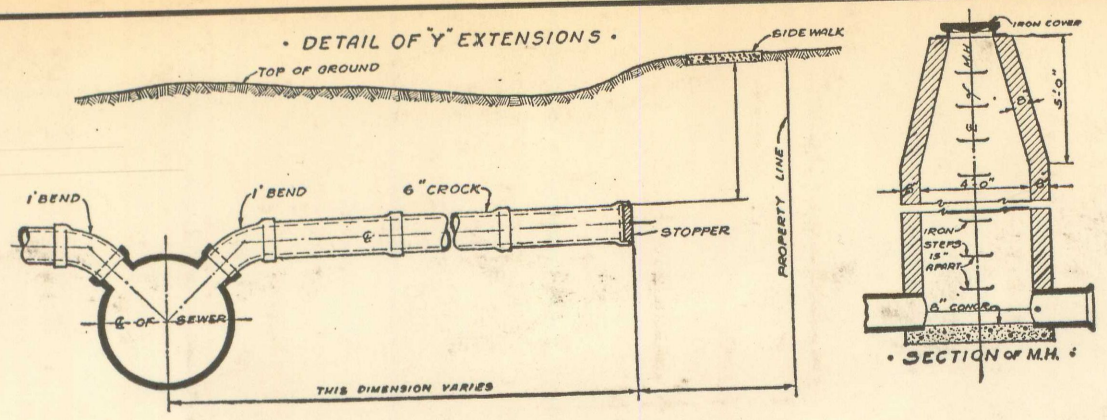

ALL CONNECTIONS OUT  
EXCEPT ONE INDICATED

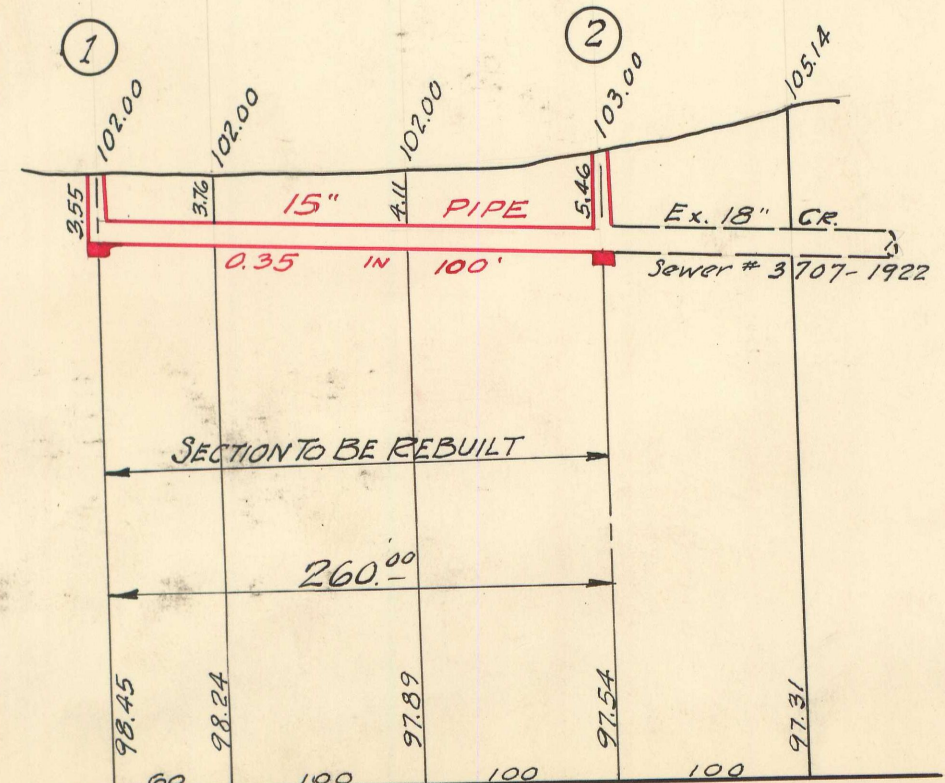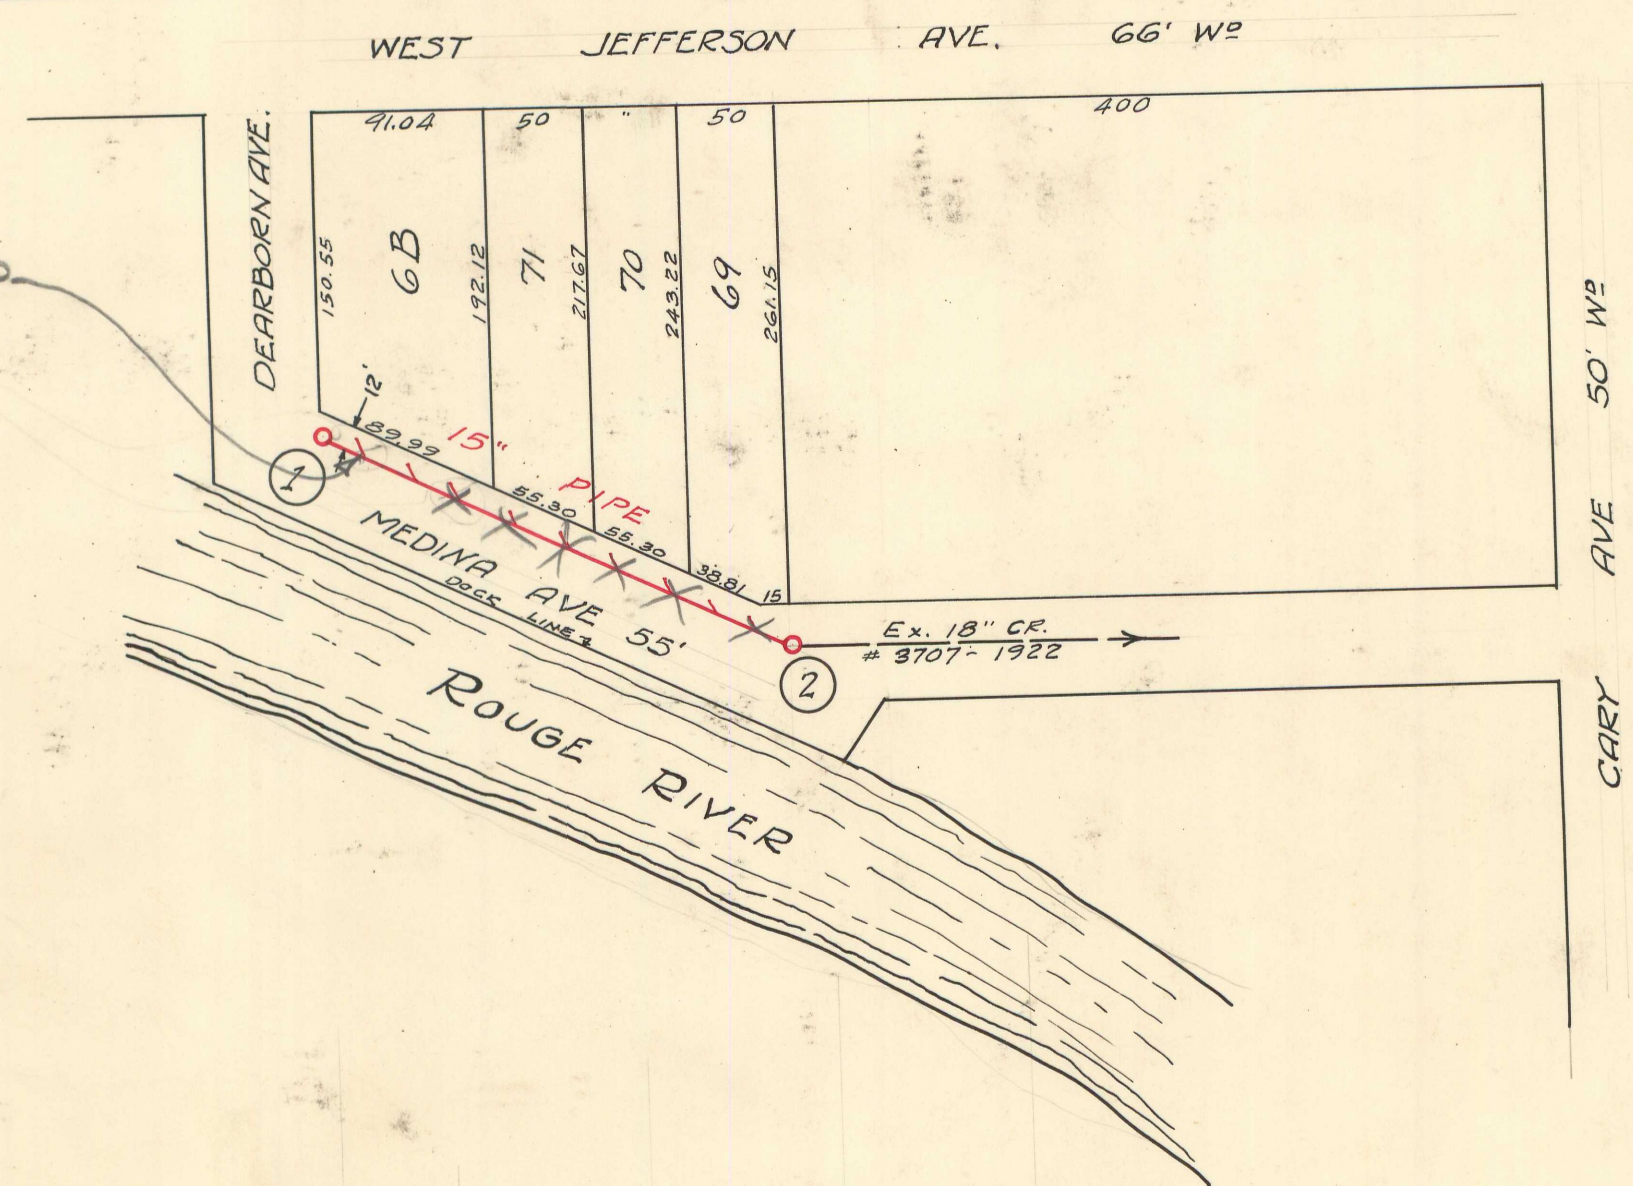

NOTE:- CONTRACTOR TO EXCAVATE TRENCH  
DOWN TO CONCRETE SLAB AND BACKFILL  
WITH SAND UP TO INVERT OF 15" PIPE

NOTE--Contractor to furnish and set as markers  
for all connections 1/2 inch iron rods 2 feet long  
with 3 inch tile collar 6 inches long.

IMPORTANT NOTICE:—The location of all public utilities are taken from best available data: City is not responsible for variations from locations shown. Sidewalks, pavements, and other existing surface and underground public utilities, whether shown on drawings or not, must be adequately protected, and when damaged the contractor must restore them to their original status. Water mains and water service pipes if damaged, are to be repaired in a manner to meet the requirements of the Water Board. Sewer is to be built in tunnel under pavement, and backfilled with Class "C" concrete. Each bidder is expected to make his estimates of the facilities and difficulties attending the execution of the work, to do all necessary pumping and build or remove bulkheads when directed by City Engineer. All above costs to be borne by Contractors.

SCALE	VERTICAL 1"=10'	DRAWN	C.J.C.	CHECK
	HORIZONTAL 1"=100'	TRACED		NOTE BOOK





UNITED STATES ENVIRONMENTAL PROTECTION AGENCY  
GREAT LAKES NATIONAL PROGRAM OFFICE  
REGION 5  
9311 GROH ROAD  
GROSSE ILE, MI 48138

07 June 2017

The Honorable City Council  
ATTN: Office of the City Clerk  
200 Coleman A. Young Municipal Center  
Detroit, Michigan 48226

RE: Request for Temporary Closure of Portion of Medina Street

Dear Sirs & Mesdames:

We are writing to you to request a hearing before the City Council to approve temporary closure of a portion of Medina Street, located in the Delray neighborhood, Detroit, Michigan. The closure is required as part of a major clean-up of contaminated sediments in the Rouge River Old Channel which will improve the quality of the river and the related environment. Additional details are provided in this letter and its attachments.

The U.S. Environmental Protection Agency (USEPA) and Honeywell Inc. have been working cooperatively under the Great Lakes Legacy Act (GLLA) to remediate contaminated sediment in the Rouge River Old Channel that impacts the river. Dredging as part of the remedy necessitates building of a permanent bulkhead wall along the shoreline. Tiebacks for this wall in turn require temporary closure of the terminal 50 feet of Medina Street. Bulkhead wall construction is set to start in summer of 2017 to allow dredging in 2018. The limits of work are designed to allow access street access for residential properties. USEPA and Honeywell will continue to work with local property owners to minimize any inconvenience. We are submitting this package to request a grant for temporary closure of the terminal end of Medina Street between January 2018 and May 2018.

Enclosed are a fact sheet describing the project and the engineering plan sets depicting the proposed changes to Medina Street. Should you have any questions, please feel free to contact me, Rose Ellison at (734) 692-7689 or provide emailed comments to [Ellison.Rosanne@epa.gov](mailto:Ellison.Rosanne@epa.gov).

Sincerely,

A handwritten signature in black ink that reads "Rose Ellison".

Rose Ellison  
Great Lakes National Program Office  
U.S. Environmental Protection Agency

Enclosures: Fact Sheet  
Drawing Set

CC: Will Tamminga, EDC



**FACT SHEET**  
**LOWER ROUGE RIVER OLD CHANNEL**  
**SEDIMENT REMEDIATION PROJECT**  
**JUNE 2017**

**Introduction and Overview**

The United States Environmental Protection Agency Great Lakes National Program Office (GLNPO) is working throughout the Great Lakes region to implement remediation and restoration projects under the Great Lakes Legacy Act. These projects focus on addressing beneficial use impairments at known areas of concern (AOCs).

As part of a collaborative agreement, GLNPO has worked with Honeywell International Inc. (the non-federal sponsor; Honeywell), to develop a plan to address sediment contamination in the Lower Rouge River Old Channel (LRROC), which is part of the Rouge River AOC. The LRROC contains sediments contaminated with multiple constituents of concern, including polycyclic aromatic hydrocarbons (PAHs) and non-aqueous phase liquid (NAPL).

**Site Setting**

The Project is located in Detroit, Michigan, adjacent to Zug Island. A history of multiple industrial discharges, stormwater outfalls, combined sewer overflows, and non-point pollution sources culminated in highly contaminated sediment. The LRROC is maintained as an active channel for industrial and commercial shipping traffic. Only maintenance dredging has occurred within the project area; no remedial actions have been performed.

**Overview of Project Components**

Based on an engineering feasibility study and the results of extensive pre-design investigation studies, the remedial design concept for the LRROC includes the following key components:

- **Dredging:** Dredging of approximately 70,000 cubic yards (CY) from 10 acres to remove contaminated sediments. Dredging will be completed using an environmental (e.g. closed/sealed) bucket. Dredging will be conducted from a barge surrounded by silt curtains to limit suspended sediment movement. Dredging will be performed with consideration of surface water quality during remediation; monitoring will be performed to maintain water quality within permitted limits. Sediment dredged as part of the Project is expected to be placed in the United States Army Corps of Engineers (USACE) Point Mouillee Confined Disposal Facility (CDF). The distance from the LRROC to the CDF is approximately 22 miles. No barge overflow of water or sediments may occur at any time—during excavation, navigation, or placement at the CDF.
- **Capping:** Subaqueous capping of about 1 acre to limit exposures to materials that are difficult to dredge due to limitations associated with a nearby water intake, shoreline/structural stability, or material depth. The aggregate cap will consist of a bulk sand/organoclay mixture for chemical isolation, overlain by a granular/gravel filter layer to prevent piping, overlain by an armor layer consisting of a cobble/boulder material. Surface water quality will also be considered during capping operations.
- **Temporary Shoreline Stabilization:** Four areas targeted for dredging are on or adjacent to the toe of the channel slopes or in proximity to existing structures; these areas will require temporary stabilization using sheet pile and backfill. Sheet pile will be driven to a depth of at least 20 feet below sediment surface with approximately 30 feet remaining above sediment surface. After dredging, the area downslope of the temporary shoring will be backfilled to preserve the stability of the channel side slopes and shoreline. After backfilling, the sheetpile will be removed.

- **Permanent Shoreline Stabilization:** In some areas along the mainland side of the LRROC, the existing slopes are very steep. To achieve a stable slope after dredging, temporary shoreline stabilization would require large amounts of backfill encroaching into the navigation channel. Temporary shoreline stabilization is not feasible in these areas. Therefore, approximately 2,500 linear feet (LF) of shoreline will be permanently stabilized via installation of a bulkhead wall with tie-backs/deadmen to address shoreline stability in areas of moderate to deep dredging. The wall will be continuous with the exception of several “windows” or openings in the sheet pile wall which will be included to allow the passage of active underground utilities and the Zug Island Bridge that cross the river.
- **Permitting, Stakeholder Coordination, and Sustainability:** A key component of the design is obtaining permits. Because the work occurs in a waterbody and floodplain, a Joint Permit Application has been submitted to the Michigan Department of Environmental Quality (MDEQ) and U.S. Army Corps of Engineers (USACE). MDEQ has issued the public notice for their permitting process and USACE issued public notice in early Fall 2016. Additional municipal and county permit applications are being submitted concurrently.
- **Schedule:** Permanent bulkhead wall construction is expected to begin in summer of 2017 and take approximately 13 months. The remedial contractor will mobilize to the site in 2018 and begin remedial construction activities (i.e., dredging, material handling and disposal, and capping), which are anticipated to take approximately 9 months to complete.


#### Relevance to Medina Street

The design of the permanent sheetpile bulkhead wall includes approximately 2,500 feet of shoreline along the channel. The bulkhead requires tiebacks of up to 125 feet in length which connect to an anchor wall that would be located within the limits of Medina Street. Construction of the tiebacks and anchor wall require closure of the full width of the terminal 25 feet of Medina Street, and half the width of an additional 50 feet prior. The project sponsors are seeking to obtain temporary closure of this portion of the road for a duration of 3 months in early 2018. Planning for this closure has been conducted in close coordination with the adjacent landowners/residents, with whom the project team is working to obtain signed access agreements.

#### Contact Us

For further information, please contact Rose Ellison, U.S. Environmental Protection Agency, by phone at (734) 692-7689 or by email at [ellison.rosanne@epa.gov](mailto:ellison.rosanne@epa.gov).

Figure 1 - Lower Rouge River Channel Clean-Up Project

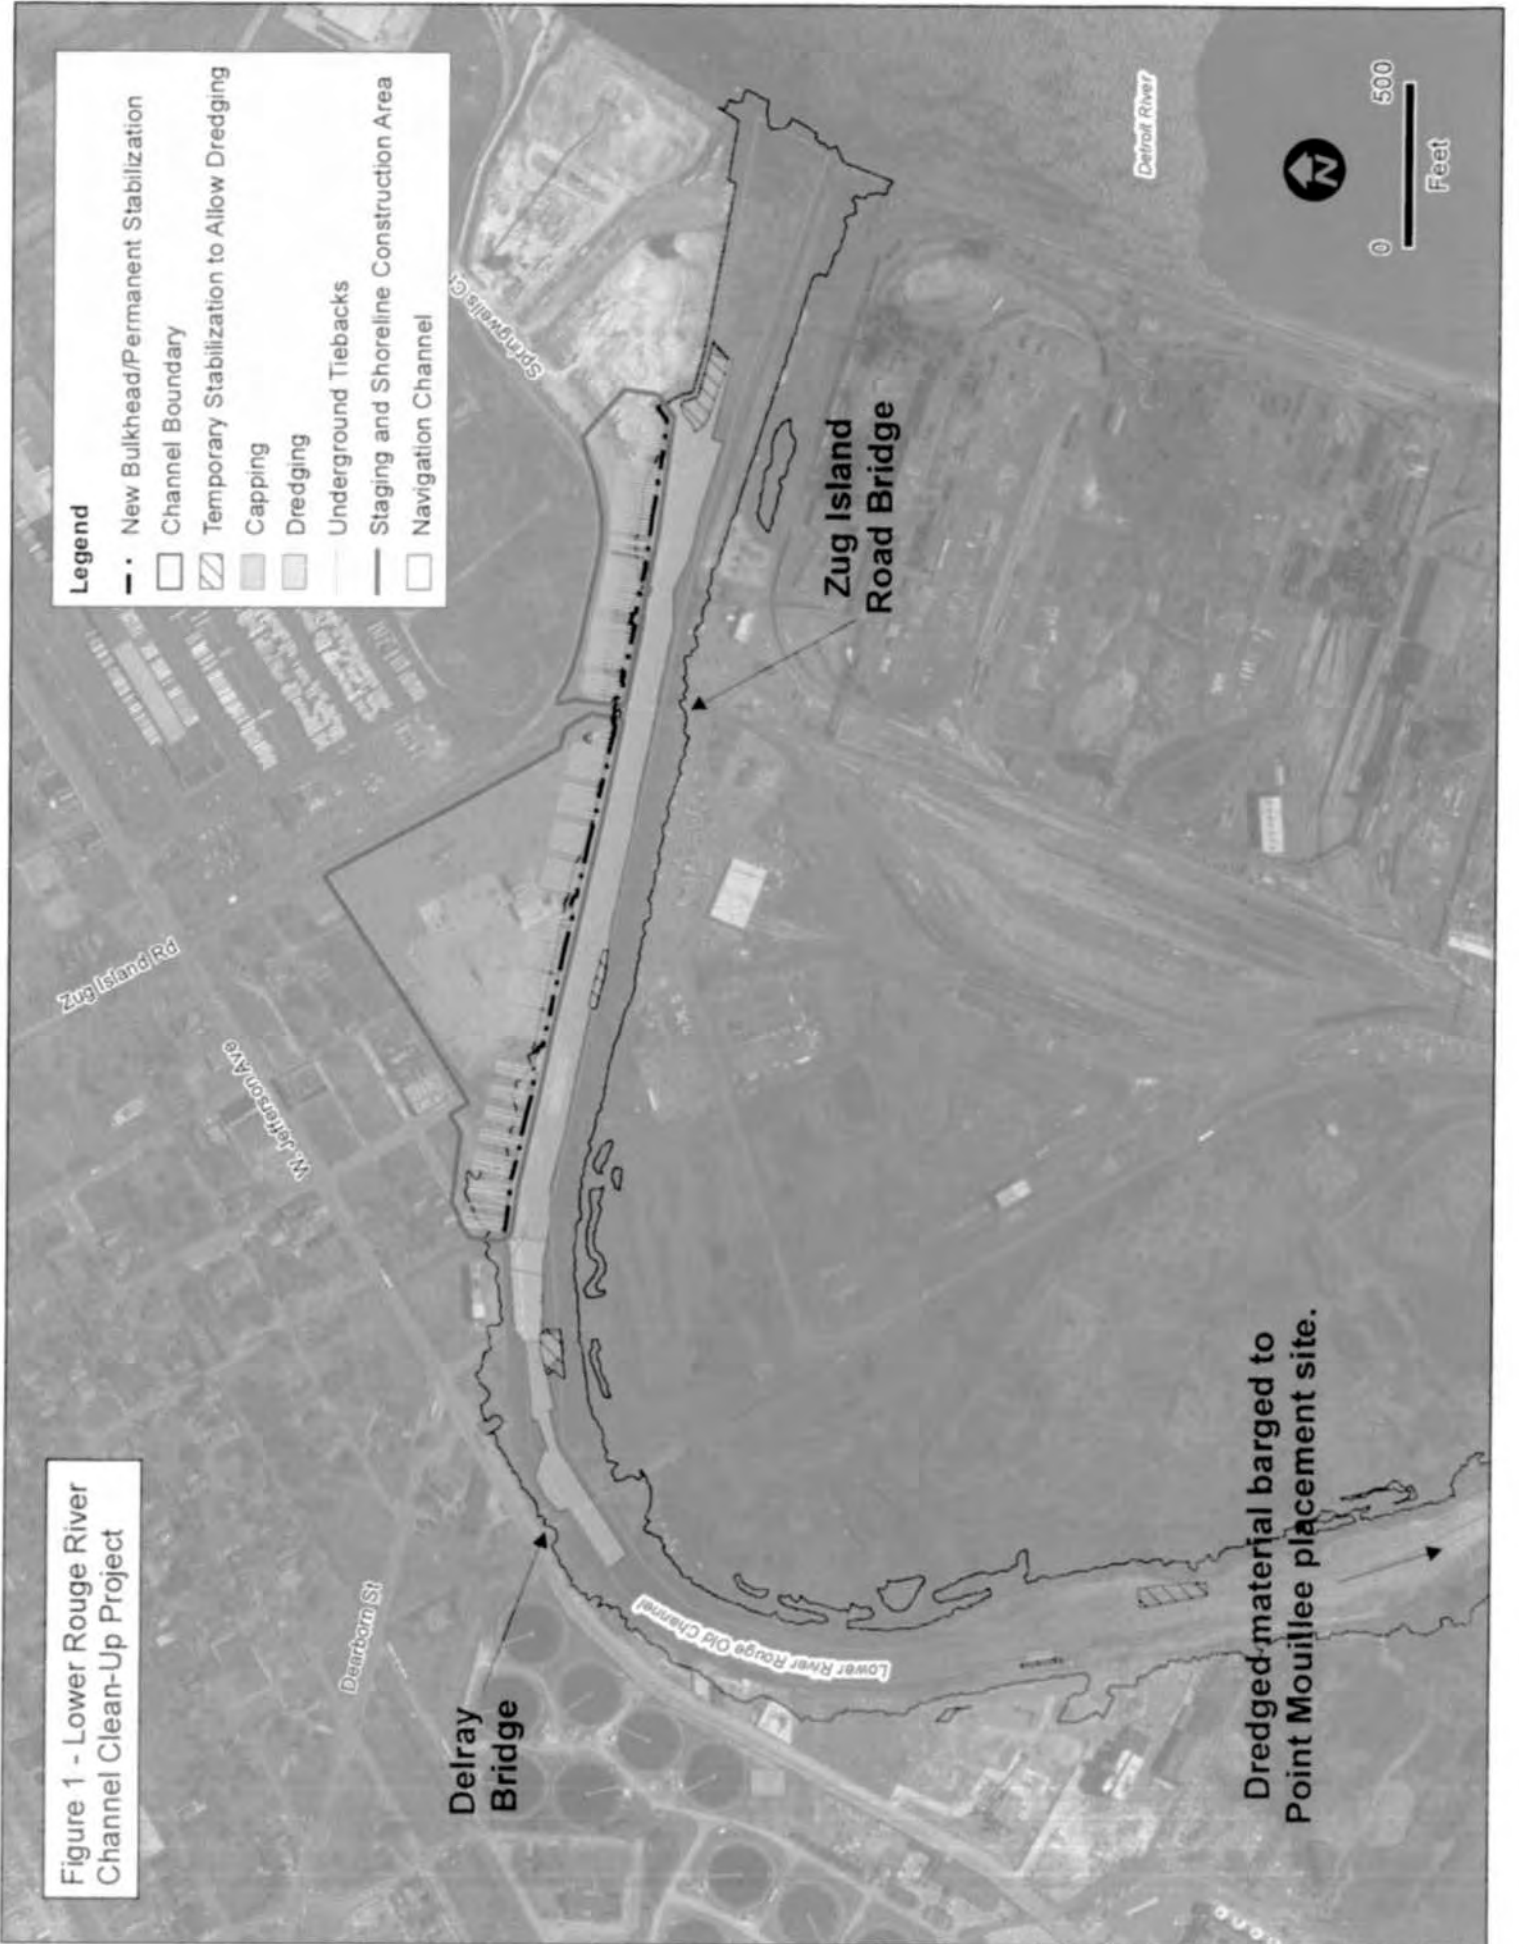




# LOWER ROUGE RIVER OLD CHANNEL ROUGE RIVER AREA OF CONCERN PERMANENT SHEETPILE WALL INSTALLATION DETROIT, MICHIGAN


## 100% DESIGN MARCH 3, 2017

### DRAWING INDEX


INCLUDED THIS SUBMITTAL	SHEET NUMBER	DRAWING TITLE	DISCIPLINE NUMBER
•	1	COVER SHEET	G-001
•	2	LEGEND AND ABBREVIATIONS	G-002
•	3	GENERAL NOTES	G-003
•	4	OVERALL SITE PLAN	C-101
•	5	EXISTING CONDITIONS PLAN (COKE)	C-102
•	6	EXISTING CONDITIONS PLAN (TAR)	C-103
•	7	EXISTING CONDITIONS PLAN (FERRISS)	C-104
•	8	STAGING PLAN (FORMER DETROIT TAR)	C-105
•	9	SITE DEMOLITION PLAN (COKE)	C-106
•	10	SITE DEMOLITION PLAN (TAR)	C-107
•	11	SITE DEMOLITION PLAN (FERRISS)	C-108
•	12	PRE-TRENCHING PLAN (COKE)	C-109
•	13	PRE-TRENCHING PLAN (TAR)	C-110
•	14	PRE-TRENCHING PLAN (FERRISS)	C-111
•	15	EXCAVATION PLAN (COKE)	C-112
•	16	EXCAVATION PLAN (TAR)	C-113
•	17	EXCAVATION PLAN (FERRISS)	C-114
•	18	FINAL GRADING PLAN (COKE)	C-115
•	19	FINAL GRADING PLAN (TAR)	C-116
•	20	FINAL GRADING PLAN (FERRISS)	C-117
•	21	INTERPRETIVE SUBSURFACE PROFILE ALONG PERMANENT SHEETPILE WALL ALIGNMENT (COKE)	C-201
•	22	INTERPRETIVE SUBSURFACE PROFILE ALONG PERMANENT SHEETPILE WALL ALIGNMENT (TAR)	C-202
•	23	INTERPRETIVE SUBSURFACE PROFILE ALONG PERMANENT SHEETPILE WALL ALIGNMENT (FERRISS)	C-203
•	24	INTERPRETIVE SUBSURFACE PROFILE ALONG DEADMAN ALIGNMENT (COKE)	C-204
•	25	INTERPRETIVE SUBSURFACE PROFILE ALONG DEADMAN ALIGNMENT (TAR)	C-205
•	26	INTERPRETIVE SUBSURFACE PROFILE ALONG DEADMAN ALIGNMENT (FERRISS)	C-206
•	27	SOIL EROSION AND SEDIMENTATION CONTROL NOTES	C-301
•	28	SOIL EROSION AND SEDIMENTATION CONTROL PLAN (COKE)	C-302
•	29	SOIL EROSION AND SEDIMENTATION CONTROL PLAN (TAR)	C-303
•	30	SOIL EROSION AND SEDIMENTATION CONTROL PLAN (FERRISS)	C-304
•	31	SOIL EROSION AND SEDIMENTATION CONTROL DETAILS	C-305
•	32	CROSS SECTIONS STA 100+00 TO STA 102+00	C-401
•	33	CROSS SECTIONS STA 103+00 TO STA 105+00	C-402
•	34	CROSS SECTIONS STA 106+00 TO STA 108+00	C-403
•	35	CROSS SECTIONS STA 109+00 TO STA 111+00	C-404
•	36	CROSS SECTIONS STA 112+00 TO STA 114+00	C-405
•	37	CROSS SECTIONS STA 115+00 TO STA 117+00	C-406
•	38	CROSS SECTIONS STA 118+00 TO STA 120+00	C-407
•	39	CROSS SECTIONS STA 121+00 TO STA 123+00	C-408
•	40	CROSS SECTIONS STA 124+00 TO STA 125+00	C-409
•	41	CIVIL DETAILS 1	C-501
•	42	CIVIL DETAILS 2	C-502
•	43	STRUCTURAL NOTES	S-001
•	44	PERMANENT SHEET PILE WALL AND ANCHOR SYSTEM PLAN (COKE)	S-101
•	45	PERMANENT SHEET PILE WALL AND ANCHOR SYSTEM PLAN (TAR)	S-102
•	46	PERMANENT SHEET PILE WALL AND ANCHOR SYSTEM PLAN (FERRISS)	S-103
•	47	STRUCTURAL DETAILS 1	S-501
•	48	STRUCTURAL DETAILS 2	S-502
•	49	STRUCTURAL DETAILS 3	S-503
•	50	STRUCTURAL DETAILS 4	S-504
•	51	STRUCTURAL DETAILS 5	S-505
•	52	STRUCTURAL DETAILS 6	S-506

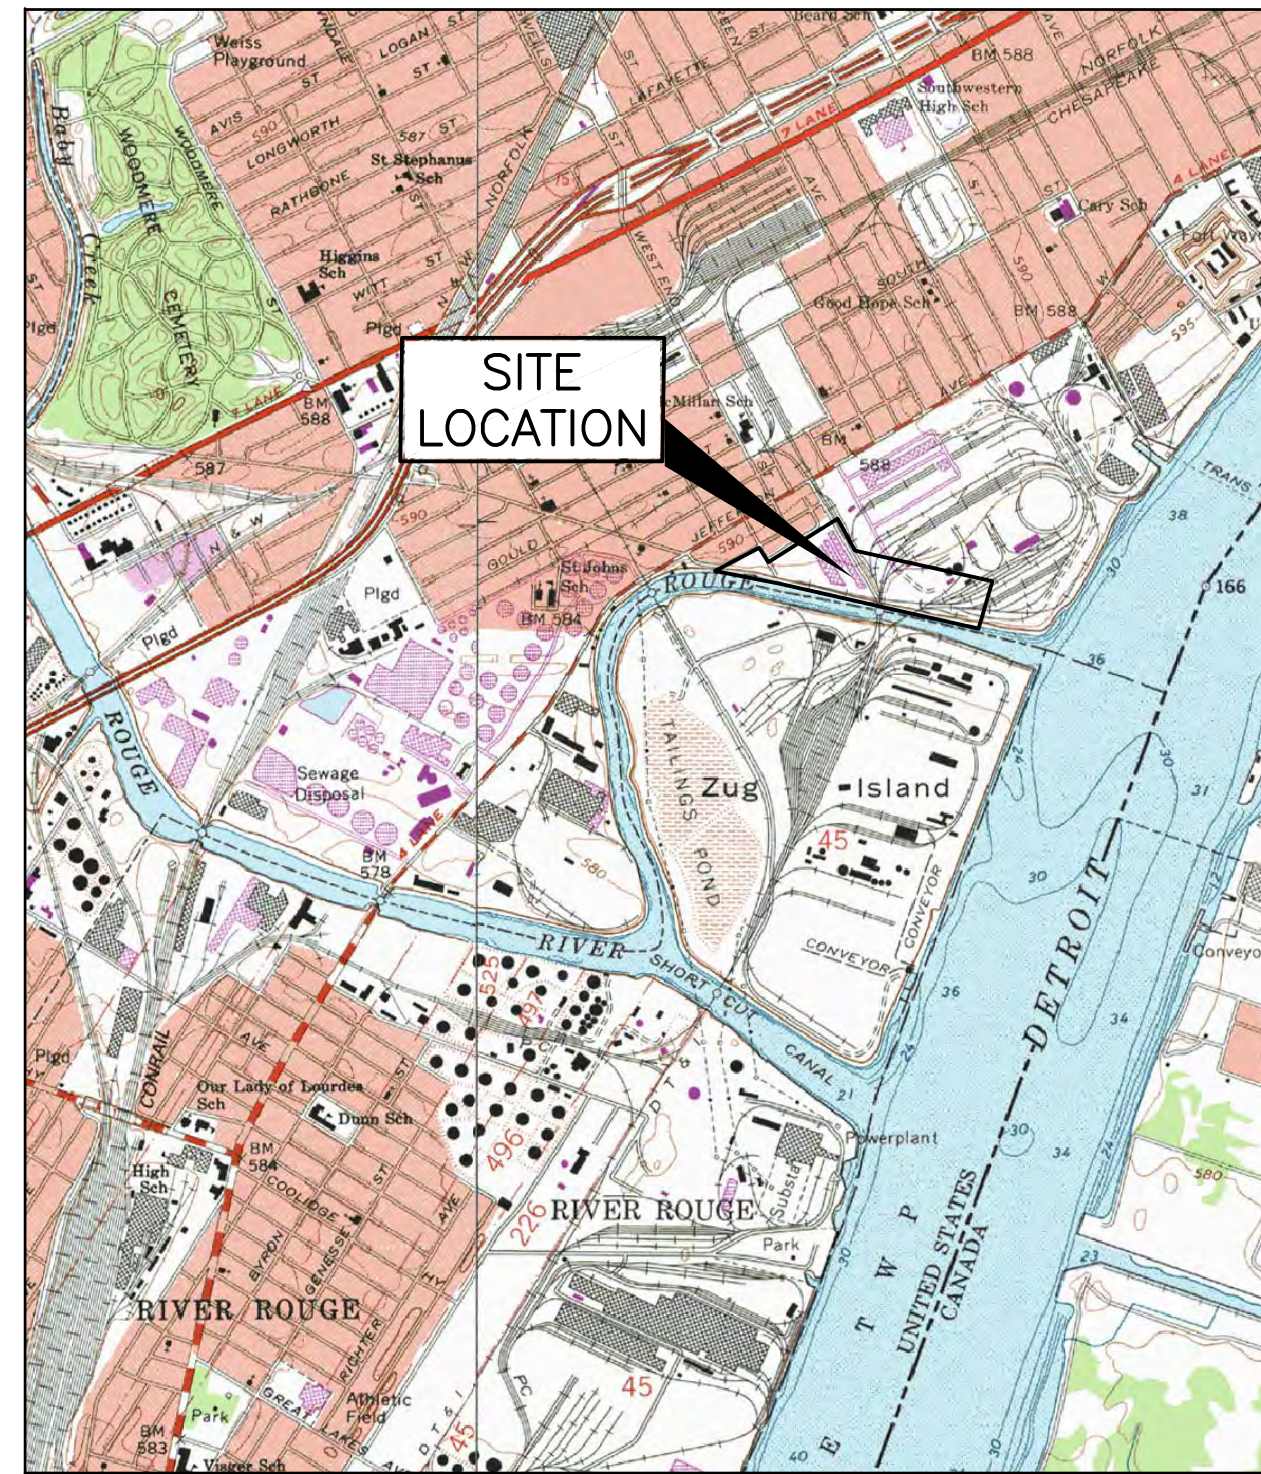


SITE LOCATION MAP

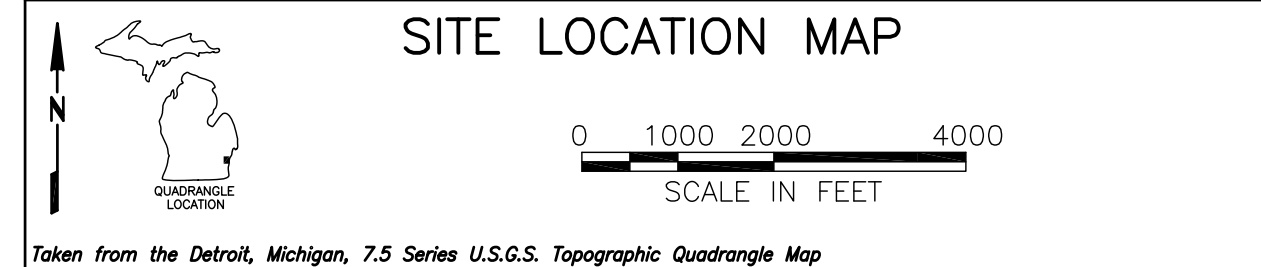

Taken from the Detroit, Michigan, 7.5 Series U.S.G.S. Topographic Quadrangle Map

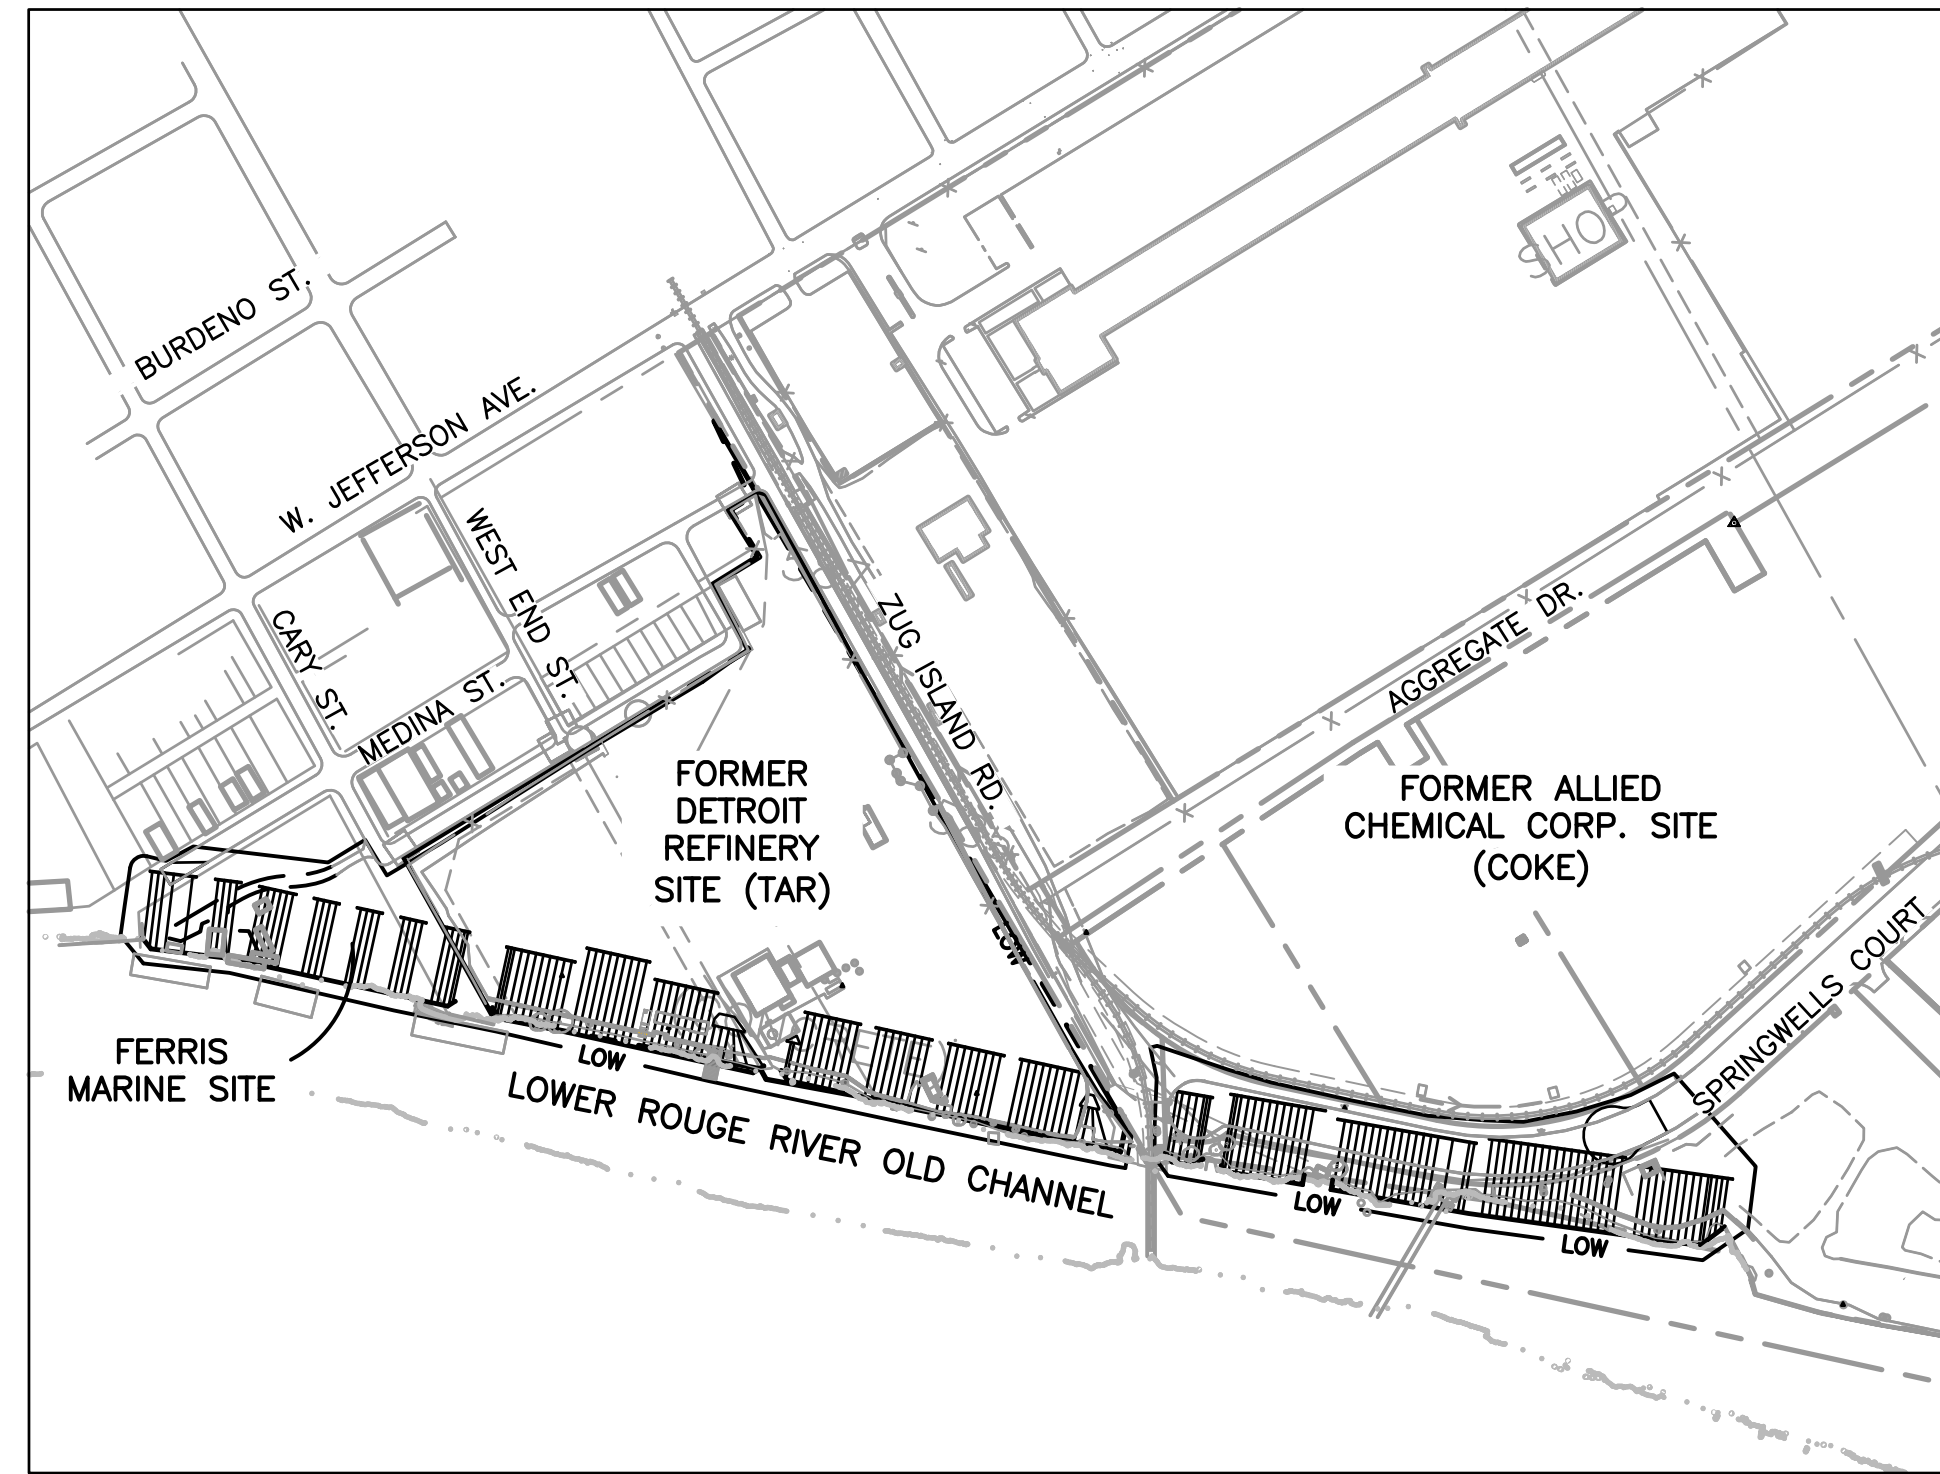

PROJECT LIMITS MAP

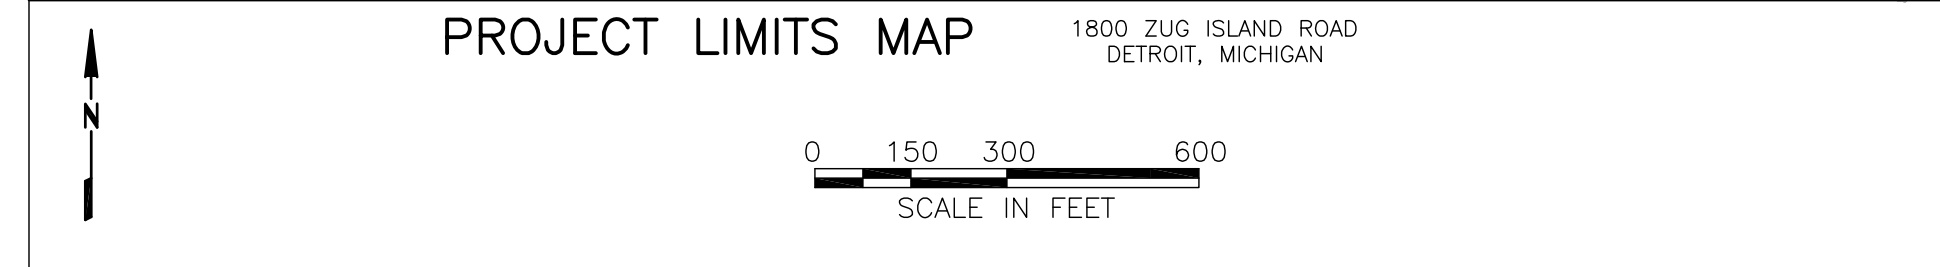

#### REFERENCE DRAWINGS

- GROUNDWATER MITIGATION CONTROL SYSTEM, HONEYWELL INTERNATIONAL, INC. FORMER DETROIT TAR REFINERY - SITE No. 35057, DETROIT, MICHIGAN, PREPARED BY AMEC FOSTER WHEELER AND CONSISTING OF 20 DRAWINGS (REV 1, 90% DESIGN DRAWINGS, DATED MAY 16, 2016).
- LOWER ROUGE RIVER OLD CHANNEL, ROUGE RIVER AREA OF CONCERN, DETROIT, MICHIGAN, 90% DESIGN, JUNE 17, 2009.

PREPARED FOR:



101 COLUMBIA RD. BOX 2105, MORRISTOWN, NJ 07962

AND



IN ASSOCIATION WITH:



AND




Lyle N Tracy  
MI PROFESSIONAL ENGINEER  
LICENSE NUMBER LNT

WJM	LNT	100% DESIGN
WJM	LNT	100% DESIGN - FOR REVIEW
JVM	LNT	90% DESIGN - CLIENT REVIEW
JVM	APVD	REVISION
	CHK	
	DR	
	DSGN	
	L. TRACY	
	W. WHITTEN	
	L. STIRBAN	

NO. DATE

Honeywell  
101 COLUMBIA RD. BOX 2105, MORRISTOWN, NJ 07962  
LOWER ROUGE RIVER OLD CHANNEL  
ROUGE RIVER AREA OF CONCERN  
PERMANENT SHEETPILE WALL INSTALLATION  
DETROIT, MICHIGAN  
HONEYWELL SITE ID - 35057

DRAWING STATUS  
100% DESIGN  
GENERAL  
COVER SHEET

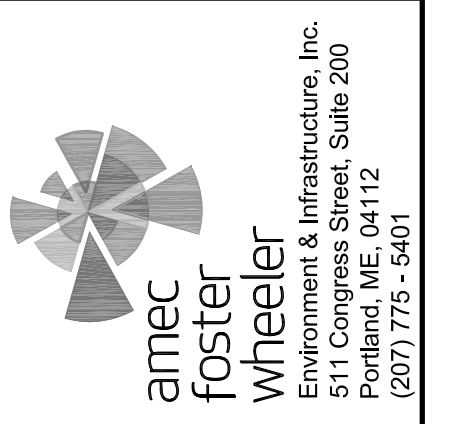


VERIFY SCALE  
BAR IS ONE INCH ON ORIGINAL DRAWING

DATE JUNE 2016  
PROJ 3293-16-1667  
DWG G-001  
SHEET 1 OF 52

THIS DRAWING IS THE PROPERTY OF AMEC FOSTER WHEELER, INCLUDING ALL PATENTED AND UNPATENTED FEATURES, AND/OR CONFIDENTIAL INFORMATION AND ITS USE IS CONDITIONED UPON THE USER'S AGREEMENT NOT TO REPRODUCE THE DRAWING, IN WHOLE OR PART, NOR THE MATERIAL DESCRIBED THEREON, NOR THE USE OF THE DRAWING FOR ANY PURPOSE OTHER THAN SPECIFICALLY PERMITTED IN WRITING BY AMEC FOSTER WHEELER.



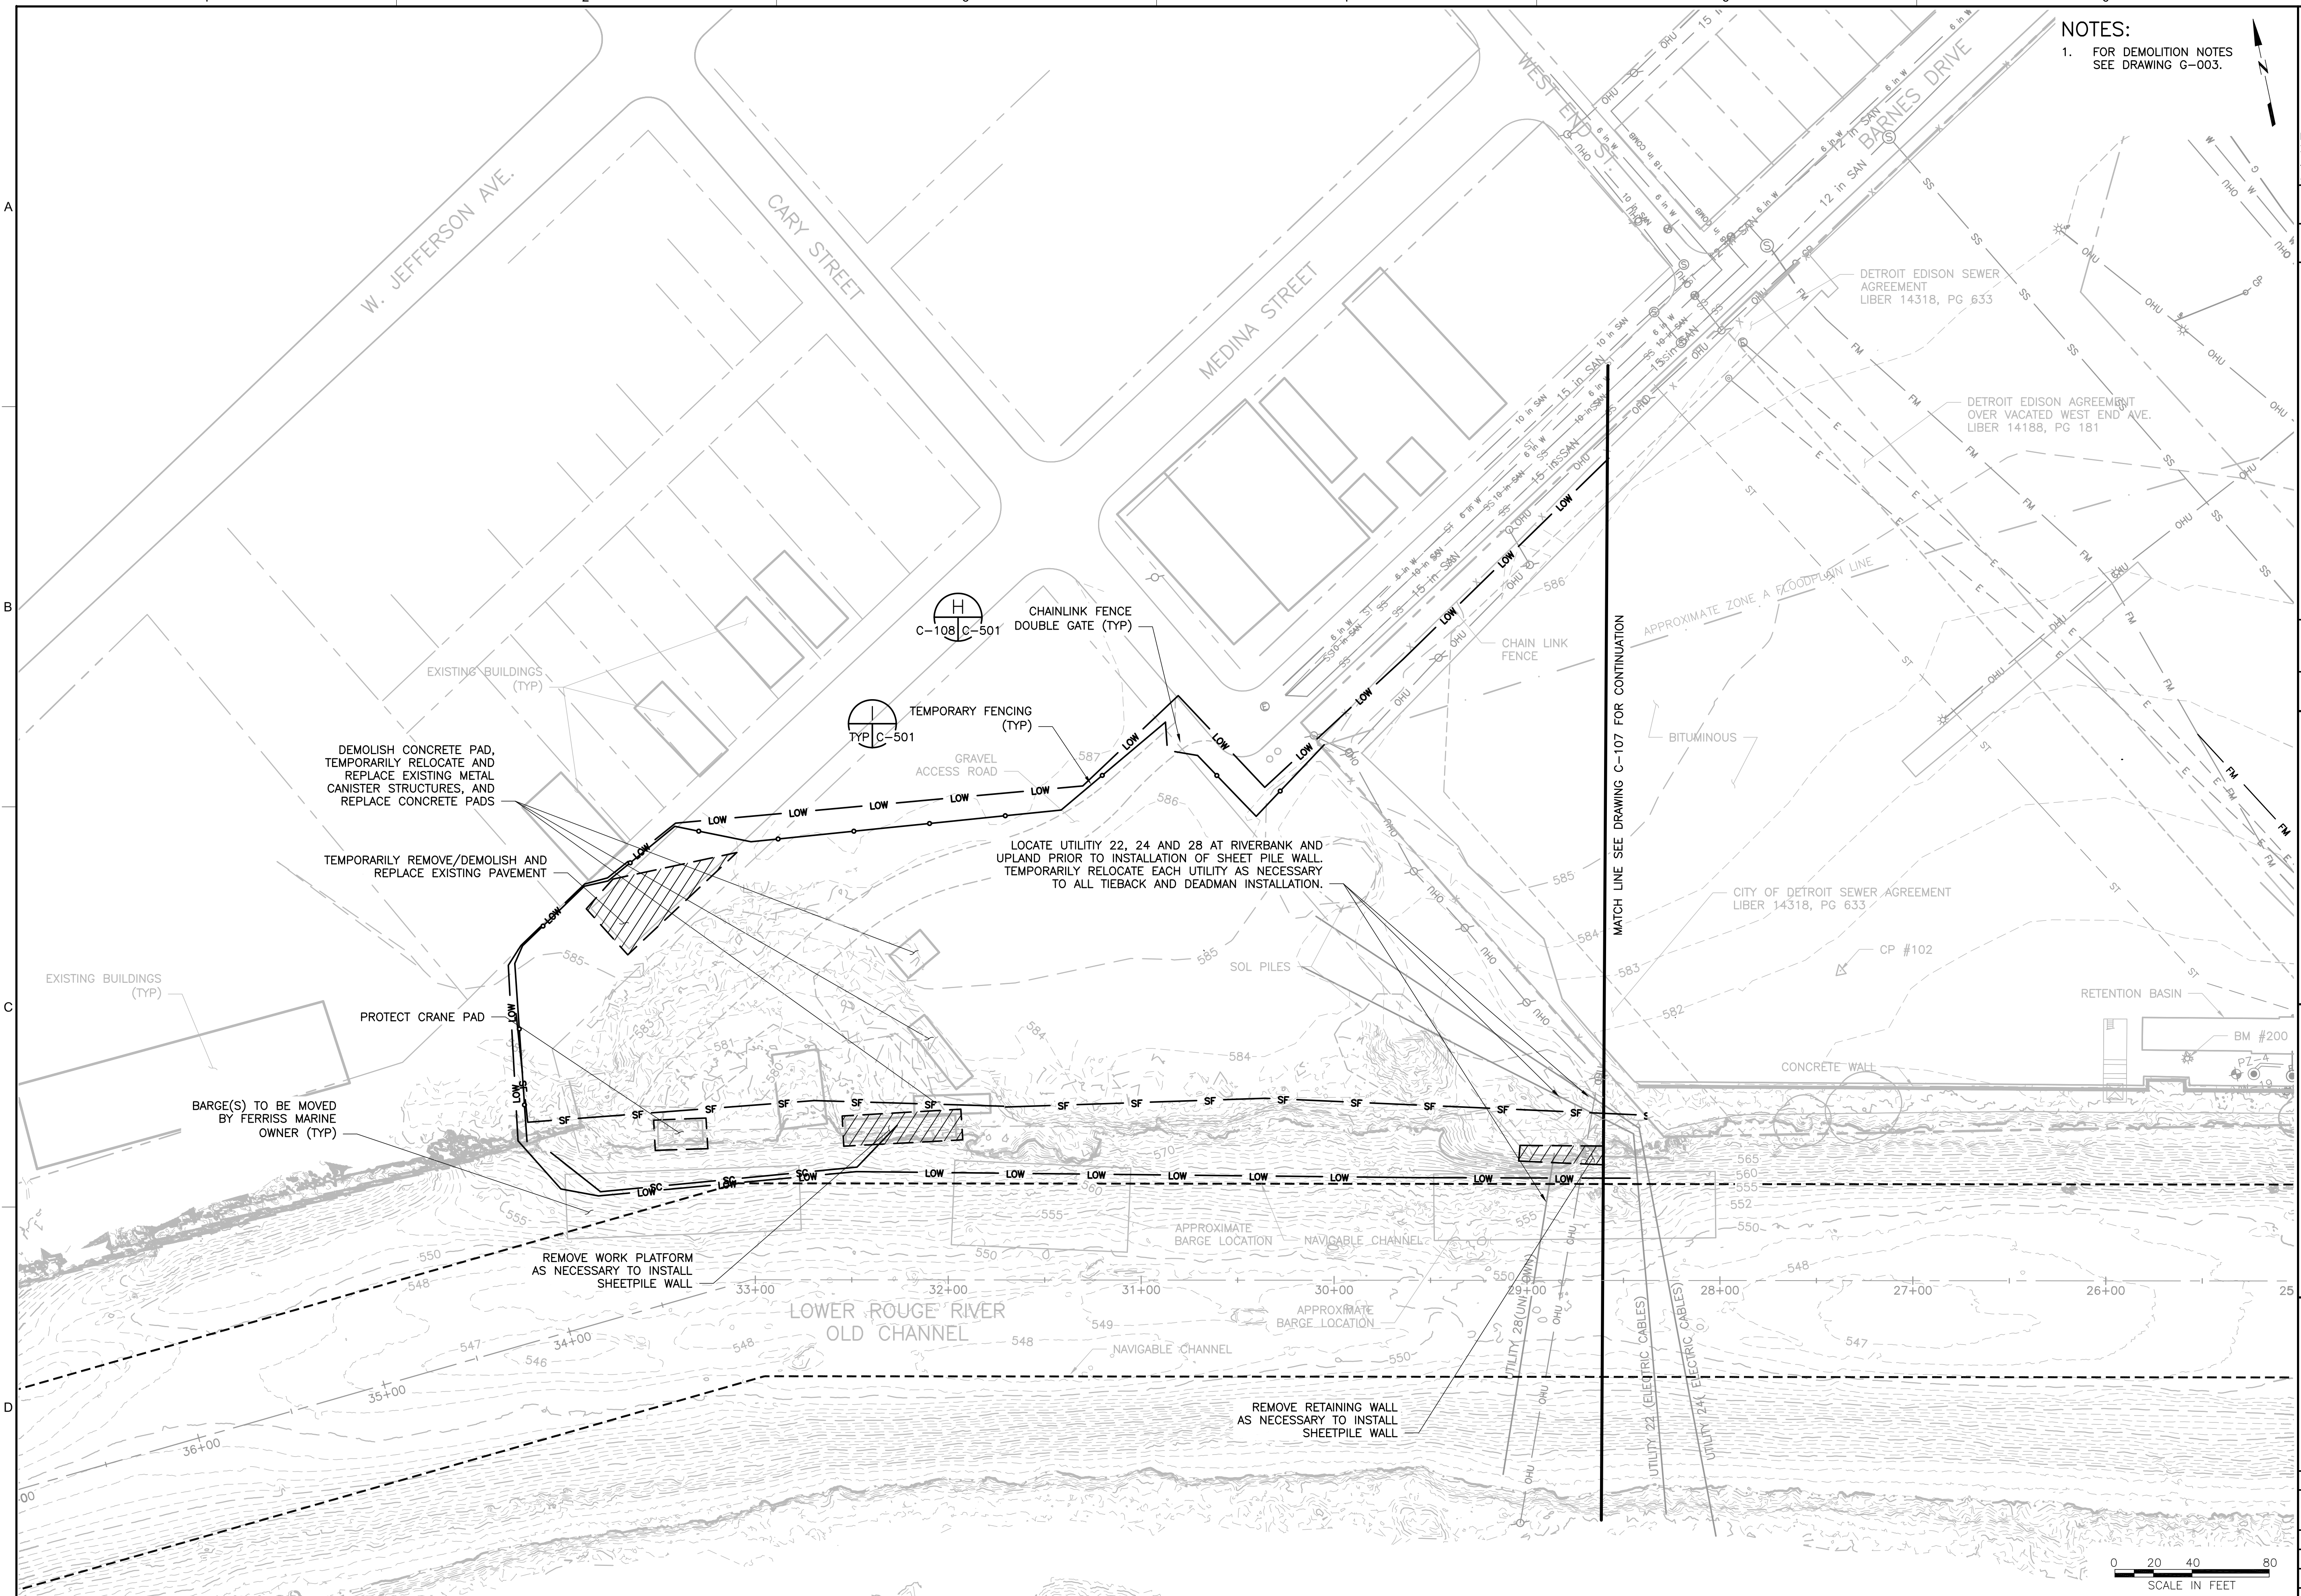

NOTES:  
 1. FOR DEMOLITION NOTES SEE DRAWING G-003.

WJM	LNT
WJM	LNT
WJM	LNT
JVM	LNT
JVM	LNT
BY	JAPVD

100% DESIGN - REVISED	3/28/17	4
100% DESIGN	3/03/17	3
100% DESIGN - FOR REVIEW	8/08/16	2
90% DESIGN - CLIENT REVIEW	6/17/16	1
NO. / DATE		
DR	L. TRACY	CHK
APVD	L. STIRBAN	CHK
MI PROFESSIONAL ENGINEER LICENSE NUMBER Lic. NUM	L. TRACY	

**Honeywell**  
 101 COLUMBIA RD., SUITE 2105, WARRISBURG, MD 21792  
 LOWER ROUGE RIVER OLD CHANNEL  
 ROUGE RIVER AREA OF CONCERN  
 PERMANENT SHEETPILE WALL INSTALLATION  
 DETROIT, MICHIGAN  
 HONEYWELL SITE ID - 35057

DRAWING STATUS  
 100% DESIGN  
 CIVIL  
 SITE DEMOLITION PLAN  
 (FERRISS)


**amec foster wheeler**  
 Environment & Infrastructure, Inc.  
 511 Congress Street, Suite 200  
 Portland, ME 04112  
 (207) 775-5401

VERIFY SCALE  
 BAR IS ONE INCH ON ORIGINAL DRAWING

DATE: JUNE 2016  
 PROJ: 3293-16-1667  
 DWG: C-108  
 SHEET: 11 OF 52



- NOTES:**
- FOR COORDINATES OF PRE-TRENCH CENTERLINE, SEE DRAWINGS S-101, S-102, AND S-103.
  - REFER TO DRAWING C-102 THROUGH C-108 FOR EXISTING STRUCTURES TO BE REMOVED.
  - FOR PRE-TRENCHING NOTES SEE DRAWING G-003.

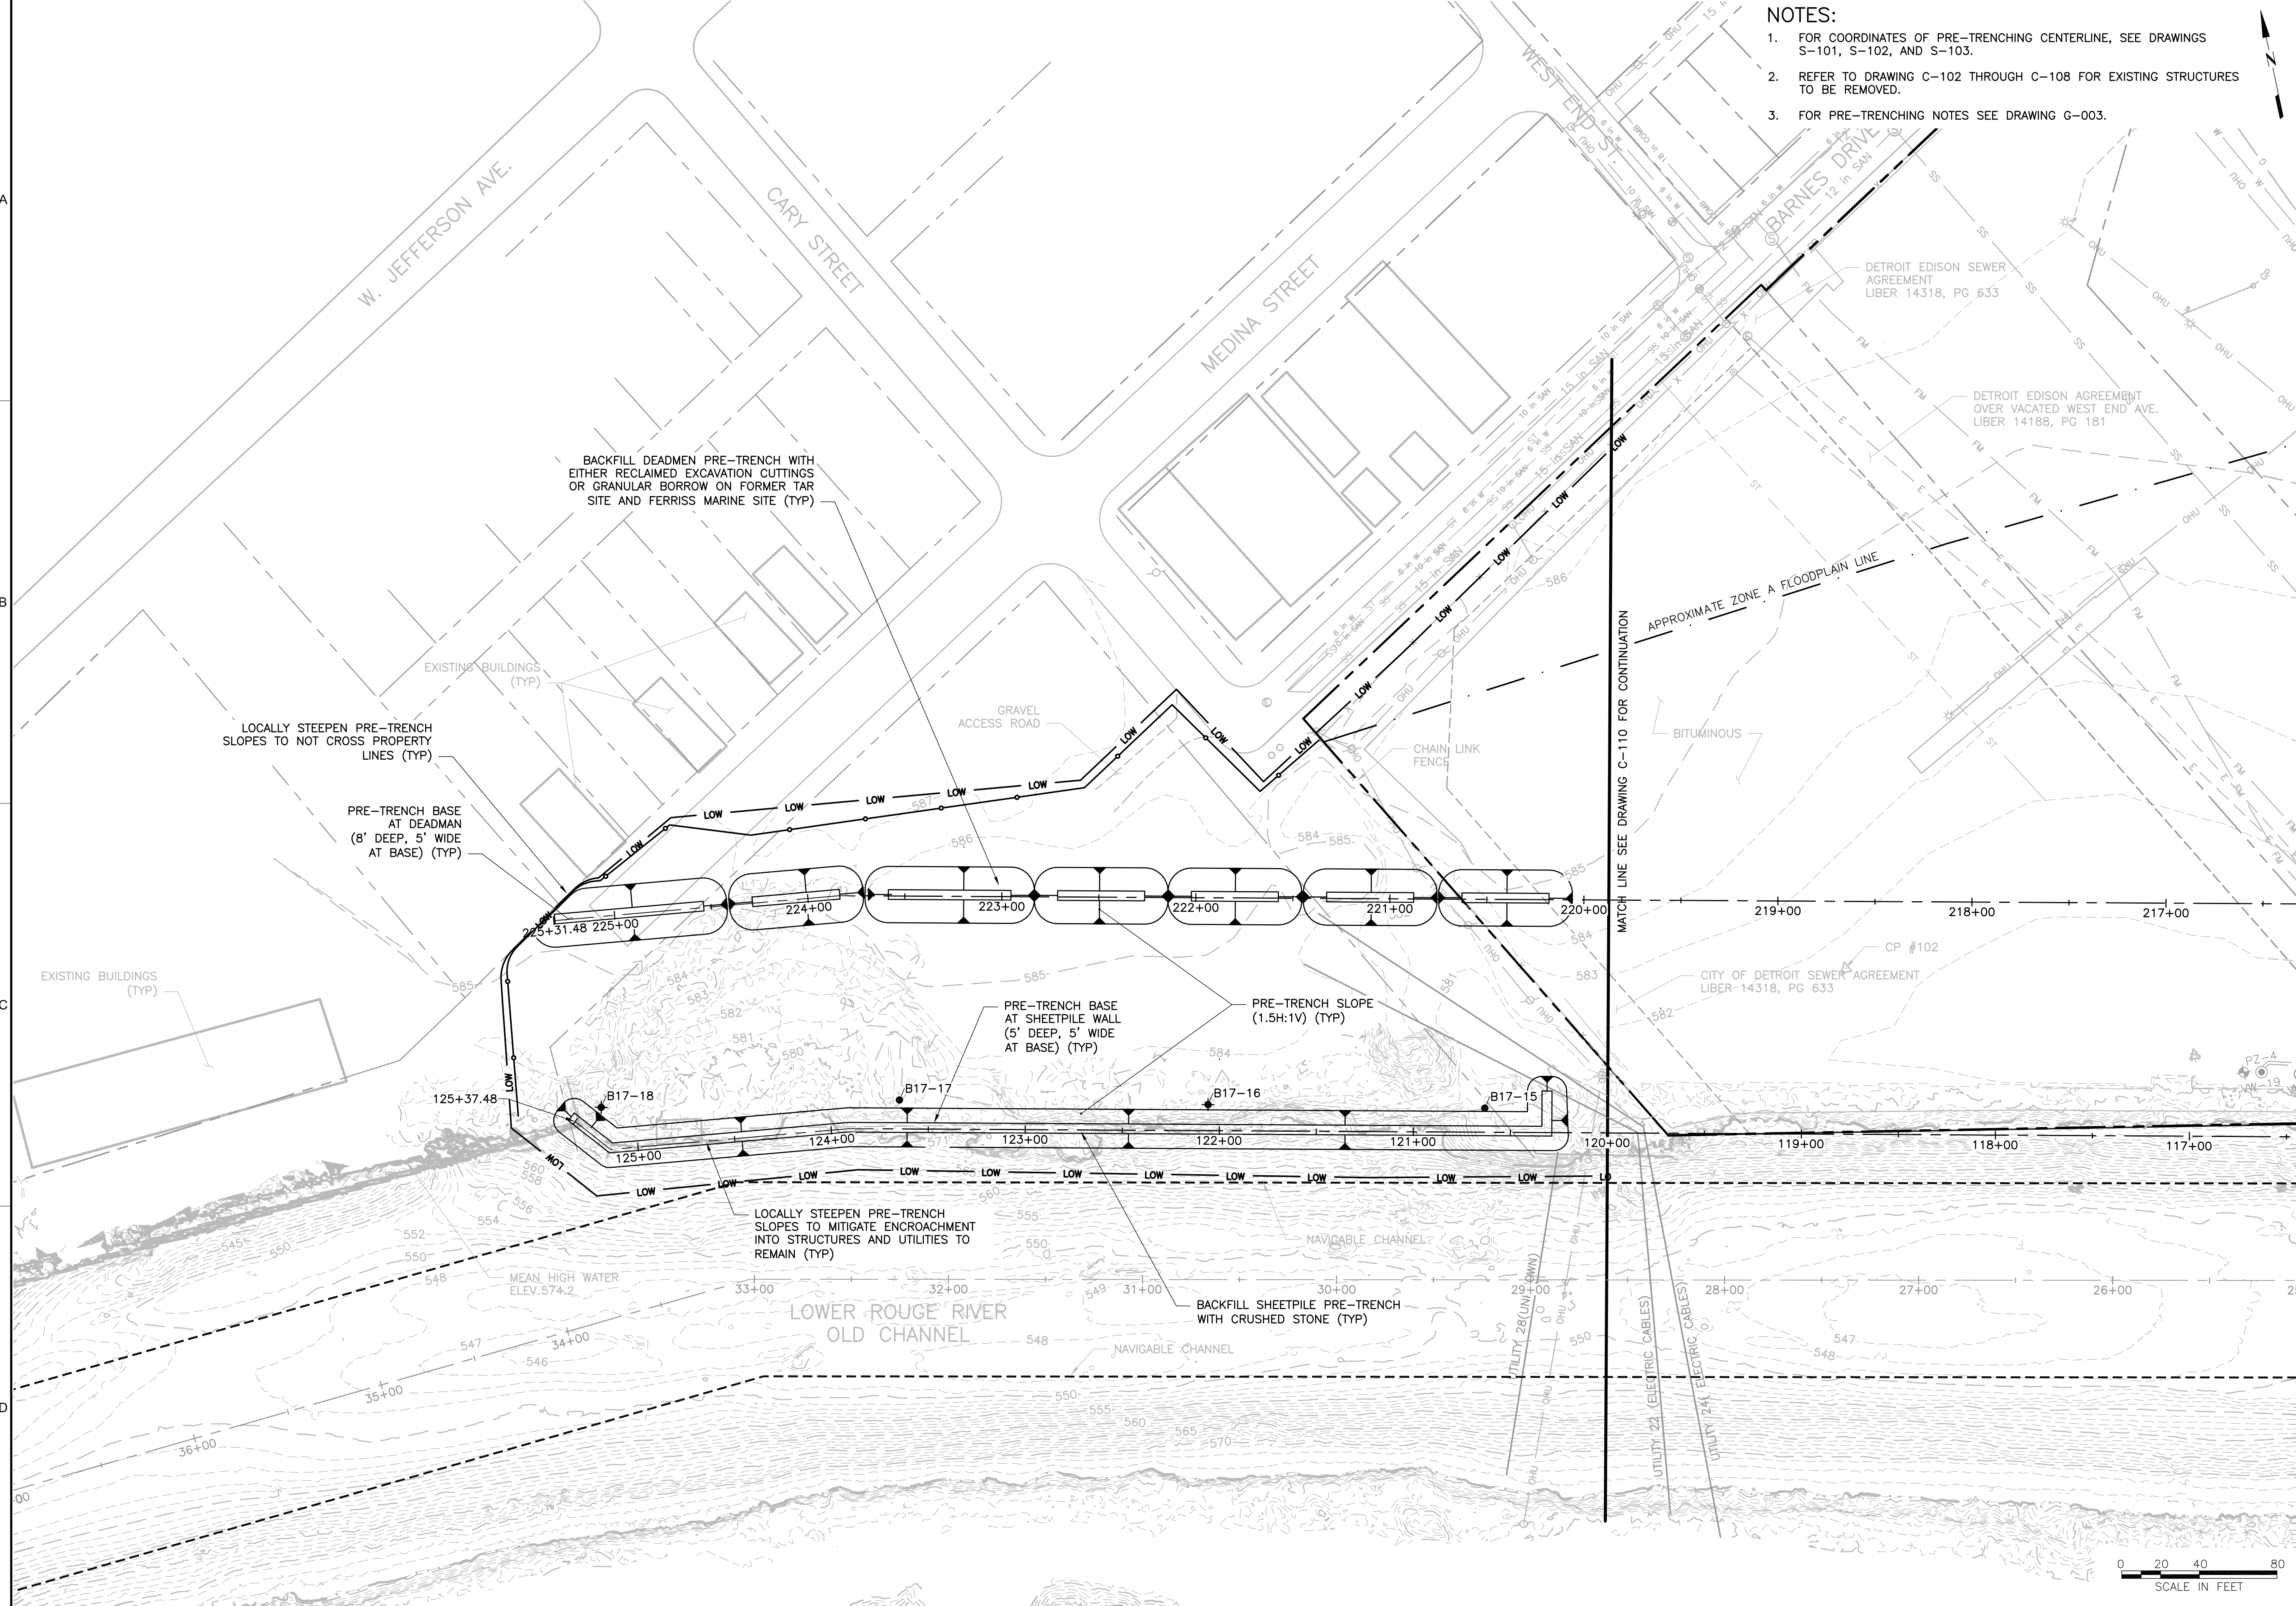


Lyle N Tracy  
 MI PROFESSIONAL ENGINEER  
 LICENSE NUMBER Lic. NUM

WJM	LNT	100% DESIGN - REVISED
WJM	LNT	100% DESIGN
WJM	LNT	100% DESIGN - FOR REVIEW
JVM	LNT	90% DESIGN - CLIENT REVIEW
BY	DATE	REVISION
L. TRACY	3/28/17	100% DESIGN - REVISED
L. TRACY	3/03/17	100% DESIGN
L. TRACY	8/08/16	100% DESIGN - FOR REVIEW
L. TRACY	6/17/16	90% DESIGN - CLIENT REVIEW
L. TRACY		CHK
L. TRACY		APVD

**Honeywell**  
 101 COLUMBIA RD. 2ND FL. WARRINGTON, MI 48090  
 LOWER ROUGE RIVER OLD CHANNEL  
 ROUGE RIVER AREA OF CONCERN  
 PERMANENT SHEETPILE WALL INSTALLATION  
 DETROIT, MICHIGAN  
 HONEYWELL SITE ID - 35057

DRAWING STATUS  
 100% DESIGN  
 CIVIL  
 PRE-TRENCHING PLAN  
 (FERRISS)

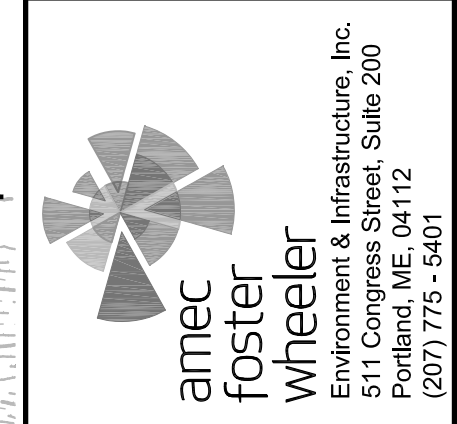


VERIFY SCALE  
 BAR IS ONE INCH ON ORIGINAL DRAWING  
 DATE: JUNE 2016  
 PROJ: 3293-16-1667  
 DWG: C-111  
 SHEET: 14 OF 52

THIS DRAWING IS THE PROPERTY OF AMEC FOSTER WHEELER, INCLUDING ALL PATENTED AND PATENTABLE FEATURES, AND/OR CONFIDENTIAL INFORMATION AND ITS USE IS CONDITIONED UPON THE USER'S AGREEMENT NOT TO REPRODUCE THE DRAWING, IN WHOLE OR PART, NOR THE MATERIAL DESCRIBED THEREON, NOR THE USE OF THE DRAWING FOR ANY PURPOSE OTHER THAN SPECIFICALLY PERMITTED IN WRITING BY AMEC FOSTER WHEELER.



1 2 3 4 5 6


- NOTES:**
- FOR COORDINATES OF PRE-TRENCHING CENTERLINE, SEE DRAWINGS S-101, S-102, AND S-103.
  - REFER TO DRAWING C-106 THROUGH C-108 FOR EXISTING STRUCTURES TO BE REMOVED.
  - FOR EXCAVATION NOTES SEE DRAWING G-003.

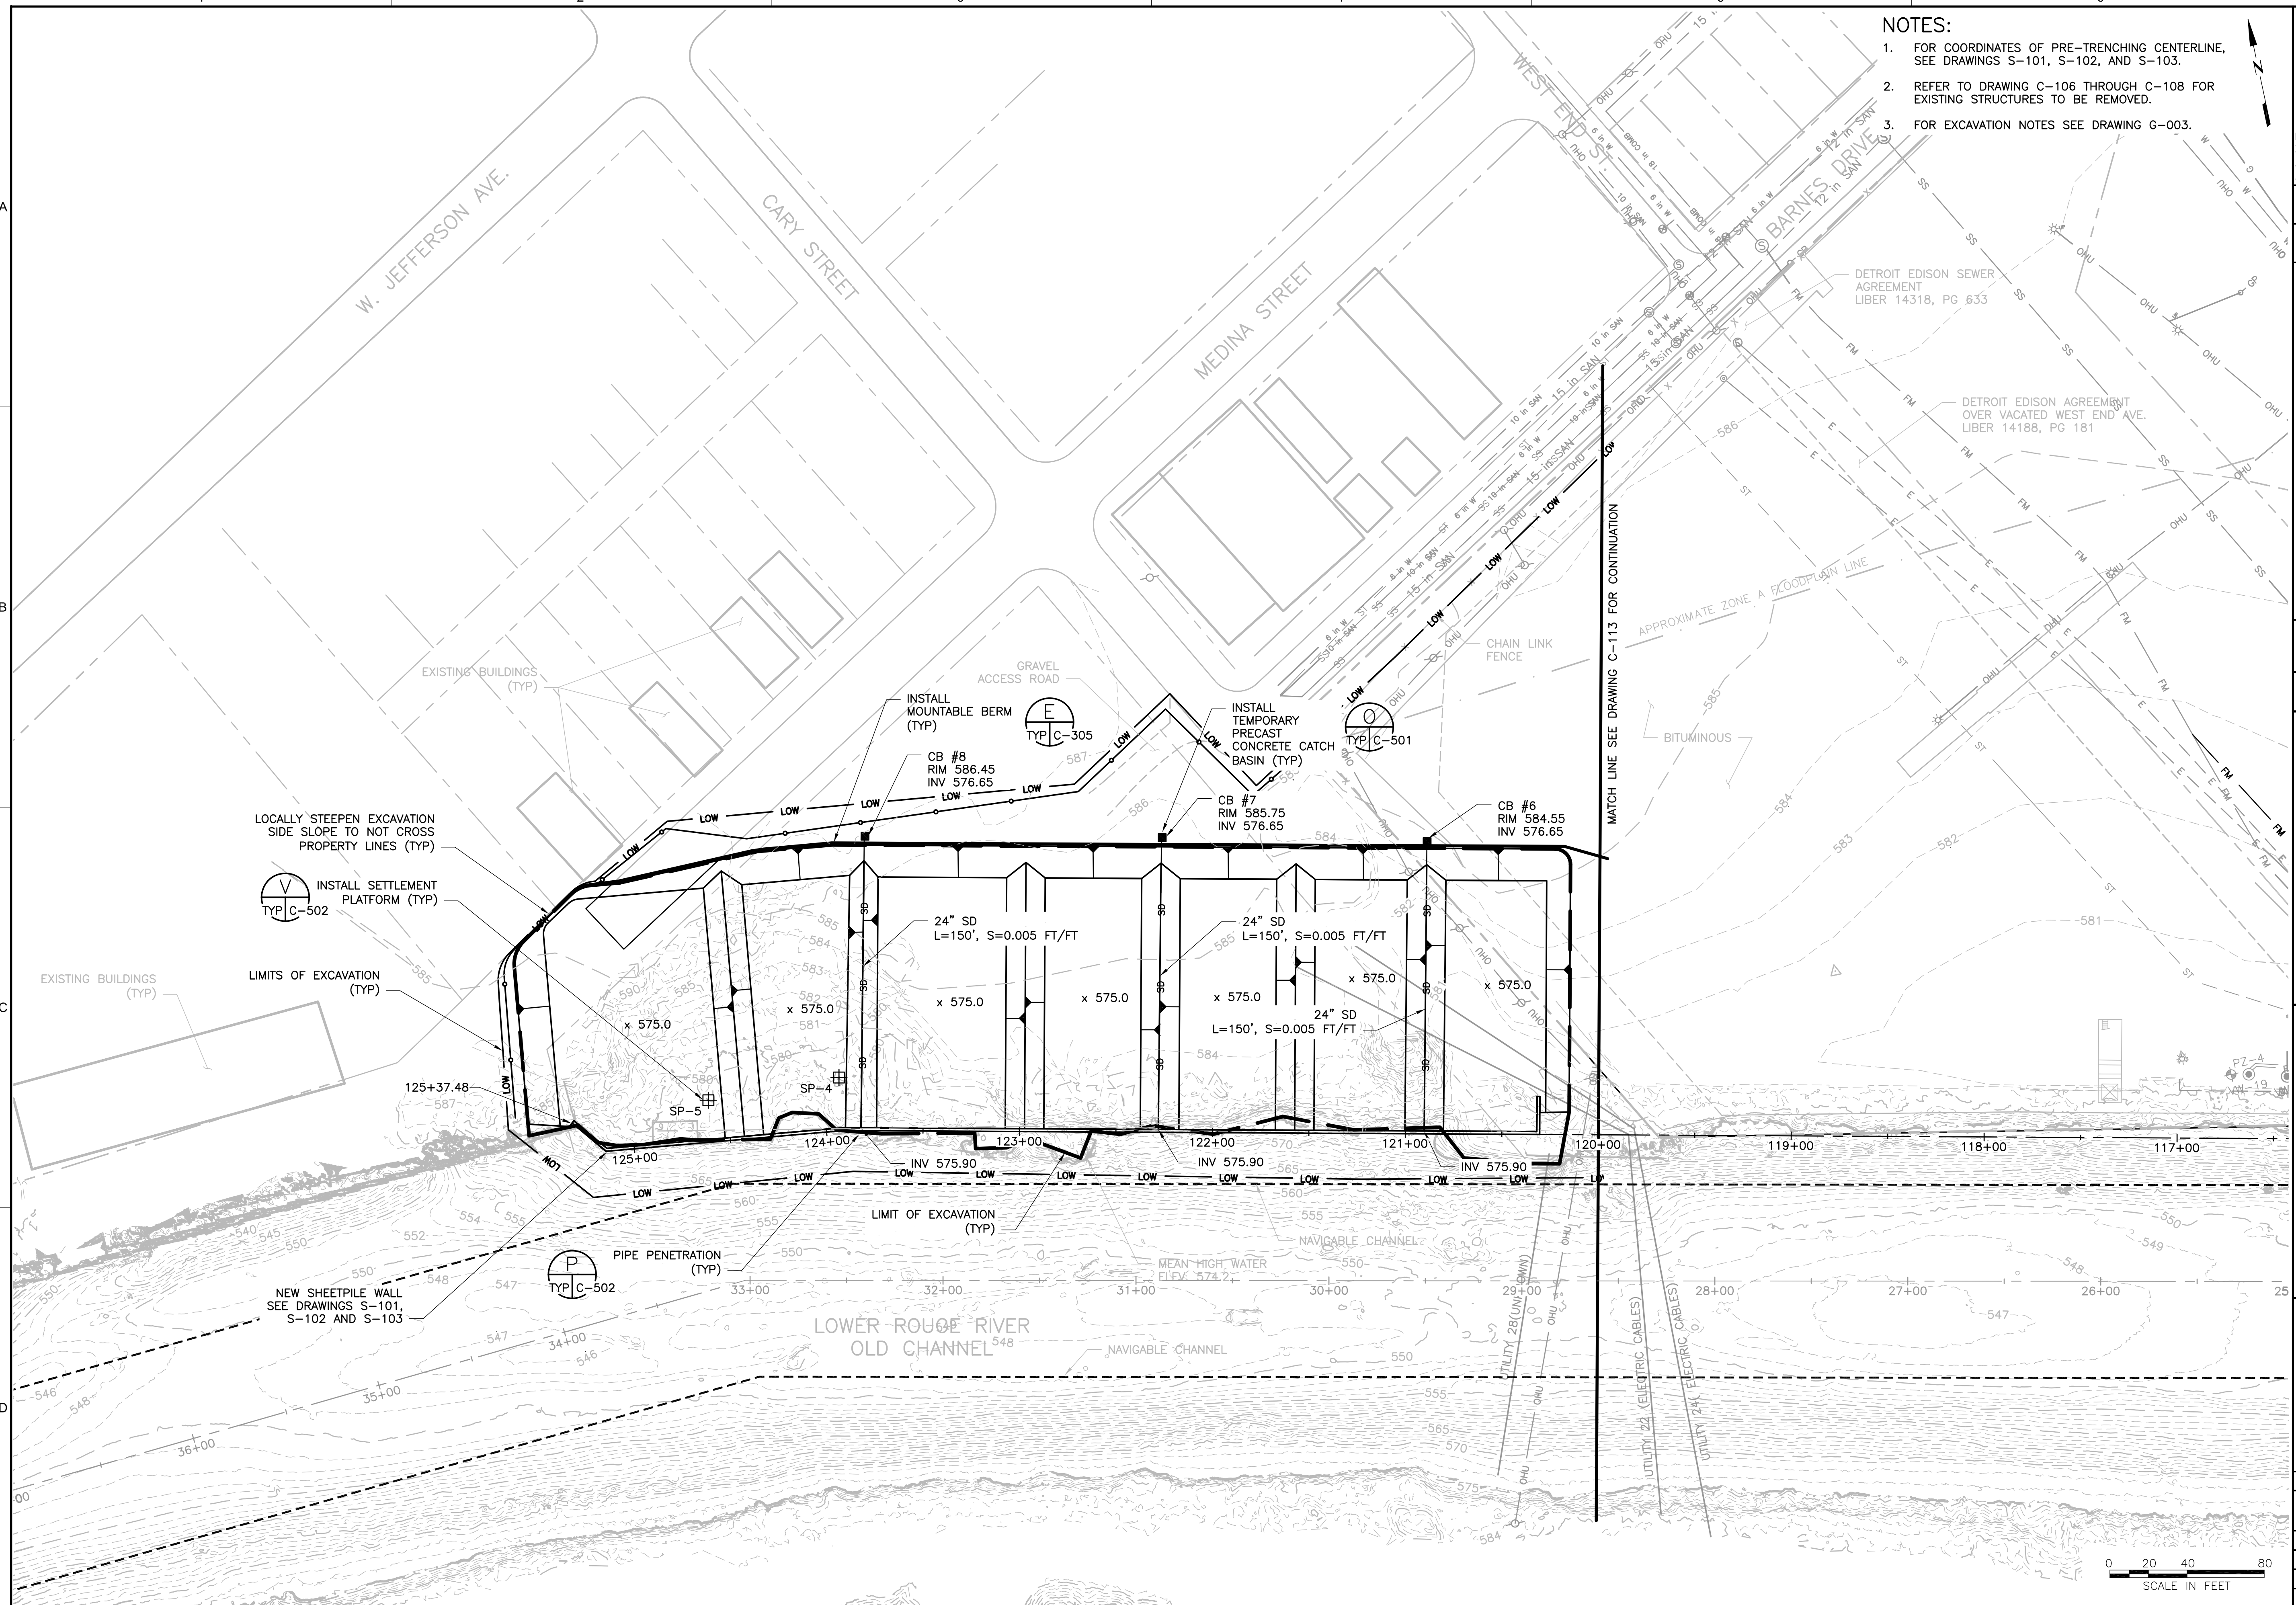


L. TRACY		L. TRACY		L. TRACY	
NO.	DATE	DR	CHK	APVD	BY
1	6/17/16	J. MCKENZIE	J. MCKENZIE	L. STIRBAN	J. MCKENZIE
2	8/08/16				
3	3/03/17				
100% DESIGN			100% DESIGN - FOR REVIEW		
90% DESIGN - CLIENT REVIEW			REVISION		
MI PROFESSIONAL ENGINEER LICENSE NUMBER Lic. NUM					

**Honeywell**  
 101 COLUMBIA RD. BOX 2105, WARREN, MI 48090  
 LOWER ROUGE RIVER OLD CHANNEL  
 ROUGE RIVER AREA OF CONCERN  
 PERMANENT SHEETPILE WALL INSTALLATION  
 DETROIT, MICHIGAN  
 HONEYWELL SITE ID - 35057


DRAWING STATUS  
 100% DESIGN  
 CIVIL  
 EXCAVATION PLAN  
 (FERRISS)

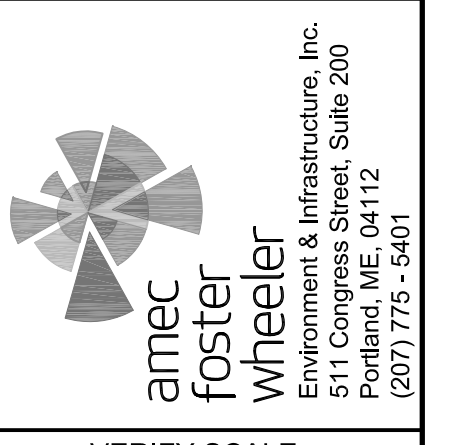

VERIFY SCALE  
 BAR IS ONE INCH ON ORIGINAL DRAWING  
 DATE JUNE 2016  
 PROJ 3293-16-1667  
 DWG C-114  
 SHEET 17 OF 52

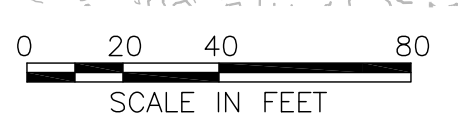



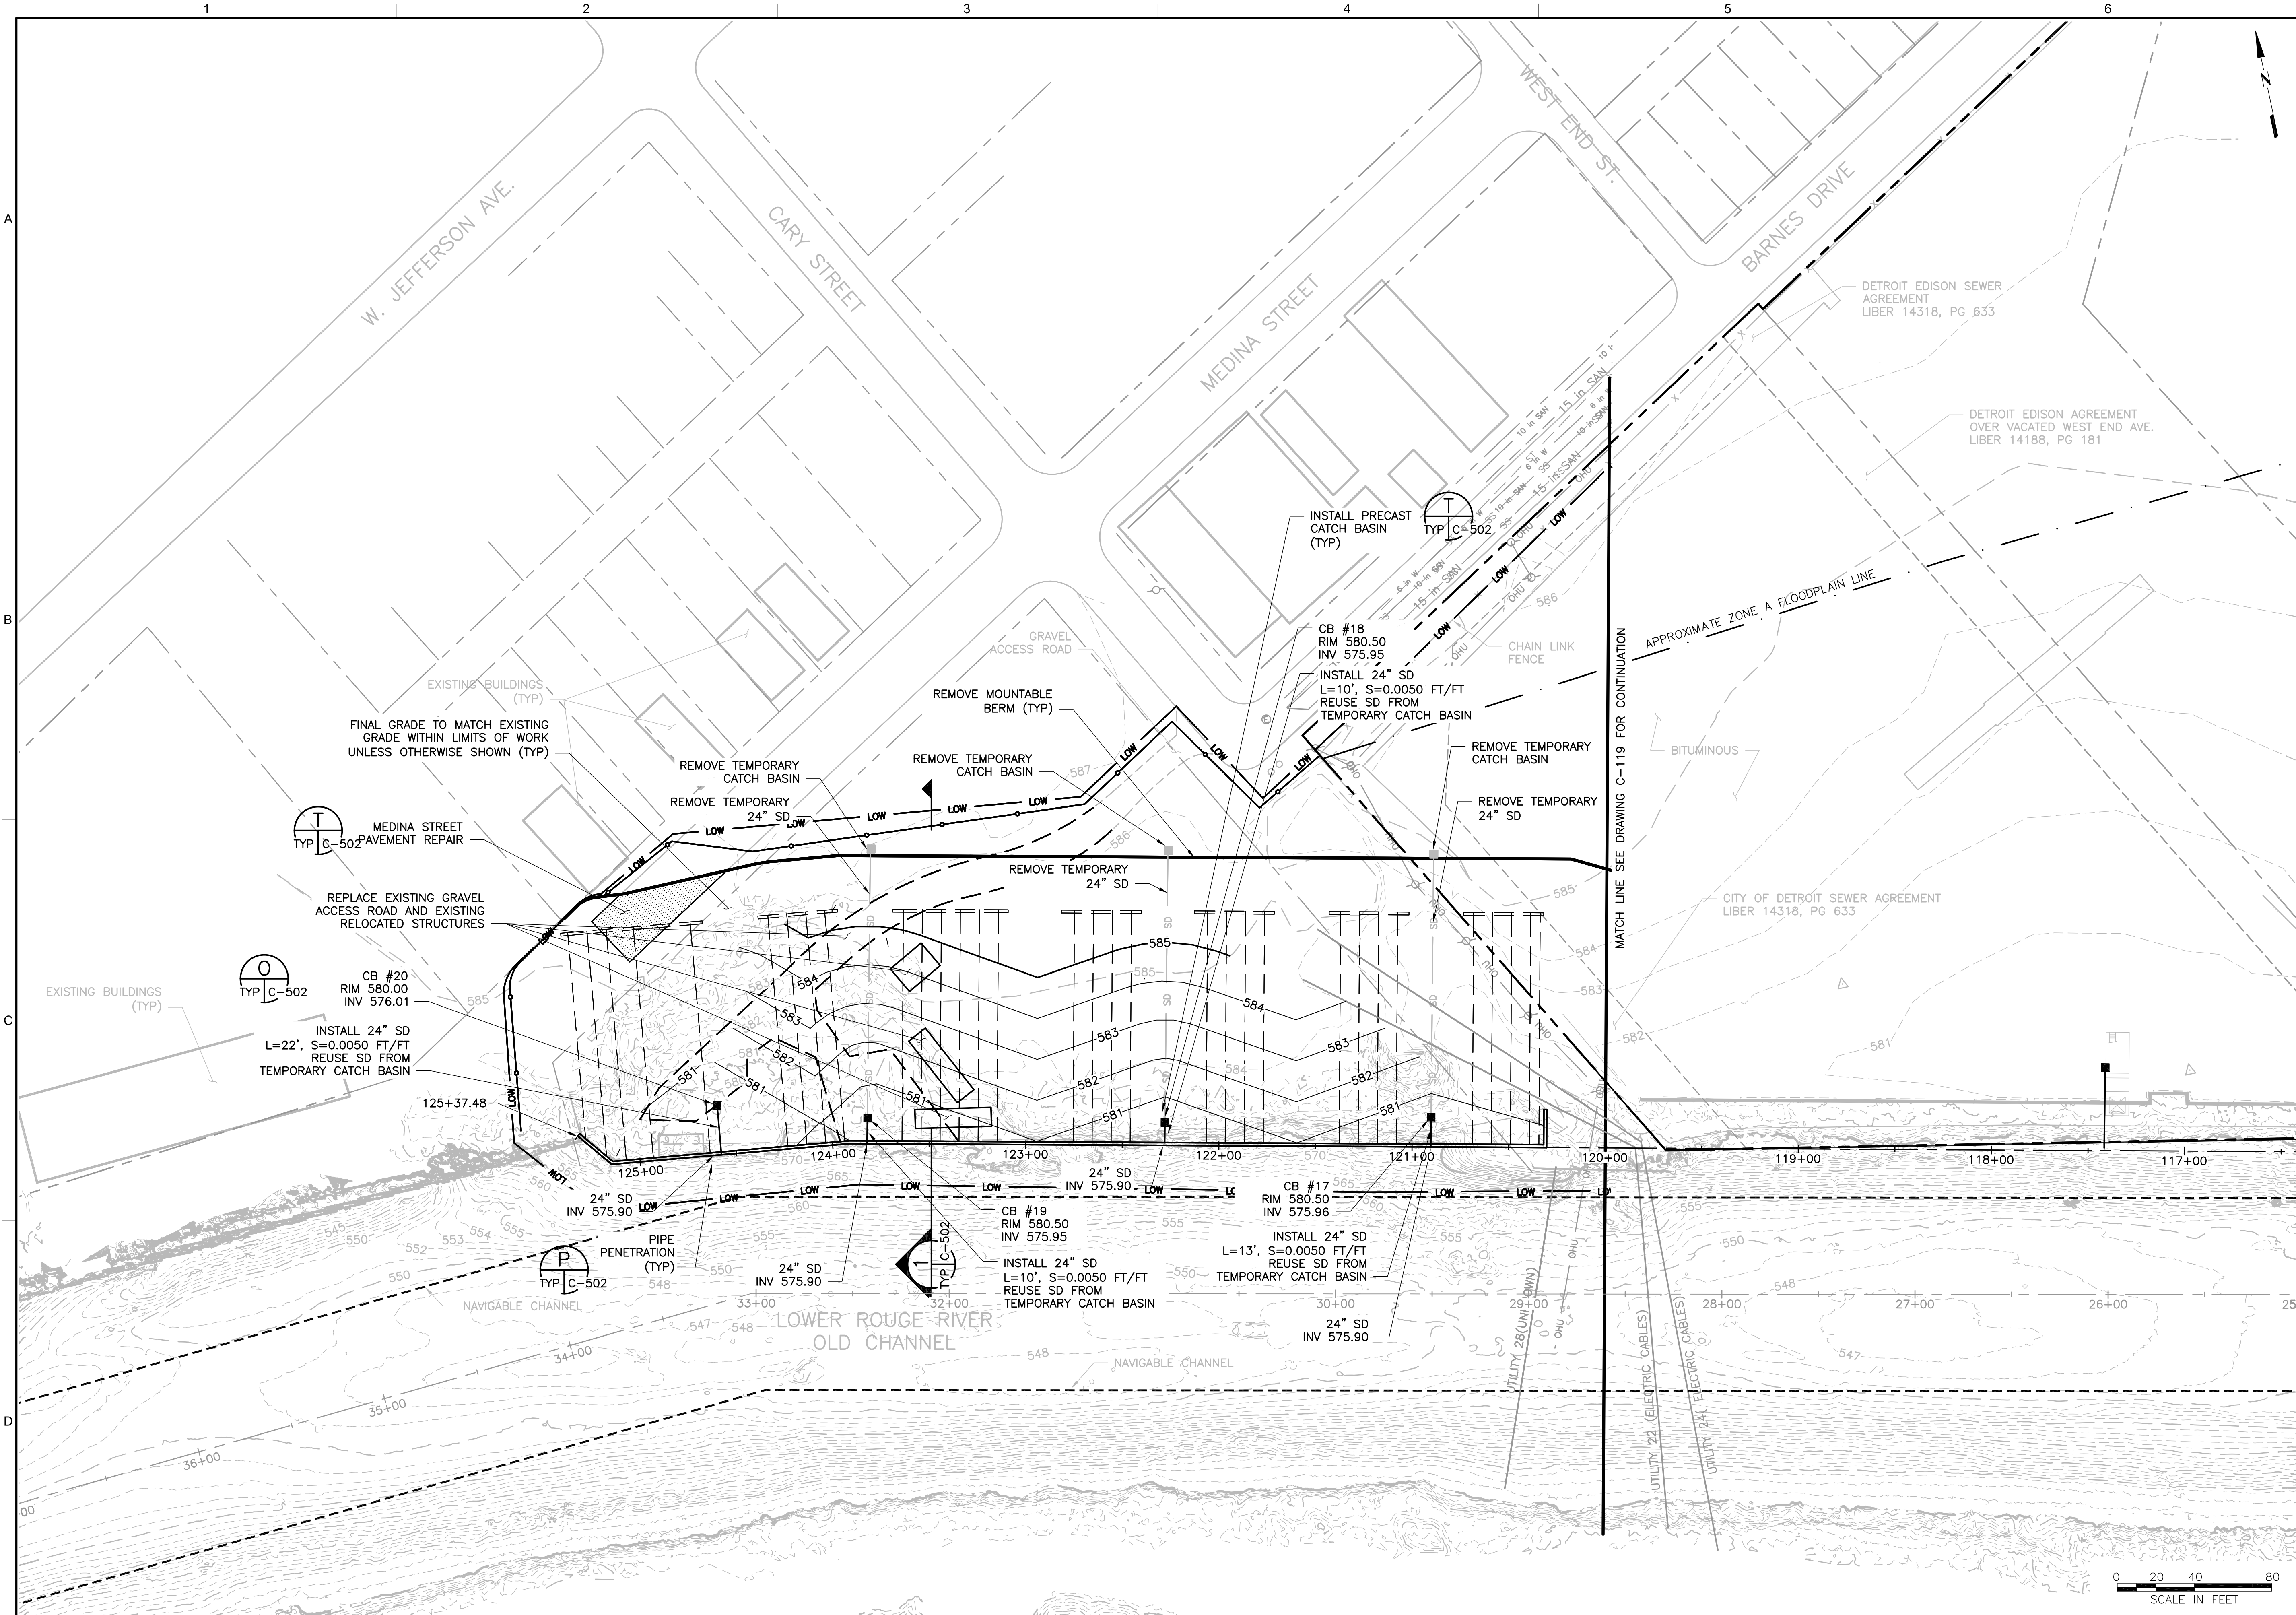


Lyle N Tracy  
 MI PROFESSIONAL ENGINEER  
 LICENSE NUMBER Lic. NUM

WJM	LNT	100% DESIGN
WJM	LNT	100% DESIGN - FOR REVIEW
JVM	LNT	90% DESIGN - CLIENT REVIEW
JVM	LNT	REVISION
NO.	DATE	BY
DR	L. TRACY	APVD
CHK	J. MCKENZIE	CHK

**Honeywell**  
 101 COLUMBIA RD. BOX 2105, MORGANTOWN, W. VA. 26506  
 LOWER ROUGE RIVER OLD CHANNEL  
 ROUGE RIVER AREA OF CONCERN  
 PERMANENT SHEETPILE WALL INSTALLATION  
 DETROIT, MICHIGAN  
 HONEYWELL SITE ID - 35057

DRAWING STATUS  
 100% DESIGN  
 CIVIL  
 FINAL GRADING PLAN  
 (FERRISS)

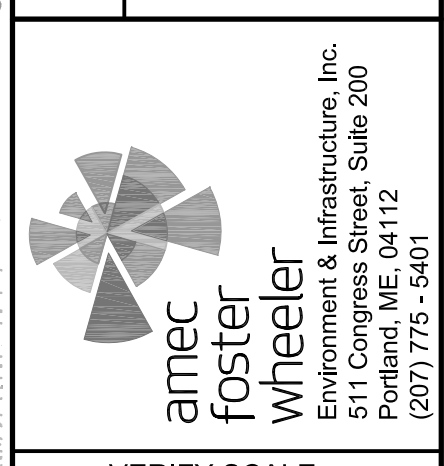

VERIFY SCALE  
 BAR IS ONE INCH ON ORIGINAL DRAWING  
 DATE JUNE 2016  
 PROJ 3293-16-1667  
 DWG C-117  
 SHEET 20 OF 52

THIS DRAWING IS THE PROPERTY OF AMEC FOSTER WHEELER, INCLUDING ALL PATENTED AND PATENTABLE FEATURES, AND/OR CONFIDENTIAL INFORMATION AND ITS USE IS CONDITIONED UPON THE USER'S AGREEMENT NOT TO REPRODUCE THE DRAWING, IN WHOLE OR PART, NOR THE MATERIAL DESCRIBED THEREON, NOR THE USE OF THE DRAWING FOR ANY PURPOSE OTHER THAN SPECIFICALLY PERMITTED IN WRITING BY AMEC FOSTER WHEELER.





A

B

C

D

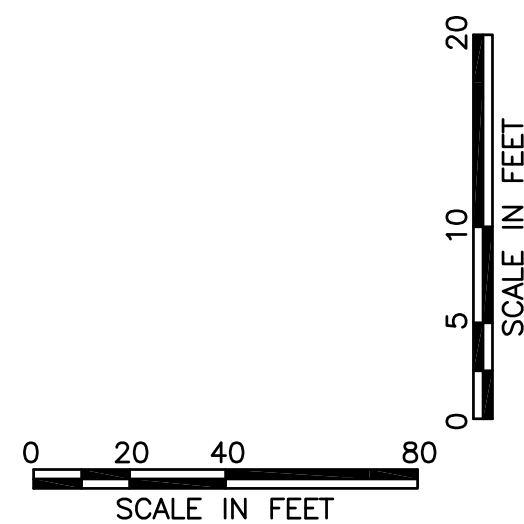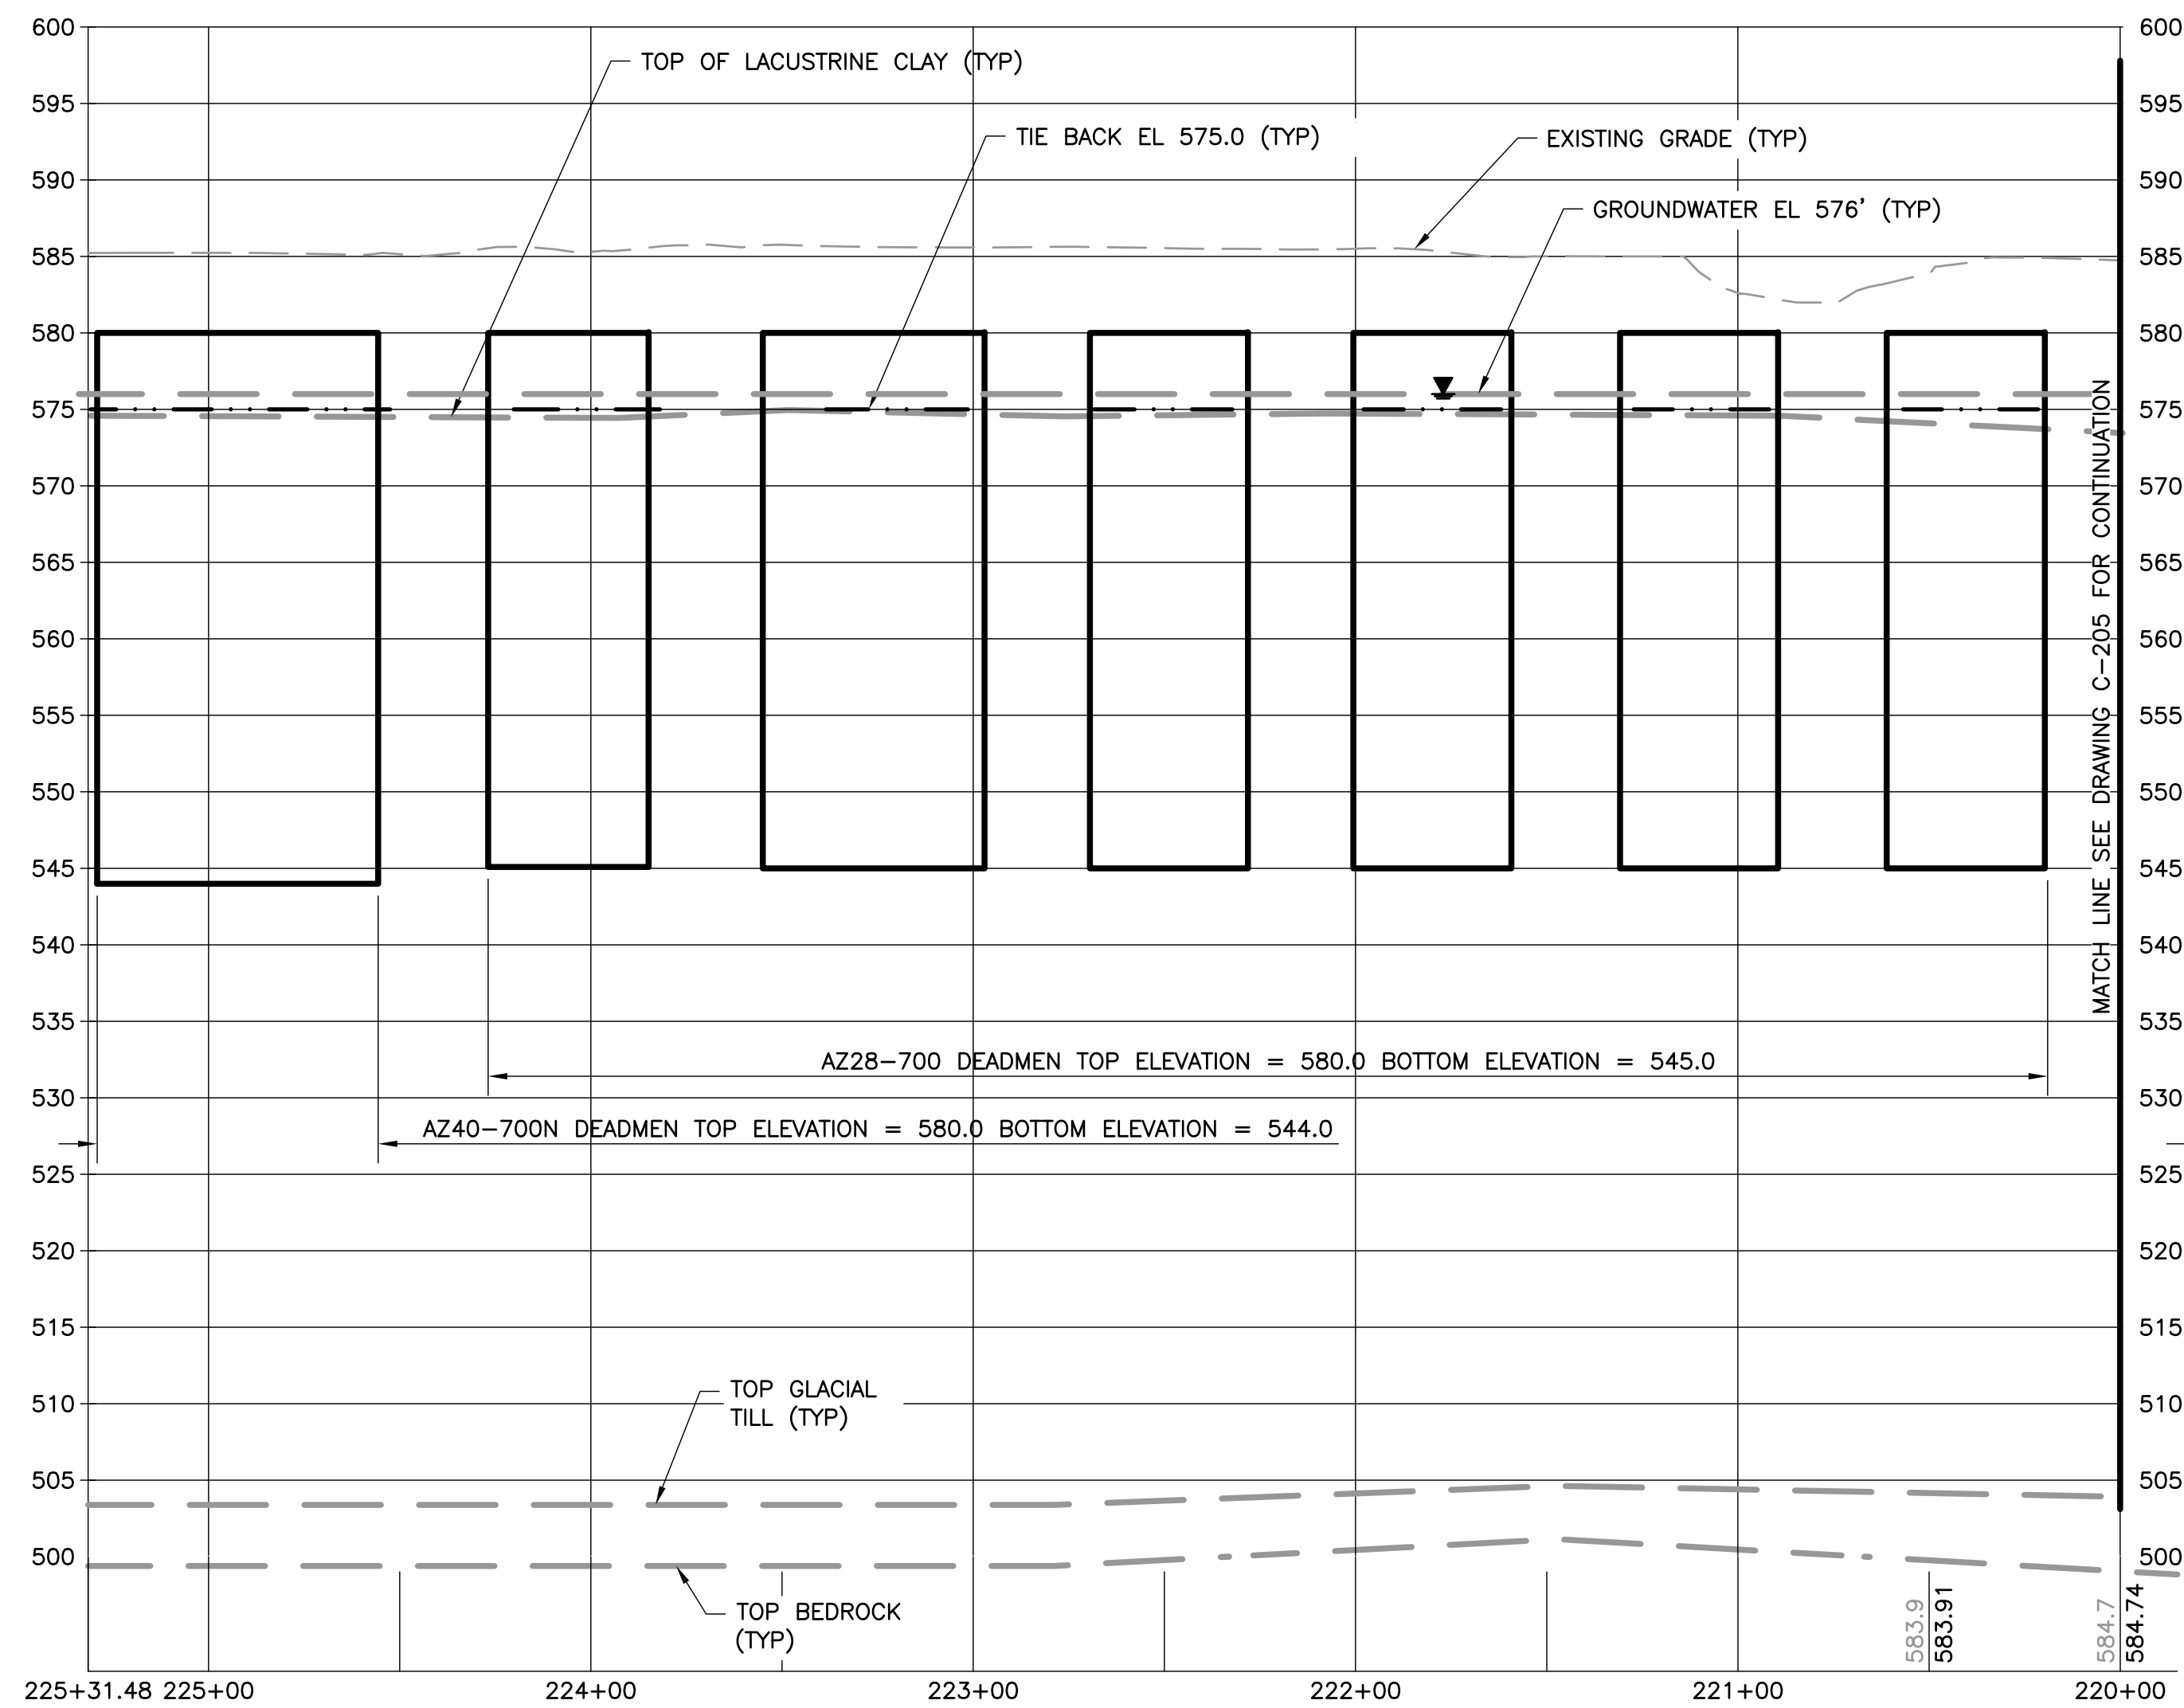

L. TRACY		L. TRACY	
WJM	LNT	WJM	LNT
JVM	LNT	JVM	LNT
JVM	LNT	JVM	LNT
BY JAPVD		BY JAPVD	

100% DESIGN		100% DESIGN	
100% DESIGN - FOR REVIEW		100% DESIGN - FOR REVIEW	
90% DESIGN - CLIENT REVIEW		90% DESIGN - CLIENT REVIEW	
NO.	DATE	NO.	DATE
3	3/03/17	2	8/08/16
1	6/17/16	1	6/17/16
DGN		DGN	
DR		DR	
CHK		CHK	
APVD		APVD	
L. TRACY		L. STIRBAN	
J. MCKENZIE		L. TRACY	
MI PROFESSIONAL ENGINEER		MI PROFESSIONAL ENGINEER	
LICENSE NUMBER Lic. NUM		LICENSE NUMBER Lic. NUM	

**Honeywell**  
 101 COLUMBIA RD. BOX 2105, MORRISTOWN, NJ 07962  
 LOWER ROUGE RIVER OLD CHANNEL  
 ROUGE RIVER AREA OF CONCERN  
 PERMANENT SHETPILE WALL INSTALLATION  
 DETROIT, MICHIGAN  
 HONEYWELL SITE ID - 35057

DRAWING STATUS  
 100% DESIGN  
 CIVIL  
 INTERPRETIVE SUBSURFACE  
 PROFILE ALONG DEADMAN  
 ALIGNMENT  
 (FERRISS)

amec  
foster  
wheeler  
Environment & Infrastructure, Inc.  
511 Congress Street, Suite 200  
Portland, ME 04112  
(207) 775-5401

VERIFY SCALE  
 BAR IS ONE INCH ON  
 ORIGINAL DRAWING  
 1"




DATE JUNE 2016  
 PROJ 3293-16-1667  
 DWG C-206  
 SHEET 26 OF 52

THIS DRAWING IS THE PROPERTY OF AMEC FOSTER WHEELER, INCLUDING ALL PATENTED AND PATENTABLE FEATURES, AND/OR CONFIDENTIAL INFORMATION AND ITS USE IS CONDITIONED UPON THE USER'S AGREEMENT NOT TO REPRODUCE THE DRAWING, IN WHOLE OR PART, NOR THE MATERIAL DESCRIBED THEREON, NOR THE USE OF THE DRAWING FOR ANY PURPOSE OTHER THAN SPECIFICALLY PERMITTED IN WRITING BY AMEC FOSTER WHEELER.

A  
B  
C  
D

**NOTES**


1. BACKFILL DETAILS, EXCEPT LIGHTWEIGHT FILL, NOT SHOWN FOR CLARITY. SEE TYPICAL BACKFILL SECTION 1 ON DRAWING C-502 FOR DETAILS.
2. LIGHTWEIGHT FILL SHOWN FOR CLARIFICATION OF TYPICAL BACKFILL SECTION 1 ON DRAWING C-502.
3. FOR EXCAVATION LIMIT DETAILS SEE DRAWINGS C-115 THROUGH C-117.
4. WALERS SHOWN NOT TO SCALE FOR CLARITY.
5. DREDGE LINE SHOWN FOR INFORMATION PURPOSES - NOT IN THIS CONTRACT.

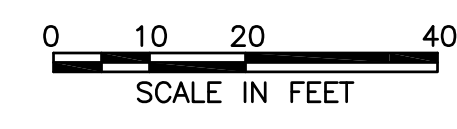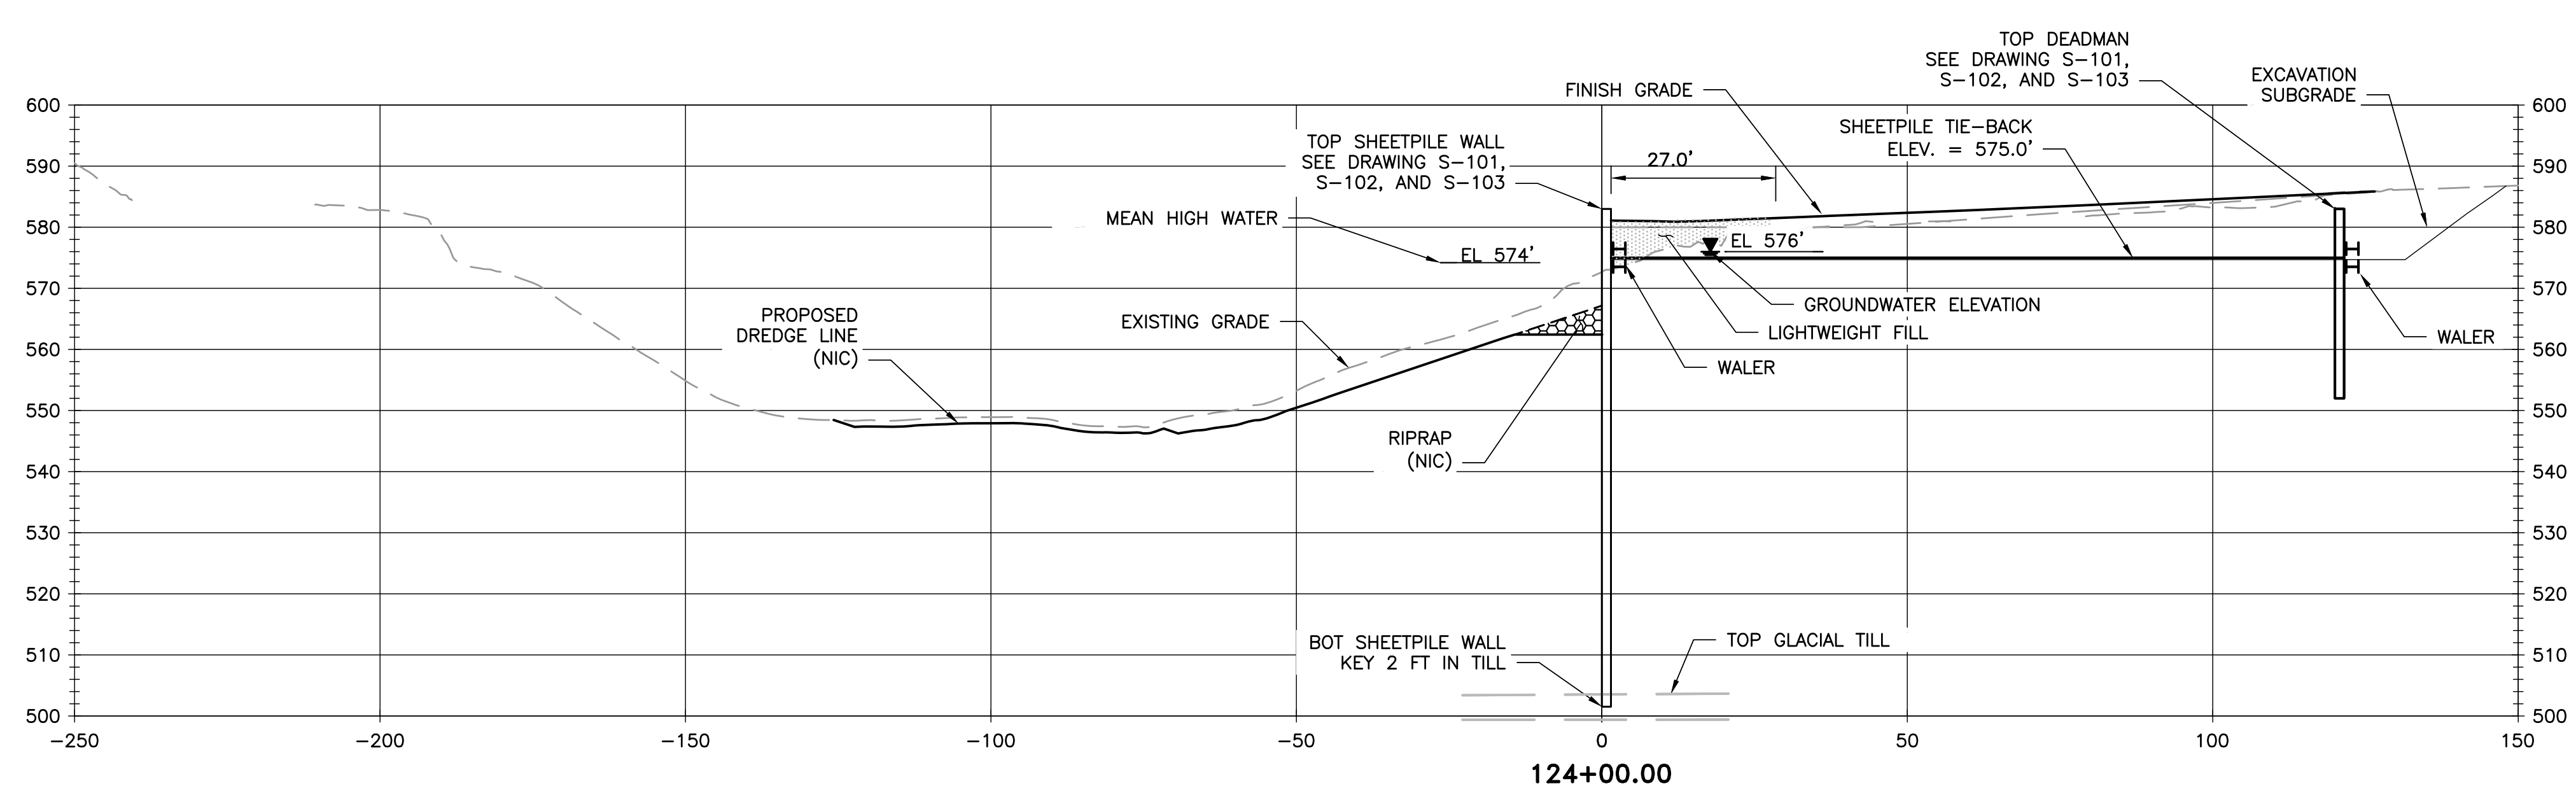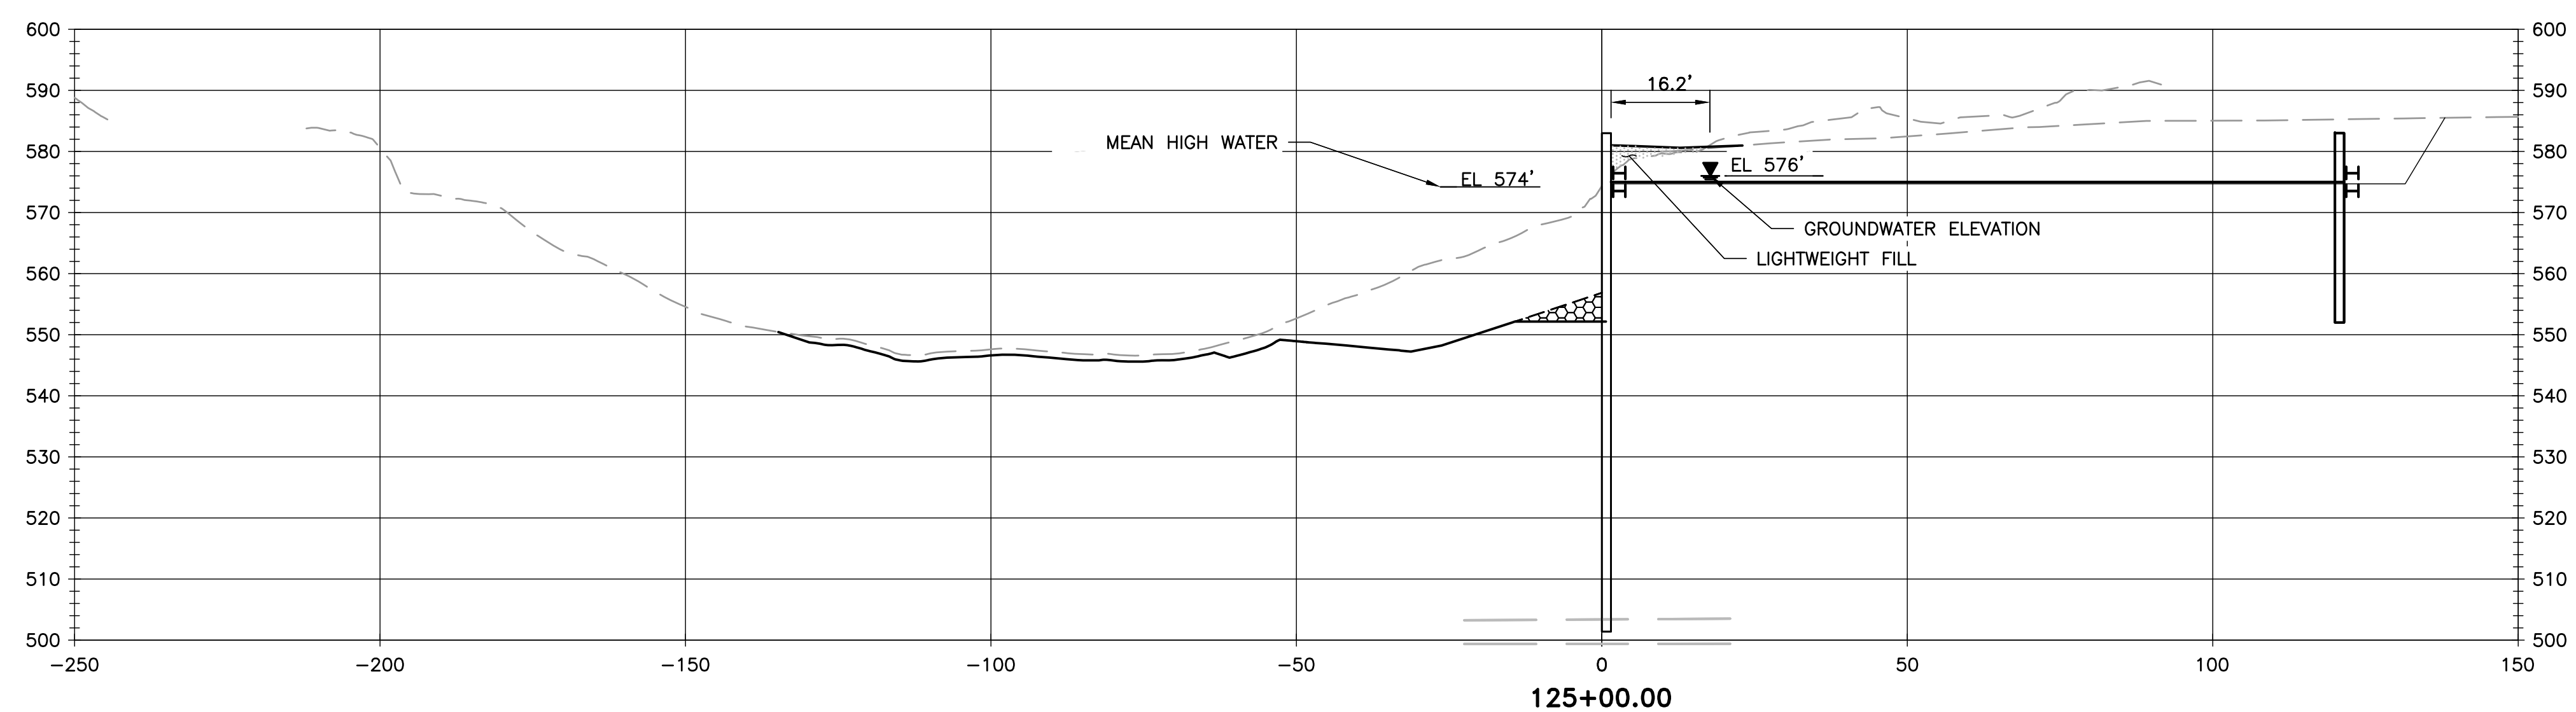

<b>Honeywell</b> <small>101 COLUMBIA RD. BOX 2105, MARSHWING, NJ 07962</small>		LOWER ROUGE RIVER OLD CHANNEL ROUGE RIVER AREA OF CONCERN PERMANENT SHEETPILE WALL INSTALLATION DETROIT, MICHIGAN HONEYWELL SITE ID - 35057	
		DRAWING STATUS 100% DESIGN	CIVIL CROSS SECTIONS STA 124+00 TO STA 125+00
amec foster wheeler <small>Environment &amp; Infrastructure, Inc.                  511 Congress Street, Suite 200                  Portland, ME 04112                  (207) 775-5401</small>		VERIFY SCALE BAR IS ONE INCH ON ORIGINAL DRAWING	
DATE	JUNE 2016	PROJ	3293-16-1667
DWG	C-409	SHEET	40 OF 52

THIS DRAWING IS THE PROPERTY OF AMEC FOSTER WHEELER, INCLUDING ALL PATENTED AND PATENTABLE FEATURES, AND/OR CONFIDENTIAL INFORMATION AND ITS USE IS CONDITIONED UPON THE USER'S AGREEMENT NOT TO REPRODUCE THE DRAWING, IN WHOLE OR PART, NOR THE MATERIAL DESCRIBED THEREON, NOR THE USE OF THE DRAWING FOR ANY PURPOSE OTHER THAN SPECIFICALLY PERMITTED IN WRITING BY AMEC FOSTER WHEELER.



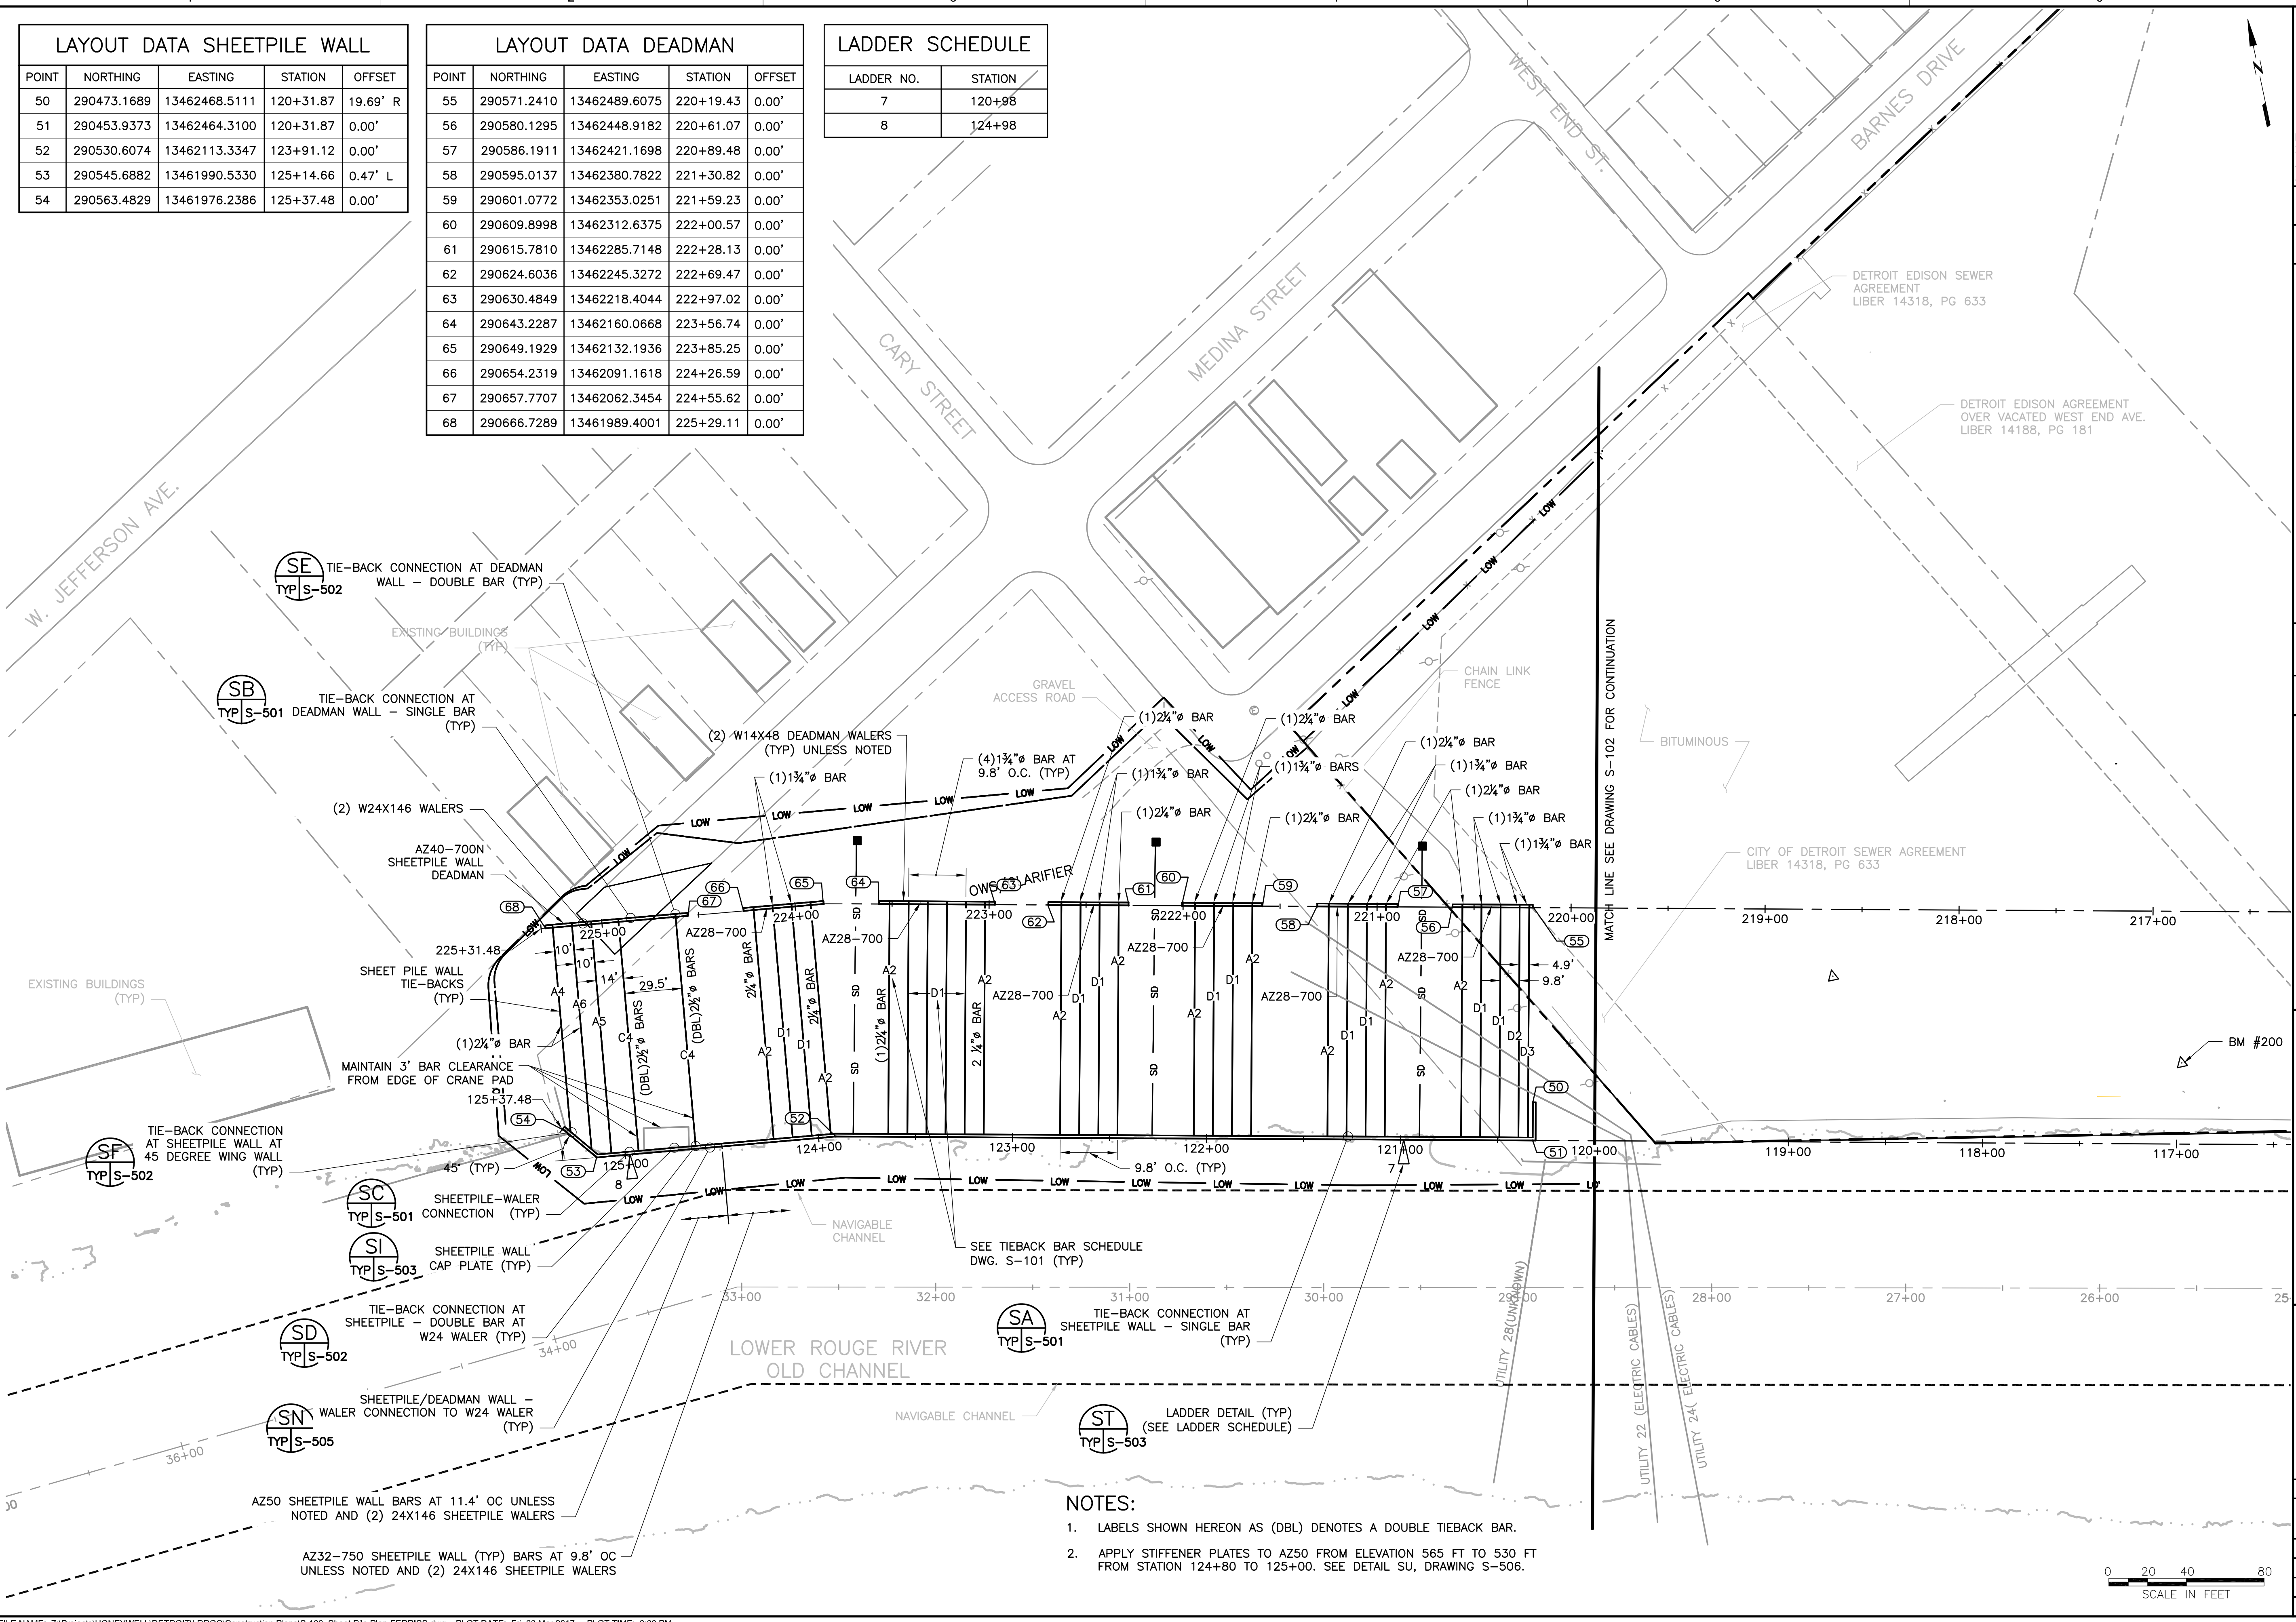

LAYOUT DATA SHEETPILE WALL				
POINT	NORTHING	EASTING	STATION	OFFSET
50	290473.1689	13462468.5111	120+31.87	19.69' R
51	290453.9373	13462464.3100	120+31.87	0.00'
52	290530.6074	13462113.3347	123+91.12	0.00'
53	290545.6882	13461990.5330	125+14.66	0.47' L
54	290563.4829	13461976.2386	125+37.48	0.00'

LAYOUT DATA DEADMAN				
POINT	NORTHING	EASTING	STATION	OFFSET
55	290571.2410	13462489.6075	220+19.43	0.00'
56	290580.1295	13462448.9182	220+61.07	0.00'
57	290586.1911	13462421.1698	220+89.48	0.00'
58	290595.0137	13462380.7822	221+30.82	0.00'
59	290601.0772	13462353.0251	221+59.23	0.00'
60	290609.8998	13462312.6375	222+00.57	0.00'
61	290615.7810	13462285.7148	222+28.13	0.00'
62	290624.6036	13462245.3272	222+69.47	0.00'
63	290630.4849	13462218.4044	222+97.02	0.00'
64	290643.2287	13462160.0668	223+56.74	0.00'
65	290649.1929	13462132.1936	223+85.25	0.00'
66	290654.2319	13462091.1618	224+26.59	0.00'
67	290657.7707	13462062.3454	224+55.62	0.00'
68	290666.7289	13461989.4001	225+29.11	0.00'

LADDER SCHEDULE	
LADDER NO.	STATION
7	120+98
8	124+98

Lyle N Tracy
MI PROFESSIONAL ENGINEER  
LICENSE NUMBER Lic. NUM

100% DESIGN	WJM LNT	APVD	L. TRACY
USACE PERMIT RESPONSE	WJM LNT	CHK	L. TRACY
100% DESIGN - FOR REVIEW	WJM LNT	DR	L. TRACY
90% DESIGN - CLIENT REVIEW	JVM LNT	DSGN	L. TRACY
REVISION	BY	DATE	

**Honeywell**  
101 COLUMBIA RD., SUITE 2105, WILMINGTON, DE 19842

LOWER ROUGE RIVER OLD CHANNEL  
ROUGE RIVER AREA OF CONCERN  
PERMANENT SHEETPILE WALL INSTALLATION  
DETROIT, MICHIGAN  
HONEYWELL SITE ID - 35057

DRAWING STATUS  
100% DESIGN

STRUCTURAL


PERMANENT SHEET PILE WALL AND ANCHOR SYSTEM PLAN (FERRISS)

**amec foster wheeler**  
Environment & Infrastructure, Inc.  
511 Congress Street, Suite 200  
Portland, ME 04112  
(207) 775-5401

VERIFY SCALE  
BAR IS ONE INCH ON ORIGINAL DRAWING

DATE: JUNE 2016  
PROJ: 3293-16-1667  
DWG: S-103  
SHEET: 46 OF 52

- NOTES:**
- LABELS SHOWN HEREON AS (DBL) DENOTES A DOUBLE TIEBACK BAR.
  - APPLY STIFFENER PLATES TO AZ50 FROM ELEVATION 565 FT TO 530 FT FROM STATION 124+80 TO 125+00. SEE DETAIL SU, DRAWING S-506.

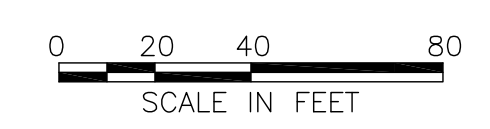



EXISTING BUILDINGS  
(TYP)

65

66

68

MEDINA STREET

LOCALLY STEEPEN EXCAVATION SIDE  
SLOPE TO NOT CROSS PROPERTY  
LINES OR USE SHORING TO KEEP  
EXCAVATION LIMITS WITHIN 5'  
OF THE DEADMAN ALIGNMENT ON THE NORTH  
SIDE OF MEDINA STREET. (TYP)

PROPOSED MEDINA  
STREET CLOSURE

DEADMAN  
(TYP)

TIEBACKS  
(TYP)


LIMIT OF  
EXCAVATION

225+31.48

225+00

224+00

125+37.48

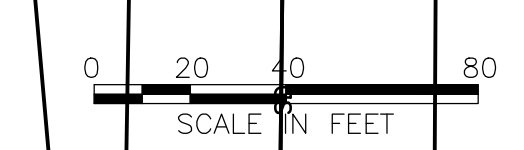

<b>Honeywell</b> 101 COLUMBIA RD. BOX 2105 MORRISTOWN, NJ 07962		LOWER ROUGE RIVER OLD CHANNEL ROUGE RIVER AREA OF CONCERN PERMANENT SHEETPILE WALL INSTALLATION DETROIT, MICHIGAN HONEYWELL SITE ID - 35057	
DRAWING STATUS ISSUED CONSTRUCTION - DRAFT		PROPOSED MEDINA STREET CLOSURE	
 <b>amec foster wheeler</b> Environment & Infrastructure, Inc. 511 Congress Street, Suite 200 Portland, ME 04112 (207) 775-5401		VERIFY SCALE BAR IS ONE INCH ON ORIGINAL DRAWING 0 1"	
DATE		DATE	
PROJ 3293-16-1667		PROJ 3293-16-1667	
DWG		DWG	
SHEET		OF 53	
NO. DATE DSGN DR REVISION (CHK) APVD BY (APVD) MI PROFESSIONAL ENGINEER LICENSE NUMBER		THIS DRAWING IS THE PROPERTY OF AMEC FOSTER WHEELER, INCLUDING ALL PATENTED AND PATENTABLE FEATURES, AND/OR CONFIDENTIAL INFORMATION AND ITS USE IS CONDITIONED UPON THE USER'S AGREEMENT NOT TO REPRODUCE THE DRAWING, IN WHOLE OR PART, NOR THE MATERIAL DESCRIBED THEREON, NOR THE USE OF THE DRAWING FOR ANY PURPOSE OTHER THAN SPECIFICALLY PERMITTED IN WRITING BY AMEC FOSTER WHEELER.	



