
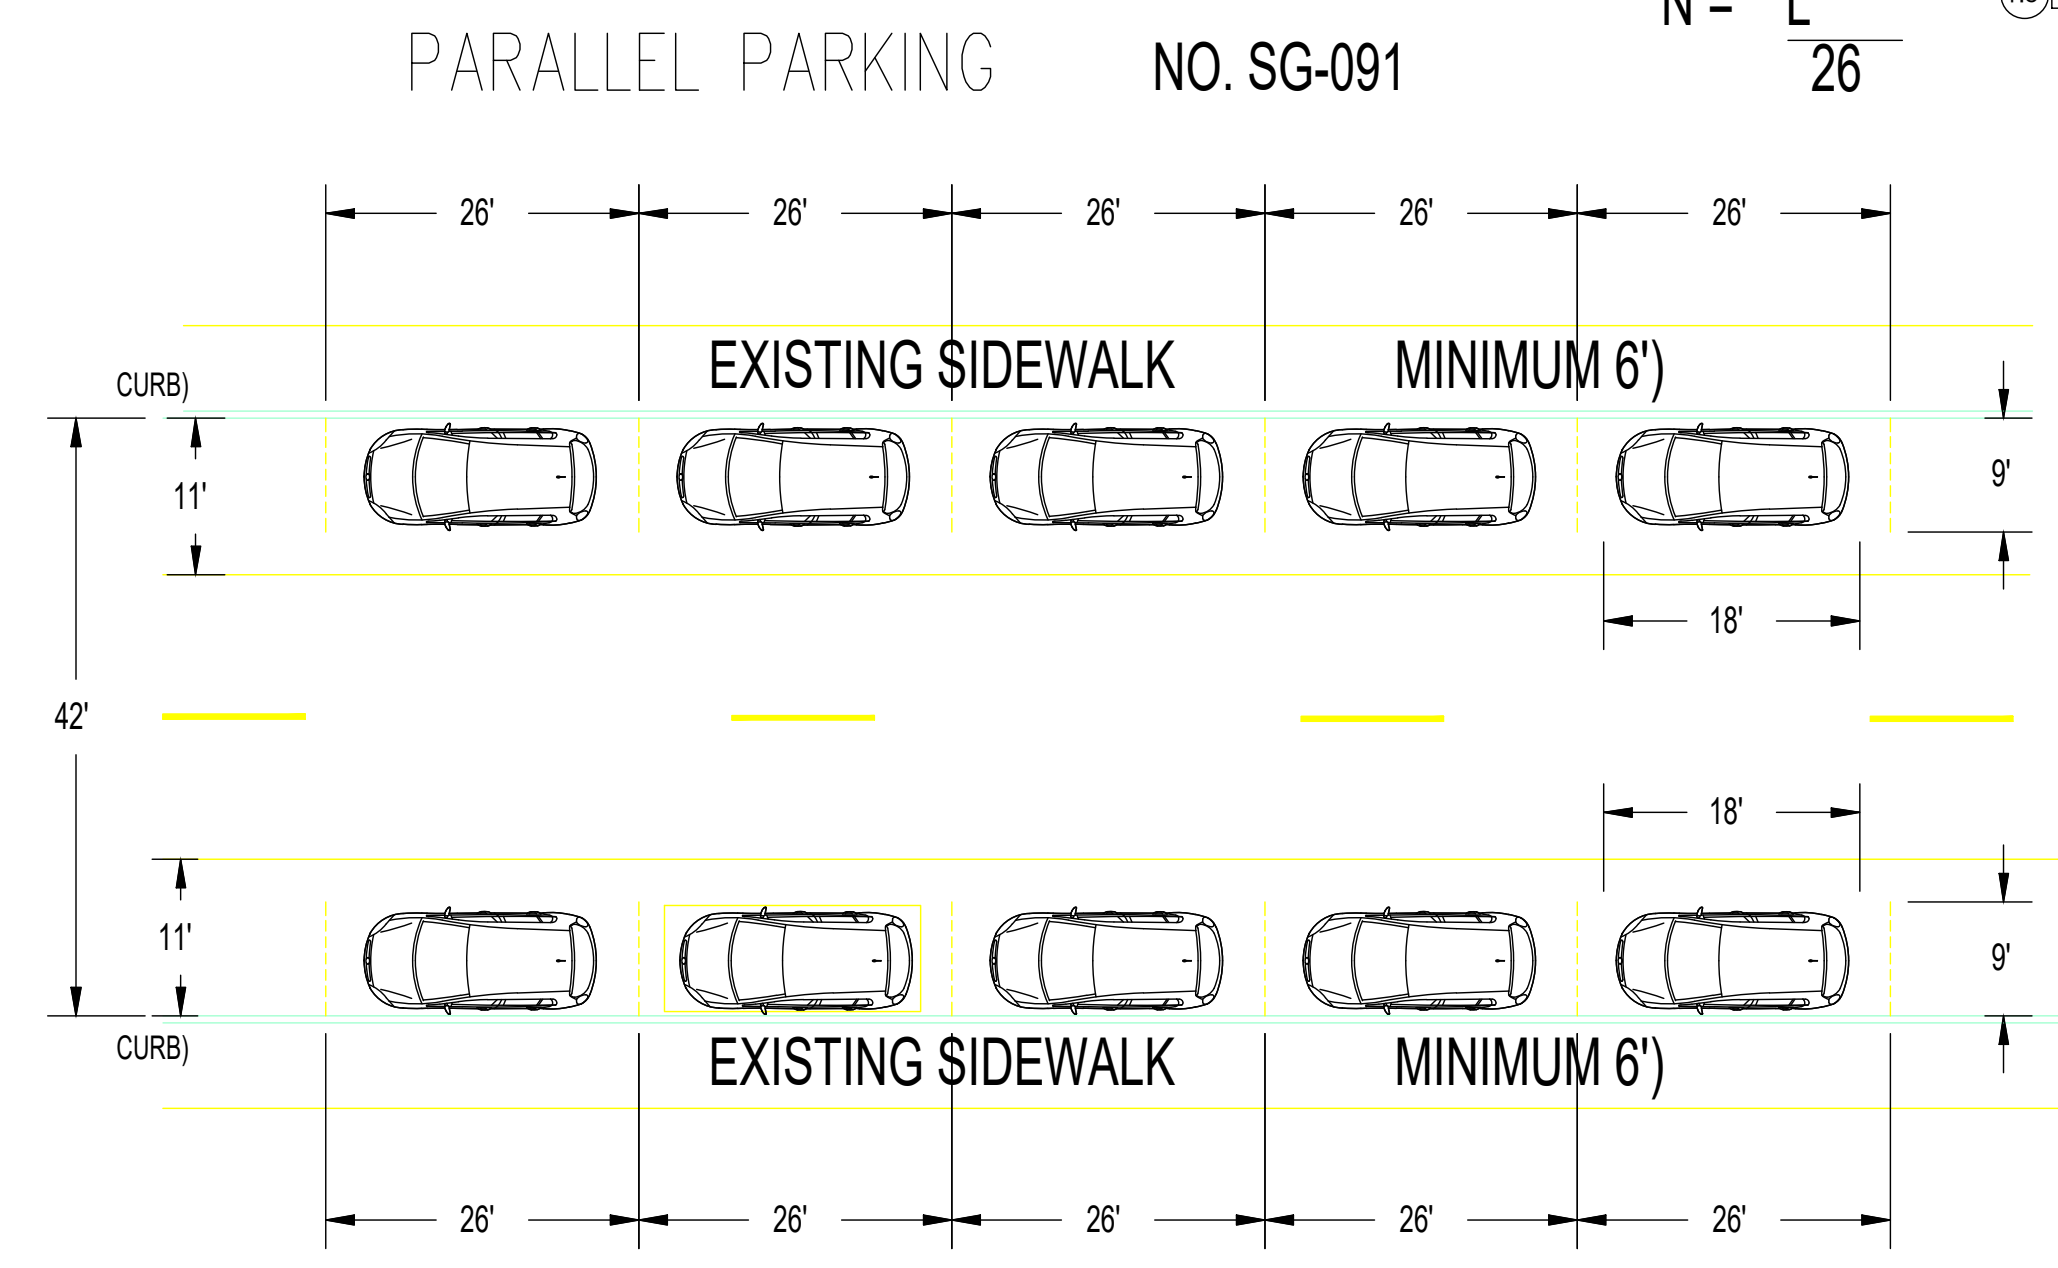


Conduits are shown diagrammatically and are not shown as actual routing. Route conduits in greenbelt between sidewalk and landscaping

Charger dimensioned distances are critical to assure charging cables can reach vehicle. Please contact DTE, Ferndale Electric, or Charge Point with any questions.

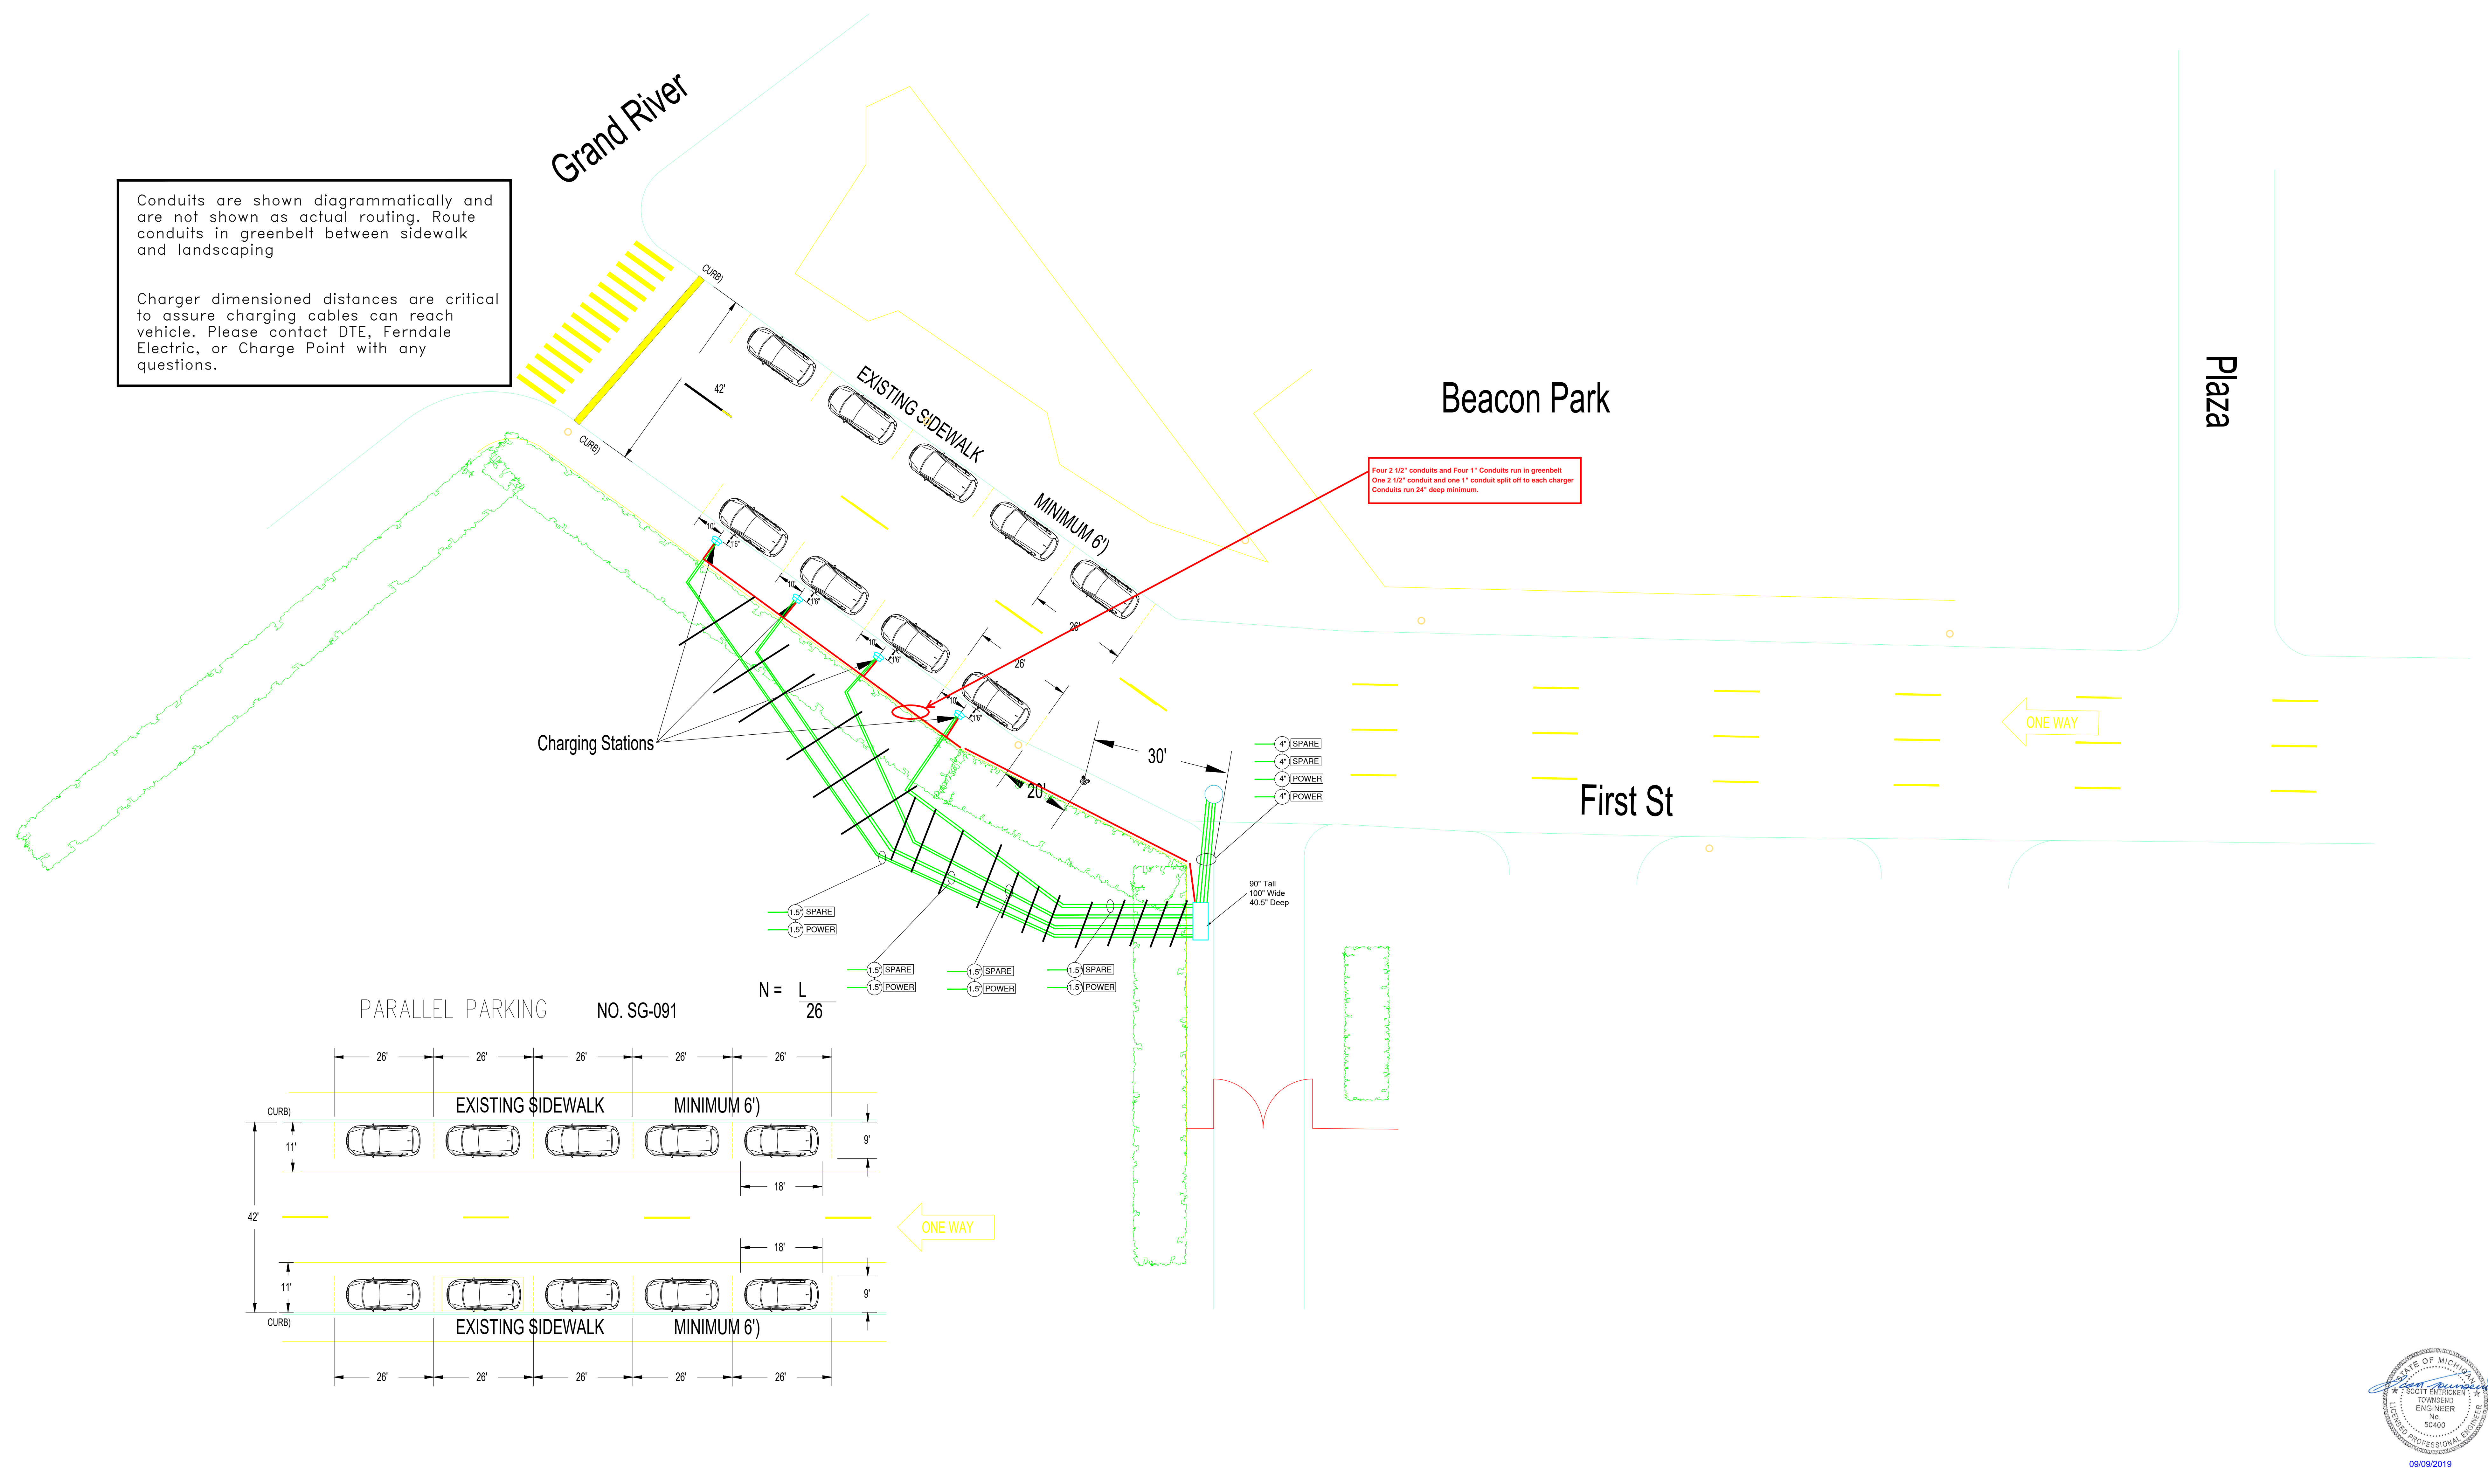

OWNER:	DTE ENERGY
CONTRACTOR:	FERNDALE ELECTRIC
ENGINEER:	STRATEGIC ENERGY SOLUTIONS
DATE:	7/1/2019

DTE ENERGY	
Electrical Site Plan	
SCALE: NOT TO SCALE	

FERNDALE ELECTRIC
 COMPANY, INC.
 SPECIALIZED ELECTRICAL SERVICES
 915 E. DRAYTON AVE. - FERNDALE, MICHIGAN - 48220
 PHONE: (248)545-4404 - FAX: (248)545-8140
<http://www.ferndale-electric.com>

SHEET NUMBER	E1
--------------	-----------

