




METRO ENGINEERING SOLUTIONS 33900 SCHOOLCRAFT RD LIVONIA, MICHIGAN 48150 PHONE: 734.483.1427 FAX: 734.483.3431

www.metroes.net

September 30, 2021

CONTRACTOR/AS-BUILT

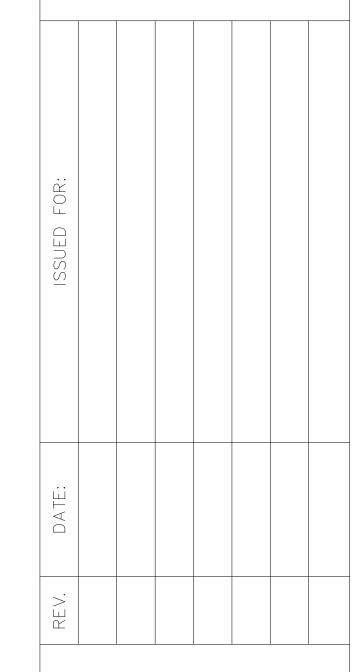

SITE NAME: WOODWARD & E.CONGRESS ST. DET-005

1035-21-1618 DRAW DATE: 09/27/21 PLOT DATE: 09/30/21

DRAWN BY: JRG

TITLE:

COVER SHEET: 01 OF 01

Call before you dig.