




METRO ENGINEERING SOLUTIONS

33900 SCHOOLCRAFT RD LIVONIA, MICHIGAN 48150 PHONE: 734.483.1427 FAX: 734.483.3431 www.metroes.net

September 30, 2021

CONTRACTOR/AS-BUILT

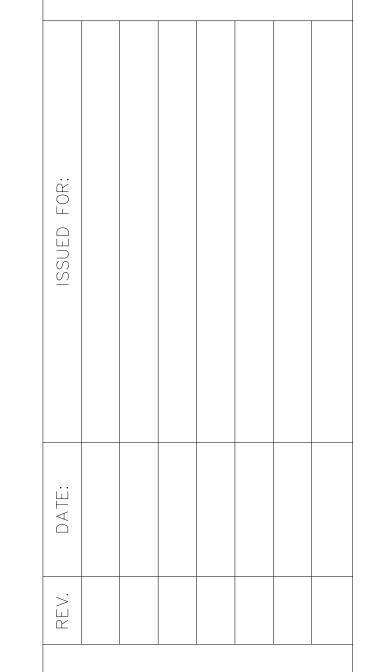

SITE NAME:

MONROE ST. & BEAUBIAN BLVD

DET-006

JOB: 1035-21-1615

DRAW DATE: 09/27/21

PLOT DATE: 09/30/21

DRAWN BY: JRG

TITLE: COVER

SHEET: 01 OF 01

CONSTRUCTION SITE SAFETY IS THE RESPONSIBILITY OF THE CONTRACTOR. NEITHER THE OWNER NOR THE ENGINEER SHALL BE EXPECTED TO ASSUME ANY RESPONSIBILITY FOR SAFETY OF THE WORK, OF PERSONS ENGAGED IN THE WORK, OF ANY NEARBY STRUCTURES, OR OF ANY OTHER PERSONS.

THE LOCATIONS OF EXISTING UNDERGROUND UTILITIES ARE SHOWN IN AN APPROXIMATE WAY ONLY AND HAVE NOT BEEN INDEPENDENTLY VERIFIED. THE CONTRACTOR SHALL DETERMINE THE EXACT LOCATION OF ALL EXISTING UTILITIES BEFORE COMMENCING WORK, AND AGREES TO BE FULLY RESPONSIBLE FOR ANY AND ALL DAMAGES WHICH MIGHT BE OCCASIONED BY THE CONTRACTOR'S FAILURE TO EXACTLY LOCATE AND PRESERVE ANY AND ALL UNDERGROUND UTILITIES.

