




METRO ENGINEERING SOLUTIONS

33900 SCHOOLCRAFT RD LIVONIA, MICHIGAN 48150 PHONE: 734.483.1427 FAX: 734.483.3431 www.metroes.net

October 1, 2021

CONTRACTOR/AS-BUILT

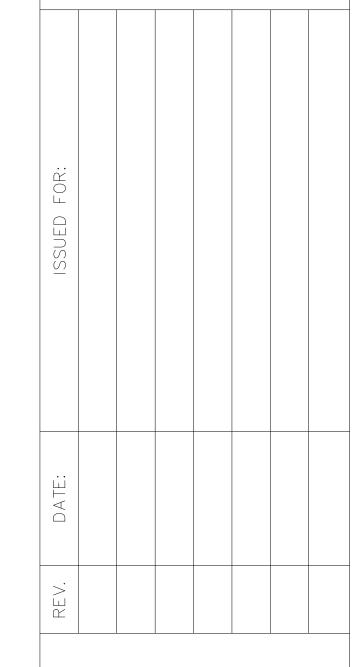

SITE NAME: CASS AVE & GRAND RIVER AVE DET-008

1035-21-1621 DRAW DATE: 09/27/21

PLOT DATE: 10/1/21

DRAWN BY: JRG

SHEET: 01 OF 01

COVER

TITLE:

Know what's **below**. Call before you dig.