




METRO ENGINEERING SOLUTIONS 33900 SCHOOLCRAFT RD LIVONIA, MICHIGAN 48150 PHONE: 734.483.1427 FAX: 734.483.3431

www.metroes.net

September 30, 2021

CONTRACTOR/AS-BUILT

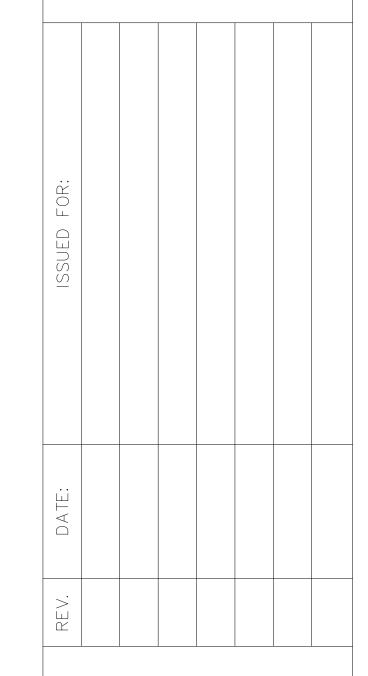

SITE NAME: BROADWAY & JOHN R.ST. DET-011

1035-21-1596 DRAW DATE: 09/27/21

PLOT DATE: 09/30/21

DRAWN BY: JRG

TITLE: COVER

Know what's **below.**

Call before you dig.

SHEET: 01 OF 01

