



Detroit Water and Sewerage Department
Central Services Facility
6425 Huber Street, Detroit, MI 48211
313-267-8000 • detroitmi.gov/DWSD

Letter of Transmittal

Date:
Petition Map:

Type of Petition

- | | | |
|---|---------------------------------------|--|
| <input type="checkbox"/> Outright Vacation | <input type="checkbox"/> Dedication | <input type="checkbox"/> Berm Use |
| <input type="checkbox"/> Conversion to Easement | <input type="checkbox"/> Encroachment | <input type="checkbox"/> Temporary Closing |

Review Status

The above petition has been received and reviewed by this office. Please see below for the review status as marked.

- | | |
|--|--|
| <input type="checkbox"/> Approved Subject to Attached Provisions | <input type="checkbox"/> Revise and Resubmit |
| <input type="checkbox"/> Not Approved | |

Additional Comments (if applicable):

--

Attached is the DWSD provision related to the petition.

	Name	Title	Signature	Date
Reviewed by:			<i>Mohammad Siddique</i>	
Approved by:			<i>Mohammad Siddique</i>	For Syed Ali

PROVISIONS FOR ENCROACHMENT

1. By approval of this petition the Detroit Water and Sewerage Department (DWSD) does not waive any of its rights to its facilities located in the right of way, and at all time, DWSD, its agents or employees, shall have the right to enter upon the right of way to maintain, repair, alter, service, inspect, or install its facilities. All costs incident to the damaging, dismantling, demolishing, removal and replacement of structures or other improvements herein permitted and incurred in gaining access to DWSD's facilities for maintenance, repairing, alteration, servicing, or inspection by DWSD shall be borne by the petitioner. All costs associated with gaining access to DWSD's facilities, which could normally be expected had the petitioner not encroached into the right of way shall be borne by DWSD.
2. All construction performed under this petition shall not be commenced until after five (5) days written notice to DWSD. Seventy-two (72) hour notice shall also be provided in accordance with P.A. 53 1974, as amended, utilizing the MISS DIG one call system.
3. Construction under this petition is subject to inspection and approval by DWSD. The cost of such inspection shall, at the discretion of DWSD, be borne by the petitioner.
4. DWSD prohibits the use of heavy construction equipment or the storage of building material directly over or near DWSD facilities. DWSD also prohibits the use of cranes and balls or hydraulic rams for pavement removal where DWSD facilities are involved. If the water main or sewer facilities are broken or damaged as a result of any action on the part of the contractor, the contractor shall be liable for all costs incidental to the repair of such broken or damaged water main or sewer facilities. If DWSD facilities located within the street shall break or be damaged as the result of any action on the part of the petitioner, then in such event the petitioner agrees to be liable for all costs incident to the repair, replacement or relocation of such broken or damaged DWSD facilities.
5. The petitioner shall hold DWSD harmless for any damage to the encroaching device constructed or installed under this petition, which may be caused by the failure of DWSD's facilities.
6. If at any time in the future the petitioner shall request removal and / or relocation of DWSD's facilities in the street being encroached upon, the petitioner agrees to pay all costs for such removal and/or relocation.
7. Prior to construction, Easement Encroachment Permit (EEP) should be obtained and the insurance required by the EEP should not expire until after completion of the construction.
8. For any proposed work that involves DWSD water mains and/or sewers, an approval and a permit is required from DWSD before commencement of work.
9. It is DWSD's requirement that any proposed utility crossing DWSD water mains and/or sewers perpendicularly must maintain a minimum of 18 inches vertical clearance. Any proposed utility running adjacent to DWSD water mains and/or sewers must maintain a minimum of 10 feet lateral clearance including any conduit and/or manholes walls. No utility is allowed to run along the top of the water main or/or sewer.
10. It is DWSD's requirement that no encroachment has a vertical clearance of less than 16 feet from the ground surface over DWSD water mains and/or sewers.

March 12, 2024

City of Detroit
Maps and Records Bureau
2 Woodward Avenue, Room 216
Detroit, MI 48226

RE: REQUEST FOR RIGHTS-OF-WAY ENCROACHMENT

- **N/S 20-FT ALLEY LOCATED BETWEEN 2607-2627 14TH STREET AND 2616-2668 15TH STREET
DETROIT, WAYNE COUNTY, MICHIGAN**

To whom it may concern:

On behalf of MHT Housing, Inc, applicant for the above reference encroachments, we seek permission to make improvements to the following alley:

- 20-ft wide alley located between 2607-2627 14th Street and 2616-2668 15th Street; for the purposes of ingress/egress, and storm sewer crossings and connections. A site plan created specifically for this purpose is included in this request.

The requested improvements are related to construction of a new 4-story, mixed-use development consisting of 49 residential units and 1st floor commercial space in one building fronting 14th Street, with rear access to the referenced alley. Alley improvements are requested to provide safe ingress/egress from 75 Service Road, connecting to the existing 20-ft alley that divides the two properties. Parking facilities are proposed west of the alley with drive connections to the alley, and sidewalk crossings connecting the building and parking area. Related encroachment requests include storm sewer facilities to capture roof drainage from the new building, and route runoff from the building to stormwater storage and pre-treatment facilities prior to discharging to the city combined sewer.

Currently, portions of the alley are improved but in disrepair.

Specific improvements include new 8-inch concrete pavement section and new stormwater catch basins, per city's standards. Given the use of the alley for overhead utilities, including the utility poles, we propose to pave around existing utility poles. No curb and gutter or parking within the alley is proposed.

A 15-inch storm sewer alley crossing is proposed to direct stormwater runoff from 14th Street westerly across the north/south alley to new stormwater facilities at the 15th Street properties. The storm sewer crosses the alley perpendicularly at a depth of approximately 4.7 feet below proposed pavement grades. A second 15" storm sewer alley crossing is proposed to discharge stormwater to the combined sewer system in the alley connecting to a new storm structure constructed over the combined sewer. The storm sewer crosses the alley perpendicularly at a depth of approximately 10.6 feet

We respectfully request permission to provide the encroachments as described herein, and as illustrated in the attached site plan.

Sincerely,




Paul Stoddard, AIA
Director of Design and Construction
MHT Housing, Inc.
32500 Telegraph Road, Suite 100
Detroit, Michigan 48025
Tel.: 248-833-0552
Email: pstoddard@mhthousing.net

N^o. 40

LATERAL SEWER IN ALBANY


Betw. Canfield Pine 15th and 14th Avenue

1875 ✓

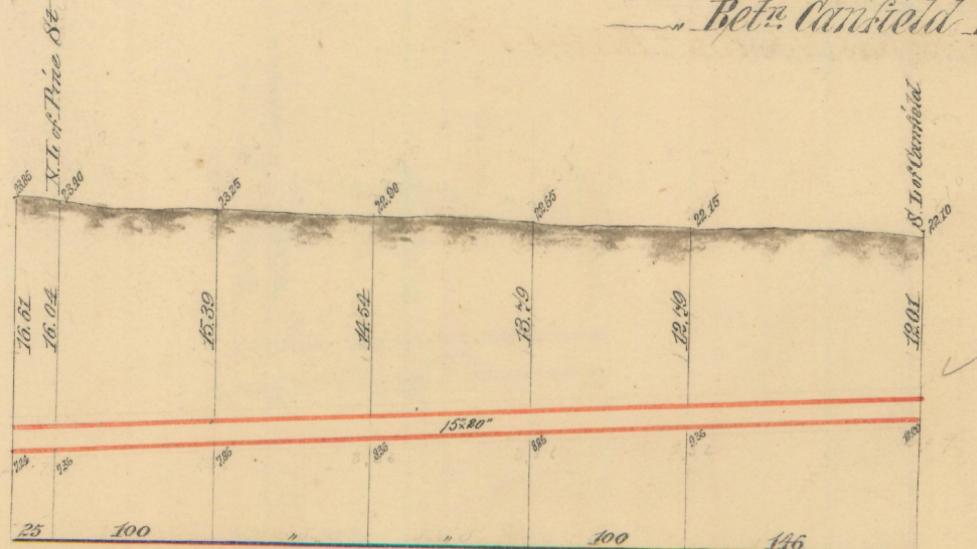

Merrill M. Battyan Contractor
N^o. of Assmt Roll 2354
Price per Foot \$1¹¹/₁₀₀

Actual Length of Sewer 54 feet
Size " " 15×20"
Grade " " 0.5 per 100 feet

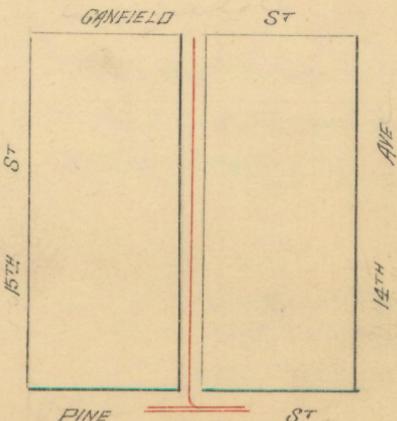

6531





MAP-24-145

PERRY ST. 50 FT. WD.



15TH ST. 60 FT. WD.

14TH AVE. 80 FT. WD.

15" HDPE STM, 68 LFT
10.6' BELOW GRADE15" HDPE STM, 37 LFT
4.7" BELOW GRADE

46

48

20'

112.22'

75.15'

68.05'


76

74

72

FISHER FREEWAY I-75

PERRY ST. 50 FT. WD.

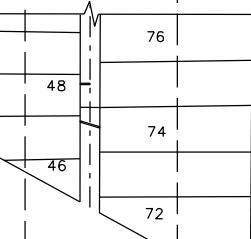

FISHER FREEWAY I-75

- REQUEST ENCROACHMENT
(FOR BELOW GRADE STORM SEWER CROSSING)

- HEAVY DUTY CONCRETE PAVEMENT AREA

(FOR OFFICE USE ONLY)

CARTO 19 F

B				
A				
DESCRIPTION	DRWN	CHKD	APPD	DATE
REVISIONS				
DRAWN BY	LC	CHECKED	AP	
DATE		APPROVED		RW
09-25-2024				

REQUEST ENCROACHMENT
INTO THE ALLEY BOUNDED BY
14TH ST., PERRY ST., 15TH ST.,
AND FISHER FWY. I-75 SERVICE DR.

CITY OF DETROIT
CITY ENGINEERING DIVISION
SURVEY BUREAU


JOB NO. 24-145

DRWG. NO.

PERRY ST. 50 FT. WD.

15TH ST. 60 FT. WD.


14TH AVE. 80 FT. WD.

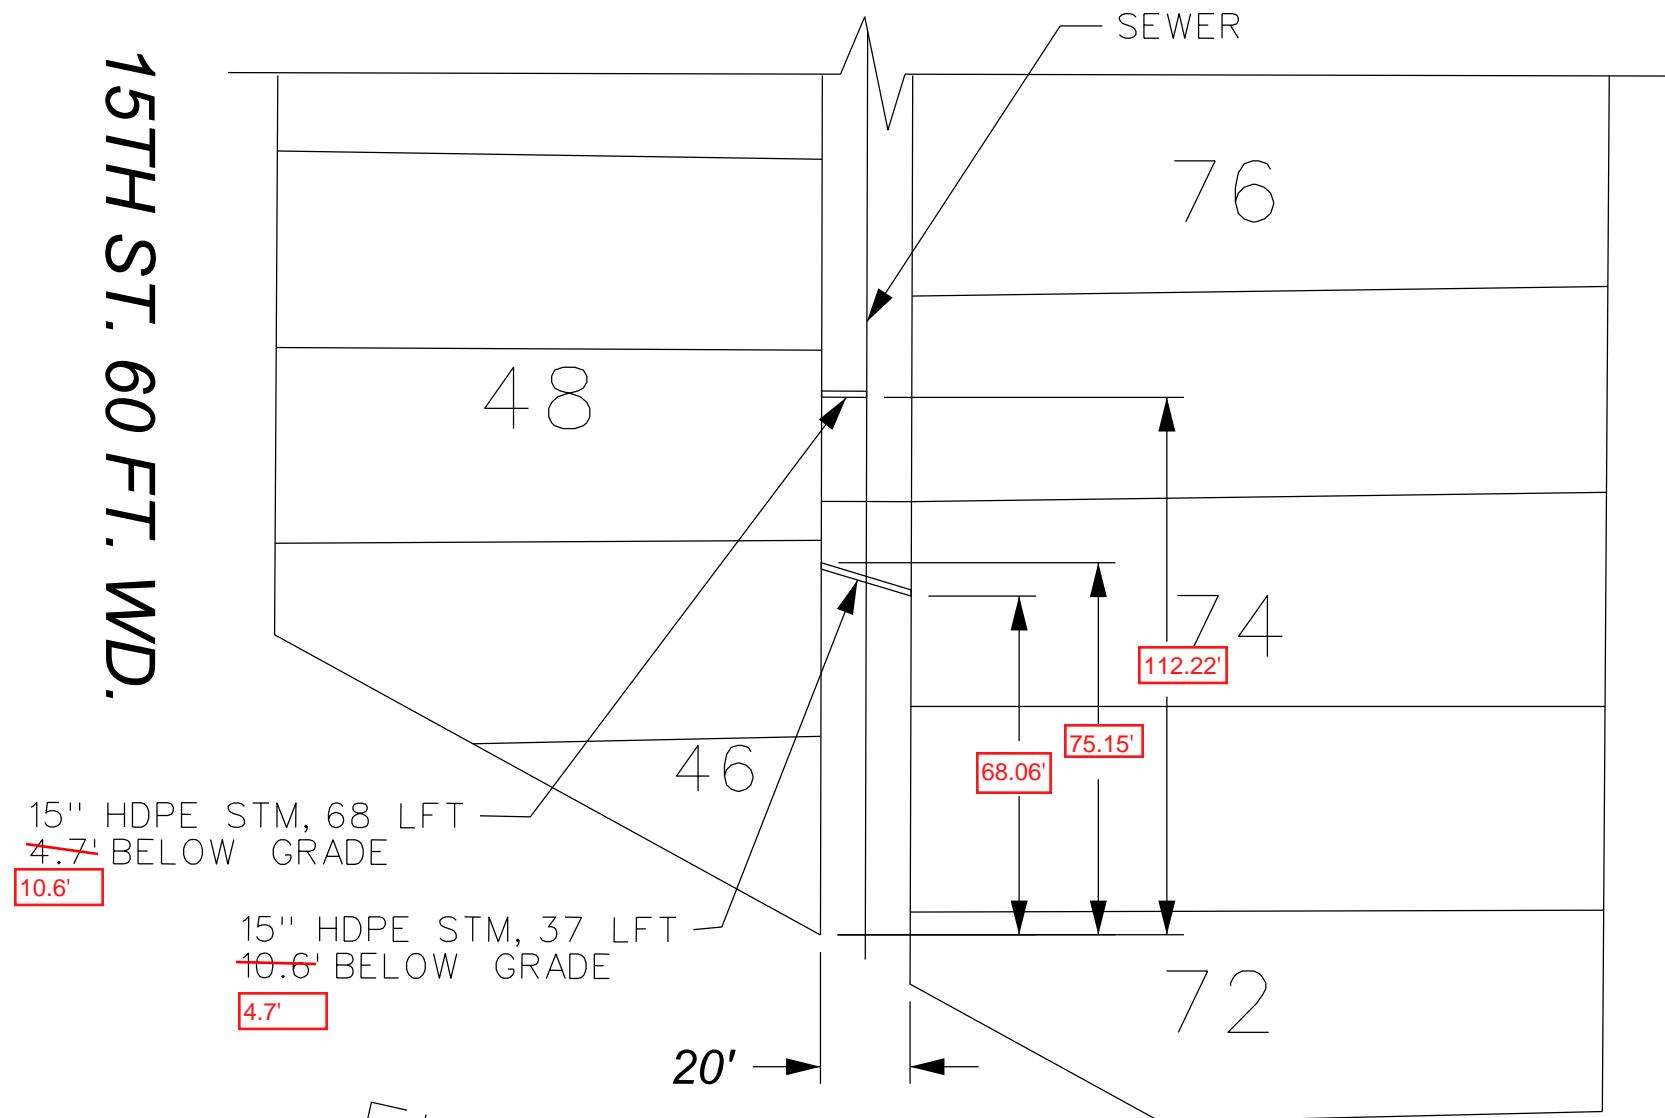

PERRY ST. 50 FT. WD.

15TH ST. 60 FT. WD.

14TH AVE. 80 FT. WD.

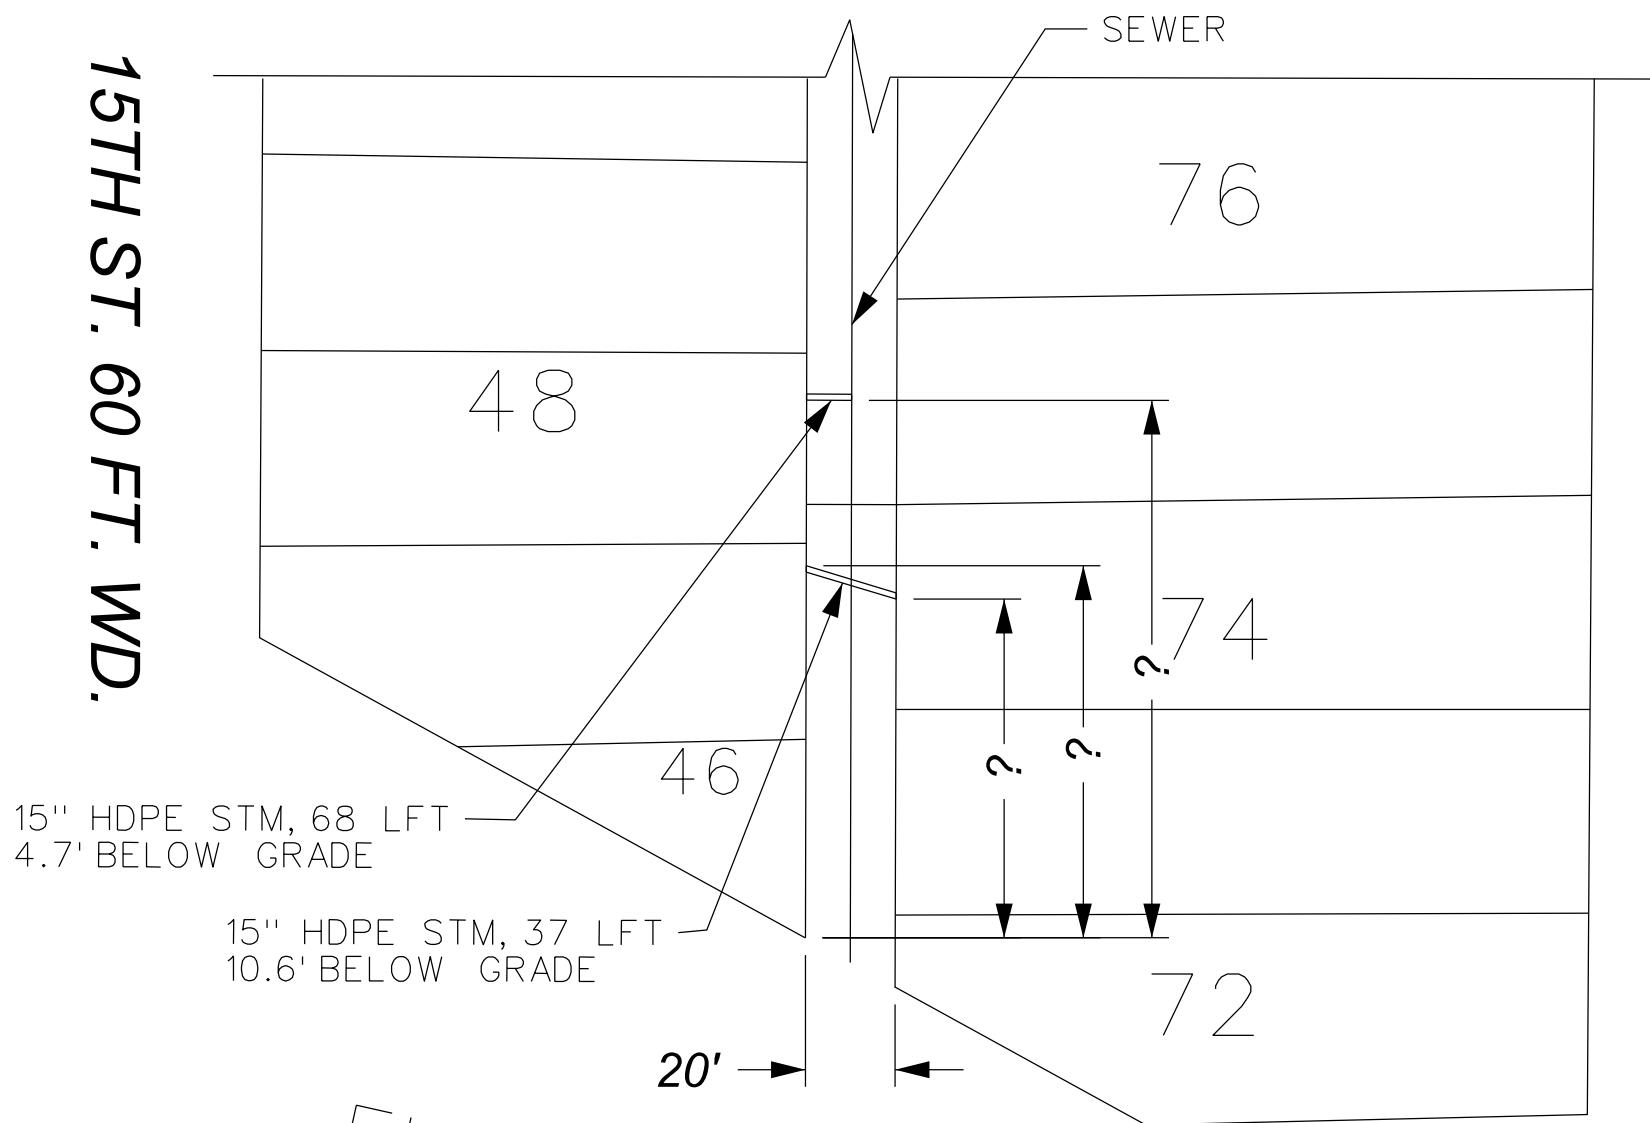



FISHER FREEWAY I-75

A 15-inch storm sewer alley crossing is proposed to direct stormwater runoff from 14th Street westerly across the north/south alley to new stormwater facilities at the 15th Street properties. The storm sewer crosses the alley perpendicularly at a depth of approximately 4.7 feet below proposed pavement grades. A second 15" storm sewer alley crossing is proposed to discharge stormwater to the combined sewer system in the alley connecting to a new storm structure constructed over the combined sewer. The storm sewer crosses the alley perpendicularly at a depth of approximately 10.6 feet

We respectfully request permission to provide the encroachments as described herein, and as illustrated in the attached site plan.

Sincerely,

A handwritten signature in blue ink, appearing to read "John Doe".

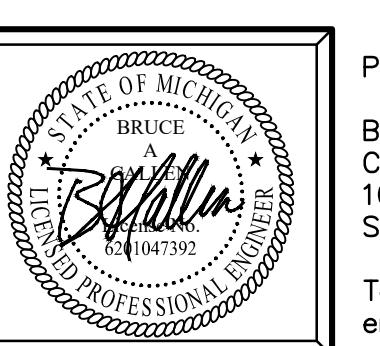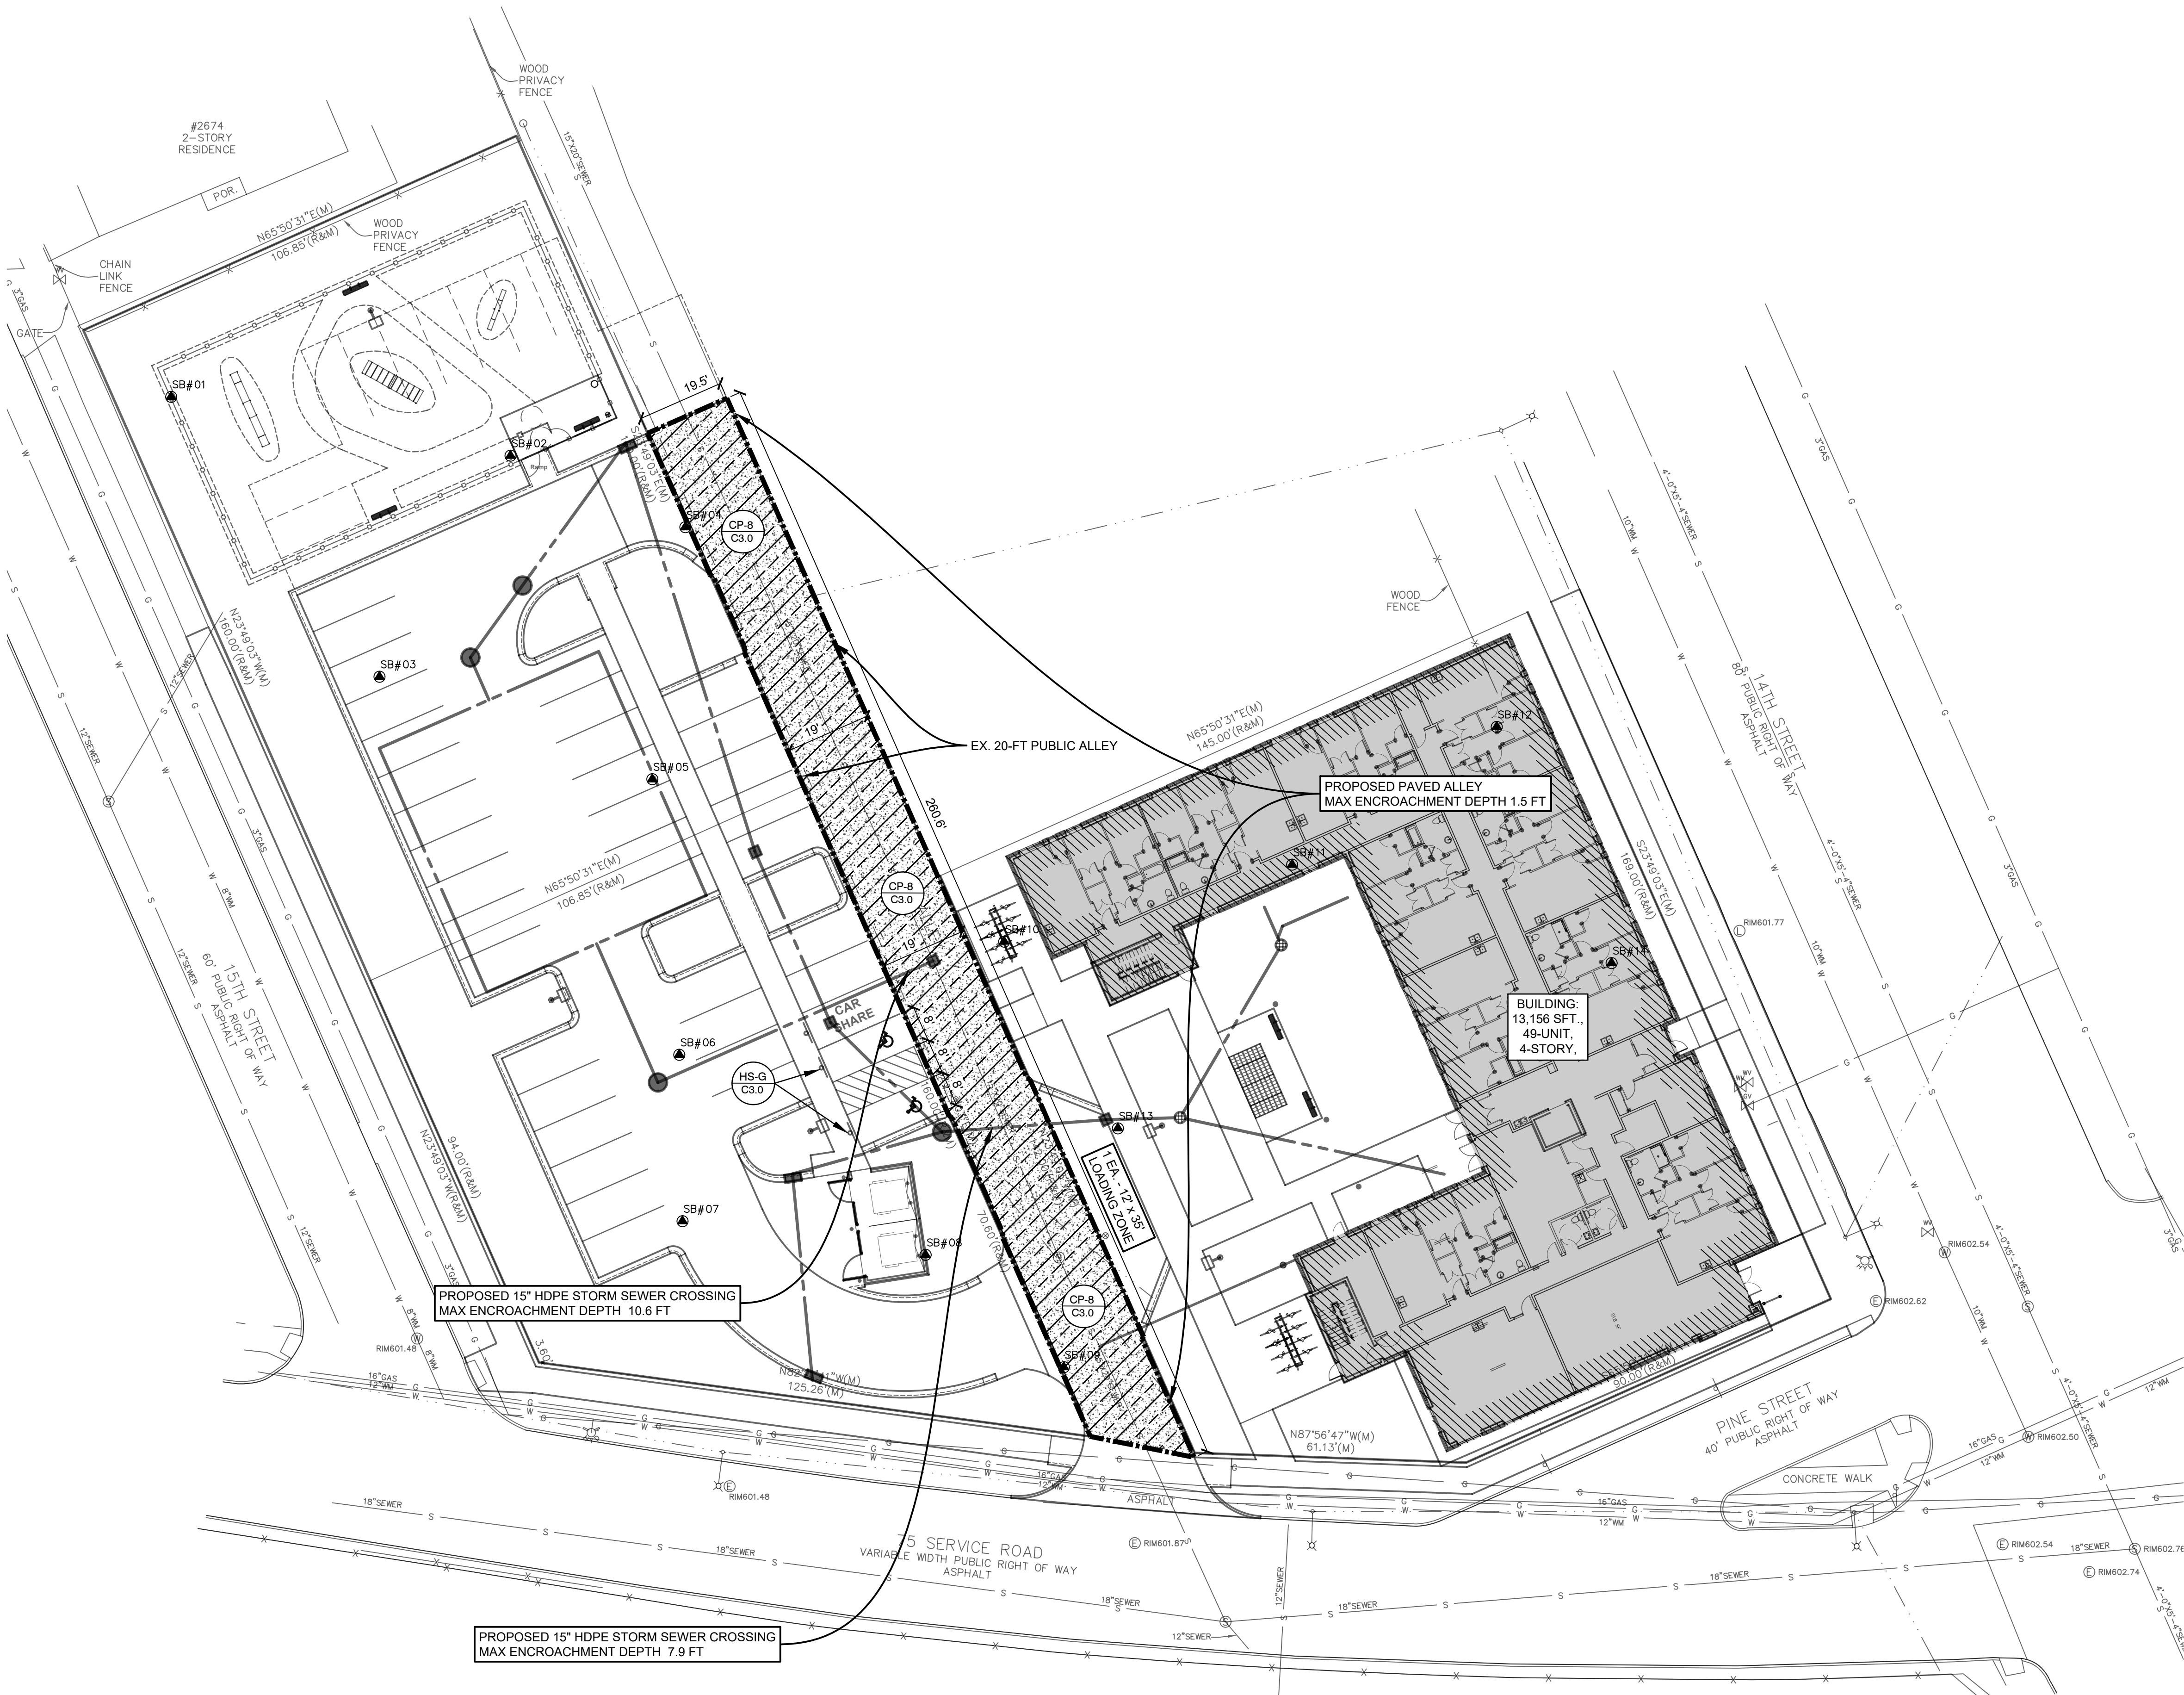

Plan Prepared By:

Bruce A. Callen, PE
Callen Engineering, Inc.
108 E. Savidge St.
Spring Lake, Michigan 49456

Tel: 616-414-5260
email: bcallen@callenengineering.com



For protection of underground utilities, the CONTRACTOR shall dial 1-800-482-7171 OR 811 a minimum of three working days, excluding Saturdays, Sundays and holidays, prior to excavation in the vicinity of utility lines. All "MISS DIG" participating members will thus be routinely notified. This does not relieve the CONTRACTOR of the responsibility of notifying the utility owners who may not be part of the "MISS DIG" alert system.

DATE OF PLAN: 07-17-24

DRAWN BY J.W.C.	DATE FEB '24
FOR PERMITS ADDITION 1	B.A.C. 07-17-24
	B.A.C. 07-17-24
	EDIT
SCALE DRAWING ▲ PLOT SCALE	
AS NOTED	1:1

PROJECT 023 NORTH CORKTOWN
SHEET NO. C1.1

MHT HOUSING, INC.
32500 TELEGRAPH ROAD, SUITE 100
BINGHAM FARMS, MI 48025
248-833-0552


Callen Engineering, Inc.
108 East Savidge Street
Spring Lake, MI 49456
T.616-414-5260
www.callenengineering.com



For protection of underground utilities, the CONTRACTOR shall dial 1-800-482-7171 OR 811 a minimum of three working days, excluding Saturdays, Sundays and holidays, prior to excavation in the vicinity of utility lines. All "MISS DIG" participating members will thus be routinely notified. This does not relieve the CONTRACTOR of the responsibility of notifying the utility owners who may not be part of the "MISS DIG" alert system.



Know what's below.
Call before you dig.





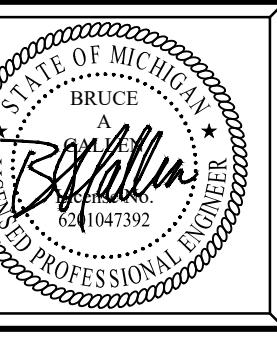


Plan Prepared By:
Bruce A. Callen, PE
Callen Engineering, Inc.
108 E. Savidge St.
Spring Lake, Michigan 49456
Tel: 616-414-5260
email: bcallen@callenengineering.com

Callen Engineering, Inc.
108 East Savidge Street
Spring Lake, MI 49456
T.616-414-5260
www.callenengineering.com



MHT HOUSING, INC.
32500 TELEGRAPH ROAD, SUITE 100
BINGHAM FARMS, MI 48025
248-833-0552

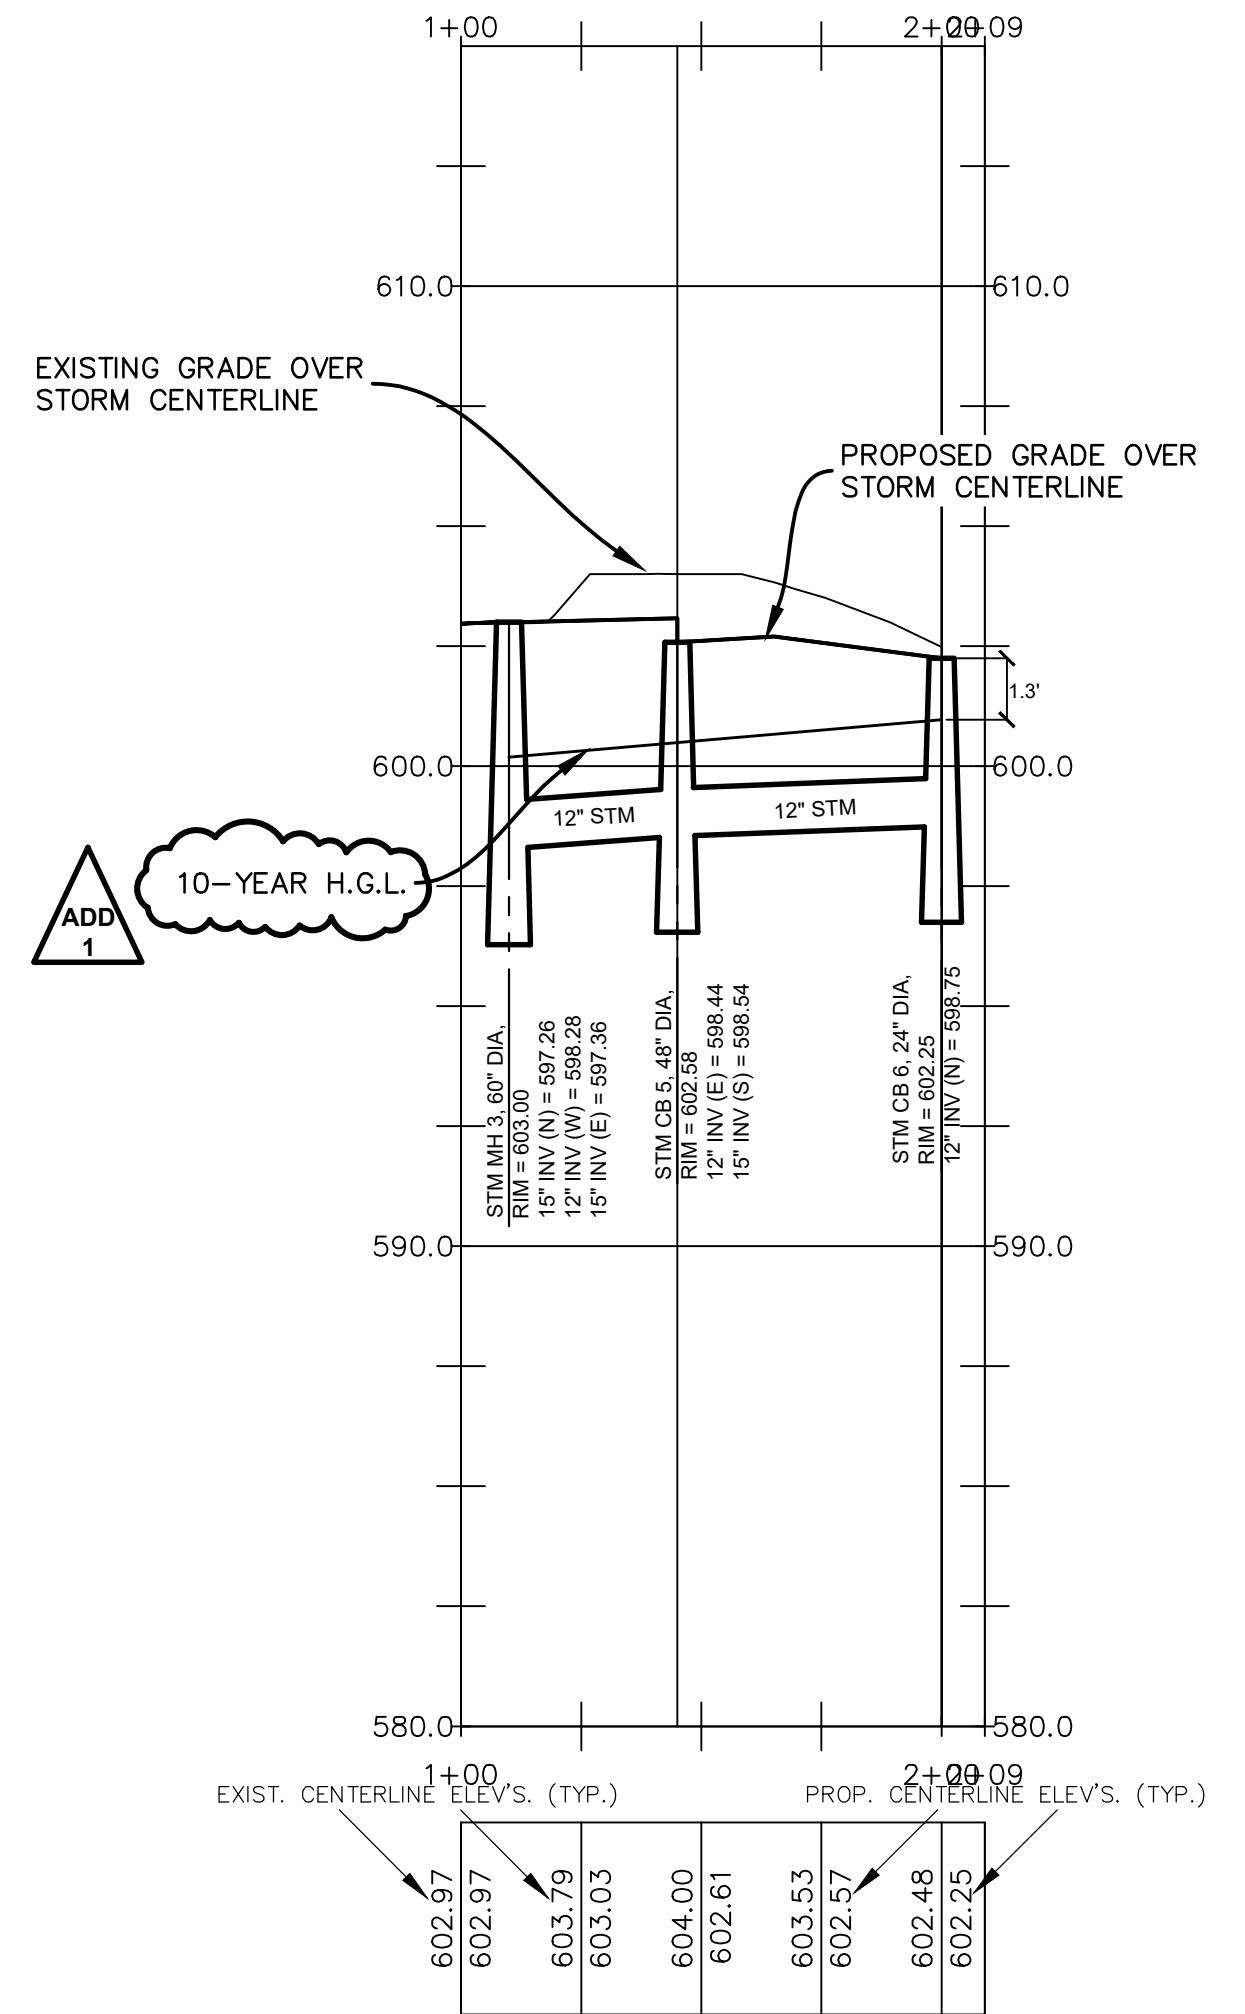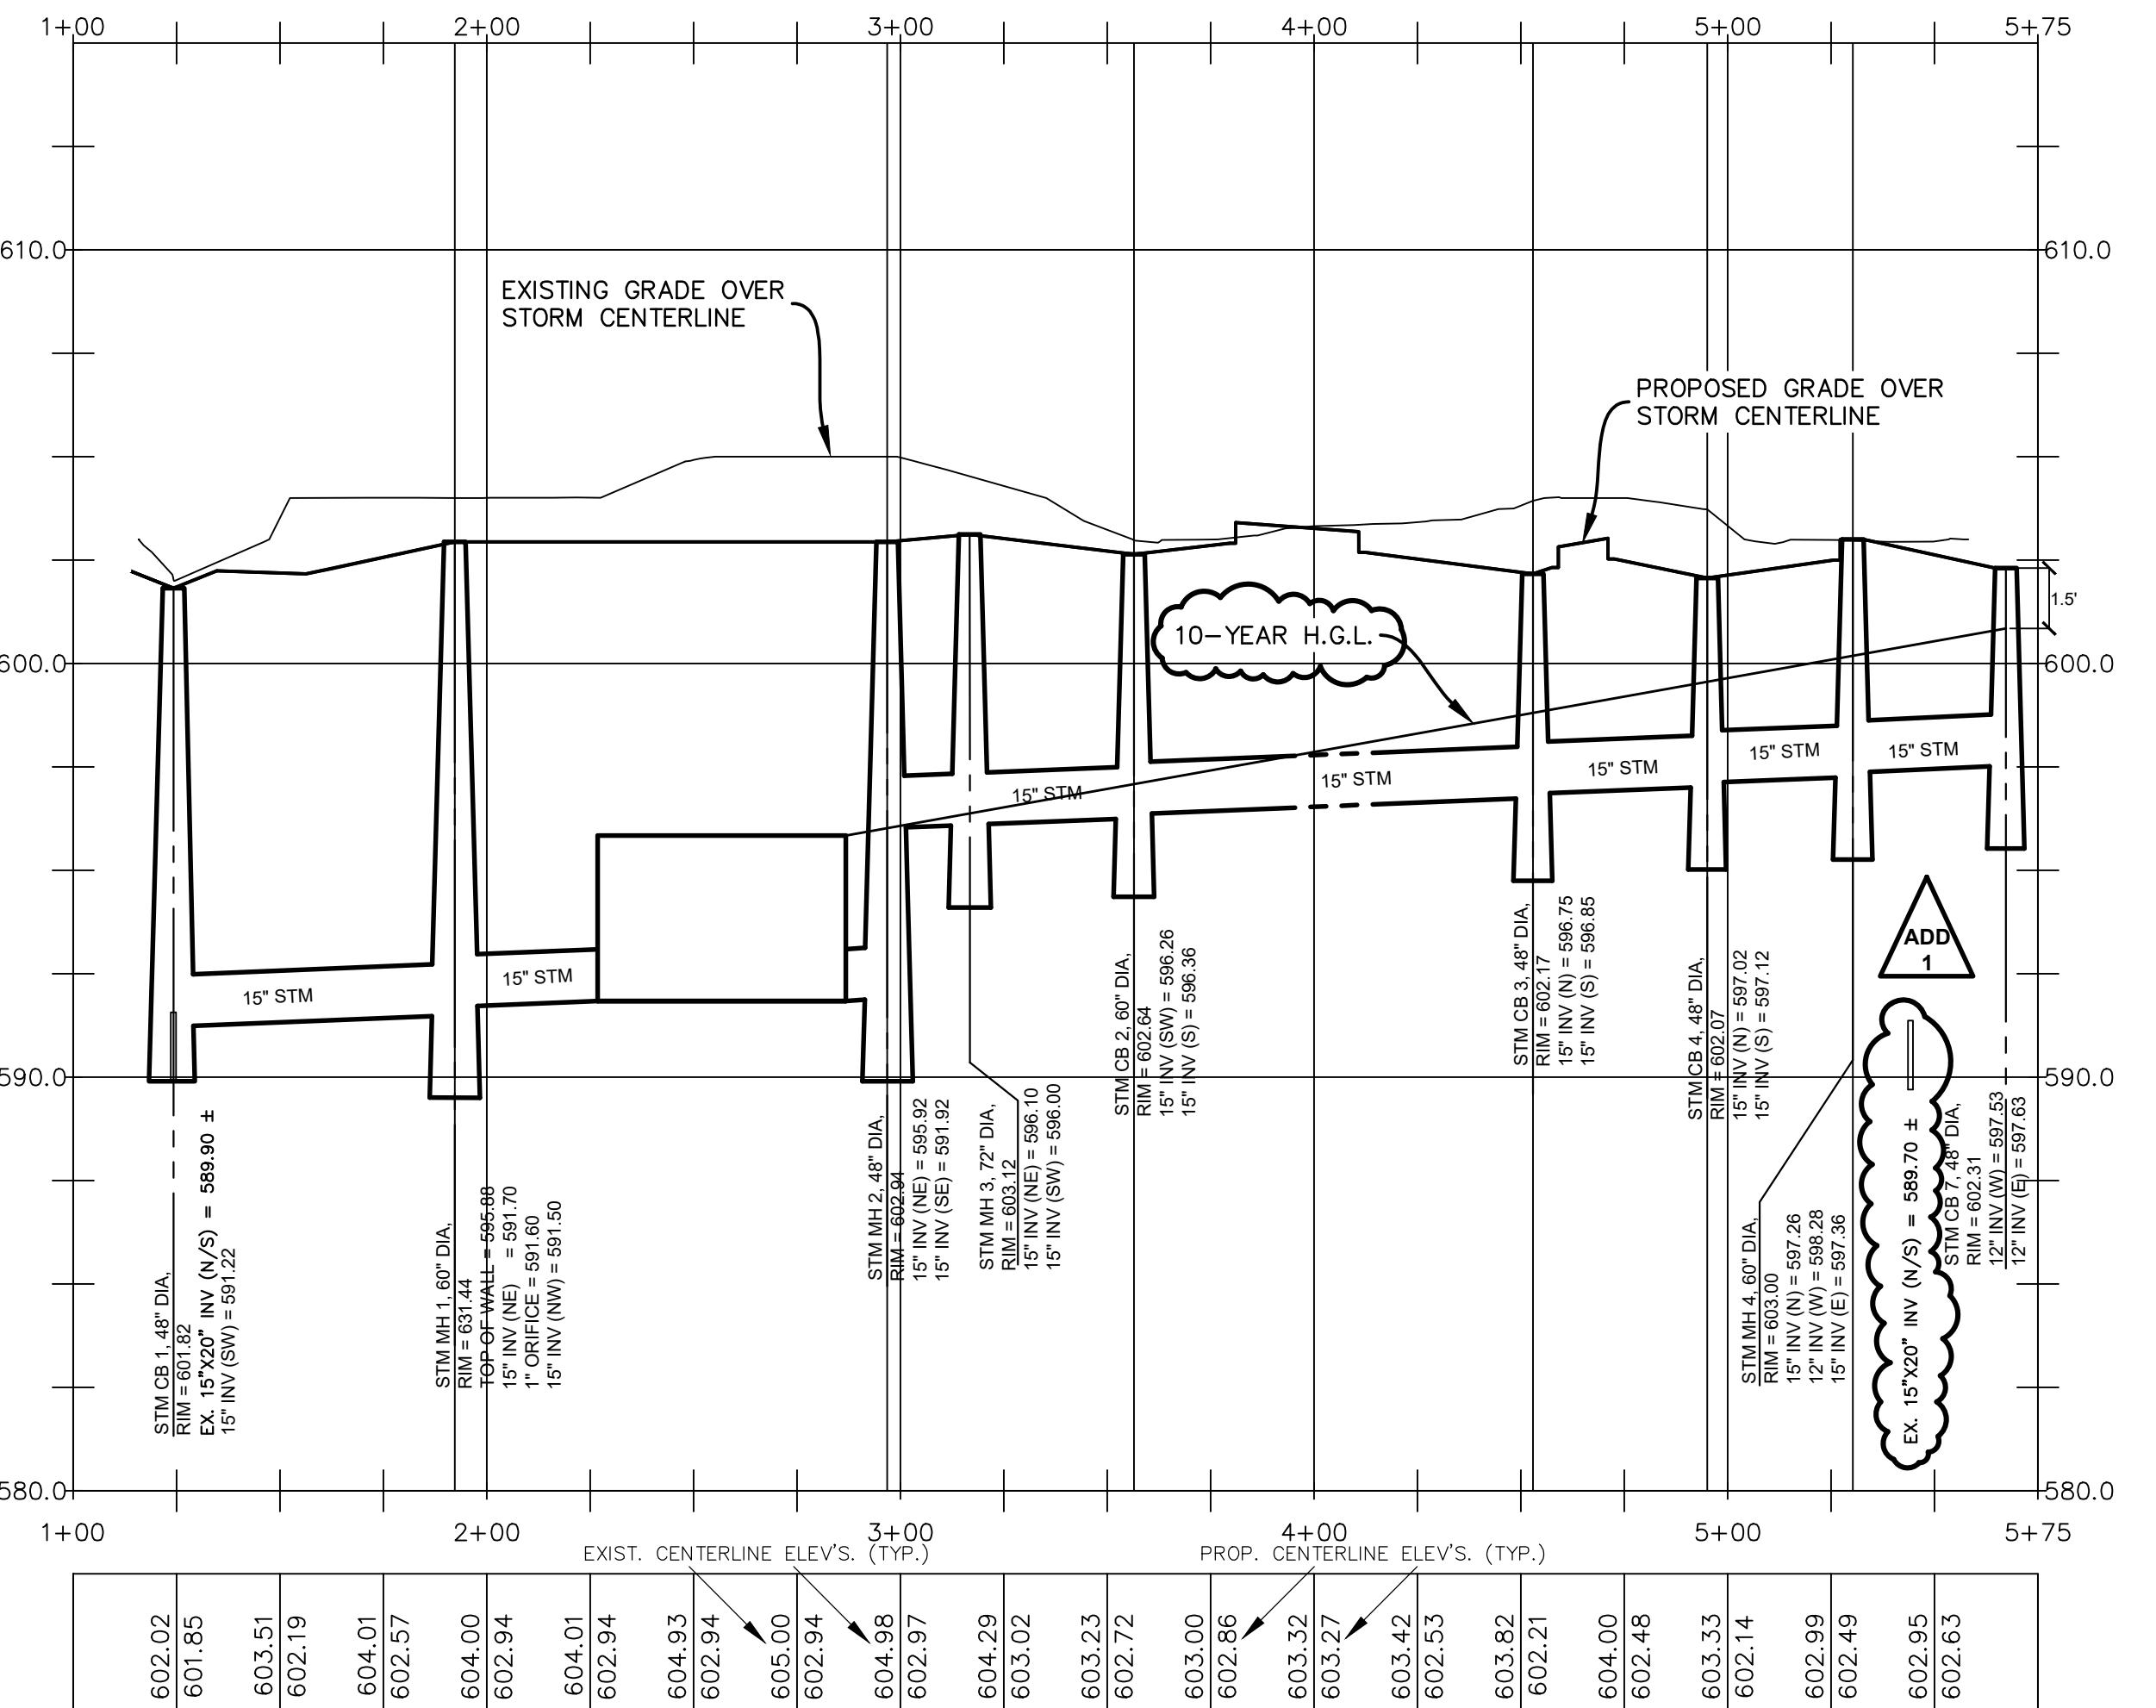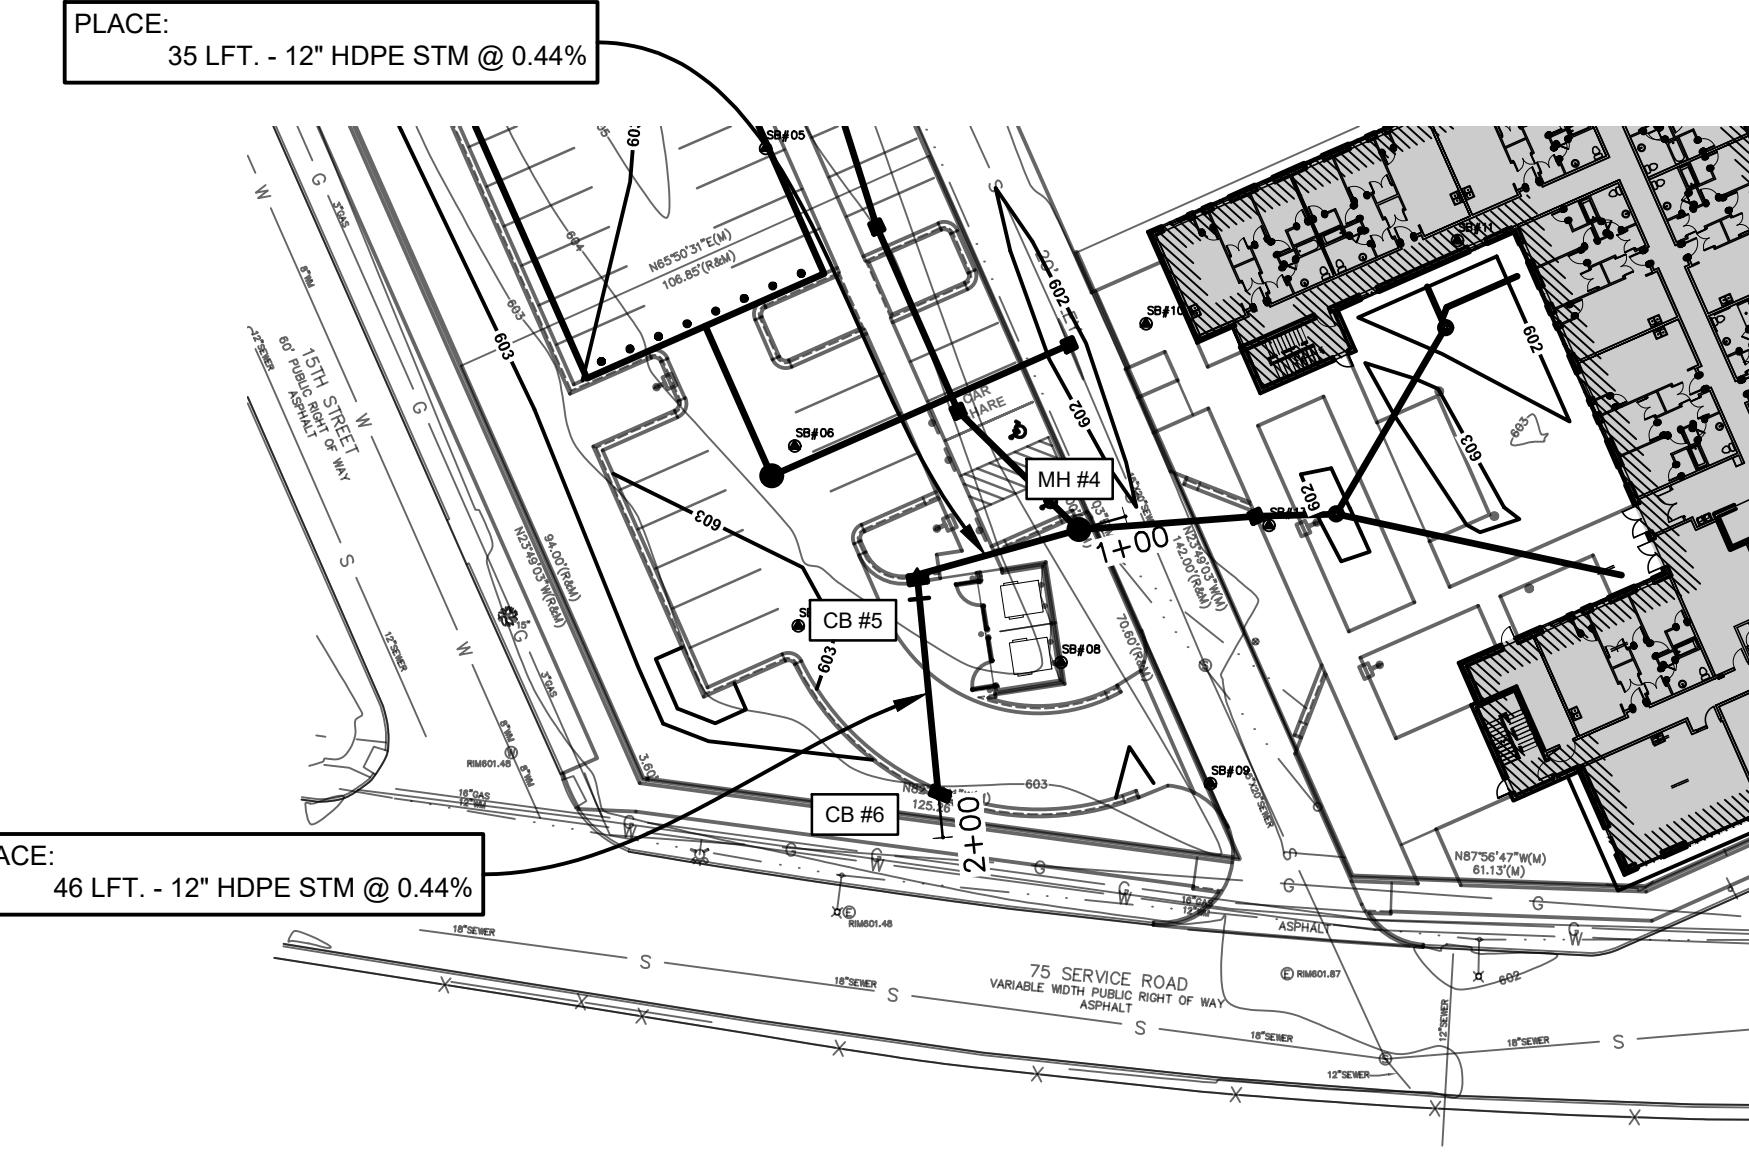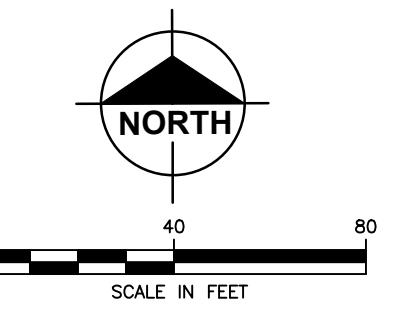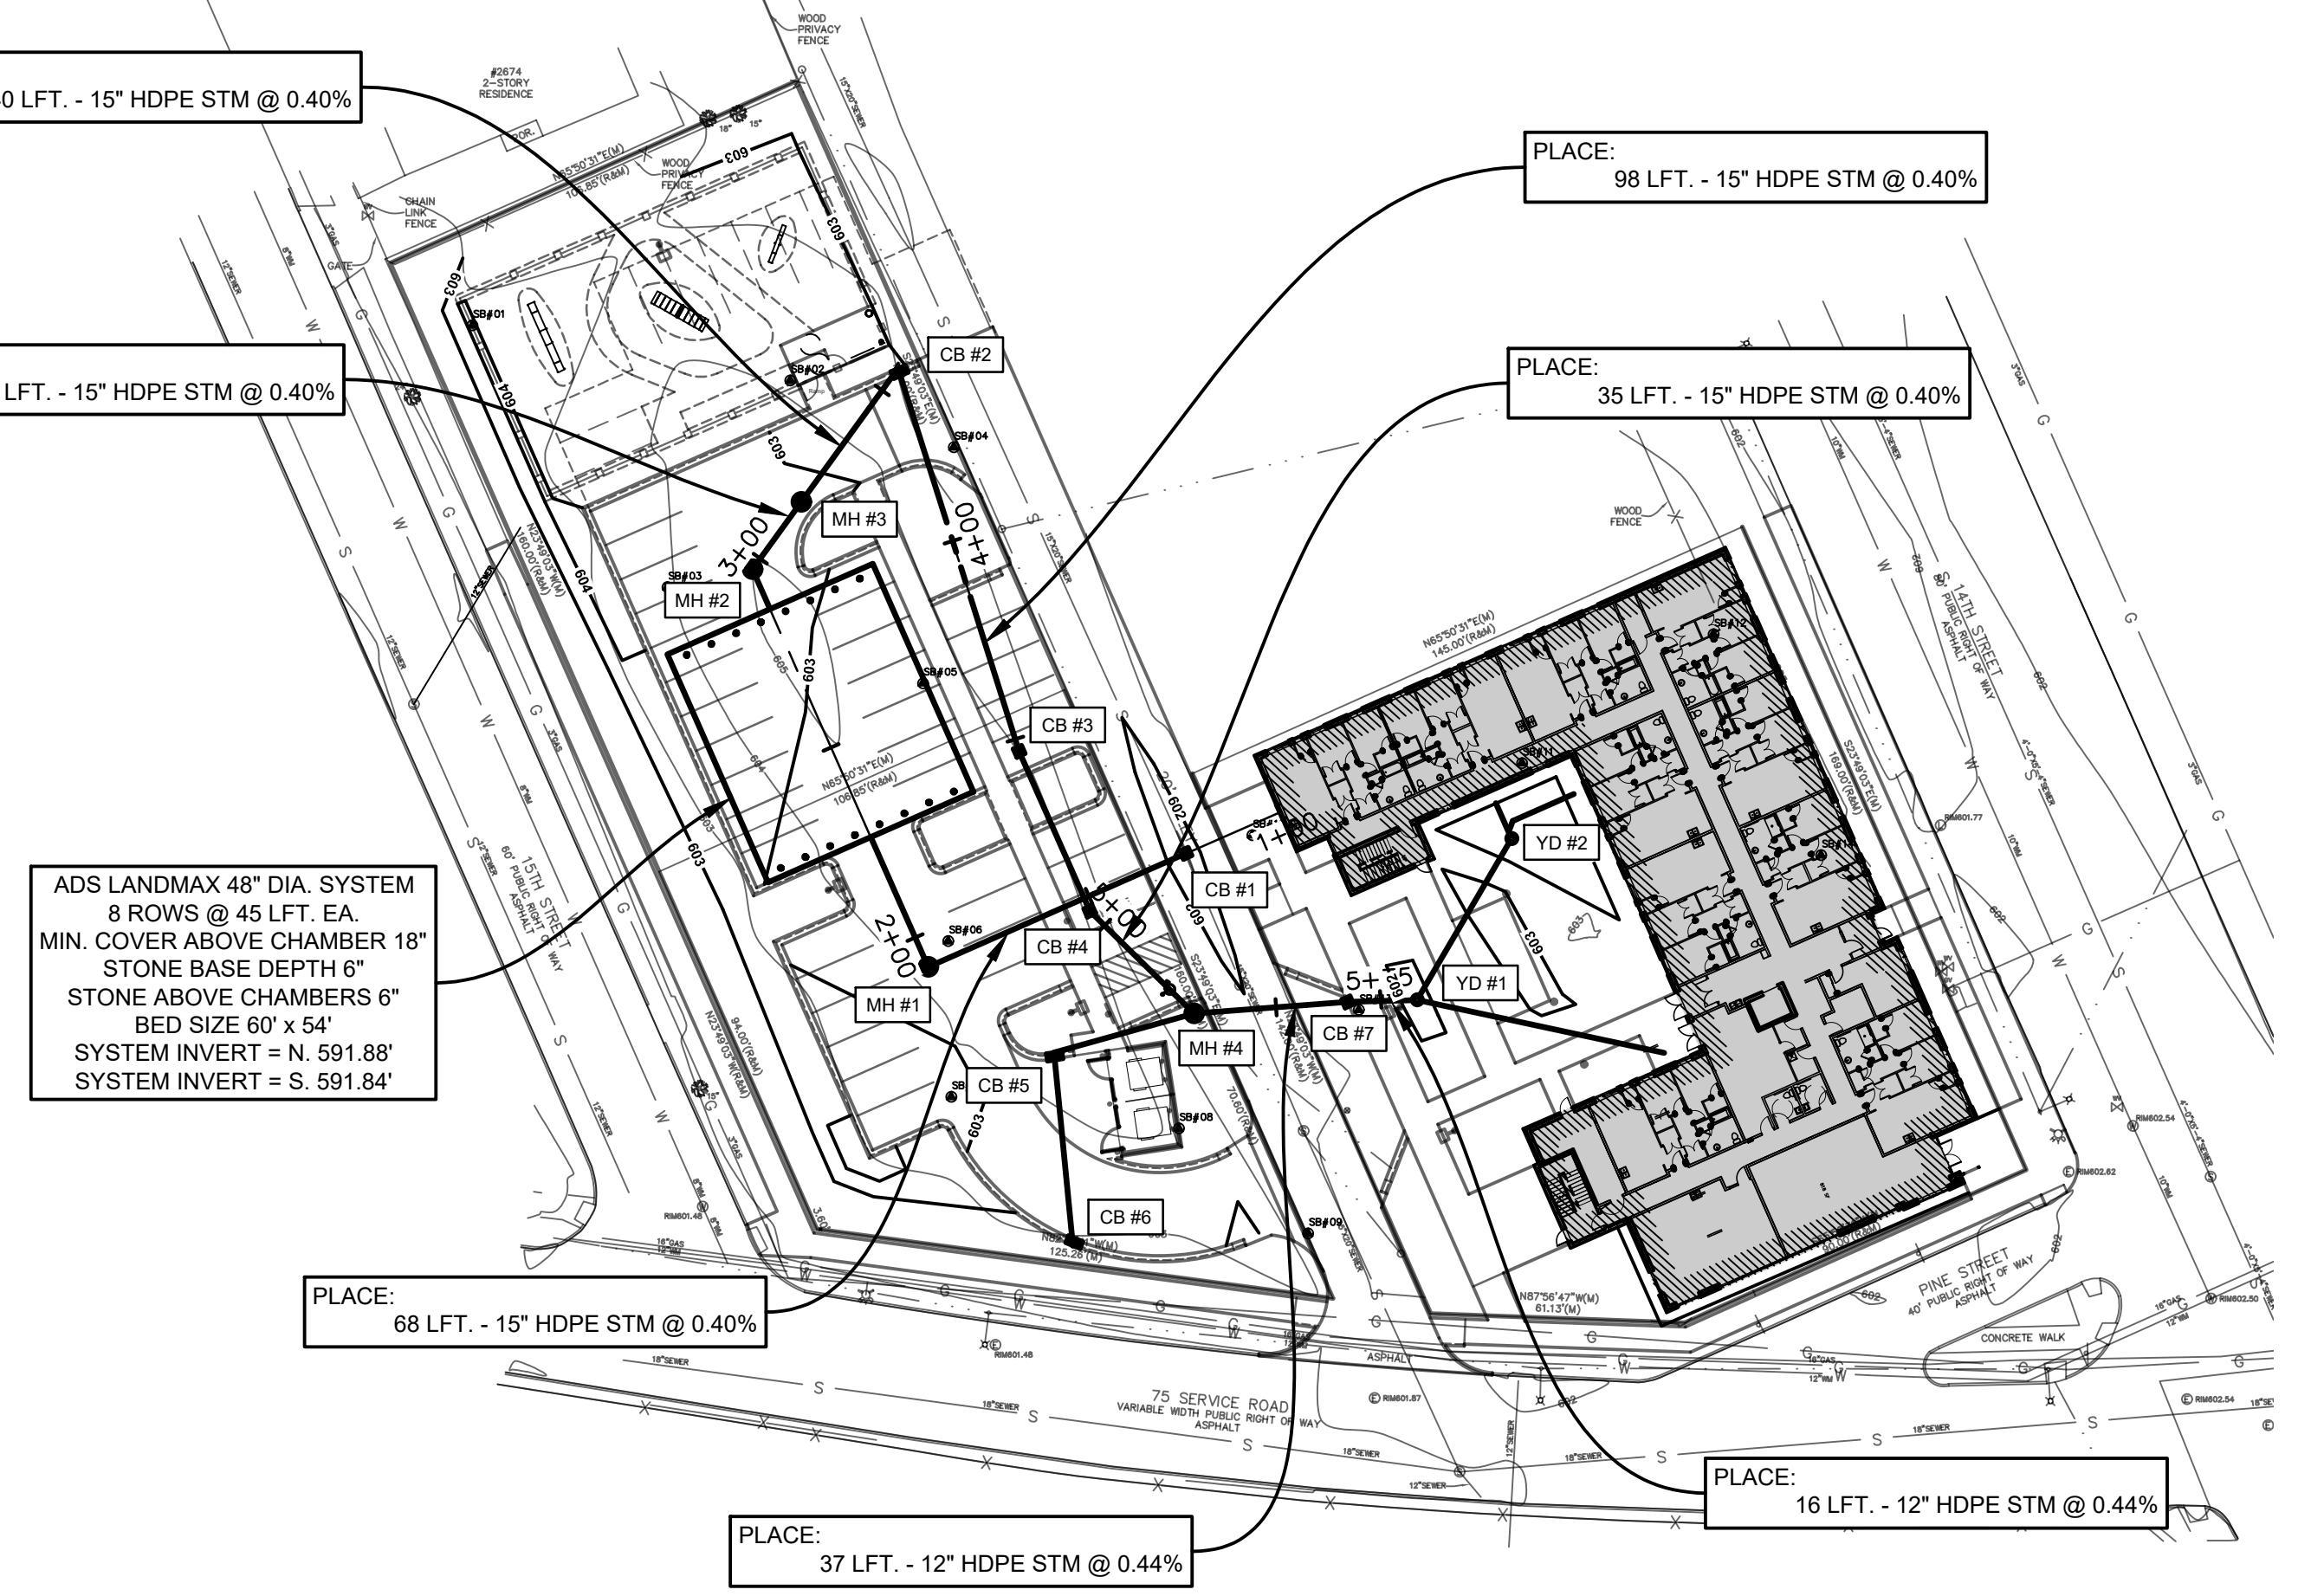

SUBSURFACE CONDITIONS

Contractor(s) shall familiarize themselves with the information and findings presented in the Geotechnical Evaluation Report prepared by SME dated March 18, 2024. SME Project No. 094183.00

Contractor(s) shall also familiarize themselves with the information and findings presented in the Phase II Environmental Site Assessment prepared by Hamp, Mathews & Associates, Inc., dated Jan. 16, 2024.


DRAWN BY J.W.C. DATE FEB '24
ENGINEER B.A.C. DATE FEB '24
EDIT DATE
SCALE PLOT SCALE
AS NOTED 1:1

PROJECT Q23 NORTH CORKTOWN SHEET NO. C3.1
DATE OF PLAN: 07-17-24

For protection of underground utilities, the CONTRACTOR shall dial 1-800-482-7171 OR 811 a minimum of three working days, excluding Saturdays, Sundays and holidays, prior to excavation in the vicinity of utility lines. All "MISS DIG" participating members will thus be routinely notified. This does not relieve the CONTRACTOR of the responsibility of notifying the utility owners who may not be part of the "MISS DIG" alert system.



Know what's below.
Call before you dig.



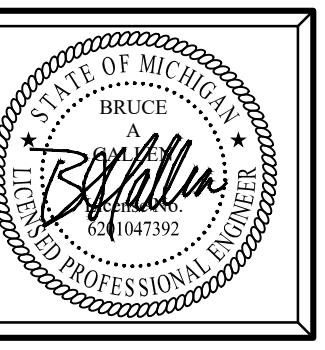


Plan Prepared By:
Bruce A. Callen, PE
Callen Engineering, Inc.
108 E. Savidge St.
Spring Lake, Michigan 49456
Tel: 616-414-5260
email: bcallen@callenengineering.com

Callen Engineering, Inc.
108 East Savidge Street
Spring Lake, MI 49456
T.616-414-5260
www.callenengineering.com



MHT HOUSING, INC.
32500 TELEGRAPH ROAD, SUITE 100
BINGHAM FARMS, MI 48025
248-833-0552

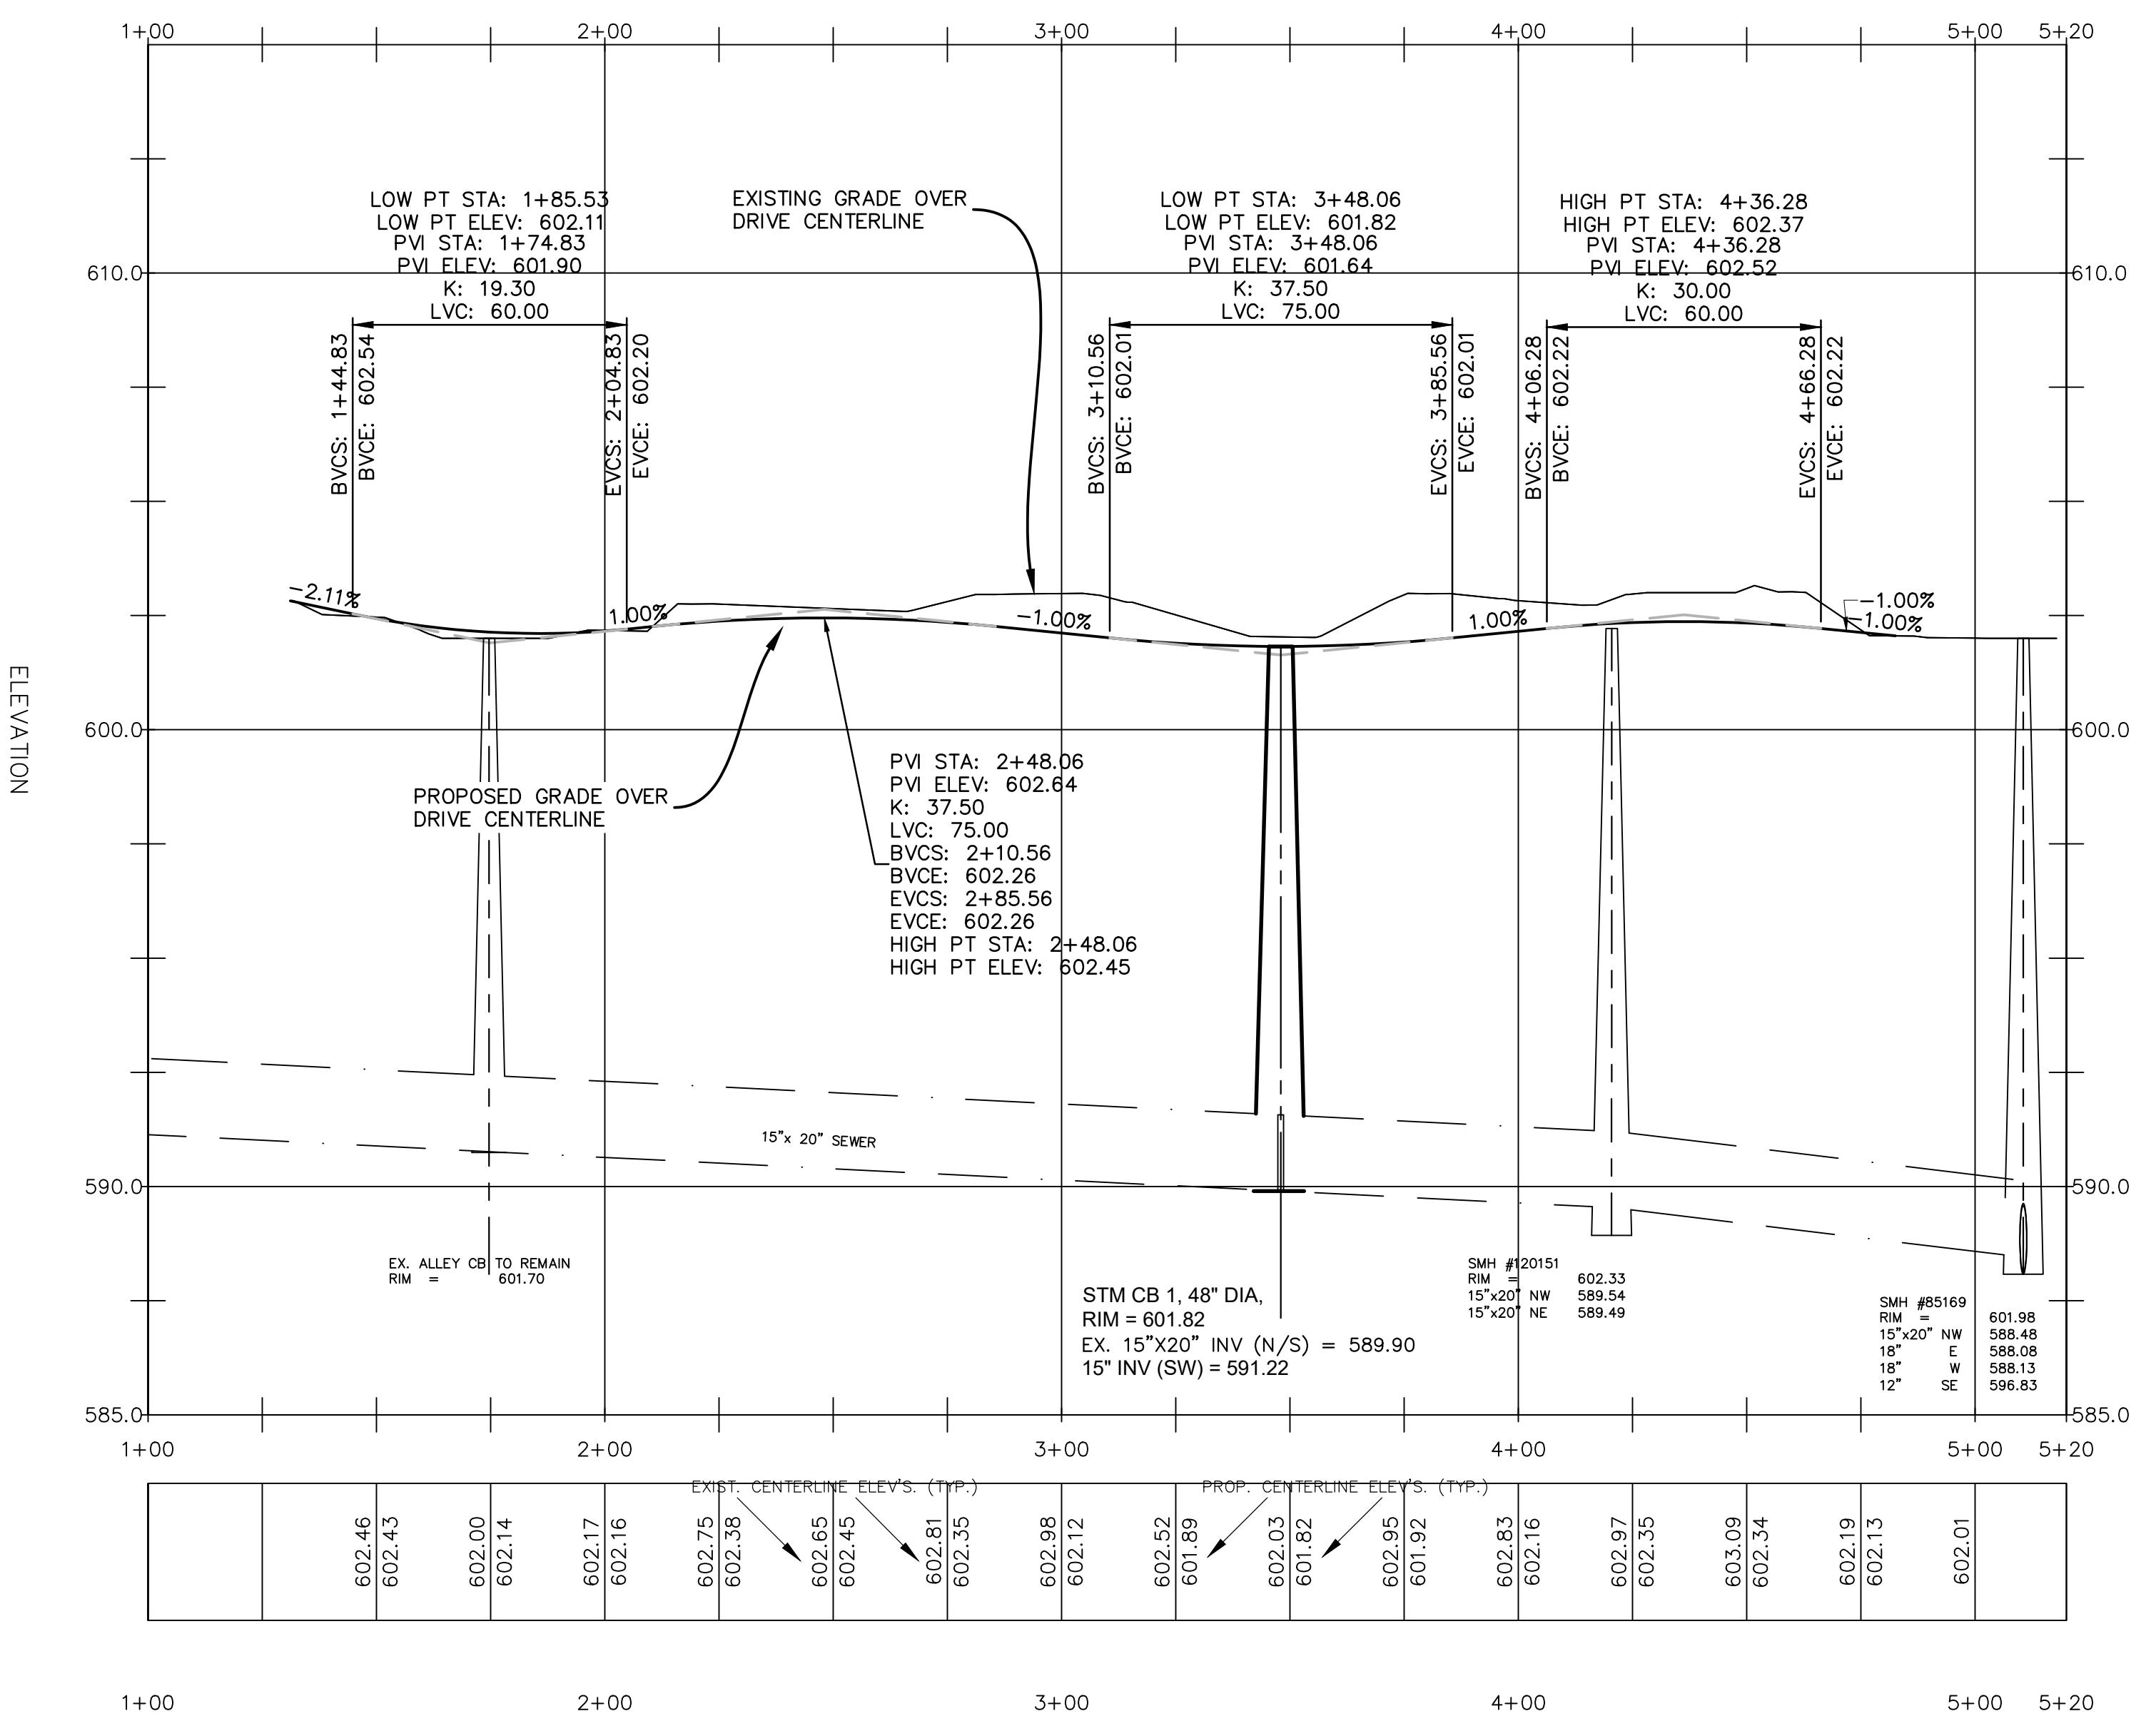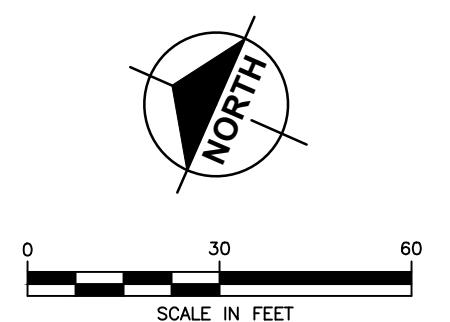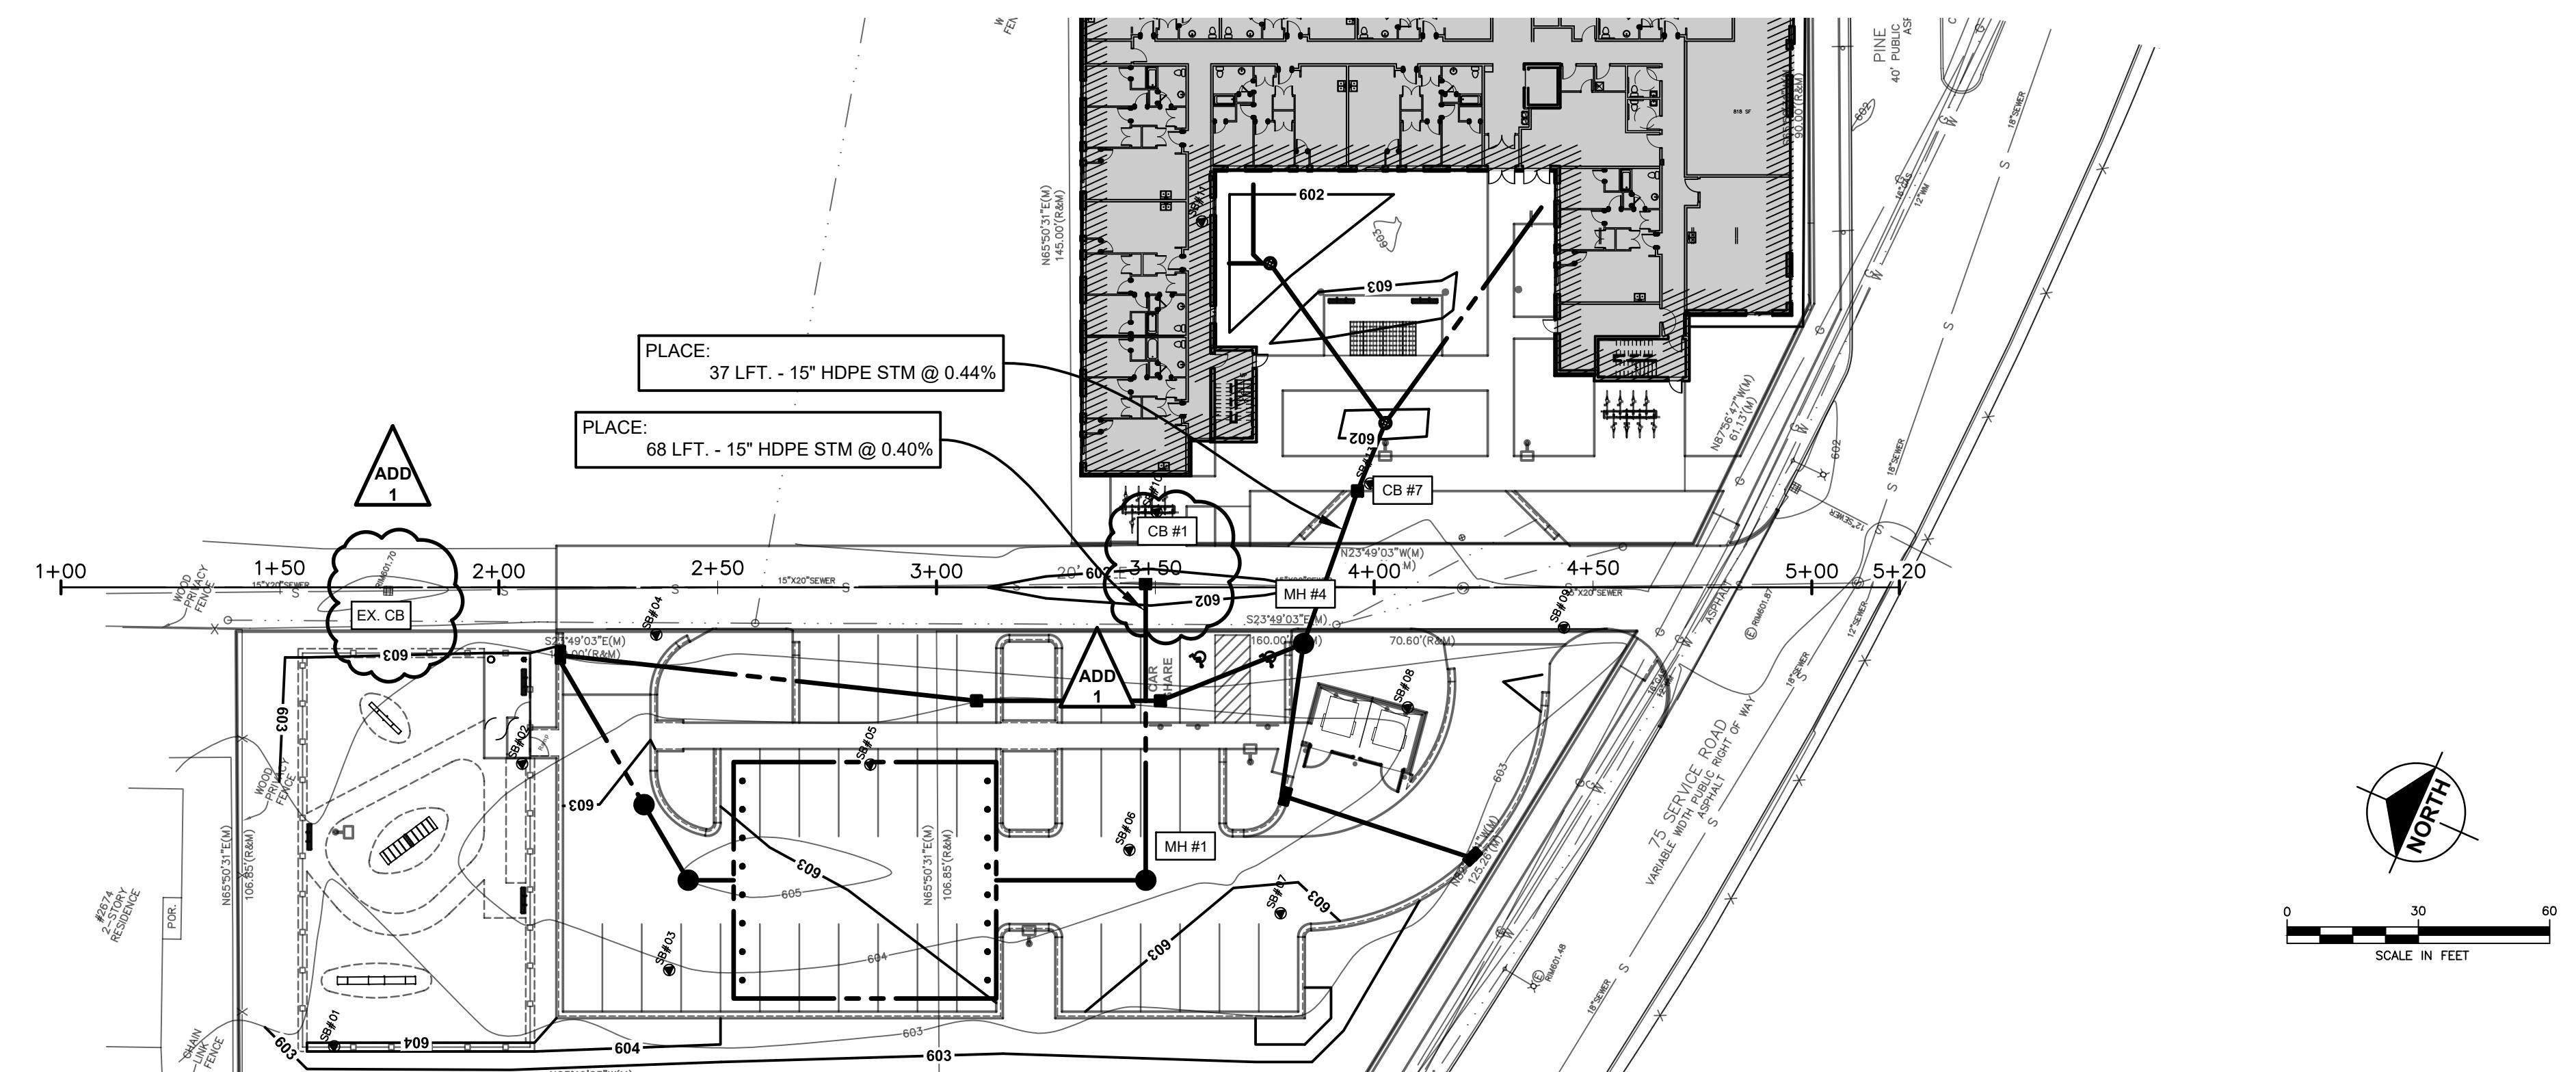

HORIZONTAL SCALE: 1"=30'

VERTICAL SCALE: 1"=3'

BENCH MARKS:

BM 1 NAIL IN SOUTH FACE OF UTILITY POLE AT
NORTHEAST CORNER OF PROPERTY.
Elevation: 603.15 ft. (NAVD 88)

BM 2 ARROW ON HYDRANT AT NORTHWEST CORNER OF
PINE ST. AND 14TH ST.
Elevation: 605.50 ft. (NAVD 88)

BM 3 ARROW ON HYDRANT AT NORTHEAST CORNER OF
15TH ST. AND FISHER SERVICE DRIVE.
Elevation: 604.07 ft. (NAVD 88)

NORTH CORKTOWN
A PROPOSED DEVELOPMENT
CITY OF DETROIT, MI 48202
WAYNE COUNTY, MICHIGAN
ALLEY PLAN & PROFILE

DRAWN BY J.W.C. DATE FEB '24
ENGINEER B.A.C. DATE FEB '24
EDIT DATE
SCALE PLOT SCALE
AS NOTED 1:1
PROJECT Q23 NORTH CORKTOWN
SHEET NO. C3.2

DATE OF PLAN: 07-17-24