
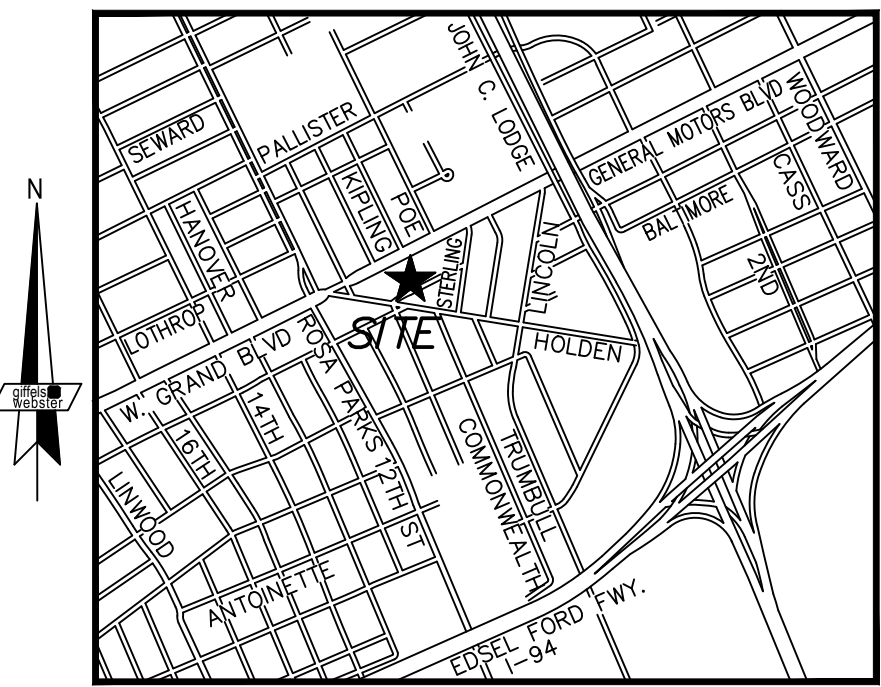


V:\182467 750 Motown Museum Expansion - Phase 2\Design\CAD\Work Sheets\C-500 Geometric & Paving Plan.dwg

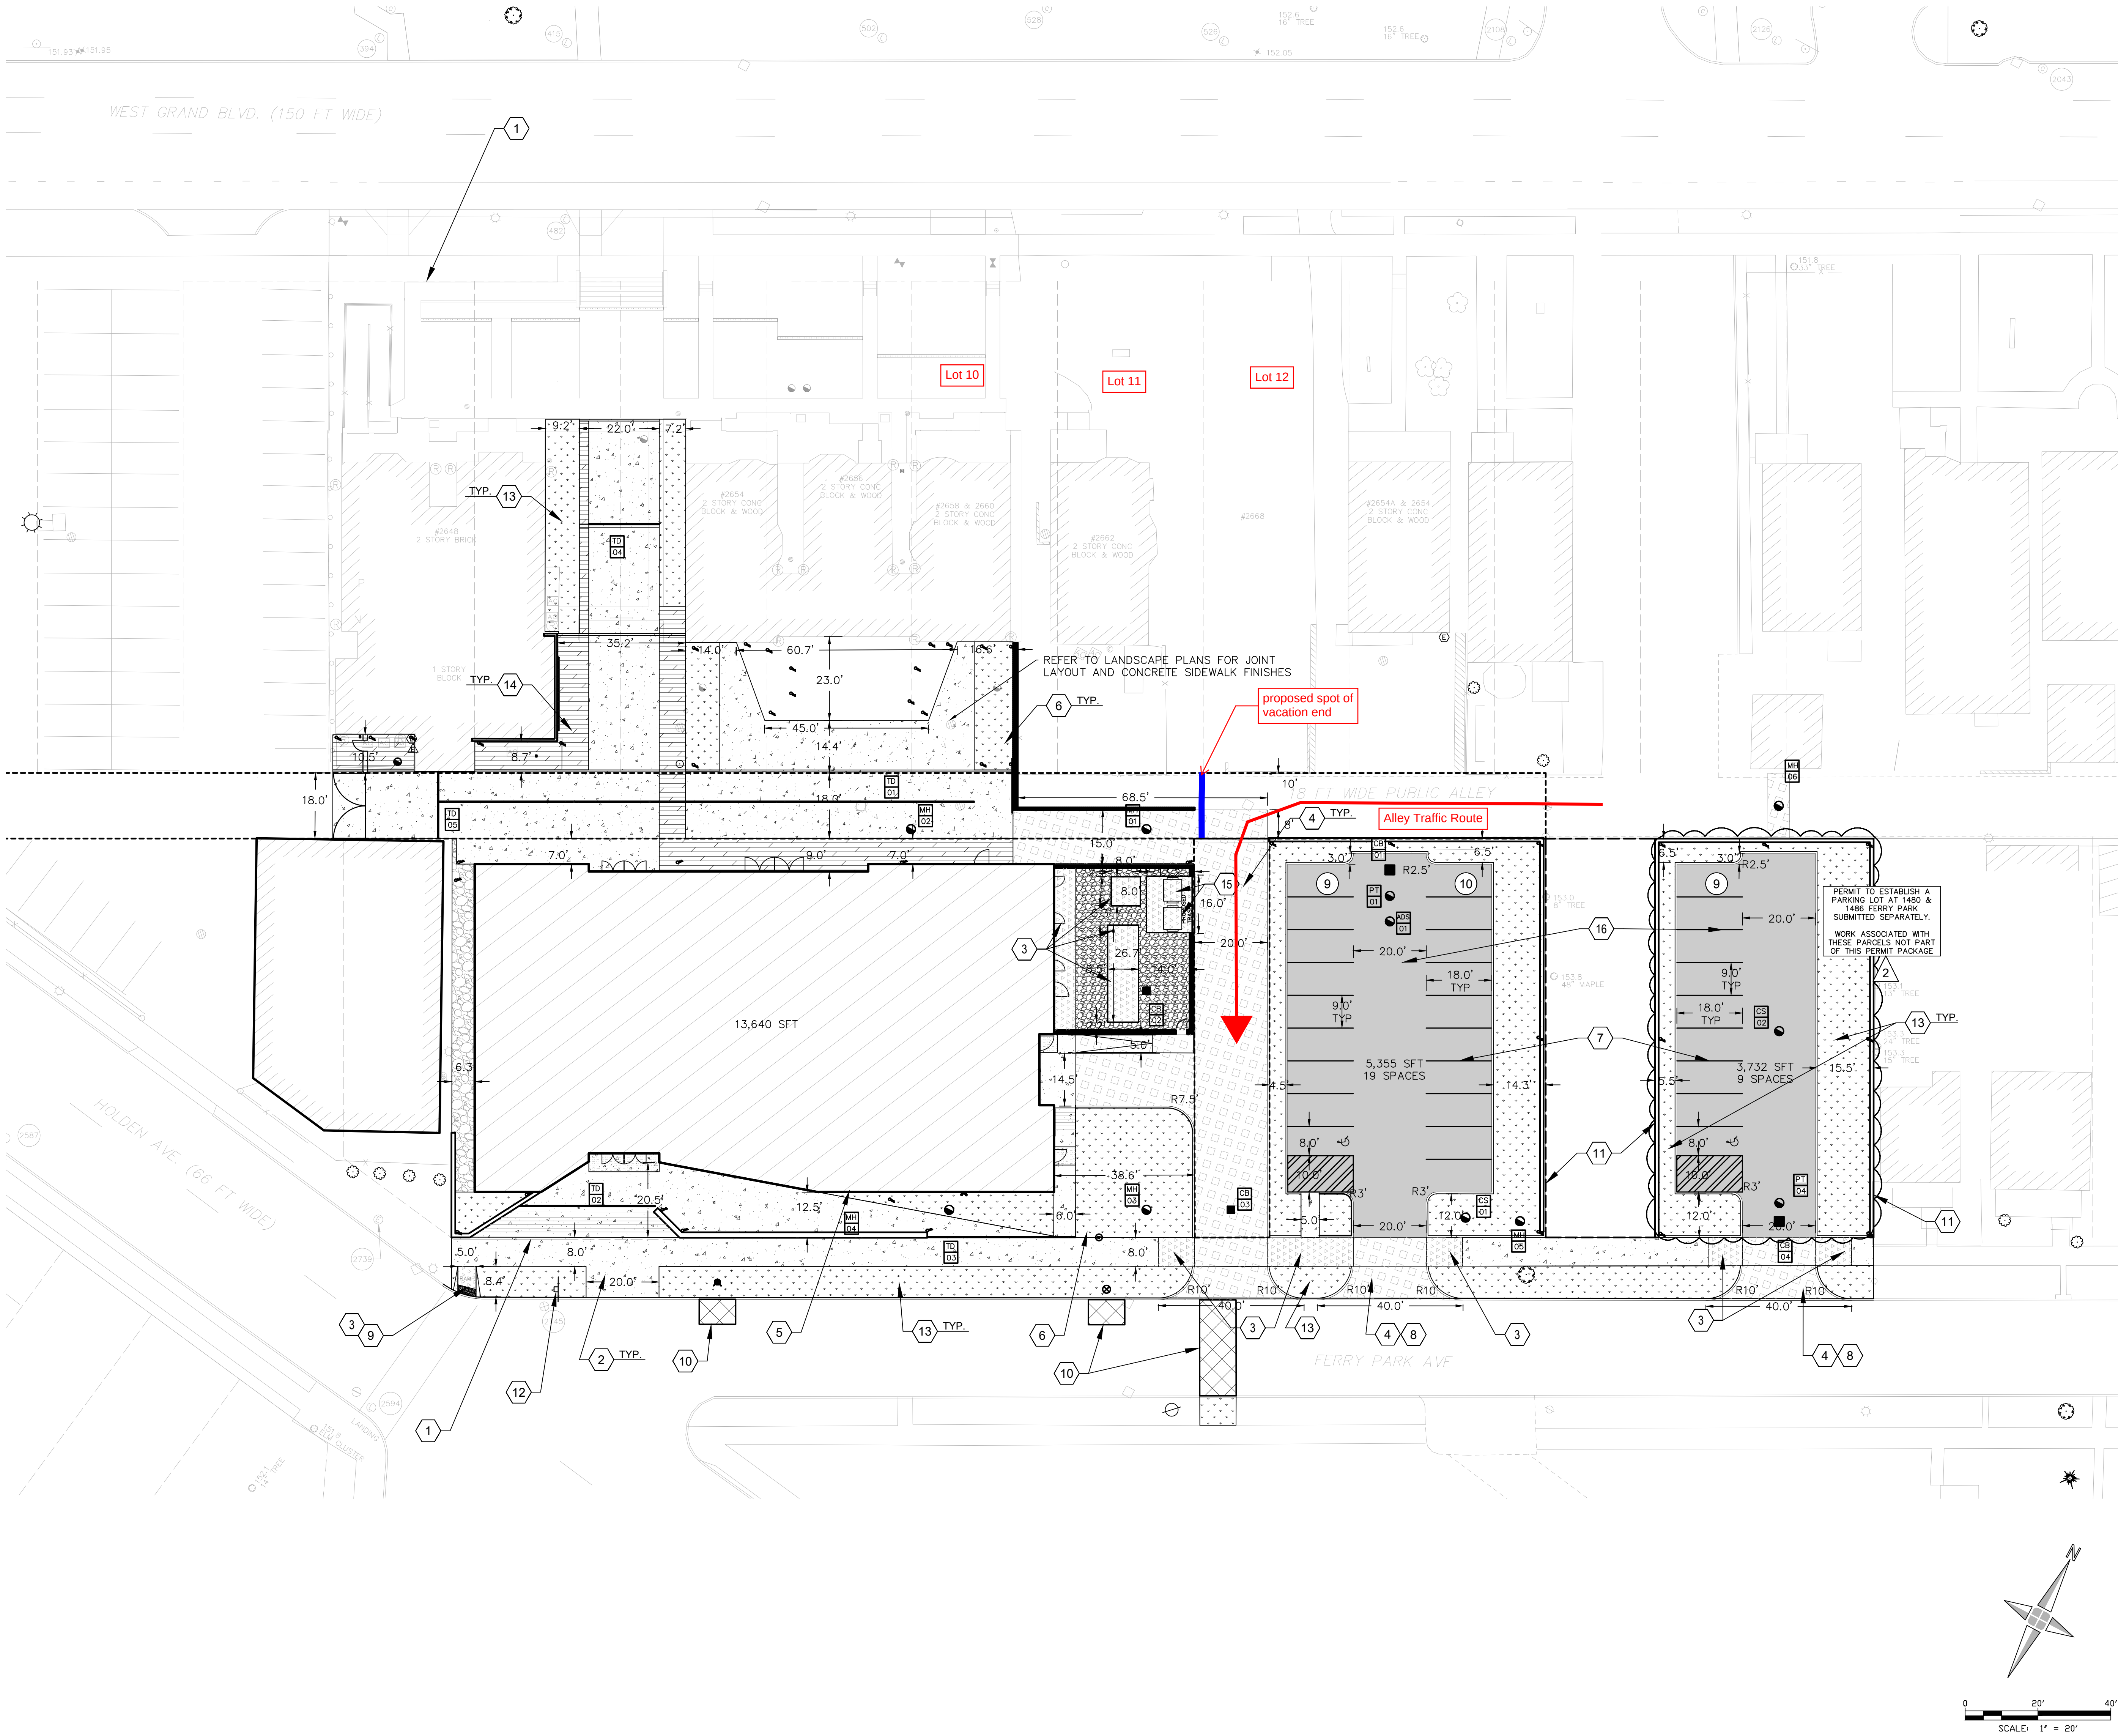

SITE IMPROVEMENT PLAN - LEGEND

- PROPOSED 6" CONCRETE PAVEMENT
- PROPOSED 8" CONCRETE PAVEMENT
- PROPOSED 4" CONCRETE SIDEWALK
- PROPOSED ASPHALT PAVEMENT
- PROPOSED LANDSCAPE
- PROPOSED UTILITY TRENCH
- PROPOSED GRAVEL
- PROPOSED BUILDING FOOTPRINT
- PROPOSED DETECTABLE TILE
- PROPOSED DECORATIVE PAVEMENT
- PROPOSED FROST SLAB

SITE IMPROVEMENT PLAN - KEY NOTES

- 1 PROPERTY LINE
- 2 PROPOSED 4" CONCRETE SIDEWALK, SEE DETAIL SHEET C-800
- 3 PROPOSED 6" CONCRETE PAVEMENT, SEE DETAIL SHEET C-800
- 4 PROPOSED 8" CONCRETE PAVEMENT, SEE DETAIL SHEET C-800
- 5 PROPOSED BUILDING
- 6 LANDSCAPE AREA, SEE LANDSCAPE SHEETS FOR DETAILS
- 7 PROPOSED PAVEMENT STRIPING, TYP.
- 8 DRIVE APPROACH, PER CITY OF DETROIT STANDARDS AND DETAILS, SEE C-820.
- 9 PROPOSED ADA RAMP WITH 24" WIDE DETECTABLE WARNING, PER CITY OF DETROIT STANDARDS AND DETAILS, SEE C-820.
- 10 UTILITY TRENCH PAVEMENT AND RESTORATION PER CITY OF DETROIT STANDARDS AND SPECIFICATIONS, SEE DETAIL ON SHEET C-820.
- 11 4' HIGH SITE SCREEN TYPE 1 FENCE, SEE LANDSCAPE PLANS FOR DETAILS AND SPECIFICATIONS.
- 12 RELOCATED STOP SIGN
- 13 SITE LIGHTING, SEE LANDSCAPE SHEETS FOR DETAILS
- 14 PROPOSED DECORATIVE PAVEMENT, SEE LANDSCAPE SHEETS FOR DETAILS
- 15 PROPOSED DUMPSTER
- 16 PROPOSED STANDARD DUTY ASPHALT. SEE DETAIL ON SHEET C-800

Perkins&Will

Legacy Tower
411 W Chapel Hill Street, Suite 200
Durham, North Carolina 27701
1919.433.5300
1919.433.5301
www.perkinswill.com

OWNER

Motown Historical Museum, Inc
2648 West Grand Boulevard, Detroit, MI
48208

CONSULTANTS

CIVIL

Giffels Webster
28 West Adams Ste 1200 Detroit, MI
48226

LANDSCAPING

Perkins&Will
80 S 8th St #300, Minneapolis, MN 55402

MEP

WSP

5145 Livernois, Suite 100 Troy, MI 48068

STRUCTURAL

MEG

33533 Twelve Mile Road Suite 200
Farmington Hills, MI 48331

ACOUSTICAL

Jaffe Holden
3737 Glenwood Avenue, Suite 100
Raleigh, NC 27612

LIGHTING

Illuminating Concepts
30733 West 10 Mile Road Farmington
Hills, MI 48336

THEATER

Fisher Dachs Associates
22 West 19th Street, New
York, NY 10011




PROJECT

Motown Museum
Expansion Phase 2

2648 West Grand Boulevard
Detroit, MI 48208



KEYPLAN

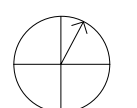

ISSUE CHART

2	PERMIT COMMENTS	11/21/24
1	REVISION 1	07/26/24
1	CONSTRUCTION DOCUMENTS	07/12/24
DATE	ISSUE	DATE
Job Number	830400.002	
TITLE		

GEOMETRIC & PAVING
PLAN

SHEET NUMBER

C-500

© 2023 Perkins and Will

CONSTRUCTION DOCUMENTS PRICING SET - 10/10/2023