

(PER TAX RECORDS)

LOTS 62 THROUGH 95 AND VACATED ALLEY ADJACENT TO SAID LOTS EXCEPT CATHEDRAL AVENUE AS WIDENED, BONAPARTE PARK HEIGHTS SUBDIVISION, LIBER 54, PAGE 26 OF PLATS, WAYNE COUNTY RECORDS; ALSO LOTS 274 THROUGH 288 AND LOTS 207 THROUGH 236 AND LOTS 140 THROUGH 169 AND VACATED STREETS AND ALLEY ADJACENT TO SAID LOTS, DANA PARK SUBDIVISION, LIBER 57, PAGE 91 OF PLATS, WAYNE COUNTY RECORDS.

NAVD88 DATUM

SITE BENCH MARK NO. 1
ARROW ON HYDRANT (2015) LOCATED ON
THE NORTH SIDE OF CATHEDRAL AVENUE
ON EAST SIDE OF FAUST.
ELEVATION=619.55'

SITE BENCH MARK NO. 2
SET MAG NAIL IN NORTH FACE OF A
UTILITY POLE LOCATED AT THE SOUTHWEST
CORNER OF ROSEMONT AVENUE AND WEST
BOUND CATHEDRAL AVENUE.
ELEVATION=617.17'

SITE BENCH MARK NO. 3
SET MAG NAIL IN NORTH FACE OF A
UTILITY POLE LOCATED ON THE SOUTH
SIDE OF DOVER AVENUE ±165 FEET WEST
OF ROSEMONT AVENUE.
ELEVATION=614.83'

SITE BENCH MARK NO. 4
SET MAG NAIL IN NORTH FACE OF A
UTILITY POLE LOCATED AT THE SOUTHEAST
CORNER OF FAUST AVENUE AND DOVER
AVENUE.
ELEVATION=615.43'

SITE BENCH MARK NO. 5
SET MAG NAIL IN EAST FACE OF A UTILITY
POLE LOCATED ON THE WEST SIDE OF
GREENVIEW AT ADDRESS #9075 GREENVIEW
AVENUE ± 385 FEET NORTH OF DOVER
AVENUE.
ELEVATION=615.30'


	E/ SITE BOUNDARY		W
	E/ PAVEMENT		GAS
	CURB		UGE
	E/ GRAVEL		UGT
	CL. ROAD		CTV
	E/ WALK		
	RAILROAD		PLD
	E/ BRICK		STEAM
	MISC. LINE		TEL
	FENCE		TEL
	GUARD RAIL		TEL
	WALL		TEL
	BLDG. LINE		TEL
	OVERHEAD WIRES		TEL
	RAILING		TEL
	OVERHANG LINE		TEL
	T/ BANK		TEL
	B/ BANK		TEL
	CL DITCH/STREAM		TEL
	SHRUB LINE		TEL
	TREE LINE		TEL
	WATER EDGE		TEL
	WETLAND LINE		TEL
	STORM LINE		TEL
	SAN. LINE		TEL
	STM		TEL
	SAN		TEL

WATER LINE		POST INDICATOR VALVE
GAS LINE		WELL HEAD
UG ELEC. LINE		IRC CONNECTION
UG TELE. LINE		FLIDGATION CONTROL BOX
UG CABLE TV LINE		
PAINT STRIP		STORM MH
COMBINED SEWER		CATCH BASIN
P.D. LINE		BEEHIVE CB
STEAM LINE		CU LVERT E.S.
SECTION LINE		
ELECTRIC OVERHEAD		ROOF/DOWN SPOUT
TELEPHONE OVERHEAD		OVERFLOW/OUTLET STRUCTURE
RIGHT-OF-WAY		STORM CLEAN OUT
		ROUND CB
PROT. POST/GUARD POST		LIGHT POLE
GUY		UTILITY POLE
DECIDUOUS TREE		ELEC. TRANS.
CONIFEROUS TREE		AIR COND. CONDITIONER
DEAD TREE		
UTILITY FLAG		ELEC. MH
BLDC. CORNER		ELEC. METER
(FIELD LOCATED)		ELEC. RISER
		TRAFFIC CONTROL BOX
HANDICAP PARKING		STEAM MH

	WETLAND FLAG		PUBLIC LIGHTING MARKER
	BUSH/SHRUB		GAS METER
	PARKING METER		GAS RISER
	RESIDENTIAL MAILBOX		GAS VALVE
	U.S. MAILBOX		GAS MH
	EXISTING ELEVATION		TELE. RISER
	SOIL BORING		TELE. MH
	MONITORING WELL		TELE. CROSS BOX
	LAWN IRRIG. HEAD		CABLE RISER
	CENTERLINE R.R. TRACK		PAY PHONE
	MILEAGE T.O.P. SHOT		MANHOLE
	SURVEY CONTROL POINT		SIGN
	FOUND IRON		
	FOUND NAIL		
	F. CUT CROSS		
	SECTION COR.		
	FENCE POST		
	BENCHMARK		
	FOUND PIPE		
	FOUND MON.		
ASPH.	ASPHALT		

CONC.	CONCRETE
A.C.	AIR CONDITIONER
G.P.	GUARD POST
C.L.F.	CHAIN-LINK FENCE
D.L.	DOOR LEDGE
F.F.	FINISHED FLOOR
O.H.	OVERHANG
F.I.	FOUND IRON
S.I.	SET IRON
F.I.P.	FOUND IRON PIPE
M.	MEASURED
R.	RECORD
F.M.	FOUND MONUMENT
S.N.	SET NAIL
CMP	CORRUGATED METAL PIPE
RCP	REINFORCED CONCRETE PIPE

LOCATION MAP
(NOT TO SCALE)

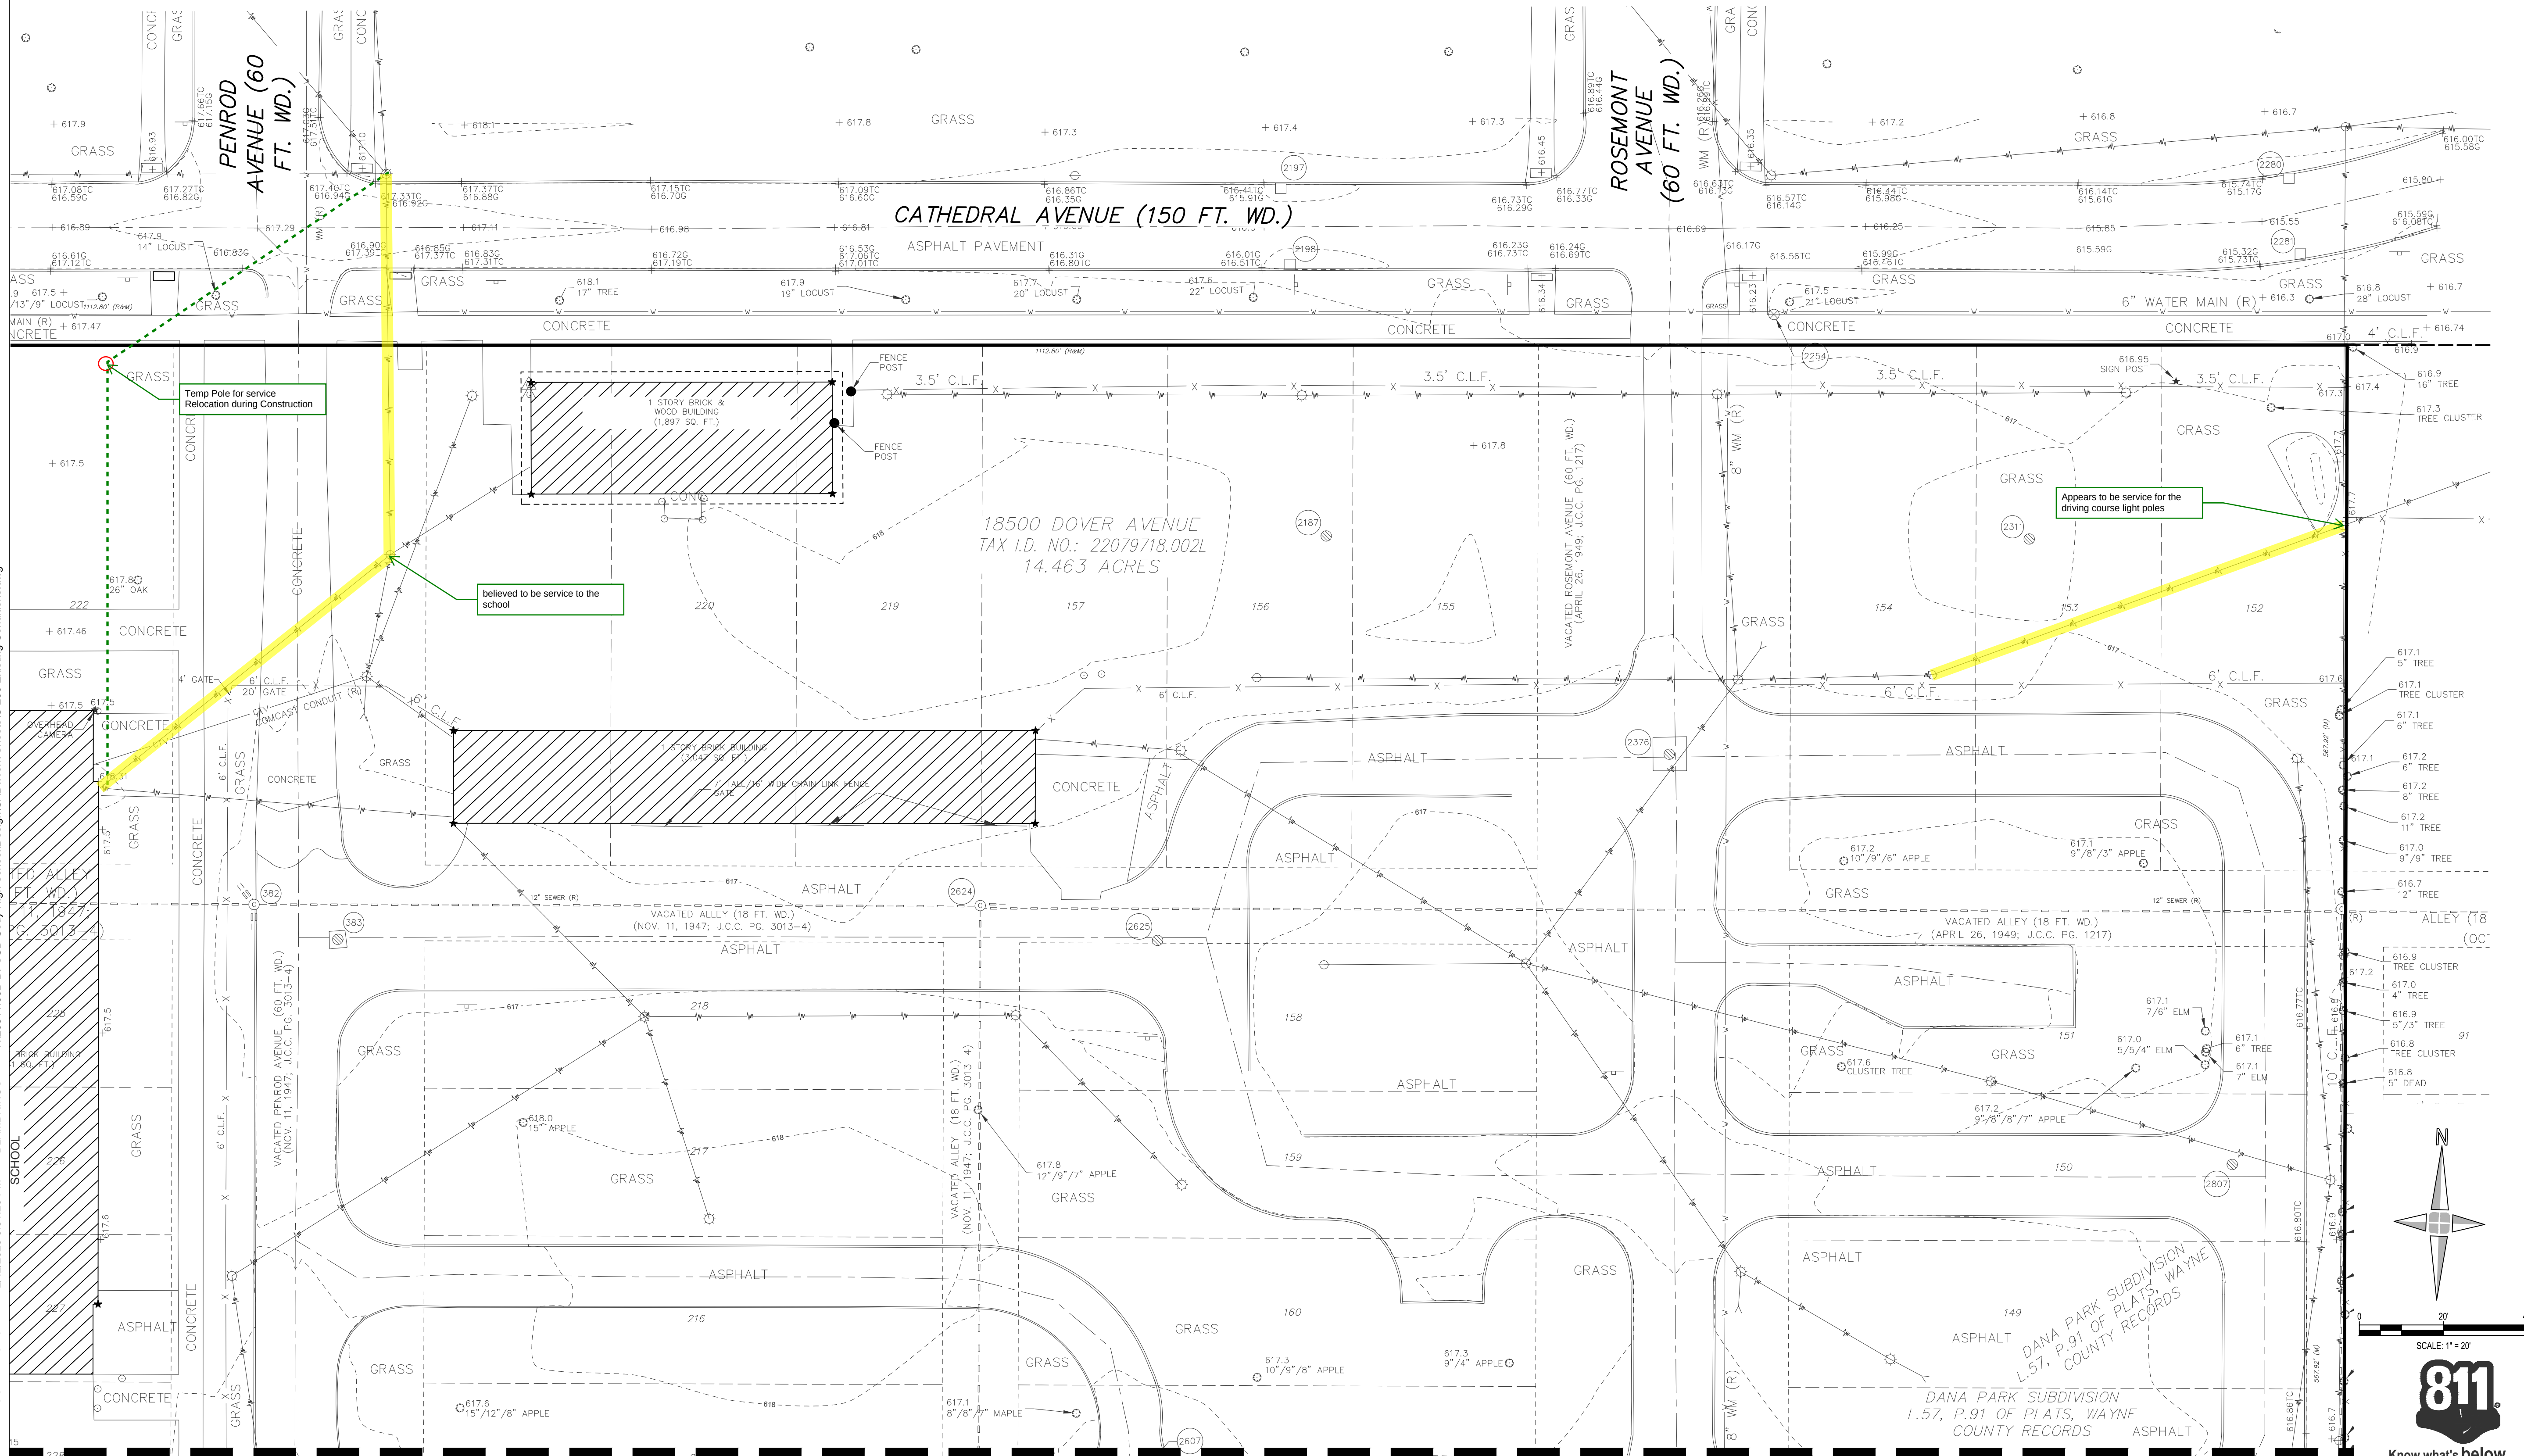

MATCHLINE - FOR AREA B SHEET C-202

Know what's **below**.
Call before you dig



DETROIT
PUBLIC SCHOOLS
COMMUNITY DISTRICT

DETROIT PUBLIC SCHOOLS
COMMUNITY DISTRICT
3011 W GRAND BLVD
DETROIT, MI 48202
313.240.4377
www.detroitk12.org

**FRANK CODY HIGH
SCHOOL**
18445 CATHEDRAL ST., DETROIT, MI
48228

GHAFARI

17101 MICHIGAN AVENUE
DEARBORN, MI 48126-2736 USA
TEL +1.313.441.3000
www.ghafari.com

giffels
webster

REGISTRATION SEAL

THIS DRAWING HAS BEEN ISSUED FOR REFERENCE ONLY AND IS NOT TO BE USED FOR ANY OTHER PURPOSE THAN THE INTENDED WORK IN PROGRESS COORDINATION. USE OF THIS DRAWING FOR PURPOSES OTHER THAN WORK IN PROGRESS IS AT THE USER'S OWN RISK. THIS DOCUMENT SHOULD NOT BE USED FOR OFFICIAL BIDDING, PRICING, QUANTITY TAKE-OFFS OR OTHER CONSTRUCTION ACTIVITIES.

[illegible]

PROJECT #	2300432
PROJECT MANAGER	A. WIELAND
DESIGNED BY	R. LOSEY
DRAWN BY	R. LOSEY
QUALCHECK	D. ROOT
SHEET TITLE	

EXISTING CONDITIONS - AREA A

C-201

SHEET NUMBER