


Existing Alley to Easement
 L. 21281, P. 103
 (Oct 21, 1981, JCC 2545)
 Vacated Alley (Mar 23, 1937)




0 25' 50'

SCALE: 1" = 50'

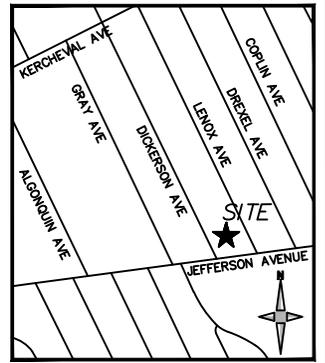

LOCATION MAP
(NOT TO SCALE)

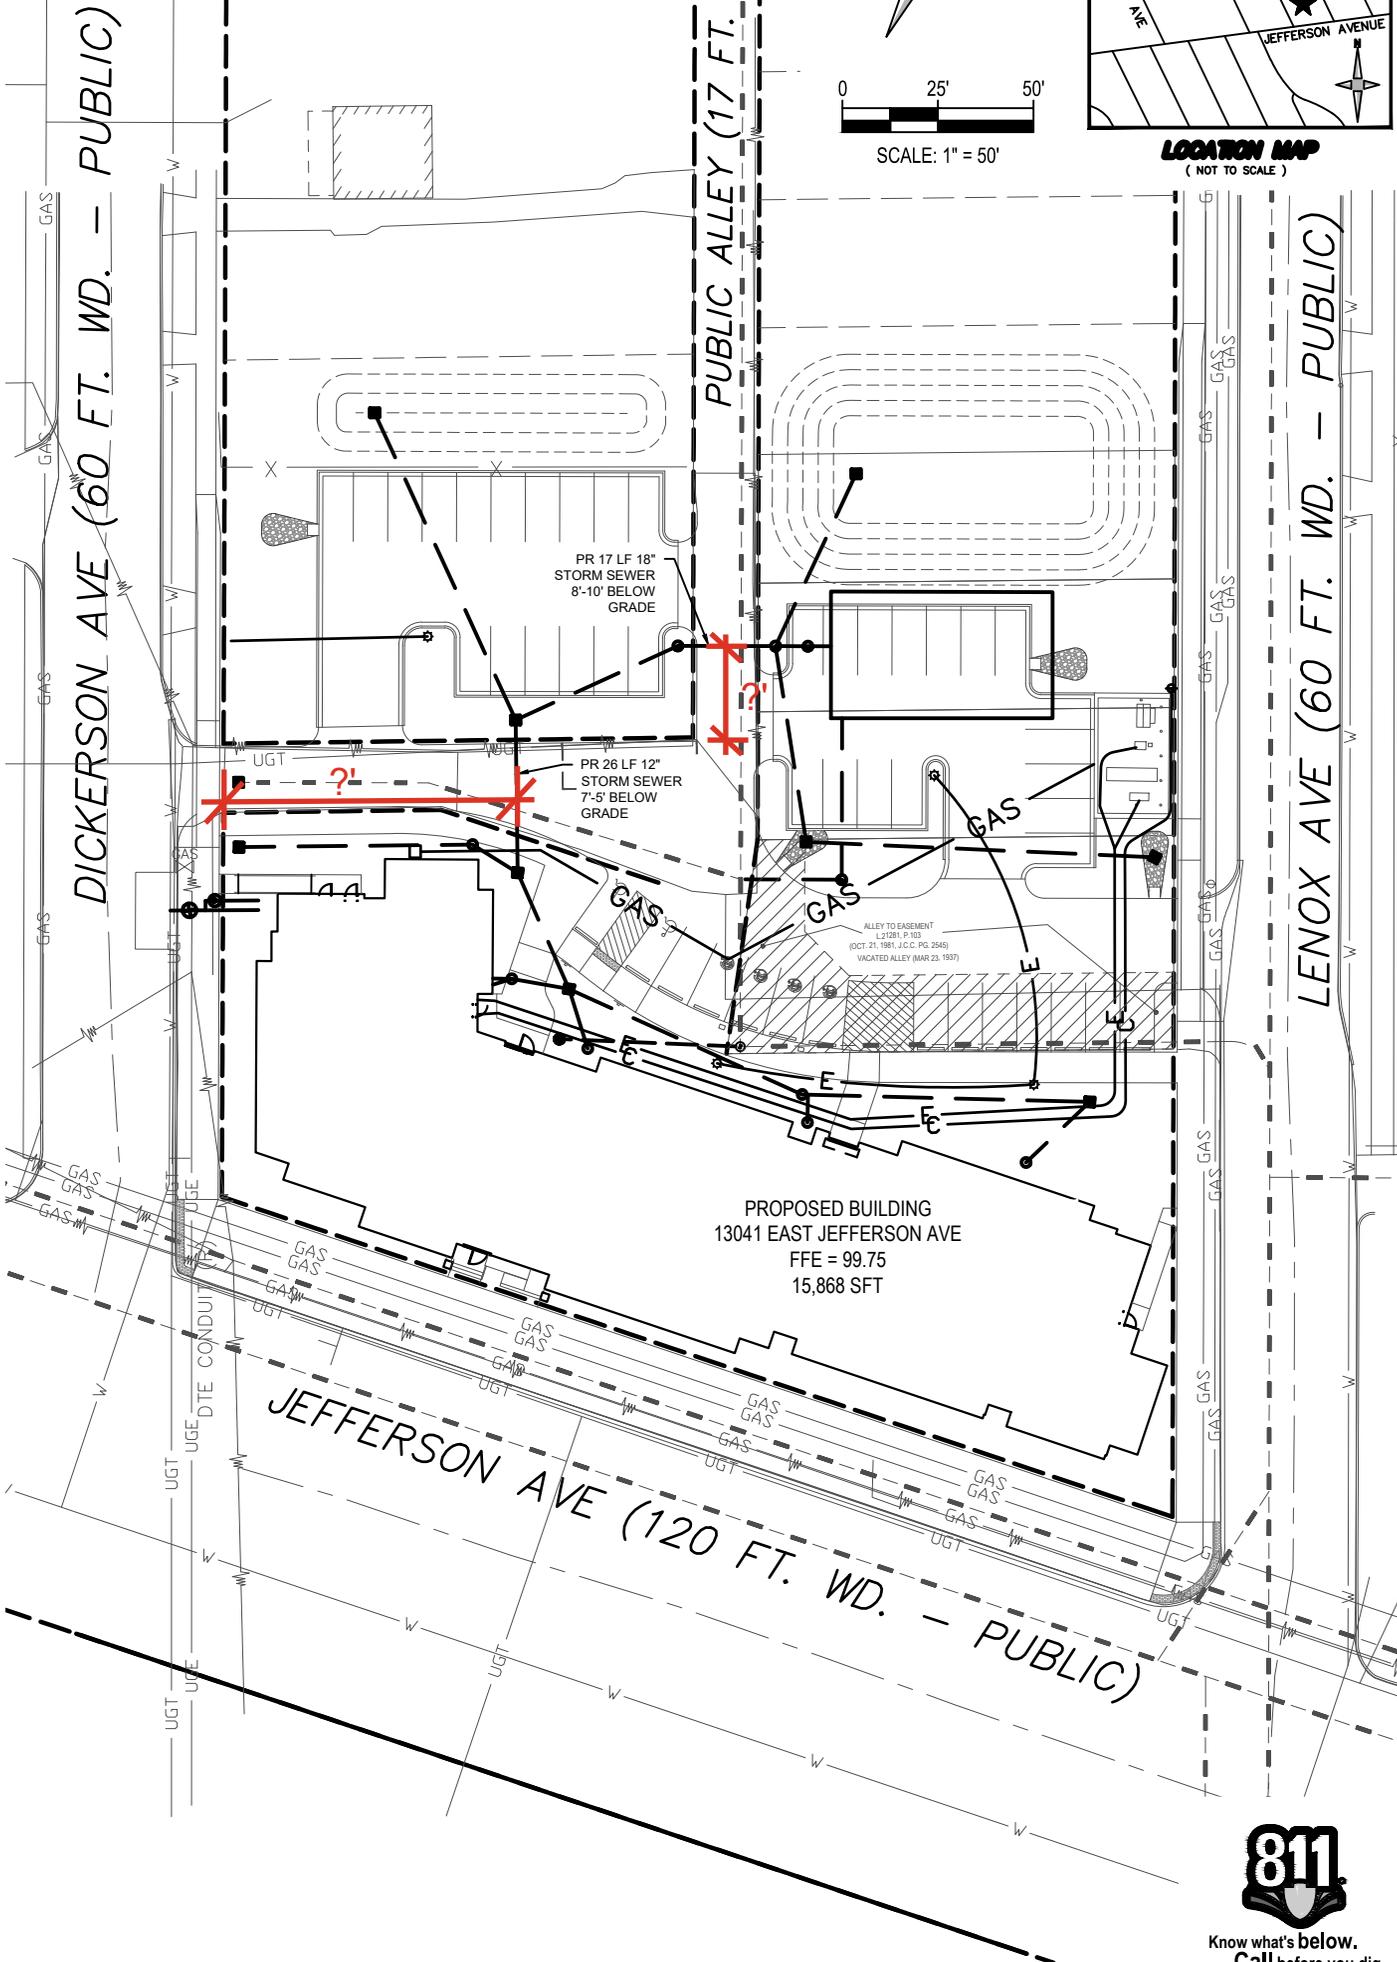

Know what's below.
Call before you dig.

EAST JEFFERSON HOUSING

CITY OF DETROIT, WAYNE COUNTY, MICHIGAN

ENCROACHMENT MAP 25-83



28 West Adams Road
 Suite 1200
 Detroit, MI 48226
 p (313) 962-4442
 f (313) 962-5068
 www.giffelswebster.com

Executive: DR
 Manager: DR
 Designer: CJ
 Quality Control: RPL
 Section:

Developed For:
 Hiti, DiFrancesco + Siebold
 1939 West 25th Street, Suite 300
 Cleveland, OH 44113
 216-696-3460 x 322

DATE:	ISSUE:
8/13/2025	Encroachment
8/15/2025	Encroachment

Date:	2025-08-11
Scale:	1"=50'
Sheet:	1 OF 1
Project:	20401.10D

Copyright © 2024 Giffels Webster.
 No reproduction shall be made
 without the prior written consent of
 Giffels Webster.