





WEST COLUMBIA ST. 60 FT. WD.

2ND BLVD. 60 FT. WD.

CASS AVE. 80 FT. WD.

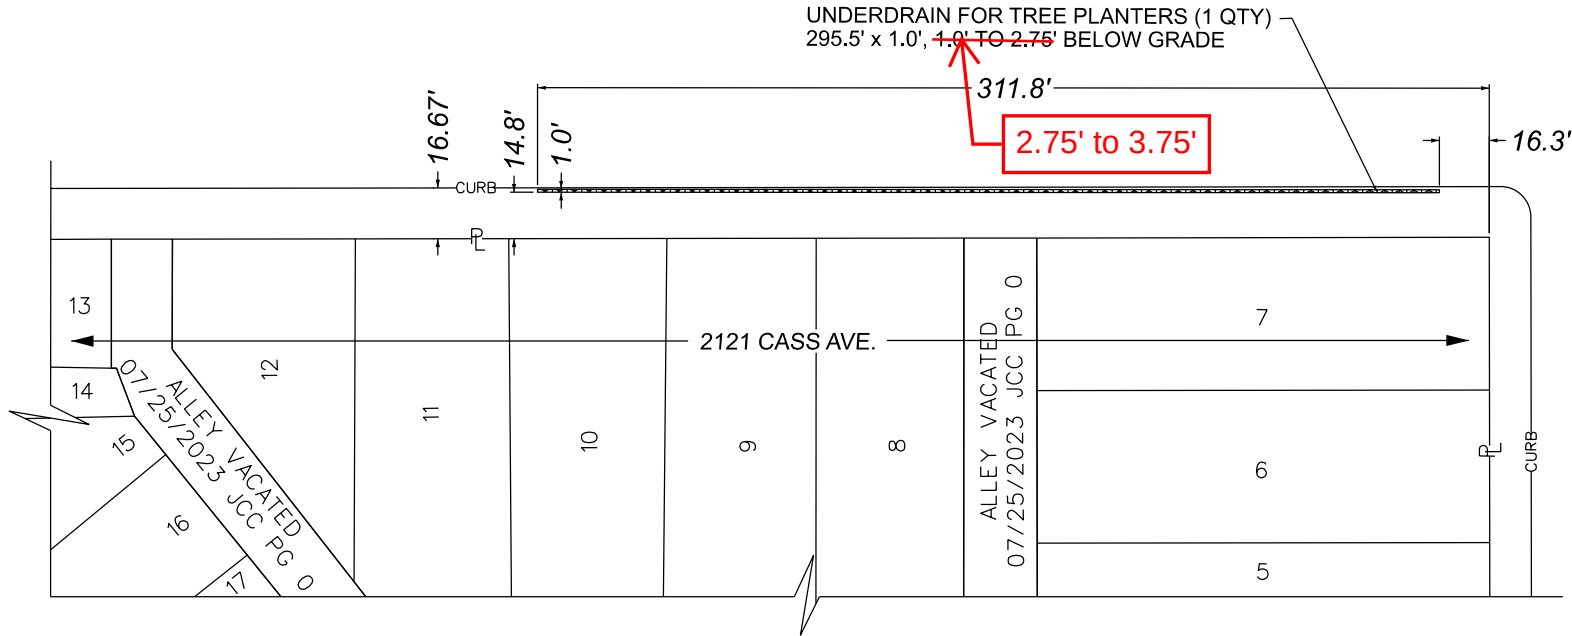

WEST ELIZABETH ST. 60 FT. WD.

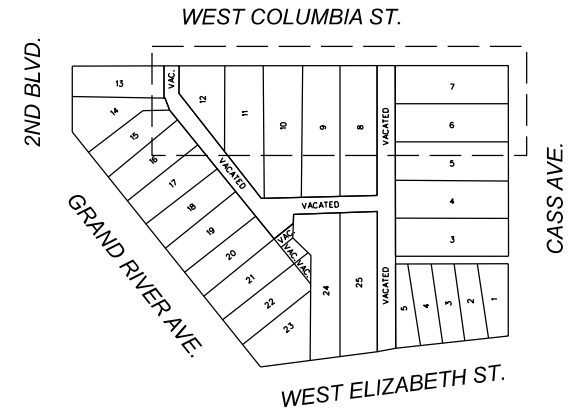

- REQUEST ENCROACHMENT
(FOR BELOW GRADE UNDERDRAIN FOR TREE PLANTERS)

(FOR OFFICE USE ONLY)

CARTO 29 E

REQUEST ENCROACHMENTS INTO WEST COLUMBIA ST. AT 2121 CASS AVE.

CITY OF DETROIT
CITY ENGINEERING DIVISION
MAPS & RECORDS BUREAU

JOB NO. 26-01

DRWG. NO. 02

DRAWN BY TS

DATE 01/12/2026

CHECKED AP/LC

APPROVED GE