



Letter of Transmittal

Date: 6-11-2026
Petition Map: 26-43

Type of Petition

- | | | |
|--|---------------------------------------|--|
| ☐ Outright Vacation | ☐ Dedication | ☐ Berm Use |
| ☒ Conversion to Easement | ☐ Encroachment | ☐ Temporary Closing |

Review Status

The above petition has been received and reviewed by this office. Please see below for the review status as marked.

- | | |
|--|--|
| ☒ Approved Subject to
Attached Provisions | ☐ Revise and Resubmit |
| ☐ Not Approved | |

Additional Comments (if applicable):

DWSD records indicate there is DWSD assets in the public right-of-way requested for easement. DWSD has no objections to the requested easement subject to the attached provision for easement is followed.
--

Attached is the DWSD provision related to the petition.

	Name	Title	Signature	Date
Reviewed by:	Mohammad Siddique	Engineer	<i>Mohammad Siddique</i>	6-11-2026
Approved by:	Syed Ali	Engineering Manager	<i>Mohammad Siddique</i> For Syed Ali	6-11-2026

PROVISIONS FOR CONVERSION TO EASEMENT

1. An easement, the full width of the existing right of way, is reserved for the Detroit Water and Sewerage Department (DWSD) for the purpose of installing, maintaining, repairing, removing, or replacing any sewers, water mains, fire hydrants and appurtenances, with the right of ingress and egress at any time to, and over said easement for the purpose above set forth. Any proposed fencing across the easement must have a gate installed to permit access for DWSD forces. The gate shall remain unlocked 24 hours a day, unless a guard is stationed near the gate to allow the DWSD ingress and egress at any time. The minimum dimensions of the gate or gates shall provide 15-foot vertical and 13 foot horizontal clearances for freedom of DWSD equipment movement.

Free and easy access to the sewers, water mains, fire hydrants and manholes and structures within the easement is required for DWSD equipment, including the use of backhoes, bull dozers, cranes or pipe trucks, and other heavy construction equipment, as necessary for the alteration or repair of the sewer and/or water main facilities.

DWSD retains the right to install suitable permanent main location guide posts over its water mains at reasonable intervals and at points of deflection.

2. Said owners of the adjoining property, for themselves, their heirs and assigns, agree that no building or structure of any nature whatsoever, including fences, porches, patios, balconies, etc., shall be built upon or over said easement, or that no grade changes or storage of materials shall be made within said easement without prior written approval and agreement with DWSD.

DWSD prohibits the use of heavy construction equipment or the storage of building material directly over or near DWSD facilities. DWSD also prohibits the use of cranes and balls or hydraulic rams for pavement removal where DWSD facilities are involved. If the water main and/or sewer facilities are broken or damaged as a result of any action on the part of the contractor, the contractor shall be liable for any and all costs incidental to the repair of such broken or damaged water main and/or sewer facilities.

3. If at any time in the future, the owners of any lots abutting on said conversion to easement shall request the removal and/or relocation of the aforementioned utilities in said easement, such owners shall pay all costs incidental to such removal and/or relocation. It is further provided that if sewers, water mains, and/or appurtenances in said easement shall break or be damaged as a result of any action on the part of the owner, or assigns, then in such event, the owner or assigns shall be liable for all costs incidental to the repair of such broken or damaged sewers and/or water mains, and shall also be liable for any and all claims for damages resulting from his action.

City of Detroit, Department of Public Works
Coleman A. Young Municipal Center
2 Woodward Avenue, Suite 600
Detroit, Michigan 48226

**RE: Letter of Support for Alley Vacation Petition
Jefferson Avenue Apartments
13041 E. Jefferson Avenue**

To Whom It May Concern:

CHN Housing Partners (CHN), co-developer of the Jefferson Avenue Apartments Project (the Project) and General Partner of CHN.TRIBE Jefferson Limited Dividend Housing Association Limited Partnership ("LDHA LP"), Property Owner and Project Owner, writes in support of the petition to vacate the public alley located between Dickerson and Lenox Streets, with a north boundary of Brooks St. The Project is a 52-unit multifamily affordable housing building that is currently under construction having received all required permits and City entitlements. CHN.TRIBE Jefferson LDHA LP maintains ownership of 13 lots adjacent to the referenced alley, which will be utilized for the building and required parking (details included as addendum).

CHN supports this alley vacation for the following reasons:

1. Enhanced Site Security

The vacation of this alley will enable the Property Owner to install perimeter fencing around the Jefferson Avenue Apartments site. This enhanced security measure will protect residents, reduce unauthorized access, and contribute to a safer living environment for the community.

2. Preservation of Utility Access

The Property Owner has confirmed they will not seek ownership of the vacated alley but rather requests vacation with a permanent easement reserved for public utilities. This approach ensures that essential utility providers maintain uninterrupted access for maintenance and service while addressing the security needs of the Project development.

The Jefferson Avenue Apartments Project represents an important investment in Detroit's housing stock, and this alley vacation is a reasonable measure that supports both the Project's success and the public interest.

CHN respectfully requests favorable consideration of this alley vacation petition.

Sincerely,



CHN.TRIBE Jefferson LDHA LP

By: Mark E. Whipkey, CAM of CHN Housing Partners,
Managing Member of CHN.TRIBE Jefferson, LLC., GP

City of Detroit Department of Public Works

Coleman A. Young Municipal Center 2 Woodward Avenue, Suite 600 Detroit, Michigan 48226

**RE: Letter of Support for Alley Vacation Petition
Jefferson Avenue Apartments
13041 E. Jefferson Avenue**

To Whom It May Concern:

CHN Housing Partners, co-developer of the Jefferson Avenue Apartments and General Partner of CHN.TRIBE Jefferson Limited Dividend Housing Association Limited Partnership (project owner), writes in support of the petition to vacate the public alley located between Dickerson and Lenox Streets, with a north boundary of Brooks St. The project is currently under construction having received all required permits and City entitlements. CHN.TRIBE Jefferson Limited Dividend Housing Association Limited Partnership maintains ownership of 13 lots adjacent to the referenced alley, which will be utilized for the building and required parking (details included as addendum).

CHN supports this alley vacation for the following reasons:

1. Enhanced Site Security

The vacation of this alley will enable the property owner to install perimeter fencing around the Jefferson Avenue Apartments site. This enhanced security measure will protect residents, reduce unauthorized access, and contribute to a safer living environment for the community.

2. Preservation of Utility Access

The property owner has confirmed they will not seek ownership of the vacated alley but rather requests vacation with a permanent easement reserved for public utilities. This approach ensures that essential utility providers maintain uninterrupted access for maintenance and service while addressing the security needs of the development.

The Jefferson Avenue Apartments project represents an important investment in Detroit's housing stock, and this alley vacation is a reasonable measure that supports both the project's success and the public interest.

13041 E. Jefferson Ave.



6/3/2026

Wastewater Control Devices - GLWA

<all other values>

Wastewater Structures - GLWA

Chamber

Manhole

Wastewater Mains - GLWA

GLWA Gravity Main

Transmission System Mains - GLWA

Active Water Main

Transmission System Valves - GLWA

Blowoff



Gate

Distribution System Main

Active

Abandoned

Wastewater Catch Basin

Wastewater Manhole

Wastewater Fitting

Bend/Slope Change

Blind Connection

Bulkhead/Cap

Coupling

Crown/Main Point


Wastewater Lamp Hole

Wastewater GravityMain

Active

Abandoned/Inactive/Retired

Wastewater Regulator

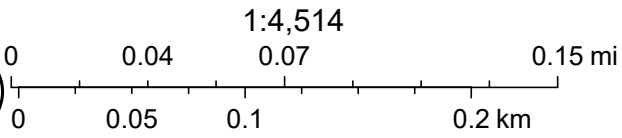


Sources: Esri, TomTom, Garmin, FAO, NOAA, USGS, © OpenStreetMap contributors, and the GIS User Community, GLWA, DWSD, Vantor

13041 E. Jefferson Ave.



6/3/2026, 8:37:16 AM

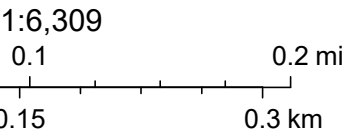

- | | | | | | |
|-------------------------|----------------------|----------------------------|-----------------------------------|---------------------------|--------------------------|
| CoD Base Units Geocoder | Blind Connection | Wastewater Lamp Hole | Wastewater Regulator | Stationary Dam | Submersible Level Sensor |
| Wastewater Catch Basin | Bulkhead/Cap | Wastewater Flow Direction | Wastewater Outfalls (GLWA) | Stop Log Gate | Ultrasonic Level Sensor |
| Wastewater Manhole | Coupling | Wastewater Gravity Main | Wastewater Control Devices (GLWA) | Weir | Ultrasonic Transducer |
| Wastewater Fitting | Material/Size Change | Active | Backwater Gate | <all other values> | Unknown |
| Bend/Slope Change | Crown/Main Point | Abandoned/Inactive/Retired | Regulator Gate | Wastewater Sensors (GLWA) | Wastewater Mains (GLWA) |
| | | | | Hydrostatic Level Sensor | GLWA Gravity Main |

Sources: Esri, TomTom, Garmin, FAO, NOAA, USGS, © OpenStreetMap contributors, and the GIS User Community, Vantor

13041 E. Jefferson Ave.



6/3/2026, 8:37:20 AM

CoD Base Units Geocoder

Transmission System Valve (GLWA)

Blowoff

Gate

Transmission System Main (GLWA)

Active Water Main

Distribution System Hydrant (DWSD)

DWSD

Distribution System Main (DWSD)

Active

Abandoned

Sources: Esri, TomTom, Garmin, FAO, NOAA, USGS, © OpenStreetMap contributors, and the GIS User Community, DWSD, Vantor

LATERAL SEWER IN ALLEY

IN BLOCK BOUNDED BY
DICKERSON, LENOX

JEFFERSON & KERCHEVAL AVES.

DETAILS

LENGTH OF SEWER 2370 FEET.

"	"	24" PIPE	203	"	INC. 4-6" Ys.
"	"	20" "	428	"	INC. 24-6" Ys. & 1-12" Y
"	"	18" "	480	"	INC. 30-6" Ys.
"	"	15" "	510	"	INC. 33-6" Ys.
"	"	12" "	749	"	INC. 42-6" Ys.

6 MANHOLES WITH IRON STEPS.
GRADE 0.20 PER 100 FEET.

SEWER N^o 2239
ROLL " 7549

DICKERSON AVE. 60 FT.




LENOX AVE. 60 FT.

DICKERSON AVE. 60 FT.


KERCHEVAL AVE. 80 FT.

LENOX AVE. 60 FT.

*drawn up
wrong see
BK 252 p 77*

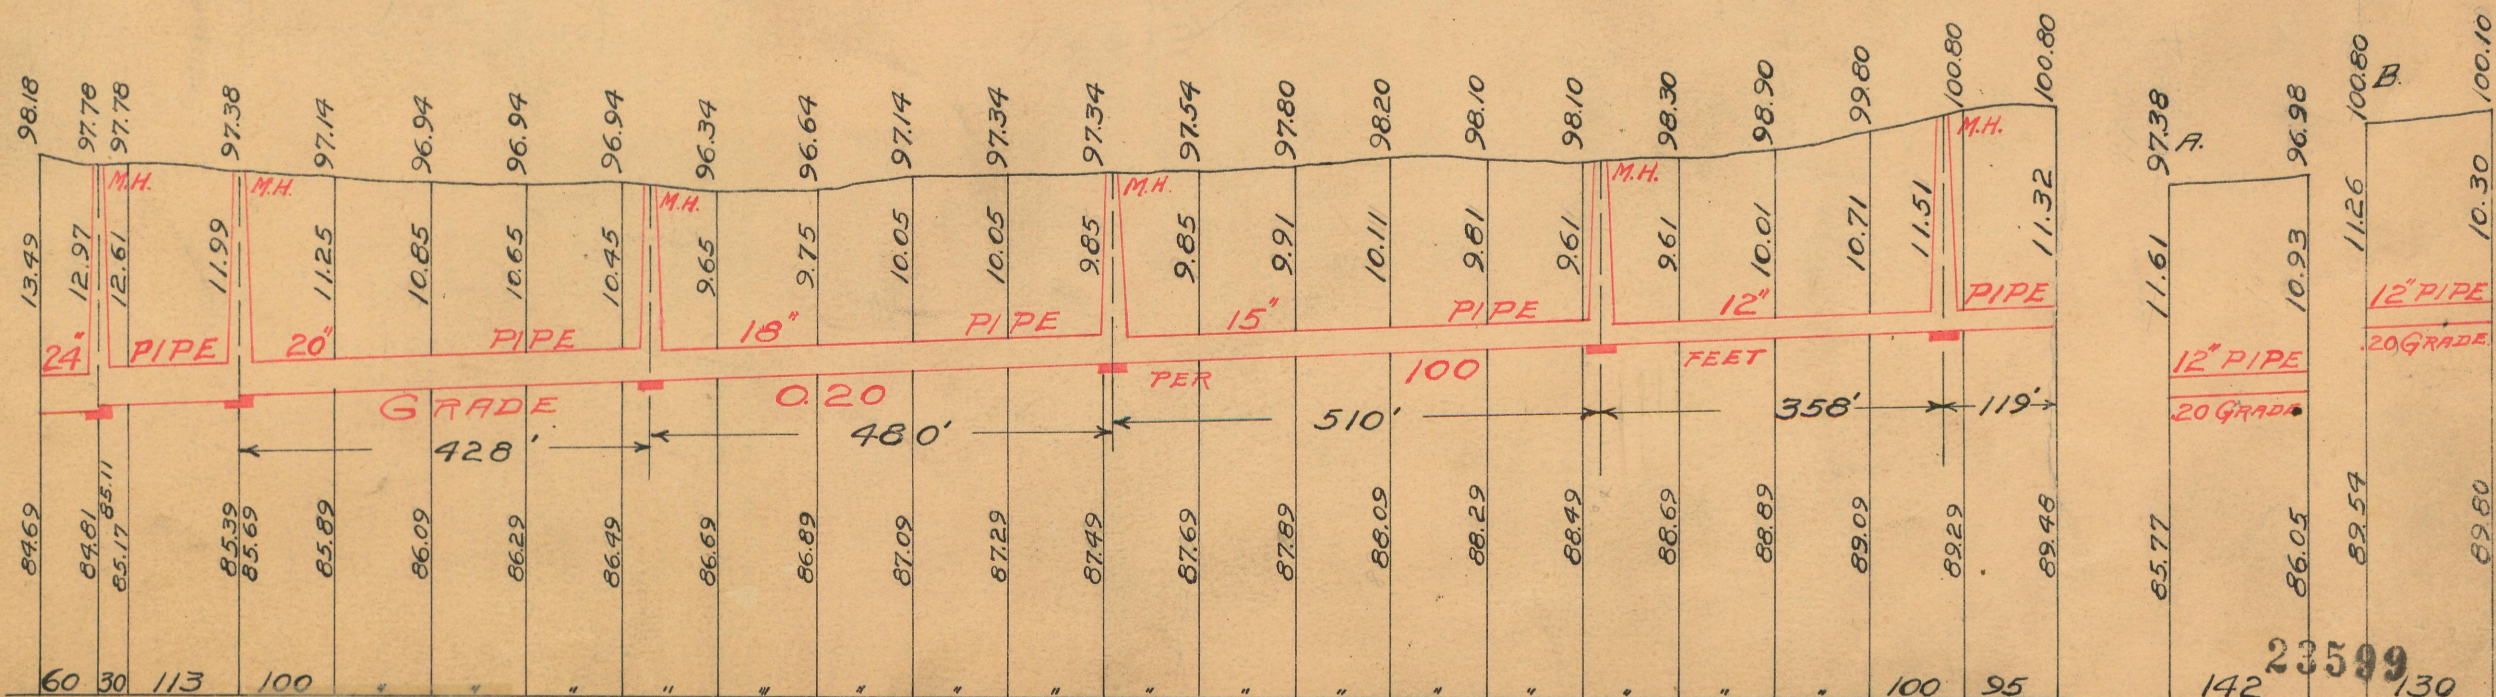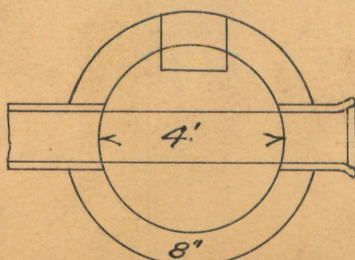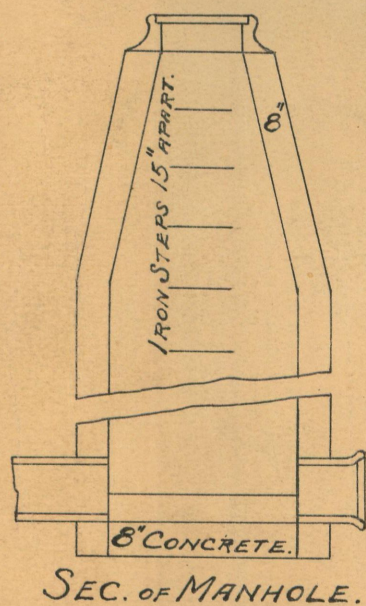



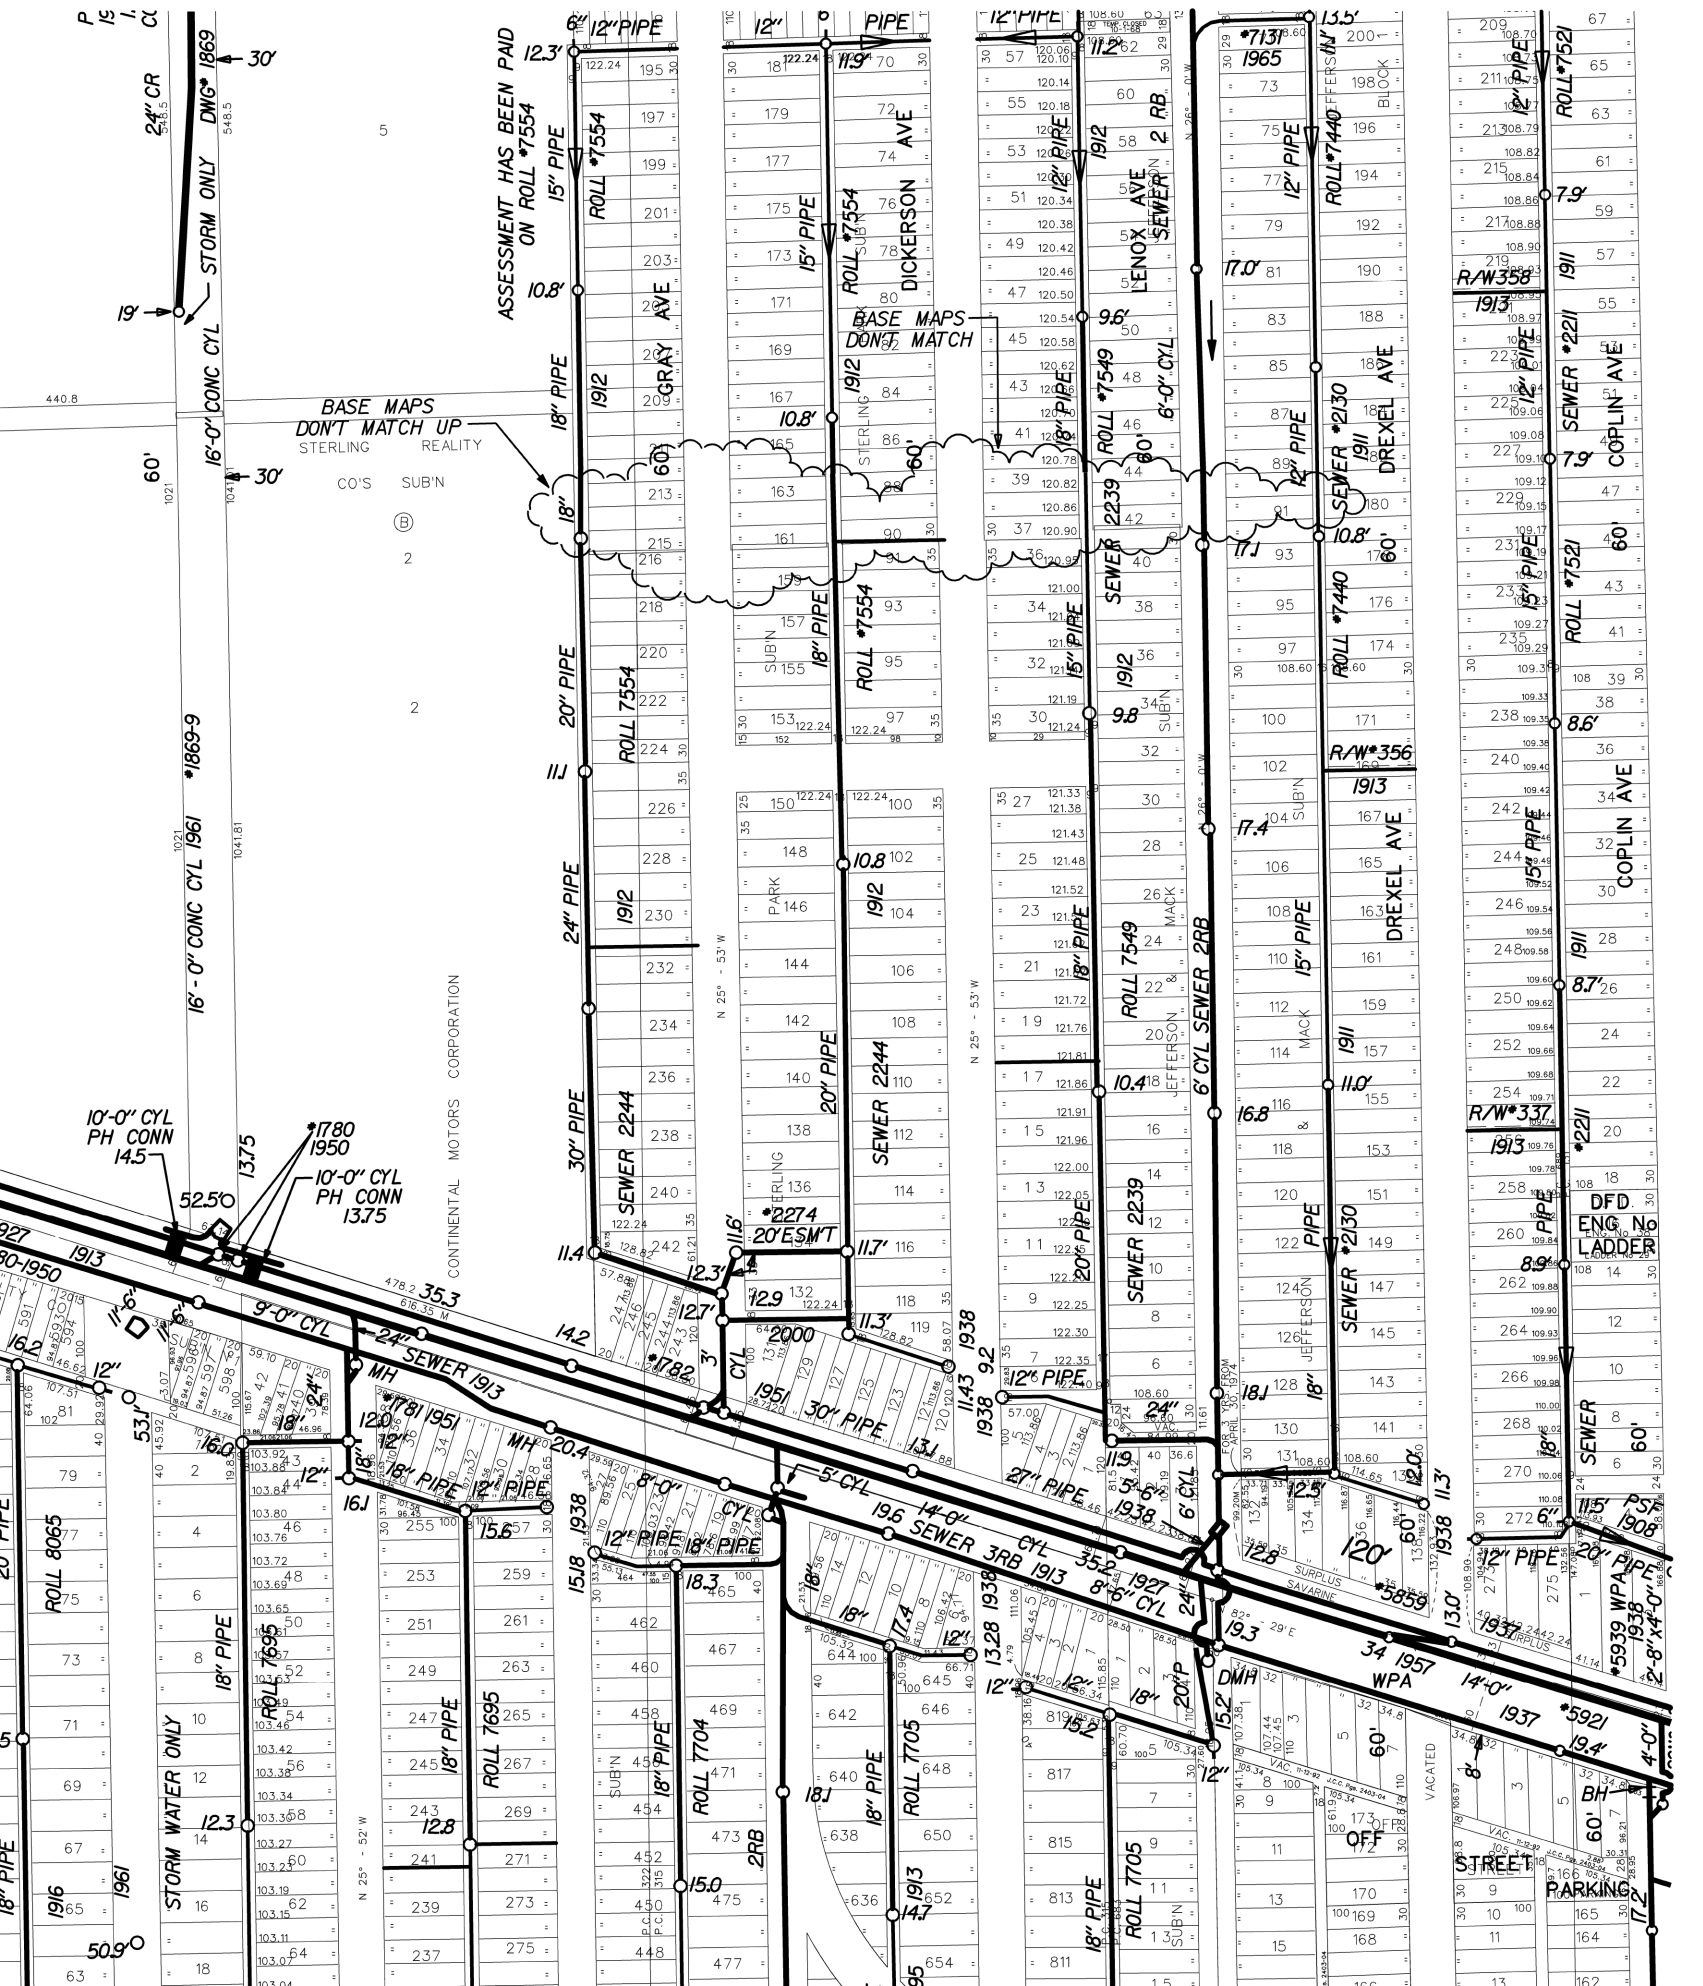



KERCHEVAL AVE. 80 FT. WD.

BROOKS AVE.
60 FT. WD.

DICKERSON AVE. 60 FT. WD.


LENOX AVE. 60 FT. WD.

JEFFERSON AVE. 120 FT. WD.



- REQUEST VACATION WITH EASEMENT

(FOR OFFICE USE ONLY)

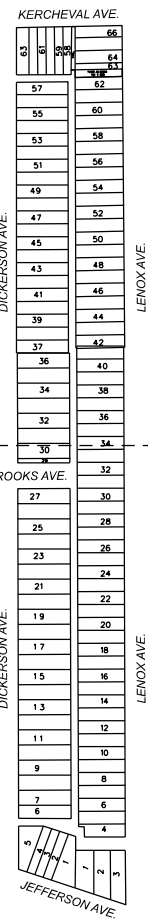

CARTO 62 C 63 D

DRAWN BY	AP	REQUEST VACATION WITH EASEMENT A PORTION OF NORTH/SOUTH AND EAST/ WEST PUBLIC ALLEY BOUNDED BY E. JEFFERSON AVE., DICKERSON AVE., BROOKS AVE., KERCHEVAL AVE., AND LENOX AVE.	CITY OF DETROIT	
DATE	05/11/2026		CITY ENGINEERING DIVISION	
CHECKED	LC		MAPS & RECORDS BUREAU	
APPROVED	GE		JOB NO. 26-43	
			DRWG. NO.	

v:\20401.100 east jefferson housing - design\Design\CADwork sheets\100 Landscape Plan.dwg

PLANT LIST: xxx
x

PERENNIALS:


SYMBOL	NO.	COMMON NAME	BOTANICAL NAME	SIZE	COST
ALL	177	LAVENDER BUBBLES ALLIUM	ALLIUM 'LAVENDER BUBBLES' PP31126	1 GAL. POT	\$2920
HYB	49	STARRY STARRY NIGHT HIBISCUS	HIBISCUS STARRY STARRY NIGHT	1 GAL. POT	\$1470

SHRUBS:

SYMBOL	NO.	COMMON NAME	BOTANICAL NAME	SIZE	COST
RED	32	ADMIRATION BARBERRY	BERBERIS THUNBERGII ADMIRATION PP16921	1 GAL. POT	\$1070
PRI	29	GOLDEN VICARY PRIVET	PHYSOCARPUS OPULIFOLIUS 'UMNHARPELL' PP30792	2 GAL. POT	\$1180
GLD	49	BOJANZA GOLD BARBERRY	BERBERIS THUNBERGII BOJANZA GOLD PP8215	1 GAL. POT	\$1720
BAY	34	NORTHERN BAYBERRY	MYRICA PENSYLVANICA	2 GAL. POT	\$2130
EUO	62	GREEN LANE EUONYMUS	EUONYMUS FORTUNEI	1 GAL. POT	\$2500

TREES:

SYMBOL	NO.	COMMON NAME	BOTANICAL NAME	SIZE	COST
TU	4	ARNOLD TULIP TREE	LIRIODENDRON TULIPIFERA 'ARNOLD'	2-1/2" CAL. B&B	\$2800
GG	9	GREEN GIANT ARBORVITAE	THUJA PLICATA 'GREEN GIANT'	7-8" HT. B&B	\$4500
OK	6	CRIMSON SPIRE OAK	QUERCUS X CRISMIDT PP9103	2-1/2" CAL. B&B	\$4900
GK	11	GOLD SPIRE GINKGO	GINKGO BILOBA 'BLAGGON'	2-1/2" CAL. B&B	\$5500
TD	9	BAID CYPRESS	TAXODIUM DISTICHUM	2-1/2" CAL. B&B	\$4050
NS	1	BLACK TUPELO	NYSSA SYLVATICA	2-1/2" CAL. B&B	\$300
TOTAL =					\$35,090

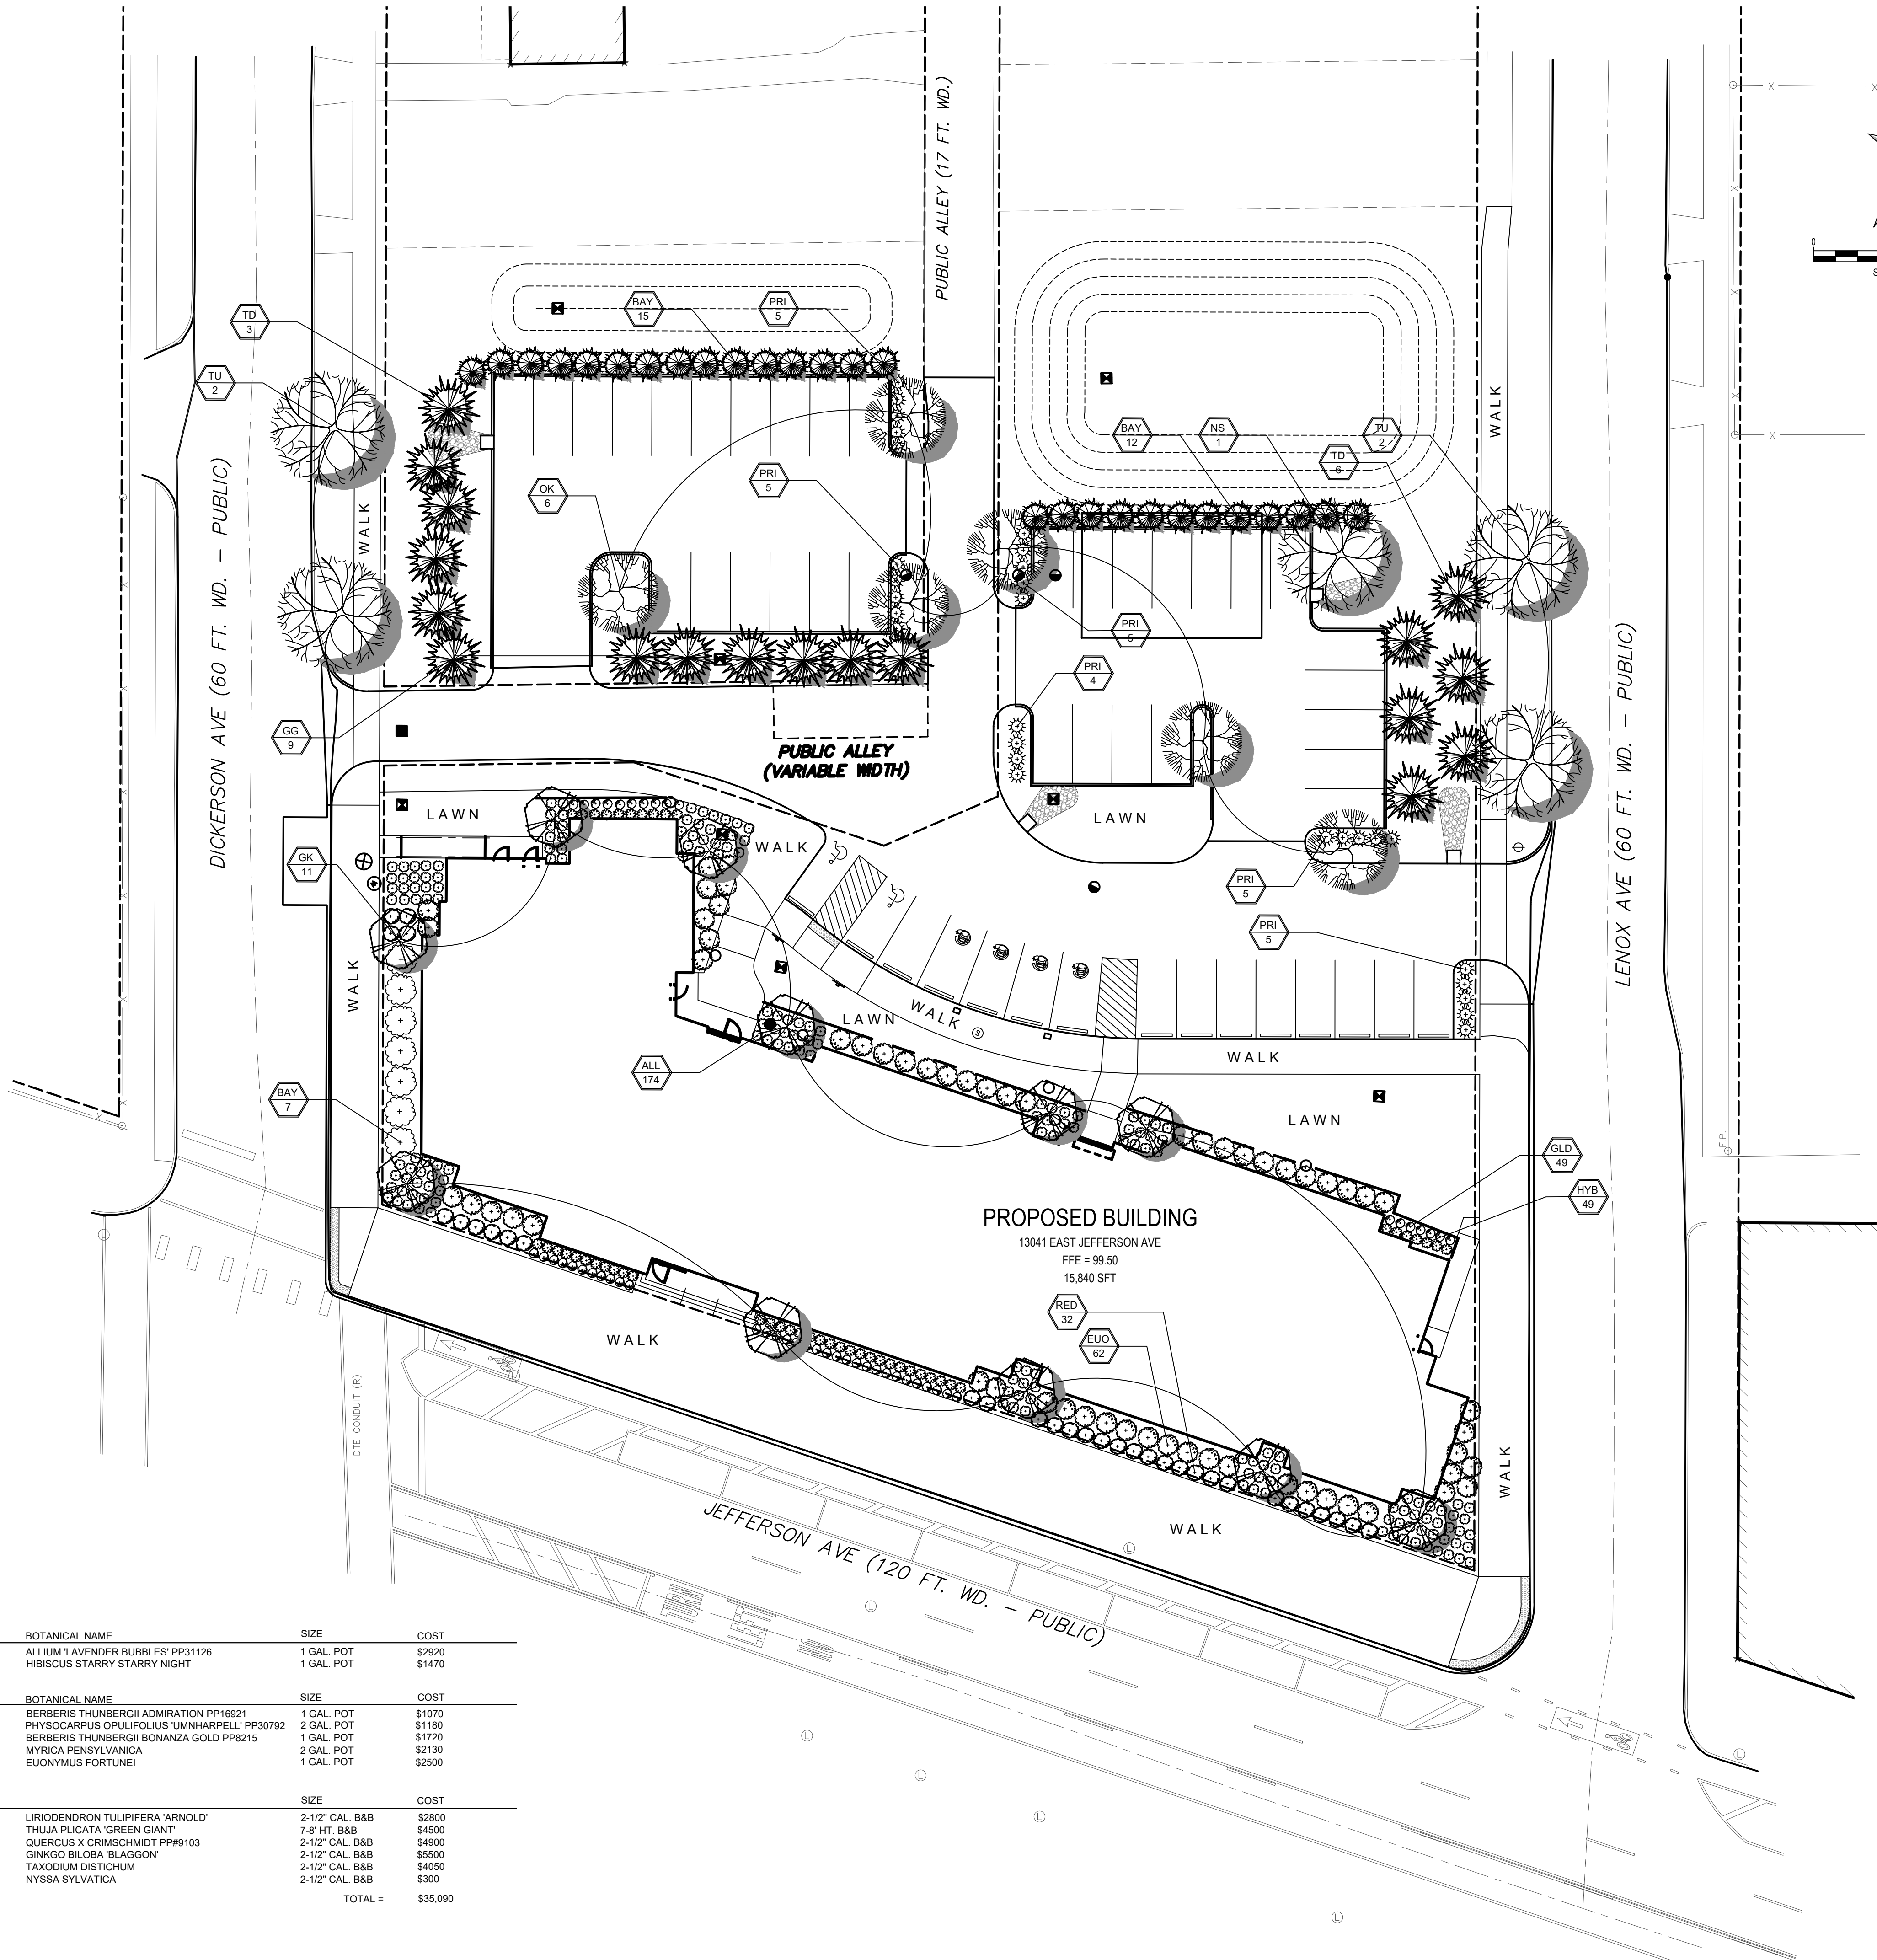

PLANT KEY

- PROPOSED DECIDUOUS TREE
- PROPOSED EVERGREEN TREE
- PROPOSED FLOWERING TREE
- PROPOSED LARGE SHRUB
- PROPOSED ORNAMENTAL SHRUB
- PROPOSED FLOWERING PERENNIALS
- PROPOSED ORNAMENTAL GRASSES
- PROPOSED COLUMNAR DECIDUOUS TREE
- PROPOSED EVERGREEN SHRUB
- EXISTING DECIDUOUS TREE

**giffels
webster**

Engineers
Surveyors
Planners
Landscape Architects

28 West Adams Road
Suite 1200
Detroit, MI 48226
p (313) 962-4442
f (313) 962-5068
www.giffelswebster.com

Executive: MD
Manager: DR
Designer: RL/SC
Quality Control: DR
Section:

Professional Seal:



Know what's below.
Call before you dig.

DATE:	ISSUE:
2023-09-08	SPR SET
2023-10-09	SPR SET
2024-10-11	80% SET

Developed For:

Hiti, DiFrancesco + Siebold

1939 West 25th Street, Suite 300
Cleveland, OH 44113

216.696.3460 x 322


LANDSCAPE
PLAN

East Jefferson Housing

Detroit
Wayne
MICHIGAN

Date: 2023-08-25
Scale: 1"=20'
Sheet: L-100
Project: 20401.100

Copyright © 2023 Giffels Webster.
No reproduction shall be made without the
prior written consent of Giffels Webster.

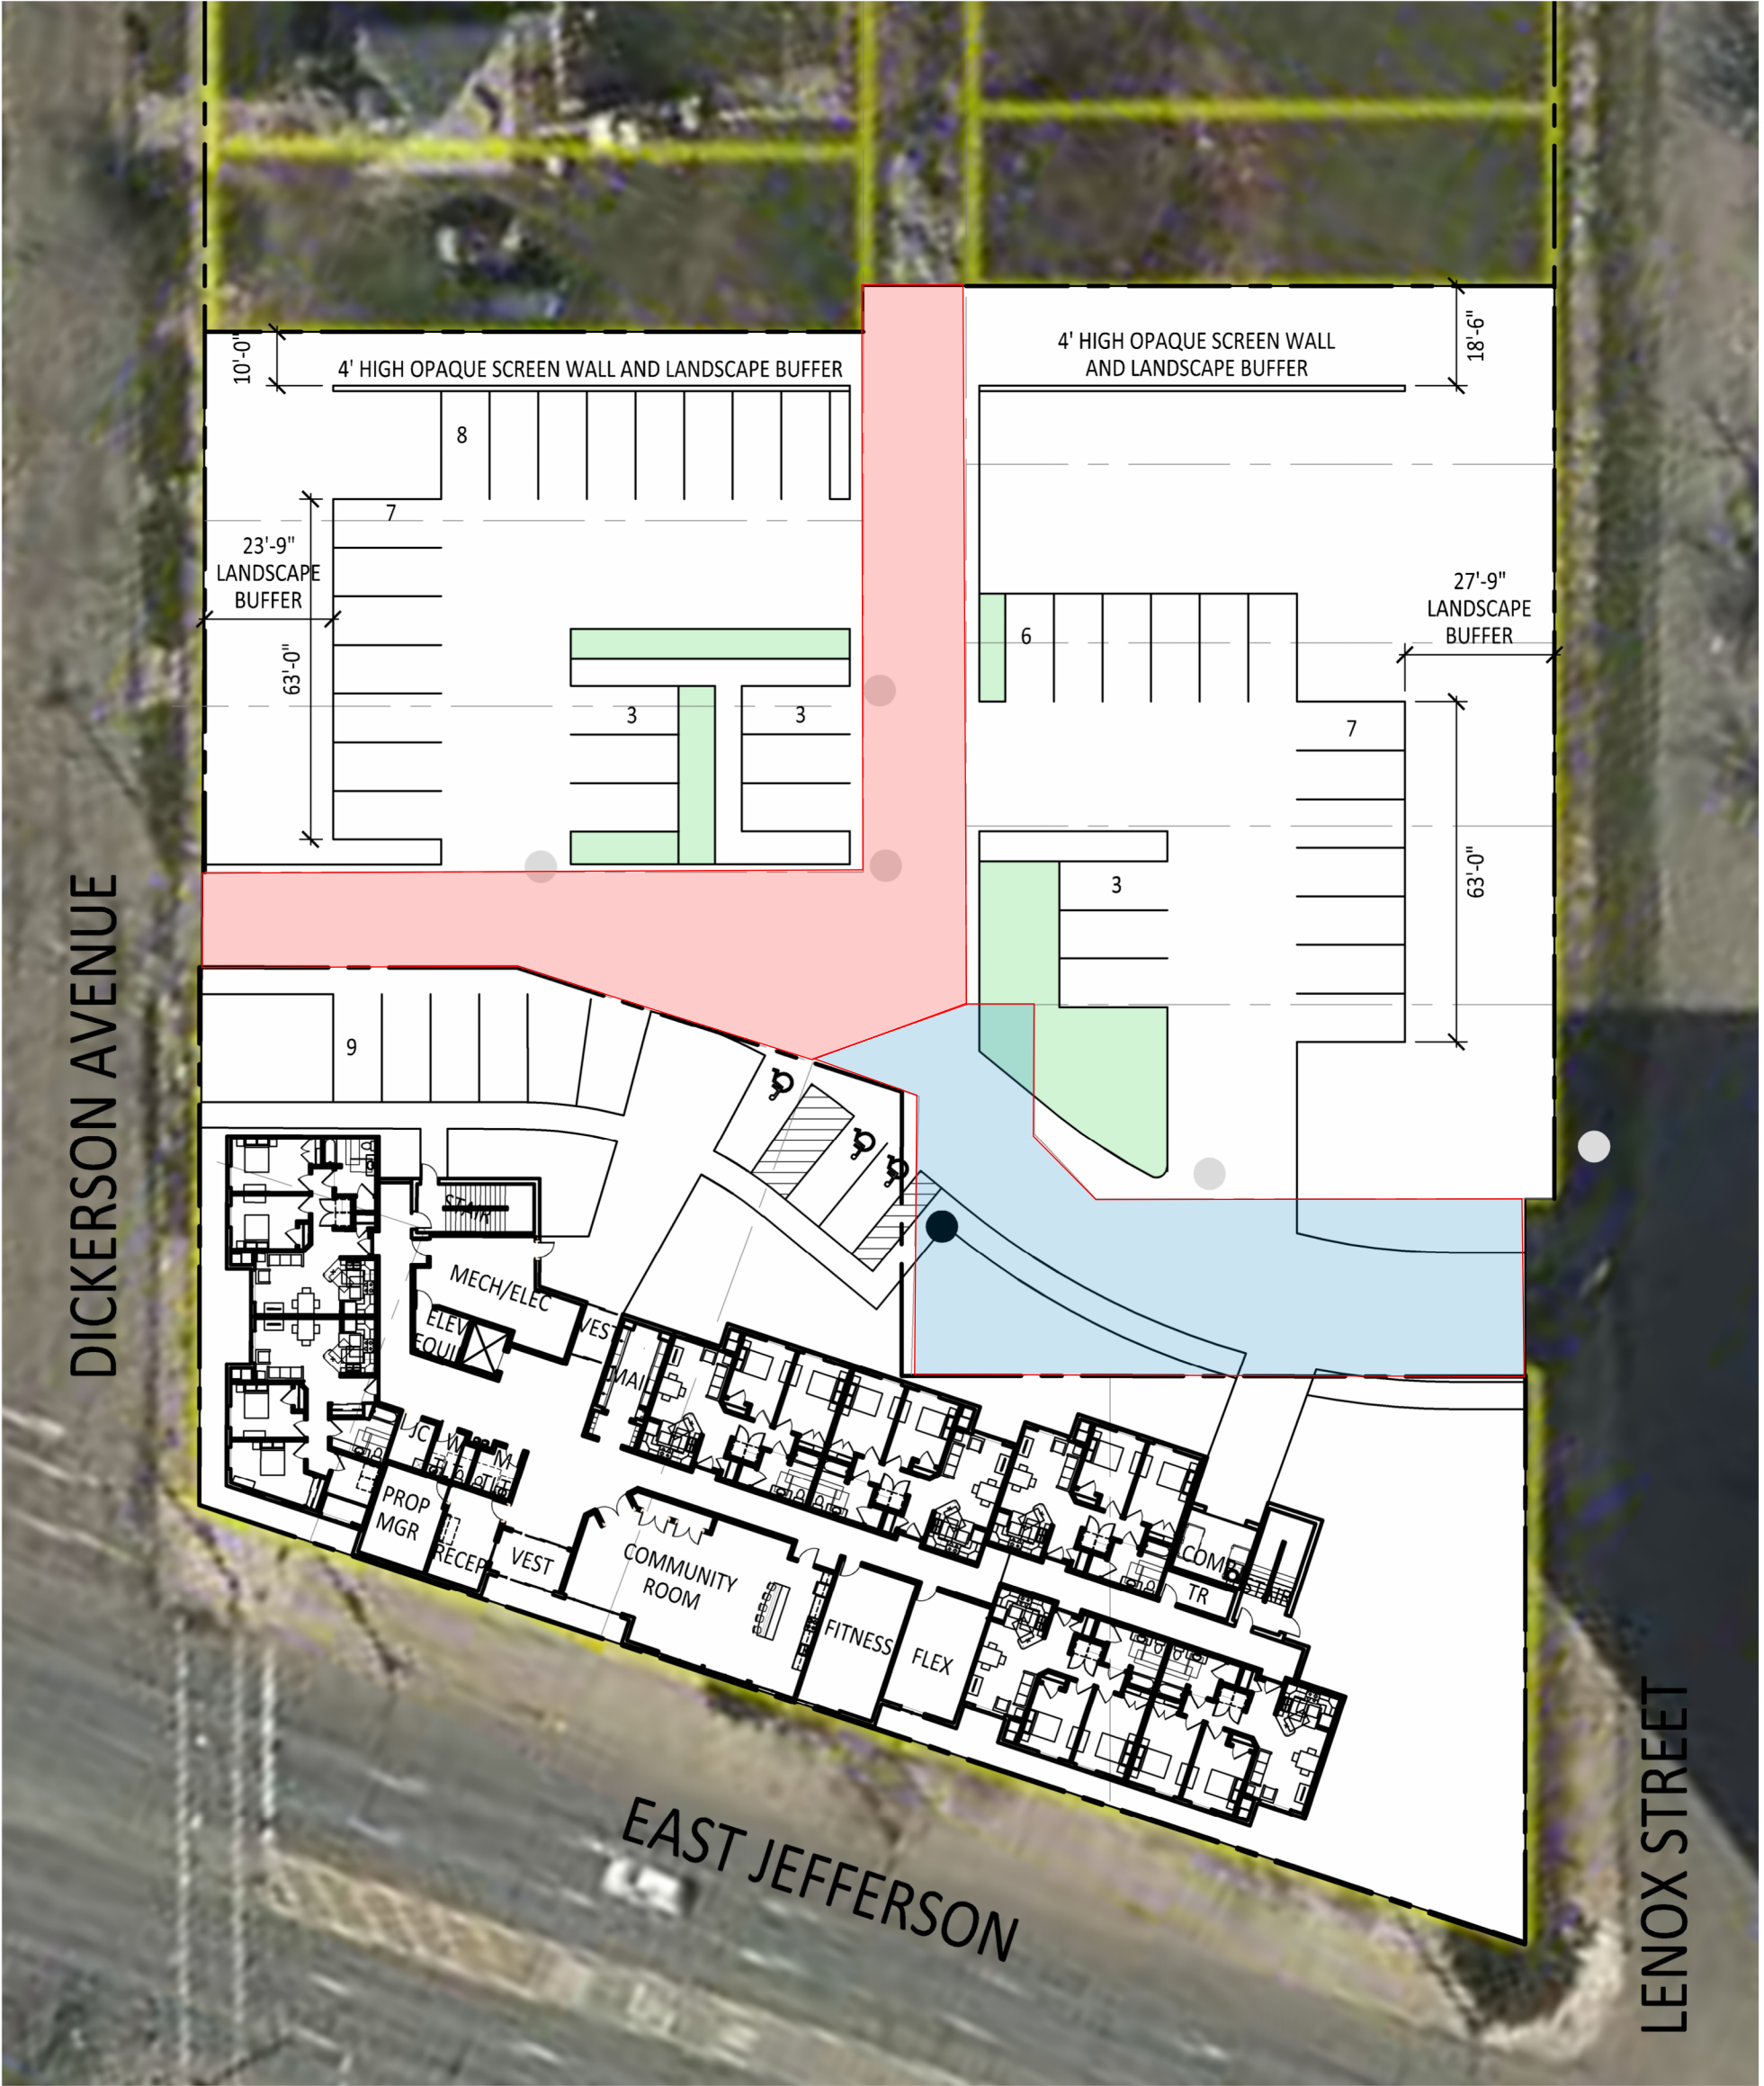

PARKING SUMMARY
0.75 PARKING SPACES PER DU
40 X 0.75 = 30 SPACES
46 PARKING SPACES PROVIDED

PARKING LANDSCAPING
46 SPACES X 18 = 828 SF
1,873 SF PROVIDED

FLOOR-TO-AREA RATIO: 2.0
B4 PARCEL = 24,878 SF
MAX AREA = 49,756 SF

AREA SUMMARY
4TH 12,747 SF
3RD 12,747 SF
2ND 12,747 SF
1ST 12,747 SF
TOT'L 50,988 SF

STAIRS AND ELEVATORS PER FLOOR
SECTION 50-14-13
572 X 4 = 2288 SF


GROSS FLOOR AREA = 48,700 SF

UNIT SUMMARY				
FLR	1BR	2BR	3BR	TOTAL
4TH	1	9	1	11
3RD	1	9	1	11
2ND	1	9	1	11
1ST	0	7	0	7
TOT'L	3	34	3	40

TMSO GLAZING
1226 SF WALL AREA (2' TO 8' ABOVE GRADE)
60% = 736 SF REQ'D
814 SF PROVIDED

TMSO WALL MATERIALS
9546 SF ELEVATION AREA
2736 SF GLAZING
6810 SF WALL LESS DOORS/WINDOWS
3,222 SF - MASONRY
3,588 SF - COMPOSITE METAL PANEL

SITE PLAN OPTION 6

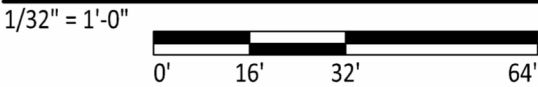


AS
7
EAST JEFFERSON

1325 EAST JEFFERSON AVENUE, DETROIT, MICHIGAN

CHN HOUSING PARTNERS
TRIBE DEVELOPMENT

Hiti, DiFrancesco and Siebold, Inc.
JUNE 12, 2023

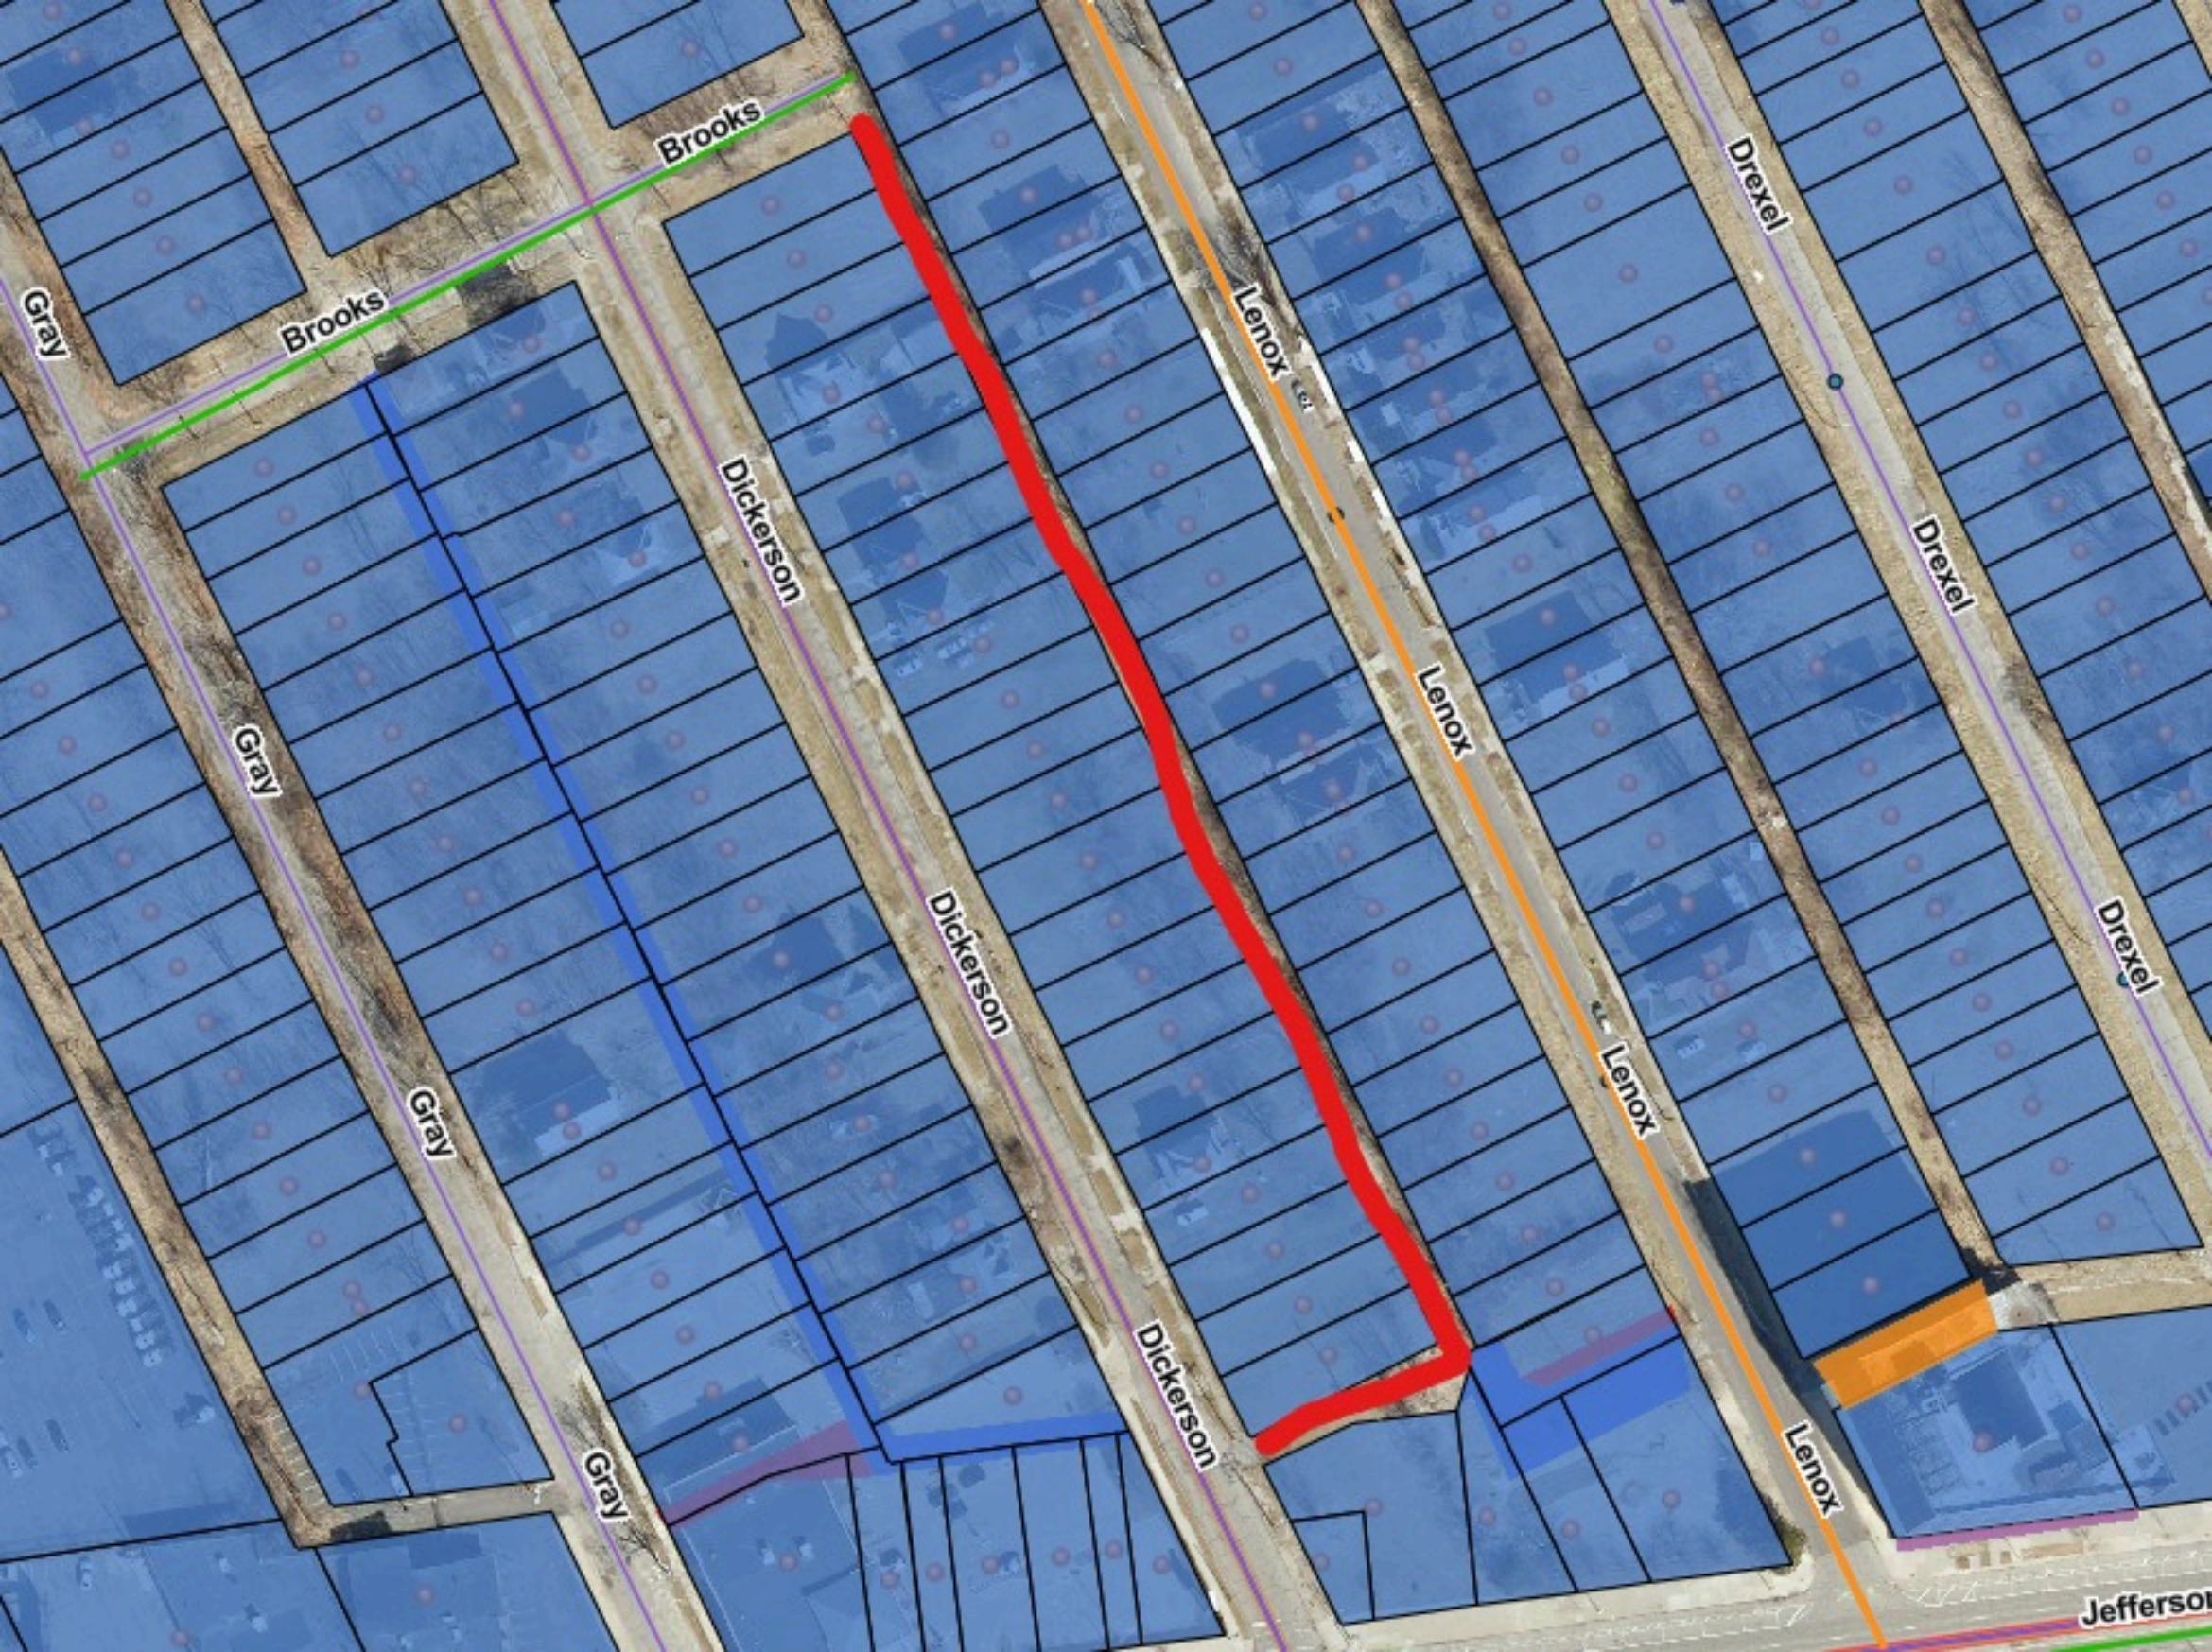



Proposed Vacation



City of Detroit
Department of Public Works
City Engineering Division

COLEMAN A. YOUNG MUNICIPAL CENTER
2 Woodward Ave. Suite 601
Detroit, Michigan 48226
Phone: (313) 224-3949 TTY: 711
www.detroitmi.gov

WRITTEN ACCEPTANCE OF THE TERMS AND CONDITIONS OF
DETROIT CITY COUNCIL RESOLUTION
PETITION NUMBER MAP-26-43 , ADOPTED

CHN.TRIBE Jefferson LDHA LP

_____, whose address is

3711 Chester Ave., Suite 100, Cleveland, OH 44114 _____, (hereinafter referred to as the "Permittee") do hereby accept the terms and conditions of the City Council Resolution granting Petition Number _____, and agrees to comply with its requirements; and further, that pursuant to the said Resolution, Permittee does hereby agree to defend, indemnify and save harmless the City of Detroit from any and all claims, liabilities, obligations, penalties, costs, charges, demands, losses, damages, or expenses (including without limitation, fees, and expenses of attorneys, expert witness and other consultants) that may be imposed upon, incurred by or asserted against the City of Detroit or its departments, officers, employees, or agents by reason of the issuance of said permit(s), or the performance or non-performance by the Permittee of the terms of the permit(s) hereof, or that may rise out of its activities described in said Resolution by Permittee and its personnel, agents, representatives and employees.

Permittee agrees to waive, release and discharge the City of Detroit or its departments, officers, employees, or agents from any and all liability, claims, demands, and causes of action whatsoever, legal and equitable, because of damages, losses, or injuries to Permittee or Permittee's property or both, arising from or related to Permittee's activities described in said Resolution. Permittee agrees and covenants not to sue the City of Detroit or its departments, officers, employees, or agents, and to refrain from instituting, continuing, presenting, subrogating, collecting or in any way aiding or proceeding upon any claims, judgments, debts, causes of action, suits and proceedings of any kind at law or in equity arising from or related to Permittee's activities described in said Resolution.

Date May 21 _____, 2026

Permittee Signature: _____

Mark E. Whipkey, CAM of CHN Housing Partners,
Managing Member of GP, CHN.TRIBE Jefferson, LLC.

Detroit Land Bank Authority Parcel Ownership

Parcel #	Owner	Address	City	Zip
21050173	DETROIT LAND BANK AUTHORITY	1059 LENOX ST	Detroit	48215
21050172	DETROIT LAND BANK AUTHORITY	1065 LENOX ST	Detroit	48215
21050171	DETROIT LAND BANK AUTHORITY	1071 LENOX ST	Detroit	48215
21050170	DETROIT LAND BANK AUTHORITY	1081 LENOX ST	Detroit	48215
21050169	DETROIT LAND BANK AUTHORITY	1091 LENOX ST	Detroit	48215
21050165	DETROIT LAND BANK AUTHORITY	1115 LENOX ST	Detroit	48215
21050164	DETROIT LAND BANK AUTHORITY	1119 LENOX ST	Detroit	48215
21050158	DETROIT LAND BANK AUTHORITY	1155 LENOX ST	Detroit	48215
21050157	DETROIT LAND BANK AUTHORITY	1161 LENOX ST	Detroit	48215
21048923	DETROIT LAND BANK AUTHORITY	1166 DICKERSON ST	Detroit	48215
21050156	DETROIT LAND BANK AUTHORITY	1167 LENOX ST	Detroit	48215
21048924	DETROIT LAND BANK AUTHORITY	1174 DICKERSON ST	Detroit	48215
21048925	DETROIT LAND BANK AUTHORITY	1186 DICKERSON ST	Detroit	48215
21050154	DETROIT LAND BANK AUTHORITY	1187 LENOX ST	Detroit	48215
21048926	DETROIT LAND BANK AUTHORITY	1194 DICKERSON ST	Detroit	48215
21050153	DETROIT LAND BANK AUTHORITY	1195 LENOX ST	Detroit	48215
21048927	DETROIT LAND BANK AUTHORITY	1200 DICKERSON ST	Detroit	48215
21048929	DETROIT LAND BANK AUTHORITY	1212 DICKERSON ST	Detroit	48215
21048936	DETROIT LAND BANK AUTHORITY	1260 DICKERSON ST	Detroit	48215
21048937	DETROIT LAND BANK AUTHORITY	1266 DICKERSON ST	Detroit	48215
21048938	DETROIT LAND BANK AUTHORITY	1274 DICKERSON ST	Detroit	48215
21048939	DETROIT LAND BANK AUTHORITY	1506 DICKERSON ST	Detroit	48215

CHN.TRIBE Jefferson Limited Dividend Housing Association Limited Partnership Parcel Ownership

Parcel #	Owner	Address
21050178	CHN.TRIBE Jefferson Limited Dividend Housing Association Limited Partnership	1011 LENOX ST
21050177	CHN.TRIBE Jefferson Limited Dividend Housing Association Limited Partnership	1035 LENOX ST
21050176	CHN.TRIBE Jefferson Limited Dividend Housing Association Limited Partnership	1041 LENOX ST
21050175	CHN.TRIBE Jefferson Limited Dividend Housing Association Limited Partnership	1047 LENOX ST
21050174	CHN.TRIBE Jefferson Limited Dividend Housing Association Limited Partnership	1053 LENOX ST
21048917	CHN.TRIBE Jefferson Limited Dividend Housing Association Limited Partnership	1126 DICKERSON ST
21048918	CHN.TRIBE Jefferson Limited Dividend Housing Association Limited Partnership	1132 DICKERSON ST
21048919	CHN.TRIBE Jefferson Limited Dividend Housing Association Limited Partnership	1138 DICKERSON ST
21000567	CHN.TRIBE Jefferson Limited Dividend Housing Association Limited Partnership	13011 E JEFFERSON AVE
21000566	CHN.TRIBE Jefferson Limited Dividend Housing Association Limited Partnership	13003 E JEFFERSON AVE
21000568	CHN.TRIBE Jefferson Limited Dividend Housing Association Limited Partnership	13025 E JEFFERSON AVE
21000569	CHN.TRIBE Jefferson Limited Dividend Housing Association Limited Partnership	13035 E JEFFERSON AVE
21000570	CHN.TRIBE Jefferson Limited Dividend Housing Association Limited Partnership	13041 E JEFFERSON AVE

p



City of Detroit Department of Public Works

Coleman A. Young Municipal Center 2 Woodward Avenue, Suite 600 Detroit, Michigan 48226

**RE: Letter of Support for Alley Vacation Petition
Jefferson Avenue Apartments
13041 E. Jefferson Avenue**

To Whom It May Concern:

The Detroit Land Bank Authority ("DLBA") writes in support of the petition to vacate the public alley located between Dickerson and Lenox Streets, with a north boundary of Brooks St. as requested by CHN.TRIBE Jefferson Limited Dividend Housing Association Limited Partnership for the Jefferson Avenue Apartments project. The project is currently under construction having received all required permits and City entitlements. The DLBA maintains ownership of 22 vacant lots adjacent to the referenced alley (details included as addendum).

The DLBA supports this alley vacation for the following reasons:

1. Enhanced Site Security

The vacation of this alley will enable the property owner to install perimeter fencing around the Jefferson Avenue Apartments site. This enhanced security measure will protect residents, reduce unauthorized access, and contribute to a safer living environment for the community.

2. Preservation of Utility Access

The property owner has confirmed they will not seek ownership of the vacated alley but rather requests vacation with a permanent easement reserved for public utilities. This approach ensures that essential utility providers maintain uninterrupted access for maintenance and service while addressing the security needs of the development.

The Jefferson Avenue Apartments project represents an important investment in Detroit's housing stock, and this alley vacation is a reasonable measure that supports both the project's success and the public interest.

The DLBA respectfully requests favorable consideration of this alley vacation petition.

Sincerely,

A handwritten signature in black ink, appearing to read "Jeanne Hanna", is written over a horizontal line.

Jeanne Hanna
Director, Real Estate, Sales, and Marketing
Detroit Land Bank Authority

City of Detroit

PUBLIC WORKS DEPARTMENT: CITY ENGINEERING DIVISION

Coleman A. Young Municipal Center - 6th Floor

We, the undersigned individuals owning property adjacent to the proposed right-of-way to be vacated have no objections to the request of the petitioner. This petition requires consent by 2/3 of the adjacent owners in residential areas. Commercial areas require 100% of adjacent owners to consent. Properties owned by a business or other entity must be signed by an authorized agent in order to be counted in this petition.

By signing this petition the property owner is confirming awareness of the following changes to their property:

- (1) Vacating the proposed street or alley will result in the property owner being allocated ownership of ½ of the street or alley (conditional to the design of the subdivision) and will cause the property assessment to be adjusted to include the increase in square footage.
- (2) Drainage fees to the property will be adjusted based on any added impervious surfaces added to the property. Please contact the Department of Water and Sewage for additional questions regarding rates.
- (3) Garages orientated toward the alley may no longer be accessible by the alley. Upon approval of this petition the alley will no longer be considered public. The property owner waves their right to access their property using the alley.

Commercial properties are subject to the conditions of their land use grant. Which may require permission from the Buildings and Safety Engineering and Environment Department or the Board of Zoning Appeals prior to changing the limits of their property.

PRINT NAME / ADDRESS / DATE SIGNED

TONY L ALLEN 1254 DICKERSON 48213
+ 1298 Dickerson

SIGNATURE

Tony L Allen

PRINT NAME / ADDRESS / DATE SIGNED

SIGNATURE
