
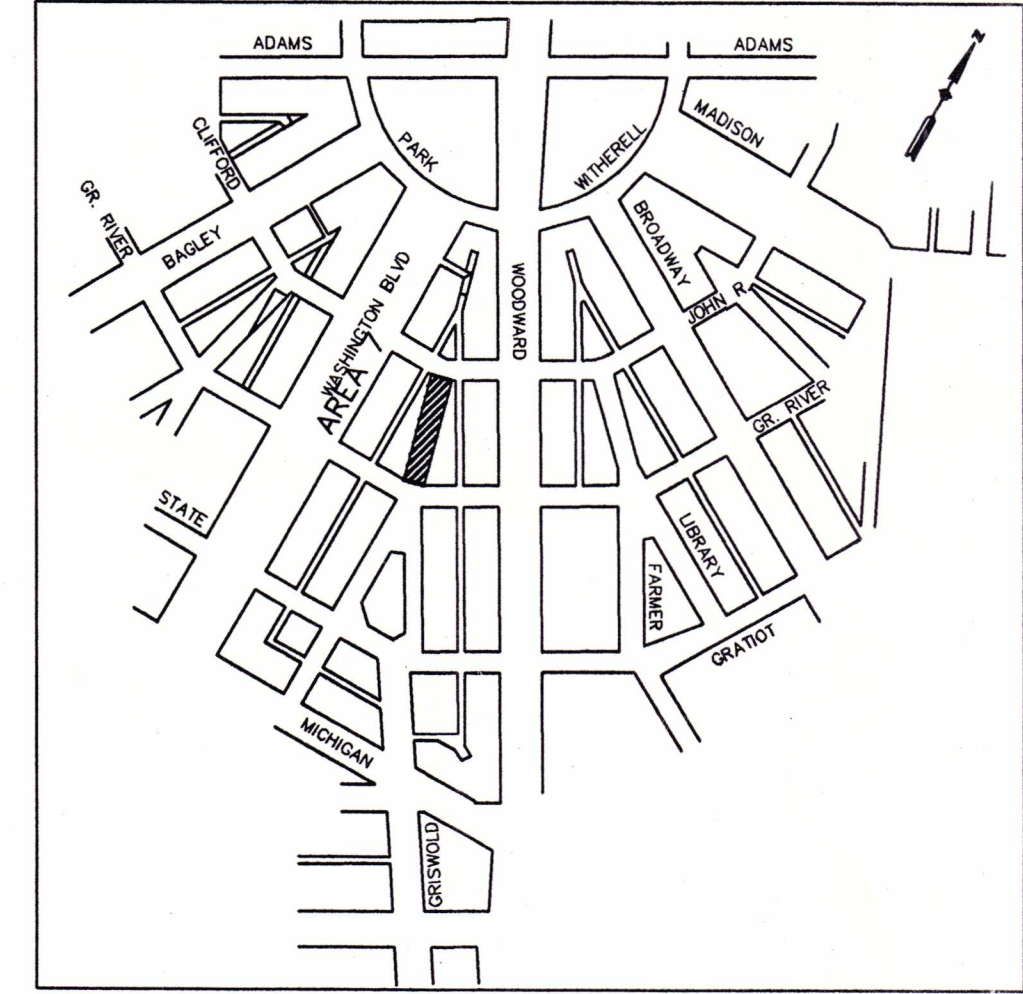


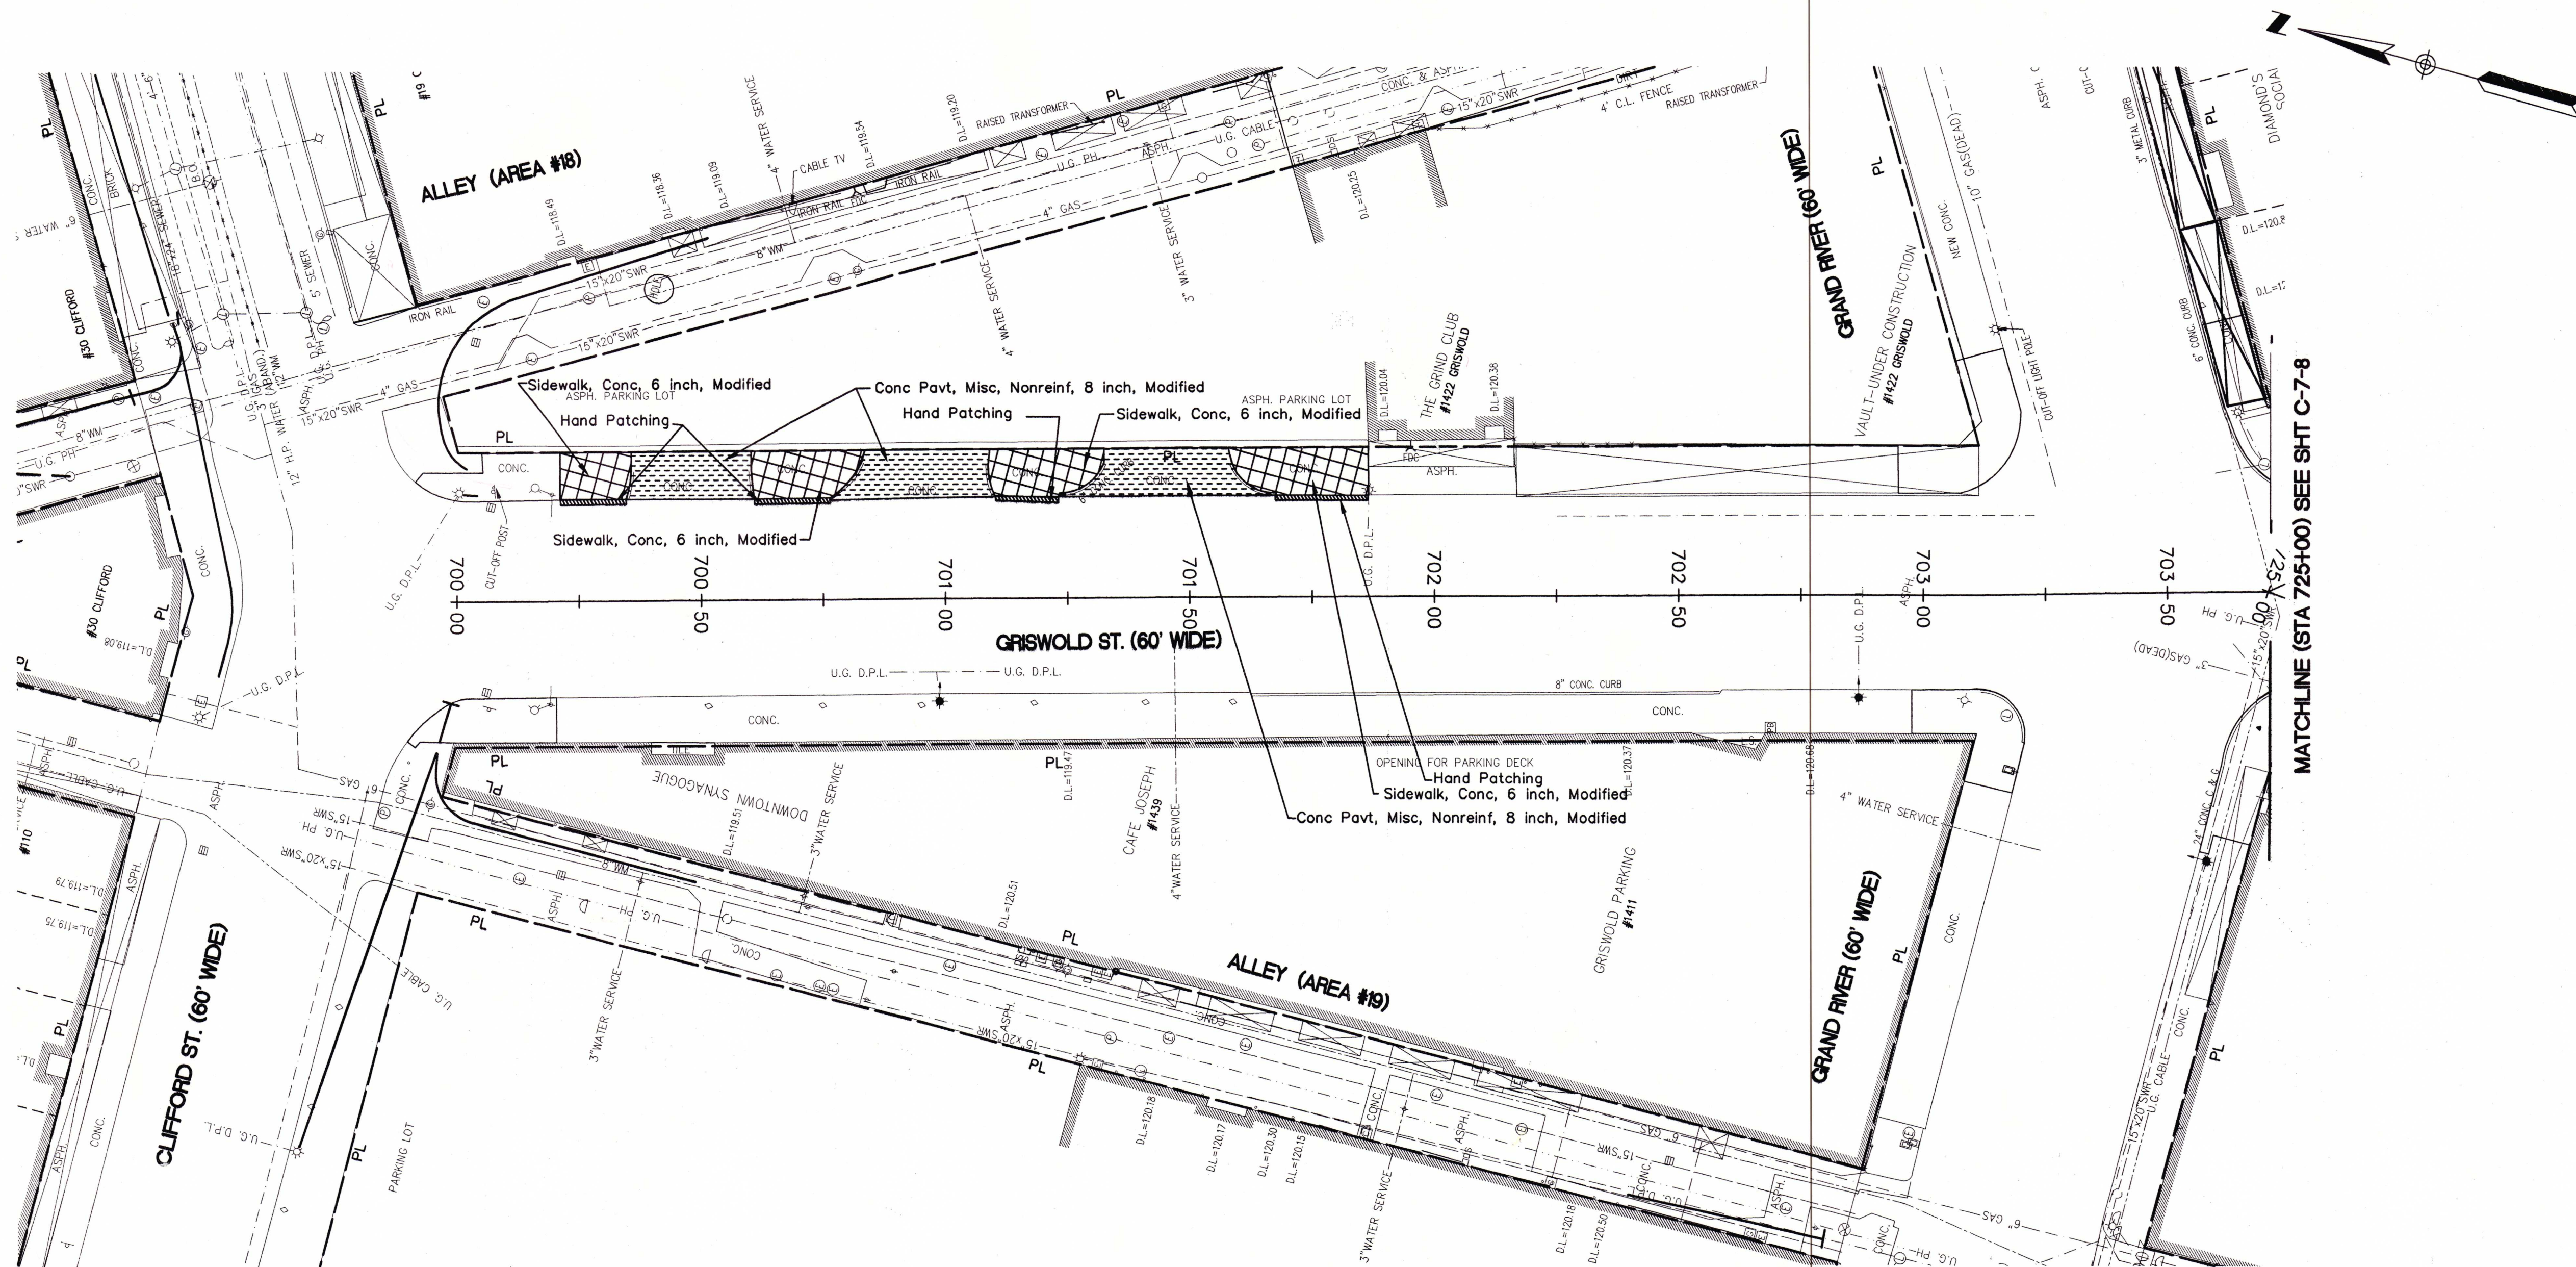

- CONSTRUCTION LEGEND**
- Sidewalk, Conc, 4 inch, Modified
 - Sidewalk, Conc, 6 inch, Modified
 - Integral Curb and Sidewalk, Conc, 4 inch, Modified
 - Integral Curb and Sidewalk, Conc, 6 inch, Modified
 - Integral Curb and Sidewalk, 2 Feet, Modified
 - Conc Pavt, Misc, Nonrein, 8 inch
 - Hand Patching
 - Brick Paving, Modified
 - LIMITS OF CONSTRUCTION ON CROSS STREET
 - PROPERTY LINE

NOTE:
FOR SIDEWALK CONSTRUCTION OVER
VAULTS DETAILS SEE SHT # X-1.

NON PARTICIPATING QUANTITIES, THIS SHEET		
PAY ITEM	UNIT	QUANTITY
Integral Curb and Sidewalk, 2 Feet, Modified	Ft	-
Sidewalk, Conc, 4 inch, Modified	Sft	-
Sidewalk, Conc, 6 inch, Modified	Sft	783
Conc Pavt, Misc, Nonrein, 8 inch, Modified	Syd	85
Hand Patching	Ton	1

AS-BUILT

**3 WORKING DAYS
BEFORE YOU DIG
CALL MISS DIG.
1-800-482-7171**

For the location of public utility lines

F E D C B A					DRAWN BY: MW	LOWER WOODWARD CROSS STREETS IMPROVEMENTS CITY OF DETROIT - DOWNTOWN DEVELOPMENT AUTHORITY	CONSTRUCTION PLAN GRISWOLD (EAST + WEST) - CLIFFORD TO MATCHLINE "D-D"	SCALE: 1"=20'	DATE: 08-28-08
					DESIGNED BY: KD				
					CHECKED BY: MH				
					APPROVED BY: MH				
DESCRIPTION		CHKD	APPRD	DATE					
REVISIONS									

220 W. CONGRESS, SUITE 400
DETROIT, MI 48226
PHONE: (313) 967-4700
FAX: (313) 967-4707
www.hamiltonanderson.com

480 Ford Field, 2000 Brush Street
DETROIT, MI 48226
PHONE: (313) 237-3900
FAX: (313) 237-3909
www.nthconsultants.com

16580 Wyoming Avenue,
DETROIT, MI 48221-2882
PHONE: (313) 341-5797
FAX: (313) 341-0205
www.consulteng.com

20349 Alderton Street, Suite 200
DETROIT, MI 48219-9550
PHONE: (313) 434-8282
FAX: (313) 537-7945
www.urbanengineeringolutions.com

MANSELL Monnell Associates, INC.
33608 Grand River
Farmington, MI 48335
PHONE: (248) 473-7070
FAX: (248) 473-8190

CITY OF DETROIT
DOWNTOWN DEVELOPMENT AUTHORITY

500 Griswold, Suite 2200,
Detroit, MI 48228
P: (313) 963-2940
F: (313) 963-8893

SECTION MAP					TOWN					RANGE					SECTION					PORTION CODE				
- - - - -					- - - - -					- - - - -					- - - - -					- - - - -				

M.D.P.H./D.N.R. PERMIT NO.

REF. NO. **DE06001.OT**

CONTRACT NO.

FILE NO.

DRAWING NO. **C-7-7**

BASE BID