COYLE AVE. 60' WD.

FROM N.L. TIREMAN TO S.L. JOY RD.

PAVED - CLASS "B" - 8" MAC. + 2½" OIL AGG. - 1939

WATER MAINS OK 9-28-38

Class "B" paving

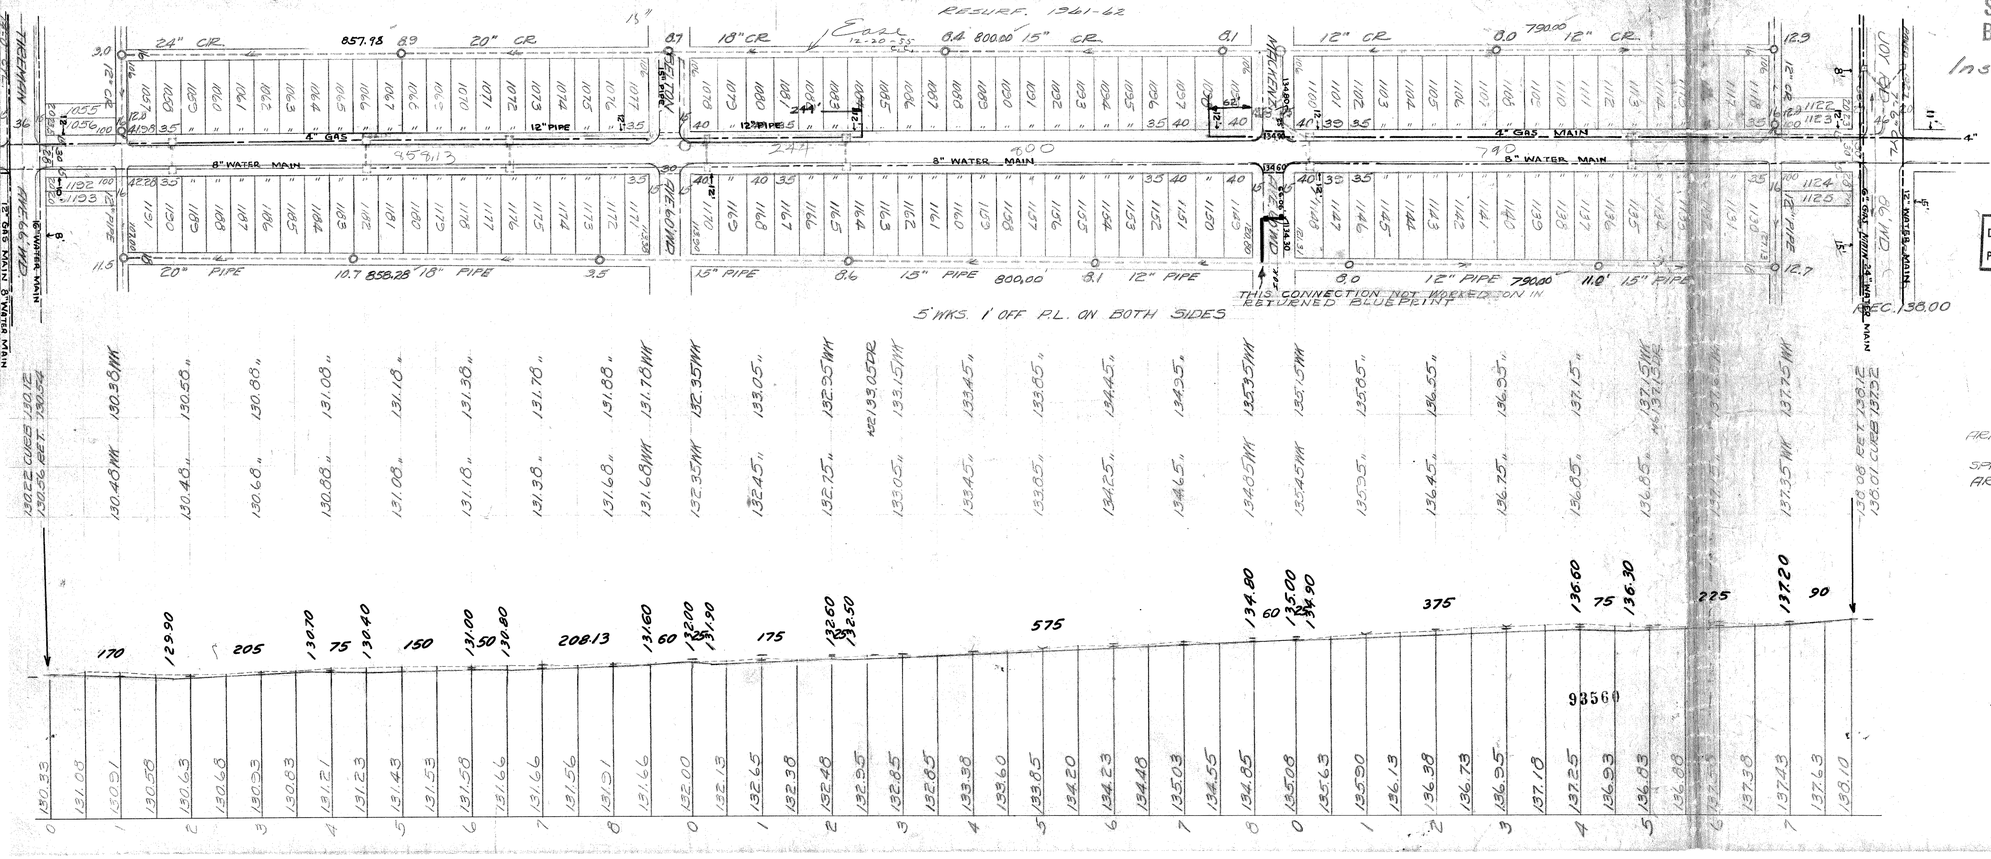

SUMP MANHOLE BASINS BY W.P.A.

Installed 5-3-38

DEPARTMENT OF PUBLIC WORKS

CITY ENGINEER'S OFFICE

DETROIT, MICH.

INDEXED

SCALE: HOR. 1" - 100 / VER. 1" - 10	DATE 1-15-32
PLAN DRAWN BY	J. Cerulla
PLAN CHECKED BY	W. Cathcart
PROFILE DRAWN BY	J. Cerulla
COMPUTATIONS MADE BY	
" CHECKED BY	
GRADE ESTABLISHED BY	V.G. 1-8-38

996 45	LOTS	CITY
Excavation		
R. C. Straight		
Ctl Curb Reset		
R. C. Ind. Cycles by Distr.		
Paving		
" Concrete Base		
Curb Concrete		
Pot. Stone		
Concr. Header Sq. Yds.		

LOTS	"	4 832	26	½	"	2 416	13
CITY	"	304		½	"	152	-
TOTAL	"	5 136	26		"	2 568	13

DRAINAGE COMPLETED.....

PAVING COMPLETED.....-1938

SEWER REC.
BOOK 4 PAGE 81
CHK'D. BY J. Liepak O.K.

BENCH MARKS

ARROW	ON	HYD.	N.E.	COR.	OF COYLE	& TIREMAN	133.53
"	"	"	N.E.	"	"	" BELTON	135.54
SPK.	IN	L. POLE	S.W.	"	"	" MACKENZIE	136.00
ARROW	ON	HYD.	N.E.	"	"	" JOY RD.	140.89

DESIGNED BY	V. Guillemetz	APPROVED
DRAWN BY	J. Cerulla	W. J. Wallace ENGINEER OF STREETS
TRACED BY		
CHECKED BY	V. Guillemetz	Martin R. Fisher ASS'T CITY ENGINEER