WPA-1060-1936-37

#69

GRANDMONT AVE. 60' WD.

FROM N.L. W. CHICAGO TO S.C. PLYMOUTH

~~CLASS "A" 6" One Co. Concrete~~ 30' WD.

6" BASE WINTER CONSTR. - 2" OIL AGGR. LATER.

SERIES "P-P"

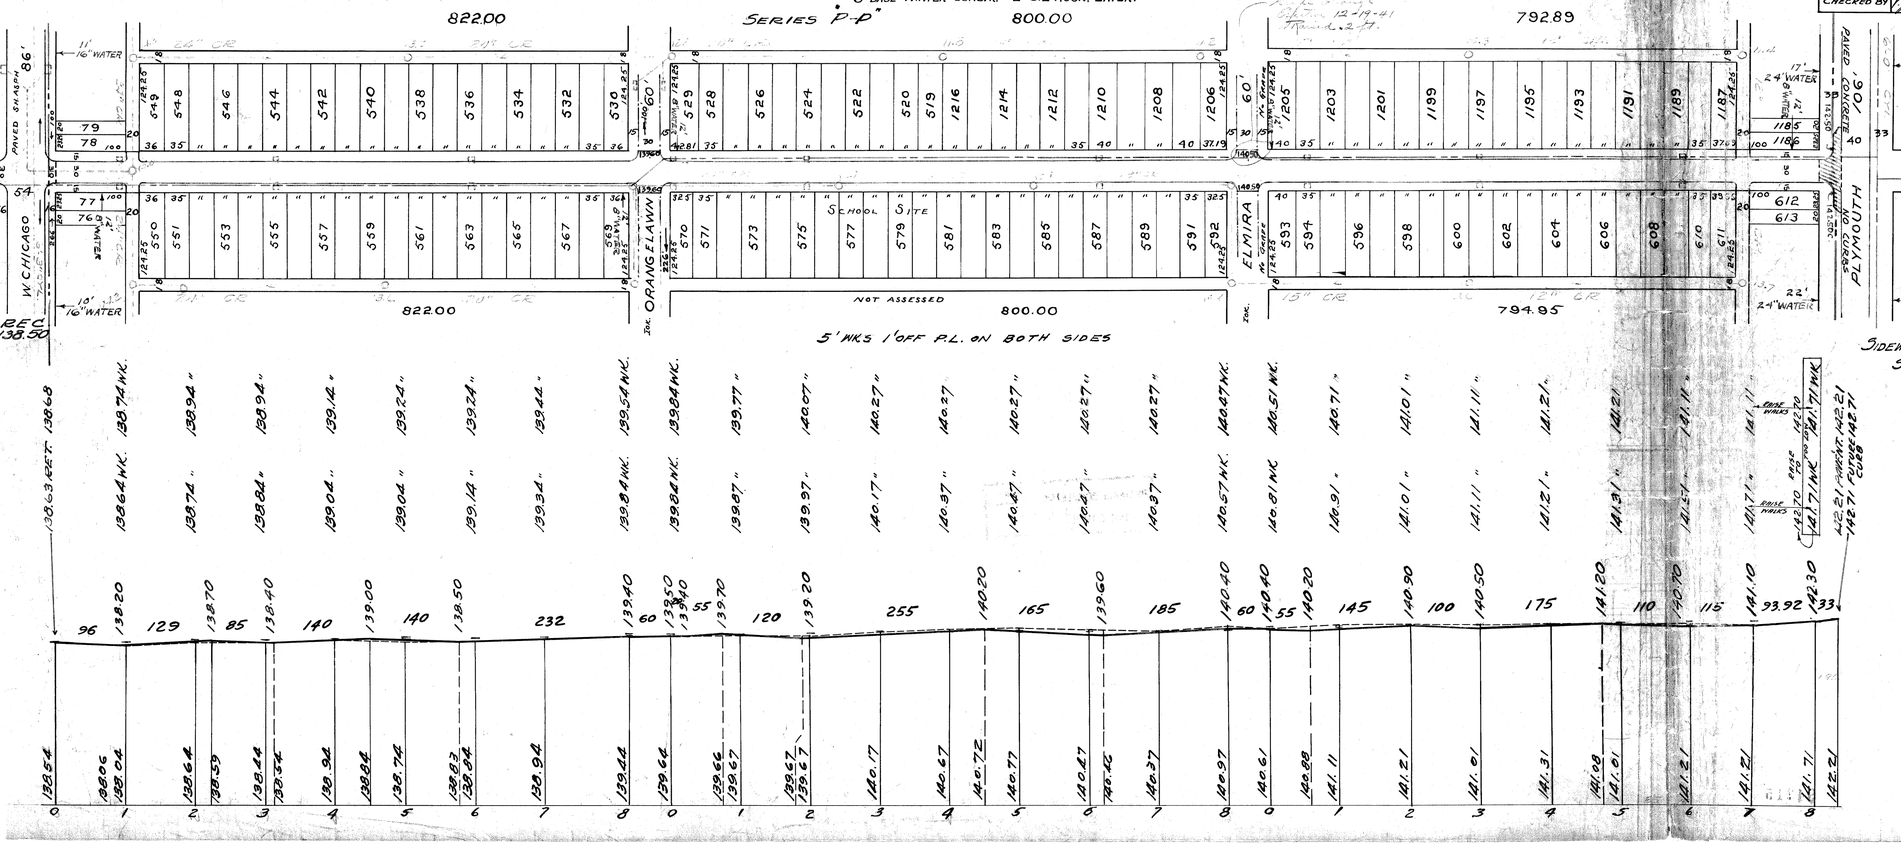

DESIGNED BY	[signature]	APPROVED
DRAWN BY	J. Cerulla	
TRACED BY		ENGINEER OF STREETS
CHECKED BY	[signature]	ASST. CITY ENGINEER

DEPARTMENT OF PUBLIC WORKS
CITY ENGINEER'S OFFICE
DETROIT, MICH.

Job #319

SCALE: HOR. 1" = 100 VER. 1" = 10	DATE 12-1-30	
PLAN DRAWN BY	J. Cerulla	
PLAN CHECKED BY	W. Cathcart	11-1-39 C.N.A.
PROFILE DRAWN BY	J. Cerulla	
COMPUTATIONS MADE BY		
" CHECKED BY		
GRADE ESTABLISHED BY		

895 P.43	LOTS	CITY
Excavation		2 175
N.G. Straight		
Cut Curb Reset		
S.F. Bnd. Cradle by Contr.		
Paving		215
" Concrete Base		
Curb Concrete		
Ext. Stone		
Concr. Header Sq. Yds.		

LOTS	"	4	751	84	1/2 "	2	375 92
CITY	"		386	-	1/2 "		193 -
TOTAL	"	5	137	84	"	2	568 92

~~6" MACADAM - 2 1/2" OIL AGG. 30' WD.~~ CLASS A-1

SEWER REC.
BOOK 4 PAGE 100
CHK'D BY J. Legah O.K.

B.P. - 12-22-36
1060
Cna

SUMP MANHOLE BASINS BY W.P.A.
INSTALLED 1-18-37

BASINS IN JOB

SIDEWALKS O.K. FOR GRADE EST.
SEPT. 3. 1941.

BENCH MARKS

+ ON INTERSECTION WKS. S.E. COR. OF W. CHICAGO & GRANDMONT	138.92
TOP OF HYD. N.W. COR. OF GRANDMONT & ORANGELAWN	142.86
" " S.W. " " " " ELMIRA	143.68
SPK. IN D.S.R. POLE S.E. COR. OF GRANDMONT & PLYMOUTH	142.81
R.R. SPK. IN 30" MAPLE N.S. OF PLYMOUTH 125' E OF MEMORIAL.	143.10

□ = EXISTING POOLS & BASINS
■ = NEW " " "

DRAINAGE COMPLETED.....
PAVING COMPLETED 3-28-42