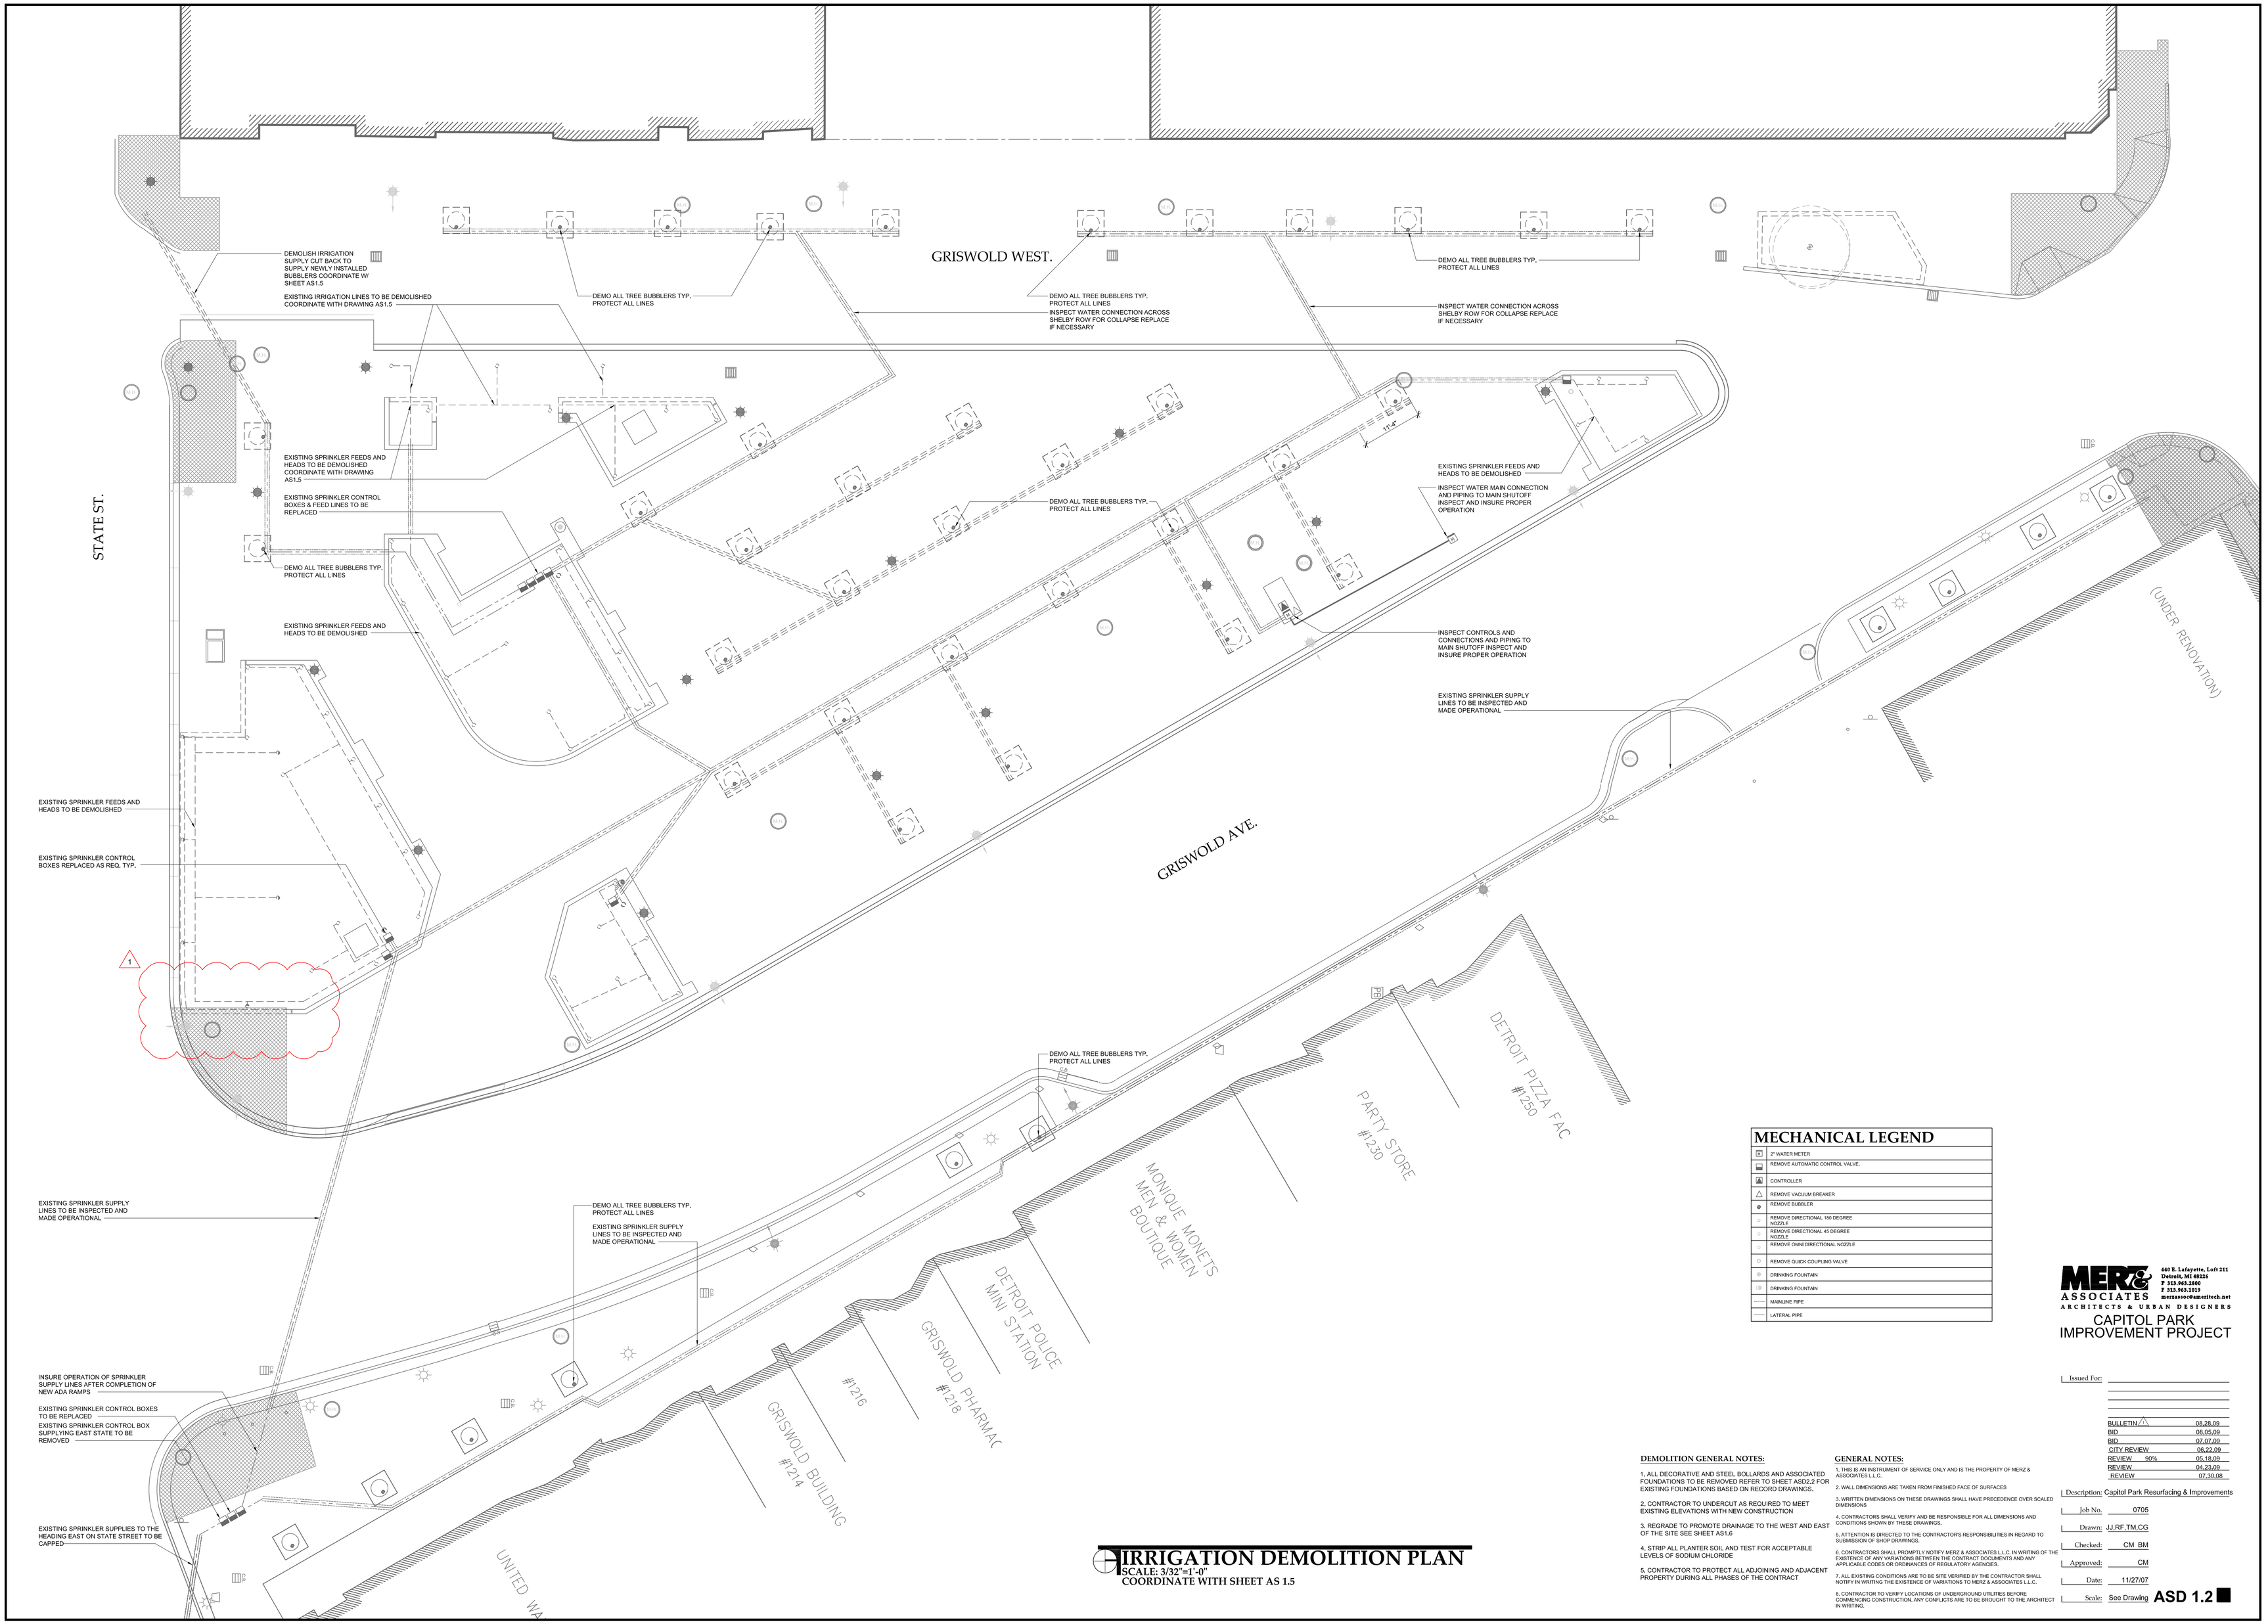

IRRIGATION DEMOLITION PLAN

SCALE: 3/32"=1'-0"

COORDINATE WITH SHEET AS 1.5

MECHANICAL LEGEND

	2" WATER METER
	REMOVE AUTOMATIC CONTROL VALVE.
	CONTROLLER
	REMOVE VACUUM BREAKER
	REMOVE BUBBLER
	REMOVE DIRECTIONAL 180 DEGREE NOZZLE
	REMOVE DIRECTIONAL 45 DEGREE NOZZLE
	REMOVE OMNI DIRECTIONAL NOZZLE
	REMOVE QUICK COUPLING VALVE
	DRINKING FOUNTAIN
	DRINKING FOUNTAIN
	MAINLINE PIPE
	LATERAL PIPE

DEMOLITION GENERAL NOTES:

1. ALL DECORATIVE AND STEEL BOLLARDS AND ASSOCIATED FOUNDATIONS TO BE REMOVED REFER TO SHEET ASD2.2 FOR EXISTING FOUNDATIONS BASED ON RECORD DRAWINGS.

2. CONTRACTOR TO UNDERCUT AS REQUIRED TO MEET EXISTING ELEVATIONS WITH NEW CONSTRUCTION

3. REGRADE TO PROMOTE DRAINAGE TO THE WEST AND EAST OF THE SITE SEE SHEET AS1.6

4. STRIP ALL PLANTER SOIL AND TEST FOR ACCEPTABLE LEVELS OF SODIUM CHLORIDE

5. CONTRACTOR TO PROTECT ALL ADJOINING AND ADJACENT PROPERTY DURING ALL PHASES OF THE CONTRACT

GENERAL NOTES:

1. THIS IS AN INSTRUMENT OF SERVICE ONLY AND IS THE PROPERTY OF MERZ & ASSOCIATES L.L.C.

2. WALL DIMENSIONS ARE TAKEN FROM FINISHED FACE OF SURFACES

3. WRITTEN DIMENSIONS ON THESE DRAWINGS SHALL HAVE PRECEDENCE OVER SCALED DIMENSIONS

4. CONTRACTORS SHALL VERIFY AND BE RESPONSIBLE FOR ALL DIMENSIONS AND CONDITIONS SHOWN BY THESE DRAWINGS.

5. ATTENTION IS DIRECTED TO THE CONTRACTOR'S RESPONSIBILITIES IN REGARD TO SUBMISSION OF SHOP DRAWINGS.

6. CONTRACTORS SHALL PROMPTLY NOTIFY MERZ & ASSOCIATES L.L.C. IN WRITING OF THE EXISTENCE OF ANY VARIATIONS BETWEEN THE CONTRACT DOCUMENTS AND ANY APPLICABLE CODES OR ORDINANCES OF REGULATORY AGENCIES.

7. ALL EXISTING CONDITIONS ARE TO BE SITE VERIFIED BY THE CONTRACTOR SHALL NOTIFY IN WRITING THE EXISTENCE OF VARIATIONS TO MERZ & ASSOCIATES L.L.C.

8. CONTRACTOR TO VERIFY LOCATIONS OF UNDERGROUND UTILITIES BEFORE COMMENCING CONSTRUCTION. ANY CONFLICTS ARE TO BE BROUGHT TO THE ARCHITECT IN WRITING.

MERZ & ASSOCIATES
ARCHITECTS & URBAN DESIGNERS
440 E. Lafayette, Loft 211
Detroit, MI 48226
P 313.963.2800
F 313.963.3019
merzassoc@mediatech.net

CAPITOL PARK IMPROVEMENT PROJECT

Issued For:

BULLETIN 1	08.28.09
BID	08.05.09
BID	07.07.09
CITY REVIEW	06.22.09
REVIEW 90%	05.18.09
REVIEW	04.23.09
REVIEW	07.30.08

Description: Capitol Park Resurfacing & Improvements

Job No. 0705

Drawn: JJ,RF,TM,CG

Checked: CM BM

Approved: CM

Date: 11/27/07

Scale: See Drawing

ASD 1.2