B-4027

DEPARTMENT OF PUBLIC WORKS DETROIT

CITY ENGINEER'S OFFICE --- DIVISION OF PAVING DESIGN

STREET PAVING PLAN

EST- SERIES W

NAME OF STREET: HAVERHILL

FROM: ~~HAYES~~ WHITEHILL

TO: WAYBURN ~~McKINNEY~~

CLASS "B" — 8" MACADAM - 2½" OIL AGG.

TYPE OF PAVEMENT

WIDTH 30'

NUMBER OF SHEETS: 2

SHEET NO.: 2

PET. #6296 6/28/43
CARL A. HUHN
WAYBURN TO McKINNEY

CARD NO.

INDEX NO.: 36 TOPO. NO.: 97

RECORD NO.

CIRCLES						
AT	NO.	Δ	RADIUS	TANG.	ARC	SEG.

QUANTITIES	LOTS	CITY	LOTS	CITY
EXCAVATION				
STRAIGHT CURB NEW				
OLD CURB RESET				
CIRCULAR CURB				
PAVING				
CONCRETE BASE				

HOR. SCALE 1" = 100'		BOOK 1273 PAGE 19			
VER. SCALE 1" = 2'		DATE 1-17-38			
PLAN	W.I.C.	PROFILE	W.I.C.	COMPUTED	
CHECKED E.M. 4-15-40 5-3-39		GRADE	K.G.	CHECKED	7/18/38
LOTS 2L	7	177 48	LENGTH	3	588 74
CITY 2L		708 56	LENGTH		354 28
TOTAL 2L	7	886 04	LENGTH	3	943 02
			LOTS	CITY	
COST ADVERTISING BLANKS					
COST INSPECTION					

BENCH MARKS

SPK IN EL. POLE N.E. COR. HAVERHILL & WHITEHILL		122.86
HYD ARRO N.E. COR. " " LAKEPOINTE		124.64
SPK IN PL.C. POLE N.W. COR. " " ROXBURY		121.81
HYD ARRO S.E. COR. " " BEACONSFIELD		122.92
HYD " " " " SOMERSET		122.21
HYD " N.W. " " MC KINNEY		121.87

EXISTING POOLS & BASINS
NEW

CONTRACTOR MUST CHECK WITH UTILITIES, BEFORE BEGINNING CONSTRUCTION, ON LOCATION OF EXISTING STRUCTURES, WHETHER SHOWN ON PLANS OR NOT.

Installed 12-3-38

DRAINAGE COMPLETED.....
PAVING COMPLETED.....
WAYBURN TO WHITEHILL - 7-12-41

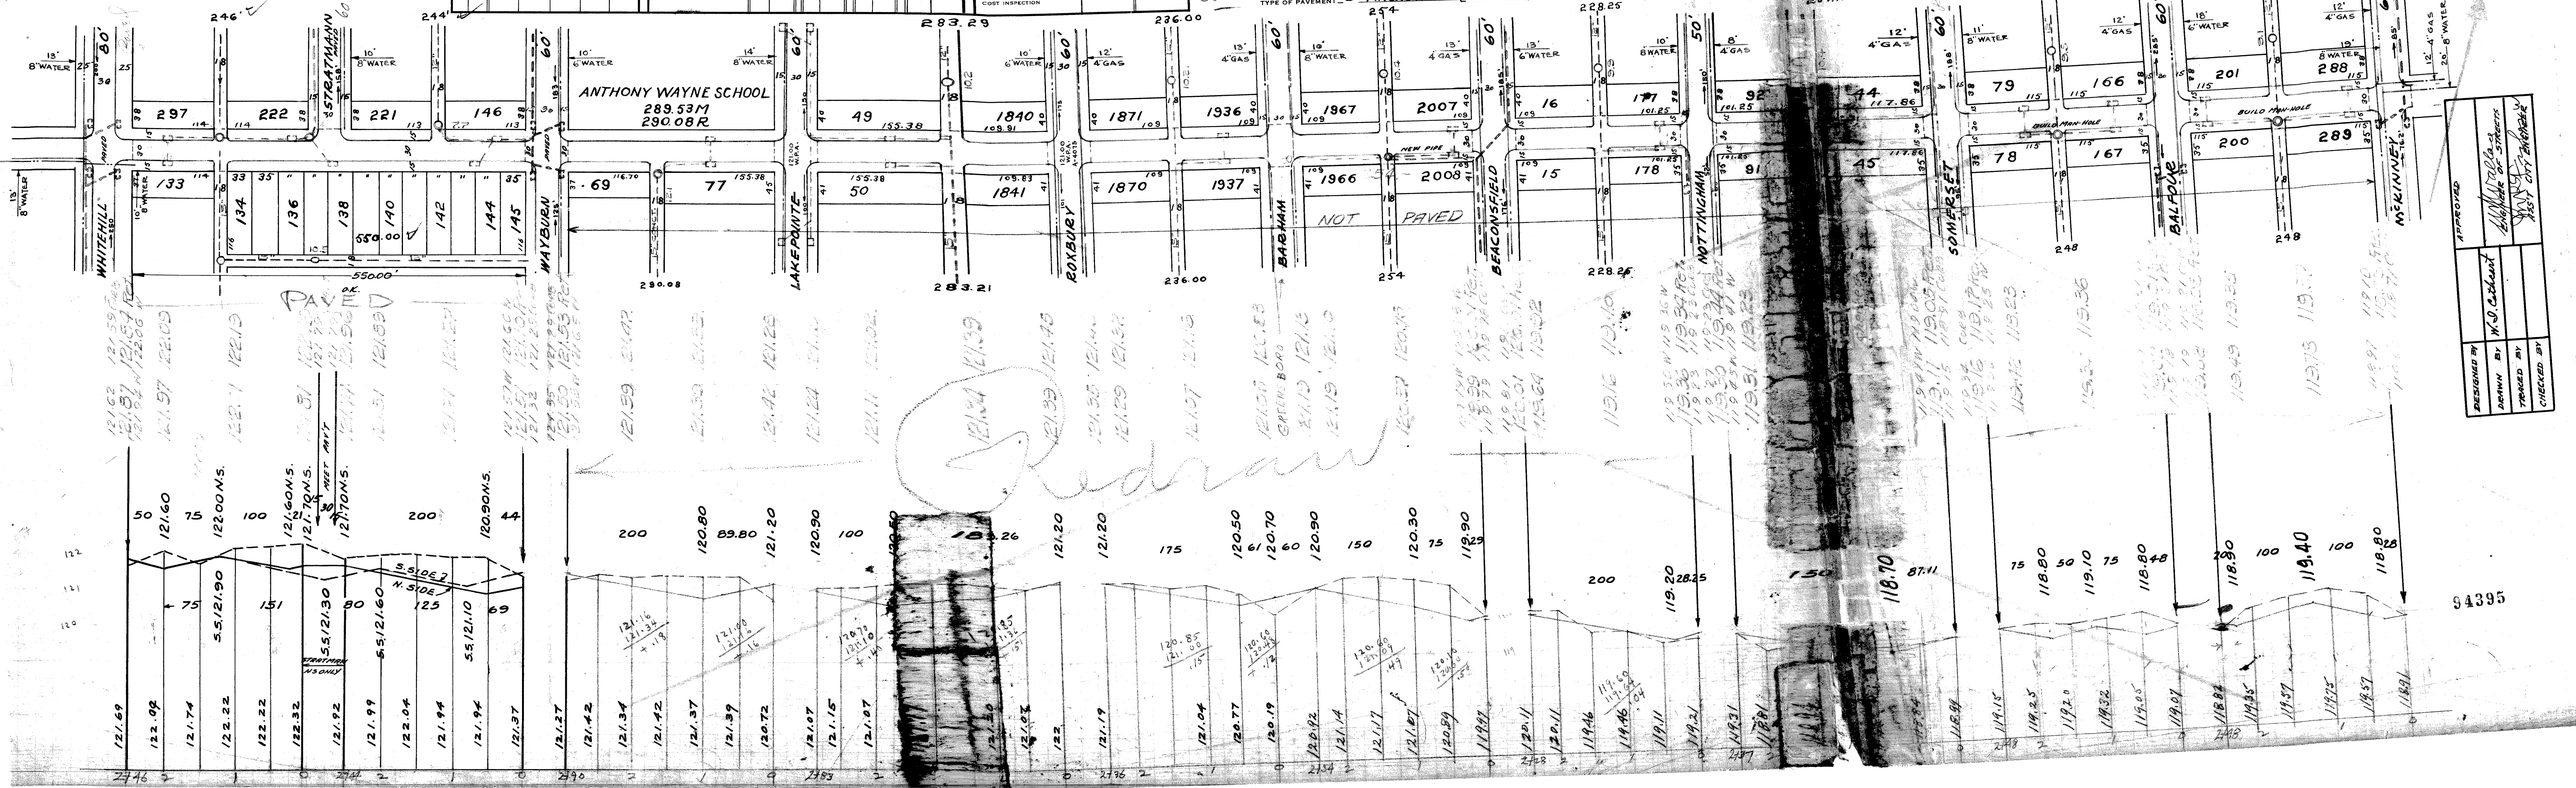

DESIGNED BY	
DRAWN BY	W.J. Cathcart
TRACED BY	
CHECKED BY	
APPROVED	